


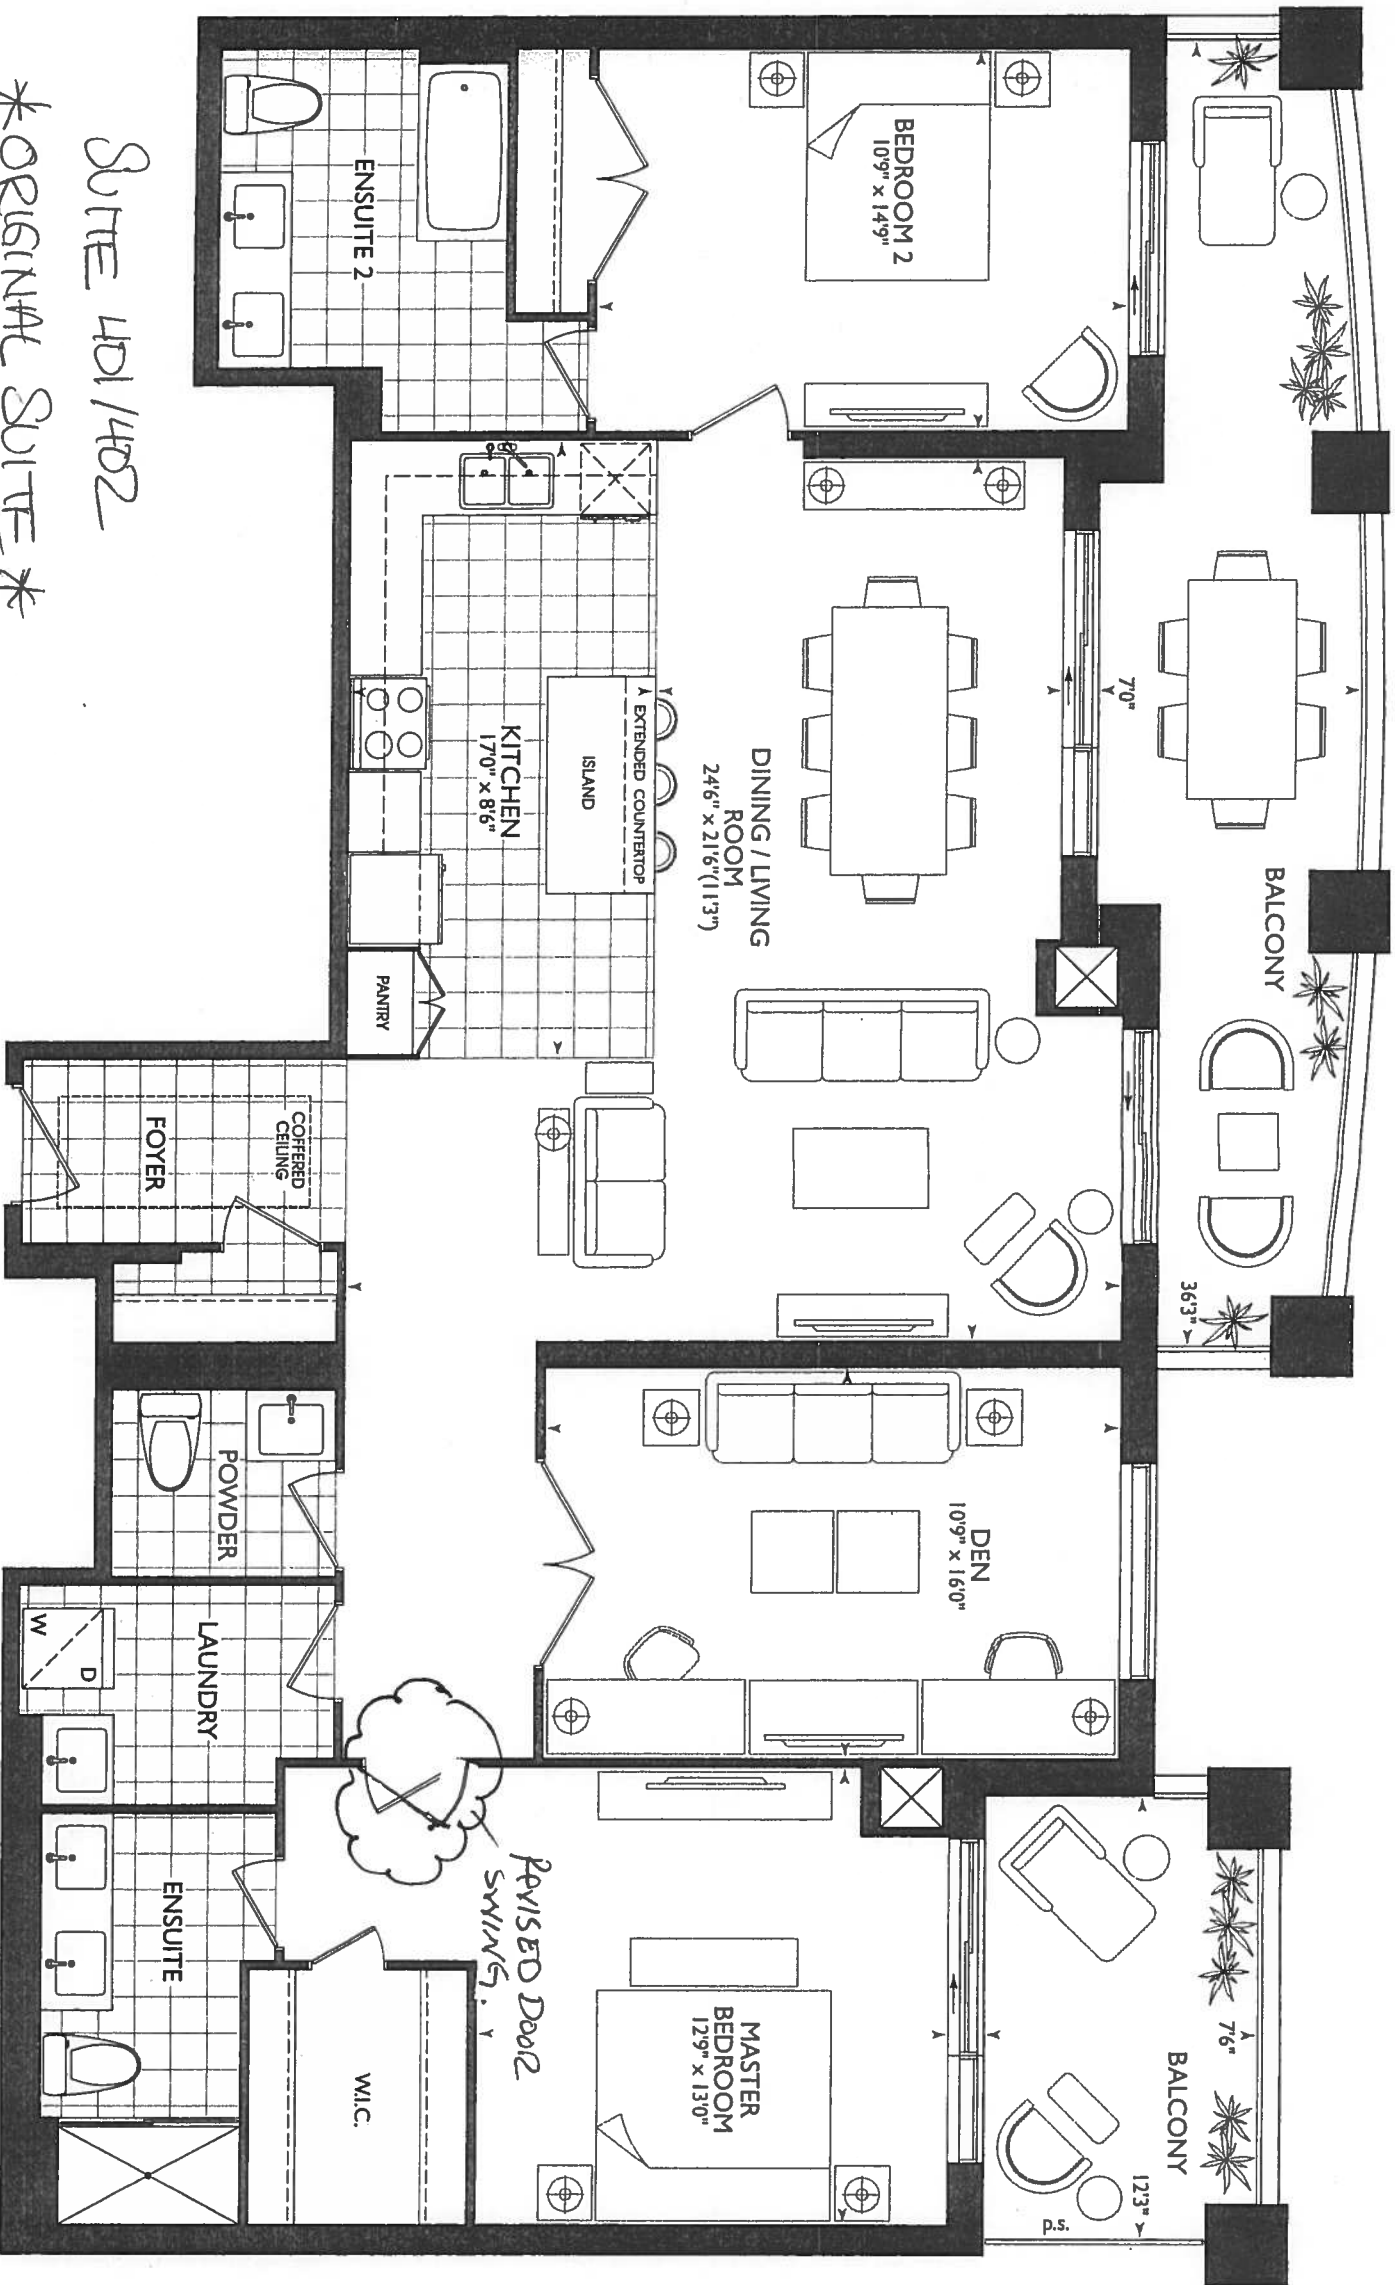

Suite 401/402
ORIGINAL SUITE

LONG ISLAND
2B+D



CONSTRUCTION SUMMARY

Hampton Place

PURCHASER: MARIELLA ALTOBELLO

TEL: RES.: 905-773-6557 BUS.: 416-471-8522

LOT NUMBER	PHASE	HOUSE TYPE	CLOSING DATE	
401+402	1	LONG ISLAND+DEN	18-Oct-18	

Offer Note:	PURCHASER TO RECEIVE \$5,000(INCLUDES APPLICABLE TAXES) WORTH OF UPGRADES AT THE DECOR CENTER AT TIME OF COLOUR CHART.
----------------	--

Offer Upgrade Note:	5 POT LIGHTS, IF POSSIBLE , CENTERED IN BULKHEAD IN KITCHEN ON SEPERATE SWITCH AS PER SKETCH
---------------------------	--

Offer Upgrade Note:	RAINHEAD FROM CEILING IN MASTER ENSUITE, FROM VENDORS SAMPLES
---------------------------	---

Offer Upgrade Note:	CONDUIT AND BLOCKING FOR WALL MOUNTED TV IN LIVING ROOM (60 INCHES ABOVE FINISHED FLOOR) AS PER SKETCH
---------------------------	--



SITE COPY

CONSTRUCTION SUMMARY

Hampton Place

PURCHASER: MARIELLA ALTOBELLO

TEL: RES.: 905-773-6557 BUS.: 416-471-8522

LOT NUMBER	PHASE	HOUSE TYPE	CLOSING DATE	
401+402	1	LONG ISLAND+DEN	18-Oct-18	

Date Added: 22-Jan-18

Invoice Number: 7076

1 - CLARIFICATION; REFER TO APAS; BEDROOM - Standard electrical outlet to be installed at standard height beside conduit pipe Additional electrical outlet to be installed beside pipe & standard cable rough-in Approx. 60" AFF (See Attached Sketch) Note: As per Vince at Head-Office
230 - FOYER & KITCHEN - 1ST UPGRADE - PORCELAIN TILES - 12x24 CALACATTA POLISH - To be installed throughout foyer and kitchen (To be Installed Straight) (See Sketch) Note: Includes Rectified
1 - KITCHEN / BATHROOMS / LAUNDRY ROOM - SEE QUALITY TOPS & KITCHENS FOR ALL KITCHEN, BATHROOMS AND LAUNDRY ROOM UPGRADES / LAYOUTS. - Upgrade Package #1 - (See Attached QTK Paperwork) Note:
1 - KITCHEN - CABINETRY - Install CROWN MOULDING - Style E32 - To be installed throughout kitchen cabinetry, where applicable. Crown Moulding to Touch Underside of Bulk-Head (See Sketch) Note: Priced as per Sheliza at QTK
2 - KITCHEN - Install TWO (2) ADDITIONAL PUCK LIGHTS (Same Switch as Standard Puck Lights) at kitchen. To be installed below kitchen cabinetry, where applicable. (See Attached QTK Layout for Locations) Note: Purchaser Paying Difference for Additional Puck Lights - Standard Kitchen to Receive Five (5) Puck Lights - Upgrade Kitchen Requires Seven (7) Puck Lights
1 - KITCHEN - CABINETRY - Install UPGRADE PACKAGE #1 CABINTERY - Category 3 Fiberboard Classic Grey QT 4801 - To be installed throughout kitchen, where applicable. (See Sketch) Note:
KITCHEN - CABINETRY HARDWARE - Install UPGRADE PACKAGE #1 HARDWARE - STYLE # 527-160 - To be installed throughout kitchen cabinetry, where applicable. (See Sketch) Note:
1 - KITCHEN - Kitchen Backsplash - Install Standard 3x6 SUBWAY WHITE in UPGRADE BRICK PATTERN - To be installed throughout kitchen, where applicable. (does not include behind the fridge or stove) (See Sketch) Note:
1 - KITCHEN - Install STANDARD Granite Countertop - SERENATA GRANITE - To be installed throughout kitchen, where applicable. (Does not include granite backsplash) (See Sketch) Note:
1 - KITCHEN - Countertop Edging - Install UPGRADE " 1 " EDGING - To be installed throughout kitchen countertop, where applicable. (See Sketch) Note: Priced as per Orlando at Connolly
1 - DSICLAIMER - GRANITE COUNTERTOP; KITCHEN - Due to the many variables that can affect the pattern, colour and/or design and "pitting" of natural products, granite installed will not be identical to the samples displayed. Note: Every effort is made to provide granite countertops as close as possible but the vendor is not responsible for results which differ from the sample displayed. All countertop surfaces may have seams, and product pattern and shade can change in areas containing seams.
1 - USCLAIMER - STONE COUNTERTOP; KITCHEN - Stone slabs vary in size & all seams are visible & the fabricator reserves the right to position the seams as necessary.
1 - KITCHEN - Kitchen Sink - Install Upgrade Undermount Sink - BLANCO Quatrus U Super Single Undermount Sink - Model # 401248 (See Attached) Note:
1 - KITCHEN - Kitchen Faucet - Install Standard Faucet - DELTA Chrome Pull-Out Kitchen Faucet (Single Hole) - Model #469LF - Chrome Note:



SITE COPY

CONSTRUCTION SUMMARY

Hampton Place

PURCHASER: MARIELLA ALTOBELLO

TEL: RES.: 905-773-6557 BUS.: 416-471-8522

LOT NUMBER	PHASE	HOUSE TYPE	CLOSING DATE	
401+402	1	LONG ISLAND+DEN	18-Oct-18	

Date Added: 22-Jan-18 Invoice Number: 7076

1 - APPLIANCE PACKAGE - Install Upgrade Appliance Package - UPGRADE PACKAGE #2 - To be Installed throughout suite, where applicable. (See Sketch)
1 - KITCHEN - Install WATER LINE - To Fridge at Kitchen (See Sketch) Note:
1 - POWDER ROOM / MASTER ENSUITE / MASTER ENSUITE #2 - Install RAISED VANITY Heights throughout all bathroom vanities. To Include; Powder Room, Master Ensuite & Master Ensuite #2 (See Sketch) Note:
1 - POWDER ROOM - CABINETRY - Install UPGRADE PACKAGE #1 CABINTRY - Category 3 Fiberboard Classic Grey QT 4801 - To be installed throughout powder room vanity. (See Sketch) Note:
1 - MASTER ENSUITE - CABINETRY - Install UPGRADE PACKAGE #3 CABINTRY - Category 4G Fiberboard Tause Taupe with Black Linen Glaze QT 4801 - To be installed throughout master ensuite vanity. (See Sketch) Note:
1 - MASTER ENSUITE - CABINETRY HARDWARE - Install UPGRADE PACKAGE #1 HARDWARE - STYLE # 55329-G10 - To be installed throughout master ensuite, where applicable. (See Sketch) Note:
1 - MASTER ENSUITE #2 - CABINETRY - Install UPGRADE PACKAGE #3 CABINTRY - Category 4G Fiberboard Asphalt with Black Linen Glaze QT 4801 - To be installed throughout master ensuite vanity. (See Sketch) Note:
1 - MASTER ENSUITE #2 - CABINETRY HARDWARE - Install UPGRADE PACKAGE #1 HARDWARE - STYLE # 55329-G10 - To be installed throughout master ensuite #2, where applicable. (See Sketch) Note:
40 - POWDER ROOM - 1ST UPGRADE - PORCELAIN TILES - 12x24 CALACATTA POLISH - To be installed throuhgout powder room floor. (To be Installed Straight) (See Sketch) Note: Includes Rectified
60 - MASTER ENSUITE - 2ND UPGRADE - PORCELAIN TILES - 12x24 LANCASTER GREY - To be installed throuhgout master ensuite floor. (To be Installed Straight) (See Sketch) Note: Includes Rectified
100 - MASTER ENSUITE - 2ND UPGRADE - PORCELAIN TILES - 12x24 LANCASTER GREY - To be installed throuhgout master ensuite shower stall. (To be Installed Horizontally / Stacked) (See Sketch) Note: Includes Rectified
80 - MASTER ENSUITE #2 - 2ND UPGRADE - PORCELAIN TILES - 12x24 DREAM WHITE - To be installed throuhgout master ensuite #2 floor. (To be Installed Straight) (See Sketch) Note: Includes Rectified
1 - MASTER ENSUITE #2 - 2ND UPGRADE - PORCELAIN TILES - 12x24 DREAM WHITE - To be installed throuhgout master ensuite #2 tub/shower enclosure. (To be Installed Horizontally / Stacked) (See Sketch) Note: Includes Rectified
1 - CLARIFICATION; ALL BATHROOMS - Install Standard 3" Splash throughout All Bathroom Vanity Countertops where applicable. To Include; Powder Room, Master Ensuite & Master Ensuite #2 (See Sketch) Note:
1 - DISCLAIMER - STONE COUNTERTOPS; ALL BATHROOMS - Stone slabs vary in size & all seams are visible & the fabricator reserves the right to position the seams as necessary. Note:



SITE COPY

CONSTRUCTION SUMMARY

Hampton Place

PURCHASER: MARIELLA ALTOBELLO

TEL: RES.: 905-773-6557 BUS.: 416-471-8522

LOT NUMBER	PHASE	HOUSE TYPE	CLOSING DATE	
401+402	1	LONG ISLAND+DEN	18-Oct-18	

Date Added: 22-Jan-18

Invoice Number: 7076

1 - CLARIFICATION;
MASTER ENSUITE - Purchaser accepts & acknowledges the standard glass at master ensuite shower stall will NOT touch the ceiling and will receive a
d Chrome Header. (See Sketch)
Note:

1 - CLARIFICATION;
ALL BATHROOMS - Install Standard Plumbing Fixtures throughout all bathrooms where applicable. To Include; Powder Room, Master Ensuite &
Master Ensuite #2 (See Sketch)
Note:

1 - CLARIFICATION - REFER TO APAS;
MASTER ENSUITE - Install Rain Shower Head from Ceiling at Master Ensuite Shower Stall - DELTA - Shower Trim and Hansgrohe Slide Bar with
Handheld and Ceiling Mount Showerhead
Note: Model # R10000 / T13020-CDN/27454002 / 277440 / RP52382 / RP46870 / RP6025 / R11000 / T11800 - Chrome (See Sketch)

1 - CLARIFICATION;
LAUNDRY ROOM - Install Standard Plumbing (Sink and Faucet) and Laundry Room Vanity (See Sketch)
Note:


1 - BONUS PACKAGE - PURCHASER HAS APPLIED \$5,000.00 (Includes Taxes) WORTH OF UPGRADE PROMOTIONAL PACKAGE
TOWARDS THE PURCHASE OF UPGRADES COMPLETED AT THE DECOR CENTRE.
Note:

1 - PURCHASER HAS ATTENDED A COLOR APPOINTMENT AT THE DECOR CENTRE AND HAS DECLINED ANY ADDITIONAL
UPGRADES. Purchaser accepts and acknowledges that there will be no further changes/additions/deletions to be made upon signing on January 22,


1 - PURCHASER AWARE AND ACCEPTS THAT ANY CHANGES MADE TO UPGRADES AFTER SIGNING THIS PURCHASERS EXTRA
FORM ARE SUBJECT TO A MINIMUM ADMINISTRATION FEE OF \$1,000 PLUS A 10% HOLDBACK FEE.
Note:

This Document is Extremely Time Sensitive - Printed 26 Feb 18 at 15:19



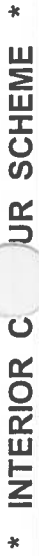

*** INTERIOR CUR SCHEME ***

	Purchaser MARIELLA ALTABELLO	Decor Consultant Melissa Di Marino	Model Type LONG ISLAND+DEN	Telephone Res. / Bus (905) 773-6557 / (416) 471-8522	Project Hampton Place	Closing Date 18/10/2018	Unit 401+402
--	--	--	--------------------------------------	--	---------------------------------	-----------------------------------	------------------------

Flooring		Wall Tile		
	Description	Main	Accent/Insert	Pattern
✓	ASTER ENSUITE	12x24 LANCASTER GREY (STRAIGHT) (UPG)	12x24 LANCASTER GREY (Horizontally) (UPG)	NONE
	AIN BATHROOM	N/A	N/A	N/A
✓	ASTER ENSUITE #2	12x24 DREAM WHITE (STRAIGHT) (UPG)	12x24 DreamWhite (Horizontally) (UPG)	NONE
✓	OWDER ROOM	12x24 CALACATTA POLISH (STRAIGHT) (UPG)	N/A	N/A
✓	ITCHEN / DINETTE	12x24 CALACATTA POLISH (STRAIGHT) (UPG)	3x6 SUBWAY WHITE (BrickPattern)(Upg)	NONE
✓	OYER	12x24 CALACATTA POLISH (STRAIGHT) (UPG)	N/A	N/A
✓	AUNDRY	8x8 BEHRAM PINK (STD)	N/A	N/A
✓	IDE HALL	7 1/2" TorleysForest - Okanogan 9742P (STD)	N/A	N/A

Notes

Page 1 of 3

Consultant: Melissa Di Marino

Purchaser: Mariella Altobello
MARIELLA ALTOBELLO

Vendor: _____
Hampton Place
Printed Jan 22, 2018 2:20 pm



* INTERIOR CLOSET SCHEME *

Purchaser MARIELLA ALTOBELLO	Decor Consultant Melissa Di Marino	Model Type LONG ISLAND+DEN	Telephone Res. / Bus (905) 773-6557 / (416) 471-8522	Project Hampton Place	Closing Date 18/10/2018	Unit 401+402
---------------------------------	---------------------------------------	-------------------------------	---	--------------------------	----------------------------	-----------------

Page 2 of 3

CABINETRY, VANITIES AND COUNTERTOPS

	Style	Countertop	Counter Edge	Handle / Knob	APPLIANCE PACKAGE
Master Ensuite	☒ CATEGORY 4G-FIBERBOARD - TAUSETAUPE with BLACK LINEN GLAZE - QT4801 (Upg)	ASPER TERRA WHITE (STD)	☒ "A" EDGE (STD)	53529-G10 (Upg)	Upgrade Package #2
MASTER ENSUITE #2	☒ CATEGORY 4G-FIBERBOARD - ASPHALT with BLACK LINEN GLAZE - QT4801 (Upg)	ASPER TRIBECA (STD)	☒ "A" EDGE (STD)	53529-G10 (Upg)	
POWDER ROOM	☒ CATEGORY 3 - FIBERBOARD - CLASSIC GREY QT 4801 (UPG)	ASPER TRIBECA (STD)	☐ "A" EDGE (STD)	B603-SC	
KITCHEN / DINETTE	☒ CATEGORY 3 - FIBERBOARD - CLASSIC GREY QT 4801 (UPG)	SERENATA GRANITE (STD)	☒ "I" EDGE (UPG)	527-160 (UPG)	
LAUNDRY ROOM	STD	STD	STD	B603-SC	
					Std 31in Opening

PLUMBING FIXTURES

KITCHEN	
Sink Model	☒ UPG - Blanco Quatrus U #401248
Sink Faucet	☒ STANDARD
TOILETS	
Master Ensuite	☒ STANDARD
ENSUITE #2	☒ STANDARD
Powder Room	☒ STANDARD
VANITY FAUCETS	
Master Ensuite	☒ STANDARD
ENSUITE #2	☒ STANDARD
Powder Room	☒ STANDARD

VANITY SINKS

Master Ensuite	☒ STANDARD
ENSUITE #2	☒ STANDARD
Powder Room	☒ STANDARD

SHOWER STALL / TUBS

Master Ensuite Shower Stall	☒ STANDARD
ENSUITE #2 Tub	☒ STANDARD
Powder Room Tub	N/A

Project: Hampton Place Model: LONG ISLAND+DEN



Trim	
Baseboard & Casing	☒ STANDARD
Interior Doors	☒ STANDARD - CARRARA SMOOTH

MISC. INSTALLATIONS	
Ceramic Accessories (installed by Vendor)	☒ Yes ☐ No
Bathroom Mirrors (installed by Vendor)	☒ Yes ☐ No
Wire Shelving - Closet (installed by Vendor)	☒ Yes ☐ No

Cornice Moulding / Medalion	
Foyer	☒ STANDARD - #CTR-611
Living Room	☒ STANDARD - #CTR-611
Dining Room	☒ STANDARD - #CTR-611
Den	NONE
Master Bedroom	NONE
Bedroom 2	NONE
Bedroom 3	N/A
Fireplace	
Fireplace	N/A
Location Flooring	N/A
Style	N/A
Finish	N/A
Marble	N/A
Hearth	N/A

Paint Throughout	
Walls	☒ STANDARD - BIRCH WHITE
Trim	☒ STANDARD - WHITE

Page 2 of 3

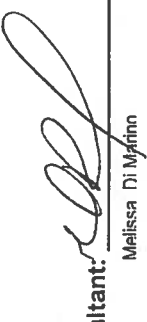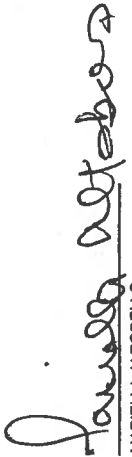Decor Consultant:  Melissa Di Marino
Purchaser:  MARIELLA ALTOBELLO

Vendor: 
Hampton Place
Printed Jan 22, 2018 2:20 pm

Suite 401 / 402
Hampton

Upgrade
Package 2

②

INSIDE ADVANTAGE™



<http://www.insideadvantage.com>

Product Dimensions:

Height: 72
Width: 35 3/4
Depth: 30 1/4

Electrical Requirements:

15 Amps.

Available In:

- ☐ Stainless Steel
- ☒ Black
- ☐ White


KRFC302ESS

22 cu.ft. 36-Inch Width Counter Depth French Door Refrigerator
with Interior Dispense

KRFC302ESS

Key Features:

- ExtendFresh™ Temperature Management System
- Interior Water Dispenser
- Professionally-Inspired Design
- Produce Preserver
- Humidity-Controlled Crispers
- FreshChill™ Temperature-Controlled Full-Width Pantry
- Pull-Out Tri-Level Freezer Drawer
- SatinGlide® System
- LED Lighting
- Star-K Certified
- Automatic Ice Maker
- Max Cool

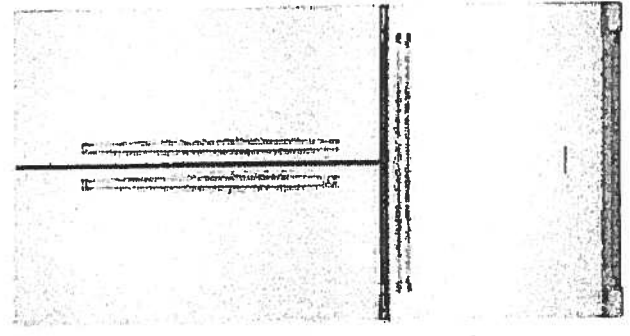

MADE IN
AMERICA


January 22, 2018

KITCHEN

- UPG. PACKAGE #2 - APPLIANCE PACKAGE
- (7x) = PUCK LIGHTS
- (2x) = PLUGS ISLAND.
- (5x) = POTS IN KITCHEN (SEE KITCHEN LAYOUT.)


- 79" STOVE PIER CENTER
- 57" SINK PIER CENTER.

* PAVED VANITIES
POWDER ROOM /
ENSUITE #2
36 1/4" + 3" SPURST

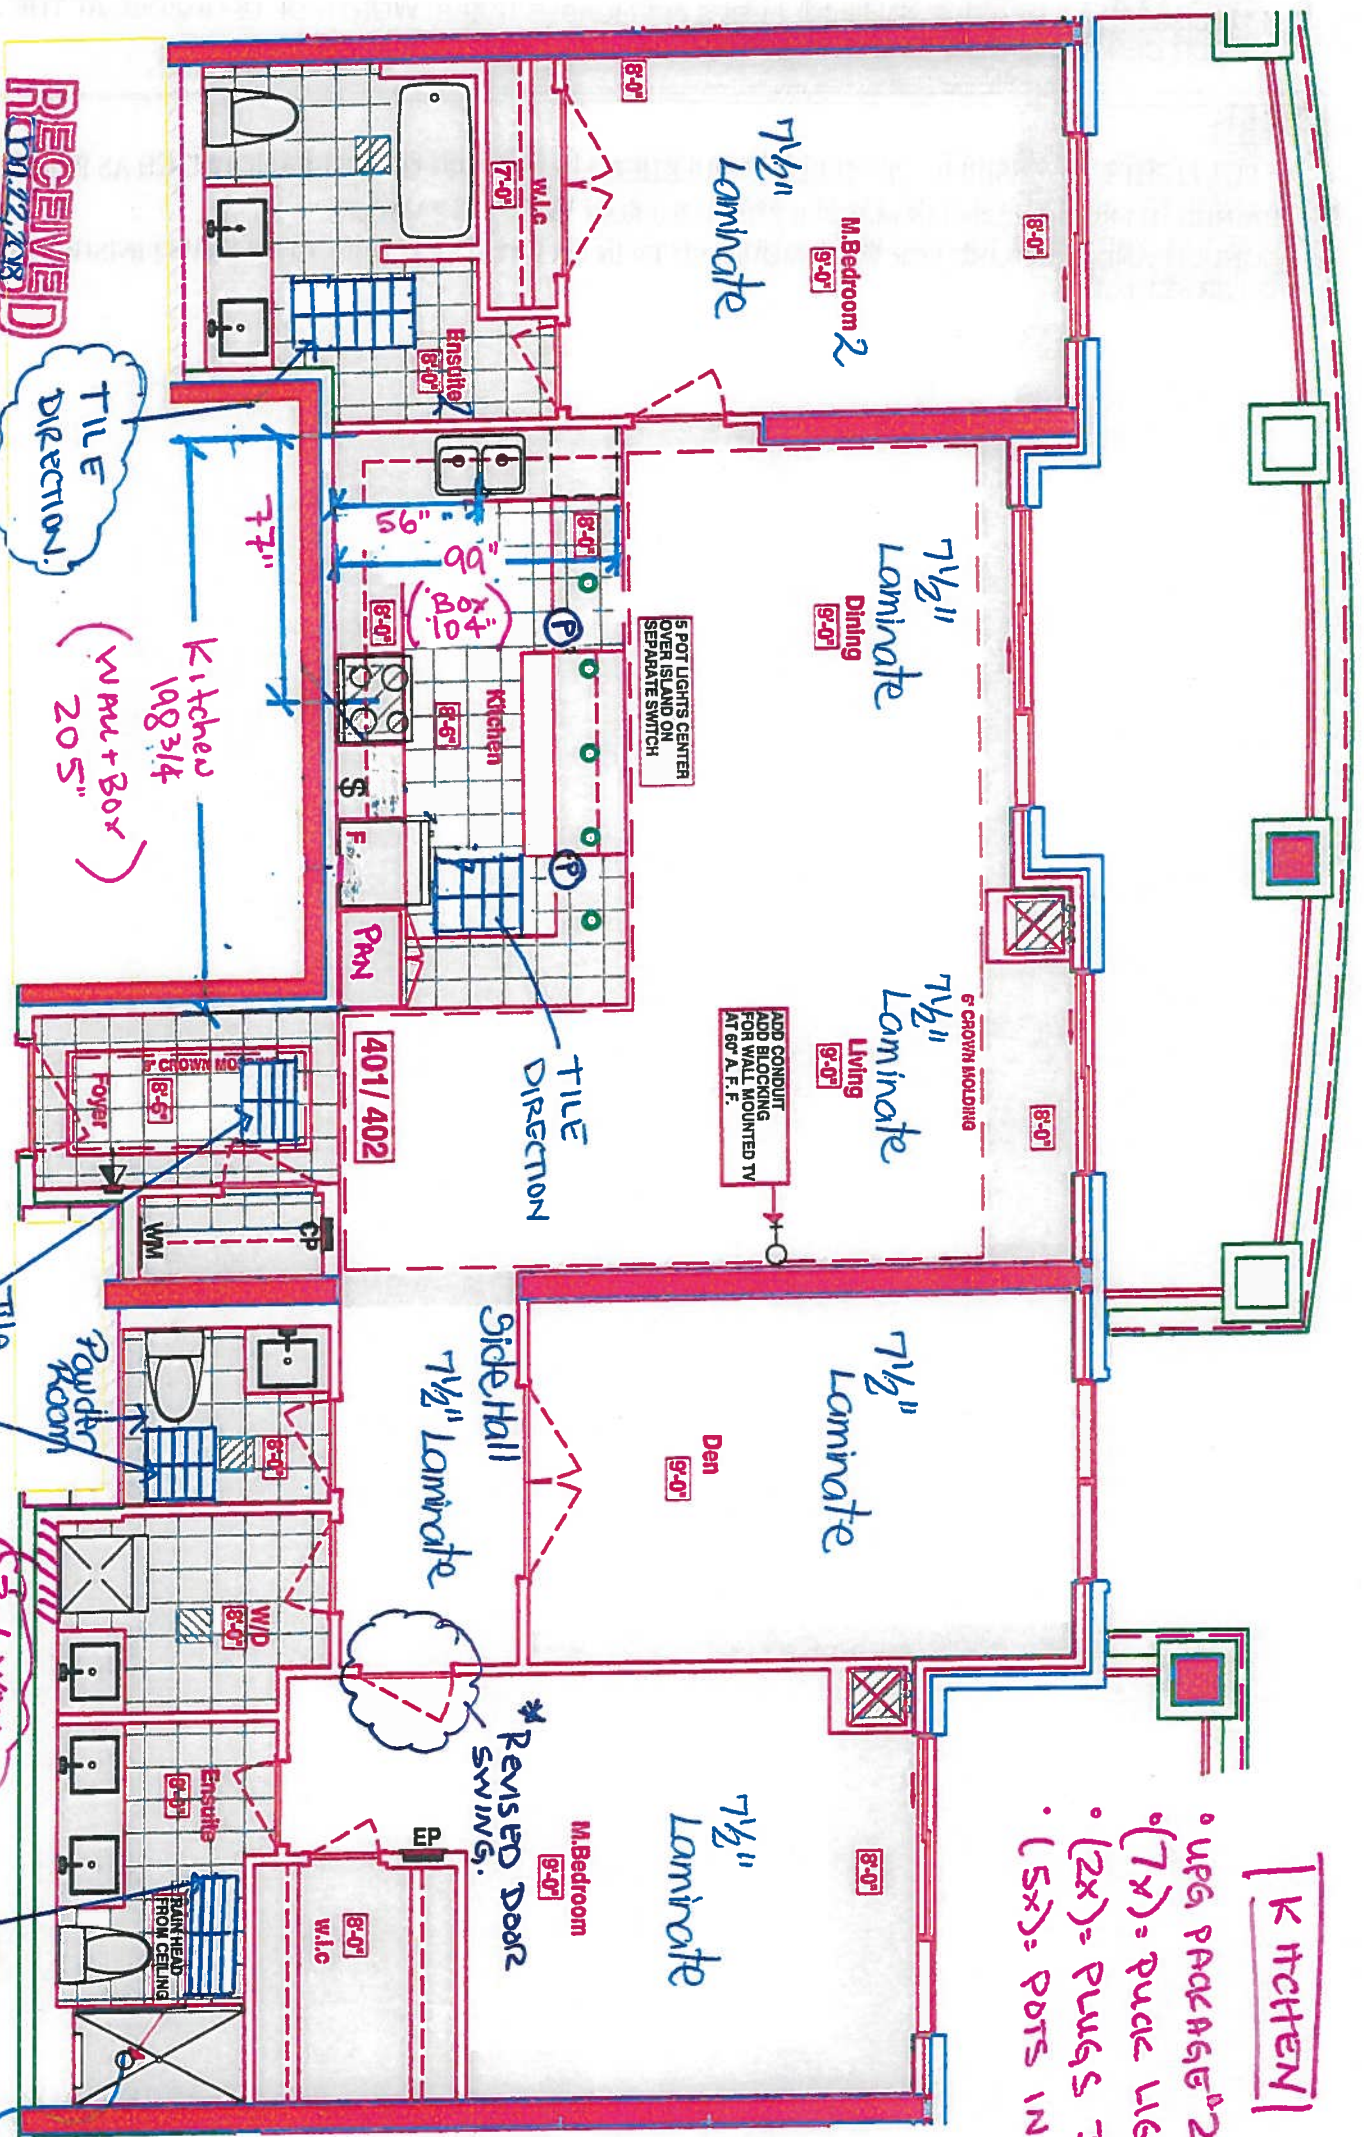


LEGEND:

	SECURITY PANEL
	ELECTRICAL PANEL
	COMMUNICATION PANEL
	WATER METER
	FRIDGE
	DROPPED AREA
	6\"/>

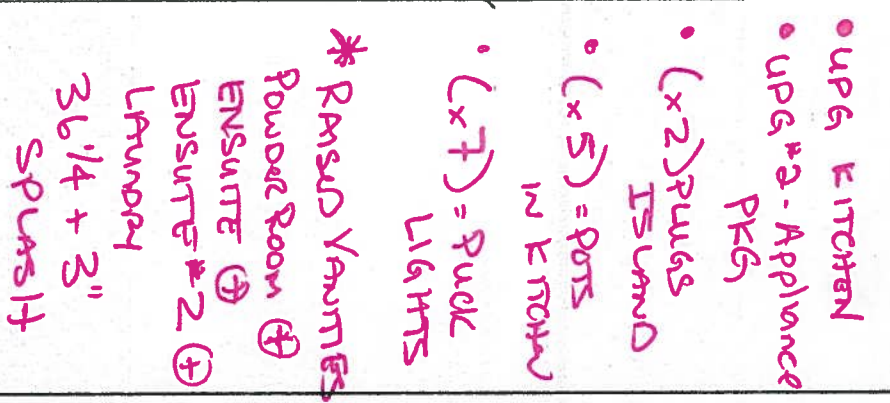

your kitchen. your taste.
80 SANTE DRIVE, VAUGHAN, ON L4K 3C4,
T: 416.748.1811 F: 905.761.5801


CLIENT: ROYAL PINE HOMES	JOB NAME: UNIT 401/402 HMP	ROOM: KITCHEN BULKHEAD PLAN	DRAWN BY: SK	COMMENTS: PLEASE NOTE ALL DIMENSIONS ARE NOT FINAL AND ARE SUBJECT TO CHANGE UPON FINAL SITE MEASURE
SITE: HAMPTON PLACE	DOOR STYLE: —	DOOR HANDLE: —	SCALE: 1/2" = 1' - 0"	
PHONE: —	FINISH: —	DRW HANDLE: —	DATE: REVISED JAN 31 2019	
EMAIL: —	SPECIES: —	TOP: —	PAGE: —	

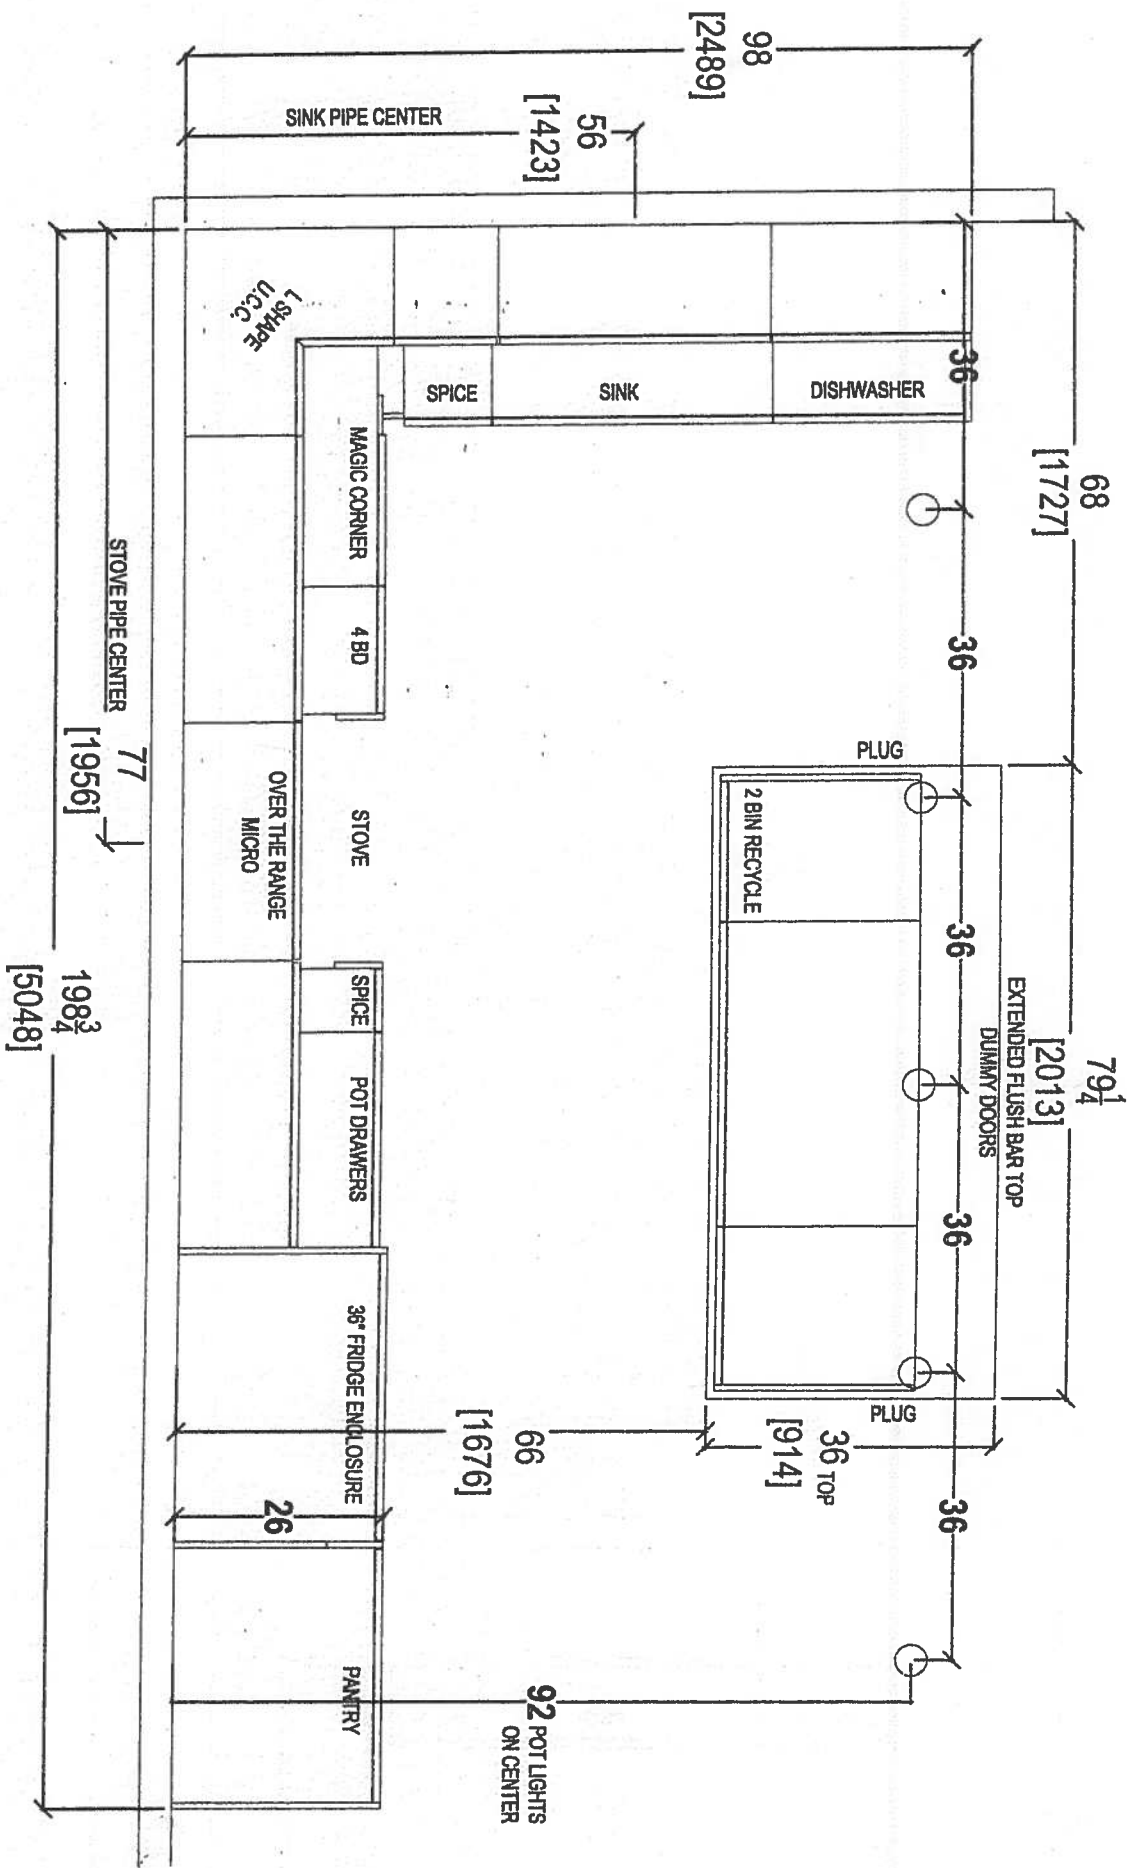

80 SANTE DRIVE, VAUGHAN, ON L4K 3C4,
T: 416.748.1811 F: 905.761.5801

CLIENT: ROYAL PINE HOMES	JOB NAME: UNIT 401/402 HMP	ROOM: KITCHEN FLOOR PLAN	DRAWN BY: SK
SITE: HAMPTON PLACE	DOOR STYLE: —	DOOR HANDLE: —	SCALE: 1/2" = 1' - 0"
PHONE: —	FINISH: —	DRW HANDLE: —	DATE: REVISED JAN 31 2019
EMAIL: —	SPECIES: —	TOP: —	PAGE: —

COMMENTS:
PLEASE NOTE ALL DIMENSIONS
ARE NOT FINAL AND ARE
SUBJECT TO CHANGE UPON
FINAL SITE MEASURE

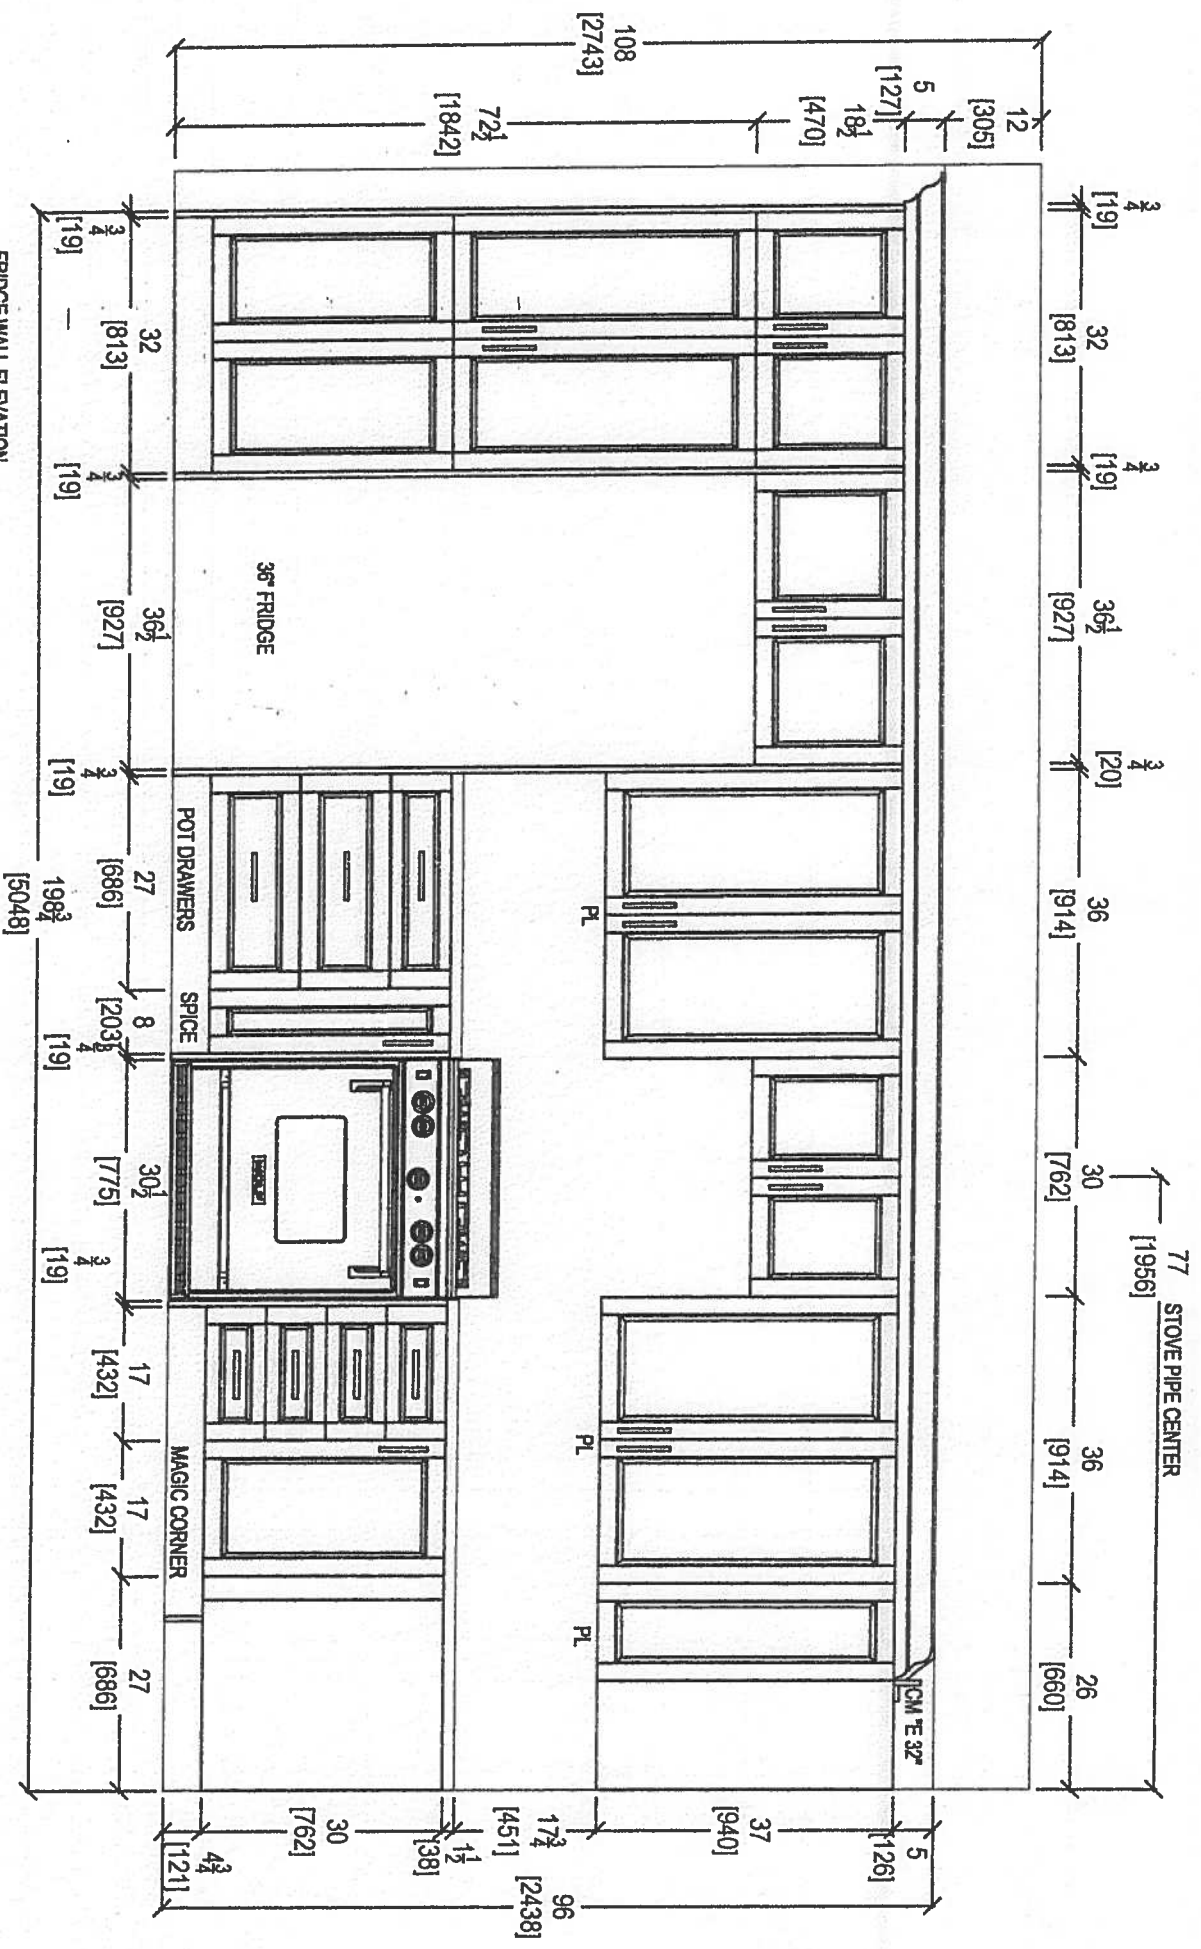




FRIDGE WALL ELEVATION

CLIENT: ROYAL PINE HOMES	JOB NAME: UNIT 401/402 HMP	ROOM: KITCHEN FLOOR PLAN	DRAWN BY: SK
SITE: HAMPTON PLACE	DOOR STYLE: ---	DOOR HANDLE: ---	SCALE: 1/2" = 1'-0"
PHONE: ---	FINISH: ---	DRW HANDLE: ---	DATE: REVISED JAN 31 2019
EMAIL: ---	SPECIES: ---	TOP: ---	PAGE: ---




your kitchen, your taste.
80 SANTE DRIVE, VAUGHAN, ON L4K 3C4,
T: 416.746.1811 F: 905.761.5901

COMMENTS:
PLEASE NOTE ALL DIMENSIONS
ARE NOT FINAL AND ARE
SUBJECT TO CHANGE UPON
FINAL SITE MEASURE

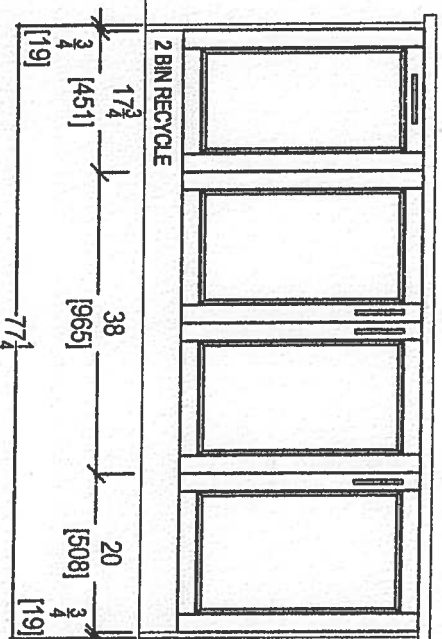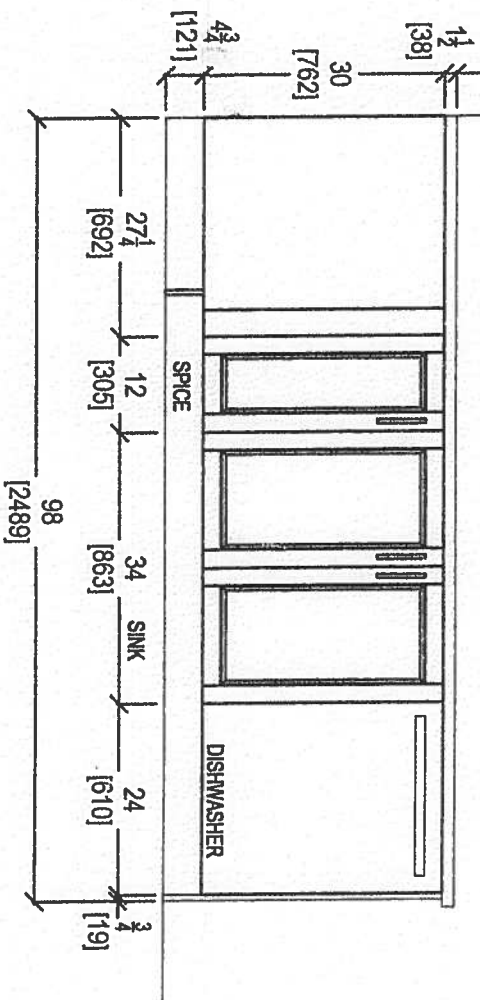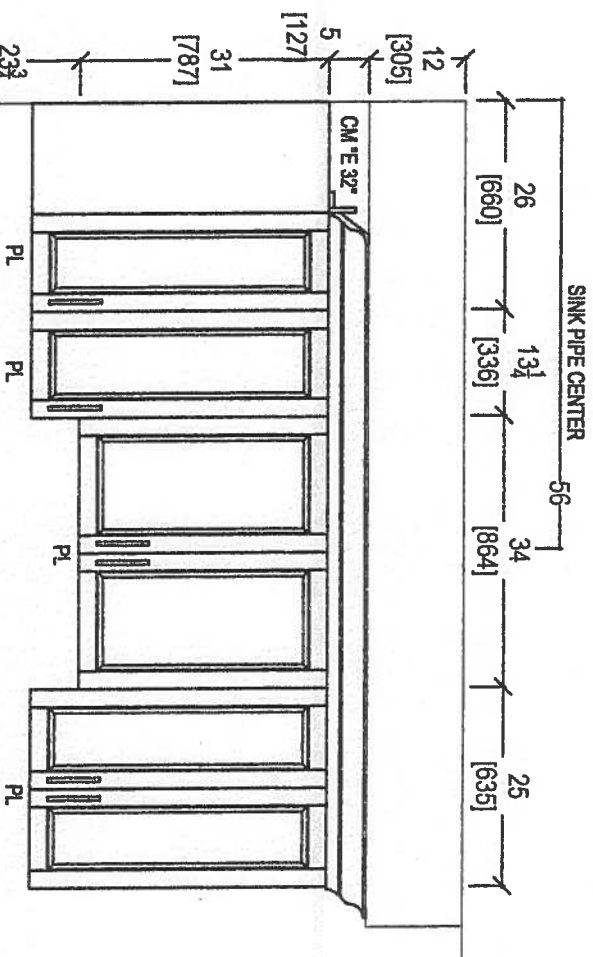

ISLAND FRONT

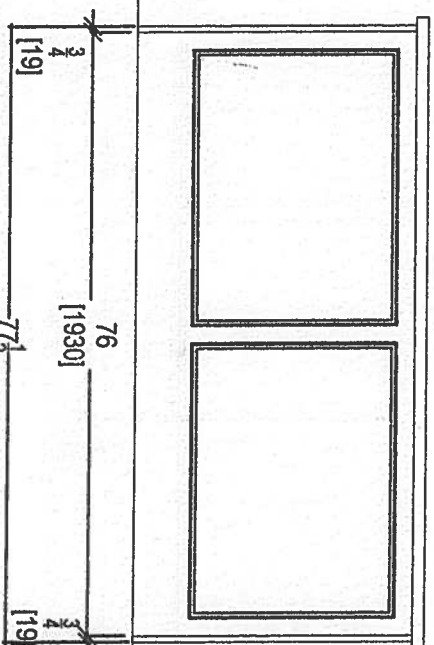

ISLAND REAR

CLIENT: ROYAL PINE HOMES

JOB NAME: UNIT 401/402 HMP

ROOM: KITCHEN FLOOR PLAN

DRAWN BY: SK

SITE: HAMPTON PLACE

DOOR STYLE: —

DOOR HANDLE: —

SCALE: 1/2" = 1'-0"

PHONE: —

FINISH: —

DRW HANDLE: —

DATE: REVISED JAN 31 2019

EMAIL: —

SPECIES: —

TOP: —









PAGE: —



your kitchen, your taste.
80 SANTE DRIVE, VAUGHAN, ON L4K 3C4,
T: 416.746.1811 F: 905.761.5801

COMMENTS:
PLEASE NOTE ALL DIMENSIONS
ARE NOT FINAL AND ARE
SUBJECT TO CHANGE UPON
FINAL SITE MEASURE

*RAISED VANITYS 3" SPLASH

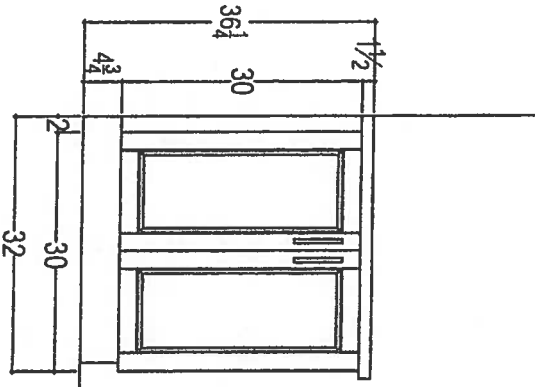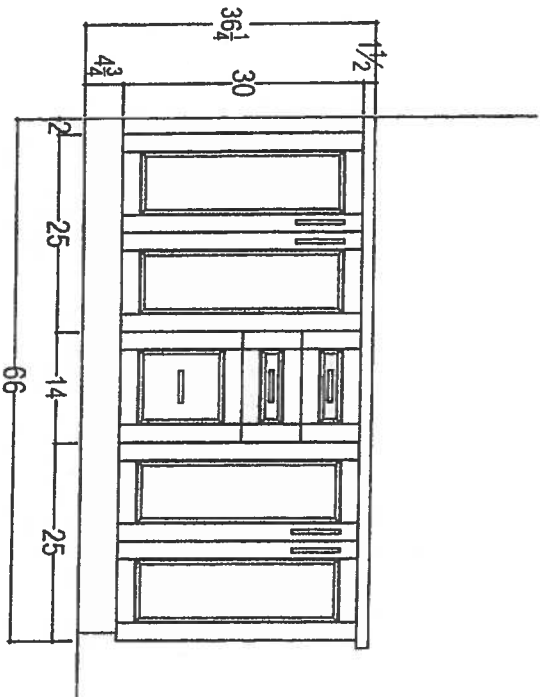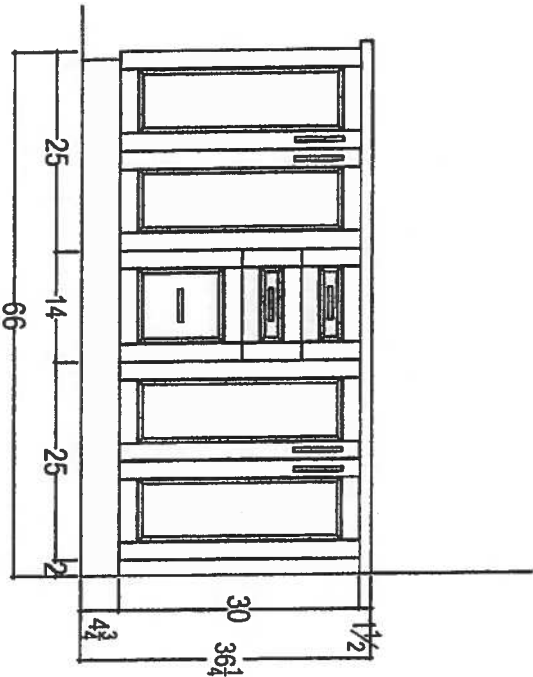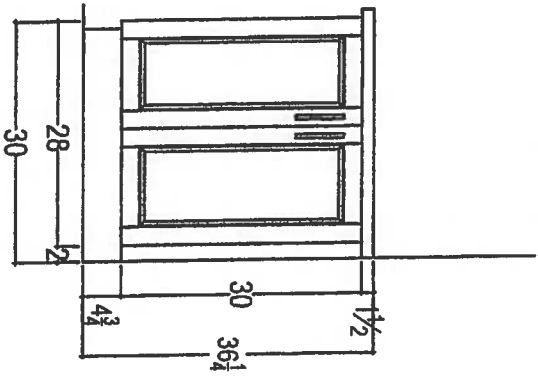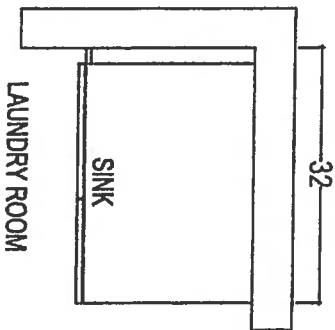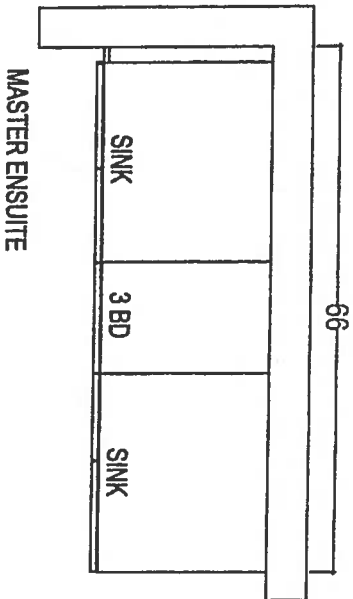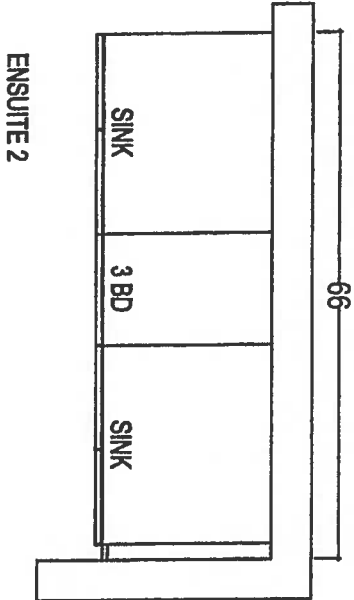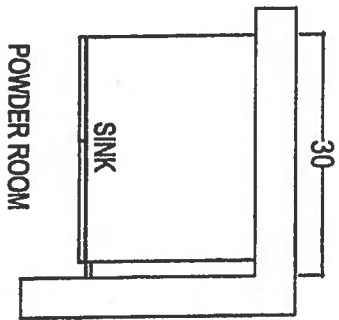

CIENT: ROYAL PINE HOMES	JOB NAME: UNIT 401/402 HMP	ROOM: VANITIES	DRAWN BY: SK	COMMENTS:
SITE: HAMPTON PLACE	DOOR STYLE: --	DOOR HANDLE: --	SCALE: 1/2" = 1'-0"	PLEASE NOTE ALL DIMENSIONS ARE NOT FINAL AND ARE SUBJECT TO CHANGE IF/WH
PHONE: --	FINISH: --	DRW HANDLE:	DATE: JAN 24 2018	

Suite 401/402
Hampton

Upgrade
Package 2




KSEB900ESS

KitchenAid

36-Inch 5-Element Electric Convection Slide-In
Range with Baking Drawer

<http://www.kitchenaid.com>

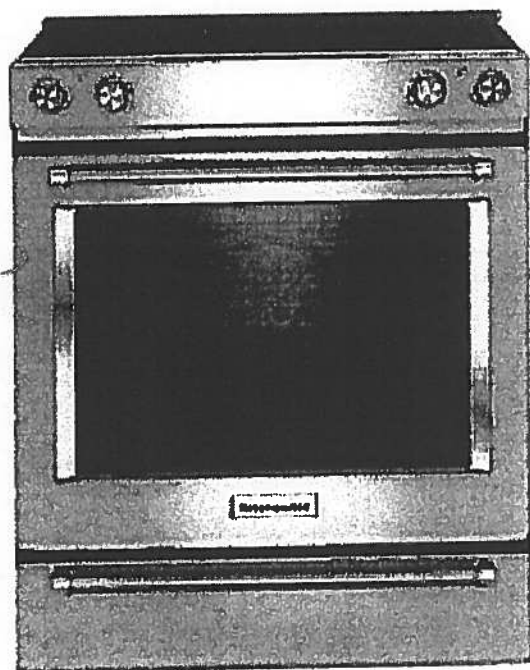

Key Features:

- Baking Drawer
- Even-Heat™ True Convection
- Wireless Probe
- Steam Rack
- 7.1 Cu Ft. Total Capacity
- 5 Cooking Elements Including a Warm Zone
- EasyConvect™ Conversion
- FIT Guarantee
- Aqualift®
- Glass Touch Controls
- Side Trim Accessory Kit

Product Dimensions:

Height: 36

Width: 29 7/8

Electrical Requirements:

40 Amps.

Additional Information:

[Use And Care Guide](#)

[Dimension Guide](#)

[Installation Guide](#)

[Warranty Certificate](#)

Available in:

- Black
- Stainless Steel
- White

INVESTED
IN
AMERICA

ADA
Compliant

©Registered trademark/TM Trademark of Whirlpool, U.S.A. © 2013 Whirlpool Corporation. All Rights Reserved.
All other trademarks are owned by their respective companies.
Because Whirlpool Corporation policy includes a continuous commitment to improve our products, we reserve the right to change materials and specifications without notice. We also reserve the right to discontinue or transition products without notice.
Manufacturer's Suggested Retail Price (MSRP) and Minimum Advertised Price (MAP) provided for reference purposes only. Dealer alone determines advertised and retail prices.
Created On: Tuesday, December 22, 2015 14:04:50

Suite 401/402 Hampton Upgrade Package 2



KMHP519ESS

KitchenAid*

1200-Watt Convection Microwave with High-Speed
Cooking - 30"

<http://www.kitchenaid.com>

Key Features:

- High-Speed Cooking
- Convection Cooking
- Professionally-Inspired Design Including Handle, Badge, Graphics, Chrome Chamfer.
- Cookshield Finish
- Crispwave™ Technology and Crisper Pan
- 1200 Watts Power
- 1.9 Cu. Ft. Capacity
- Halogen Cavity Lights and Task Light
- Steam Cleaning Function
- Keep Warm Function
- Sound-Based Popcorn Function

Product Dimensions:

Height: 17 1/8

Width: 30

Depth: 17

Electrical Requirements:

15.


Additional Information:

[Use And Care](#)

[Dimension Guide](#)

[Installation Guide](#)

[Warranty](#)

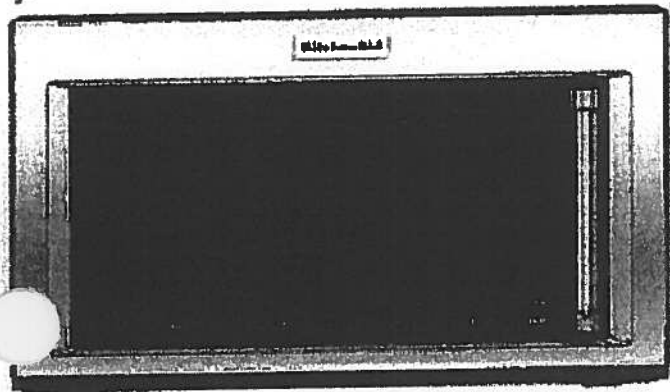

Available In:

 Stainless Steel

®Registered trademark/TM Trademark of Whirlpool, U.S.A. ©2016 Whirlpool Corporation All Rights Reserved. All other trademarks are owned by their respective companies.

Because Whirlpool Corporation policy includes a continuous commitment to improve our products, we reserve the right to change materials and specifications without notice. We also reserve the right to discontinue or transition products without notice.

Manufacturer's Suggested Retail Price (MSRP) and Maximum Advertised Price (MAP) provided for reference purposes only. Dealer alone determines advertised and retail prices.

Suite 401/402 Upgrade Hampton Package 2




KDTM354ESS

KitchenAid®

44 dBA Dishwasher with Clean Water Wash System

<http://www.kitchenaid.com>

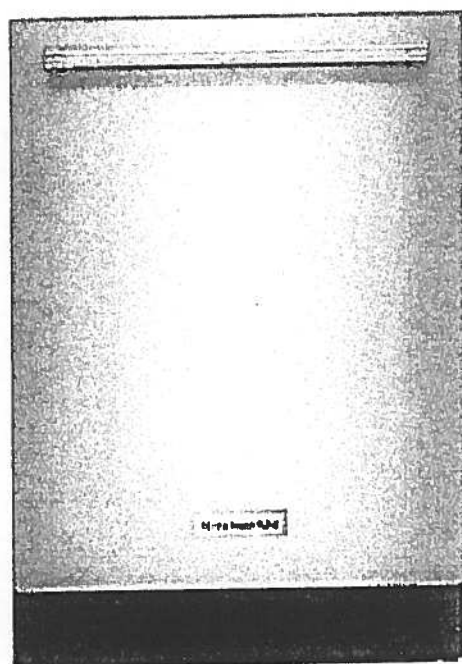

Key Features:

- Clean Water Wash System
- ProScrub® Option
- Professionally-Inspired Design
- Advanced ProDry™ System
- ProWash™ Cycle
- SatinGlide® Max Rails (Upper Rack)
- Sliding Tines in the Lower Rack
- 2 Rows Fold-Down Tines in Upper Rack
- Fold-Down Tines in the Lower Rack
- 2 Fold-Down Cup Shelves with Integrated Stemware Holders
- Utility Basket (Upper Rack)
- Express Wash

Product Dimensions:

Height: 34 1/2

Width: 23 7/8

Depth: 24 3/4

Electrical Requirements:

15 Amps.

Additional Information:

[Use And Care Guide](#)

[Dimension Guide](#)

[Installation Guide](#)

[Energy Guide](#)

[Warranty Certificate](#)

Available in:

● Stainless Steel

INVESTED
IN
AMERICA

©Registered trademark/TM Trademark of Whirlpool, U.S.A. © 2013 Whirlpool Corporation. All Rights Reserved.
All other trademarks are owned by their respective companies.
Because Whirlpool Corporation policy includes a continuous commitment to improve our products, we reserve the right to change materials and specifications without notice. We also reserve the right to discontinue or transition products without notice.
Manufacturer's Suggested Retail Price (MSRP) and Minimum Advertised Price (MAP) provided for reference purposes only. Dealer alone determines advertised and retail prices.
Created On: Friday, March 04, 2016 16:36:55

Suite 401 / 402
Hampton

Upgrade
Package 2




WED85HEFC

Whirlpool®

7.4 cu. ft. Electric Dryer with Quick Dry Cycle

<http://www.whirlpool.com>

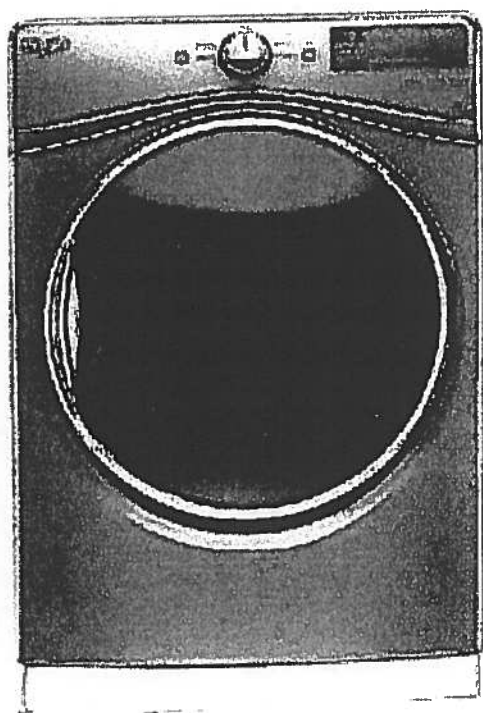

Key Features:

- Advanced Moisture Sensing System
- Tap Touch Controls with Memory
- EcoBoost™ Option
- Steam Refresh Cycle
- Wrinkle Shield™ Option
- Quad Baffles
- 7.4 Cu. Ft. Capacity
- Undercounter Installation
- ENERGY STAR® Qualified
- Sanitize Cycle
- Quick Dry Cycle

Product Dimensions:

Height: 39

Width: 27

Depth: 31

Additional Information:

[Use And Care Guide](#)

[Dimension Guide](#)

[Installation Guide](#)

[Warranty Certificate](#)

INVESTED
IN
AMERICA



©Registered trademark/TM Trademark of Whirlpool, U.S.A. © 2018 Whirlpool Corporation. All Rights Reserved
All other trademarks are owned by their respective companies.
Because Whirlpool Corporation policy includes a continuous commitment to improve our products, we reserve the right to change materials and specifications without notice. We also reserve the right to discontinue or transition products without notice.
Manufacturer's Suggested Retail Price (MSRP) and Minimum Advertised Price (MAP) provided for reference purposes only. Dealer alone determines advertised and retail prices.
Created On: Thursday, March 23, 2017 17:33:37

Suite 401/402 Hampton Upgrade Package 2




WFW85HEFC

 **Whirlpool®**

4.5 cu. ft. Front Load Washer with TumbleFresh™
c. on

<http://www.whirlpool.com>

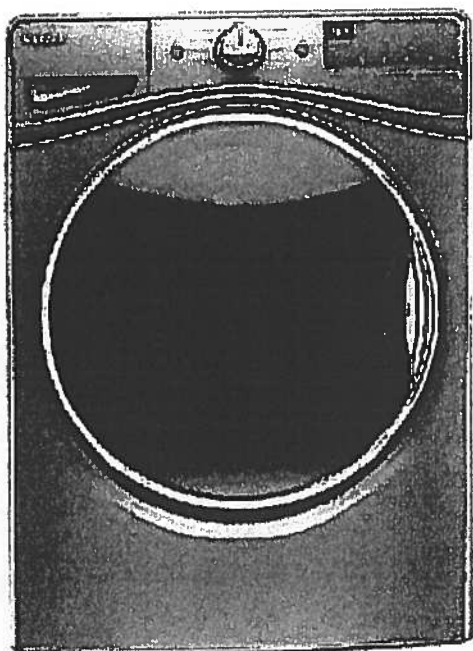

Key Features:

- TumbleFresh™ Option
- ColorLast™ Cycle
- Presoak Option
- EcoBoost™ Option
- Precision Dispense
- Steam Clean Option
- Adaptive Wash Technology
- Smooth Wave Stainless Steel Wash Basket
- 4.5 cu. ft. Capacity
- Undercounter Installation
- Add-A-Garment
- ENERGY STAR® Certified

Product Dimensions:

Height: 39 3/4

Width: 27

Depth: 33 5/16

Additional Information:

[Use And Care Guide](#)

[Dimension Guide](#)

[Installation Guide](#)

[Energy Guide](#)

[Warranty Certificate](#)

Available in:

- ☒ Chrome Shadow
☐ White

INVESTED
IN
AMERICA




©Registered trademark/TM Trademark of Whirlpool, U.S.A. © 2016 Whirlpool Corporation. All Rights Reserved.
All other trademarks are owned by their respective companies.
Because Whirlpool Corporation policy includes a continuous commitment to improve our products, we reserve the right to change materials and specifications without notice. We also reserve the right to discontinue or transition products without notice.
Manufacturer's Suggested Retail Price (MSRP) and Minimum Advertised Price (MAP) provided for reference purposes only. Dealer alone determines advertised and retail prices.
Created On: Wednesday, December 14, 2016 18:12:43

Upgrade Kitchen Sinks




BLANCO

Suite 401/402
Hampton

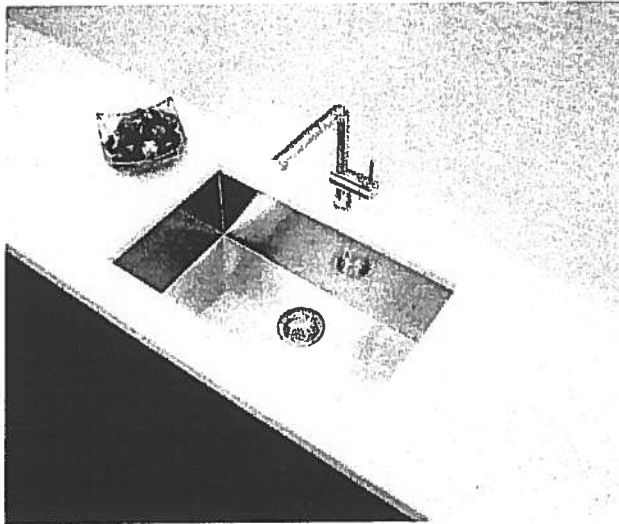

**Blanco Quatrus U Super Single
Undermount Sink
#401248**

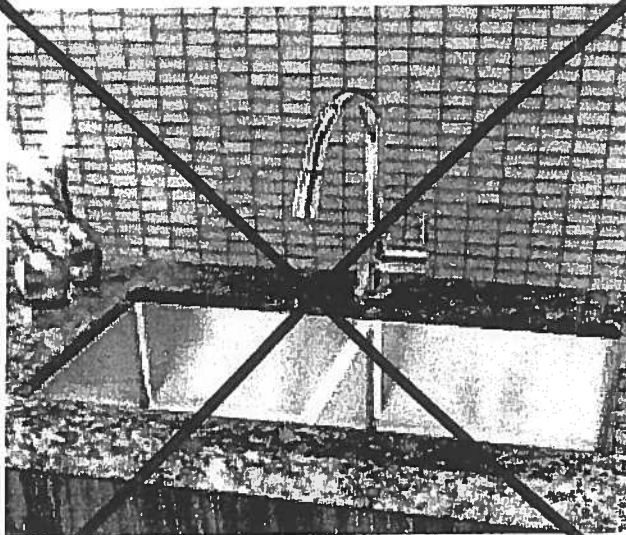

**Blanco Quatrus R15 Two Bowl
Undermount Sink
#401519**

Suite 401 / 402
Hampton


Kitchen
Sink

Product Specification Sheet
BLANCO QUATRUS U 1 SUPER SINGLE

Satin brushed finish



PRODUCT DIMENSIONS

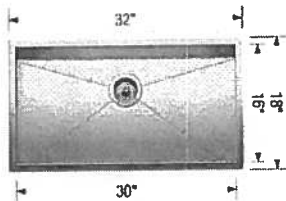

BLANCO QUATRUS U 1 SUPER SINGLE	Colour Finish	Model No.	FEATURES / SPECIFICATIONS
	Satin brushed finish	401248	• German designed and engineered • Premium 304 series, 18 gauge stainless steel • 18/10 chrome-nickel content for exceptional lustre, durability and strength • Compact sized model • Rear-positioned drain hole for maximum usable bowl and cabinet storage space • Zero-radius corners, X-pattern drain grooves • 3 1/2" (90 mm) stainless steel strainer included • Undermount clips, template included • Limited Lifetime Warranty
DESIGN AND PLANNING TIPS Cabinet Size: 36" (915 mm) Bowl depth: 9" (230 mm) Depending on cabinet construction, a different cabinet size may be required. Consult the cabinet manufacturer.			

WARRANTY

Limited Lifetime warranty

Code/Standards Compliance

BLANCO sinks and faucets are third-party tested and certified to CSA, cUPC, ANSI/ASME and NSF standards and listed by applicable certification bodies. For more information on individual product listings, contact our office or listing organization.

BLANCO CANADA
100 Corporation Drive
Brampton, ON L6S 6B5

Tel: 905 494 2400
Fax: 905 494 2425
www.blancocanada.com


Toll Free: 1 877 425 2626
Toll Free: 1 877 825 2626

© 2016 BLANCO CANADA

Standard




Suite 401/402
Hampton

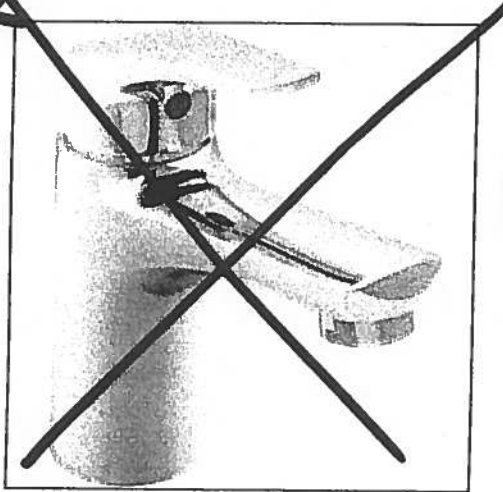


Delta Wynne Chrome Single Lever
Lavatory Faucet With Pop Up
#534LF

Master Ensuite
Shower stall

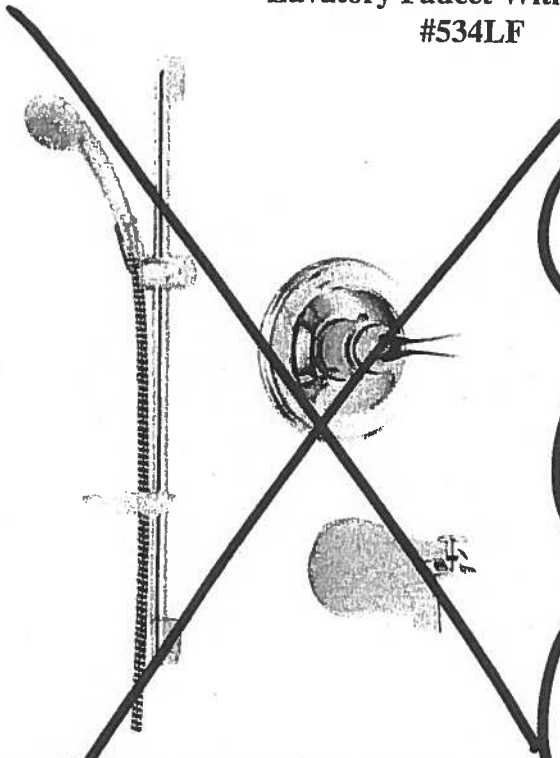

Delta Shower Trim with Tub Spout and
Hansgrohe Slide Bar with Handheld
#R10000/T13020-CDN/2001-TP/27454002/
27744000

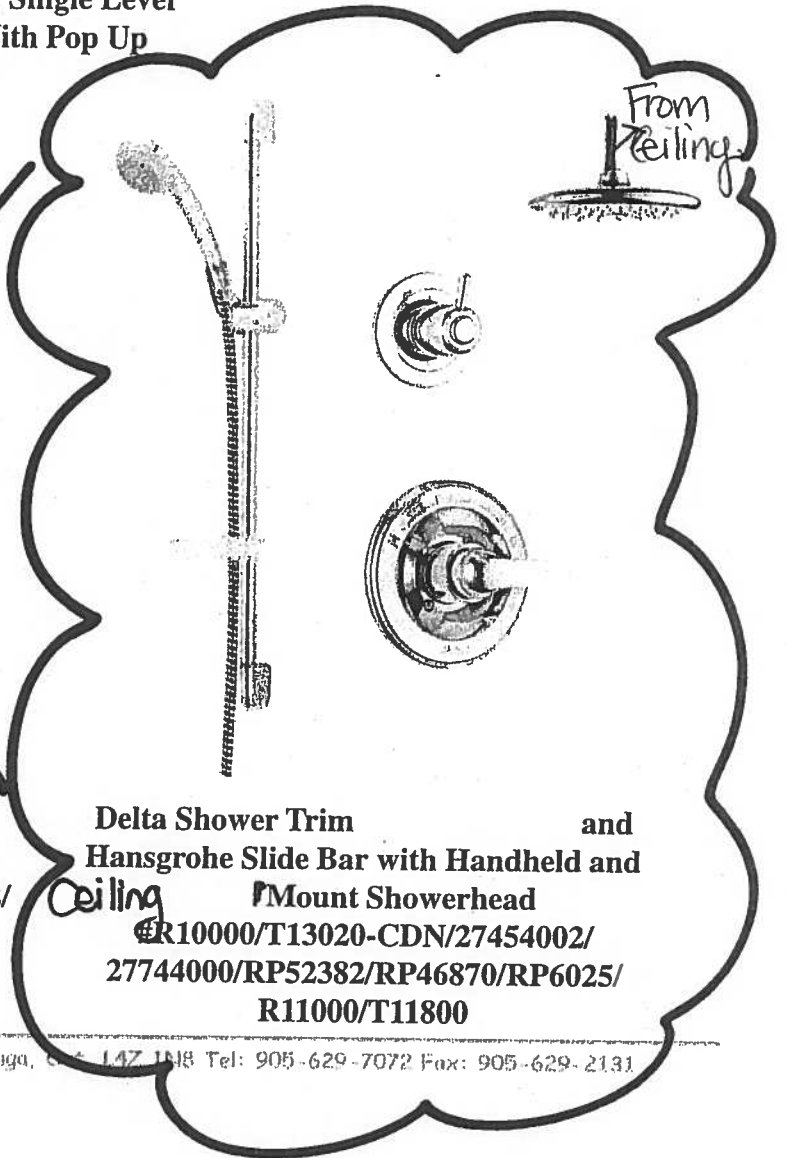

Delta Shower Trim and
Hansgrohe Slide Bar with Handheld and
Ceiling Mount Showerhead
#R10000/T13020-CDN/27454002/
27744000/RP52382/RP46870/RP6025/
R11000/T11800

Suite 401 / 402

Hampton

Living Room

→ CONDUIT :

CABLE/BELL

© 60"

TV →

← PLUG

← conduit

BLANK
PLATE

PLUG

Countertop Edges
Suite 401 / 402
Hampton



CONNOLLY Marble & Granite Ltd.

EDGE
DETAILS

004


A.



STRAIGHT EDGE
(STANDARD - 3/4")

Standard:
Powder Room
Master Ensuite
Master Ensuite #2

M.

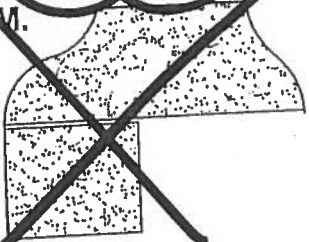

DOUBLE TOP "D" EDGE
(STANDARD - 1 1/2")

Upgrade:
Kitchen

OGEE - SQUARE EDGE
(MED./HIGH - 1 1/2")

EDGING UP-GRADE OPTIONS