





Remsenburg

1,031 SQ FT *plus* 124 sq. ft. of balcony area

Suite #216
ORIGINAL
Brochure


(Inventory Suite)

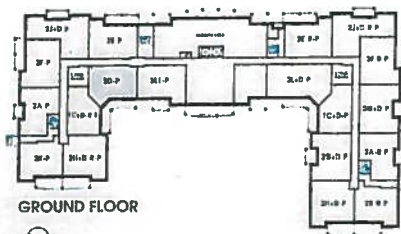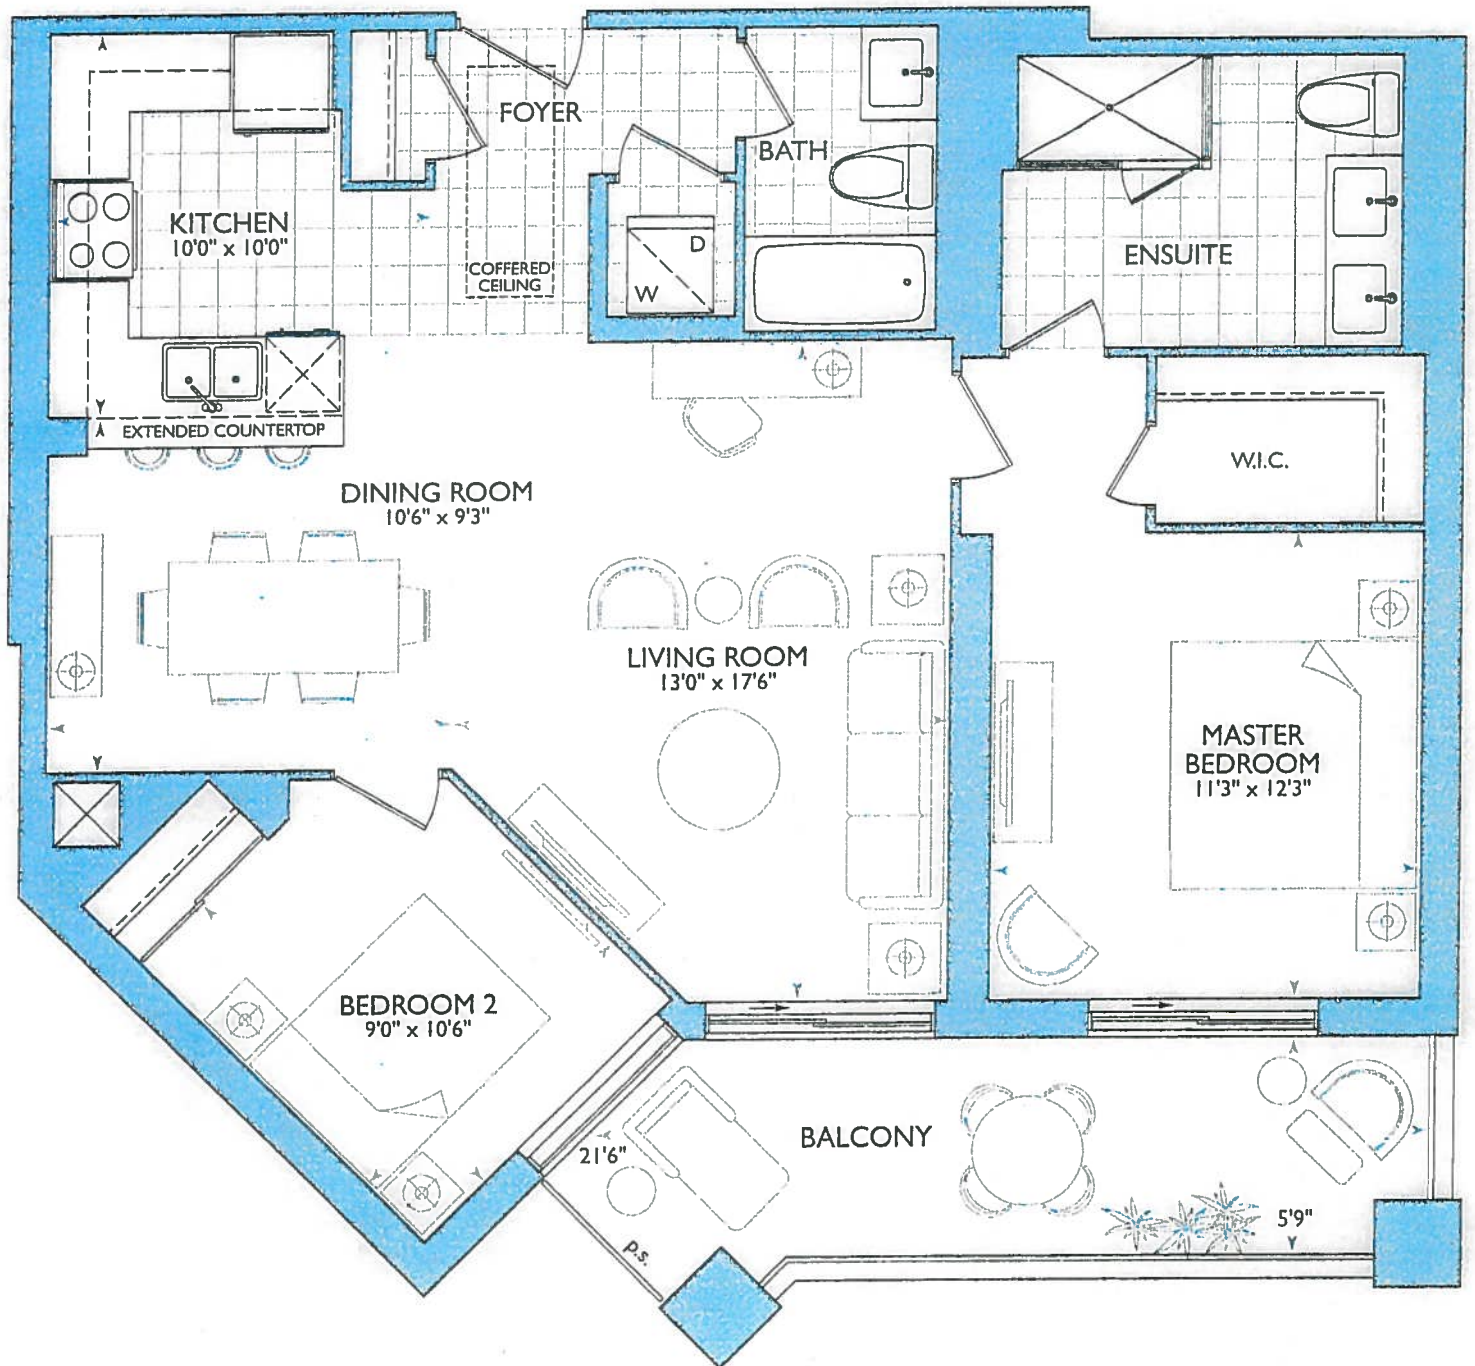

GROUND FLOOR



2ND - 5TH FLOOR

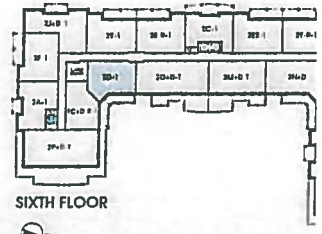

SIXTH FLOOR



KITCHEN. Revised Feb 4. 18

Ⓟ = Plug Peninsula

(2x) = Pendant Lights

over Peninsula

• STD KITCHEN LAYOUT

• 1ST WRG APPLIANCE PKG.

• (3x) = Puck Lights

• Ranso Power Room +

ensuite vanity 36 1/4" + 3" SPLAS +


• 66" stove pre center

• 117" sink pre center

Inventory Suite.


SUITE 216- REMSENBURG - 2D-R

HAUPTON PLACE • 25 Baker Rd Bldg - Scituate, MA • Jan 23, 2018
DRAWING AS PER AGREEMENT OF PURCHASE AND SALE (before decor appointment)

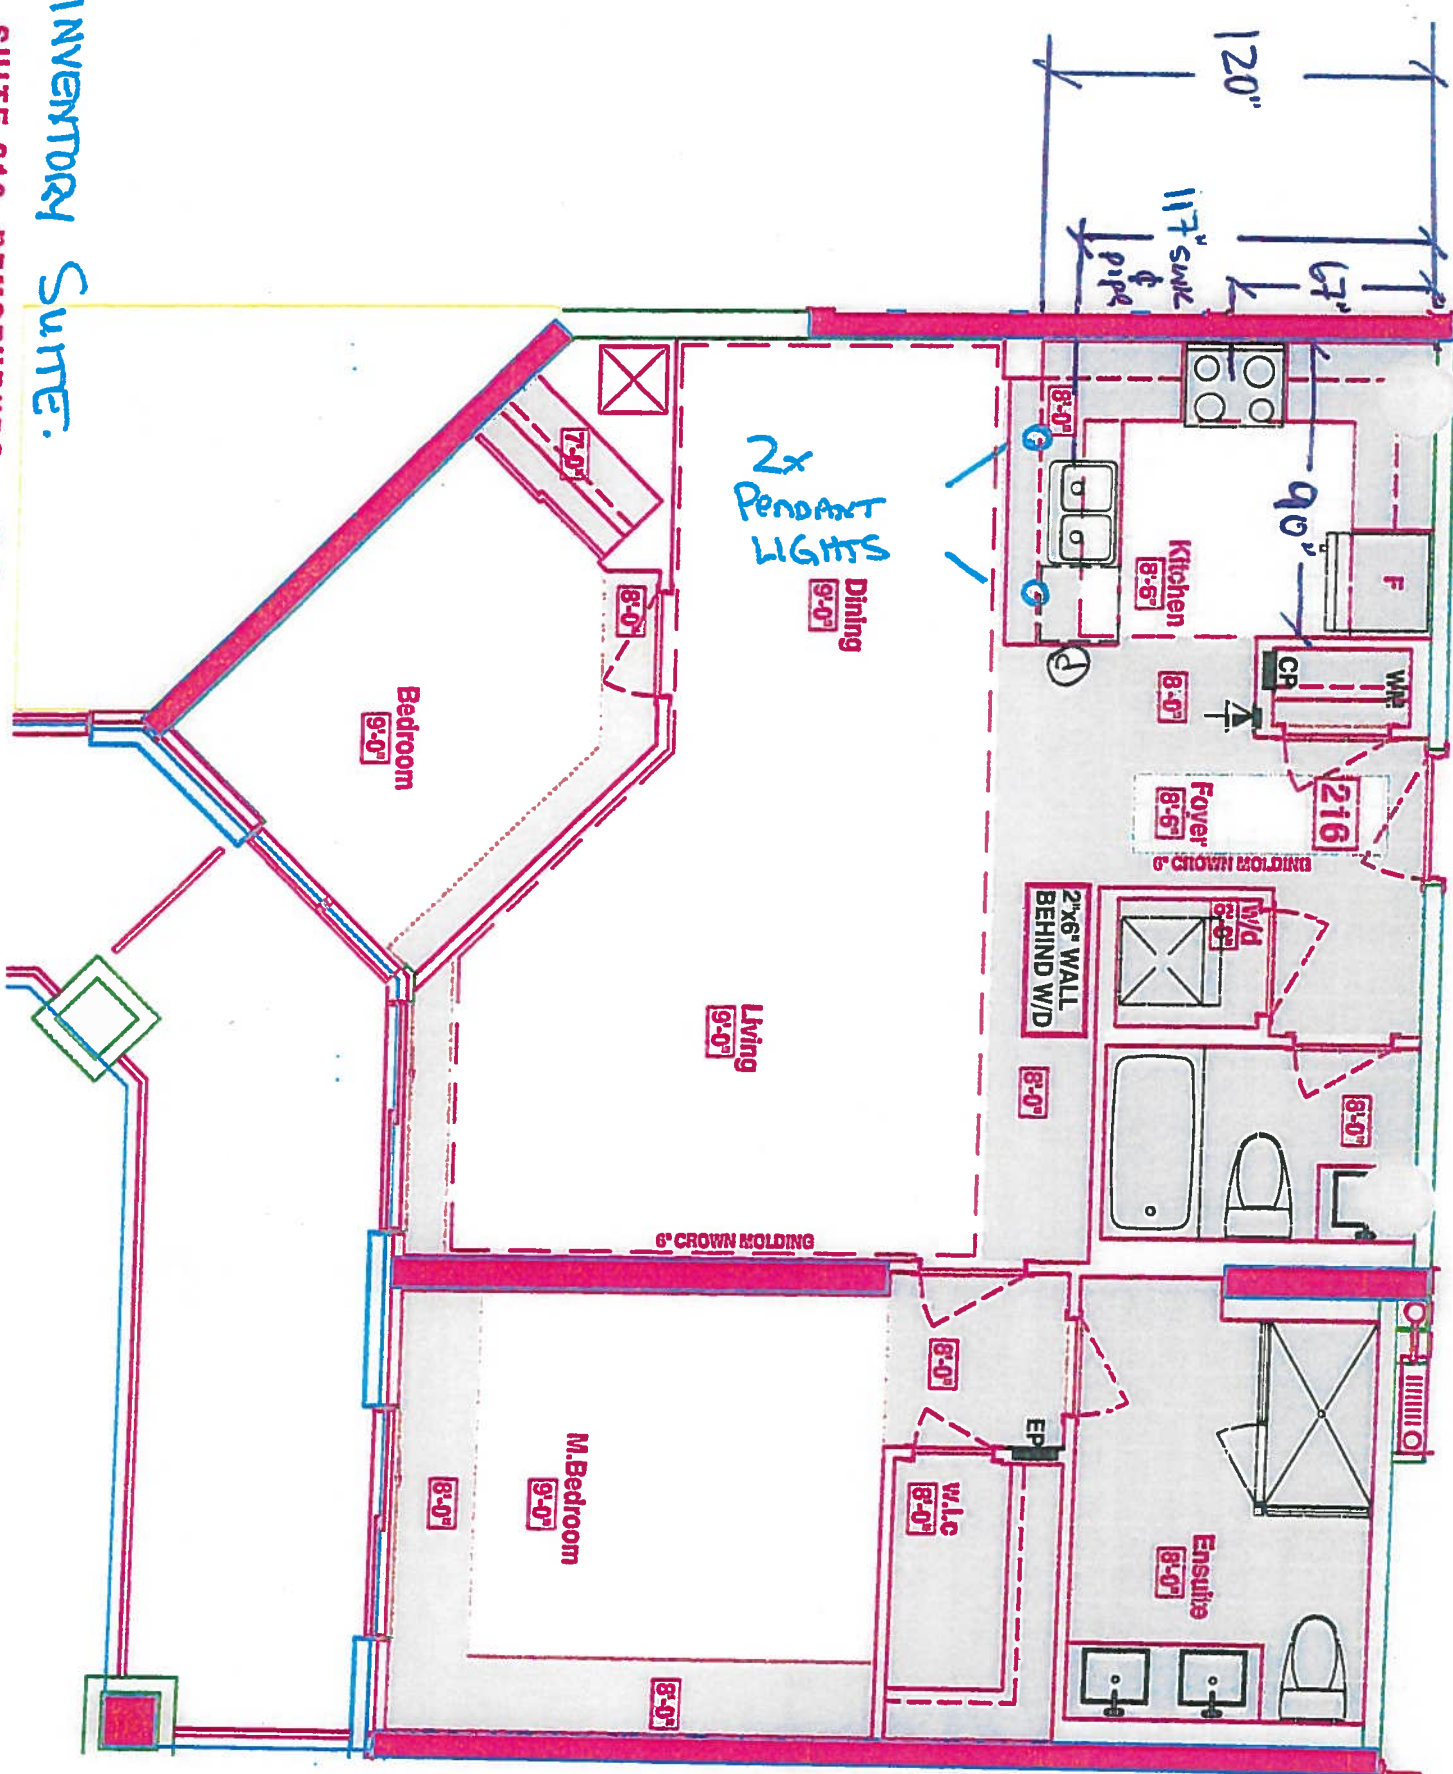


LEGEND:	
	SECURITY PANEL
	ELECTRICAL PANEL
	COMMUNICATION PANEL
	WATER METER
	FRIDGE
	DROPPED AREA
	6\"/>

- Inventory Suite
- Updated Feb 4. 19.
- SMO KITCHEN
- 1st URG. APPLIANCE
- PKG.
- (x2) CAPPED PENDANTS
- (x3) = Puck LUG HTS
- (x1) = PUG
- Peninsula
- Penaco Powder +
- EN Suite VANITIES
- 36"1/4" + 3" SPOUSAL

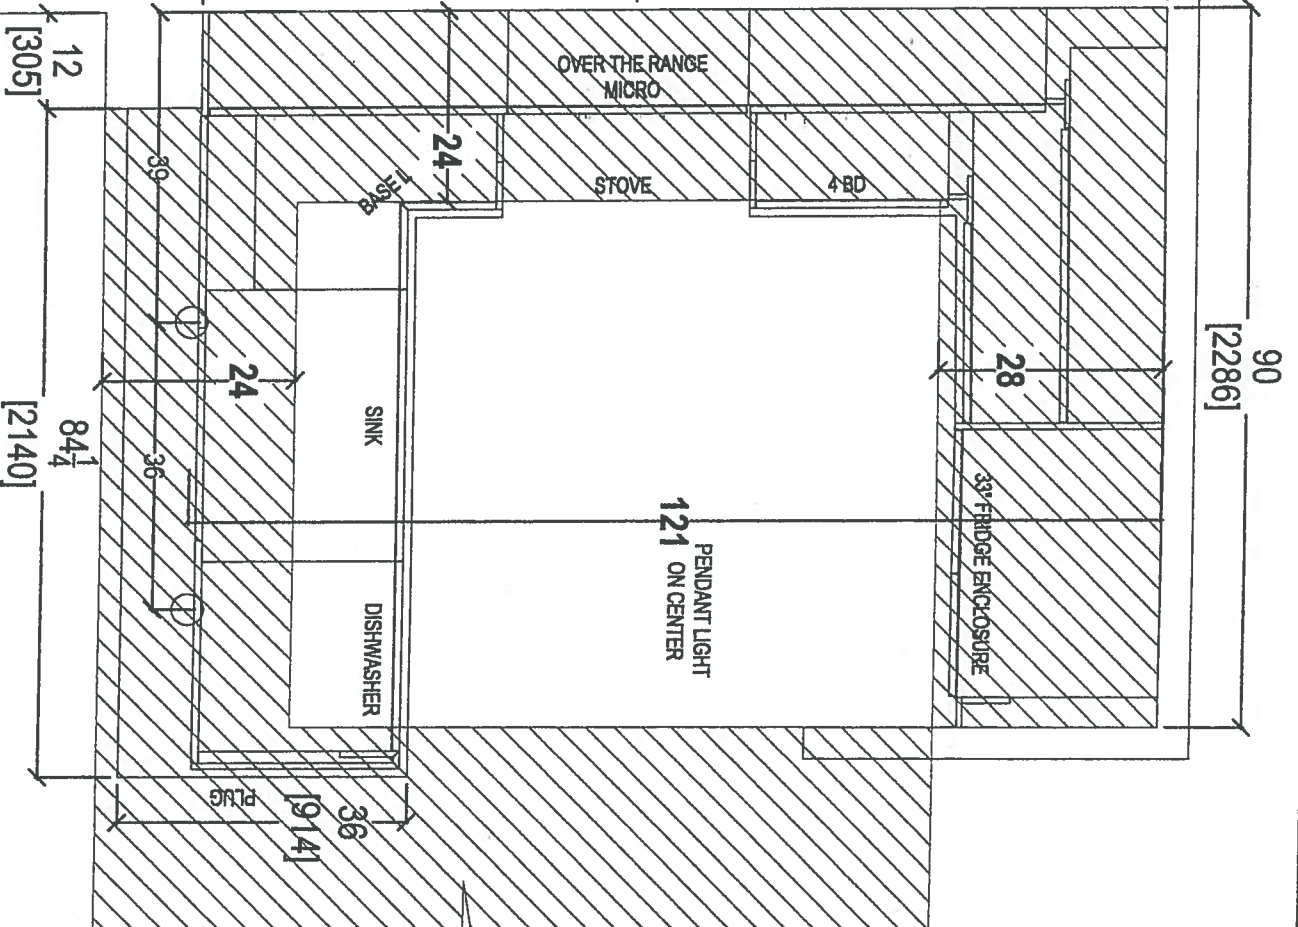

 your kitchen, your taste. 80 SANTE DRIVE, VAUGHAN, ON L4K 3C4, T: 416.746.1811 F: 905.761.5901		CLIENT: ROYAL PINE HOMES SITE: HAMPTON PLACE PHONE: — EMAIL: —		JOB NAME: UNIT 216 HMP DOOR STYLE: — FINISH: — SPECIES: —		ROOM: KITCHEN DOOR HANDLE: — DRW HANDLE: — TOP: —		DRAWN BY: SK SCALE: 1/2" = 1' - 0" DATE: FEB 4, 2019 PAGE: —		COMMENTS: PLEASE NOTE ALL DIMENSIONS ARE NOT FINAL AND ARE SUBJECT TO CHANGE UPON FINAL SITE MEASURE	
---	--	---	--	--	--	--	--	---	--	--	--

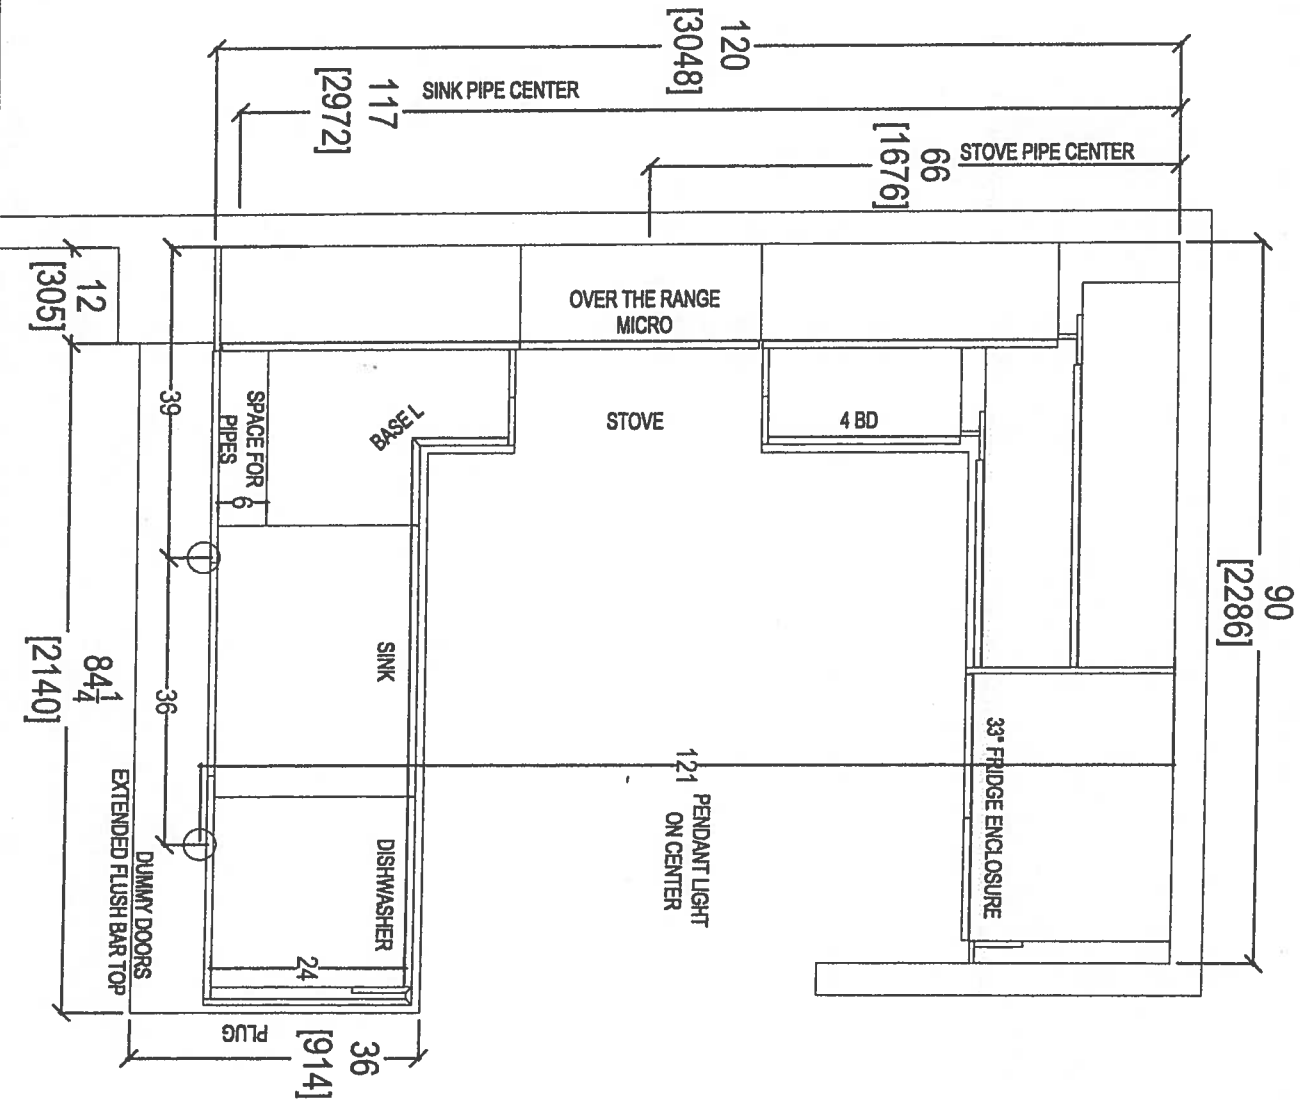

CLIENT: ROYAL PINE HOMES

JOB NAME: UNIT 218 HMP

ROOM: KITCHEN

DRAWN BY: SK

COMMENTS:

SITE: HAMPTON PLACE

DOOR STYLE: —

DOOR HANDLE: —

SCALE: 1/2" = 1' - 0"

PLEASE NOTE ALL DIMENSIONS ARE NOT FINAL AND ARE SUBJECT TO CHANGE UPON FINAL SITE MEASURE

PHONE: —

FINISH: —

DRW HANDLE: —

DATE: FEB 4, 2019

EMAIL: —



SPECIES: —

TOP: —



PAGE: —



your kitchen, your taste
80 SANTE DRIVE, VAUGHAN, ON L4K 3C4,
T: 416.746.1811 F: 905.761.5801

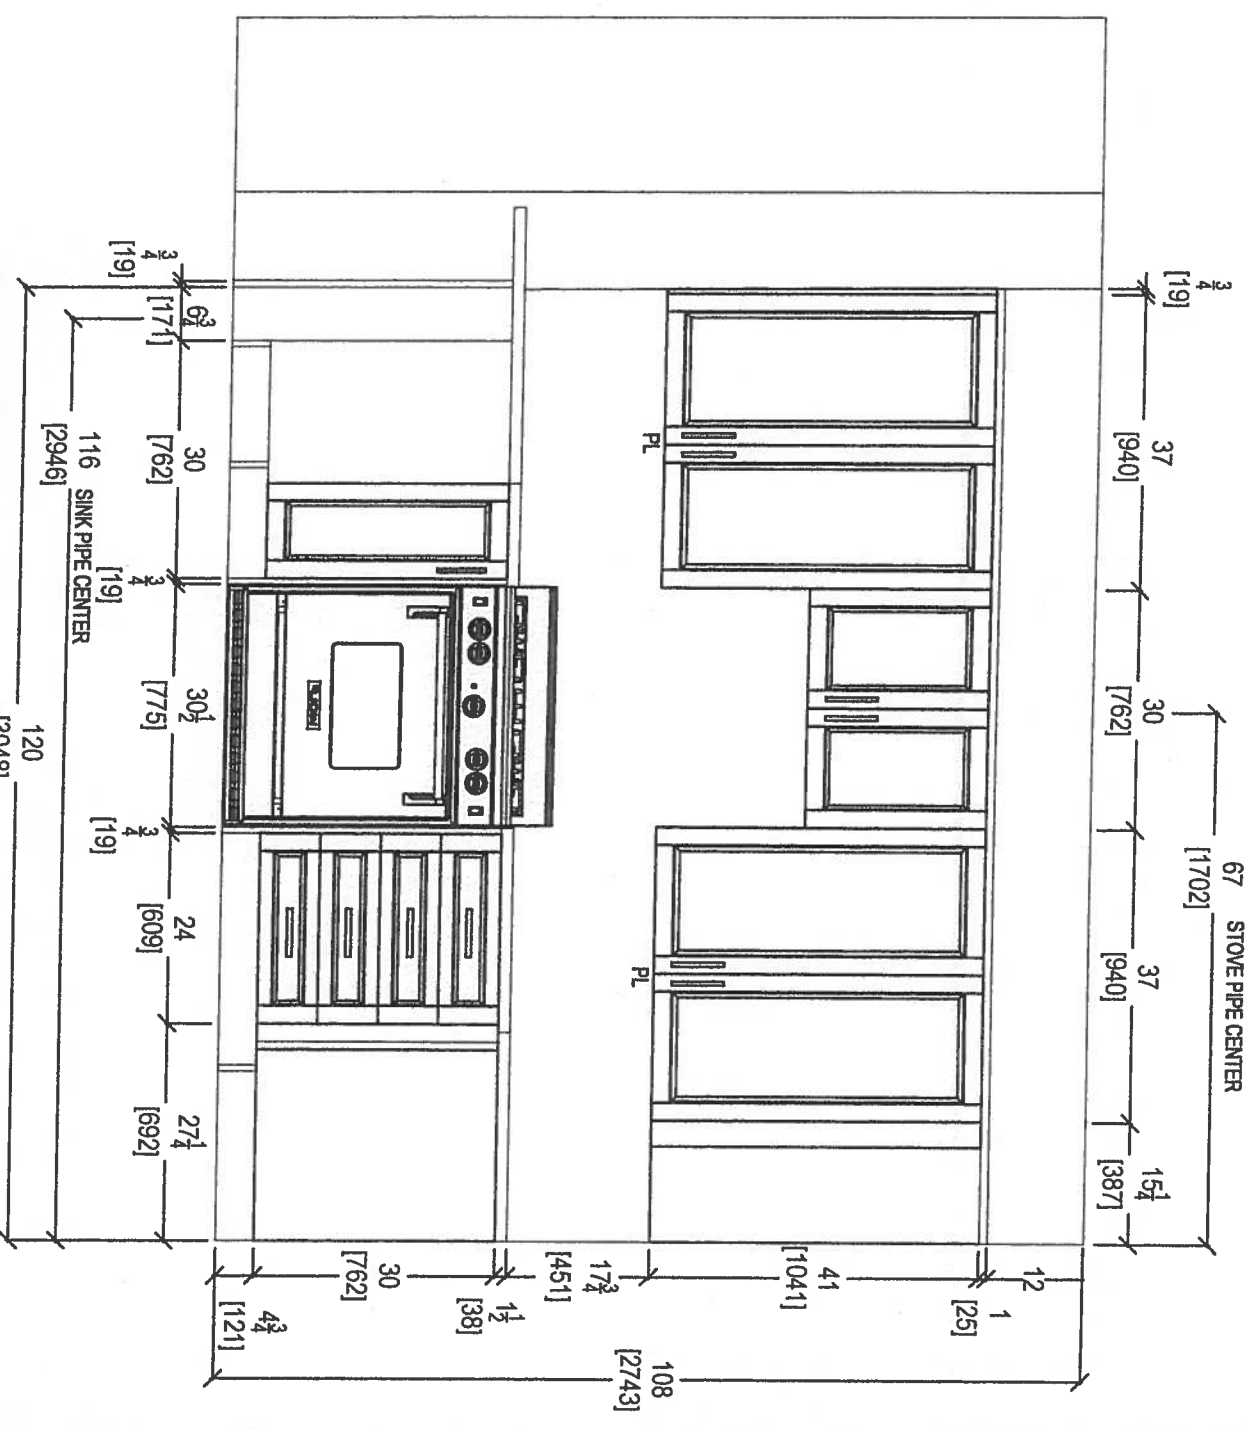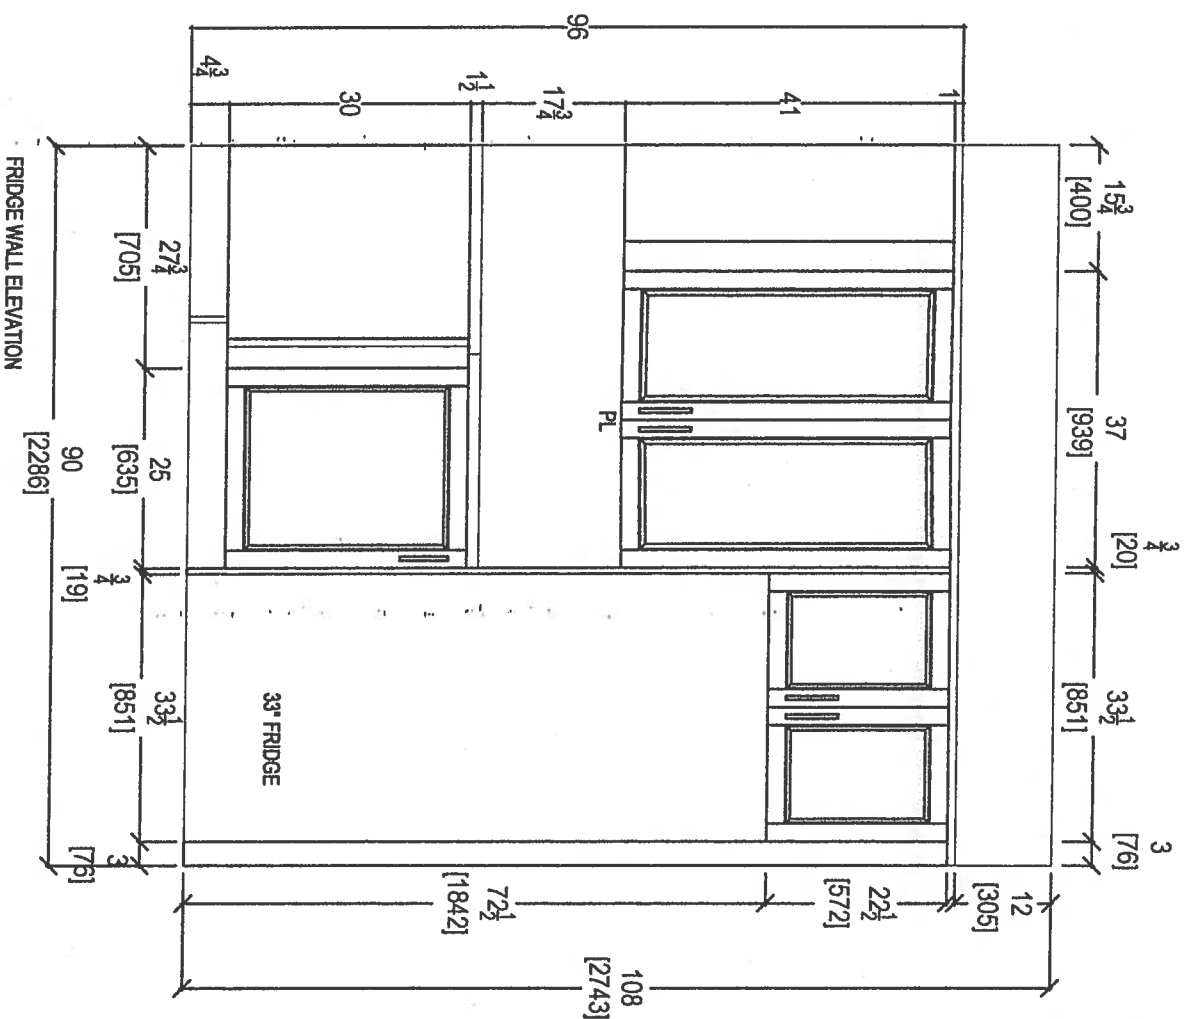


CLIENT: ROYAL PINE HOMES	JOB NAME: UNIT 216 HMP	ROOM: KITCHEN	DRAWN BY: SK	COMMENTS: PLEASE NOTE ALL DIMENSIONS ARE NOT FINAL AND ARE SUBJECT TO CHANGE UPON FINAL SITE MEASURE
SITE: HAMPTON PLACE	DOOR STYLE: ---	DOOR HANDLE: ---	SCALE: 1/2" = 1' - 0"	
PHONE: ---	FINISH: ---	DRW HANDLE: ---	DATE: FEB 4, 2018	
EMAIL: ---	SPECIES: ---	TOP: ---	PAGE: ---	

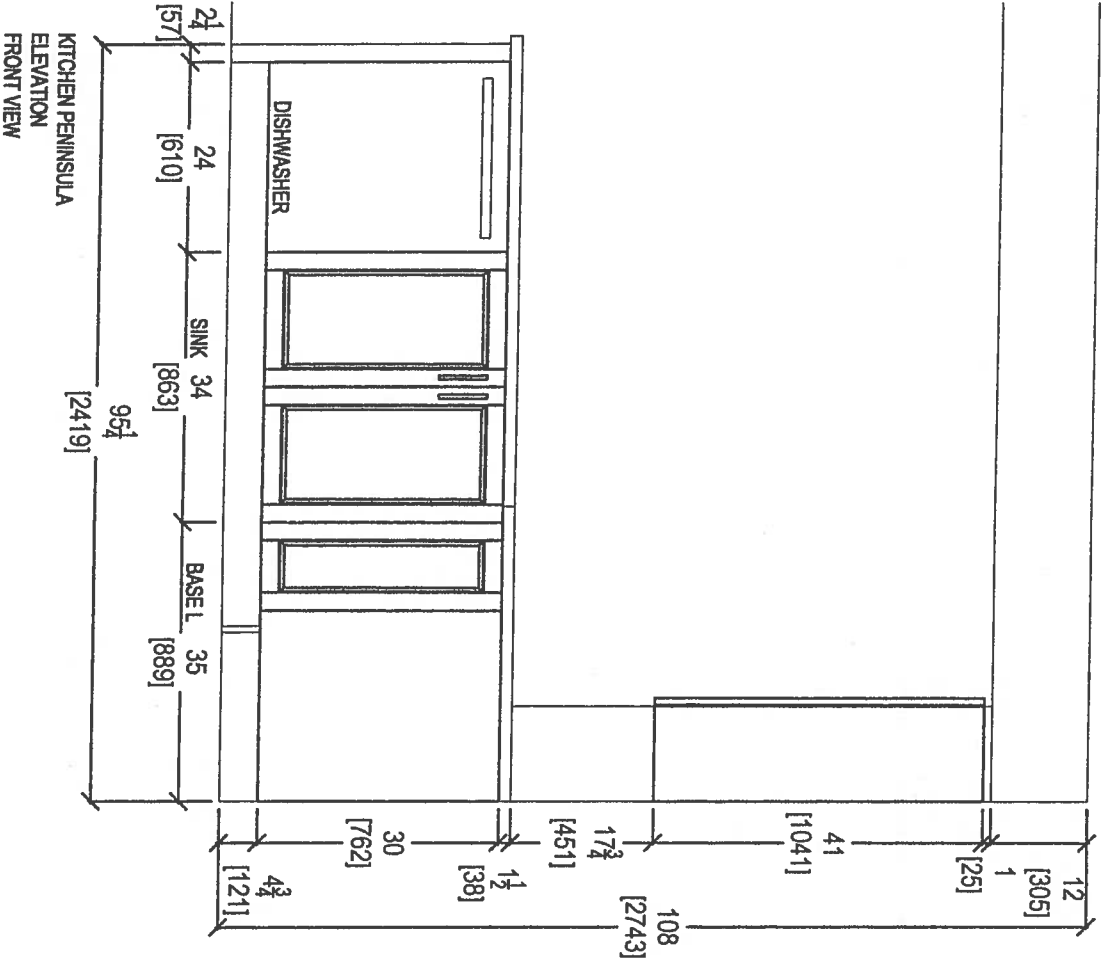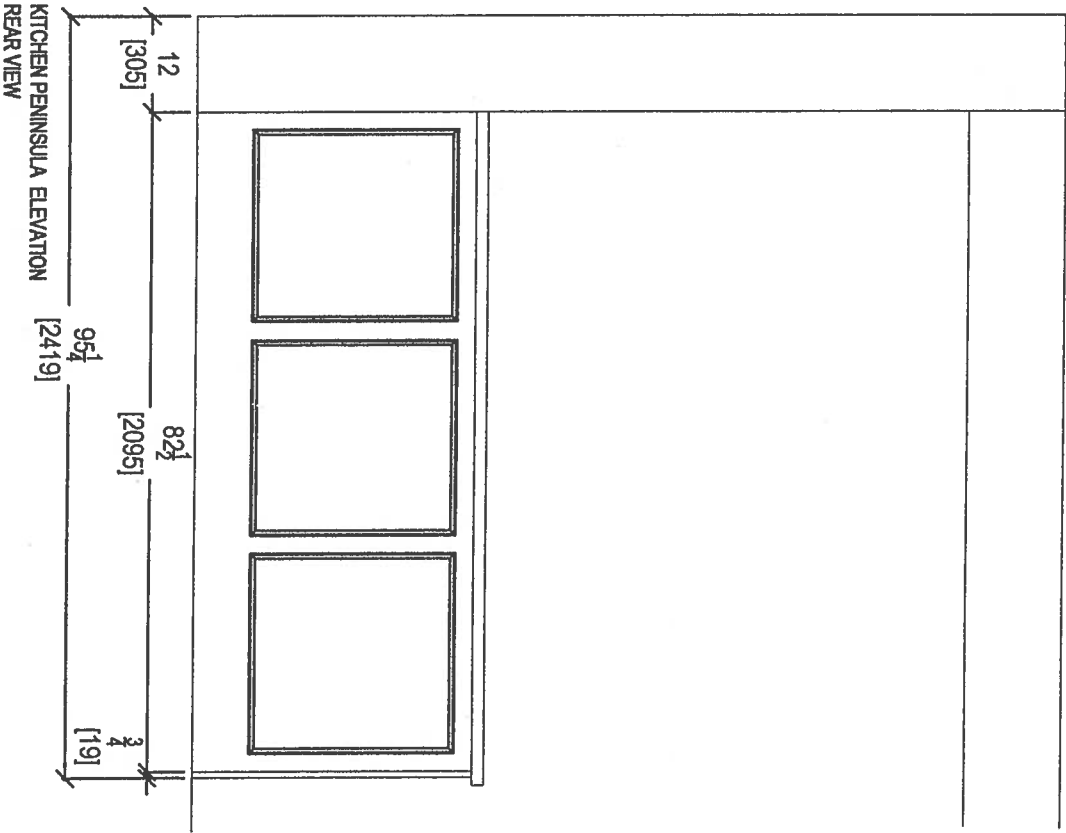


KITCHEN PENINSULA ELEVATION
REAR VIEW

KITCHEN PENINSULA
ELEVATION
FRONT VIEW



 <i>your kitchen, your taste.</i> 80 SANTE DRIVE, VAUGHAN, ON L4K 3C4, T: 416.746.1811 F: 905.761.5901		CLIENT: ROYAL PINE HOMES	JOB NAME: UNIT 216 HMP	ROOM: KITCHEN	DRAWN BY: SK	COMMENTS: PLEASE NOTE ALL DIMENSIONS ARE NOT FINAL AND ARE SUBJECT TO CHANGE UPON FINAL SITE MEASURE
SITE: HAMPTON PLACE		DOOR STYLE: —	DOOR HANDLE: —	SCALE: 1/2" = 1' - 0"		
PHONE: —		FINISH: —	DRW HANDLE: —	DATE: FEB 4, 2019		
EMAIL: —		SPECIES: —	TOP: —	PAGE: —		

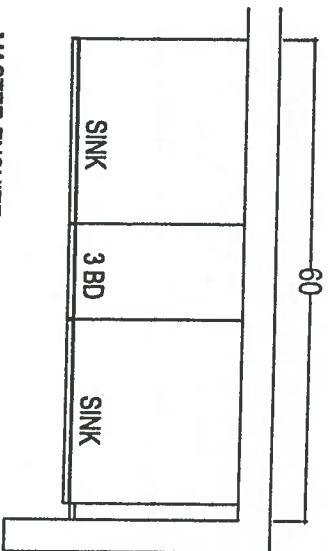

MASTER ENSUITE

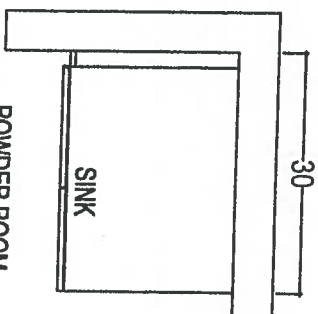

POWDER ROOM

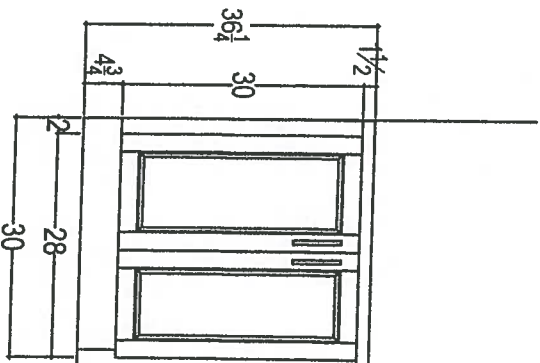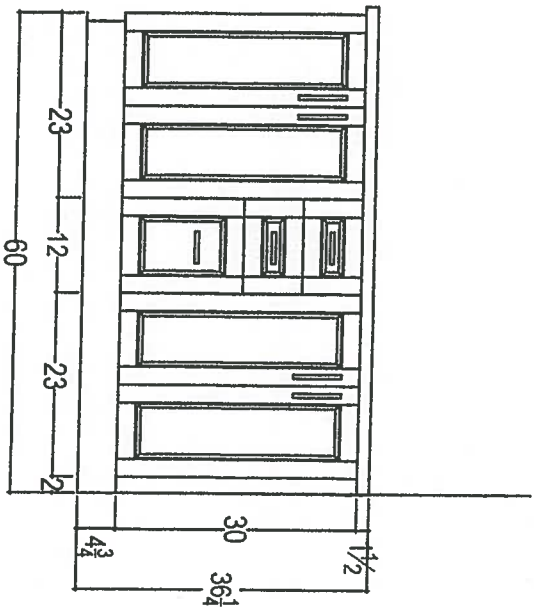

* Ranso Vanities w 3" Spacers



your kitchen, your taste.
80 SANTE DRIVE, VAUGHAN, ON L4K 3C4,
T: 416.746.1811 F: 905.761.5901

CLIENT: ROYAL PINE HOMES	JOB NAME: UNIT 216 HMP	ROOM: VANITIES	DRAWN BY: SK	COMMENTS:
SITE: HAMPTON PLACE	DOOR STYLE: —	DOOR HANDLE: —	SCALE: 1/2" = 1' - 0"	PLEASE NOTE ALL DIMENSIONS ARE NOT FINAL AND ARE SUBJECT TO CHANGE UPON FINAL SITE MEASURE
PHONE: —	FINISH: —	DRW HANDLE: —	DATE: FEB 4, 2019	
EMAIL: —	SPECIES: —	TOP: —	PAGE: —	