






Inventory Suite.

Suite 217 - ORIGINAL



Sag Harbor

878 SQ FT plus 119 sq. ft. of balcony area

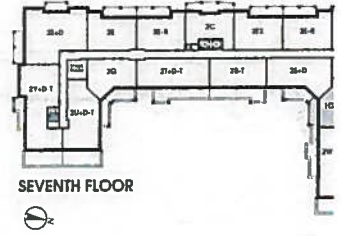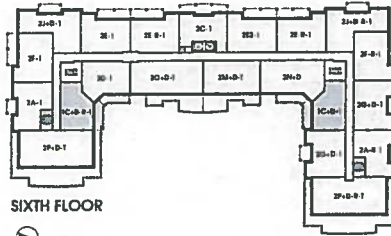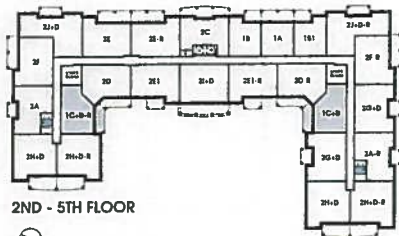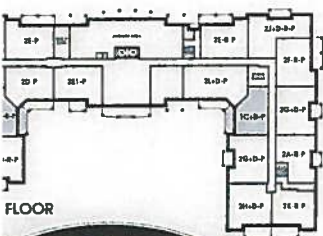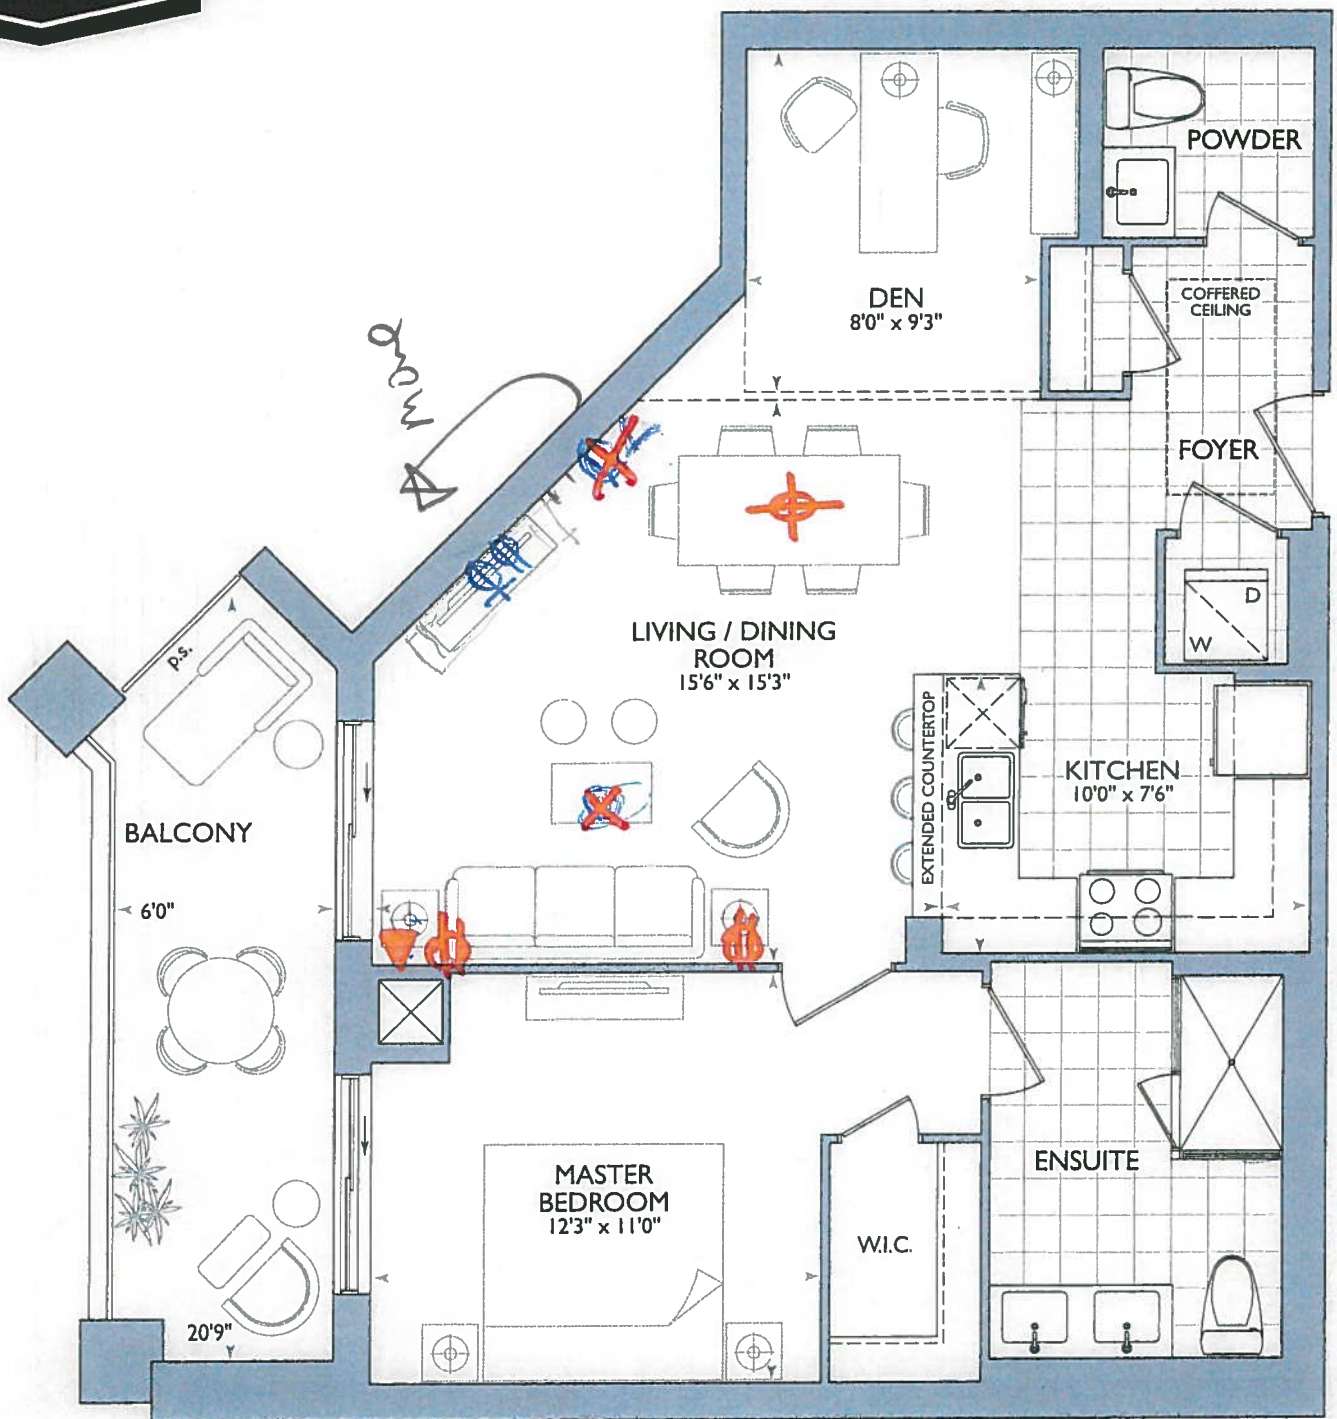

* Front Door move *
 Due to Laundry Room
 @ Kitchen size.


Kitchen

- (P) = Plug Peninsula
- (2x) = Pendant Lights over Peninsula
- STD Kitchen Layout
- 1st Urgence Appliance Pkgs
- (x3) Puck Lights

- 66" stove pipe central (std)
- 117" sink pipe central (std)

Inventory Suite

SUITE 217 - SAG HAT
 HAMPTON PLACE 25 Baker Hill Bk
 JMW, ON Jan 23, 2018

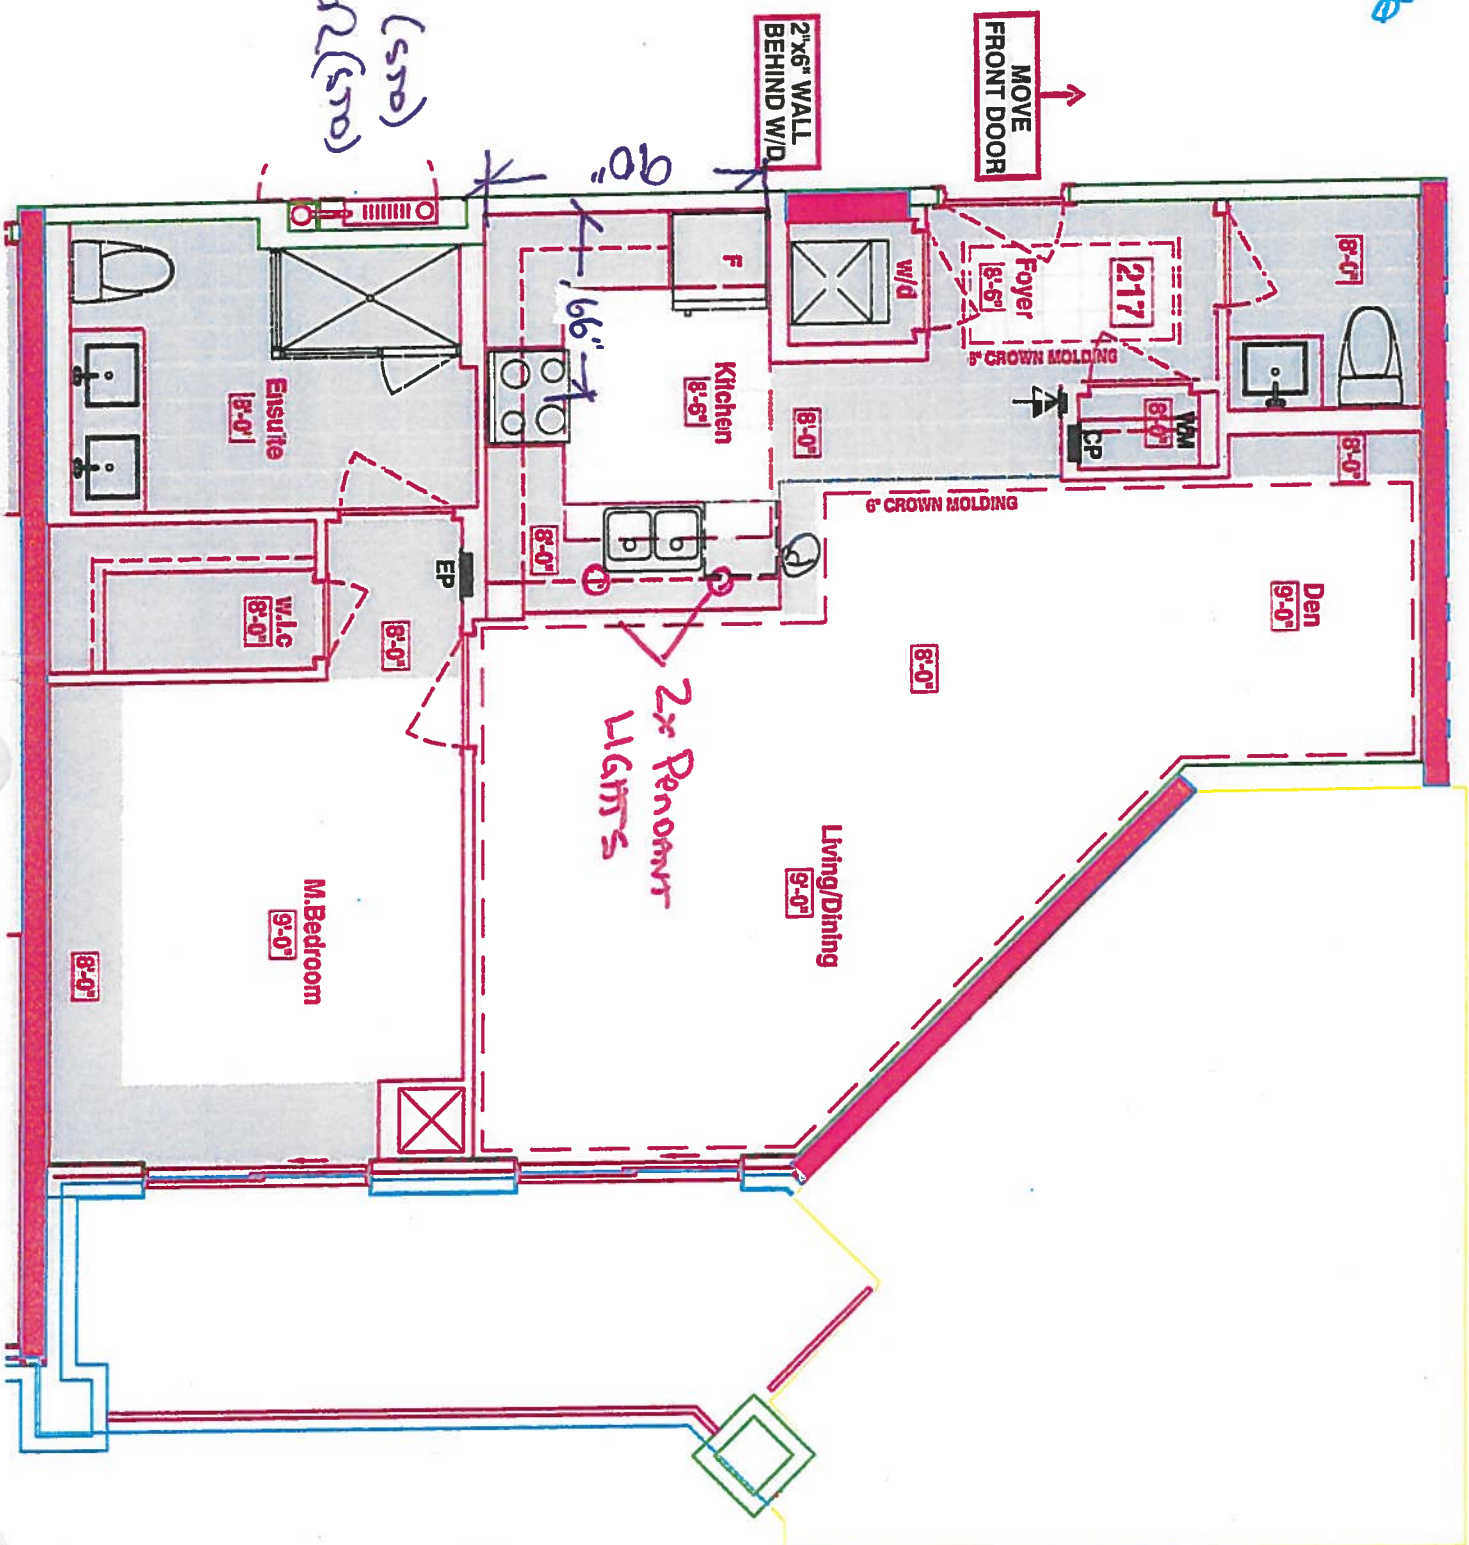


LEGEND:

- ↓ SECURITY PANEL
- EP ELECTRICAL PANEL
- CP COMMUNICATION PANEL
- WM WATER METER
- F FRIDGE
- DROPPED AREA
- - - 6" CROWN MOLDING

6" WALL BEHIND W/D
 ELIMINATE JOG AT FRIDGE WALL


Inventory Suite
Feb 4 2018.

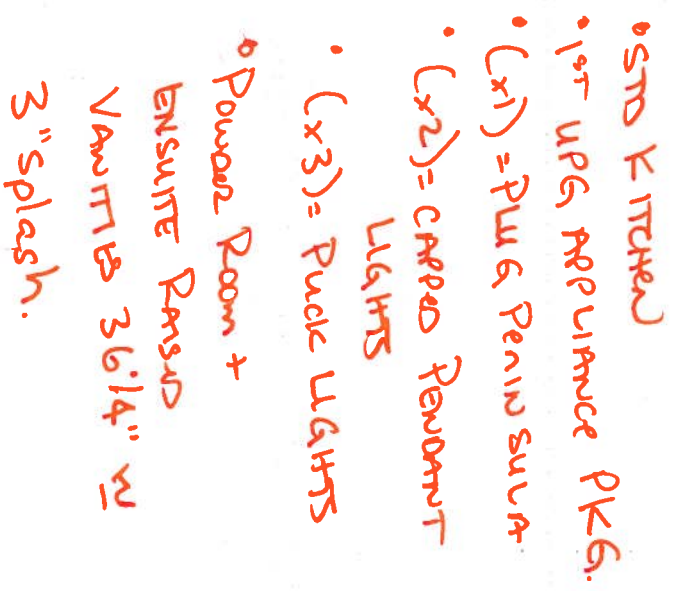

your kitchen your taste.

80 SANTE DRIVE, VAUGHAN, ON

your kitchen, your taste.
80 SANTE DRIVE, VAUGHAN, ON L4K 3C4,
T: 416.746.1811 F: 905.761.5901

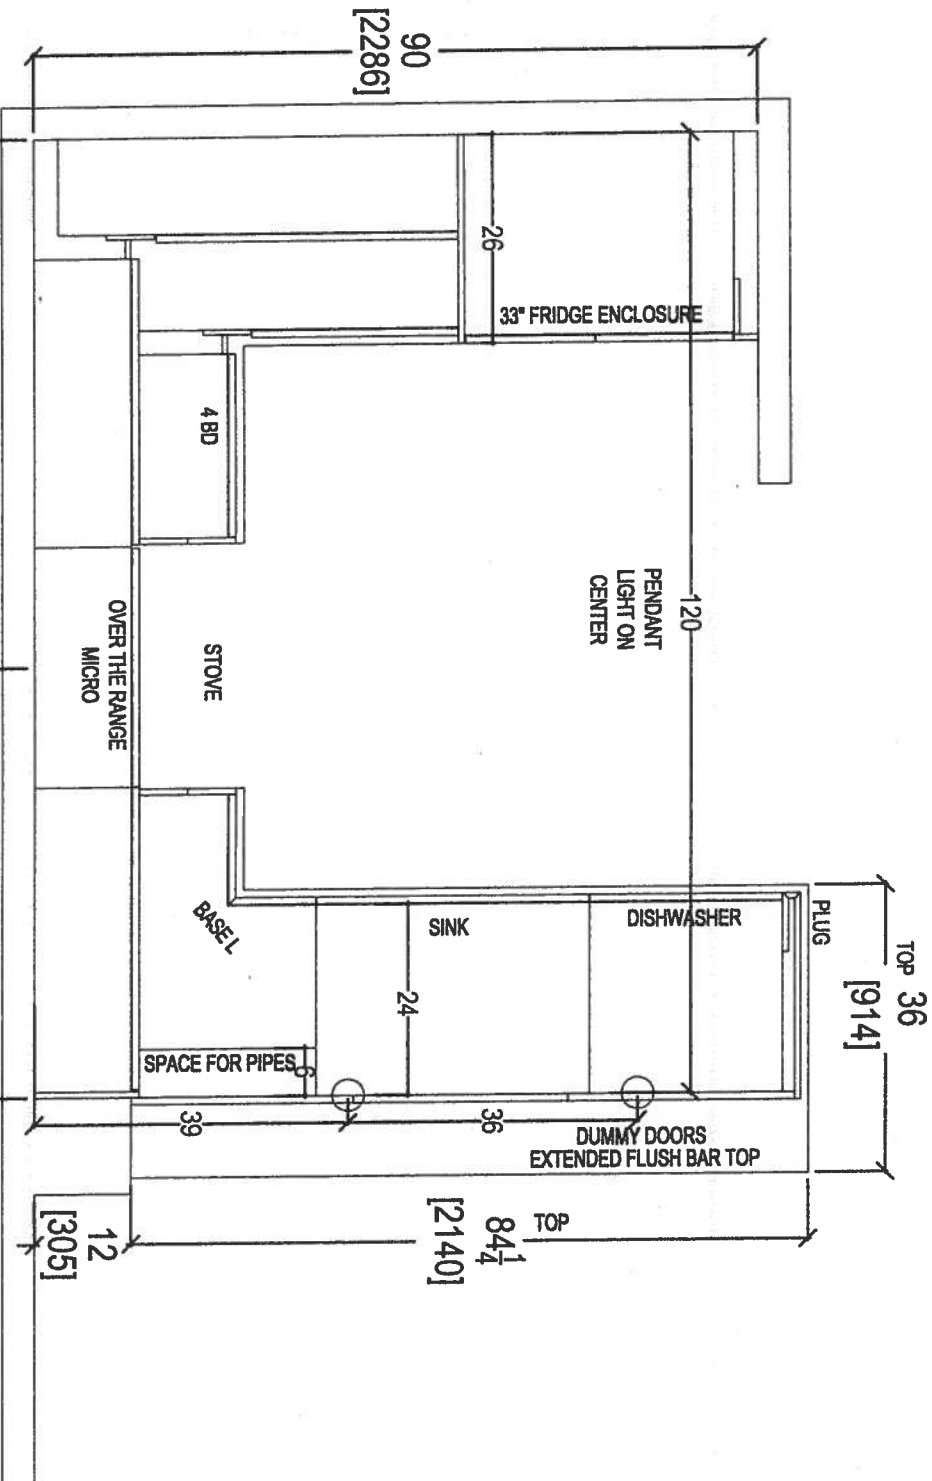


CLIENT: ROYAL PINE HOMES	JOB NAME: UNIT 217 HMP	ROOM: KITCHEN	DRAWN BY: SK
SITE: HAMPTON PLACE	DOOR STYLE: —	DOOR HANDLE: —	SCALE: 1/2" = 1'-0"
PHONE: —	FINISH: —	DRW HANDLE: —	DATE: FEB 4, 2019
EMAIL: —	SPECIES: —	TOP: —	PAGE: —

COMMENTS:
PLEASE NOTE ALL DIMENSIONS
ARE NOT FINAL AND ARE
SUBJECT TO CHANGE UPON
FINAL SITE MEASURE



80 SANTE DRIVE, VAUGHAN, ON L4K 3C4,
T: 416.746.1811 F: 905.761.5901

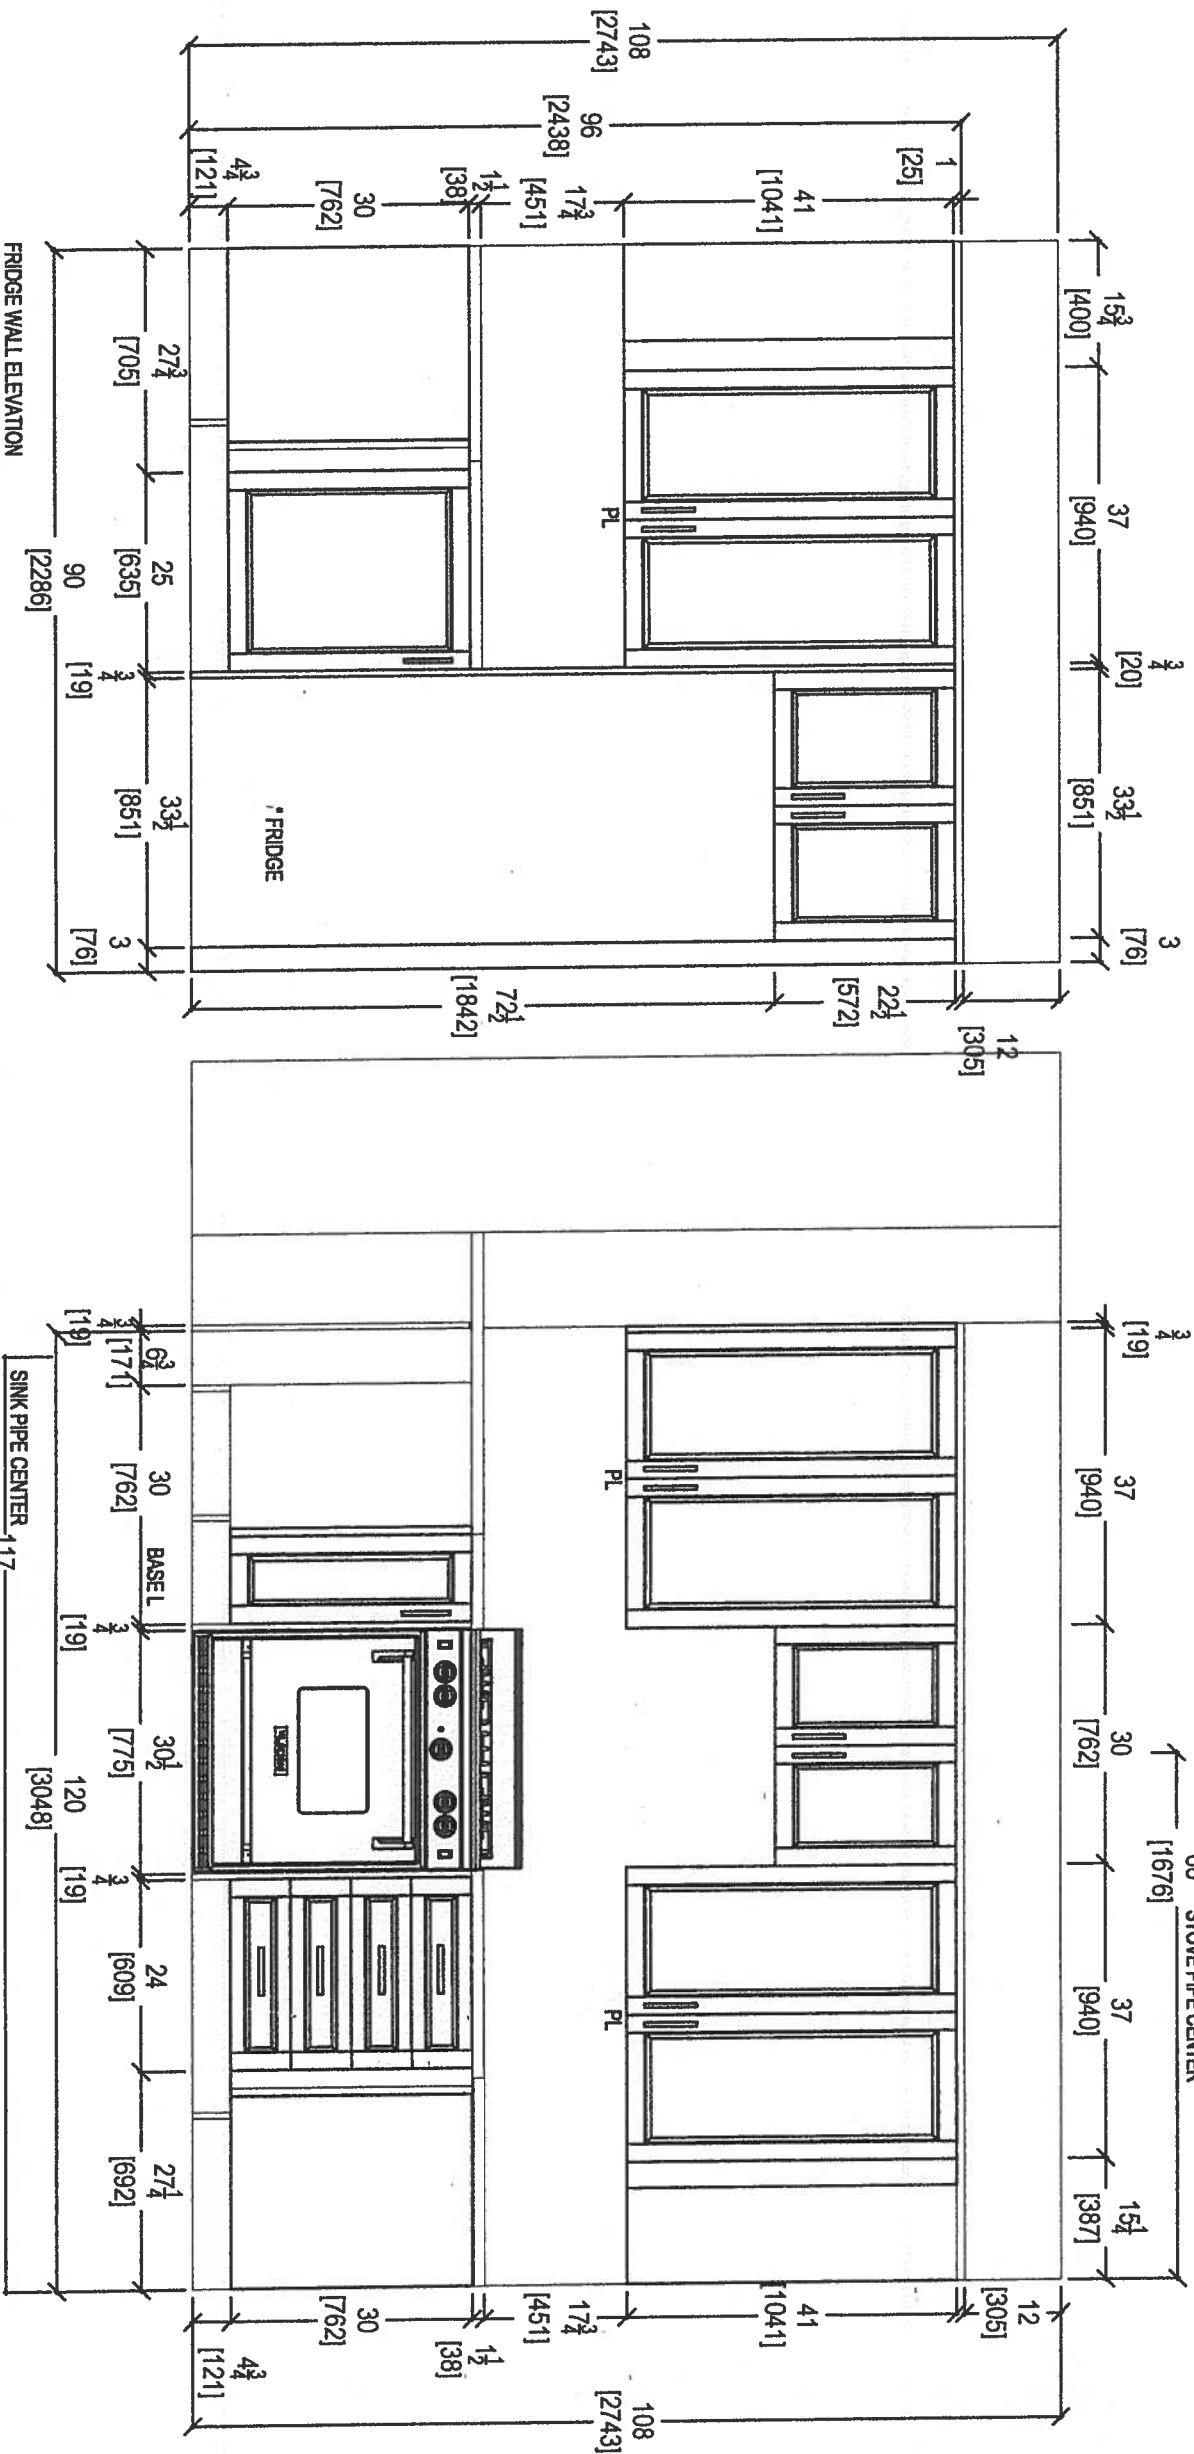

CLIENT: ROYAL PINE HOMES

JOB NAME: UNIT 217 HMP

ROOM: KITCHEN

DRAWN BY: SK

COMMENTS:

SITE: HAMPTON PLACE

DOOR STYLE: —

DOOR HANDLE: —

SCALE: 1/2" = 1'-0"

PLEASE NOTE ALL DIMENSIONS ARE NOT FINAL AND ARE SUBJECT TO CHANGE UPON FINAL SITE MEASURE

PHONE: —

FINISH: —

DRW HANDLE: —

DATE: FEB 4, 2019

DATE: FEB 4, 2019

EMAIL: —

SPECIES: —


TOP: —

PAGE: —

PAGE: —



your kitchen, your taste.
80 SANTE DRIVE, VAUGHAN, ON L4K 3C4,
T: 416.746.1811 F: 905.781.5801

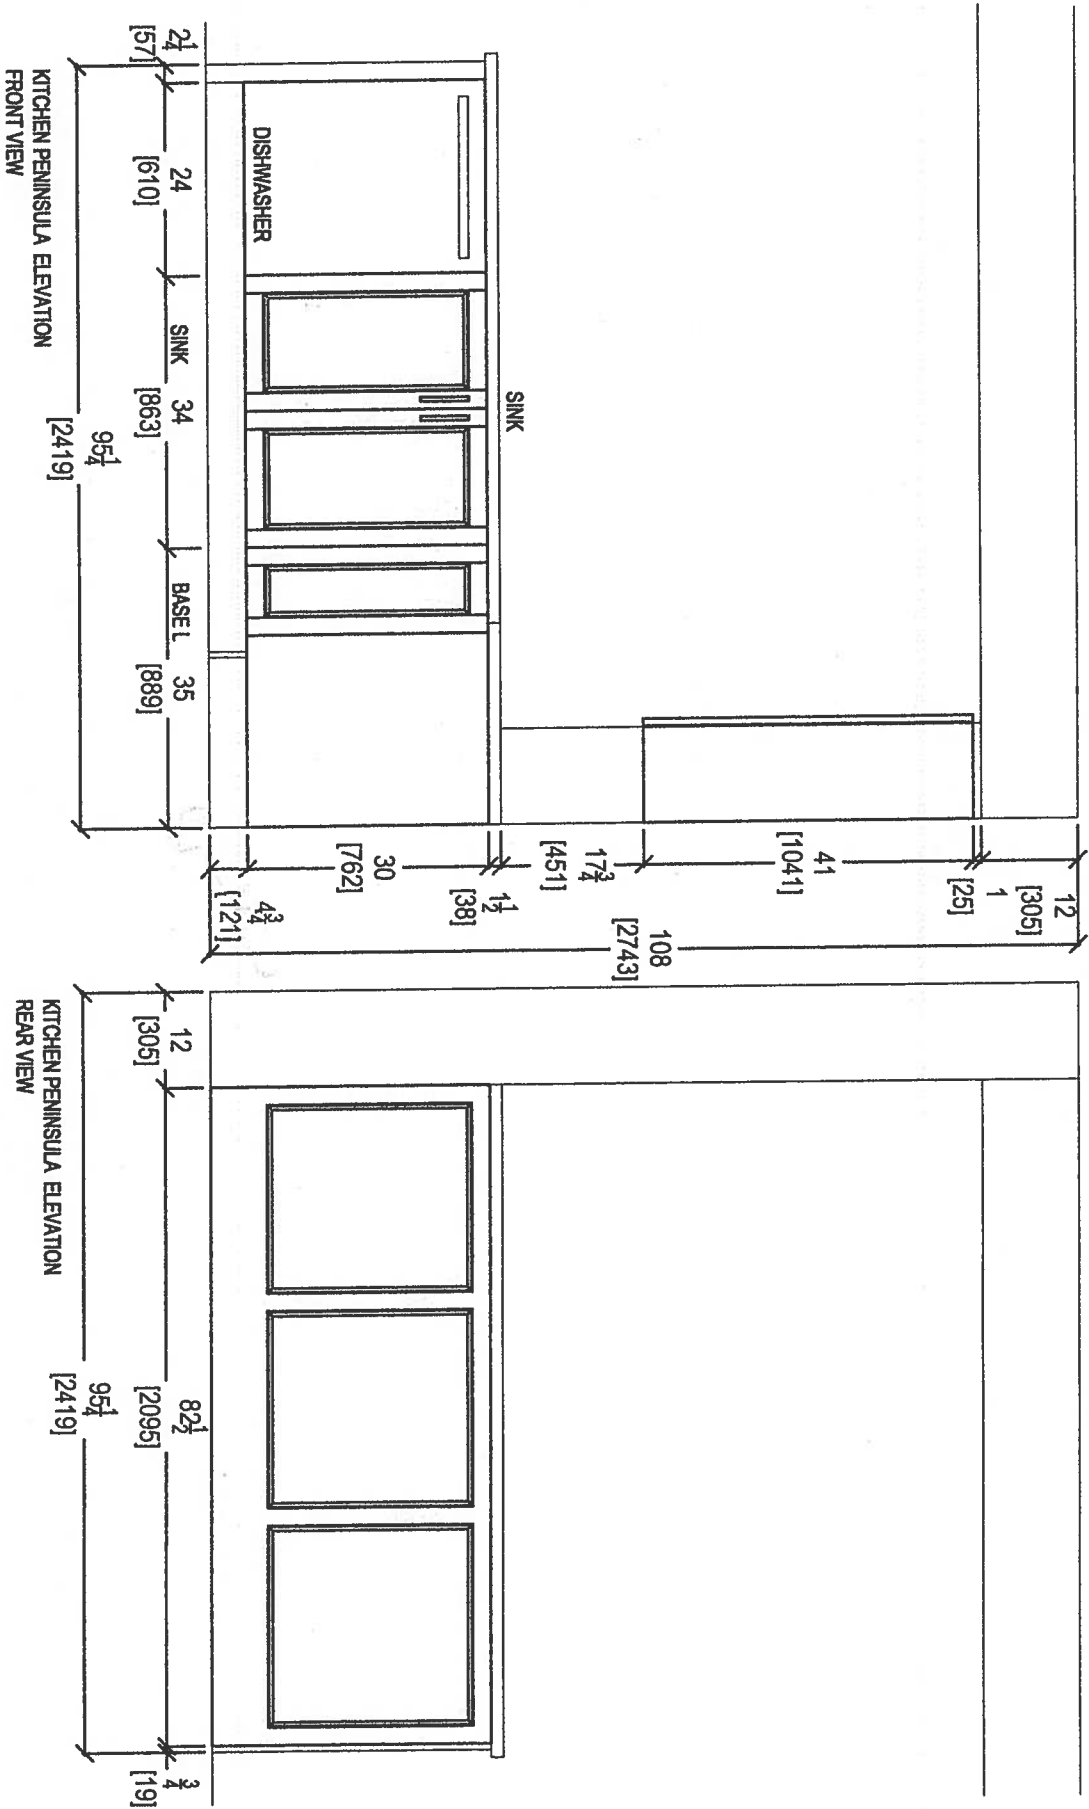


CLIENT: ROYAL PINE HOMES	JOB NAME: UNIT 217 HMP	ROOM: KITCHEN	DRAWN BY: SK
SITE: HAMPTON PLACE	DOOR STYLE: --	DOOR HANDLE: --	SCALE: 1/2" = 1'-0"
PHONE: --	FINISH: --	DRW HANDLE: --	DATE: FEB 4, 2019
EMAIL: --	SPECIES: --	TOP: --	PAGE: --


COMMENTS:
PLEASE NOTE ALL DIMENSIONS
ARE NOT FINAL AND ARE
SUBJECT TO CHANGE UPON
FINAL SITE MEASURE




your kitchen, your taste.
80 SANTE DRIVE, VAUGHAN, ON L4K 3C4,
T: 416.746.1811 F: 905.761.5601

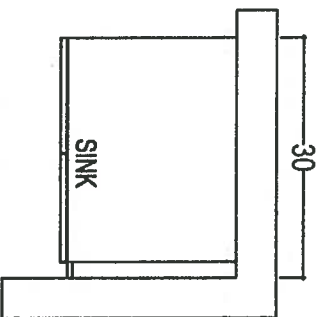

POWDER ROOM

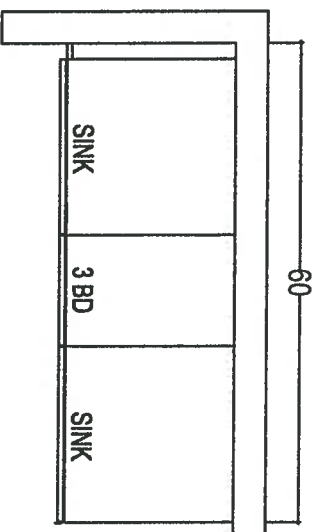

MASTER ENSUITE

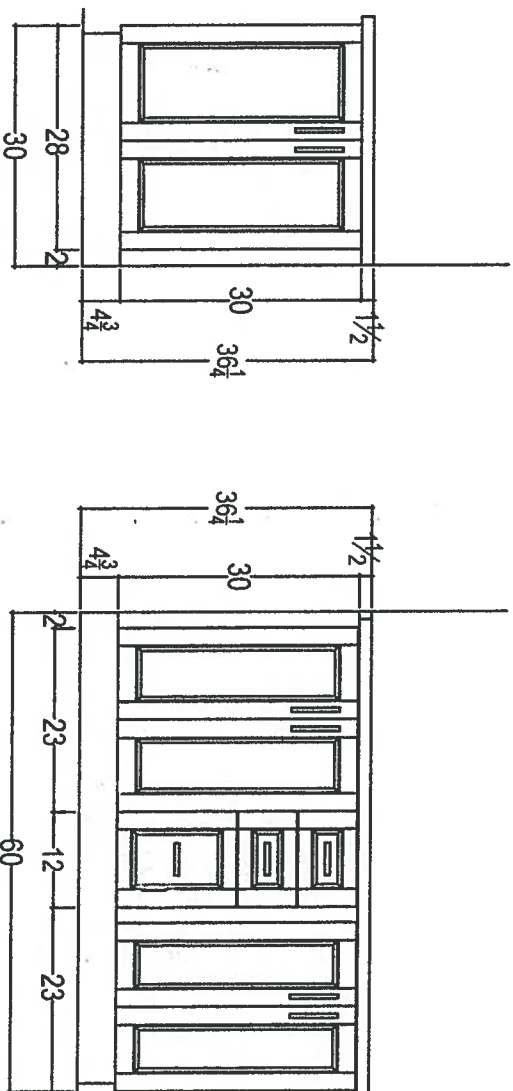

Panso Y minutes. 36 1/4 + 3" S PUSH



your kitchen, your taste.
80 SANTE DRIVE, VAUGHAN, ON L4K 3C4,
T: 416.746.1811 F: 905.761.5801

CLIENT: ROYAL PINE HOMES	JOB NAME: UNIT 217 HMP	ROOM: VANITIES	DRAWN BY: SK
SITE: HAMPTON PLACE	DOOR STYLE: —	DOOR HANDLE: —	SCALE: 1/2" = 1' - 0"
PHONE: —	FINISH: —	DRW HANDLE: —	DATE: FEB 4, 2019
EMAIL: —	SPECIES: —	TOP: —	PAGE: —

COMMENTS:
PLEASE NOTE ALL DIMENSIONS
ARE NOT FINAL AND ARE
SUBJECT TO CHANGE UPON
FINAL SITE MEASURE