






Noyac Bay

1,121 SQ FT *plus* 76sq. ft. of balcony area

SUITE 407
ORIGINAL LAYOUT
INVENTORY SUITE

(NEW).

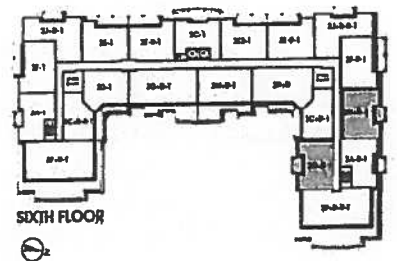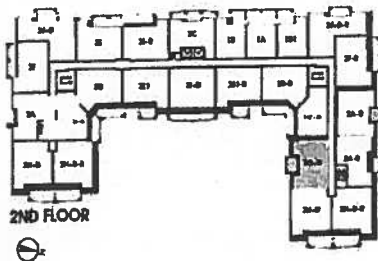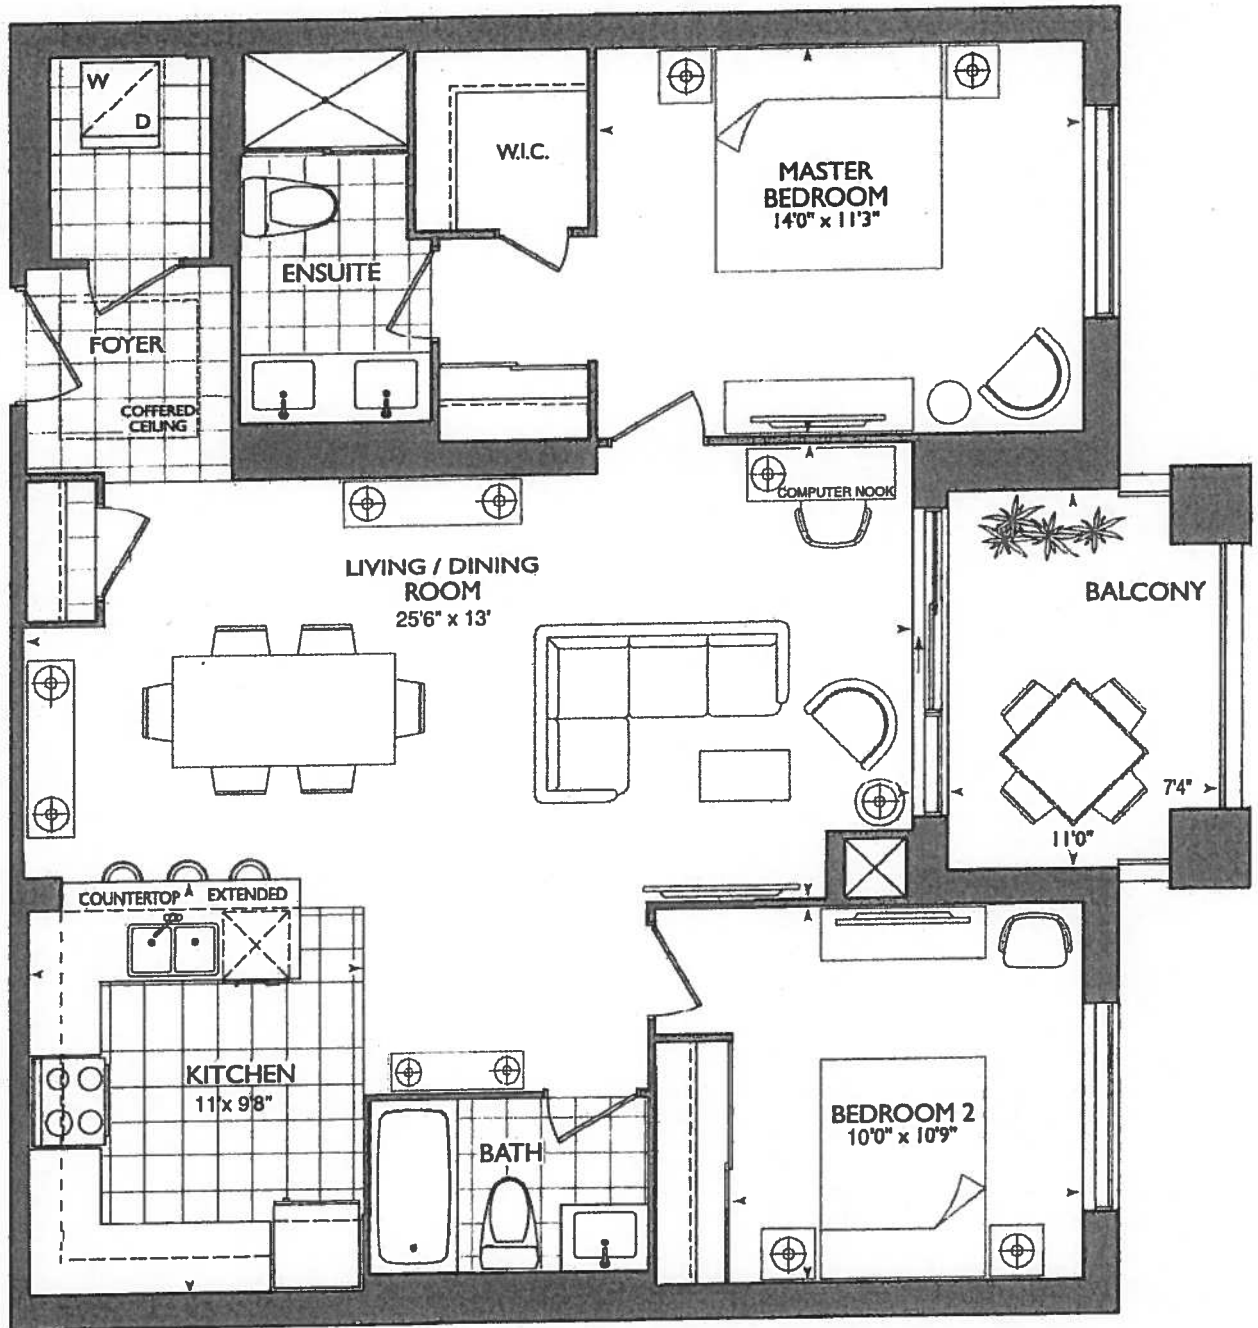


Plans and specifications are subject to change without notice. Actual usable floor space may vary from the stated floor area. All renderings are artist's concept. E. & O. E.

Suite Hampton

Living Room

→ CONDUIT =

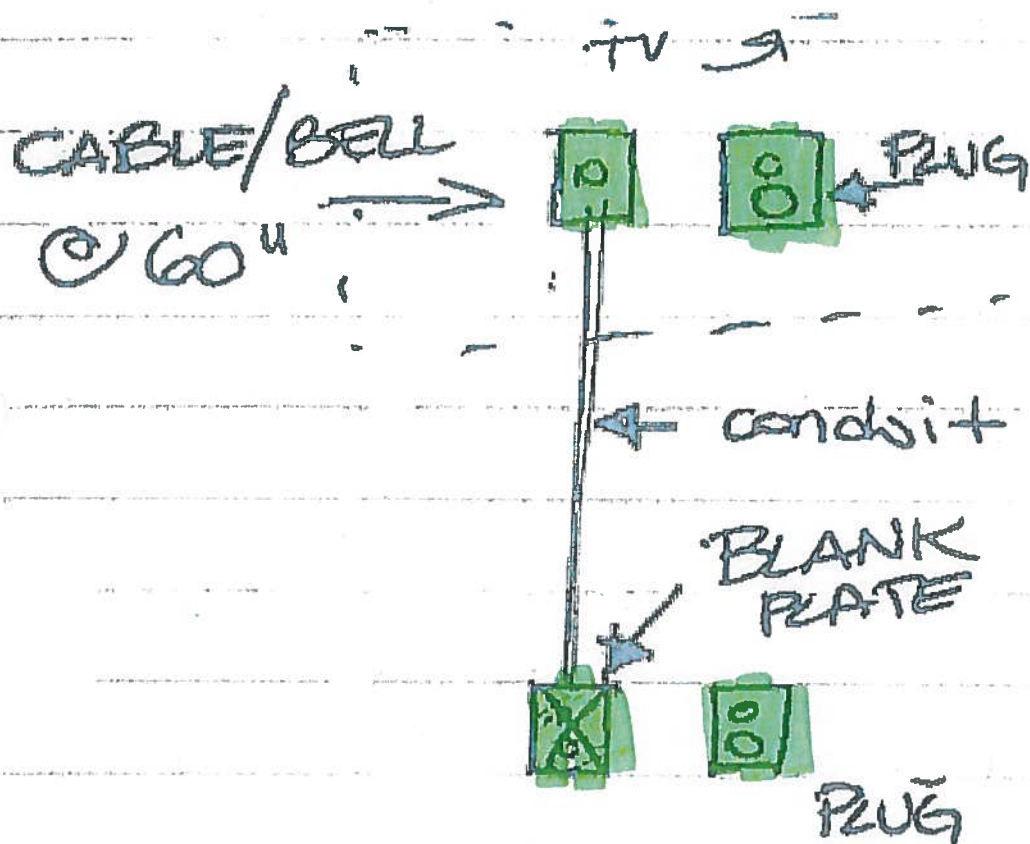

* KITCHEN *

65"0 KITCHEN LAYOUT
 015-2UR6 APPLIANCE PKG
 w/ 36" REFRIG ⊕
 CHIMNEY HOOD FAN ⊕
 MISC DRAWER


-(x2) CAPPED PENDANT
 -(x1) PLUG PENINSULA
 (x5) PUCK LIGHTS

• 65" STOVE PRE CENTER
 • 129" SINK PRE CENTER

* Revised Powder Room
 + Ensuite Vanity
 36 1/4" w/ 3" SPLASH

* LIVING Room
 Console / PUG / BLOCKING
 WALL MOUNTED
 T.V.

6" WALL
 BEHIND W/D

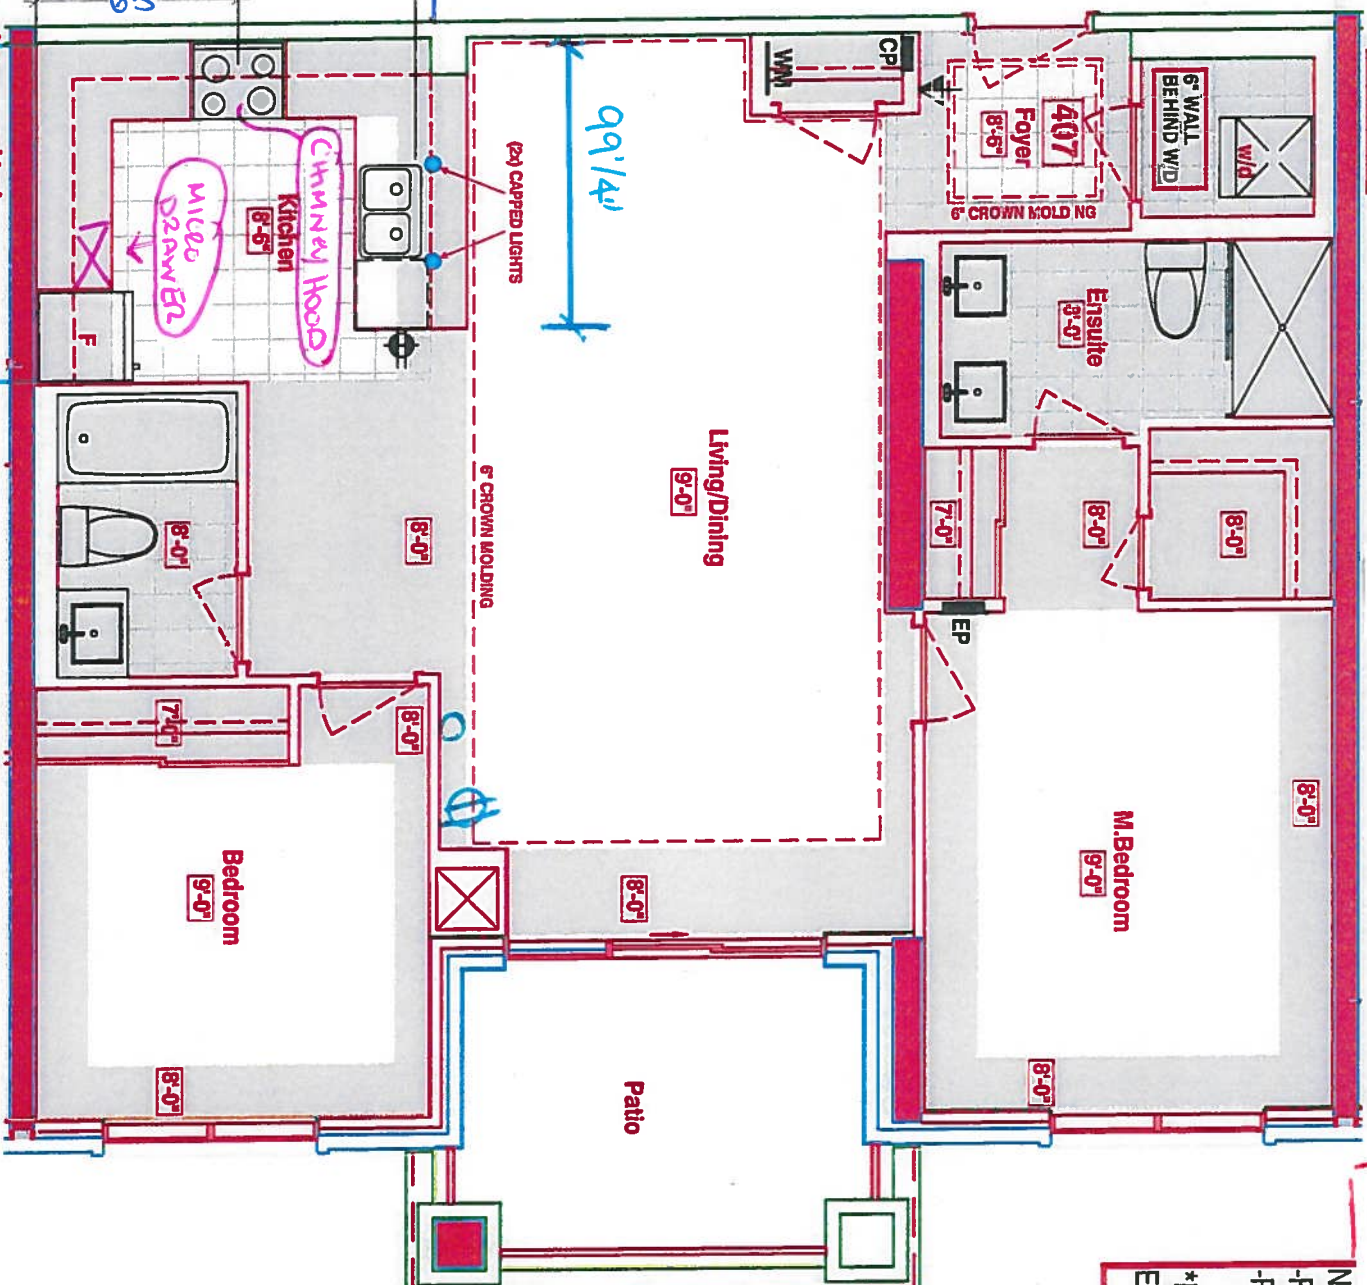

Suite 407
 * (INVENTORY SUITE)

NEW PLAN
 -REMOVED DEN
 -REVISED KITCHEN
 *REVISED LAUNDRY DOOR SWING &
 ENSUITE WALL AS PER THIS BROCHURE

FEB 4.19

LEGEND:

	SECURITY PANEL
	EP ELECTRICAL PANEL
	CP COMMUNICATION PANEL
	WM WATER METER
	F FRIDGE
	DROPPED AREA
	6" CROWN MOLDING

SUITES 407 - NOYAC BAY (Inventory suite)

Royal Pine Homes 25 Baker Hill Blvd - Scarsdale, ON Apr 04, 2018

Inventory Suite
Feb 4-19

- [illegible]



 <i>your kitchen, your taste.</i> 80 SANTE DRIVE, VAUGHAN, ON L4K 3C4, T: 416.746.1811 F: 905.781.5901				CLIENT: ROYAL PINE HOMES		JOB NAME: UNIT 407 HMP		ROOM: KITCHEN		DRAWN BY: SK		COMMENTS: PLEASE NOTE ALL DIMENSIONS ARE NOT FINAL AND ARE SUBJECT TO CHANGE UPON FINAL SITE MEASURE
SITE: HAMPTON PLACE		DOOR STYLE: —		DOOR HANDLE: —		SCALE: 1/2" = 1'-0"						
PHONE: —		FINISH: —		DRW HANDLE: —		DATE: FEB 4, 2019						
EMAIL: —		SPECIES: —		TOP: —		PAGE: —						



your kitchen, your taste.


80 SANTE DRIVE, VAUGHAN, ON L4N 4C1

your kitchen. your taste.
80 SANTE DRIVE, VAUGHAN, ON L4K 3C4,
T: 416.748.1811 F: 905.781.5901

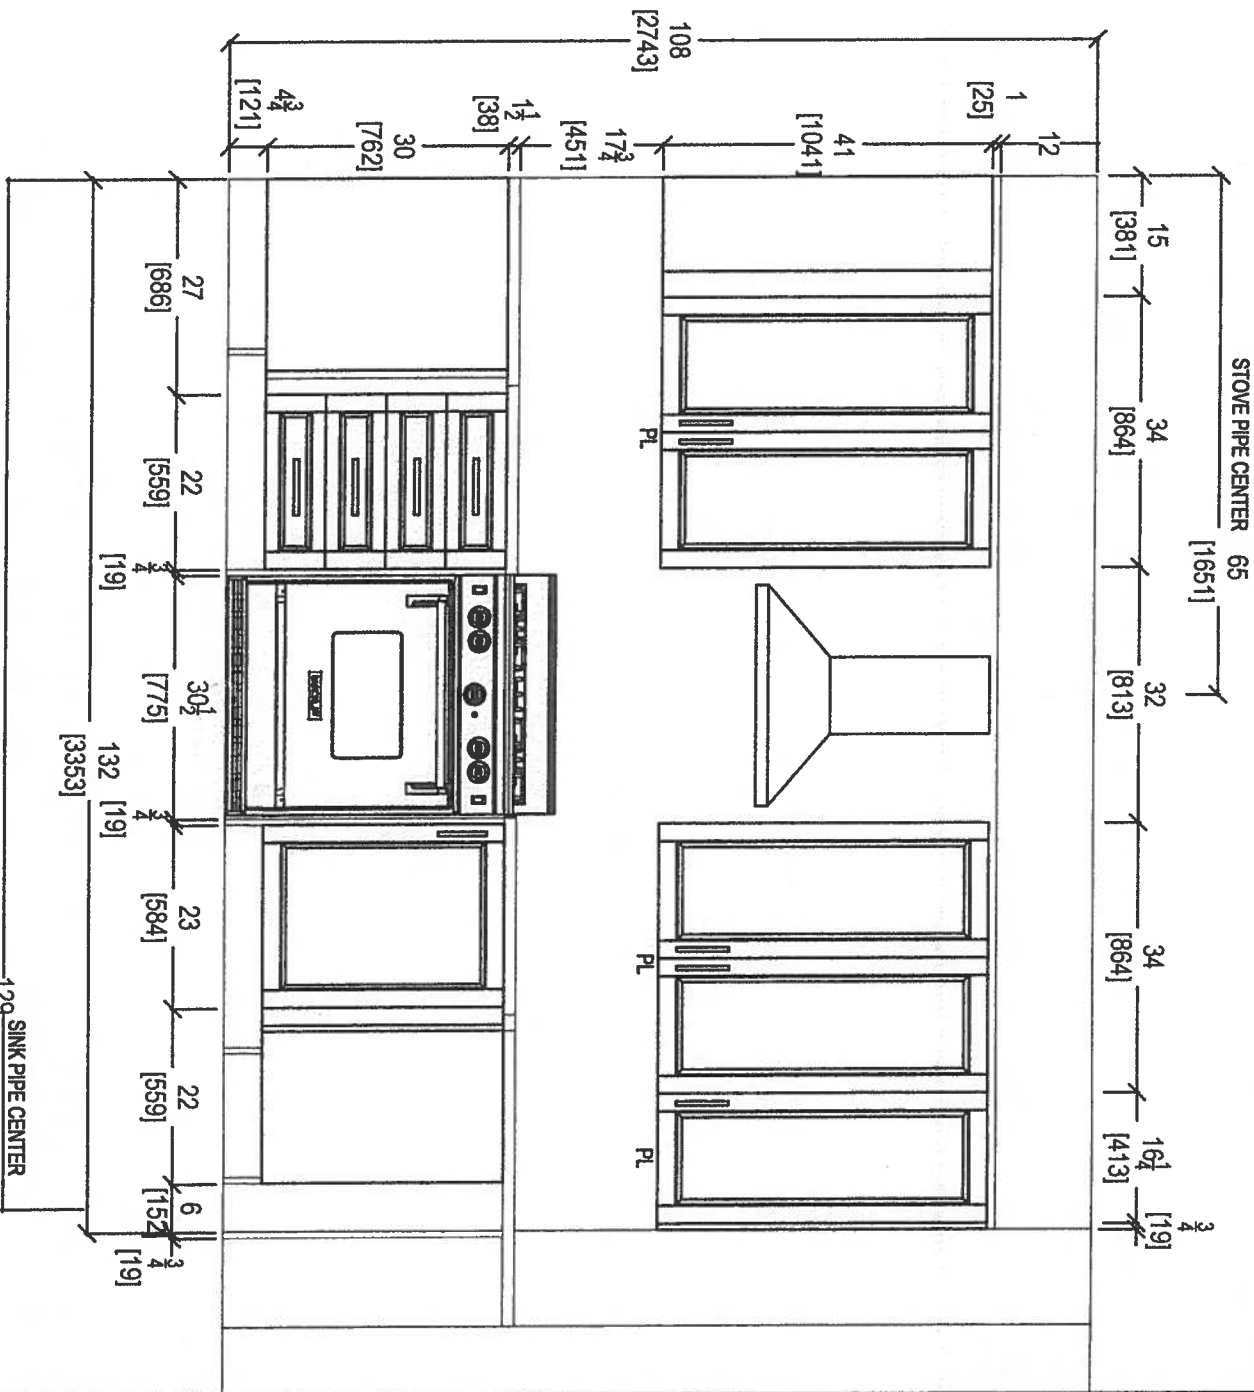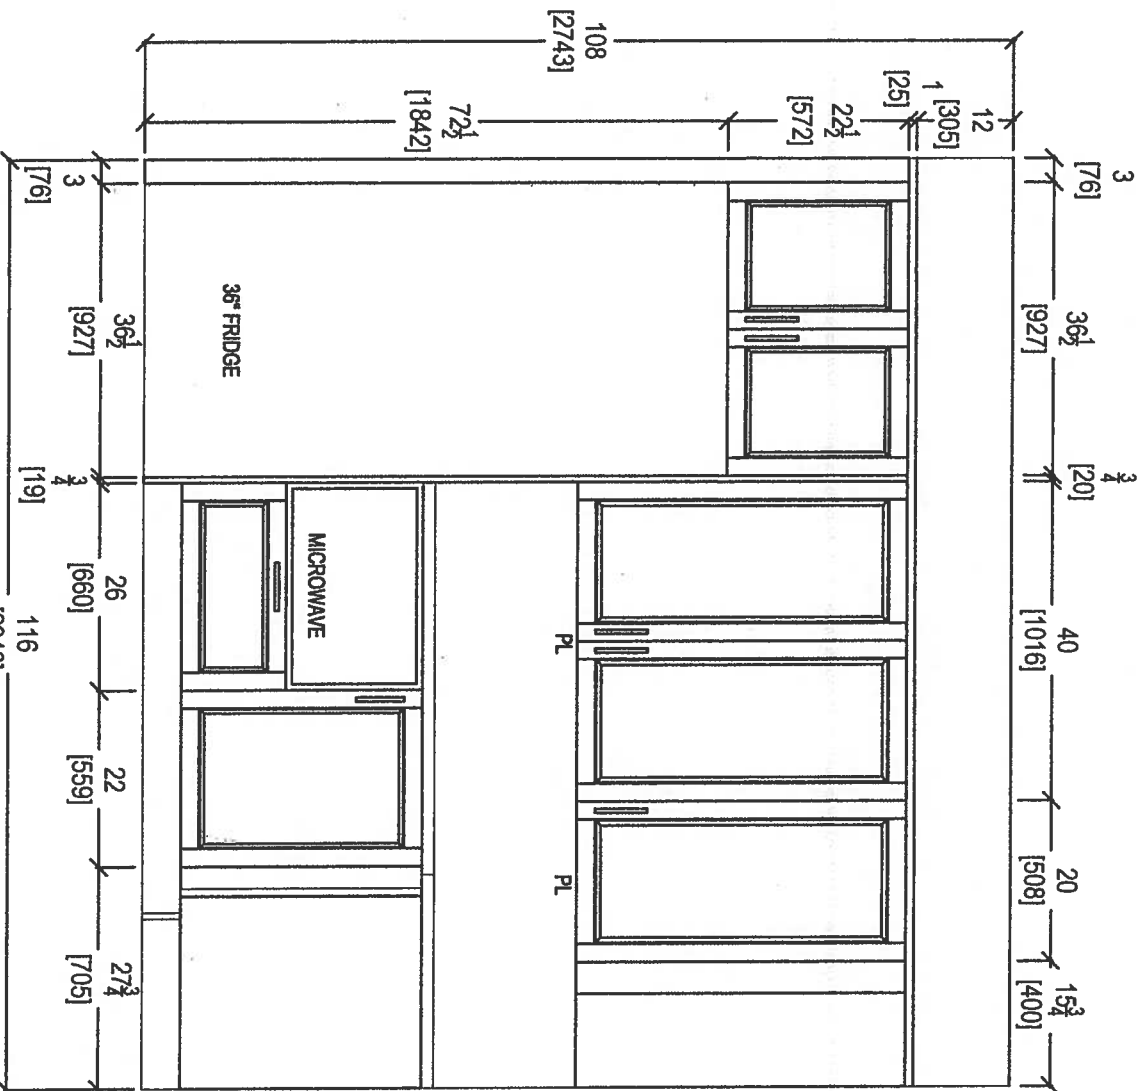


STOVE WALL ELEVATION

 your kitchen, your taste. 80 SANTE DRIVE, VAUGHAN, ON L4K 3C4, T: 416.746.1811 F: 905.781.5601		CLIENT: ROYAL PINE HOMES	JOB NAME: UNIT 407 HMP	ROOM: KITCHEN FLOOR PLAN	DRAWN BY: SK	COMMENTS:
SITE: HAMPTON PLACE	DOOR STYLE: —	DOOR HANDLE: —	SCALE: 1/2" = 1' - 0"	PLEASE NOTE ALL DIMENSIONS ARE NOT FINAL AND ARE SUBJECT TO CHANGE UPON FINAL SITE MEASURE		
PHONE: —	FINISH: —	DRW HANDLE: —	DATE: FEB 4, 2019			
EMAIL: —	SPECIES: —	TOP: —	PAGE: —			

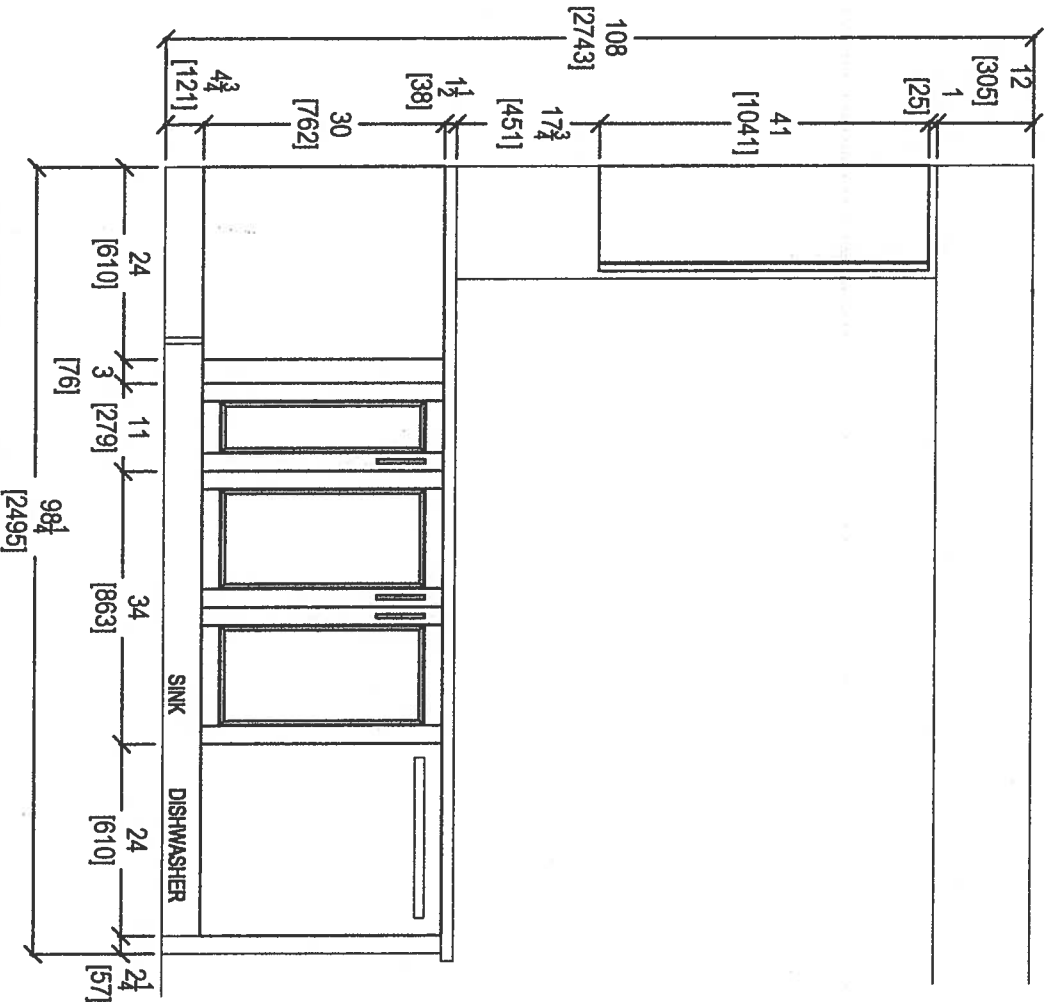


KITCHEN PENINSULA ELEVATION
FRONT VIEW

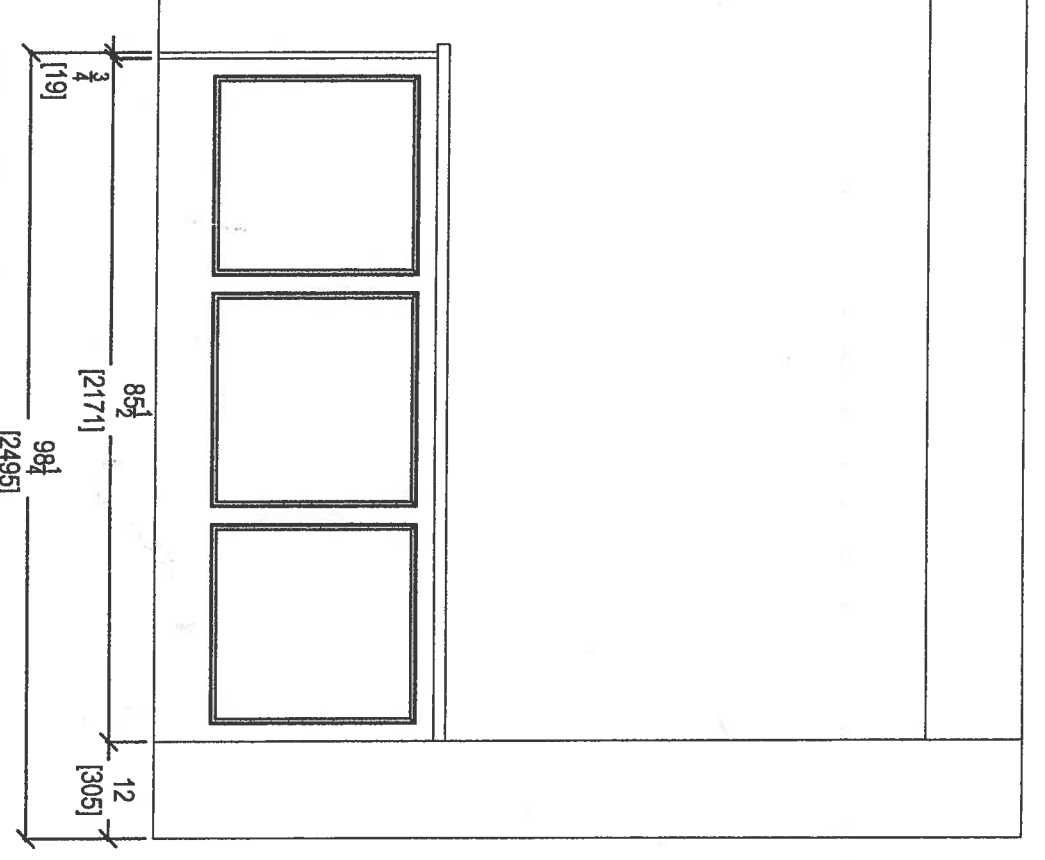


KITCHEN PENINSULA ELEVATION
REAR VIEW



 <i>your kitchen, your taste.</i> 80 SANTE DRIVE, VAUGHAN, ON L4K 3C4, T: 416.746.1811 F: 905.761.5901				CLIENT: ROYAL PINE HOMES		JOB NAME: UNIT 407 HMP		ROOM: KITCHEN FLOOR PLAN		DRAWN BY: SK		COMMENTS: PLEASE NOTE ALL DIMENSIONS ARE NOT FINAL AND ARE SUBJECT TO CHANGE UPON FINAL SITE MEASURE
SITE: HAMPTON PLACE		DOOR STYLE: —		DOOR HANDLE: —		SCALE: 1/2" = 1' - 0"						
PHONE: —		FINISH: —		DRW HANDLE: —		DATE: FEB 4, 2019						
EMAIL: —		SPECIES: —		TOP: —		PAGE: —						

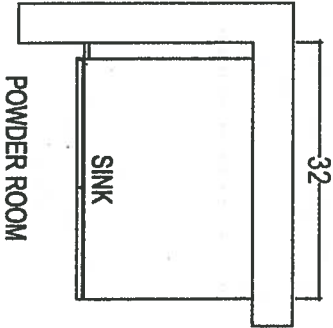

POWDER ROOM

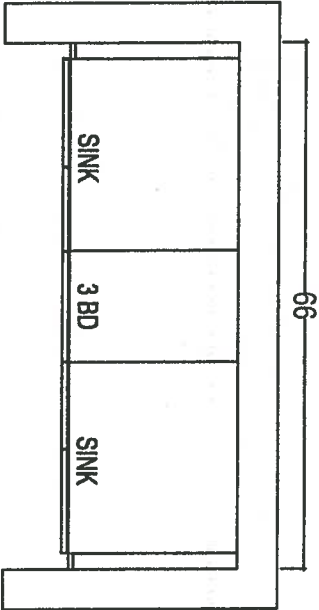

MASTER ENSUITE

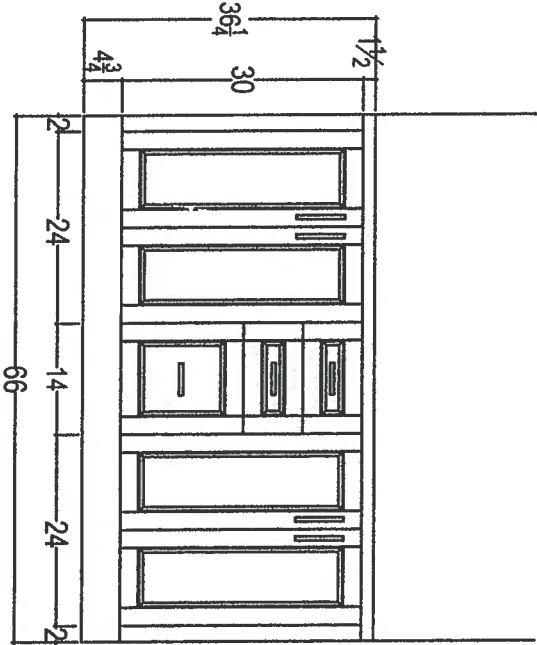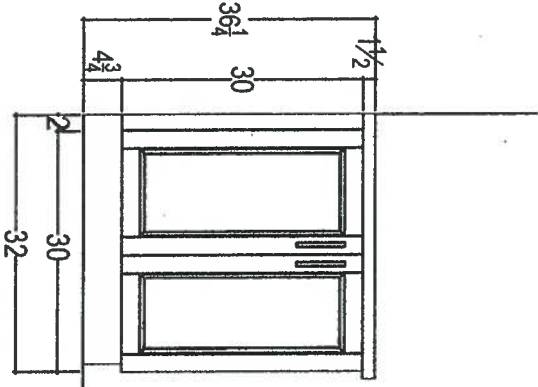

Ranso Vanities to 3" Solach.



80 SANTE DRIVE, VAUGHAN, ON L4K 3C4,
T: 416.746.1811 F: 905.761.5901

CLIENT: ROYAL PINE HOMES	JOB NAME: UNIT 407 HMP	ROOM: VANITIES	DRAWN BY: SK
SITE: HAMPTON PLACE	DOOR STYLE: —	DOOR HANDLE: —	SCALE: 1/2" = 1' - 0"
PHONE: —	FINISH: —	DRW HANDLE: —	DATE: FEB 4, 2019
EMAIL: —	SPECIES: —	TOP: —	PAGE: —

COMMENTS:
PLEASE NOTE ALL DIMENSIONS
ARE NOT FINAL AND ARE
SUBJECT TO CHANGE UPON
FINAL SITE MEASURE