






Noyac Bay

1,121 SQ FT *plus* 76sq. ft. of balcony area

SUITE 411.
ORIGINAL LAYOUT
INVENTORY SUITE

(NEW).

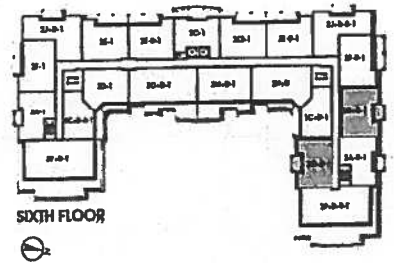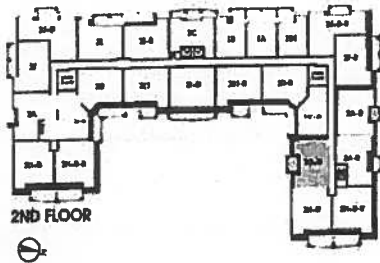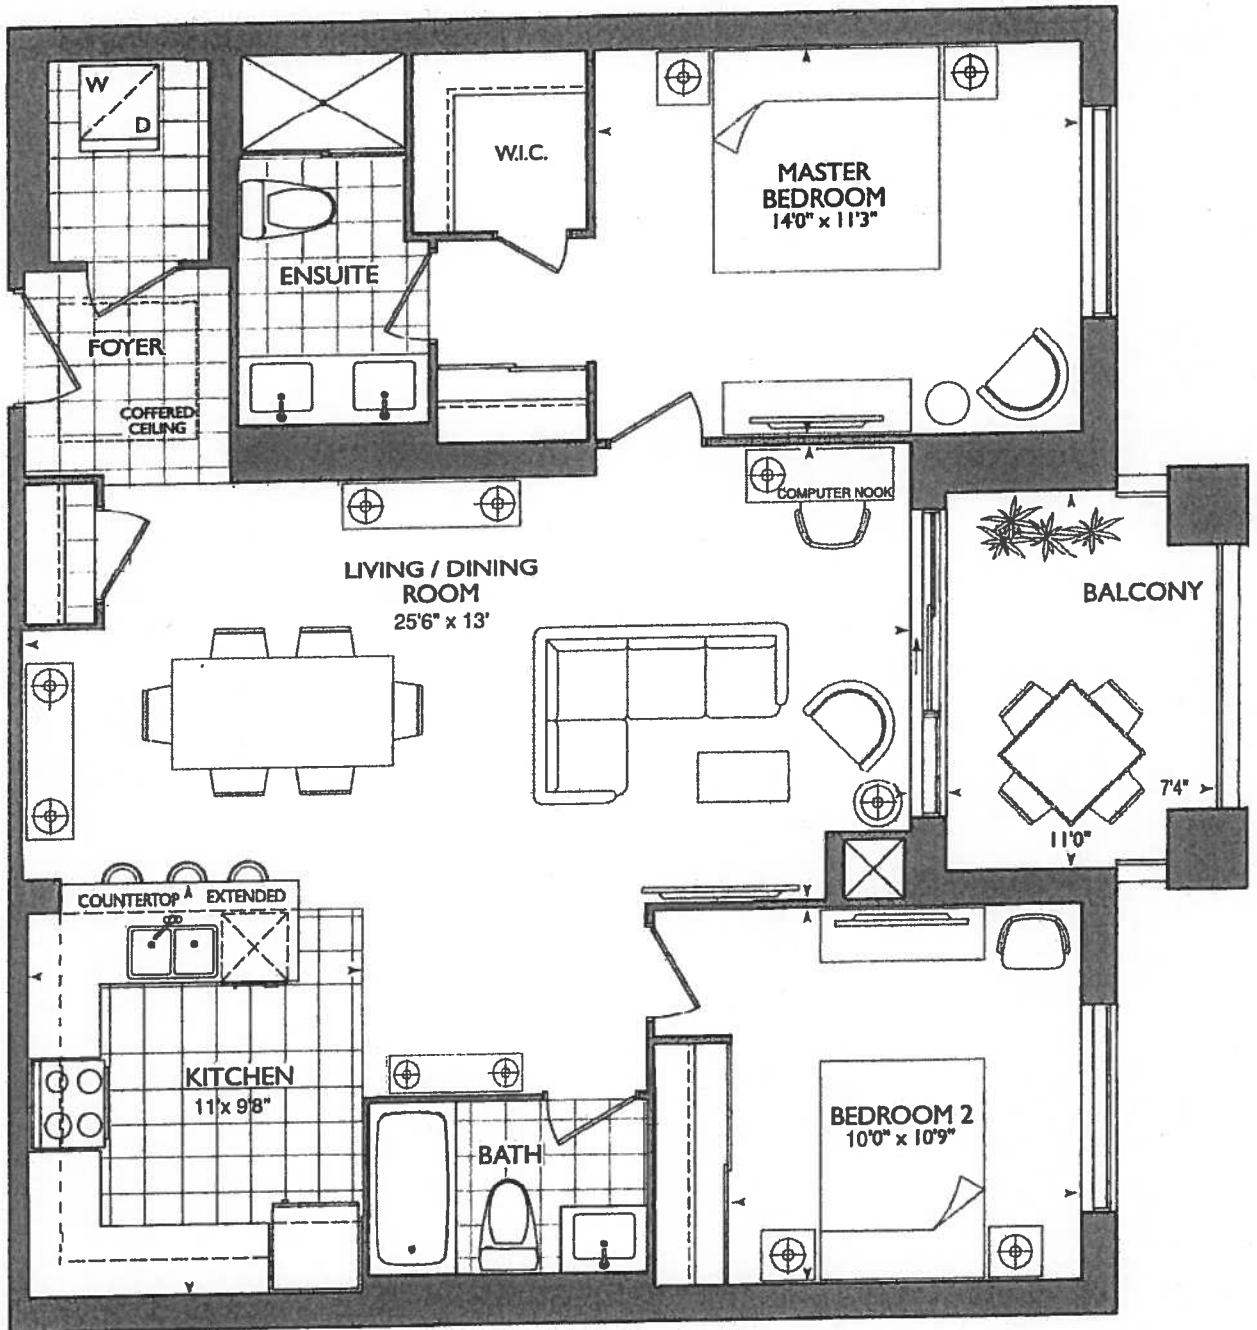


Plans and specifications are subject to change without notice. Actual usable floor space may vary from the stated floor area. All renderings are artist's concept. E. & O. E.

Suite Hampton

Living Room

→ CONDUIT :

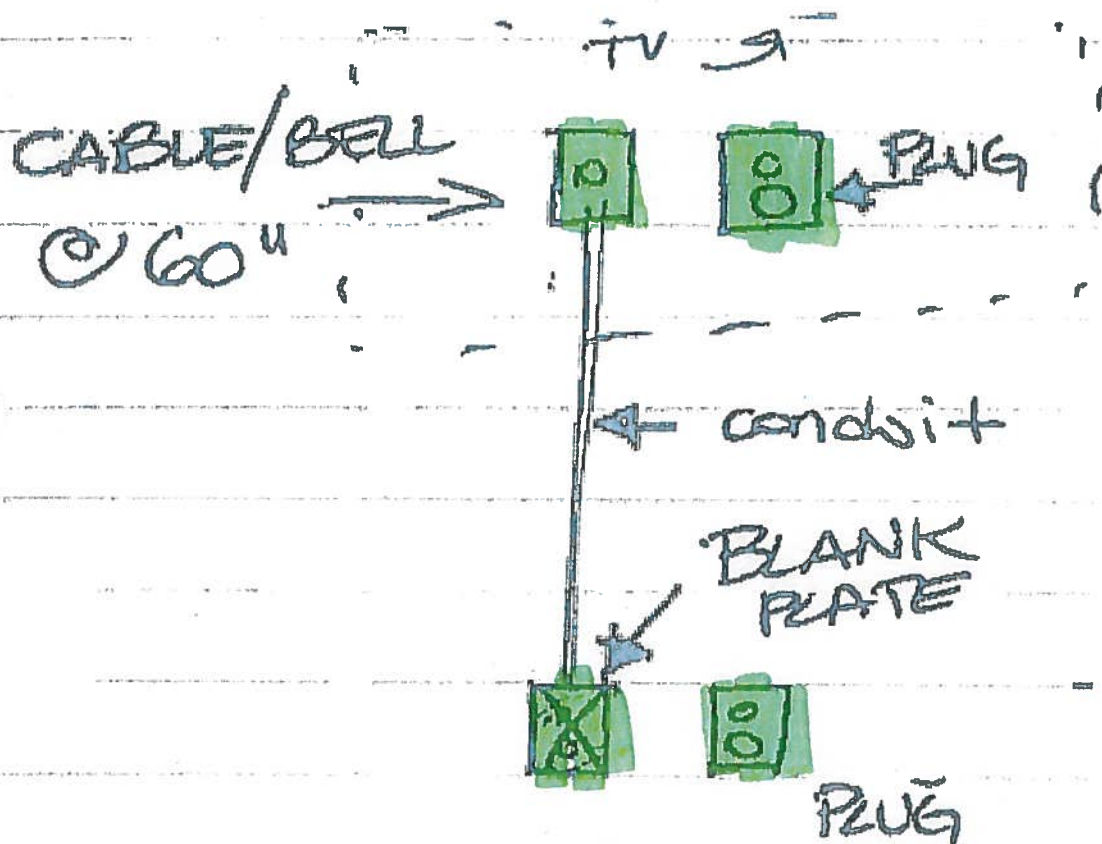

* KITCHEN *


- o STO KITCHEN
- o 1st URG APPLIANCE PKG
- o 36" FRIDGE ⊕
- o CHIMNEY HOOD FAN ⊕
- o MICRO SHELF
- o DRAWER BELOW
- (x2) CAPPED PENDANT
- (x1) PLUG PENINSULA
- (x5) PUCK LIGHTS
- o 6.5" STOVE PIPE CENTER
- o 129" SINK PIPE CENTER
- o Powder Room + ENSUITE RANSE
- o VANITY 36" / 4 + 3"
- o SPLASH

* LIVING DEN *

CONDUIT / PLUG / BLOCKING
WAS MOUNTED T.V.

SUITES 411 - NOYAC BAY

25 Baker Hill Blvd - Stoughton, ON - Apr 04, 2018

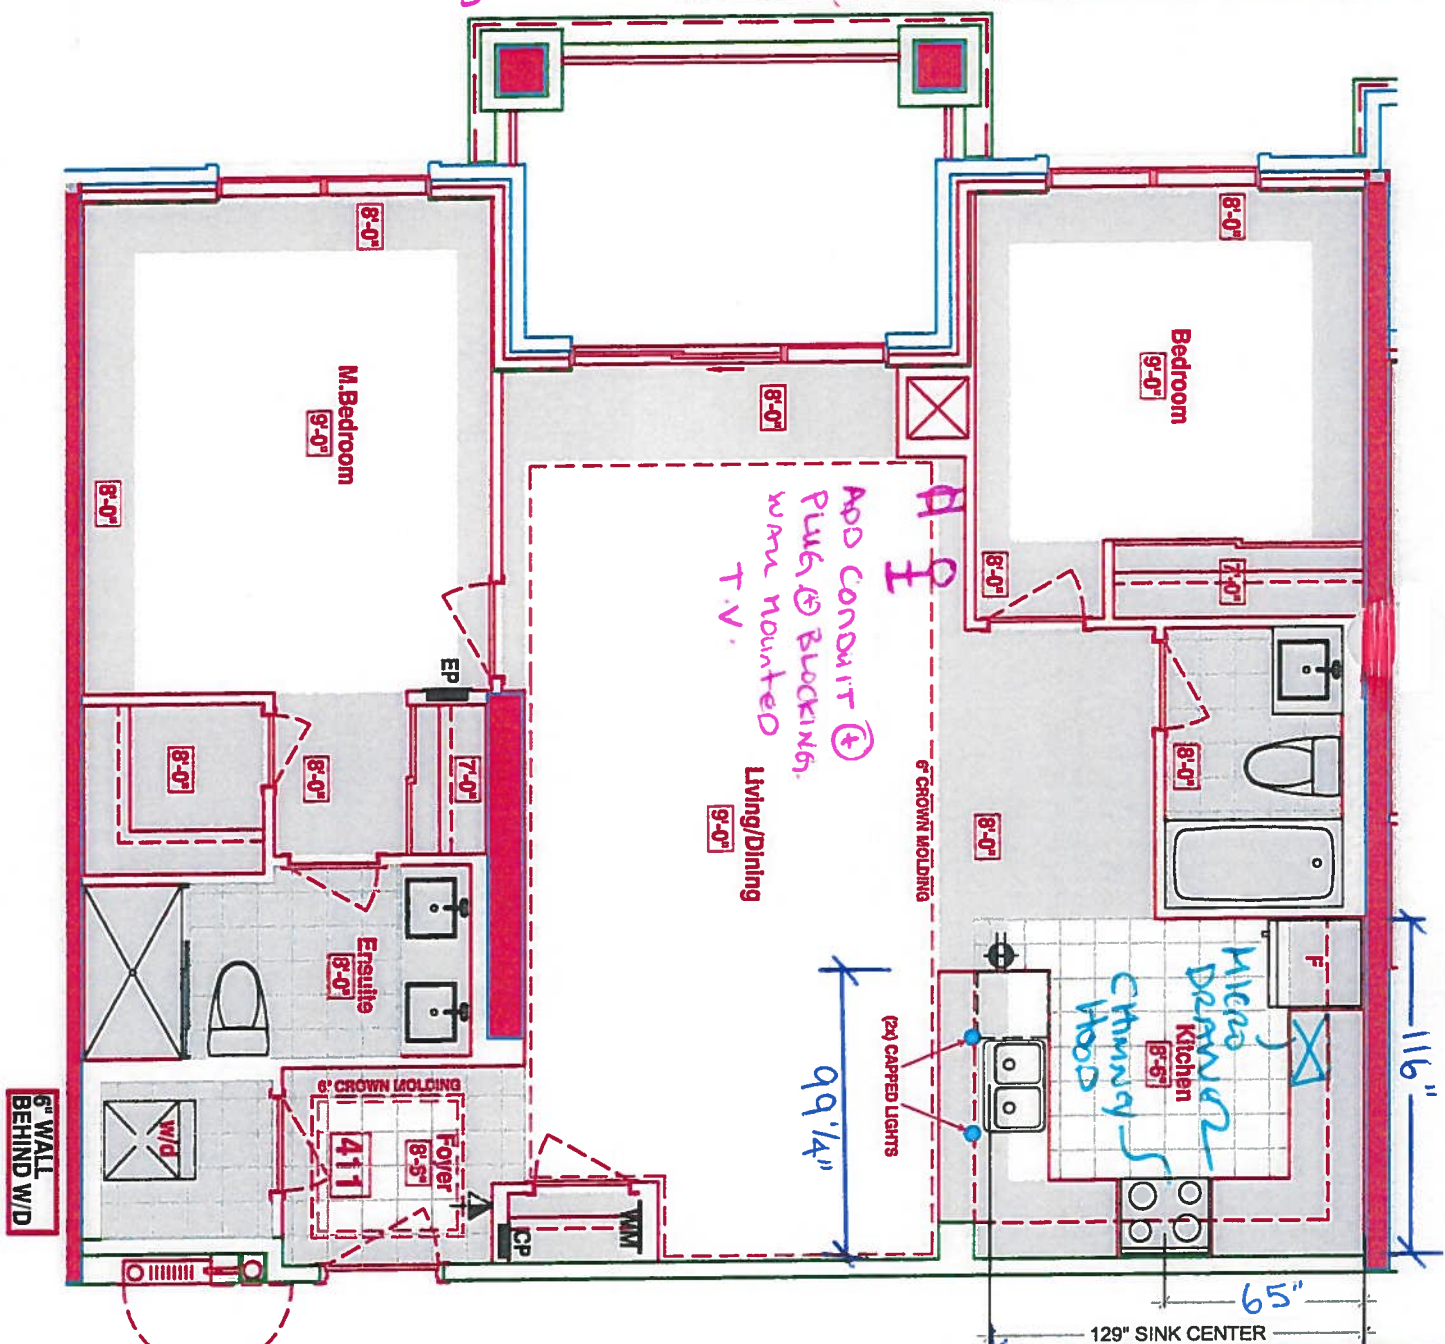


LEGEND:	
	SECURITY PANEL
	ELECTRICAL PANEL
	COMMUNICATION PANEL
	WATER METER
	FRIDGE
	DROPPED AREA
	6" CROWN MOLDING

Site
411
Inventory
Suite

- SMO KITCHEN
- 1st UPGRADE APPLIANCE PKG.
w/ 36" RANGE Ⓢ
CHIMNEY HOOD FAN Ⓢ
MICROWAVE SHELF w/ DRAWER Below

- (x2) = CAPED PENDANTS
- (x1) = PUG, PENINSULA
- (x5) = Puck LIGHTS

Powder Room + ENSUITE
RAISED VANITY 36" x 14" w/
3" SPLASH

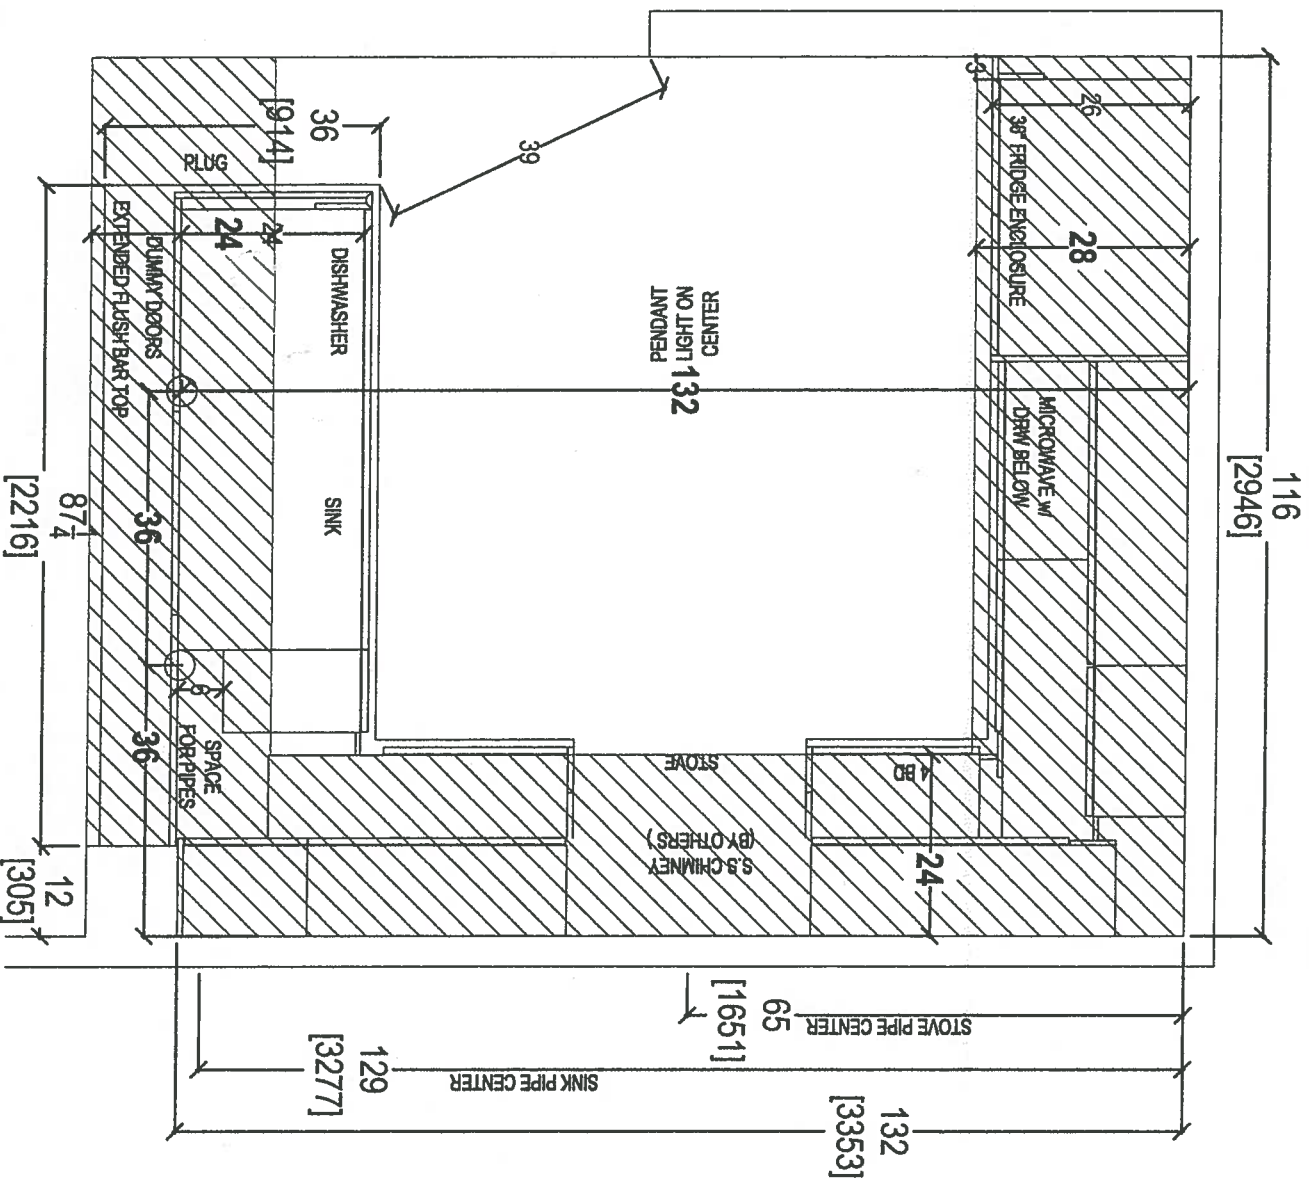

CLIENT: ROYAL PINE HOMES

UNIT 411 HMP

ROOM: KITCHEN

DRAWN BY: SK

SITE: HAMPTON PLACE

DOOR STYLE: —

DOOR HANDLE: —

SCALE: 1/2" = 1'-0"

PHONE: —

FINISH: —

DRW HANDLE: —

DATE: FEB 4, 2019

EMAIL: —

SPECIES: —

TOP: —


PAGE: —

COMMENTS:

PLEASE NOTE ALL DIMENSIONS
ARE NOT FINAL AND ARE
SUBJECT TO CHANGE UPON
FINAL SITE MEASURE



your kitchen your taste
80 SANTE DRIVE, VAUGHAN, ON L4K 3C4,
T: 416.746.1811 F: 905.761.5801


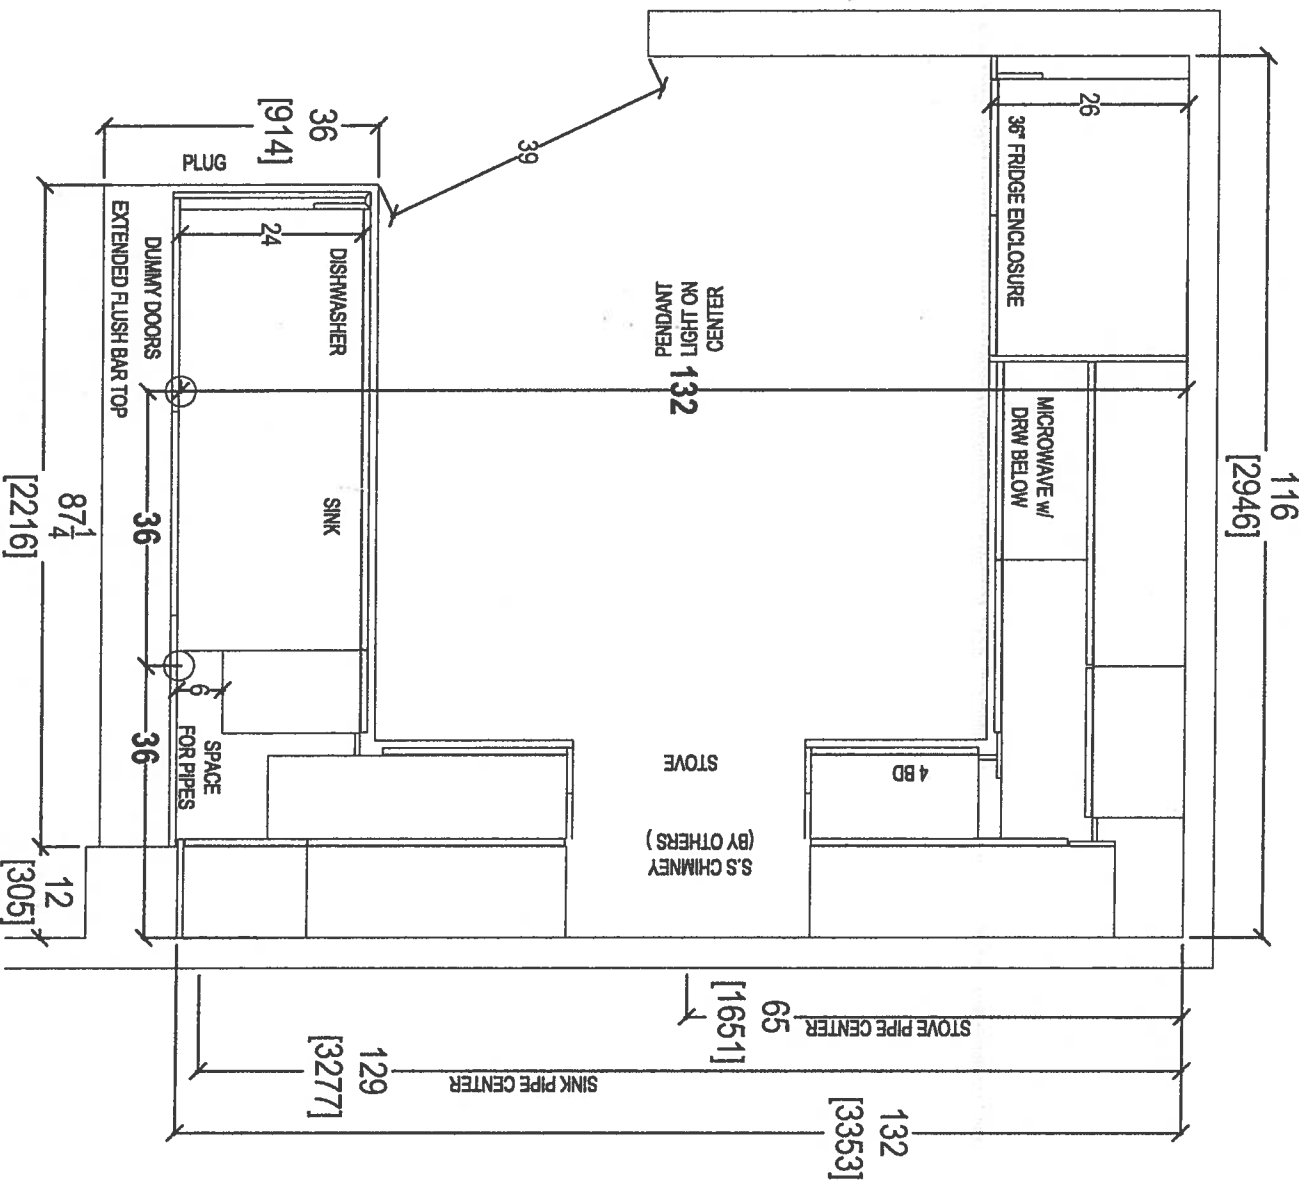


CLIENT: ROYAL PINE HOMES		UNIT 411 HMP		ROOM: KITCHEN		DRAWN BY: SK	
SITE: HAMPTON PLACE		DOOR STYLE: —		DOOR HANDLE: —		SCALE: 1/2" = 1'-0"	
PHONE: —		FINISH: —		DRW HANDLE: —		DATE: FEB 4, 2019	
EMAIL: —		SPECIES: —		TOP: —		PAGE: —	



80 SANTE DRIVE, VAUGHAN, ON L4K 3C4,
T: 416.746.1811 F: 905.761.5901

COMMENTS:
PLEASE NOTE ALL DIMENSIONS
ARE NOT FINAL AND ARE
SUBJECT TO CHANGE UPON
FINAL SITE MEASURE

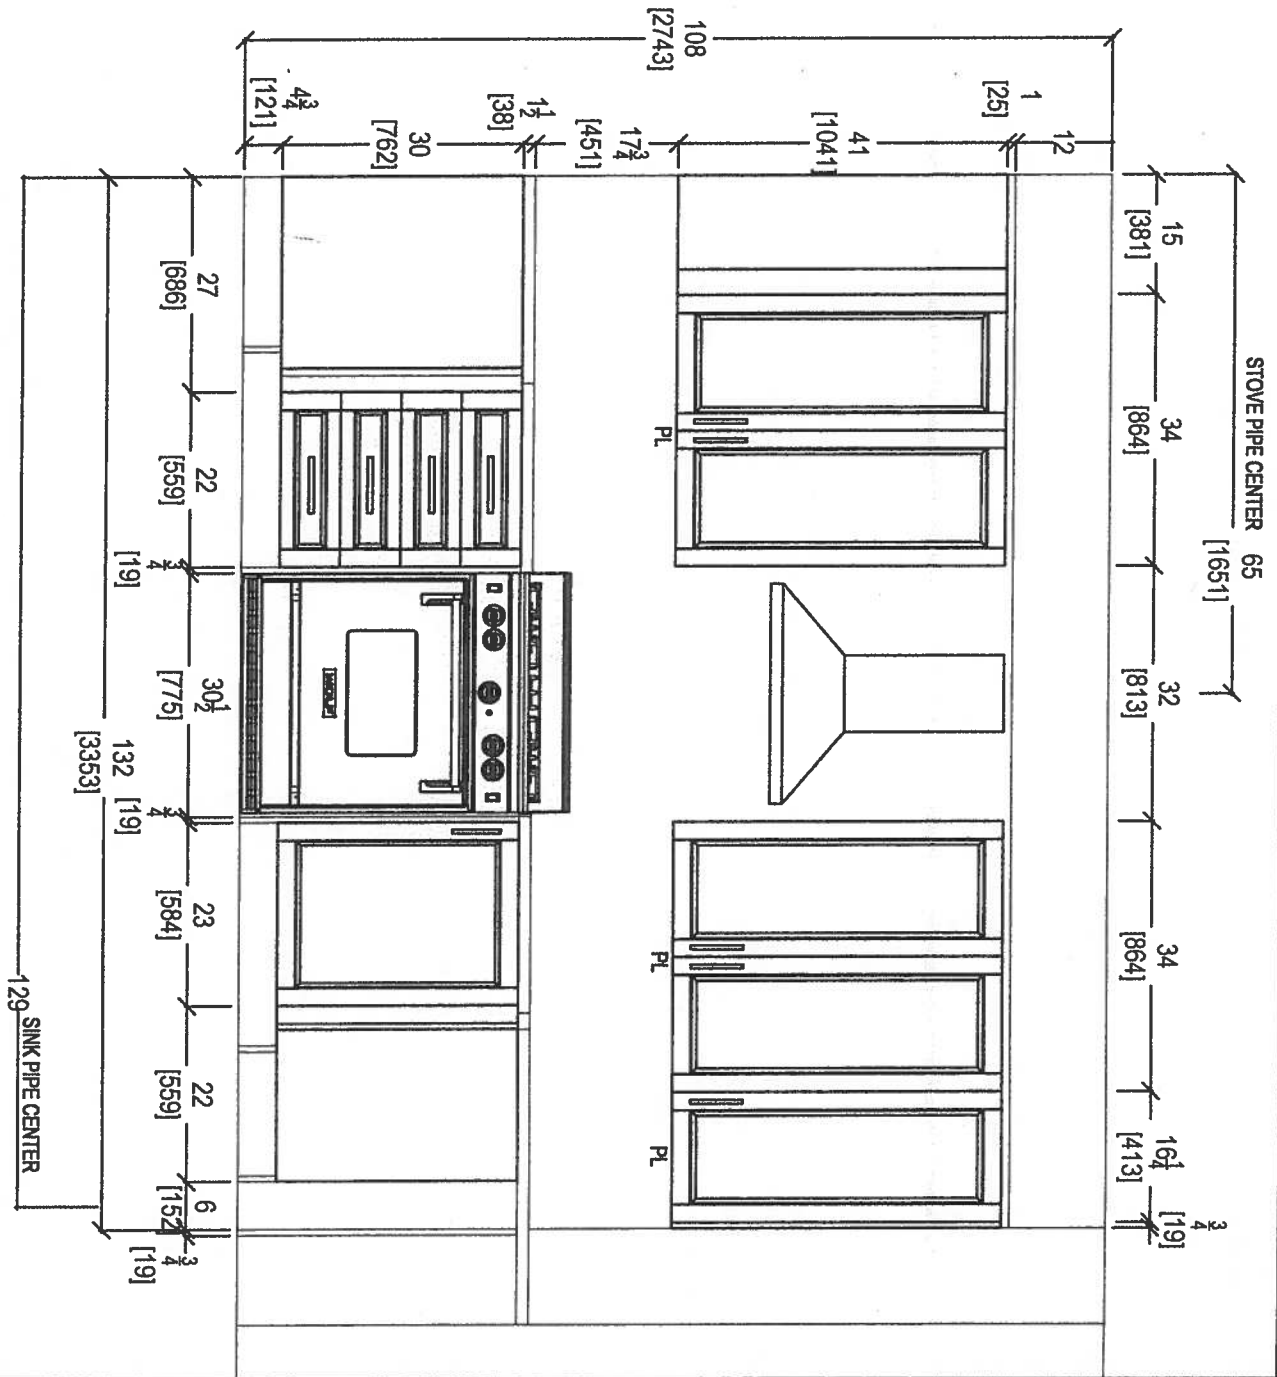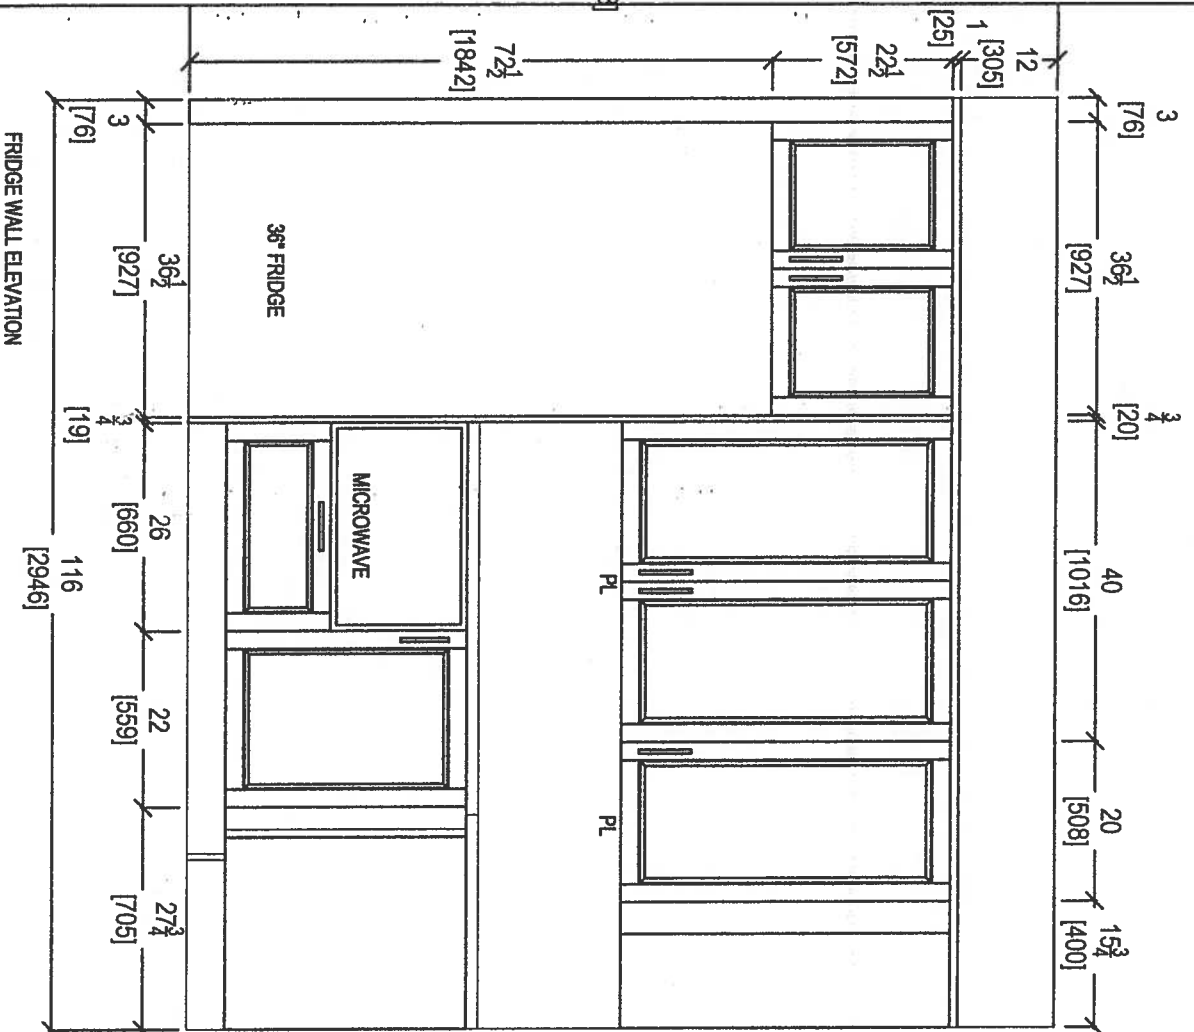



STOVE WALL ELEVATION

FRIDGE WALL ELEVATION



80 SANTE DRIVE, VAUGHAN, ON L4K 3C4.
T: 416.746.1811 F: 305.781.5801


CLIENT: ROYAL PINE HOMES	UNIT 411 HMP	ROOM: KITCHEN	DRAWN BY: SK	COMMENTS:
SITE: HAMPTON PLACE	DOOR STYLE: —	DOOR HANDLE: —	SCALE: 1/2" = 1' - 0"	PLEASE NOTE ALL DIMENSIONS ARE NOT FINAL AND ARE SUBJECT TO CHANGE UPON FINAL SITE MEASURE
PHONE: —	FINISH: —	DRYV HANDLE: —	DATE: FEB 4, 2018	
EMAIL: —	SPECIES: —	TOP: —	PAGE: —	

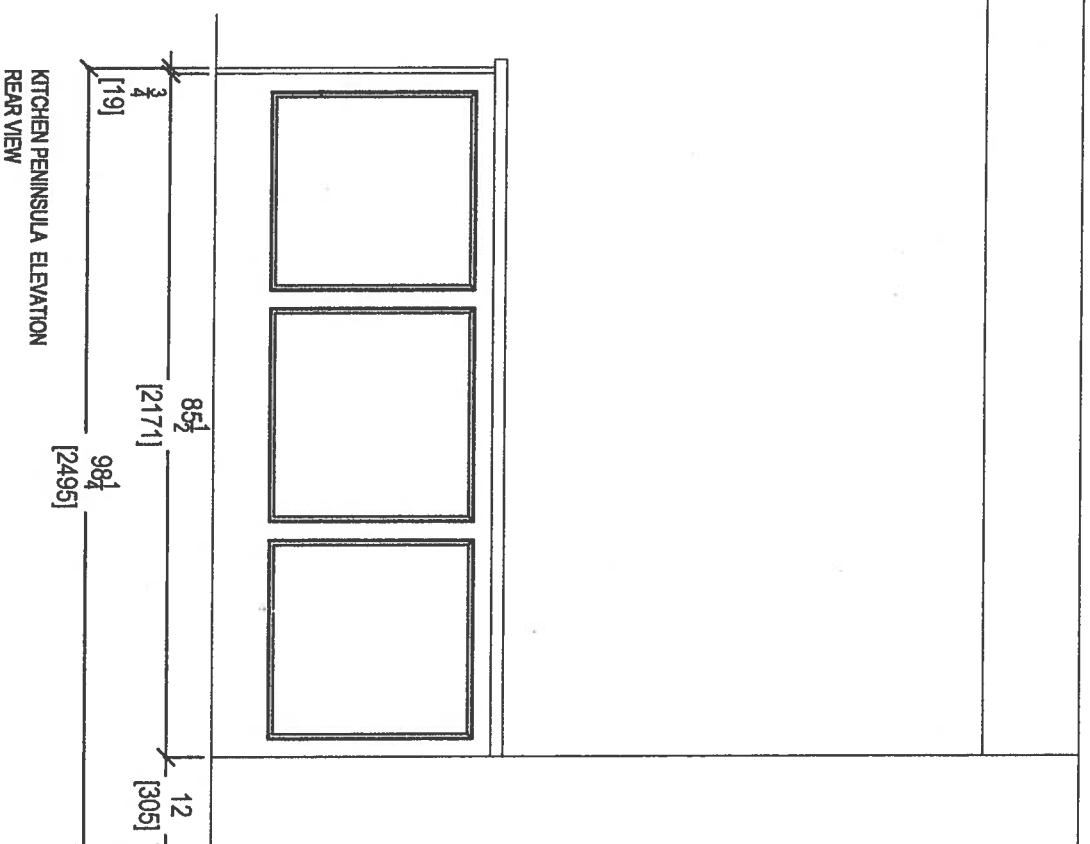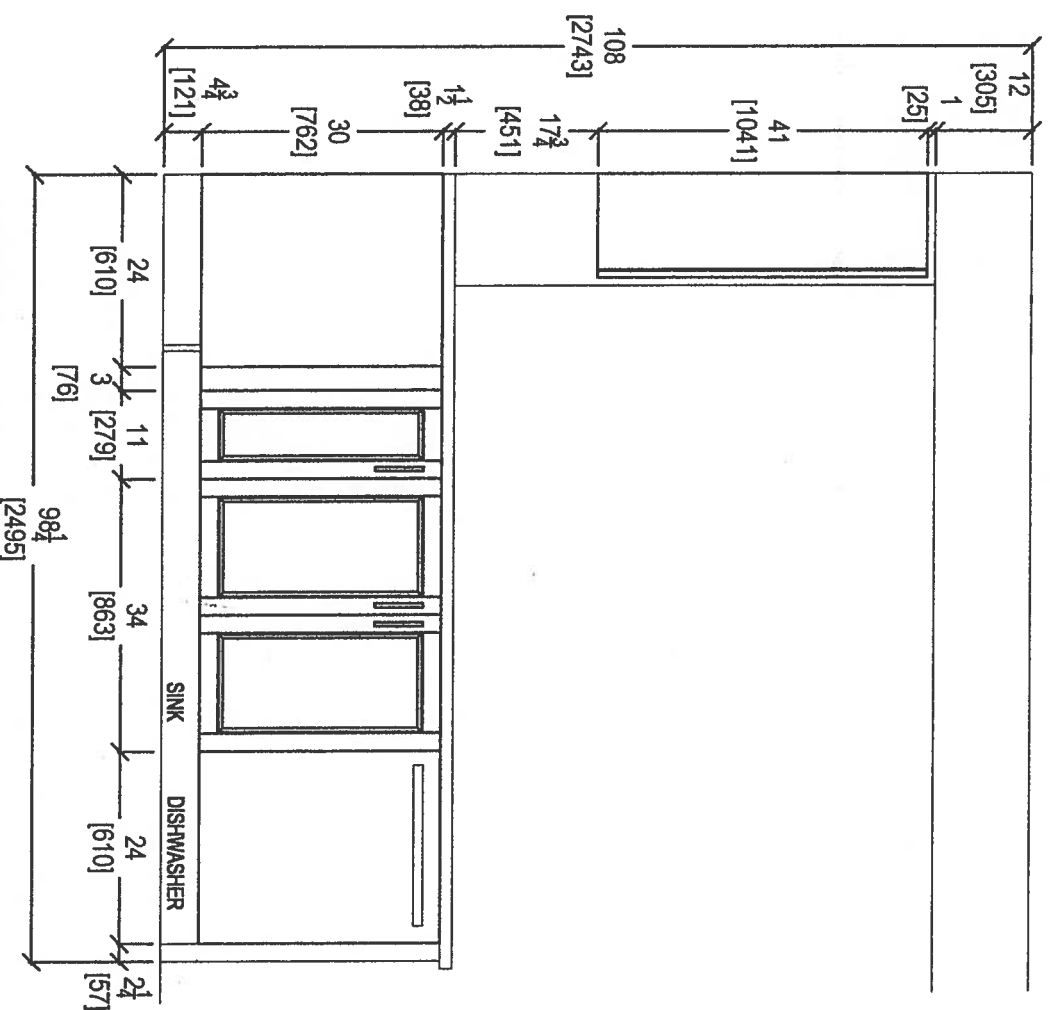


CLIENT: ROYAL PINE HOMES	UNIT 411 HMP	ROOM: KITCHEN	DRAWN BY: SK
SITE: HAMPTON PLACE	DOOR STYLE: ---	DOOR HANDLE: —	SCALE: 1/2" = 1' - 0"
PHONE: —	FINISH: ---	DRW HANDLE: ---	DATE: FEB 4, 2019
EMAIL: —	SPECIES: —	TOP: —	PAGE: —

COMMENTS:



PLEASE NOTE ALL DIMENSIONS
ARE NOT FINAL AND ARE
SUBJECT TO CHANGE UPON
FINAL SITE MEASURE

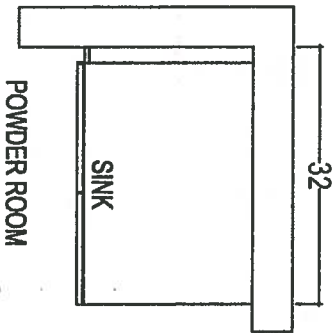

POWDER ROOM

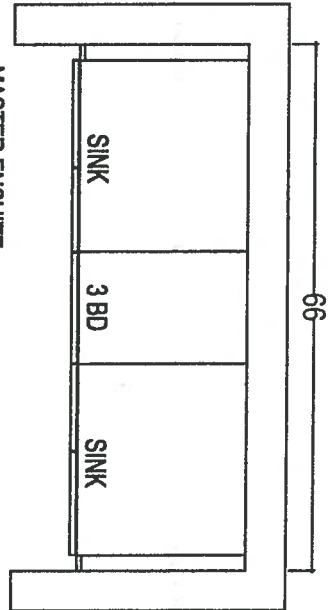

MASTER ENSUITE

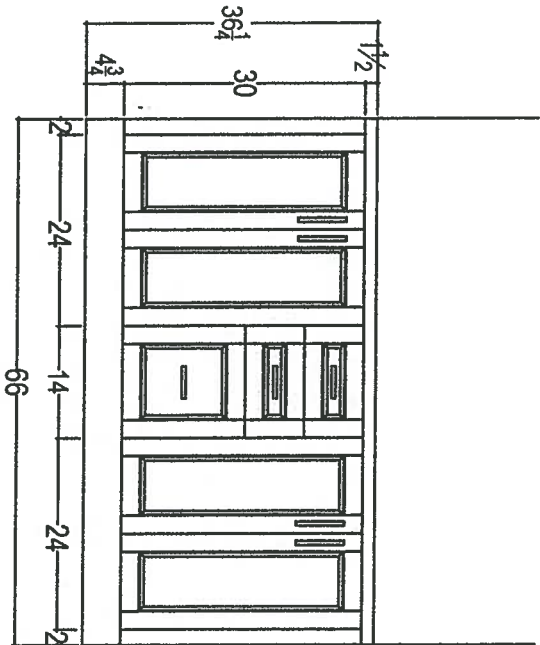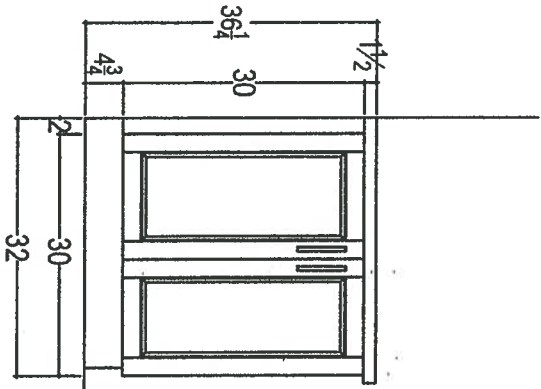

RAISED VANITIES w/ 3" SPLASH



80 SANTE DRIVE, VAUGHAN, ON L4K 3C4,
T: 416.746.1811 F: 905.761.5801

CLIENT: ROYAL PINE HOMES	UNIT 411 HMP	ROOM: VANITIES	DRAWN BY: SK
SITE: HAMPTON PLACE	DOOR STYLE: —	DOOR HANDLE: —	SCALE: 1/2" = 1' - 0"
PHONE: —	FINISH: —	DRW/HANDLE: —	DATE: FEB 4, 2019
EMAIL: —	SPECIES: —	TOP: —	PAGE: —

COMMENTS:
PLEASE NOTE ALL DIMENSIONS
ARE NOT FINAL AND ARE
SUBJECT TO CHANGE UPON
FINAL SITE MEASURE