




Sag Harbor

878 SQ FT plus 119 sq. ft. of balcony area

ORIGINAL Suite

Suite 412


Inventory.

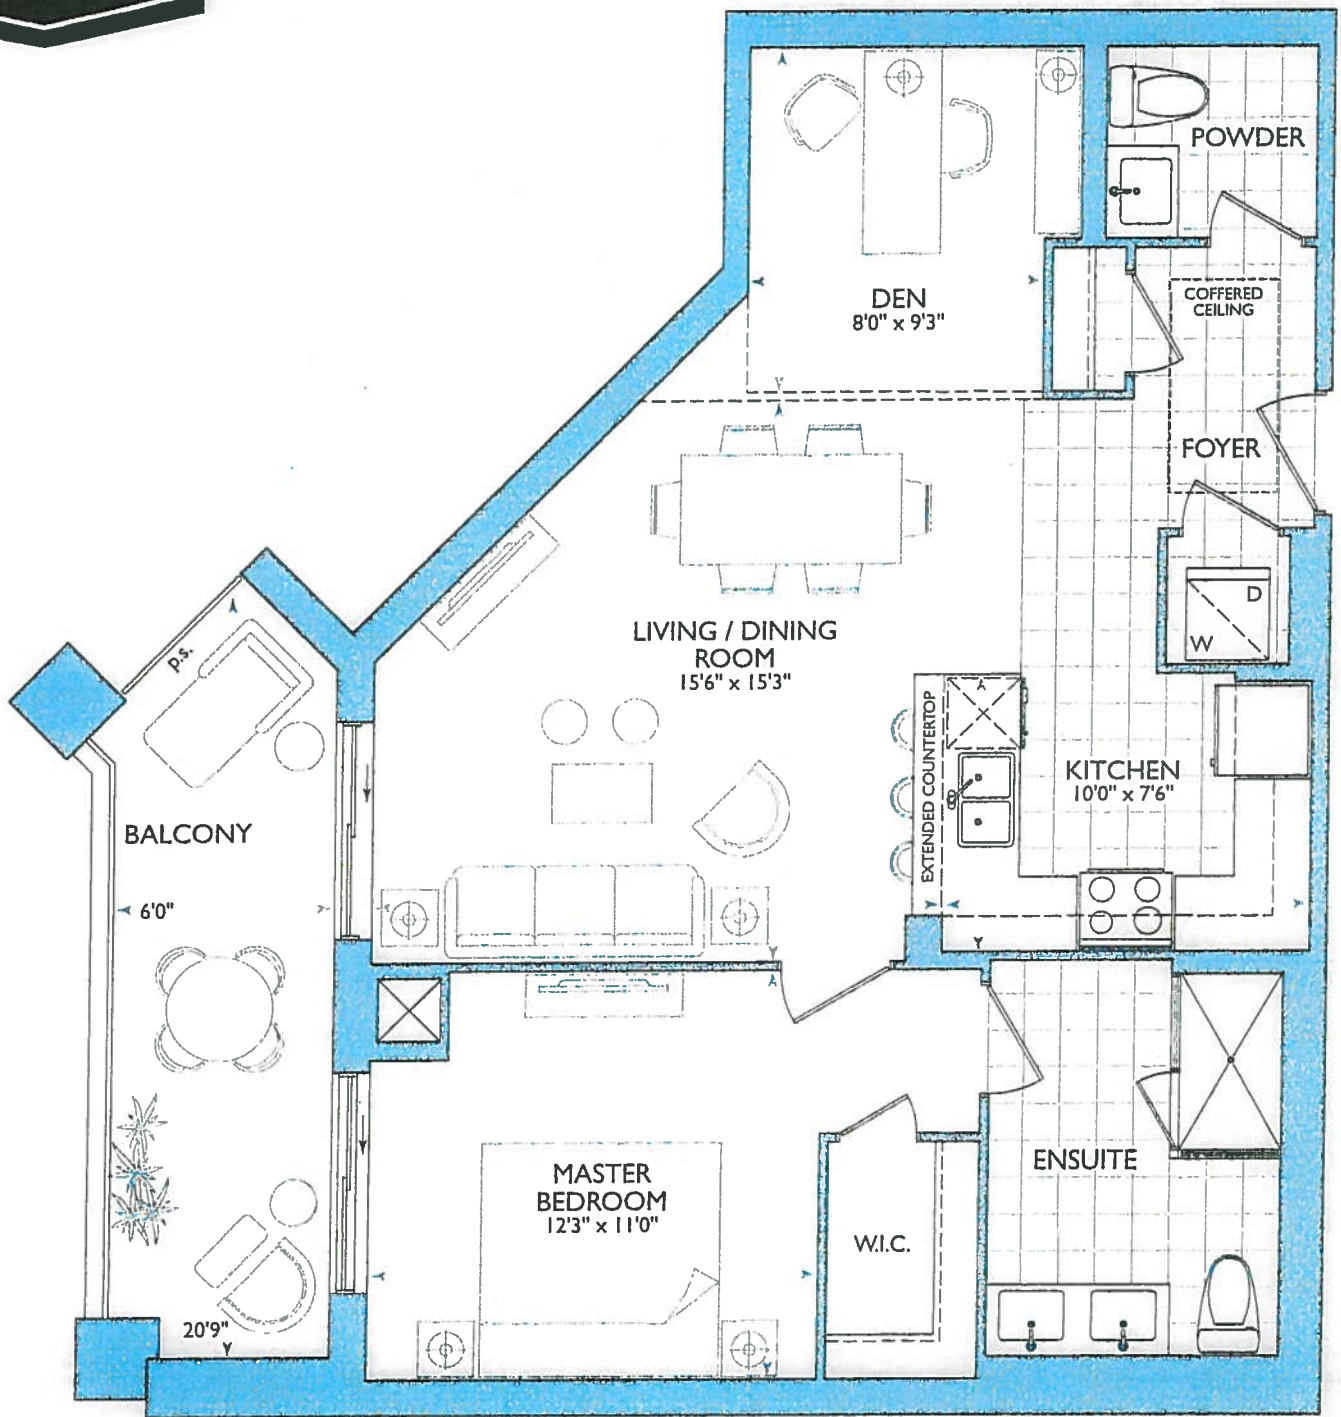

1st FLOOR



2ND - 5TH FLOOR

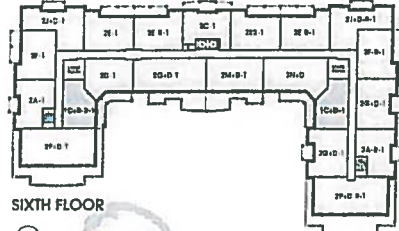

SIXTH FLOOR



SEVENTH FLOOR



Suite 412 - Inventory Suite

* move front door - Due to 6" wall moved behind w/d.

KITCHEN

- STD KITCHEN PKG.
- 1st UPGRADE APPLIANCES PKG

- (x2) = PENDANT LIGHTS OVER PENINSULA


- (x1) = PLUG PENINSULA

- (x3) = PUCK LIGHTS

*OPTIONAL BASE "L" CABINET

- 67" STOVE PIPE CENTER
- 118" SINK PIPE CENTER

* RASCO Powder Room (P)
ENSUITE VANITIES
36" x 3' SPLASH

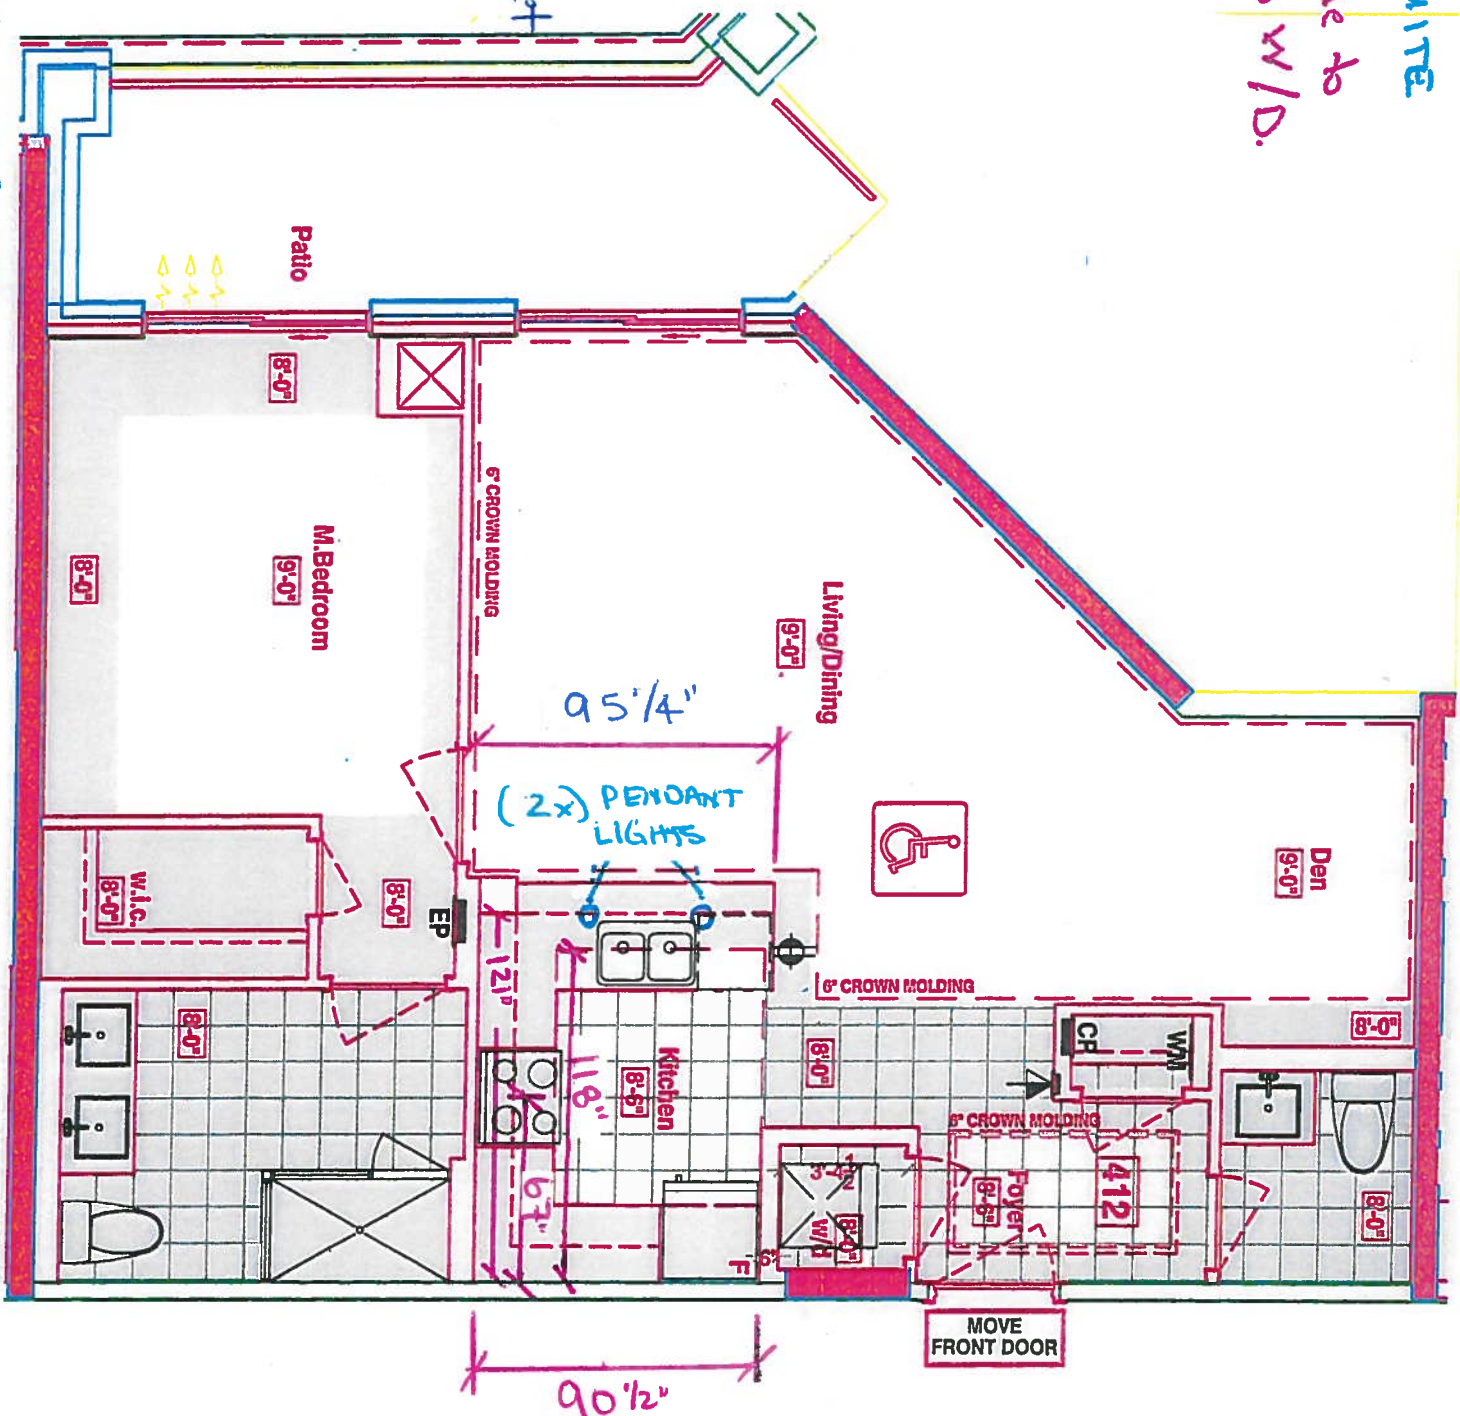


LEGEND:	
	SECURITY PANEL
	ELECTRICAL PANEL
	COMMUNICATION PANEL
	WATER METER
	FRIDGE
	DROPPED AREA
	6" CROWN MOLDING
	BARRIER FREE SUITE

- SMO KITCHEN PKG
- UPGRADE APPLIANCES PKG.
- (x2) = PENDANT LIGHTS
- (x1) = PLUG PENINSULA
- (x3) = PUCK LIGHTS


* OPTIONAL BASE "L" CABINET

* PANSY POWER ROOM + ENSUITE VANITIES 36 1/4 vs 3" splash

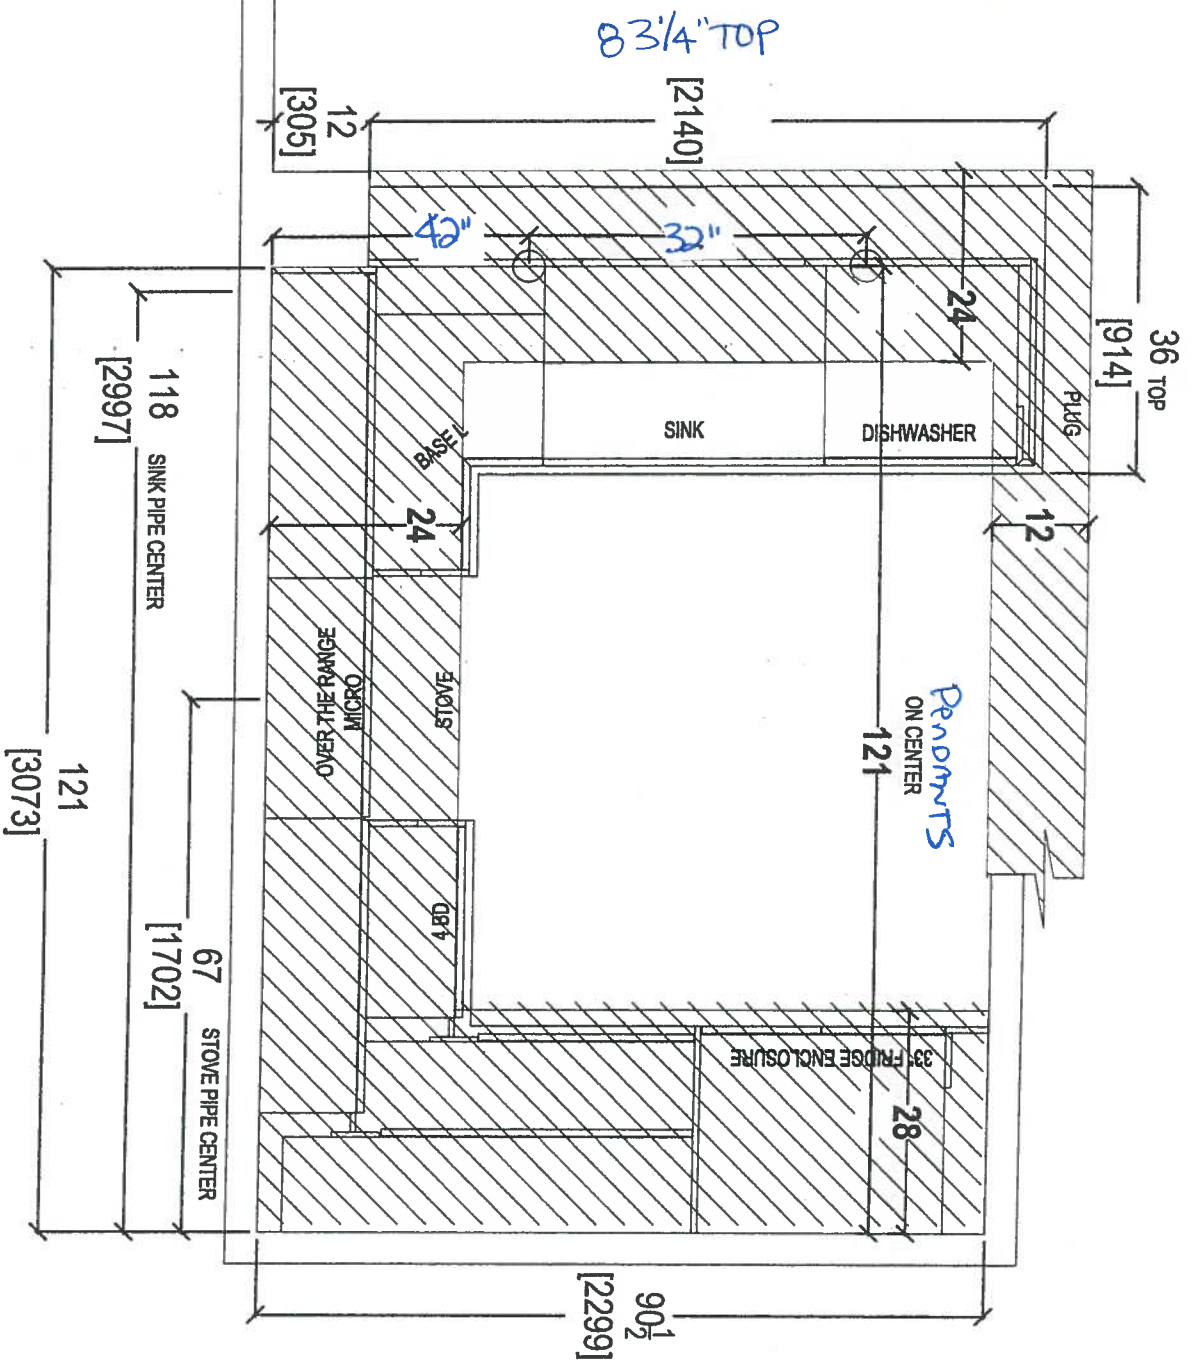



your kitchen, your taste.
80 SANTE DRIVE, VAUGHAN, ON L4K 3C4,
T: 416.746.1811 F: 905.761.5901

CLIENT: ROYAL PINE HOMES	UNIT: 412 HMP	ROOM: KITCHEN	DRAWN BY: SK	COMMENTS:
SITE: HAMPTON PLACE	DOOR STYLE: —	DOOR HANDLE: —	SCALE: 1/2" = 1'-0"	PLEASE NOTE ALL DIMENSIONS ARE NOT FINAL AND ARE SUBJECT TO CHANGE UPON FINAL SITE MEASURE
PHONE: —	FINISH: —	DRW/HANDLE: —	DATE: FEB 4, 2019	
EMAIL: —	SPECIES: —	TOP: —	PAGE: —	

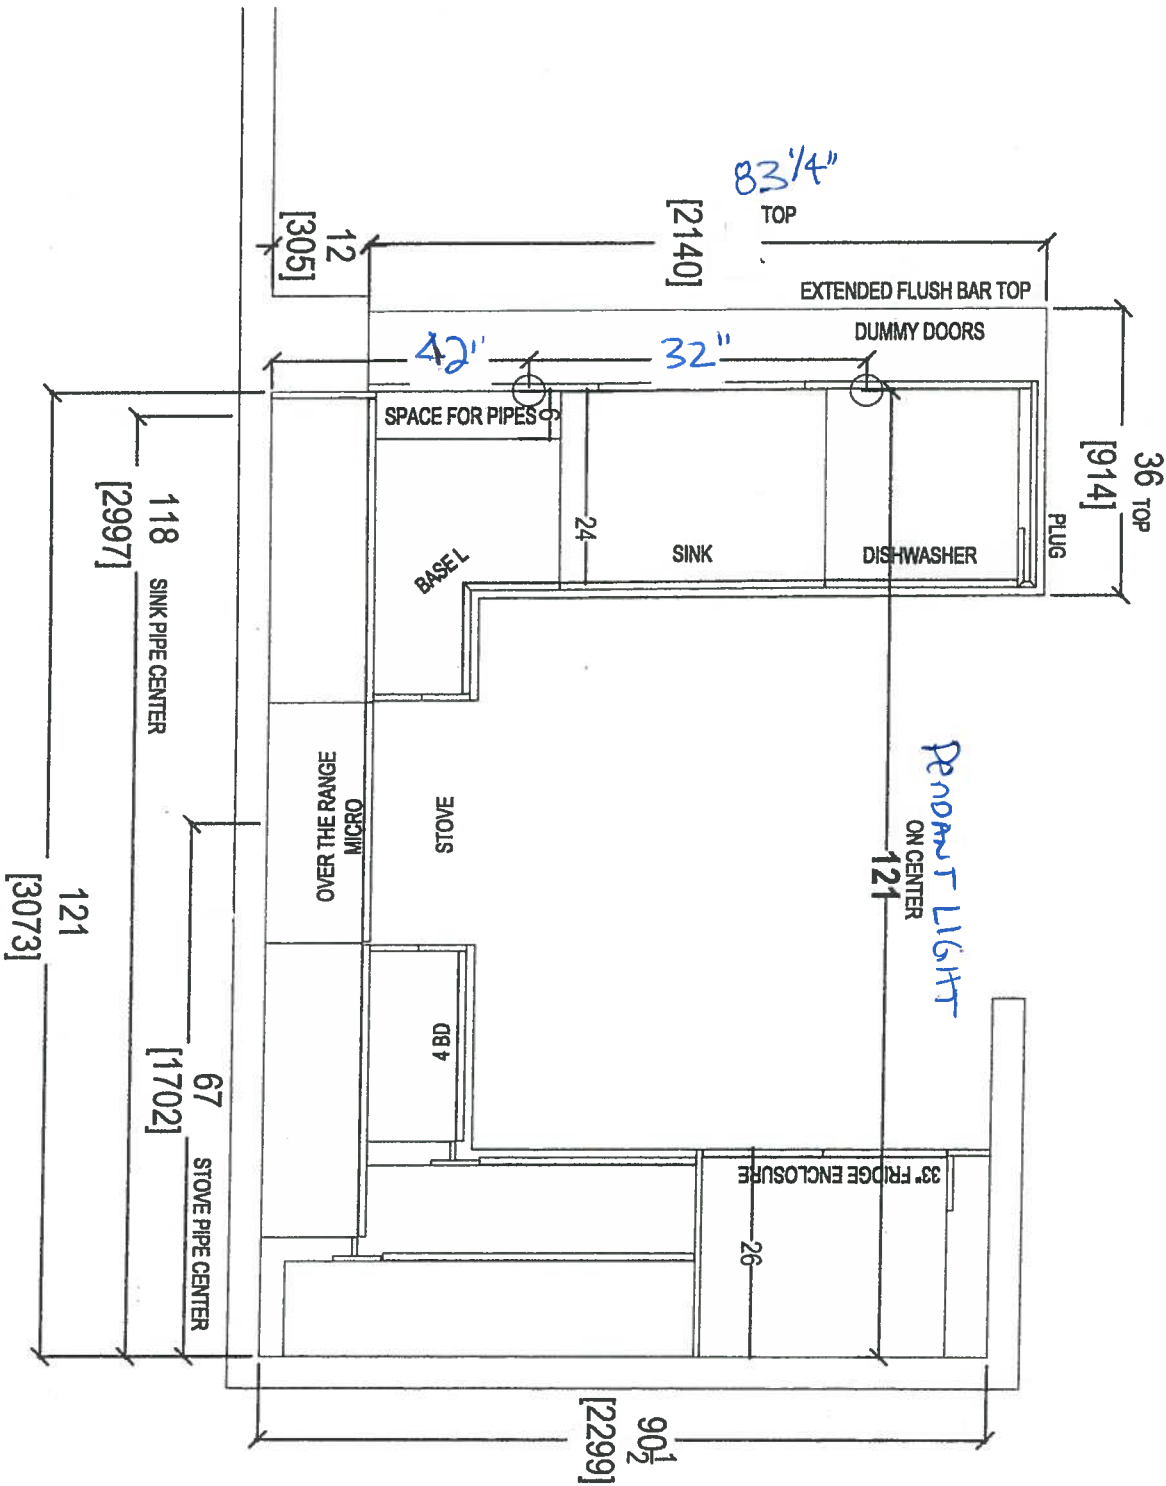


Your kitchen, your taste.
80 SANTE DRIVE, VAUGHAN, ON L4K 3C4,
T: 416.746.1811 F: 905.761.5901

CLIENT: ROYAL PINE HOMES	UNIT 412 HMP	ROOM: KITCHEN	DRAWN BY: SK	COMMENTS:
SITE: HAMPTON PLACE	DOOR STYLE: —	DOOR HANDLE: —	SCALE: 1/2" = 1' - 0"	PLEASE NOTE ALL DIMENSIONS ARE NOT FINAL AND ARE SUBJECT TO CHANGE UPON FINAL SITE MEASURE
PHONE: —	FINISH: —	DRW HANDLE: —	DATE: FEB 4, 2018	
EMAIL: —	SPECIES: —	TOP: —	PAGE: —	

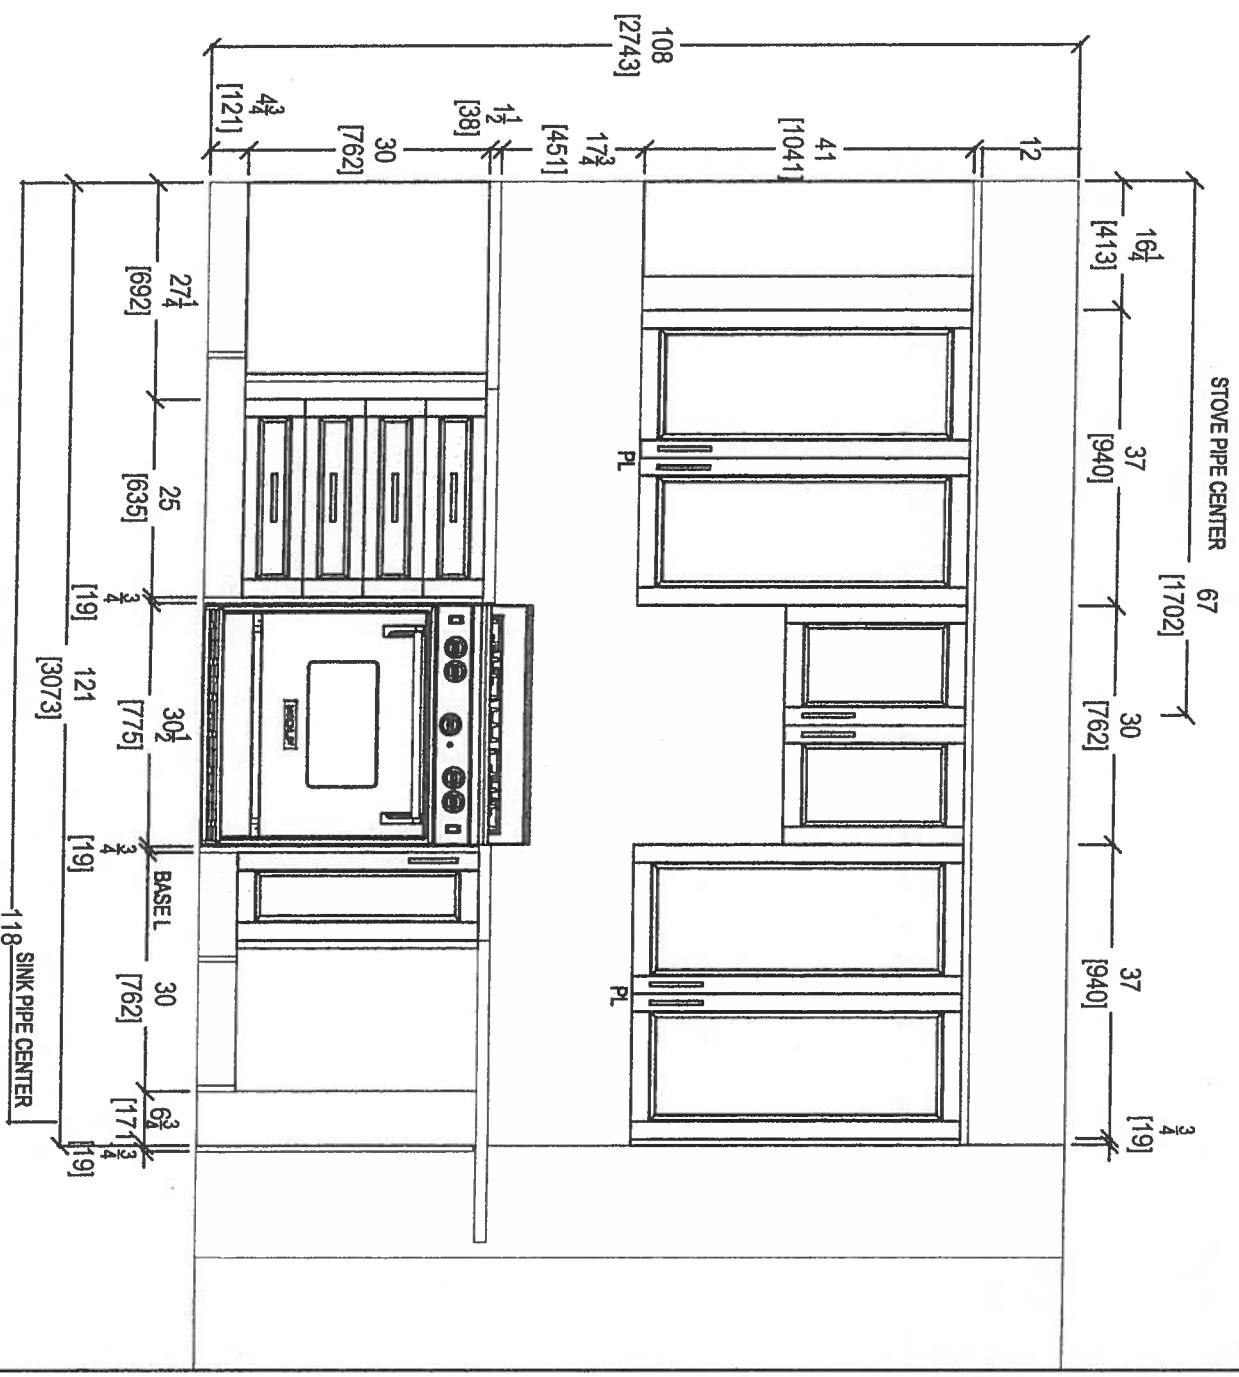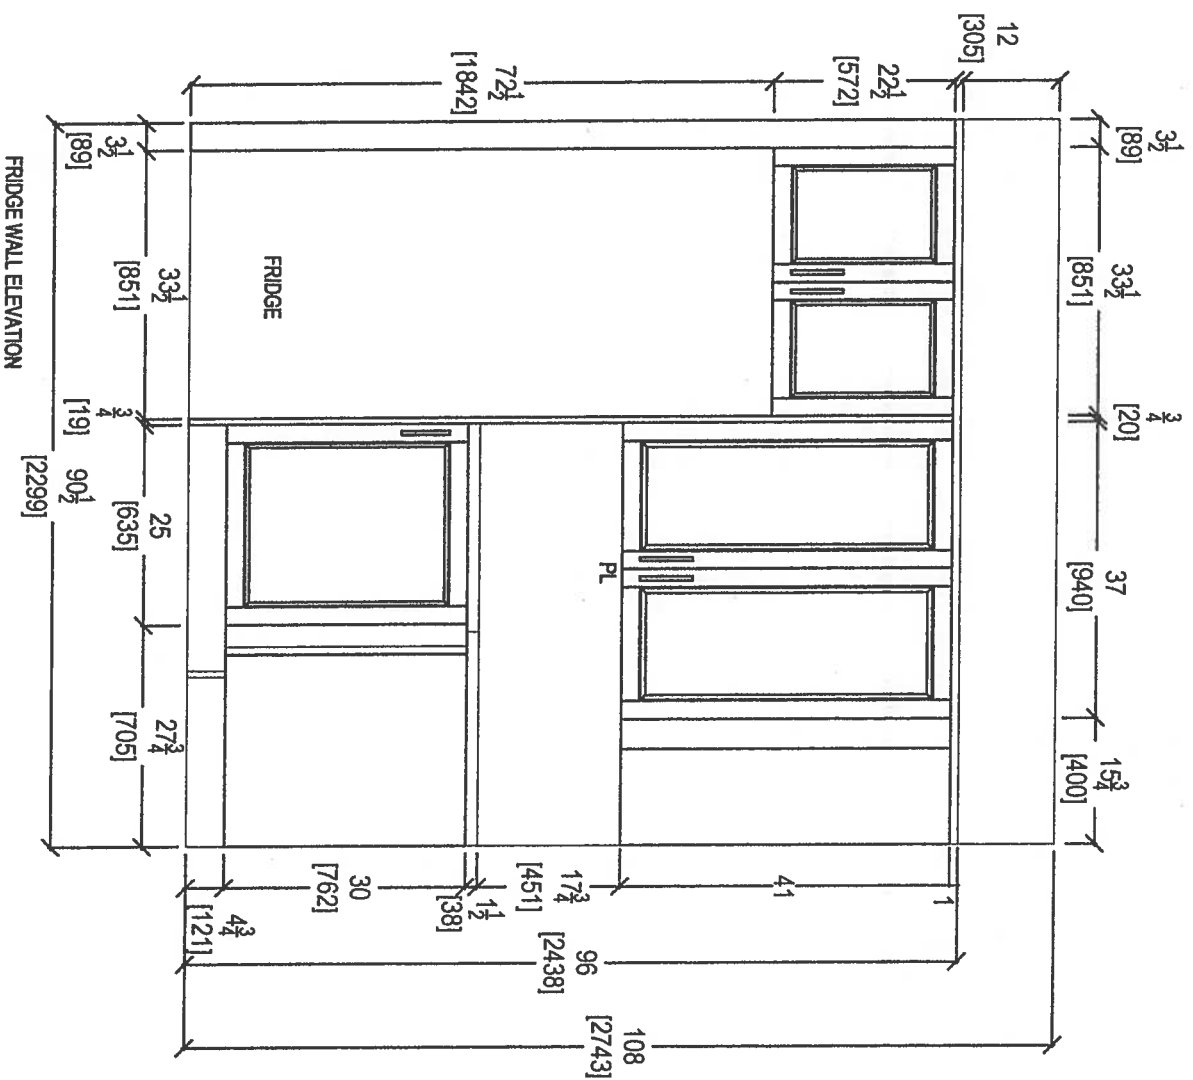

CLIENT: ROYAL PINE HOMES	UNIT 412 HMP	ROOM: KITCHEN	DRAWN BY: SK	COMMENTS: PLEASE NOTE ALL DIMENSIONS ARE NOT FINAL, AND ARE SUBJECT TO CHANGE UPON FINAL SITE MEASURE
SITE: HAMPTON PLACE	DOOR STYLE: —	DOOR HANDLE: —	SCALE: 1/2" = 1' - 0"	
PHONE: —	FINISH: —	DRW HANDLE: —	DATE: FEB 4, 2019	
EMAIL: —	SPECIES: —	TOP: —	PAGE: —	

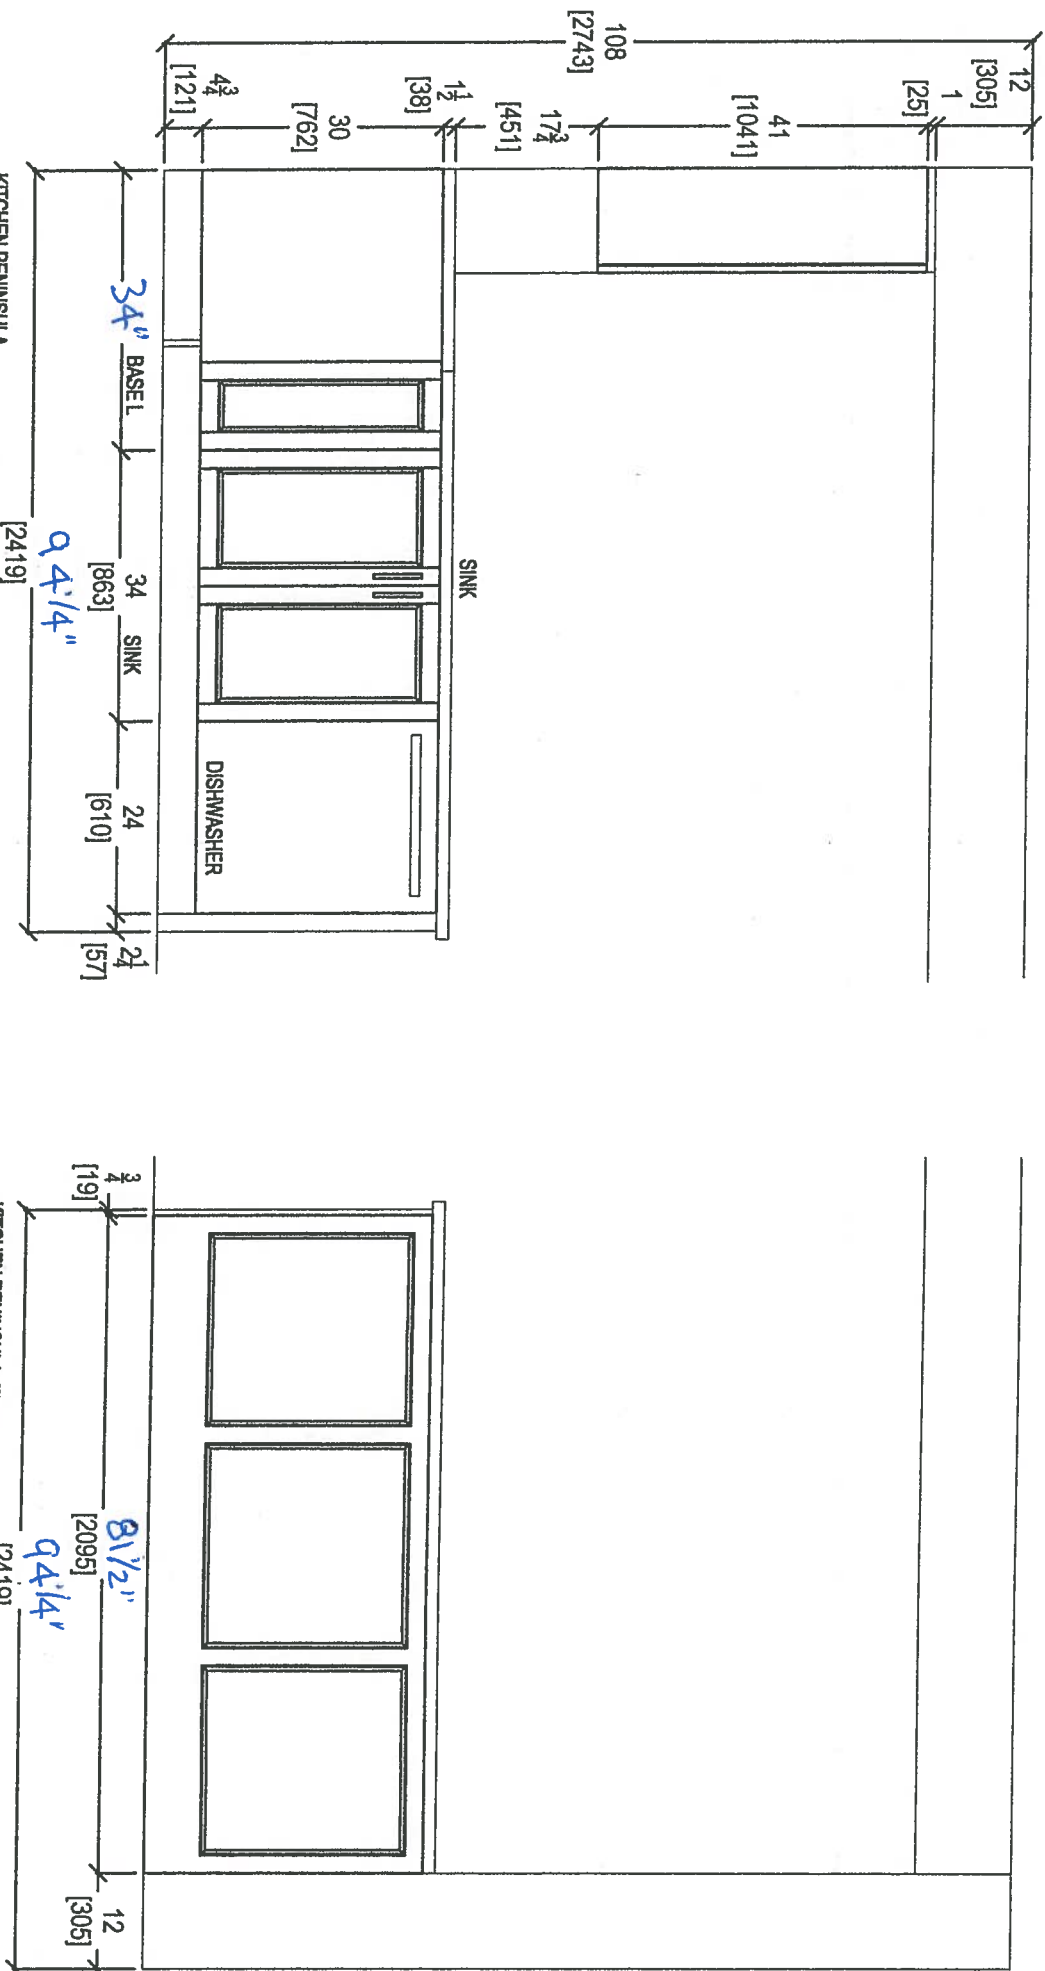





KITCHEN PENINSULA
ELEVATION
FRONT VIEW

KITCHEN PENINSULA ELEVATION
REAR VIEW



Your kitchen, your taste.
80 SANTE DRIVE VAUGHAN, ON L4K 3C4,
T: 416.746.1811 F: 905.761.9901

CLIENT: ROYAL PINE HOMES	UNIT 412 HMP	ROOM: KITCHEN	DRAWN BY: SK	COMMENTS:
SITE: HAMPTON PLACE	DOOR STYLE: --	DOOR HANDLE: --	SCALE: 1/2" = 1' - 0"	PLEASE NOTE ALL DIMENSIONS ARE NOT FINAL AND ARE SUBJECT TO CHANGE UPON FINAL SITE MEASURE
PHONE: --	FINISH: --	DRW HANDLE: --	DATE: FEB 4, 2019	
EMAIL: --	SPECIES: --	TOP: --	PAGE: --	

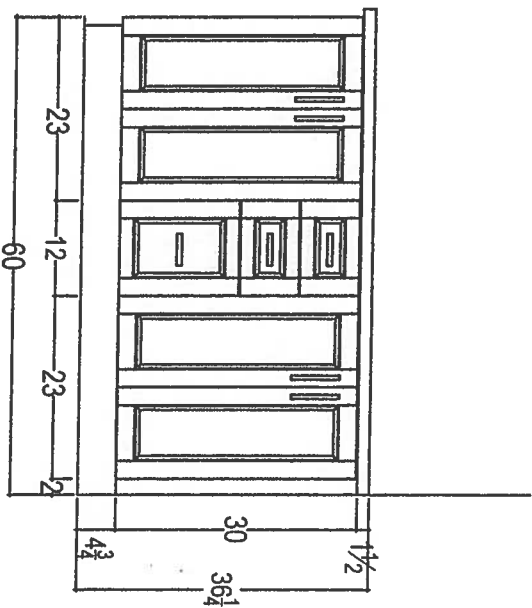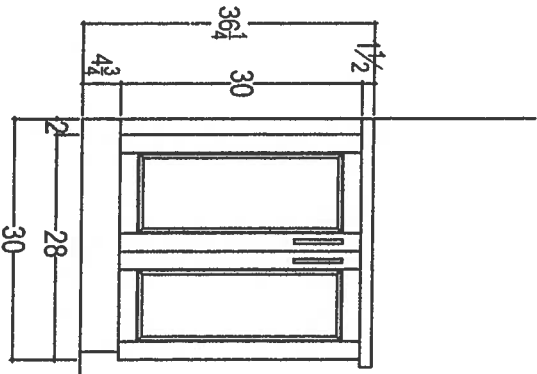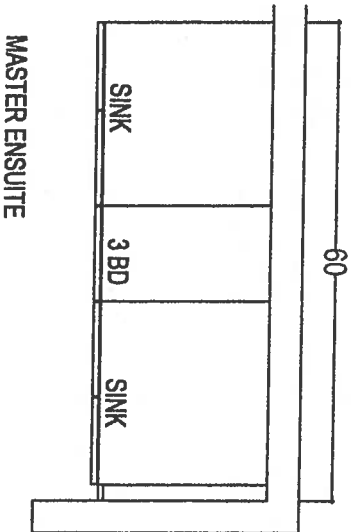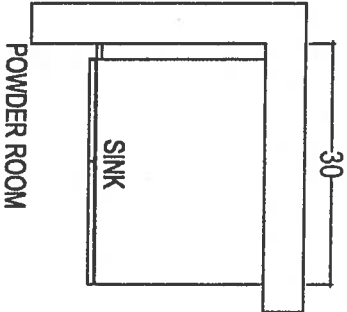

your kitchen, your taste.
80 SANTE DRIVE, VAUGHAN, ON L4K 3C4,
T: 416.746.1811 F: 905.781.5801

CLIENT: ROYAL PINE HOMES	JOB NAME: UNIT 412 HMP	ROOM: VANITIES	DRAWN BY: SK	COMMENTS:
SITE: HAMPTON PLACE	DOOR STYLE: —	DOOR HANDLE: —	SCALE: 1/2" = 1'-0"	PLEASE NOTE ALL DIMENSIONS ARE NOT FINAL AND ARE SUBJECT TO CHANGE UPON FINAL SITE MEASURE
PHONE: —	FINISH: —	DRW HANDLE: —	DATE: FEB 4, 2019	
EMAIL: —	SPECIES: —	TOP: —	PAGE: —	