

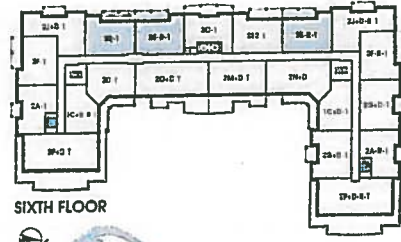


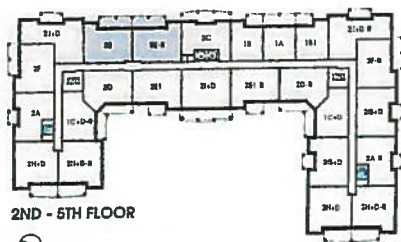

Flanders

SUITE 717
ORIGINAL LAYOUT

1,059 SQ FT *plus* 180 sq. ft. of balcony area

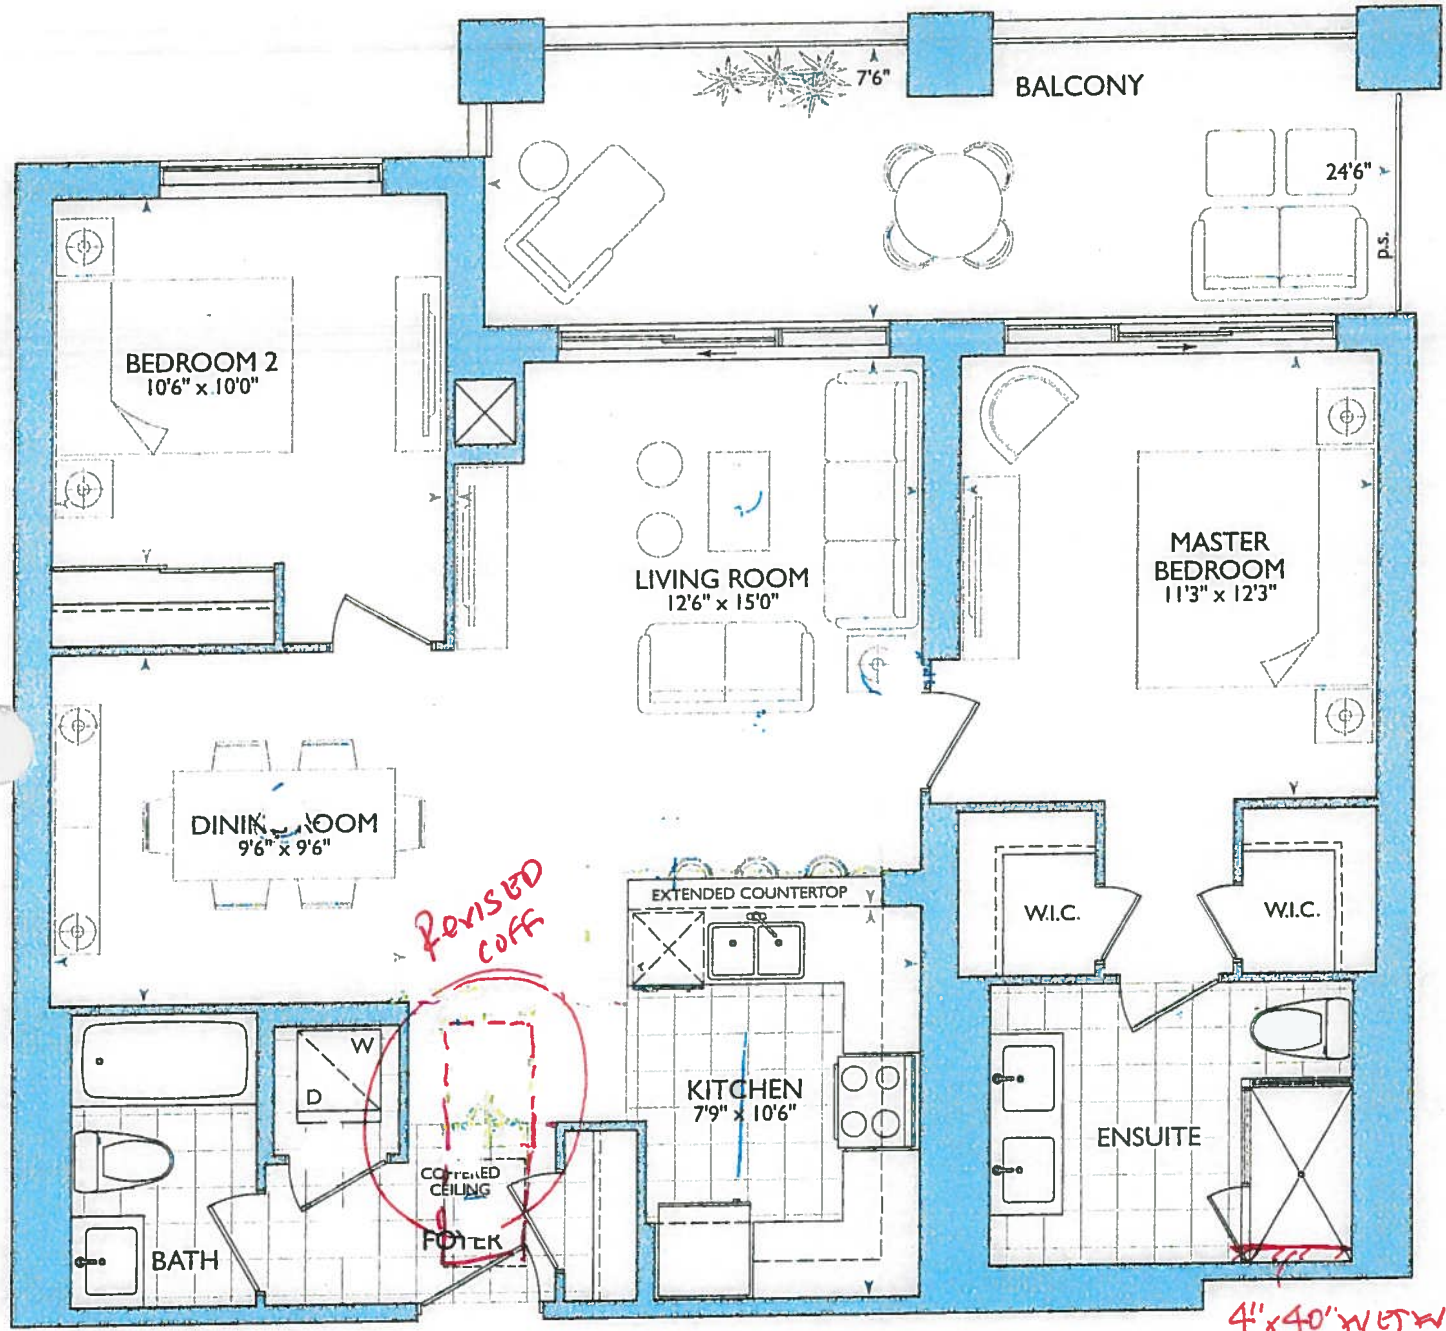

16

VINCE'S COPY

KEVISION



PURCHASER'S EXTRAS (PE)

Hampton Place - Braylea Investments Inc.

PURCHASERS: ROCCO S. QUINTO and LIDIA QUINTO

TEL: RES.: 905-944-9414

LOT NUMBER	PHASE	HOUSE TYPE	REG. PLAN #		
717	1	FLANDERS(2E)			

Item	QTY	Description	Addition to Purchase Price
1		1 - CLARIFICATION - REFER TO PE #7127, ITEM # 1: BEDROOM #2 - Re-locate Vac-Pod Unit to Bedroom #2 Closet. Re-locate Additional Vac-Inlet to living room. (See Sketch) Note: **New Locations Due to On Site Conditions - As per Fonzie C.** **Please Note: Locations of Vac-Pod Unit and Additional Vac Rough-In Inlet are Approximate**	
2		1 - PURCHASER AWARE AND ACCEPTS THAT ANY CHANGES MADE TO UPGRADES AFTER SIGNING THIS PURCHASERS EXTRA FORM ARE SUBJECT TO A MINIMUM ADMINISTRATION FEE OF \$1,000 PLUS A 10% HOLDBACK FEE. Note:	



Sub Total
HST
Total

- In the event the work on the house has progressed beyond the point where the items covered by this extra cannot be installed without entailing any unusual expense, then this order is to be cancelled and any deposit paid in connection with the same is to be refunded to the Purchaser.
- The Vendor will undertake to incorporate the work covered by the sales extra in the construction of the house but will not be liable to the purchaser in any way, if for any reason the work covered by the extra is not carried out. In that event, any monies paid in connection with the same shall be returned to the Purchaser.
- It is understood and agreed that if for any reason whatsoever the transaction of Purchase and Sale is not completed, the total cost of extras ordered are not refundable to the Purchaser(s).
- Extras or changes will not be processed unless signed by the Vendor.
- These extras may not be amended without the written consent of Braylea Investments Inc..
- The Purchaser(s) and the Vendor acknowledge and agree that this form shall not be deemed to be part of the Agreement of Purchase and Sale entered into between them, nor an addendum thereto.
- No Estimates or orders will be accepted once construction has commenced.
- Prices are estimates only and guaranteed for a period of 5 days only.
- Any cancellations to this order, providing they can be cancelled, are subject to a \$500 minimum administration charge and a 10% cancellation charge for the total amount being cancelled.
- For Visa, Mastercard and Debit payments, transactions are identified on you statement as "SHERWAY CONSTRUCTION LTD", an Authorized Visa /Mastercard/Debit Merchant and authorized Royal Pine Homes company.

Payment Summary

Paid By	Amount	Detail
Bonus		
Total Payment:		

Bonus Package From Agreement of Purchase and Sale dated December 01, 2016

Bonus Total	
PE# 7,200 - February 19, 2019	
Remaining Balance	

PURCHASER: _____ 19-Feb-19 _____ CONSULTANT: _____
ROCCO S. QUINTO DATE _____ Melissa Di Marino

PURCHASER: _____ 19-Feb-19 _____ VENDOR: _____
LIDIA QUINTO DATE _____ PER: Braylea Investments Inc.

☐ Decor ☐ Builder ☐ Purchaser

Printed: 19-Feb-19 at 10:29 am

১৫


KITCHEN

- STD K IT. LAYOUT (extends uppers)
- UPG#2 - APPLANCE PKG.
- (x4) - PUCK LIGHTS
- (x1) - PLUG PENINSULA
- (x3) - POTS OVER PENINSULA (sep. switch)
- 63" STOVE PIPE CENTER
- 125" SINK PIPE CENTER

* ENSURE BURIED
4" Due to 4" 140" W
Wm for street
MASTER BED'N +
W.I.C measurement
Revised

RECEIVED
8061708
4x40' WEL
WALL

SUITE 717 - FLANDERS
■ HAMPTON PLACE ■ 25 Baker Hill Blvd -

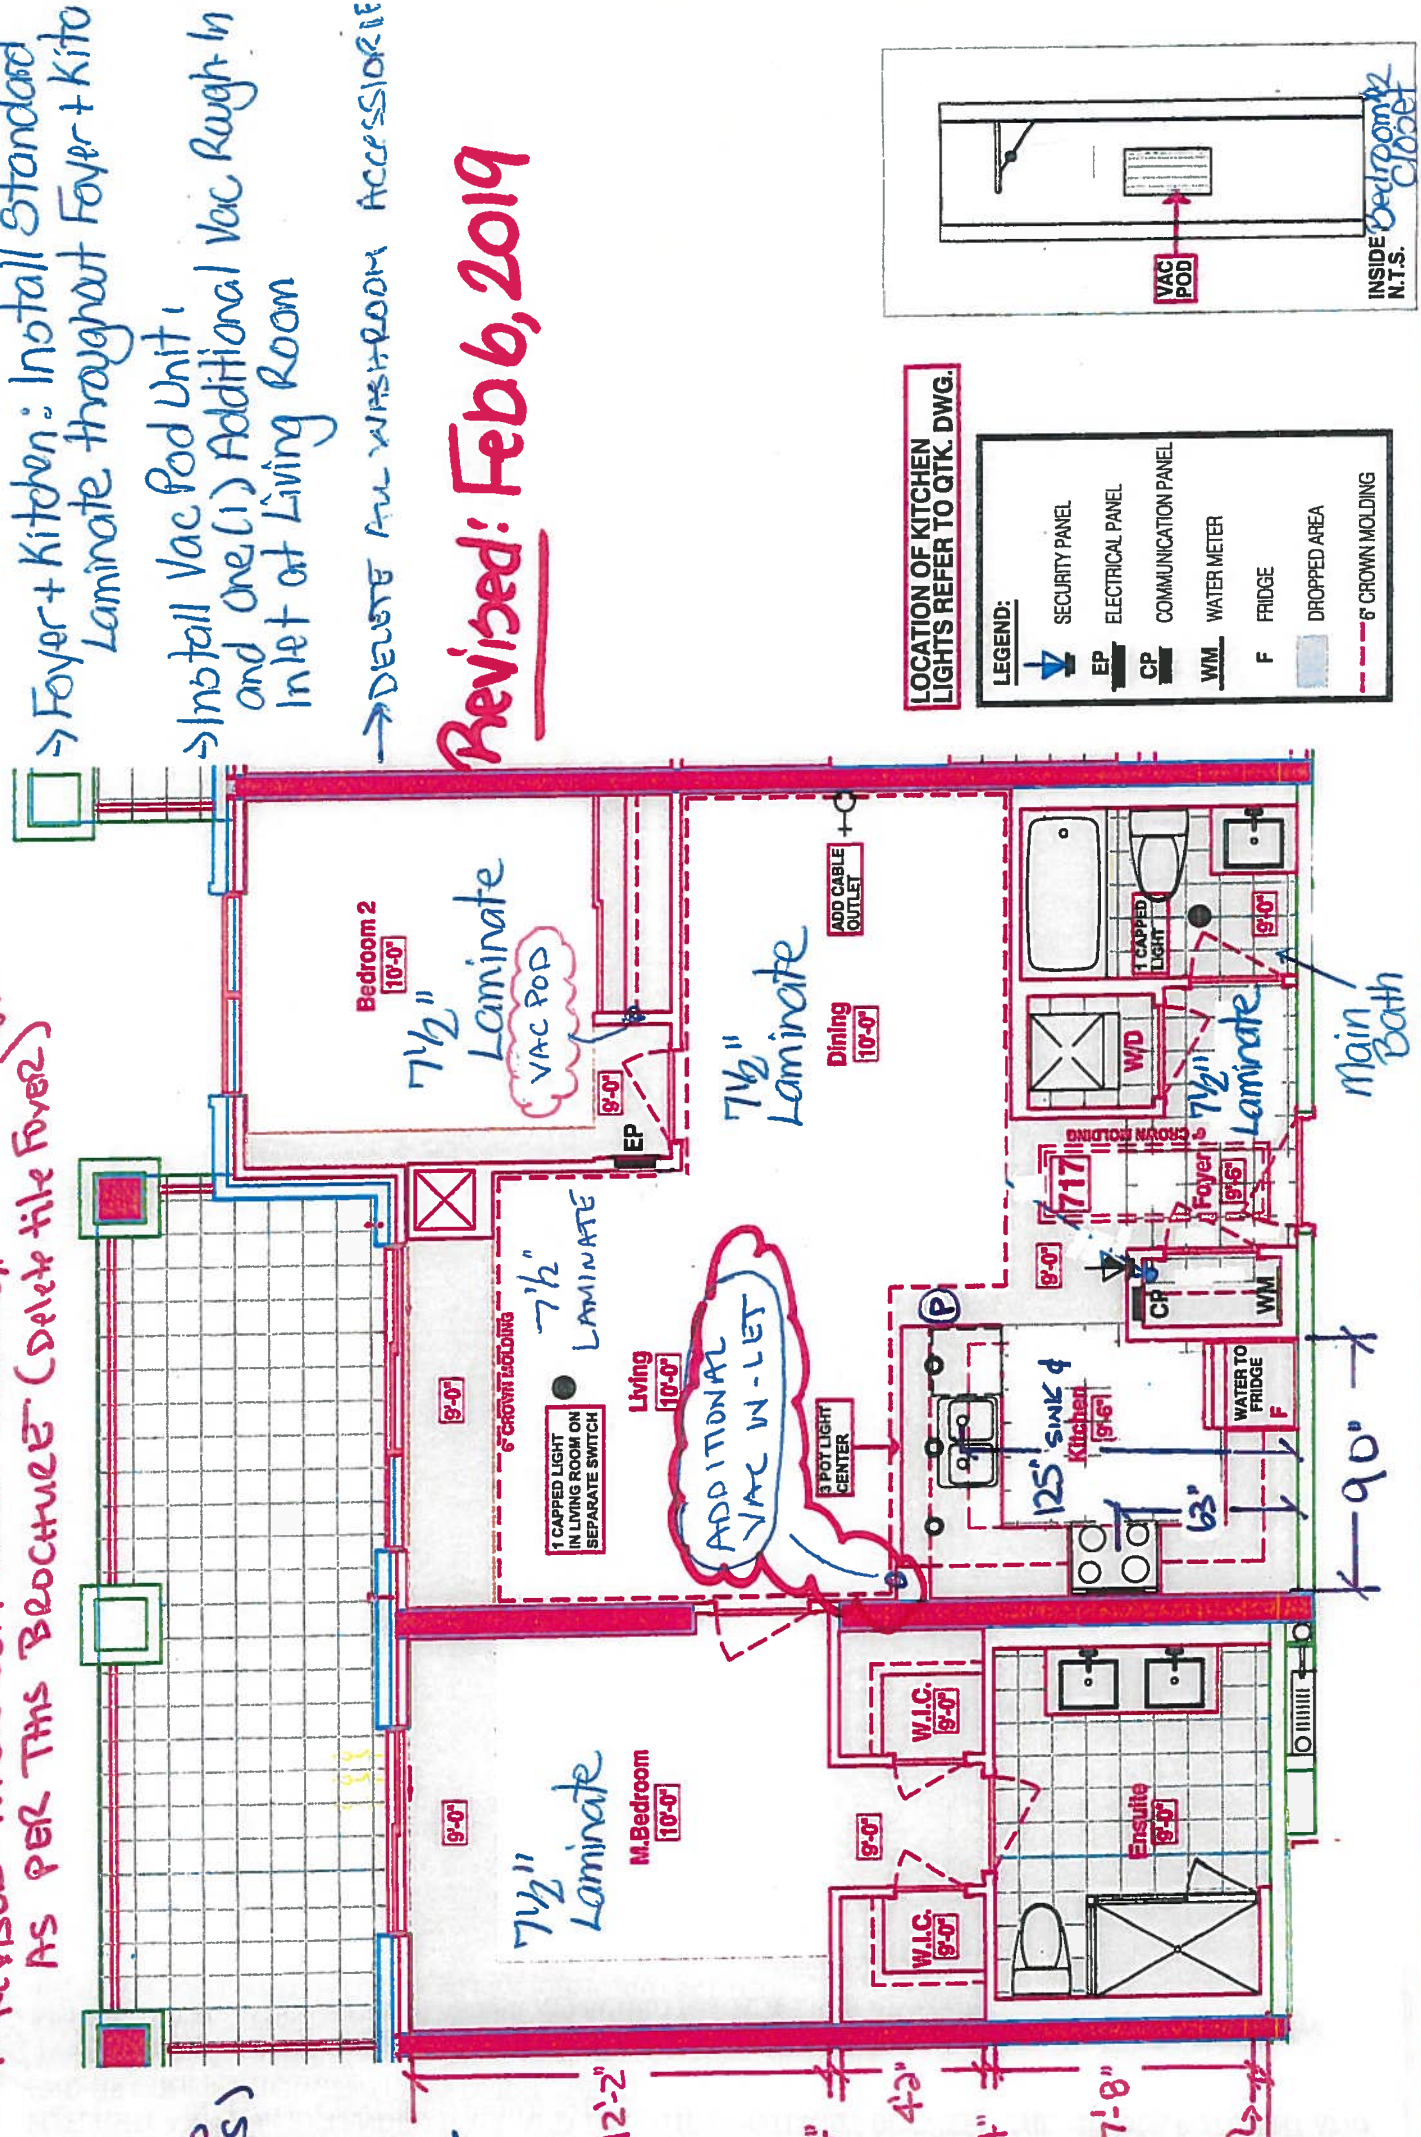

Revised: Feb 6, 2019

SUITE 717 - FLANDERS
 ■ HAMPTON PLACE ■ 25 Baker Hill Blvd - Stouffville, ON ■ Jan 31, 2018



Book
SITE COPY

CONSTRUCTION SUMMARY

Hampton Place

PURCHASERS: ROCCO S. QUINTO and LIDIA QUINTO TEL: RES.: 905-944-9414

LOT NUMBER	PHASE	HOUSE TYPE	CLOSING DATE
717	1	FLANDERS(2E)	22-Nov-18

Offer shee	☒ VENDOR AGREES TO SUPPLY AND INSTALL SMOOTH CEILINGS, AS PER PLAN, EXTENDED UPPER CABINETRY IN KITCHEN AS PER PLAN AND AS PER VENDORS SPECIFICATIONS, AND EXTENDED INTERIOR DOORS AS PER PLAN AND AS PER VENDORS SPECIFICATIONS. Note:
Offer Workshee	☒ PURCHASER TO SELECT LOCKER LOCATION ON 7TH FLOOR Note:
Offer Upgrade	☒ INSTALL ADDITIONAL CEILING CAPPED OUTLET IN LIVING ROOM ON SEPARATE SWITCH AS PER SKETCH. Note:
Offer Upgrade	☒ INSTALL ADDITIONAL CABLE OUTLET IN DINING ROOM SEE SKETCH FOR LOCATION. Note:
Offer Upgrade	☒ DO NOT INSTALL CERAMIC ACCESSORIES IN ALL BATHROOMS. Note:
Offer Upgrade	☒ INSTALL 3 POTLIGHTS OVER PENINSULA. ONE POTLIGHT IN THE MIDDLE BETWEEN EXTENDED WALL (BY EXTENDED COUNTERTOP) AND END OF COUNTERTOP BY FOYER. ONE POTLIGHT BETWEEN THE MIDDLE POTLIGHT AND THE EXTENDED WALL AND THE OTHER POTLIGHT BETWEEN THE MIDDLE POTLIGHT AND END OF COUNTERTOP CENTERED IN BULKHEAD. Note:
Offer Upgrade	☒ WATER LINE FOR FRIDGE Note:
Offer Upgrade	☒ INSTALL ONE CAPPED CEILING OUTLET IN MAIN BATHROOM NOT ON SEPARATE SWITCH CENTERED BETWEEN WALL AND BATHTUB AS PER ATTACHED SKETCH Note:



SITE COPY

CONSTRUCTION SUMMARY

Hampton Place

PURCHASERS: ROCCO S. QUINTO and LIDIA QUINTO

TEL: RES.: 905-944-9414

LOT NUMBER	PHASE	HOUSE TYPE	CLOSING DATE	
717	1	FLANDERS(2E)	22-Nov-18	

Date Added: 26-Feb-18 Invoice Number: 7127

1 - FOYER CLOSET - Install VAC-POD at Foyer Closet (Includes 30ft. air hose package)
Include; ONE (1) ADDITIONAL VAC-ROUGH-IN INLET at living room. (See Sketch)
Note:

1 - FOYER & KITCHEN - Install Standard Laminate Flooring throughout Foyer and Kitchen in lieu of builders standard porcelain tiles (See Sketch)
Note:

1 - LAUNDRY ROOM - 2ND UPGRADE - PORCELAIN TILES - 13x13 HELLO SILVER - To be installed throughout laundry room floor (See Sketch)
Note:

1 - KITCHEN & BATHROOMS - Purchaser has DECLINED All Upgrades offered during decor appointment at the decor centre for kitchen & bathroom cabinetry. Standard Kitchen Layout & Standard Bathroom Vanities to be installed as per standard plan. (See Sketch)
Note:

1 - KITCHEN - Install Standard Granite Countertop - SERENATA - To be installed throughout kitchen, where applicable (does not include granite backsplash) (See Sketch)
Note:

1 - DISCLAIMER - GRANITE COUNTERTOP;
KITCHEN - Due to the many variables that can affect the pattern, colour and/or design and "pitting" of natural products, granite installed will not be identical to the samples displayed.
Note: Every effort is made to provide granite countertops as close as possible but the vendor is not responsible for results which differ from the sample displayed. All countertop surfaces may have seams, and product pattern and shade can change in areas containing seams.

1 - DISCLAIMER - STONE COUNTERTOP;
KITCHEN - Stone slabs vary in size & all seams are visible & the fabricator reserves the right to position the seams as necessary.
Note:

1 - KITCHEN - Kitchen Sink - Install Standard Undermount Sink - BLANCO Horizon Plus U2 Undermount Sink (8") - Model # 401234
Note:

1 - KITCHEN - Kitchen Faucet - Install Standard Faucet - DELTA Chrome Pull-Out Kitchen Faucet (Single Hole) - Model # 469LF - Chrome
Note:

1 - KITCHEN - Kitchen Backsplash - Install Standard 3x6 SUBWAY WHITE Backsplash Tile in UPGRADE BRICK PATTERN - To be installed throughout kitchen, where applicable (Does not include behind the fridge or stove) (See Sketch)
Note:

1 - APPLIANCE PACKAGE - Install Upgrade Appliance Package - UPGRADE PACKAGE #2 - To be installed throughout suite, where applicable (See Sketch)
Note:

1 - CLARIFICATION;
MAIN BATH & MASTER ENSUITE - Install Standard 3" Splash throughout Main Bath and Master Ensuite vanity countertop, where applicable (See Sketch)
Note:

1 - DISCLAIMER - STONE COUNTERTOP;
MAIN BATH & MASTER ENSUITE - Stone slabs vary in size & all seams are visible & the fabricator reserves the right to position the seams as necessary.
Note:

1 - CLARIFICATION;
MASTER ENSUITE - Purchaser accepts & acknowledges the standard frameless glass enclosure at master ensuite shower stall will NOT touch the ceiling and will receive a Standard Chrome Header. (See Sketch)
Note:



SITE COPY

CONSTRUCTION SUMMARY

Hampton Place

PURCHASERS: ROCCO S. QUINTO and LIDIA QUINTO

TEL: RES.: 905-944-9414

LOT NUMBER	PHASE	HOUSE TYPE	CLOSING DATE
717	1	FLANDERS(2E)	22-Nov-18

Date Added: 26-Feb-18 Invoice Number: 7127

1 - CLARIFICATION;
N BATH & MASTER ENSUITE - Install Standard Plumbing Fixtures throughout Main Bath and Master Ensuite where applicable (See Sketch)
:

1 - PURCHASER HAS ATTENDED A COLOR APPOINTMENT AT THE DECOR CENTRE AND HAS DECLINED ANY ADDITIONAL UPGRADES. Purchaser accepts and acknowledges that there will be no further changes/additions/deletions to be made upon signing on February 26,2018
Note:

1 - PURCHASER AWARE AND ACCEPTS THAT ANY CHANGES MADE TO UPGRADES AFTER SIGNING THIS PURCHASERS EXTRA FORM ARE SUBJECT TO A MINIMUM ADMINISTRATION FEE OF \$1,000 PLUS A 10% HOLDBACK FEE.
Note:

This Document is Extremely Time Sensitive - Printed 10 May 18 at 16:05



Purchasers		Decor Consultant		Model Type		Telephone Res. / Bus		Project		Closing Date		Unit	
ROCCO S. QUINTO & LIDIA QUINTO		Melissa Di Marino		FLANDERS(2E)		(905) 944-9414 /		Hampton Place		22/11/2018		717	

MASTER ENSUITE

MAIN BATHROOM

POWDER ROOM

KITCHEN / DINETTE

FOYER

LAUNDRY

LIVING ROOM

DINING ROOM

DEN

MASTER BEDROOM

BEDROOM 2

BEDROOM 3

Flooring		Wall Tile	
Description		Main	
13x13 RUSTIC GREY (STD)	✓	8x10 NATURALE GRIGIO (STD)	NONE
13x13 HELLO SILVER (STD)	✓	8x10 GOLF GRIGIO (STD)	NONE
N/A		N/A	N/A
7 1/2" TorleysForest - Okanogan 9742P (UPG)	✓	3x6 SUBWAY WHITE (BrickPattern)(Upg)	NONE
7 1/2" TorleysForest - Okanogan 9742P (UPG)	✓	N/A	N/A
13x13 HELLO SILVER (UPG)	✓	N/A	N/A
7 1/2" TorleysForest - Okanogan 9742P (STD)	✓		
7 1/2" TorleysForest - Okanogan 9742P (STD)	✓		
N/A			
7 1/2" TorleysForest - Okanogan 9742P (STD)	✓		
7 1/2" TorleysForest - Okanogan 9742P (STD)	✓		
N/A			

Notes

Consultant:	Purchaser:	Vendor:
Melissa Di Marino	ROCCO S. QUINTO	LIDIA QUINTO



* INTERIOR CLOUR SCHEME *

Purchasers ROCCO S. QUINTO & LIDIA QUINTO		Decor Consultant Melissa Di Marino	Model Type FLANDERS(2E)	Telephone Res. / Bus (905) 944-9414 /	Project Hampton Place	Closing Date 22/11/2018	Unit 717
--	--	---------------------------------------	----------------------------	--	--------------------------	----------------------------	-------------

Page 2 of 3

CABINETRY, VANITIES AND COUNTERTOPS

	Style	Countertop	Counter Edge	Handle / Knob
MAIN BATHROOM	☒ CATEGORY 1 - FIBERBOARD - WHITE QT 1203 (STD)	☒ ASPEN TERRA WHITE (STD)	☒ 1" A" EDGE (STD)	3487-128
MASTER ENSUITE	☒ CATEGORY 2 - MAPLE - CHESTNUT QT 2503 (STD)	☒ ASPEN TERRA WHITE (STD)	☒ 1" A" EDGE (STD)	3487-128
POWDER ROOM	☐ N/A	☐ N/A	☐ N/A	N/A
KITCHEN / DINETTE	☒ CATEGORY 1 - FIBERBOARD - WHITE QT 1203 (STD)	☒ SERANATA GRANITE (STD)	☒ 1" A" EDGE (STD)	3487-128
LAUNDRY ROOM	☐ N/A	☐ N/A	☐ N/A	N/A
	☐	☐	☐	
	☐	☐	☐	

APPLIANCE PACKAGE
upgrade
Package #2
Std 31in Opening

PLUMBING FIXTURES

KITCHEN	
Sink Model	☒ STANDARD
Sink Faucet	☒ STANDARD
TOILETS	
Master Ensuite	☒ STANDARD
Main Bathroom	☒ STANDARD
Powder Room	☐ N/A
VANITY FAUCETS	
Master Ensuite	☒ STANDARD
Main Bathroom	☒ STANDARD
Powder Room	☐ N/A

VANITY SINKS

Master Ensuite	☒ STANDARD
Main Bathroom	☒ STANDARD
Powder Room	☐ N/A

SHOWER STALL / TUBS

Master Ensuite Shower Stall	☒ STANDARD
Master Ensuite Tub	☐ N/A
Main Bathroom Tub	☒ STANDARD

Trim	
Baseboard & Casing	☒ STANDARD
Interior Doors	☒ STANDARD - CARRARA, SMOOTH

Levers ☒ STANDARD
Door Height ☒ STANDARD

Cornice Moulding / Medallion

Foyer	☒ STANDARD - #CTR-611
Living Room	☒ STANDARD - #CTR-611
Dining Room	☒ STANDARD - #CTR-611
Den	☐ N/A
Master Bedroom	☐ NONE
Bedroom 2	☐ N/A
Bedroom 3	☐ N/A

Fireplace

Fireplace	☐ N/A
Location Flooring	☐ N/A
Style	☐ N/A
Finish	☐ N/A
Marble	☐ N/A
Hearth	☐ N/A

Paint Throughout


Walls	Trim
☒ STANDARD - BIRCH WHITE	☒ STANDARD - WHITE

MISC. INSTALLATIONS
Ceramic Accessories
(installed by Vendor) ☒ Yes ☐ No
Bathroom Mirrors
(installed by Vendor) ☒ Yes ☐ No
Wire Shelving - Closet
(installed by Vendor) ☒ Yes ☐ No

Page 2 of 3

Decor Consultant: Melissa Di Marino
Purchaser: Rocco Quinto
Lidia Quinto
Hampton Place
Printed Feb 26, 2018 12:14 pm

Handwritten: **THE END**
Hampton

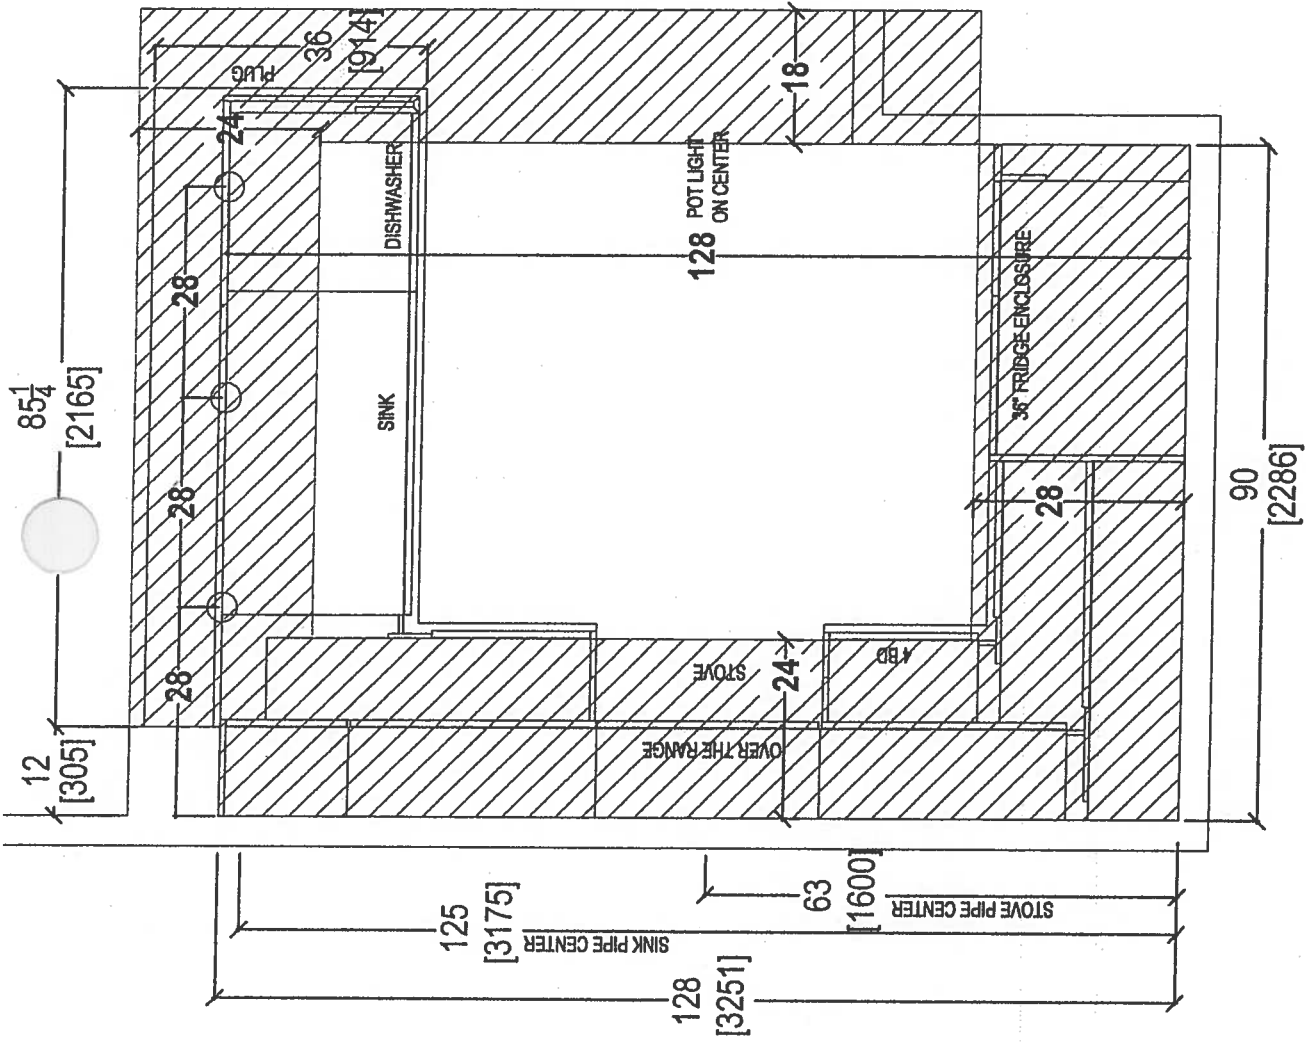



- STD KITCHEN LAYOUT
- UPG #2- APPLIANCE PKG.
- $(x4)$ = RUCK LIGHTS
- $(x1)$ = PLUG PENINSULA
- $(x3)$ = POTS OVER PENINSULA



your kitchen. your taste.

80 SANTE DRIVE, VAUGHAN, ON L4K 3C4,
T: 416.748.1811 F: 905.761.5901


CLIENT: ROYAL PINE HOMES	JOB NAME: UNIT 717 HMP	ROOM:	KITCHEN FLOOR PLAN	DRAWN BY: SK	COMMENTS: PLEASE NOTE ALL DIMENSIONS ARE NOT FINAL AND ARE SUBJECT TO CHANGE UPON FINAL SITE MEASURE
SITE: HAMPTON PLACE	DOOR STYLE: ---	DOOR HANDLE: ---	SCALE: 1/2" = 1' - 0"		
PHONE: ---	FINISH: ---	DRW HANDLE: ---	DATE: APRIL 28, 2018		
EMAIL: ---	SPECIES: ---	TOP: ---	PAGE:		

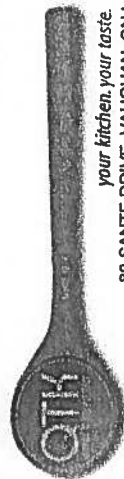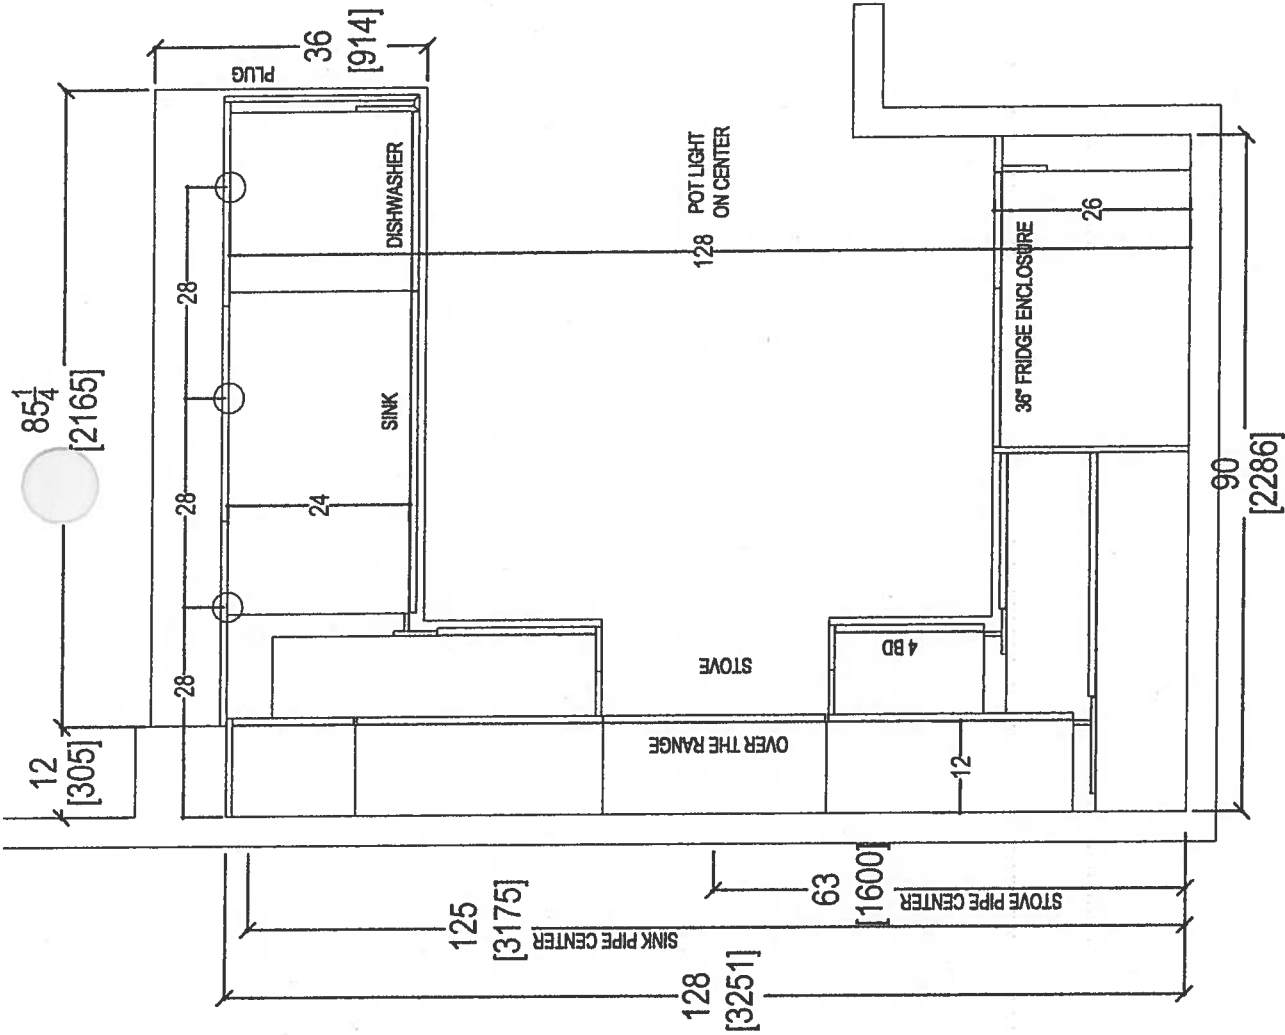

your kitchen. your taste.
80 SANTE DRIVE, VAUGHAN, ON L4K 3C4,
T: 416.746.1611 F: 905.761.5601

CLIENT: ROYAL PINE HOMES		JOB NAME: UNIT 717 HMP	ROOM: KITCHEN FLOOR PLAN	DRAWN BY: SK	COMMENTS: PLEASE NOTE ALL DIMENSIONS ARE NOT FINAL AND ARE SUBJECT TO CHANGE UPON FINAL SITE MEASURE
SITE: HAMPTON PLACE	DOOR STYLE: —	DOOR HANDLE: —	SCALE: 1/2" = 1'-0"		
PHONE: —	FINISH: —	DRW HANDLE: —	DATE: APRIL 28, 2018		
EMAIL: —	SPECIES: —	TOP: —	PAGE:		


6

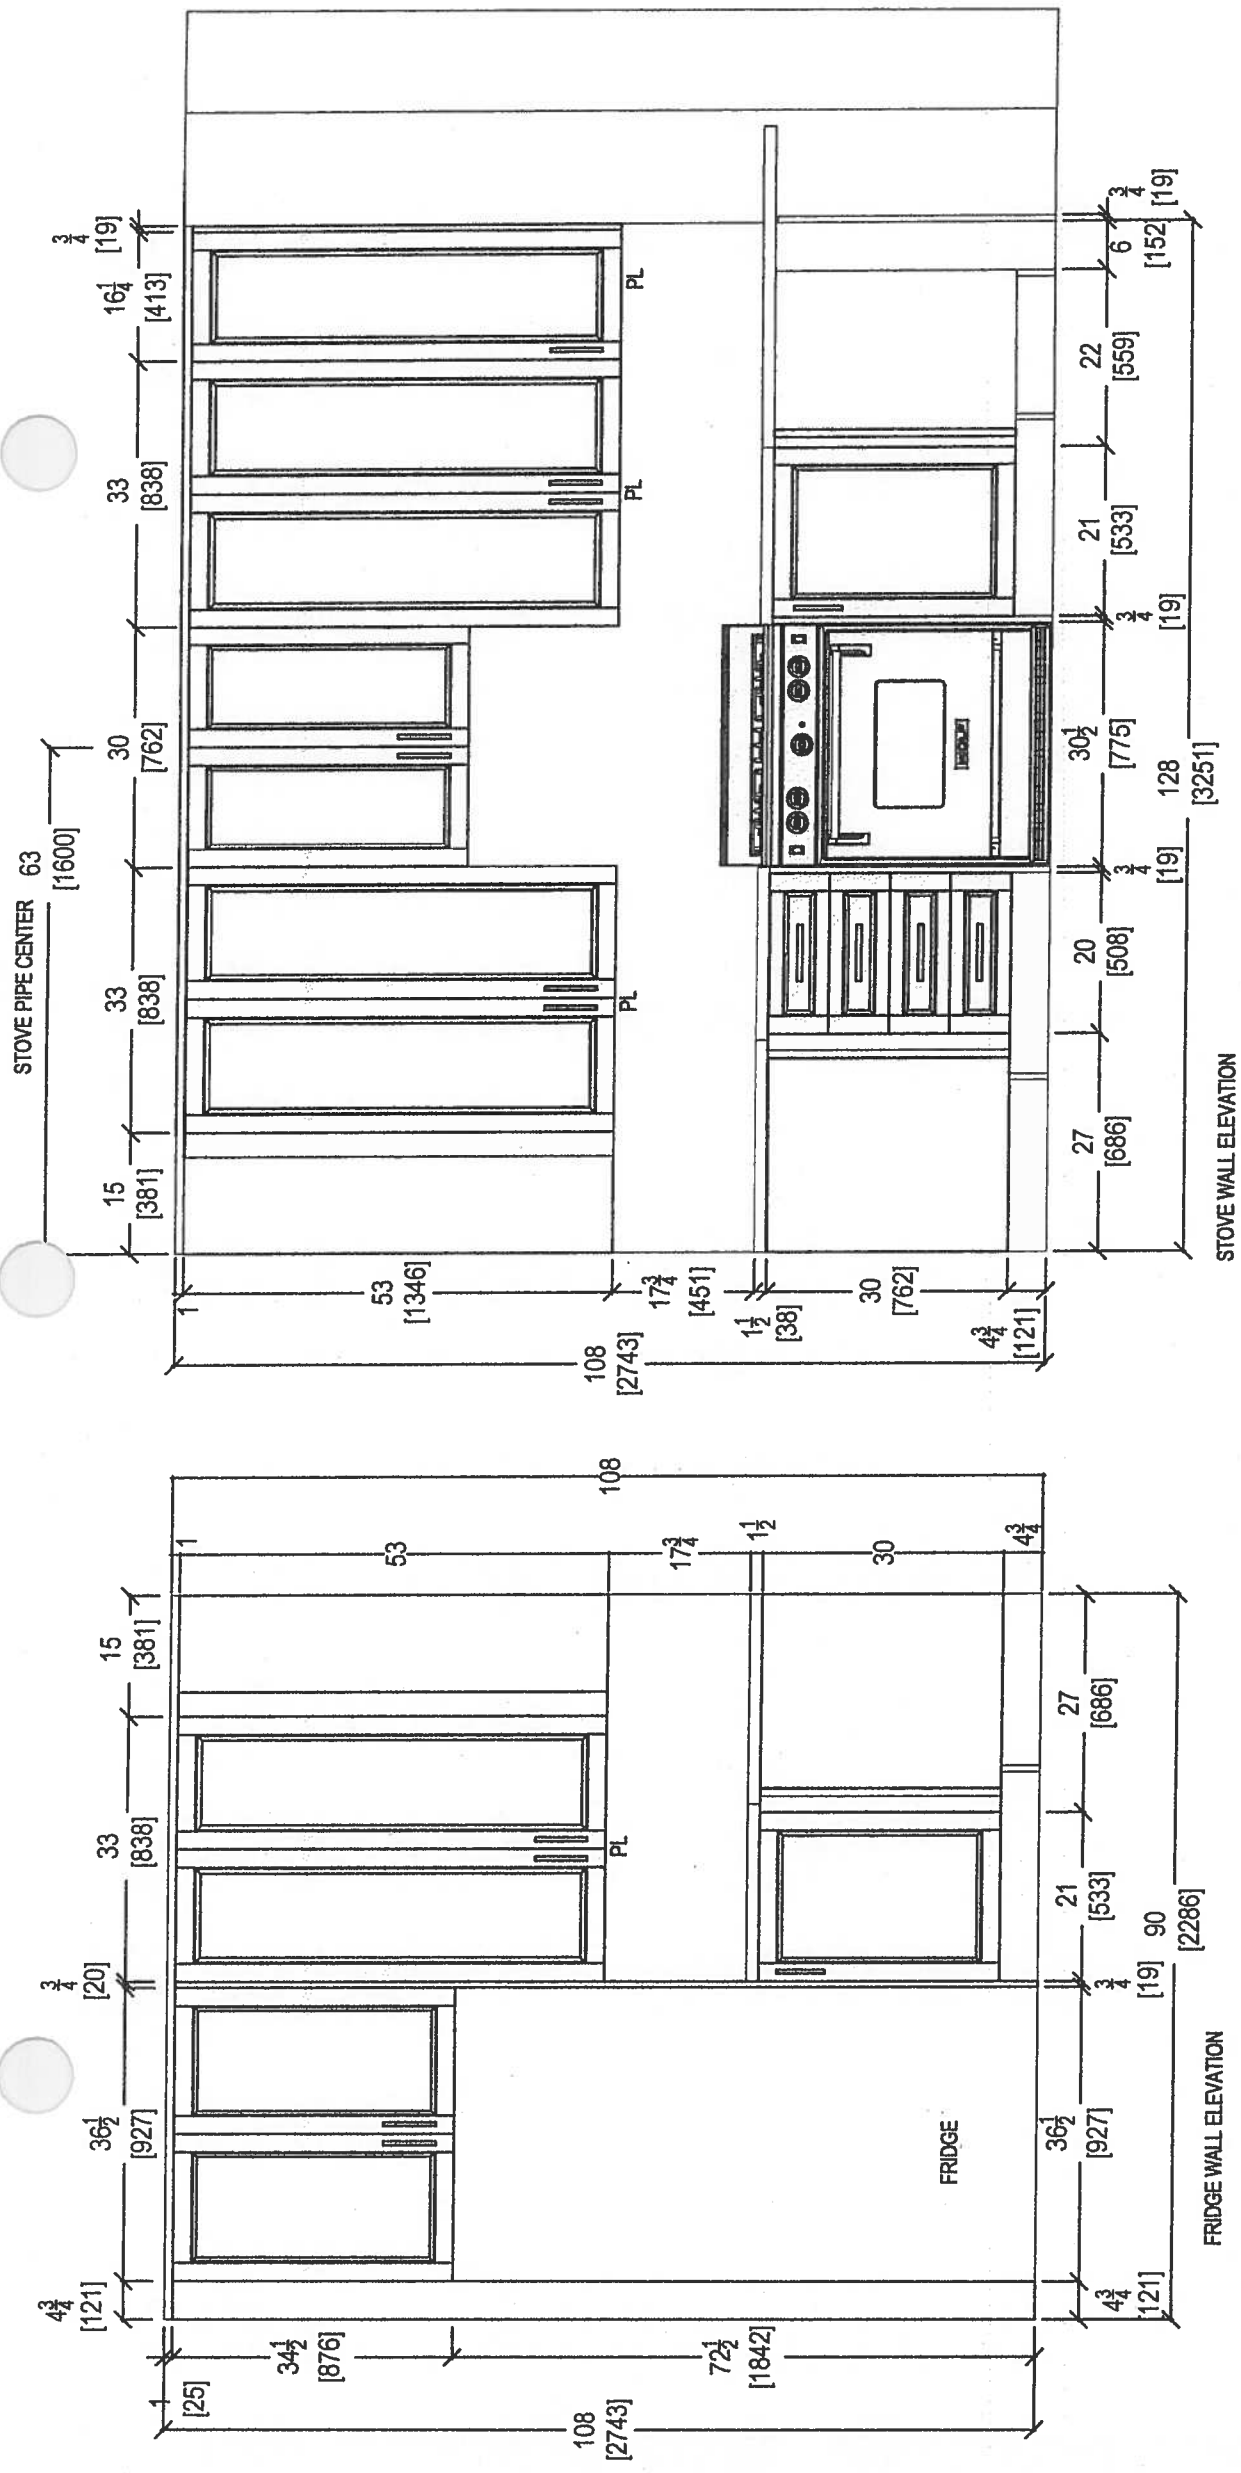

80 SANTE DRIVE, VAUGHAN, ON L4K 3C4,
T: 416.748.1811 F: 905.761.5901

CLIENT: ROYAL PINE HOMES SITE: HAMPTON PLACE PHONE: --- EMAIL: ---	JOB NAME: UNIT 717 HMP	ROOM: KITCHEN	DRAWN BY: SK	COMMENTS: PLEASE NOTE ALL DIMENSIONS ARE NOT FINAL AND ARE SUBJECT TO CHANGE UPON FINAL SITE MEASURE
	DOOR STYLE: ---	DOOR HANDLE: ---	SCALE: 1/2" = 1' - 0"	
	FINISH: ---	DRW HANDLE: ---	DATE: APRIL 28, 2018	
	SPECIES: ---	TOP: ---	PAGE:	




6

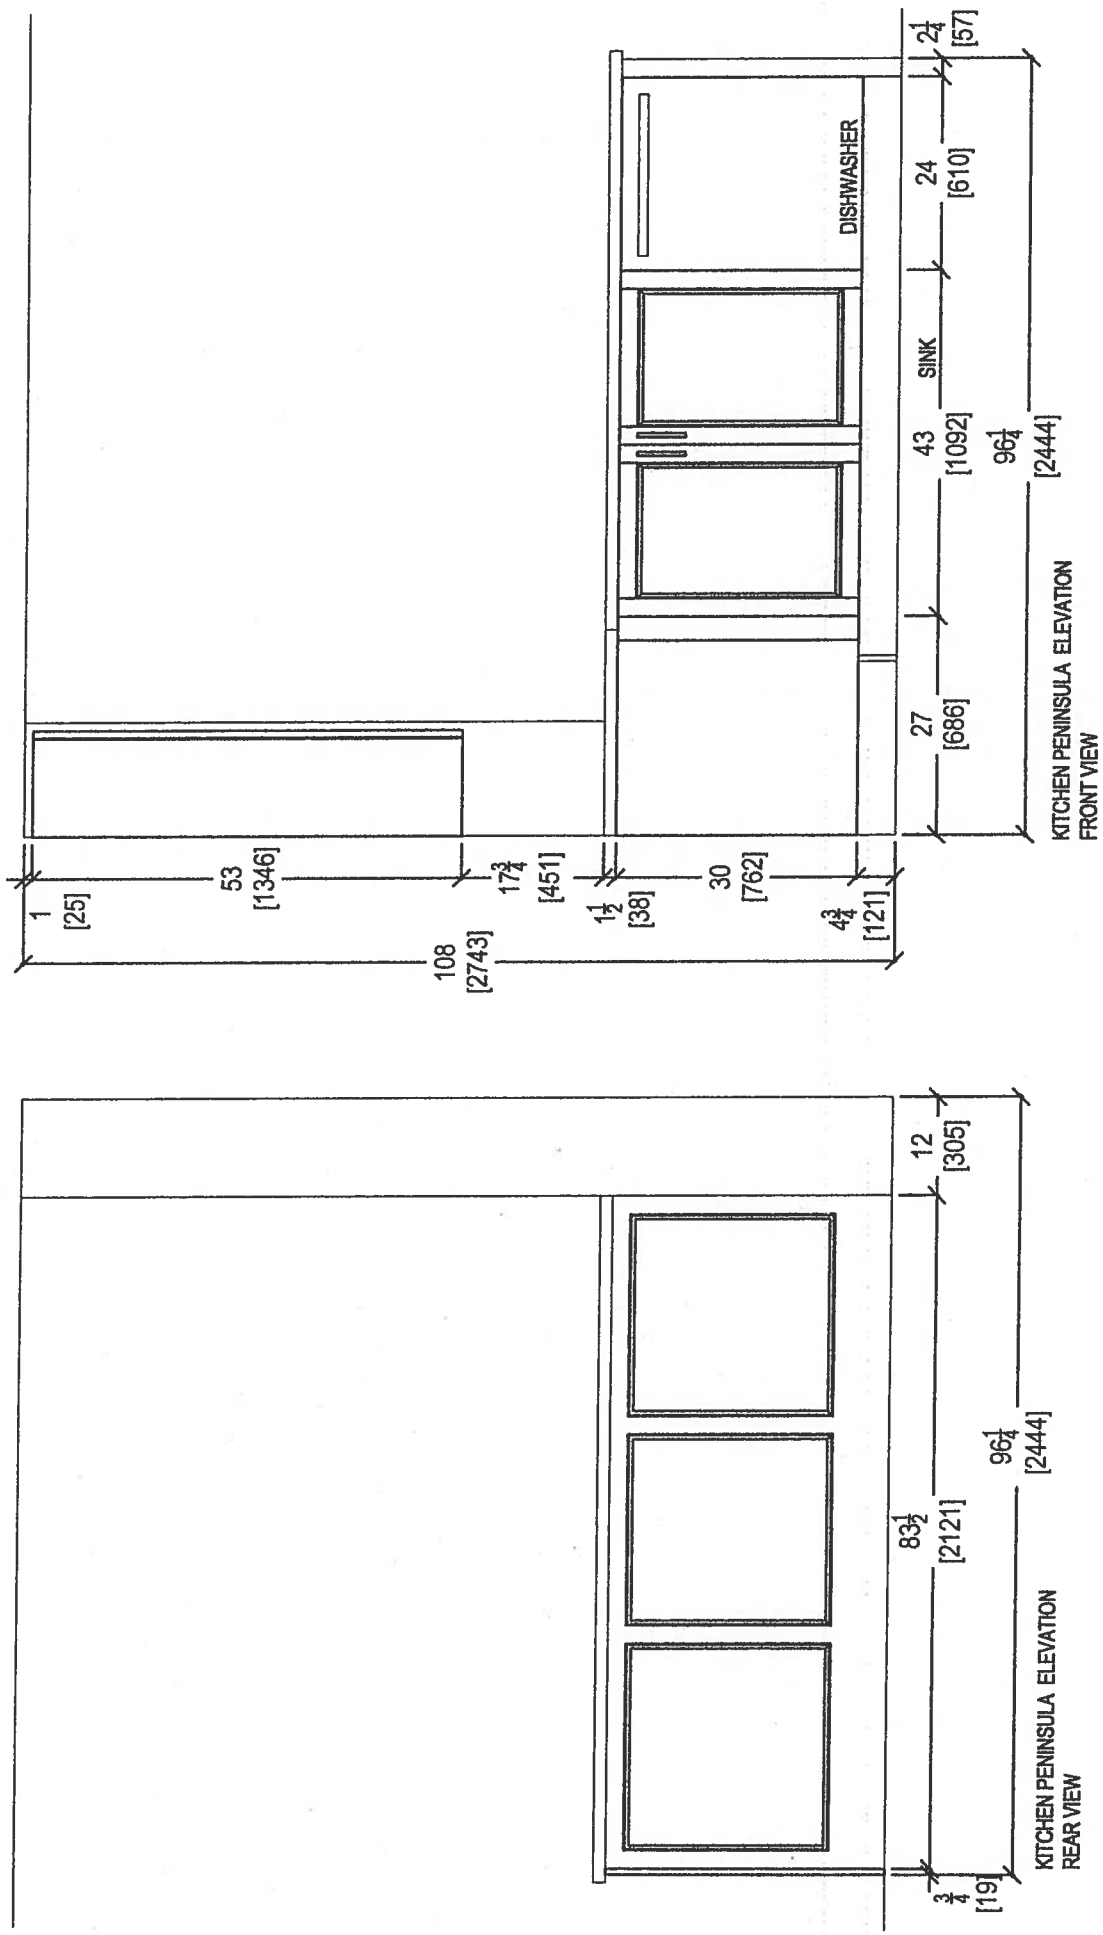

80 SANTE DRIVE, VAUGHAN, ON L4K 3C4,
T: 416.746.1811 F: 905.781.5901

CLIENT: ROYAL PINE HOMES		JOB NAME: UNIT 717 HMP	ROOM: KITCHEN	DRAWN BY: SK		COMMENTS: PLEASE NOTE ALL DIMENSIONS ARE NOT FINAL AND ARE SUBJECT TO CHANGE UPON FINAL SITE MEASURE
SITE: HAMPTON PLACE	DOOR STYLE: —	DOOR HANDLE: —	SCALE: 1/2" = 1' - 0"			
PHONE: —	FINISH: —	DRW HANDLE: —	DATE: APRIL 28, 2018			
EMAIL: —	SPECIES: —	TOP: —	PAGE:			

9

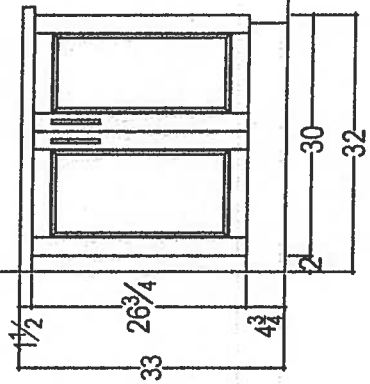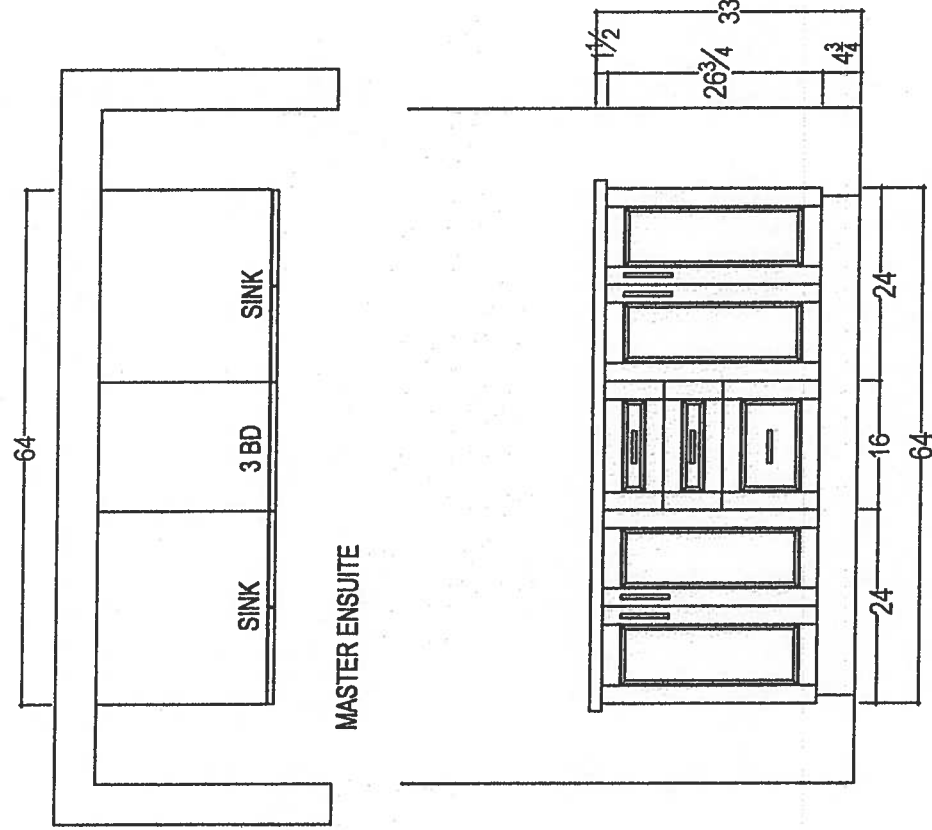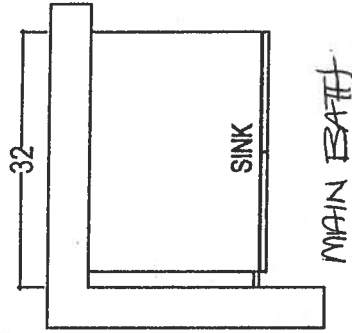

80 SANTE DRIVE, VAUGHAN, ON L4K 3C4,
T: 416.746.1811 F: 905.761.5901

CLIENT: ROYAL PINE HOMES		JOB NAME: UNIT 717 HMP	ROOM:	VANITIES	DRAWN BY: SK	COMMENTS: PLEASE NOTE ALL DIMENSIONS ARE NOT FINAL AND ARE SUBJECT TO CHANGE UPON FINAL SITE MEASURE
SITE: HAMPTON PLACE	LOT #:		DOOR HANDLE: —		SCALE: 1/2" = 1' - 0"	
PHONE: —	FINISH: —		DRW HANDLE: —		DATE: APRIL 28, 2018	
EMAIL: —	SPECIES: —		TOP: —		PAGE:	

Suite 717
Hampton

Upgrade
Package 2

L-8 R-8

INSIDEADVANTAGE™



<http://www.insideadvantage.com>

Product Dimensions:

Height: 72
Width: 35 3/4
Depth: 30 1/4

Electrical Requirements:

15 Amps.

Available In:

- ☐ Stainless Steel
- ☒ Black
- ☐ White


KRFC302ESS

22 cu.ft. 36-Inch Width Counter Depth French Door Refrigerator
with Interior Dispense

KRFC302ESS

Key Features:

- ExtendFresh™ Temperature Management System
- Interior Water Dispenser
- Professionally-Inspired Design
- Produce Preserver
- Humidity-Controlled Crispers
- FreshChill™ Temperature-Controlled Full-Width Pantry
- Pull-Out Tri-Level Freezer Drawer
- SatinGlide® System
- LED Lighting
- Star-K Certified
- Automatic Ice Maker
- Max Cool

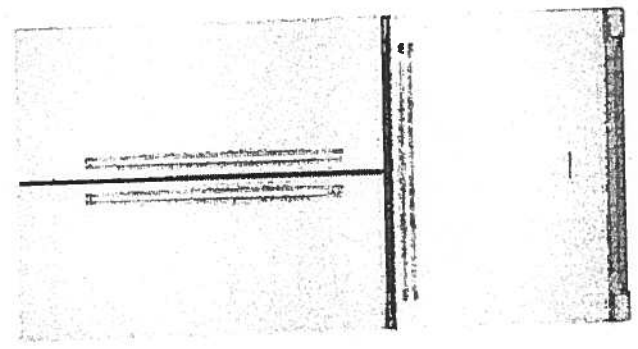

MADE IN
AMERICA

Because Whirlpool Corporation policy includes a continuous commitment to improve our products, we reserve the right to change materials and specifications without notice. We also reserve the right to discontinue or transition products without notice.
Reg. Registered trademark/TM Trademark of Whirlpool U.S.A. © 2013 Whirlpool Corporation. All Rights Reserved. All other trademarks are owned by their respective companies.
Created On: Wednesday, April 22, 2015 15:51:04

Suite 717 Hampton Upgrade Package 2



KMHP519ESS

1000-Watt Convection Microwave with High-Speed
Cooking - 30"

KitchenAid

<http://www.kitchenaid.com>

Key Features:

- High-Speed Cooking
- Convection Cooking
- Professionally-Inspired Design Including Handle, Badge, Graphics, Chrome Chamfer.
- Cookshield Finish
- Crispwave™ Technology and Crisper Pan
- 1200 Watts Power
- 1.9 Cu. Ft. Capacity
- Halogen Cavity Lights and Task Light
- Steam Cleaning Function
- Keep Warm Function
- Sound-Based Popcorn Function

Product Dimensions:

Height: 17 1/8

Width: 30

Depth: 17

Electrical Requirements:

15.


Additional Information:

[Use And Care](#)

[Dimension Guide](#)

[Installation Guide](#)

[Warranty](#)

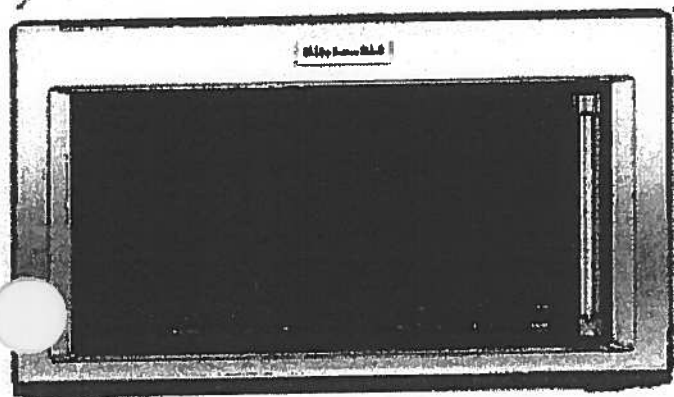

Available In:



Stainless Steel

®Registered trademark/TM Trademark of Whirlpool, U.S.A. © 2016 Whirlpool Corporation. All Rights Reserved. All other trademarks are owned by their respective companies.

Because Whirlpool Corporation policy includes a continuous commitment to improve our products, we reserve the right to change materials and specifications without notice. We also reserve the right to discontinue or transition products without notice.

Manufacturer's Suggested Retail Price (MSRP) and Minimum Advertised Price (MAP) provided for reference purposes only. Dealer alone determines advertised and retail prices.

Suite 717
Hampton

Upgrade
Package 2




KSEB900ESS

KitchenAid

36-Inch 5-Element Electric Convection Slide-In
Range with Baking Drawer

<http://www.kitchenaid.com>

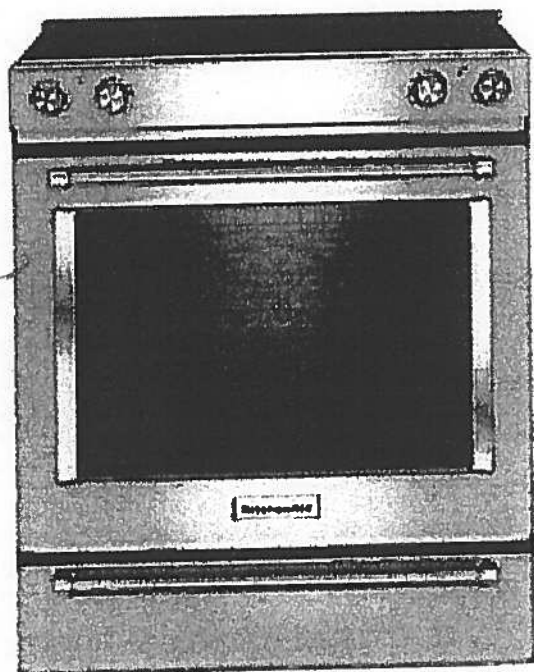

Key Features:

- Baking Drawer
- Even-Heat™ True Convection
- Wireless Probe
- Steam Rack
- 7.1 Cu Ft. Total Capacity
- 5 Cooking Elements Including a Warm Zone
- EasyConvect™ Conversion
- FIT Guarantee
- Aqualift®
- Glass Touch Controls
- Side Trim Accessory Kit

Product Dimensions:

Height: 36

Width: 29 7/8

Electrical Requirements:

40 Amps.

Additional Information:

[Use And Care Guide](#)

[Dimension Guide](#)

[Installation Guide](#)

[Warranty Certificate](#)

Available in:

- Black
- Stainless Steel
- White

INVESTED
IN
AMERICA

ADA
Compliant

©Registered trademark/TM Trademark of Whirlpool, U.S.A. © 2013 Whirlpool Corporation. All Rights Reserved
All other trademarks are owned by their respective companies.
Because Whirlpool Corporation policy includes a continuous commitment to improve our products, we reserve
the right to change materials and specifications without notice. We also reserve the right to discontinue or
transition products without notice.
Manufacturer's Suggested Retail Price (MSRP) and Minimum Advertised Price (MAP) provided for reference
purposes only. Dealer alone determines advertised and retail prices
Created On: Tuesday, December 22, 2015 14:04:50

Suite 717
Hampton

Upgrade
Package 2




KDTM354ESS

KitchenAid®

dBA Dishwasher with Clean Water Wash System

<http://www.kitchenaid.com>

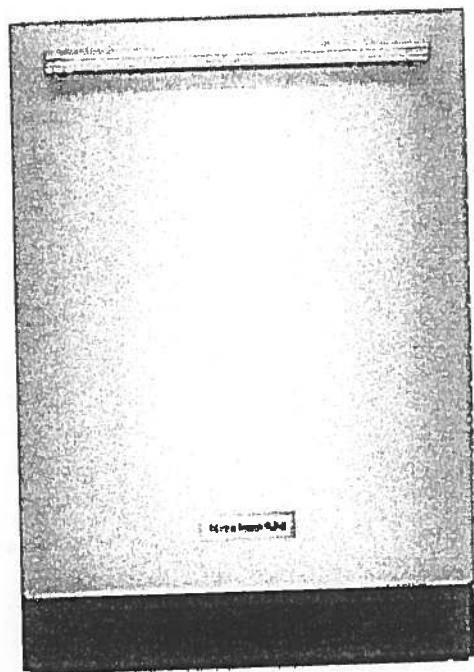

Key Features:

- Clean Water Wash System
- ProScrub® Option
- Professionally-Inspired Design
- Advanced ProDry™ System
- ProWash™ Cycle
- SatinGlide® Max Rails (Upper Rack)
- Sliding Tines in the Lower Rack
- 2 Rows Fold-Down Tines in Upper Rack
- Fold-Down Tines in the Lower Rack
- 2 Fold-Down Cup Shelves with Integrated Stemware Holders
- Utility Basket (Upper Rack)
- Express Wash

Product Dimensions:

Height: 34 1/2

Width: 23 7/8

Depth: 24 3/4

Electrical Requirements:

15 Amps.

Additional Information:

[Use And Care Guide](#)

[Dimension Guide](#)

[Installation Guide](#)

[Energy Guide](#)

[Warranty Certificate](#)

Available in:

● Stainless Steel

INVESTED
IN
AMERICA

®Registered trademark/TM Trademark of Whirlpool, U.S.A. © 2013 Whirlpool Corporation. All Rights Reserved.
All other trademarks are owned by their respective companies.
Because Whirlpool Corporation policy includes a continuous commitment to improve our products, we reserve the right to change materials and specifications without notice. We also reserve the right to discontinue or transition products without notice.
Manufacturer's Suggested Retail Price (MSRP) and Minimum Advertised Price (MAP) provided for reference purposes only. Dealer alone determines advertised and retail prices.
Created On: Friday, March 04, 2016 16:36:55

Suite 717
Hampton

Upgrade Package 2




WFW85HEFC

Whirlpool®

<http://www.whirlpool.com>

4.5 cu. ft. Front Load Washer with TumbleFresh™
option

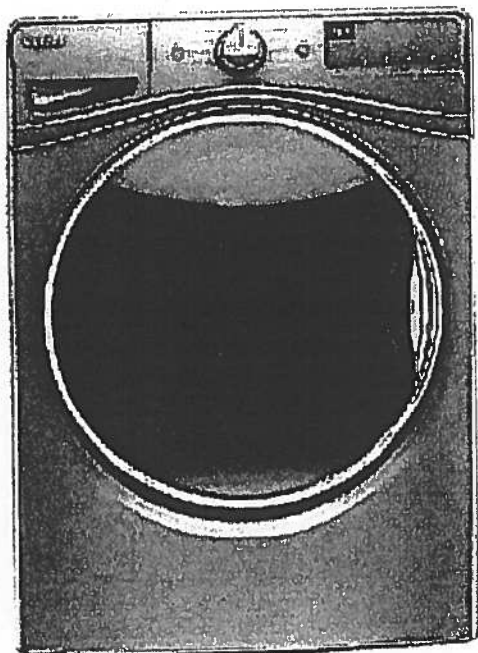

Key Features:

- TumbleFresh™ Option
- ColorLast™ Cycle
- Presoak Option
- EcoBoost™ Option
- Precision Dispense
- Steam Clean Option
- Adaptive Wash Technology
- Smooth Wave Stainless Steel Wash Basket
- 4.5 cu. ft. Capacity
- Undercounter Installation
- Add-A-Garment
- ENERGY STAR® Certified

Product Dimensions:

Height: 39 3/4

Width: 27

Depth: 33 5/16

Additional Information:

[Use And Care Guide](#)

[Dimension Guide](#)

[Installation Guide](#)

[Energy Guide](#)

[Warranty Certificate](#)

Available in:

- ☒ Chrome Shadow
☐ White

INVESTED
IN
AMERICA



©Registered trademark/TM Trademark of Whirlpool, U.S.A. © 2016 Whirlpool Corporation. All Rights Reserved.
All other trademarks are owned by their respective companies.
Because Whirlpool Corporation policy includes a continuous commitment to improve our products, we reserve the right to change materials and specifications without notice. We also reserve the right to discontinue or transition products without notice.
Manufacturer's Suggested Retail Price (MSRP) and Minimum Advertised Price (MAP) provided for reference purposes only. Dealer alone determines advertised and retail prices.
Created On: Wednesday, December 14, 2016 18:12:43

Suite 717
Hampton

Upgrade
Package 2


LD 179

WED85HEFC

Whirlpool®

<http://www.whirlpool.com>

cu. ft. Electric Dryer with Quick Dry Cycle

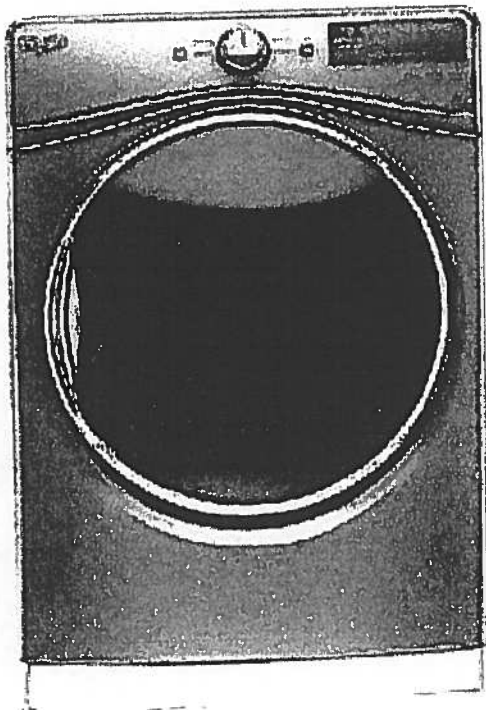

Key Features:

- Advanced Moisture Sensing System
- Tap Touch Controls with Memory
- EcoBoost™ Option
- Steam Refresh Cycle
- Wrinkle Shield™ Option
- Quad Baffles
- 7.4 Cu. Ft. Capacity
- Undercounter Installation
- ENERGY STAR® Qualified
- Sanitize Cycle
- Quick Dry Cycle

Product Dimensions:

Height: 39

Width: 27

Depth: 31

Additional Information:

[Use And Care Guide](#)

[Dimension Guide](#)

[Installation Guide](#)

[Warranty Certificate](#)

INVESTED
IN
AMERICA



©Registered trademark/TM Trademark of Whirlpool, U.S.A. © 2016 Whirlpool Corporation. All Rights Reserved
All other trademarks are owned by their respective companies
Because Whirlpool Corporation policy includes a continuous commitment to improve our products, we reserve the right to change materials and specifications without notice. We also reserve the right to discontinue or transition products without notice
Manufacturer's Suggested Retail Price (MSRP) and Minimum Advertised Price (MAP) provided for reference purposes only. Dealer alone determines advertised and retail prices
Created On: Thursday, March 23, 2017 17:33:37

Countertop Edges
Suite 717
Hampton



13

CONNOLLY Marble & Granite Ltd.

EDGE
DETAILS


004

A.




STRAIGHT EDGE
(STANDARD - 3/4")

Standard:
Kitchen
Main Bath
Master Ensuite

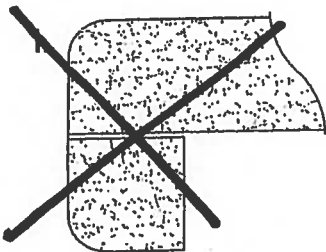

DOUBLE TOP "D" EDGE
(STANDARD - 1 1/2")

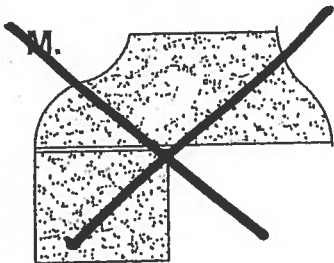

OGEE - SQUARE EDGE
(MED./HIGH - 1 1/2")

EDGING UP-GRADE OPTIONS