

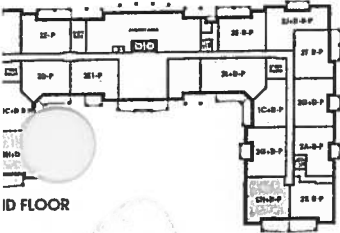


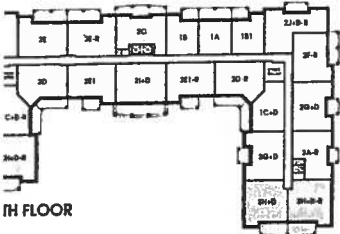

Glen Cove

#114

1,162 SQ FT *plus 168 sq. ft. of balcony area*

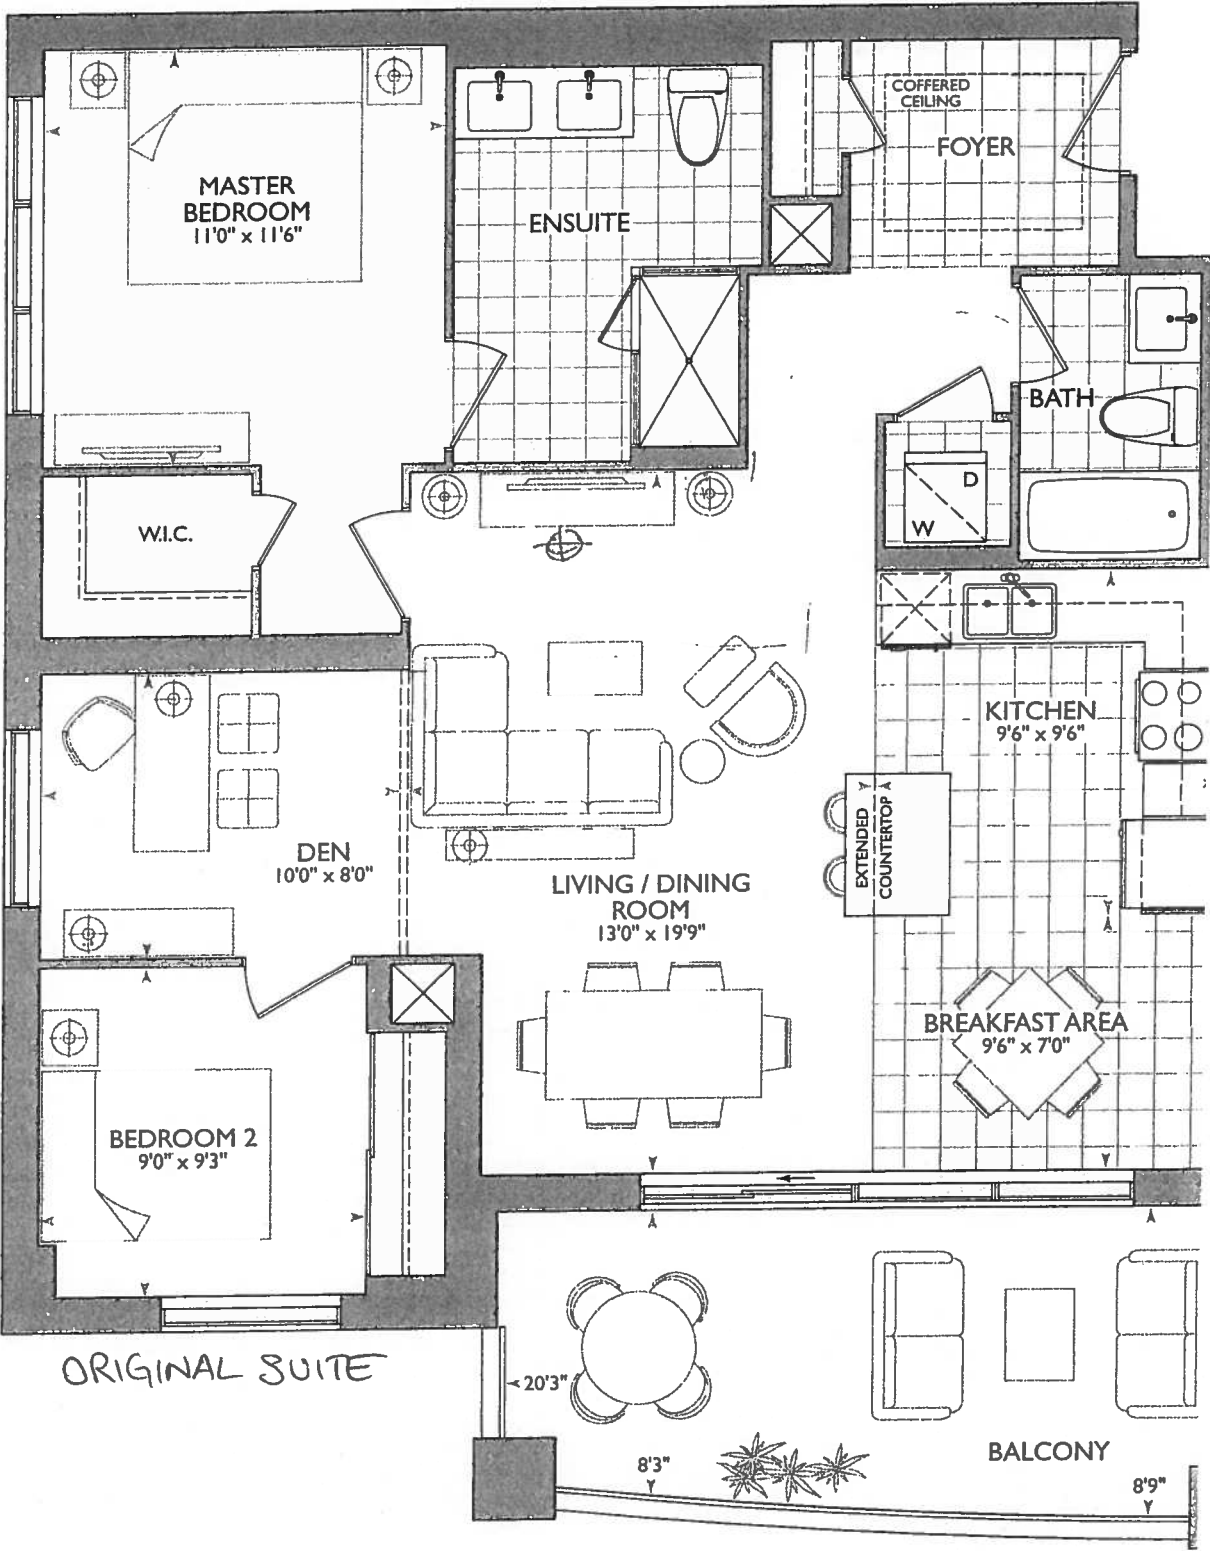

* 5 extended Height Doors

Kitchen (see Layout)

- stove pipe center 60"
 - sink pipe center 67³/₄
 - P = plugs in island (x2)
- * kitchen island extended

④ SHIFTED TOWARDS

FRIDGE MAN

- (8x) Puck lights.
- (1x) = CAPPED ceiling LIGHT centered

LIGHT CENTRE
OVER ISLAND

- UPG #1 - Appliances
PackAGB

2 # 465

下にもし

PACKAGE

- 4'-3" From Ext. Wall

- 4'-3" Flange


Ext. wall

SUITE 114-GLEN COVE-2H+D-P-R

■ CHAMPION PLACE

■ 25 Baker Hill Blvd

Ruffville, ON - Oct 27, 2017

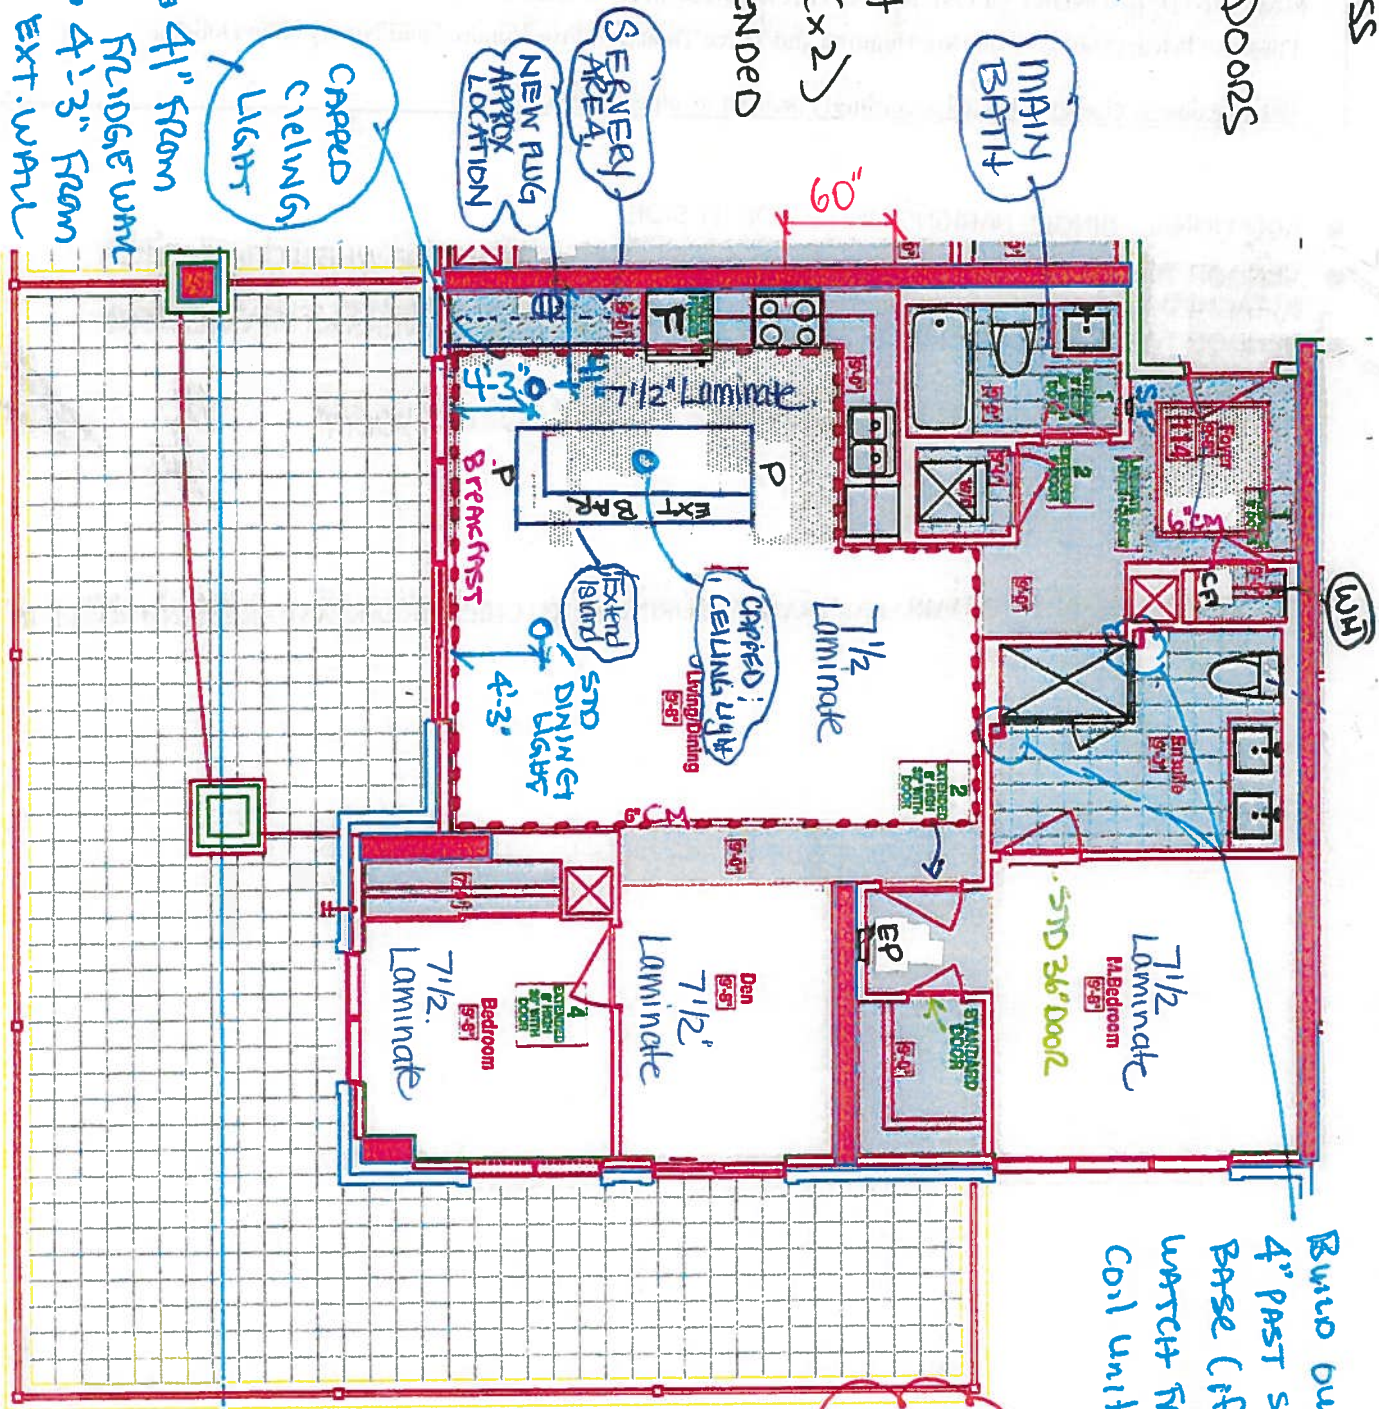

Build out with
4" PAST SPOWER
BASE (if POSSIBLE)
WATCH FAN -
COIL UNIT

November 9, 2017
Suite 114

MAIN + ENSUITE
PASSAGE VANITIES
36 1/4" + 3" splash

LEGEND:

	SECURITY PANEL
	ELECTRICAL PANEL
	COMMUNICATION PANEL
	WATER METER
	FRIDGE
	DROPPED AREA
	6" CHOWN MOLDING
	BARRIER FREE SUITE

- extend with **BY** show **BASE**

RECEIVED
OCT 27-11



Hampton Place

TEL: RES.: 905-887-9794

Offer / Upgrade	INSTALL WATER LINE FOR FRIDGE. Note:
-----------------	---



SITE COPY

CONSTRUCTION SUMMARY
Hampton Place

PURCHASERS: BHANU KHATRI and GOKUL KHATRI

TEL: RES.: 905-887-9794

LOT NUMBER	PHASE	HOUSE TYPE	CLOSING DATE
114	1	GLEN COVE(2H+D-P)	10-Sep-18

Date Added: 17-Nov-17 Invoice Number: 6964

1 - INTERIOR DOORS- CLARIFICATION- Purchaser accepts & acknowledges that FIVE (5) interior doors will be extended to 8'-0" Tall: Front Foyer Closet, Main Bath,Laundry MasterBdrm, Bdrm #2 Purchaser has declined the option to upgrade the additional extended height interior doors . Master Ensuite and Master Bedroom WIC to be left standard height
1 - KITCHEN (ISLAND)- In addition to the builders standard ceiling light in the kitchen, Install a Capped ceiling light, Centred over the new sized island (See attached sketch) Note:
1 - BREAKFAST AREA- In addition to the builders standard ceiling light in the kitchen, Install a Capped ceiling light, in the Breakfast area. New capped light to be in line with the Dining Room light (See attached sketch) Note:
1 - SERVERY AREA- Install an additional plug in the new Servery area of kitchen. The plug to be installed at the standard height above the counter top of the Servery (See Sketch) Note: Approved as per Stella
1 - KITCHEN & BATHROOM- SEE QUALITY TOPS & KITCHENS FOR ALL KITCHEN & BATHROOMS UPGRADES/LAYOUTS (See attached Upgrade Package) Note: **PLEASE NOTE** Included in the P&SA is ONE (1) set of Pot and Pan drawers
4 - KITCHEN- Install FOUR (4) ADDITIONAL PUCK LIGHTS (Same Switch as standard Puck Lights) at kitchen. To be installed below kitchen cabinetry, where applicable (See attached QTK layout for locations) Note: Purchaser is paying the difference for additional Puck LIghts- standard Kitchen to Receive Four (4) Puck LIghts- Upgrade Kitchen requires Eight (8) Puck Lights
KITCHEN- Install ADDITIONAL Standard Counter Top- ASPEN TERRA WHITE- Throughout kitchen where applicable -Includes additional counter on the island & new servery area (Does not Include Quartz backsplash) Note: The above is based on the revised QTK layout Priced as per Connolly
1 - KITCHEN- Install an upgraded counter top edge throughout the kitchen, where applicable. Install the "I" egde (Includes New Servery Area) Note:
1 - KITCHEN- Install additional builders standard kitchen backsplash (3x6 Subway White) for the new servery area of kitchen (See QTK sketch) Note:
1 - KITCHEN/SERVERY- Install the 3x6 Subway "White" tile in a Brick Pattern, throughout the kitchen area and applicable servery area Note:
1 - APPLIANCE PACKAGE- Install Upgrade Appliance Package #1 To be installed throughout the suite, where applicable (See Sketch) Note: **See P&SA for Water line purchased by purchaser**
1 - KITCHEN- Install the builders standard undermount sink in the kitchen- Install the BLANCO HORIZON Plus U2 (8") Undermount Sink- Model # 401234
1 - KITCHEN- Install the builders standard Faucet in the kitchen- Install the DELTA Chrome Pull-Out Kitchen Faucet (Single Hole) - Model # 469LF- Chrome Note:
1 - MAIN BATH- CLARIFICATION- Install the standard Plumbing Fixtures throughout all bathrooms, where applicable. To Include the Main Bath Note:
1 - MASTER ENSUITE- Install an upgraded Toilet in the Master Ensuite ONLY- Contrac CALI Model # 4710 B0VU Note: **PLEASE NOTE** Install builders standard Sink / Faucet/ and shower stall plumbing in the Master Ensuite



SITE COPY

CONSTRUCTION SUMMARY
Hampton Place

PURCHASERS: BHANU KHATRI and GOKUL KHATRI
TEL: RES.: 905-887-9794

LOT NUMBER	PHASE	HOUSE TYPE	CLOSING DATE
114	1	GLEN COVE(2H+D-P)	10-Sep-18

Date Added: 17-Nov-17 Invoice Number: 6964

1 - CLARIFICATION:
MASTER ENSUITE & MAIN BATH-Install RAISED VANITY HEIGHT at Main Bath and Master Ensuite Vanities, where applicable (See attached Upgrade paperwork and Layouts)

1 - CLARIFICATION-
MASTER ENSUITE-
Standard Frameless glass shower to NOT reach the ceiling. To be install at 8'-0" high with applicable chrome header.
Note:

1 - CLARIFICATION-
MASTER ENSUITE / MAIN BATH- Install the Standard 3" Splash throughout all bathroom vanity counter tops, where applicable. To include the Main Bath and the Master Ensuite
Note:

1 - PURCHASER AWARE AND ACCEPTS THAT ANY CHANGES MADE TO UPGRADES AFTER SIGNING THIS PURCHASERS EXTRA FORM ARE SUBJECT TO A MINIMUM ADMINISTRATION FEE OF \$1000. PLUS A 10% HOLDBACK FEE.
Note:

1 - PURCHASER HAS ATTENDED A COLOR APPOINTMENT AT THE DECOR CENTRE AND HAS DECLINED ANY ADDITIONAL UPGRADES.
Note:

This Document is Extremely Time Sensitive - Printed 22 Jan 18 at 17:07



* INTERIOR COLOUR SCHEME *

Purchasers		Decor Consultant	Model Type	Telephone Res. / Bus	Project	Closing Date	Unit
BHANU KHATRI & GOKUL KHATRI		Laura Di Pede	GLEN COVE(2H+D-P)	(905) 887-9794 /	Hampton Place	10/09/2018	114

Page 1 of 3

	Flooring		Wall Tile	
	Description	Main	Accent/Insert	Pattern
✓ MASTER ENSUITE	13X13 HELLO SILVER- STD	8X10 GOLF GRIGIO- STD	N/A	N/A
✓ MAIN BATHROOM	13X13 RUSTIC CHARCOAL- STD	8X10 CARRARA MATTE- STD	N/A	N/A
	N/A	N/A	N/A	N/A
POWDER ROOM	N/A	N/A	N/A	N/A
✓ KITCHEN	7 1/2" TorleysForest-Cordillera 9687 P-STD	3X6 SUBWAY WHITE -Brick Pattern	N/A	N/A
✓ FOYER	7 1/2" TorleysForest-Cordillera 9687 P-STD	N/A	N/A	N/A
✓ LAUNDRY	8X8 BEHRAM PINK- STD	N/A	N/A	N/A
✓ SERV	7 1/2" TorleysForest-Cordillera 9687 P-STD	3X6 SUBWAY WHITE -Brick Pattern	N/A	N/A
✓ LIVING ROOM	7 1/2" TorleysForest-Cordillera 9687 P-STD			
✓ DINING ROOM	7 1/2" TorleysForest-Cordillera 9687 P-STD			
✓ DEN	7 1/2" TorleysForest-Cordillera 9687 P-STD			
✓ MASTER BEDROOM	7 1/2" TorleysForest-Cordillera 9687 P-STD			
✓ BEDROOM 2	7 1/2" TorleysForest-Cordillera 9687 P-STD			
BEDROOM 3	N/A			

Notes

INTERIOR EXTENDED DOORS- AS PER P&SA, INSTALL FIVE (5) EXTENDED HEIGHT DOORS-FRONT FOYER CLOSET, MAIN BATH,LAUNDRY DOOR,MASTER BEDROOM, AND BEDROOM #2
STANDARD INTERIOR DOOR HEIGHT THE FOR MASTER ENSUITE & MASTER BEDROOM WIC

Page 1 of 3

Consultant
Laura Di Pede

Purchaser:
GOKUL KHATRI

Purchaser:
BHANU KHATRI

Vendor:



* INTERIOR COLOUR SCHEME *

Purchasers

BHANU KHATRI & GOKUL KHATRI

Decor Consultant

Laura Di Pede

Model Type

GLEN COVE(2H+D-P)

Telephone Res. / Bus

(905) 887-9794 /

Project

Hampton Place

Closing Date

10/09/2018

Unit

114

Page 2 of 3

CABINERY, VANITIES AND COUNTERTOPS

Style	Countertop	Counter Edge	Handle / Knob
MAIN BATHROOM	CATEGORY 1 WHITE- QT 1203- (STD) FIREBOARD	1/2" (STD)	16338 195 std
MASTER ENSUITE	CATEGORY 2 MAPLE CHESTNUT QT 2503 (STD)	1/2" (STD)	16338 195 std
POWDER ROOM	N/A	N/A	N/A
KITCHEN / DINETTE	CATEGORY 2 MAPLE QT 2503 PISTACHIO (STD)	1/2" (UPGD)	16338 195 std
LAUNDRY ROOM	N/A	N/A	N/A
SEWER	CATEGORY 2 MAPLE QT 2503 PISTACHIO (STD)	1/2" (UPGD)	16338 195 std

APPLIANCE PACKAGE

PACKAGE #1

Std 31in Opening

PLUMBING FIXTURES

KITCHEN	Sink Model	STANDARD
	Sink Faucet	STANDARD
TOILETS	Master Ensuite	CALI- 4710 BOVU- (UPGD)
	Main Bathroom	STANDARD
	Powder Room	STANDARD
VANITY FAUCETS	Master Ensuite	STANDARD
	Main Bathroom	STANDARD
	Powder Room	N/A
VANITY SINKS	Master Ensuite	STANDARD
	Main Bathroom	STANDARD
	Powder Room	N/A
SHOWER STALL / TUBS	Master Ensuite Shower Stall	STANDARD
	Master Ensuite Tub	N/A
	Main Bathroom Tub	STANDARD

Trim

Baseboard & Casing	STANDARD
Interior Doors	STANDARD
Cornice Moulding / Medalion	
Foyer	STANDARD #CTR-611
Living Room	STANDARD #CTR-611
Dining Room	STANDARD #CTR-611
Den	N/A
KITCHEN	STANDARD #CTR-611
Bedroom 2	N/A
Bedroom 3	N/A

Levers	STANDARD
Door Height	5 Extended- P&SA **See Notes**

Fireplace

Fireplace	N/A
Location Flooring	N/A
Style	N/A
Finish	N/A
Marble	N/A
Hearth	N/A

MISC. INSTALLATIONS

Ceramic Accessories
(installed by Vendor)

Yes ☒ No ☐

Bathroom Mirrors
(installed by Vendor)

Yes ☒ No ☐

Wire Shelving - Closet
(installed by Vendor)

Yes ☒ No ☐

Paint Throughout

Walls	BIRCH WHITE- STANDARD
Trim	STANDARD -WHITE

Page 2 of 3

Decor Consultant:

I aura Di Pede

Purchaser:

BHANU KHATRI



Vendor:

Hampton Place

Lot: 114 Project: Hampton Place Model: GLEN COVE(2H+D-P)



GOKUL KHATRI

Printed Nov 06, 2017 10:19 am

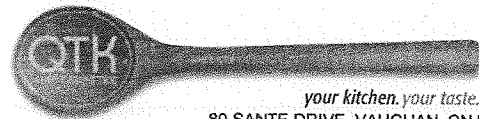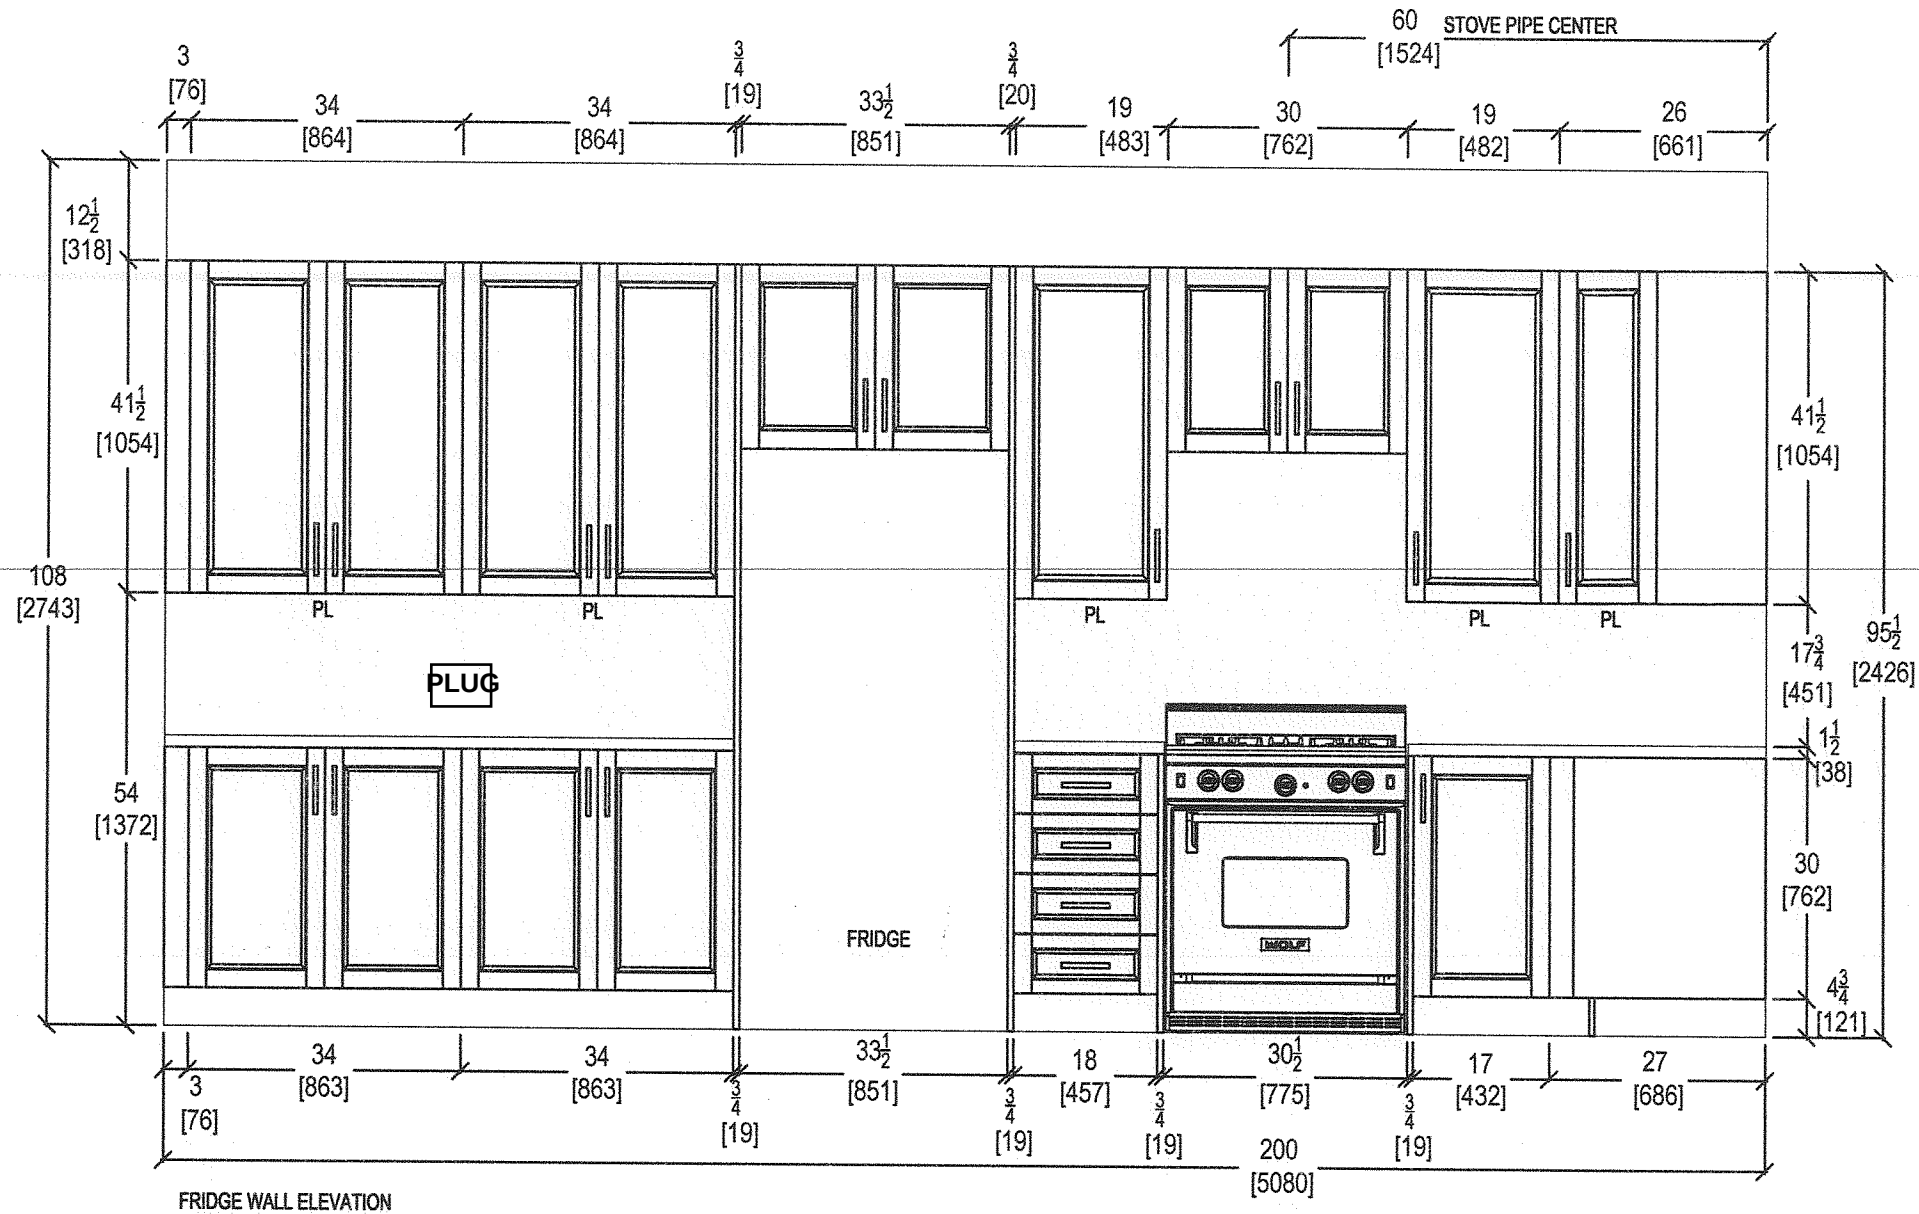


80 SANTE DRIVE, VAUGHAN, ON L4K 3C4,
T: 416.746.1811 F: 905.761.5901

CLIENT: ROYAL PINE HOMES	JOB NAME: UNIT 114 HMP	ROOM: KITCHEN	DRAWN BY: SK	COMMENTS: PLEASE NOTE ALL DIMENSIONS ARE NOT FINAL AND ARE SUBJECT TO CHANGE UPON FINAL SITE MEASURE
SITE: HAMPTON PLACE	DOOR STYLE: —	DOOR HANDLE: —	SCALE: 1/2" = 1' - 0"	
PHONE: —	FINISH: —	DRW HANDLE: —	DATE: REVISED APRIL 2, 2019	
EMAIL: —	SPECIES: —	TOP: —	PAGE: —	

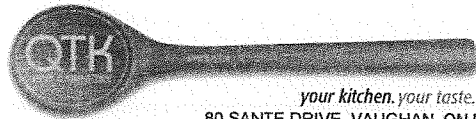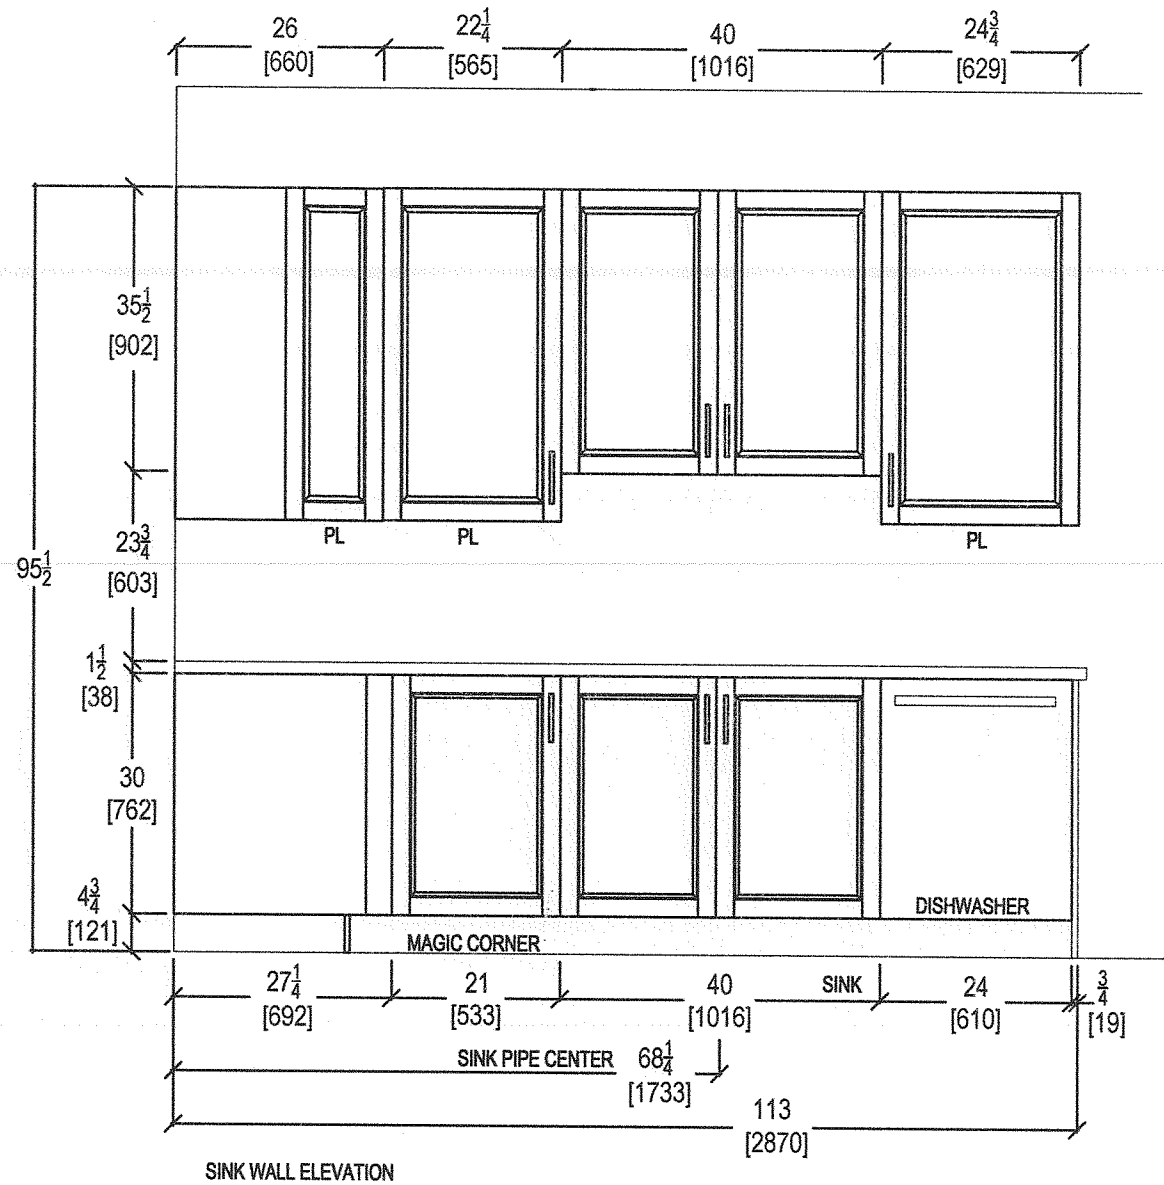






your kitchen. your taste.
 80 SANTE DRIVE, VAUGHAN, ON L4K 3C4,
 T: 416.746.1811 F: 905.761.5901

CLIENT: ROYAL PINE HOMES	JOB NAME: UNIT 114 HMP	ROOM: KITCHEN	DRAWN BY: SK	COMMENTS: PLEASE NOTE ALL DIMENSIONS ARE NOT FINAL AND ARE SUBJECT TO CHANGE UPON FINAL SITE MEASURE
SITE: HAMPTON PLACE	DOOR STYLE: —	DOOR HANDLE: —	SCALE: 1/2" = 1' - 0"	
PHONE: —	FINISH: —	DRW HANDLE: —	DATE: REVISED: APRIL 2, 2019	
EMAIL: —	SPECIES: —	TOP: —	PAGE: —	

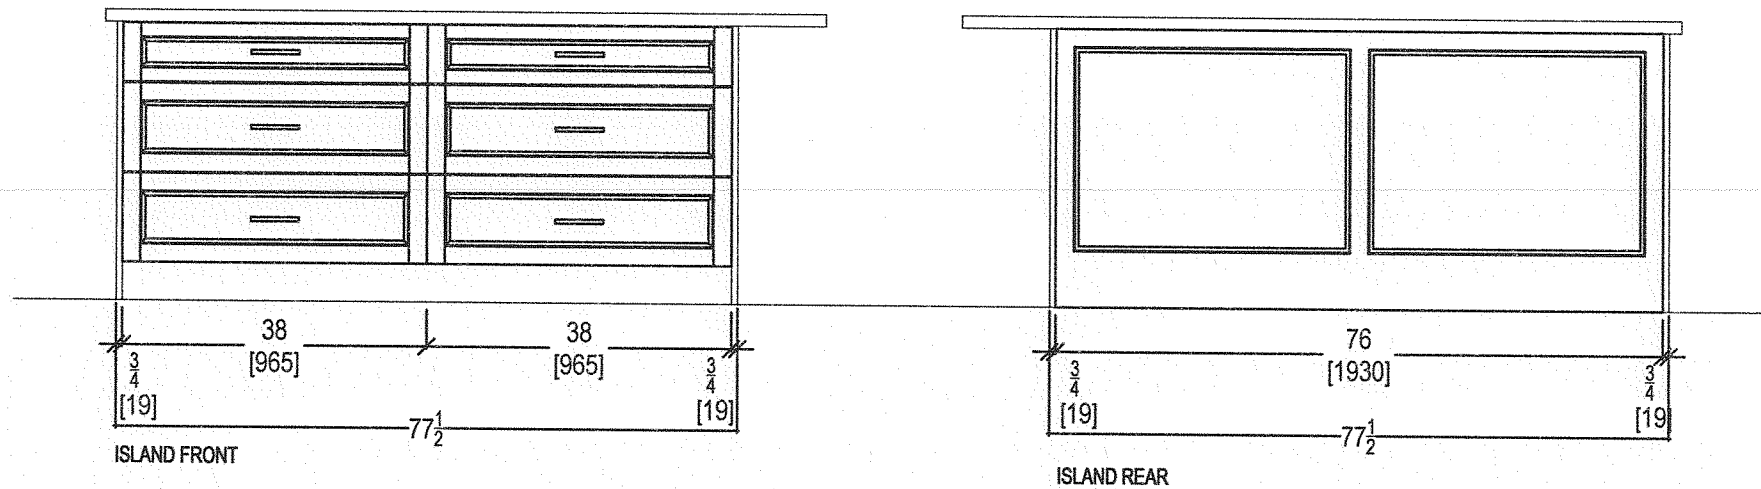

your kitchen. your taste.
 80 SANTE DRIVE, VAUGHAN, ON L4K 3C4,
 T: 416.746.1811 F: 905.761.5901

CLIENT: ROYAL PINE HOMES	JOB NAME: UNIT 114 HMP	ROOM: KITCHEN	DRAWN BY: SK	COMMENTS: PLEASE NOTE ALL DIMENSIONS ARE NOT FINAL AND ARE SUBJECT TO CHANGE UPON FINAL SITE MEASURE
SITE: HAMPTON PLACE	DOOR STYLE: —	DOOR HANDLE: —	SCALE: 1/2" = 1' - 0"	
PHONE: —	FINISH: —	DRW HANDLE: —	DATE: REVISED: APRIL 2, 2019	
EMAIL: —	SPECIES: —	TOP: —	PAGE: —	

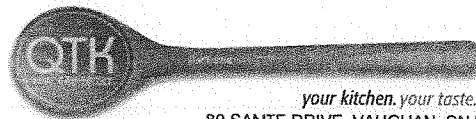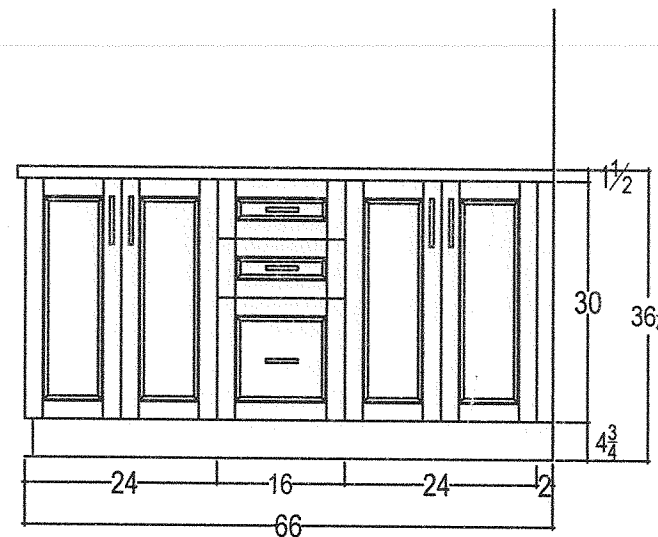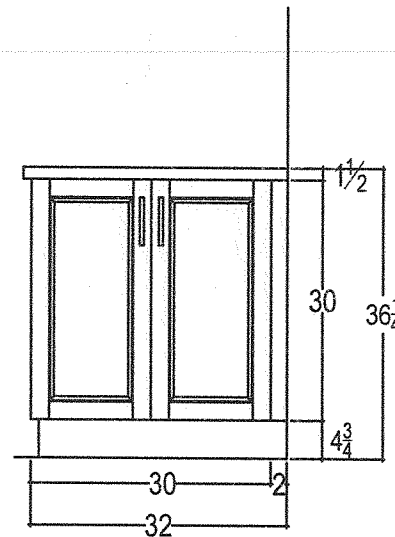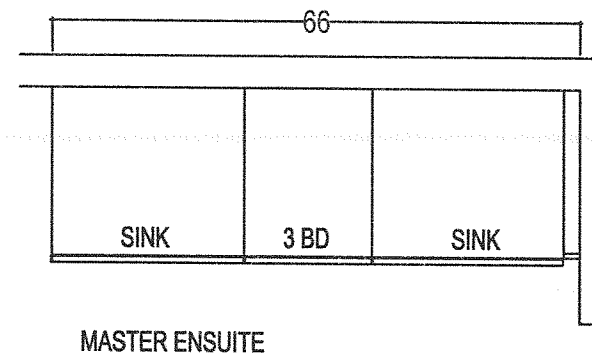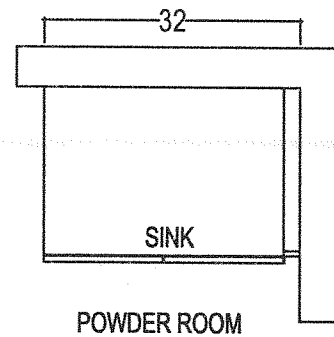

your kitchen. your taste.
80 SANTE DRIVE, VAUGHAN, ON L4K 3C4,
T: 416.746.1811 F: 905.761.5901

CLIENT: ROYAL PINE HOMES

SITE: HAMPTON PLACE

PHONE: —

EMAIL: —

JOB NAME: UNIT 114 HMP

DOOR STYLE: —

FINISH: —

SPECIES: —

ROOM: VANITIES

DOOR HANDLE: —

DRW HANDLE: —

TOP: —

DRAWN BY: SK

SCALE: 1/2" = 1' - 0"

DATE: REVISED APRIL 2, 2019

PAGE: —

COMMENTS:

**PLEASE NOTE ALL DIMENSIONS
ARE NOT FINAL AND ARE
SUBJECT TO CHANGE UPON
FINAL SITE MEASURE**

Countertop Edges

CONNOLLY Marble & Granite Ltd.

EDGE
DETAILS

004

A.




STRAIGHT EDGE
(STANDARD - 3/4")

MAIN BATH
MASTER ENSUITE

SUITE 114




I.

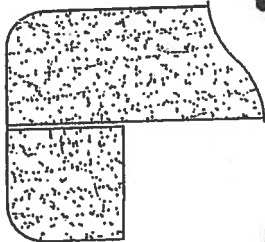

DOUBLE TOP "D" EDGE
(STANDARD - 1 1/2")

KITCHEN

M.

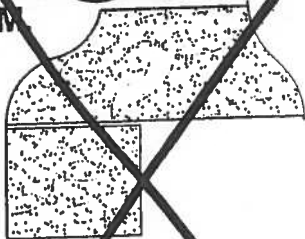

OGEE - SQUARE EDGE
(MED./HIGH - 1 1/2")

EDGING UP-GRADE OPTIONS

PH - PMS

SUITE 114
HAMPTON

MASTER ENSUITE

CALI®

4.8Lpf / 1.28Gpf 1PC 16⁷/₈" HIGH ELONGATED

- ☐ 4710BOV Lined Tank
- ☐ 4710BOVU Unlined Tank

Product Specs:

- High efficiency toilet
- 4.8Lpf/1.28Gpf
- Elongated bowl with concealed skirted trapway
- Vitreous china
- 16⁷/₈" Plus Height bowl
- Soft white tank lever
- 12" (305mm) Rough-in
- 2" Fully glazed ball pass trapway
- 3" Flapper
- Siphon jet flush action
- Water surface (240mm x 170mm) 9¹/₂" x 6⁵/₈"
- Decorative chrome and soft white side caps included
- Smooth close toilet seat included

Overall Dimensions:

392mm (W) x 725mm (D) x 760mm (H)
15¹/₂" (W) x 28¹/₂" (D) x 29³/₈" (H)

Compliance Certifications:

Meets or exceeds the following:

- IAPMO cUPC
- US EPA WaterSense
- ASME A 12.19.2 / CSA B45.1-2013
- ADA Guidelines & ANSI A117.1
- MaP Tested 1000g
- LEED Compliant


Shipping:

Cube 9.39
GW 92.50lbs



Notes:

This toilet is designed to rough-in at a minimum dimension of 305mm (12") from finished wall to C/L of outlet. Supply line not included with fixture and must be ordered separately.
Important: Dimensions of fixtures are nominal and may vary within the range of tolerances established by ASME standard A112.19.2. These measurements are subject to change or cancellation. No responsibility is assumed for use of superseded or voided pages.
Products are designed to comply ADA/ANSI A117.1 Standard. It shall be the responsibility of the installer to comply with the local disability codes and standards prior to installing the product.

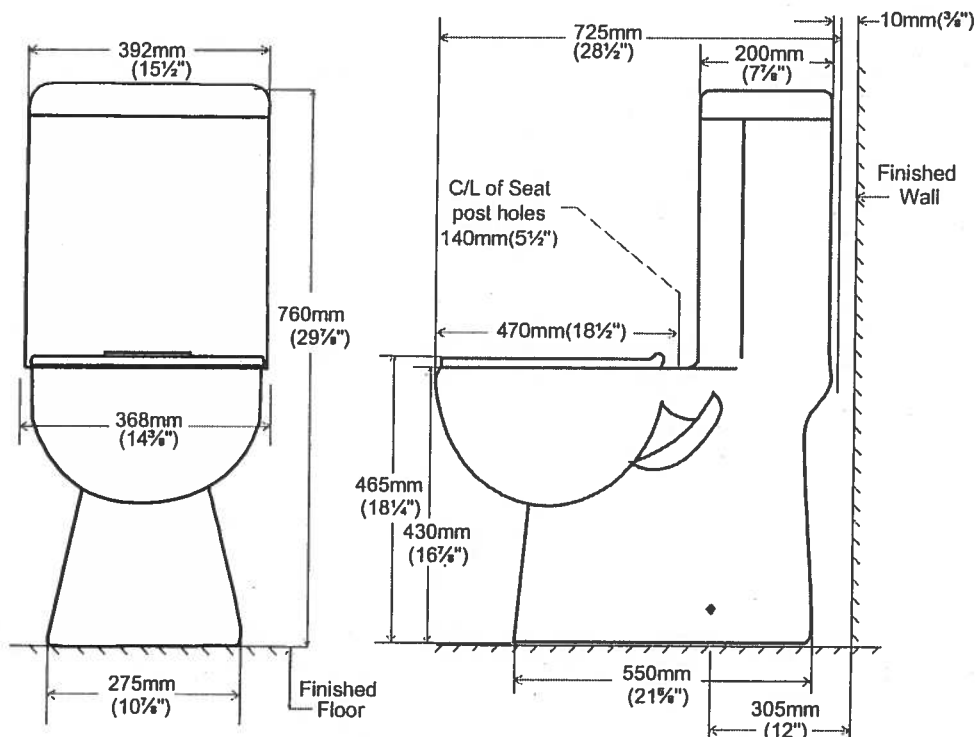

contrac®

5970 Chedworth Way, Unit A, Mississauga, ON, Canada L5R 3V5
www.contrac.ca

Revised: January 2016

WRB322DMBM

Upgrade Package I



Whirlpool®

36-inches wide Bottom-Freezer Refrigerator with
SpillGuard™ Glass Shelves - 22 cu. ft

<http://www.whirlpool.com>

Key Features:

- SpillGuard™ Glass Shelves
- Adaptive Defrost / *Factory Installed Icemaker*
- FreshFlow™ Produce Preserver
- LED Interior Lighting
- ENERGY STAR® Qualified

Product Dimensions:


Height: 70
Width: 32 5/8
Depth: 33 3/8

Electrical Requirements:

15

Additional Information:

[Use And Care Guide](#)
[Dimension Guide](#)
[Energy Guide](#)
[Warranty Certificate](#)

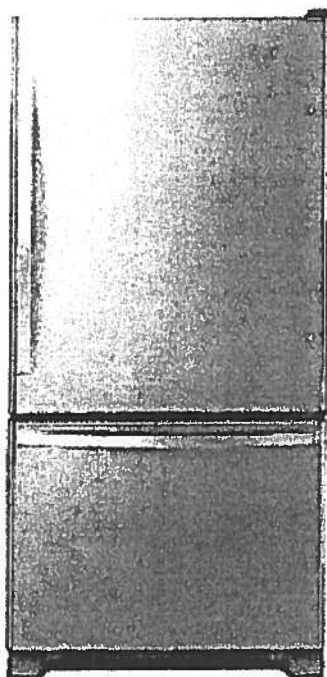

INVESTED
IN
AMERICA



®Registered trademark/TM Trademark of Whirlpool, U.S.A. © 2018 Whirlpool Corporation. All Rights Reserved.
All other trademarks are owned by their respective companies.
Because Whirlpool Corporation policy includes a continuous commitment to improve our products, we reserve
the right to change materials and specifications without notice. We also reserve the right to discontinue or
transition products without notice.
Manufacturer's Suggested Retail Price (MSRP) and Minimum Advertised Price (MAP) provided for reference
purposes only. Dealer alone determines advertised and retail prices.
Created On: Tuesday, March 14, 2017 11:30:08

WEE745H0FS


Upgrade
Package I



Whirlpool®

6.4 Cu. Ft. Slide-In Electric Range with True Convection

<http://www.whirlpool.com>

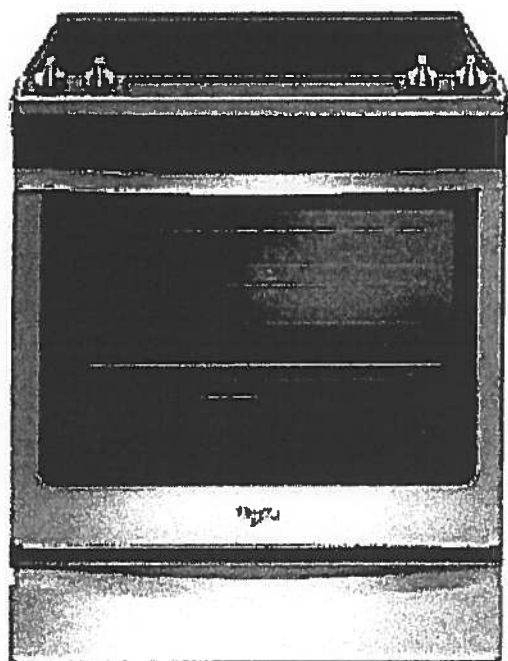

Key Features:

- Frozen Bake™ Technology
- True Convection Cooking
- FlexHeat™ Triple Radiant Element
- Convection Conversion
- AquaLift® Self-Cleaning Technology
- Temperature Sensor
- Rapid Preheat
- 6.4 Cu. Ft. Capacity
- Easy-Wipe Ceramic Glass Cooktop
- Large Oven Window
- Max Capacity Rack
- Hidden Bake Element

Product Dimensions:

Height: 36

Width: 29 7/8

Additional Information:

[Use And Care Guide](#)

[Dimension Guide](#)

[Installation Guide](#)

[Warranty Certificate](#)

INVESTED
IN
AMERICA

ADA
Compliant

©Registered trademark/TM Trademark of Whirlpool, U.S.A. © 2016 Whirlpool Corporation. All Rights Reserved.
All other trademarks are owned by their respective companies.
Because Whirlpool Corporation policy includes a continuous commitment to improve our products, we reserve the right to change materials and specifications without notice. We also reserve the right to discontinue or transition products without notice.
Manufacturer's Suggested Retail Price (MSRP) and Minimum Advertised Price (MAP) provided for reference purposes only. Dealer alone determines advertised and retail prices.
Created On: Friday, January 27, 2017 10:48:47

Upgrade Package 1



YWMH76719CS



<http://www.whirlpool.com>

1.9 cu. ft. Microwave Hood Combination with
TimeSavor™ Plus True Convection

Key Features:

- TimeSavor™ Plus True Convection Cooking System
- Steam Cooking
- Sensor Cooking
- AccuPop™ Cycle
- CleanRelease® Non-Stick Interior
- SteamClean Option
- Integrated Hidden Vent and Console
- Auto Adapt Fan
- Recessed, Stoppable Glass Turntable
- Universal Microwave Steamer
- 1.9 cu. ft. Capacity
- 1,100 Watts Cooking Power

Product Dimensions:

Height: 17 1/8

Width: 29 15/16

Depth: 18 1/2

Electrical Requirements:

15 or 20. 120 V.

Additional Information:


[Use And Care Guide](#)

[Installation Guide](#)

[Warranty Certificate](#)

Available in:

Stainless Steel

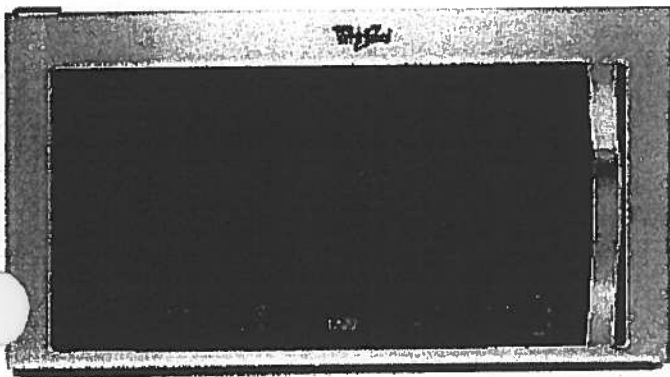

©Registered trademark/TM Trademark of Whirlpool, U S A. © 2013 Whirlpool Corporation. All Rights Reserved.
All other trademarks are owned by their respective companies.
Because Whirlpool Corporation policy includes a continuous commitment to improve our products, we reserve the right to change materials and specifications without notice. We also reserve the right to discontinue or transition products without notice.
Manufacturer's Suggested Retail Price (MSRP) and Minimum Advertised Price (MAP) provided for reference purposes only. Dealer alone determines advertised and retail prices.
Created On: Monday, March 14, 2016 13:16:48

Upgrade Package 1



WDTA50SAHZ

Whirlpool®

<http://www.whirlpool.com>

Contemporary Design. Stainless Steel Tub
Dishwasher with TotalCoverage Spray Arm

Key Features:

- Sensor Cycle
- TotalCoverage Spray Arm
- 1-Hour Wash Cycle
- Tap Touch Controls

Product Dimensions:

Height: 34 1/2

Width: 23 7/8

Depth: 24 1/2

Additional Information:


[Use And Care](#)

[Dimension Guide](#)

[Installation Guide](#)

[Energy Guide](#)

[Warranty](#)

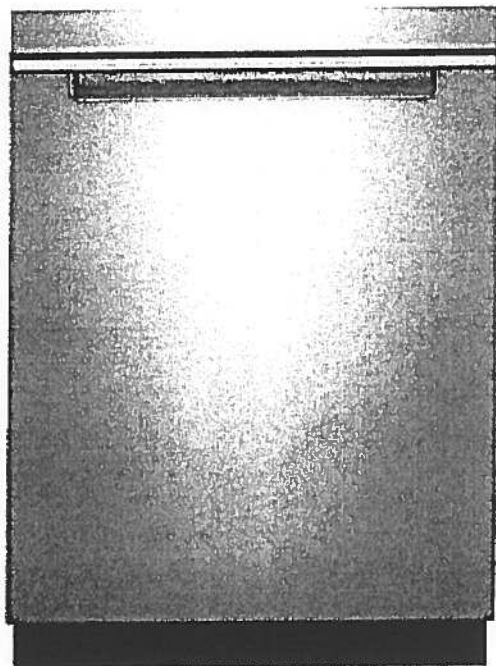

Available in:

● Black

Fingerprint Resistant Sunset Bronze

Fingerprint Resistant Black Stainless

○ White

Fingerprint Resistant Stainless Steel

INVESTED
IN
AMERICA



©Registered trademark/TM Trademark of Whirlpool, U.S.A. © 2016 Whirlpool Corporation. All Rights Reserved. All other trademarks are owned by their respective companies.

Because Whirlpool Corporation policy includes a continuous commitment to improve our products, we reserve the right to change materials and specifications without notice. We also reserve the right to discontinue or transition products without notice.

Manufacturer's Suggested Retail Price (MSRP) and Minimum Advertised Price (MAP) provided for reference purposes only. Dealer alone determines advertised and retail prices.

Upgrade Package 1




WFW75HEFW



<http://www.whirlpool.com>

5 cu. ft. Front Load Washer with Precision
Dispense

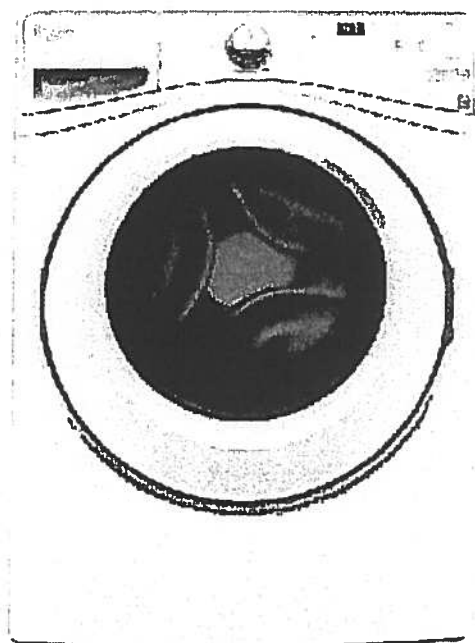

Key Features:

- Precision Dispense
- Adaptive Wash Technology
- Smooth Wave Stainless Steel Wash Basket
- 4.5 cu. ft. Capacity
- ENERGY STAR® Qualified

Product Dimensions:

Height: 39 3/4

Width: 27

Depth: 33 5/16

Electrical Requirements:

15 or 20. 120 V.

Additional Information:

[Use And Care Guide](#)

[Dimension Guide](#)

[Installation Guide](#)

[Energy Guide](#)

[Warranty Certificate](#)

INVESTED
IN
AMERICA



©Registered trademark/TM Trademark of Whirlpool, U.S.A. ©2013 Whirlpool Corporation All Rights Reserved.
All other trademarks are owned by their respective companies.
Because Whirlpool Corporation policy includes a continuous commitment to improve our products, we reserve the right to change materials and specifications without notice. We also reserve the right to discontinue or transition products without notice.
Manufacturer's Suggested Retail Price (MSRP) and Minimum Advertised Price (MAP) provided for reference purposes only. Dealer alone determines advertised and retail prices.
Created On: Wednesday, March 23, 2016 11:51:03

Upgrade Package 1



YWED75HEFW

7.5 cu. ft. Duet® High Efficiency Front Load Electric
Dryer with ENERGY STAR®

Whirlpool®

<http://www.whirlpool.com>

MSRP: \$0.00

Key Features:

- Advanced Moisture Sensing System
- Quad Baffles
- Tap Touch Controls with Memory
- EcoBoost™ Option
- Wrinkle Shield™ Plus Option
- Undercounter Installation
- 7.4 Cu. Ft. Capacity
- ENERGY STAR® Qualified

Product Dimensions:

Height: 39

Width: 27


Depth: 31

Additional Information:

[Use And Care](#)

[Installation Guide](#)

[Warranty](#)

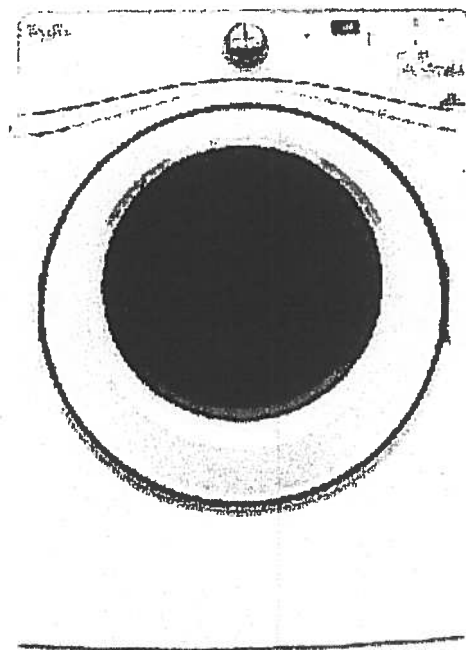

Available in:

☐ White

INVESTED
IN
AMERICA

ADA
Compliant

®Registered trademark/TM Trademark of Whirlpool, U.S.A. © 2016 Whirlpool Corporation All Rights Reserved. All other trademarks are owned by their respective companies.

Because Whirlpool Corporation policy includes a continuous commitment to improve our products, we reserve the right to change materials and specifications without notice. We also reserve the right to discontinue or transition products without notice.

Manufacturer's Suggested Retail Price (MSRP) and Minimum Advertised Price (MAP) provided for reference purposes only. Dealer alone determines advertised and retail prices.