



ROYAL PINE HOMES – SITE INSTRUCTION


SITE INSTRUCTION NO.6.RP.INTERIORS			
PROJECT:	Hampton Place	LOCATION:	25 Baker Hill Blvd Stouffville, ON
DATE:	April 15, 2019	BY:	L. Renzetti

Site Instructions are issued for the purpose of clarification, direction or further interpretation of the contract documents. Where this Site Instruction shall alter the contract amount, the work shall not proceed without the approval of Braylea Investments Inc., with an itemized proposal for approval.

DISTRIBUTION			
NAME	COMPANY	PHONE	EMAIL
Vince Staffieri	Royal Pine Homes	905.856.2150	vince@royalpinehomes.com
Keith Schumacher	RPH	905.856.2150	keith@royalpinehomes.com
Cinzia Caruso	RPH	905.856.2150	cinzia@royalpinehomes.com
Ric Wight	Dineen Construction	416. 675.7676	rwight@dineen.com
Jeff Ellis	Dineen Construction	416. 675.7676	jellis@dineen.com
Steven Marchetti	Penegal Trim	416.989.3159	steven@marchetti-group.com
Amedeo Altobell	Panson Electrical	905.951.6112	amedeo@panson.ca
Pedro Taborda	O'Neil Electric	416.609.7863	pedrotaborda@oneilelectric.com
Matthew DiCarlo	Canamould	905.264.4436	mdicarlo@canamould.com
Tony Borrelli	Traditional Door	905.851.1118	Tony@traditionaldoor.com

NO.	ITEM/DRWG NO.	DESCRIPTION
1.01	ID.304. Partial RCP Janitor & Concierge Strg	CHANGE: Delete t-bar ceiling as indicated in RP.INT.SI.04. Now drywall ceiling in both rooms. Change three (3) FL1 fixtures to FL surface mounted fixtures.
1.02	ID.304. Partial RCP Janitor	CHANGE: Delete crown moulding (used to be hall to mail room)
1.03	Dog Wash	CHANGE: Delete t-bar ceiling as indicated on ID 304. Now drywall ceiling. Change two (2) FL1 fixtures to FL surface mounted fixtures (as per email dated March 27.19 to O'Neil Electric).
1.04	Amenity Kitchenette Shop Drawings	CLARIFICATION: All receptacles mount in bottom of upper cabinets. Led strip lights at front of upper cabinets.

End of Site Instruction

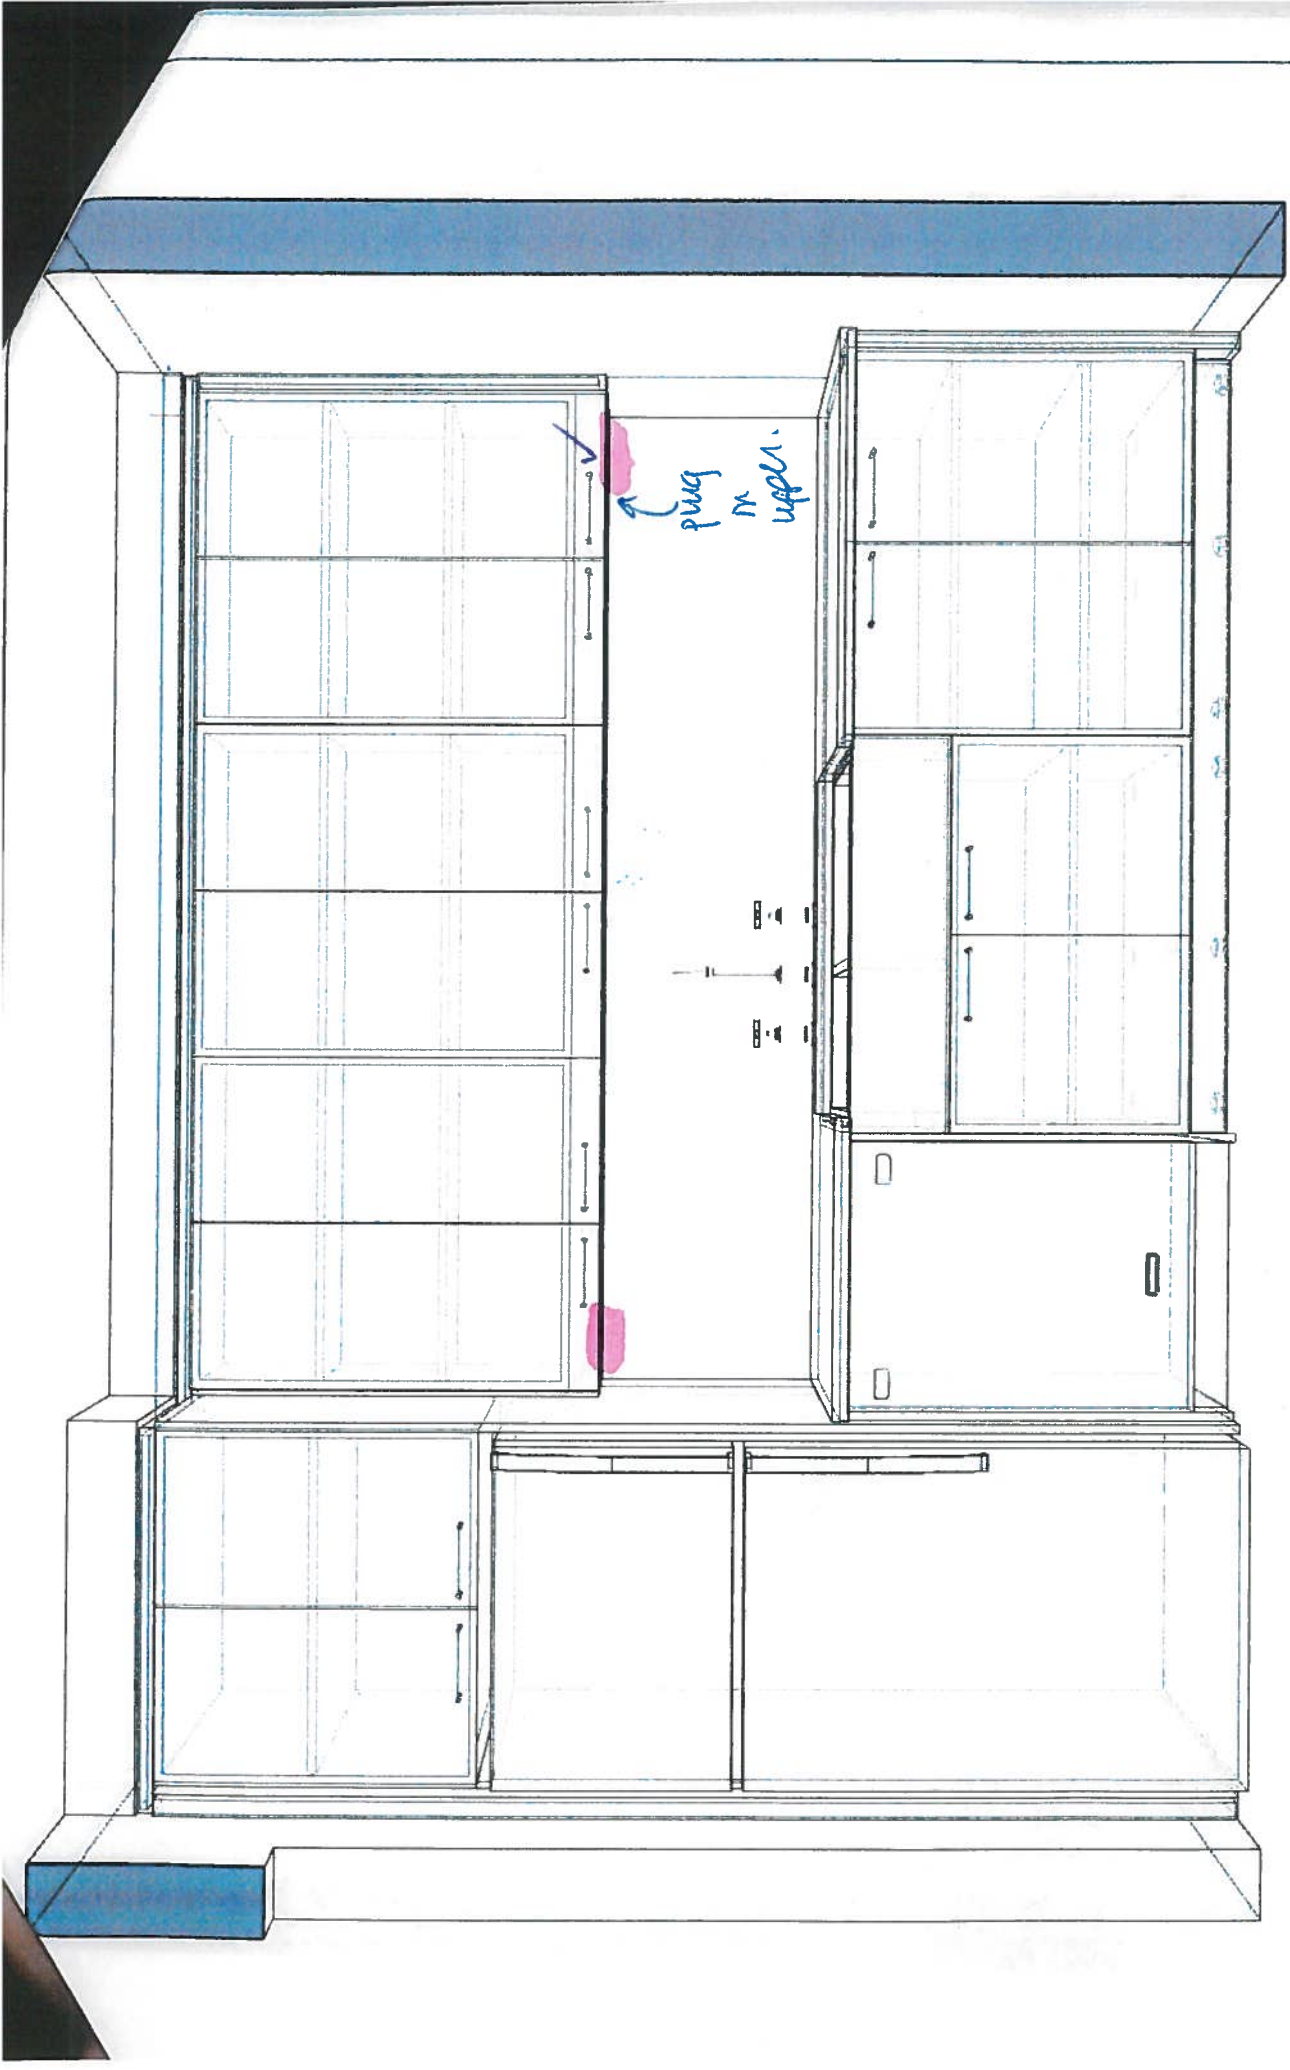

DRAWN BY: AB/LB


AMENITY KITCHEN
X-RAY VIEW 2



ID 323


ROYAL PINE HOMES - HAMPTON MANOR

2/12/19

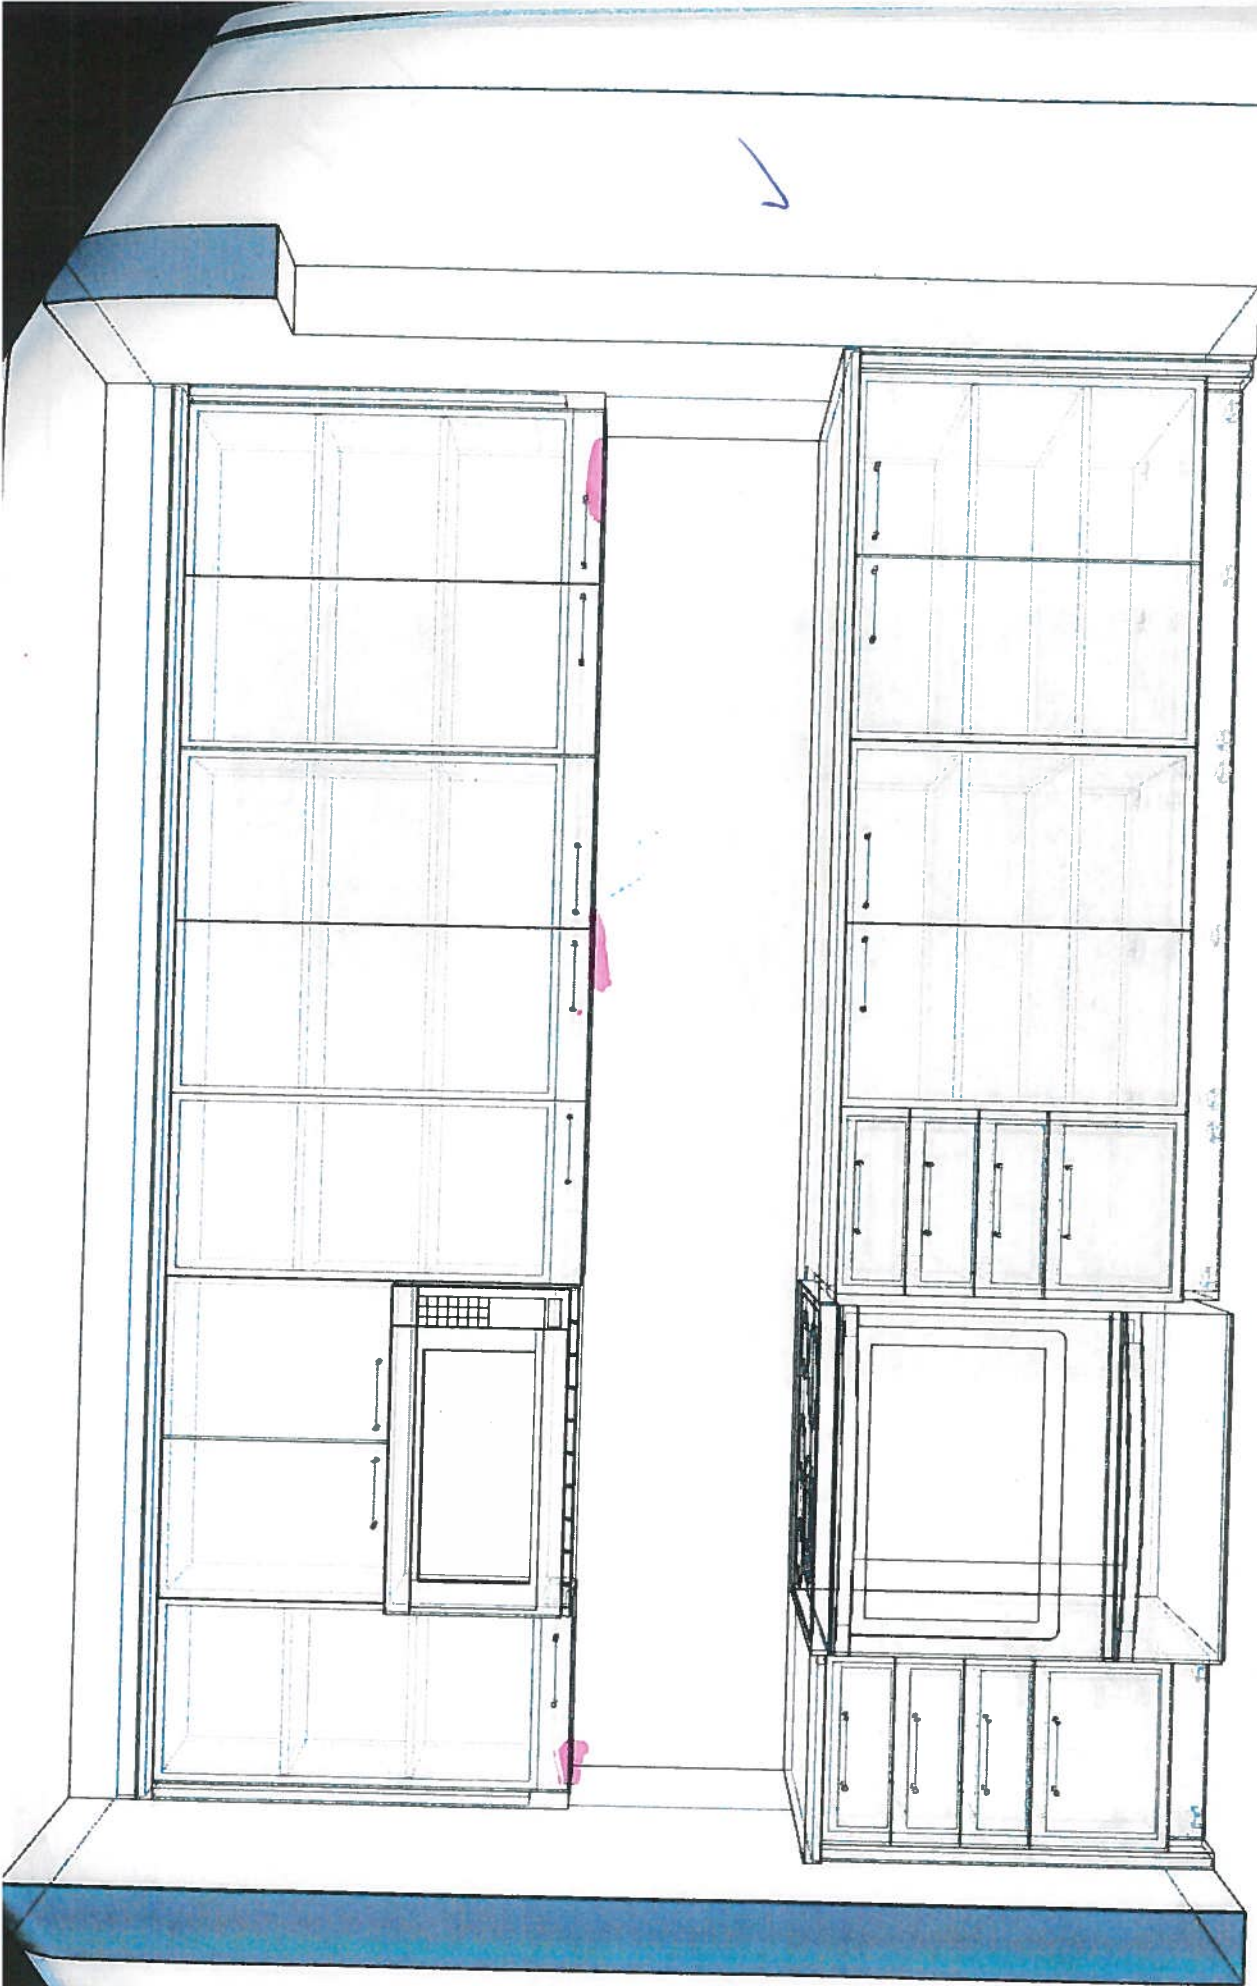

DRAWN BY: AB / LB

AMENITY KITCHEN
X-RAY VIEW 1

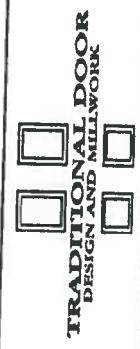

ID 323

ROYAL PINE HOMES - HAMPTON MANOR

2/12/19