

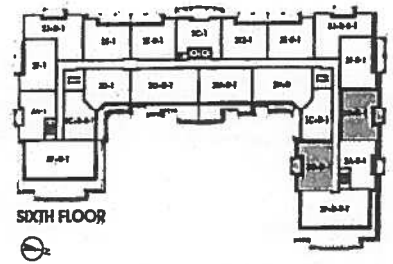


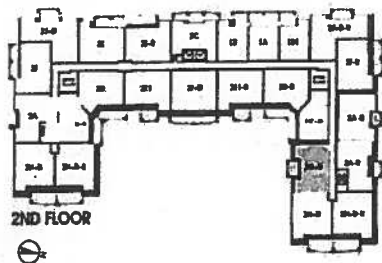

Noyac Bay

1,121 SQ FT *plus* 76sq. ft. of balcony area

SUITE 606
NEW ORIGINAL LAYOUT
INVENTORY SUITE

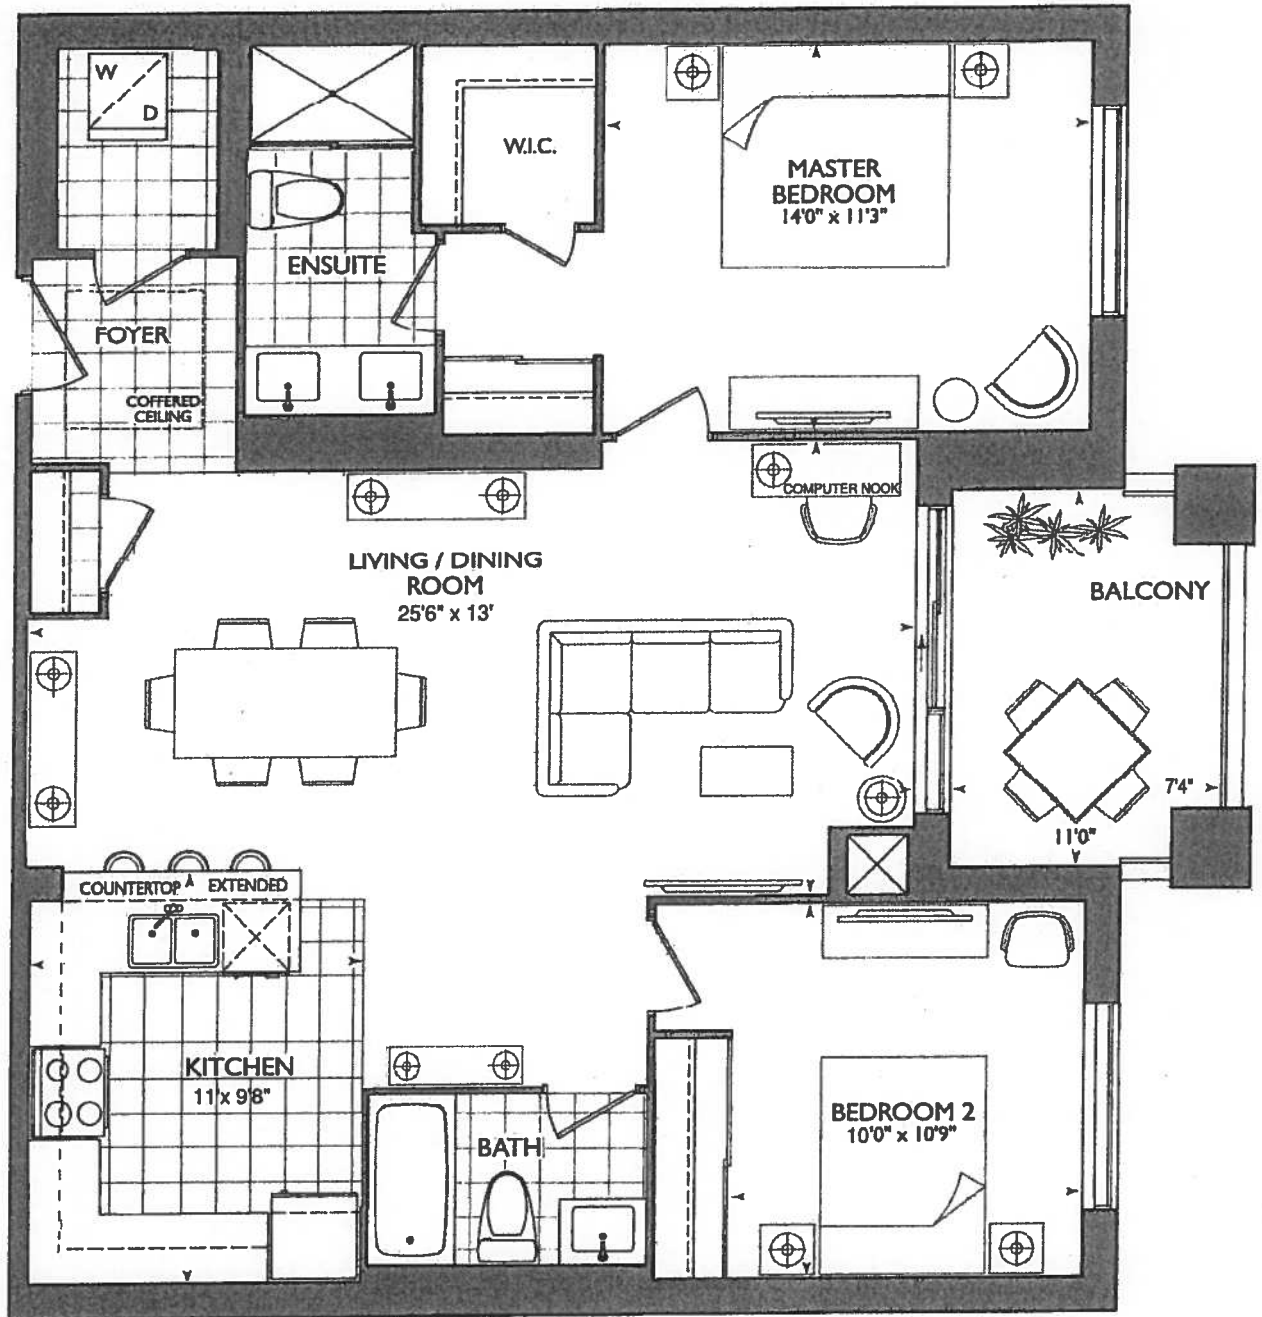


Plans and specifications are subject to change without notice. Actual usable floor space may vary from the stated floor area. All renderings are artist's concept E. & O. E.

Suite Hampton


Living Room

→ CONDUIT:

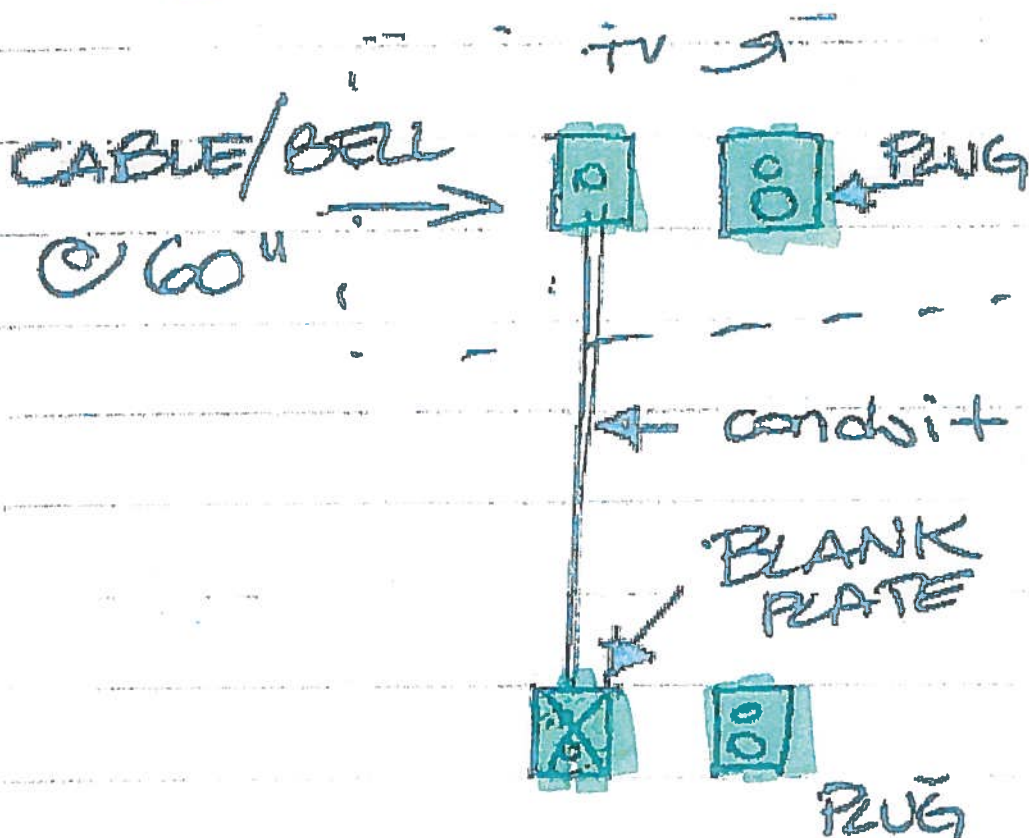

* KITCHEN *

- STANDARD KITCHEN LAYOUT
- 1ST UPG. APPLIANCE PACKAGE WITH: 36" FRIDGE, CHIMNEY HOOD FAN, MICROWAVE SHELF
- 2 CAPPED PENDANT LIGHTS
- x 5 PUCK LIGHTS
- 64" STOVE CENTER
- 129" SINK PIPE CENTER
- x1 PLUG IN PENINSULA
- MAIN AND ENSUITE RAISED VANITYS
- 36 1/4" WITH 3" SPLASH
- OPTIONAL KITCHEN UPGRADES: MAGIC BASE CORNER UPPER CORNER 'L' SHAPED CABINET
- opt Pantry w Micro Shelf

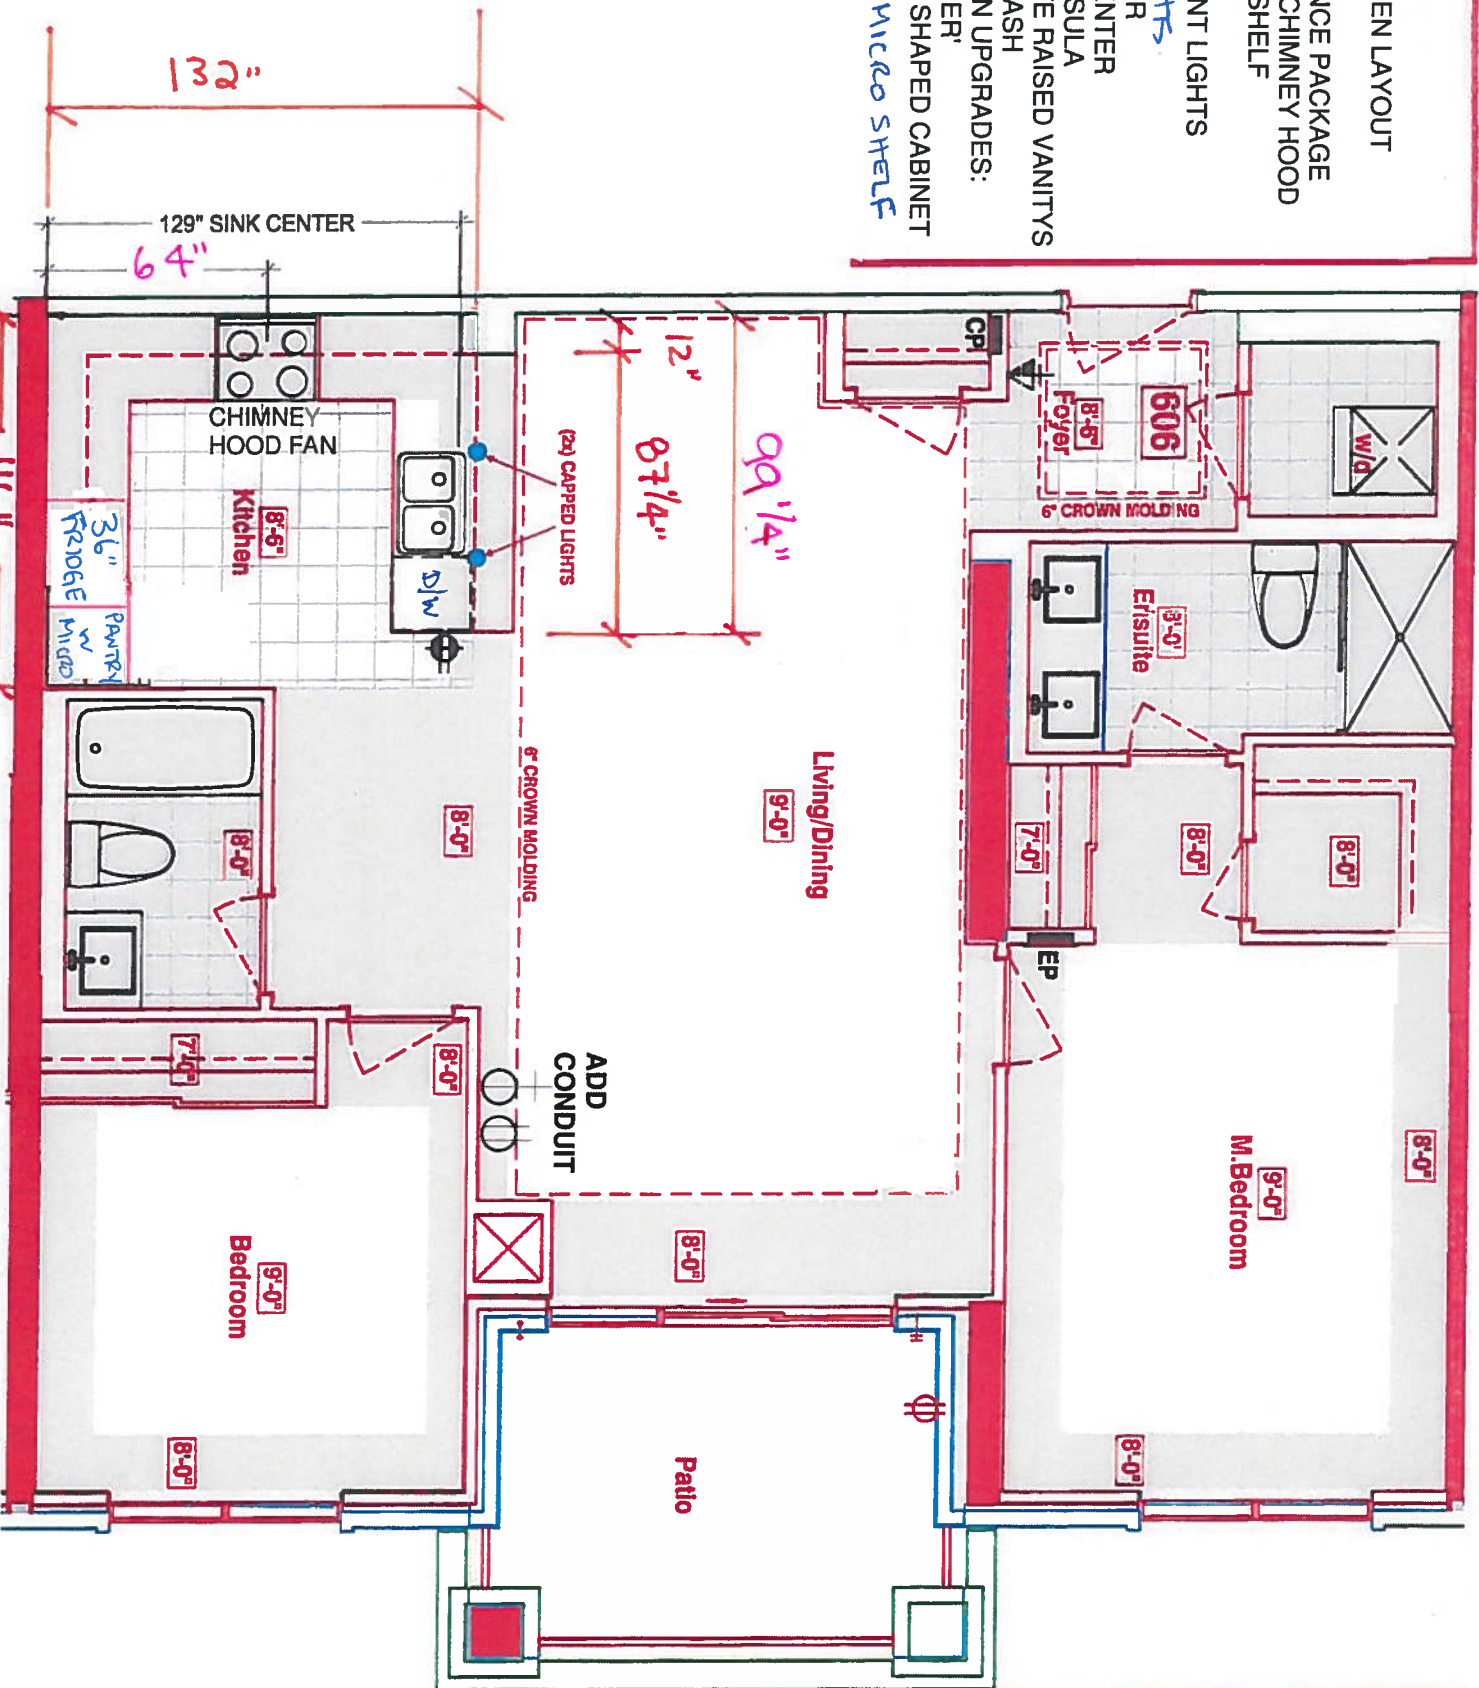


* SUITE 606 (INVENTORY SUITE)

- NEW PLAN
- REMOVED DEN
- REVISED KITCHEN
- * REVISED LAUNDRY DOOR SWING & ENSUITE WALL AS PER THIS BROCHURE


ADD 1 CONDUIT IN LIVING/ DINING ROOM + PLUG + BLOCKING FOR FUTURE MOUNTED TV

LEGEND:	
	SECURITY PANEL
	ELECTRICAL PANEL
	COMMUNICATION PANEL
	WATER METER
	FRIDGE
	DROPPED AREA
	6" CROWN MOLDING


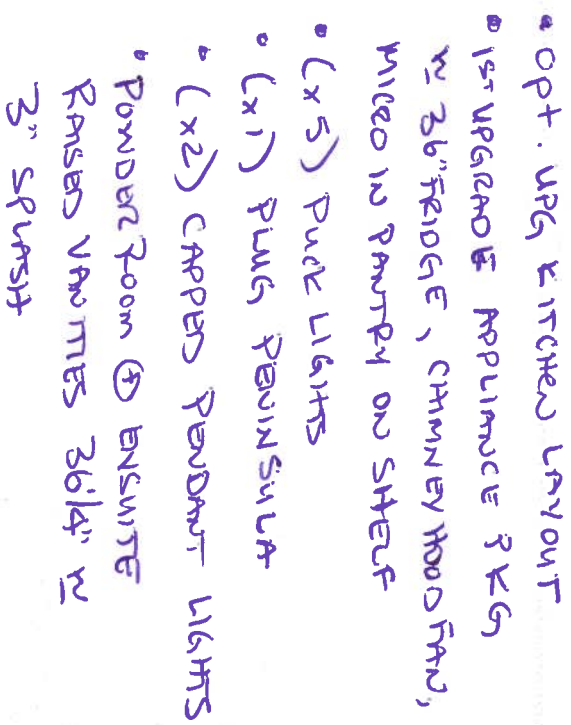


Rev. April 4/15.

CLIENT: ROYAL PINE HOMES	JOB NAME: UNIT 606 HMP	ROOM: KITCHEN	DRAWN BY: SK	COMMENTS: PLEASE NOTE ALL DIMENSIONS ARE NOT FINAL AND ARE SUBJECT TO CHANGE UPON FINAL SITE MEASURE
SITE: HAMPTON PLACE	DOOR STYLE: —	DOOR HANDLE: —	SCALE: 1/2" = 1'-0"	
PHONE: —	FINISH: —	DRW HANDLE: —	DATE: REVISED APRIL 4, 2019	
EMAIL: —	SPECIES: —	TOP: —	PAGE:	

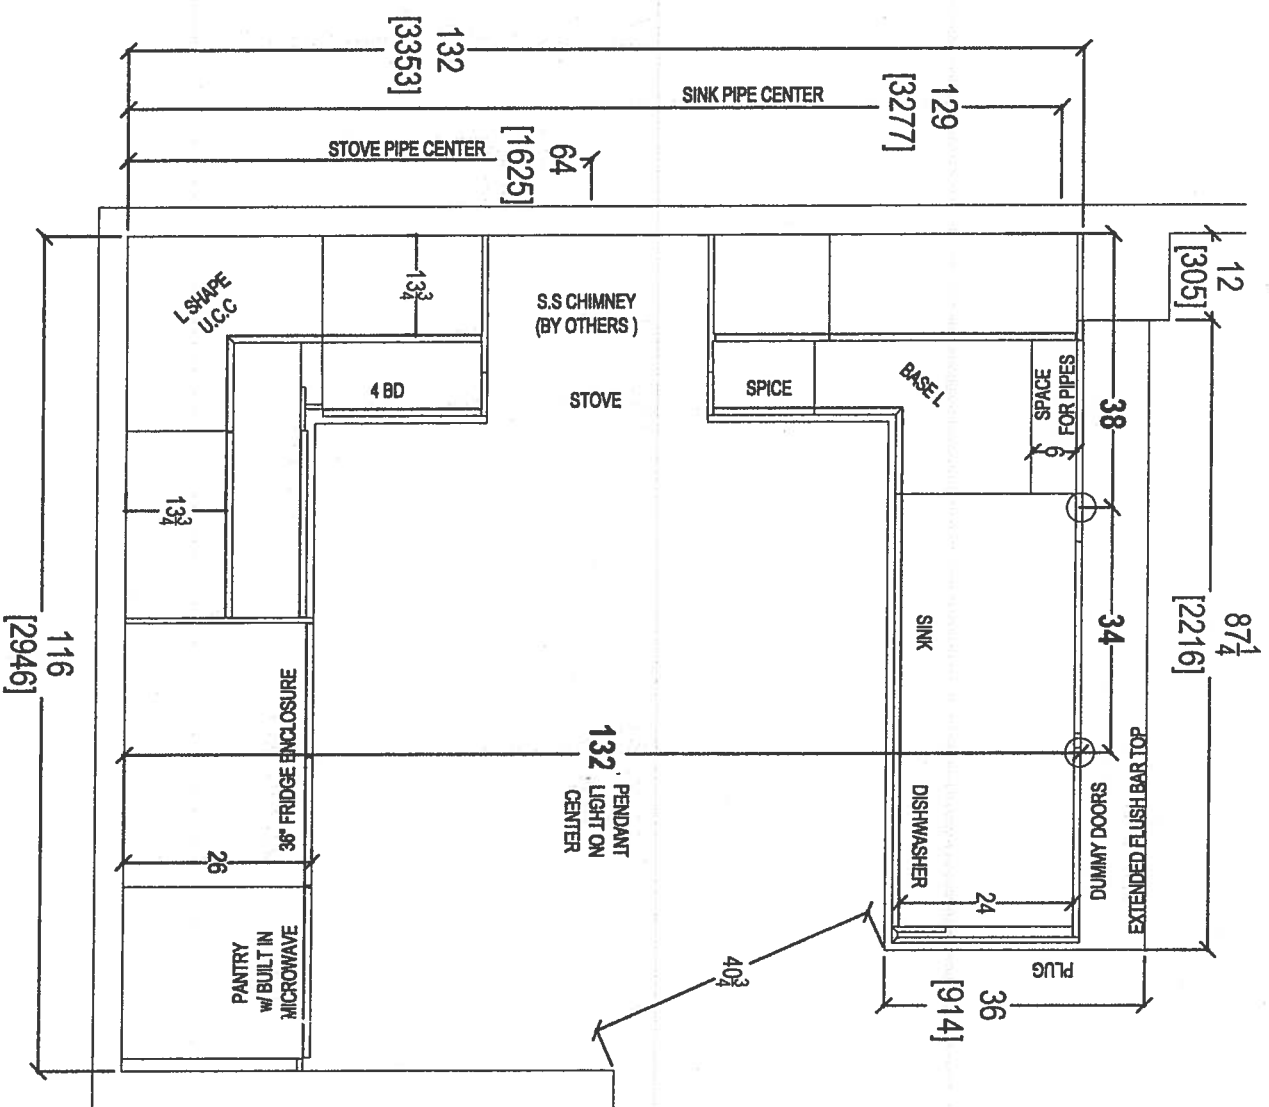


 your kitchen, your taste. 80 SANTE DRIVE, VAUGHAN, ON L4K 3C4, T: 416.746.1811 F: 905.761.5801			
CLIENT:	ROYAL PINE HOMES	JOB NAME:	UNIT 806 HMP
SITE:	HAMPTON PLACE	DOOR STYLE:	—
PHONE:	—	FINISH:	—
EMAIL:	—	SPECIES:	—
		ROOM:	KITCHEN
		DOOR HANDLE:	—
		DRW HANDLE:	—
		TOP:	—
		DRAWN BY:	SK
		SCALE:	1/2" = 1' - 0"
		DATE:	REVISED APRIL 4, 2019
		PAGE:	
		COMMENTS: PLEASE NOTE ALL DIMENSIONS ARE NOT FINAL AND ARE SUBJECT TO CHANGE UPON FINAL SITE MEASURE	

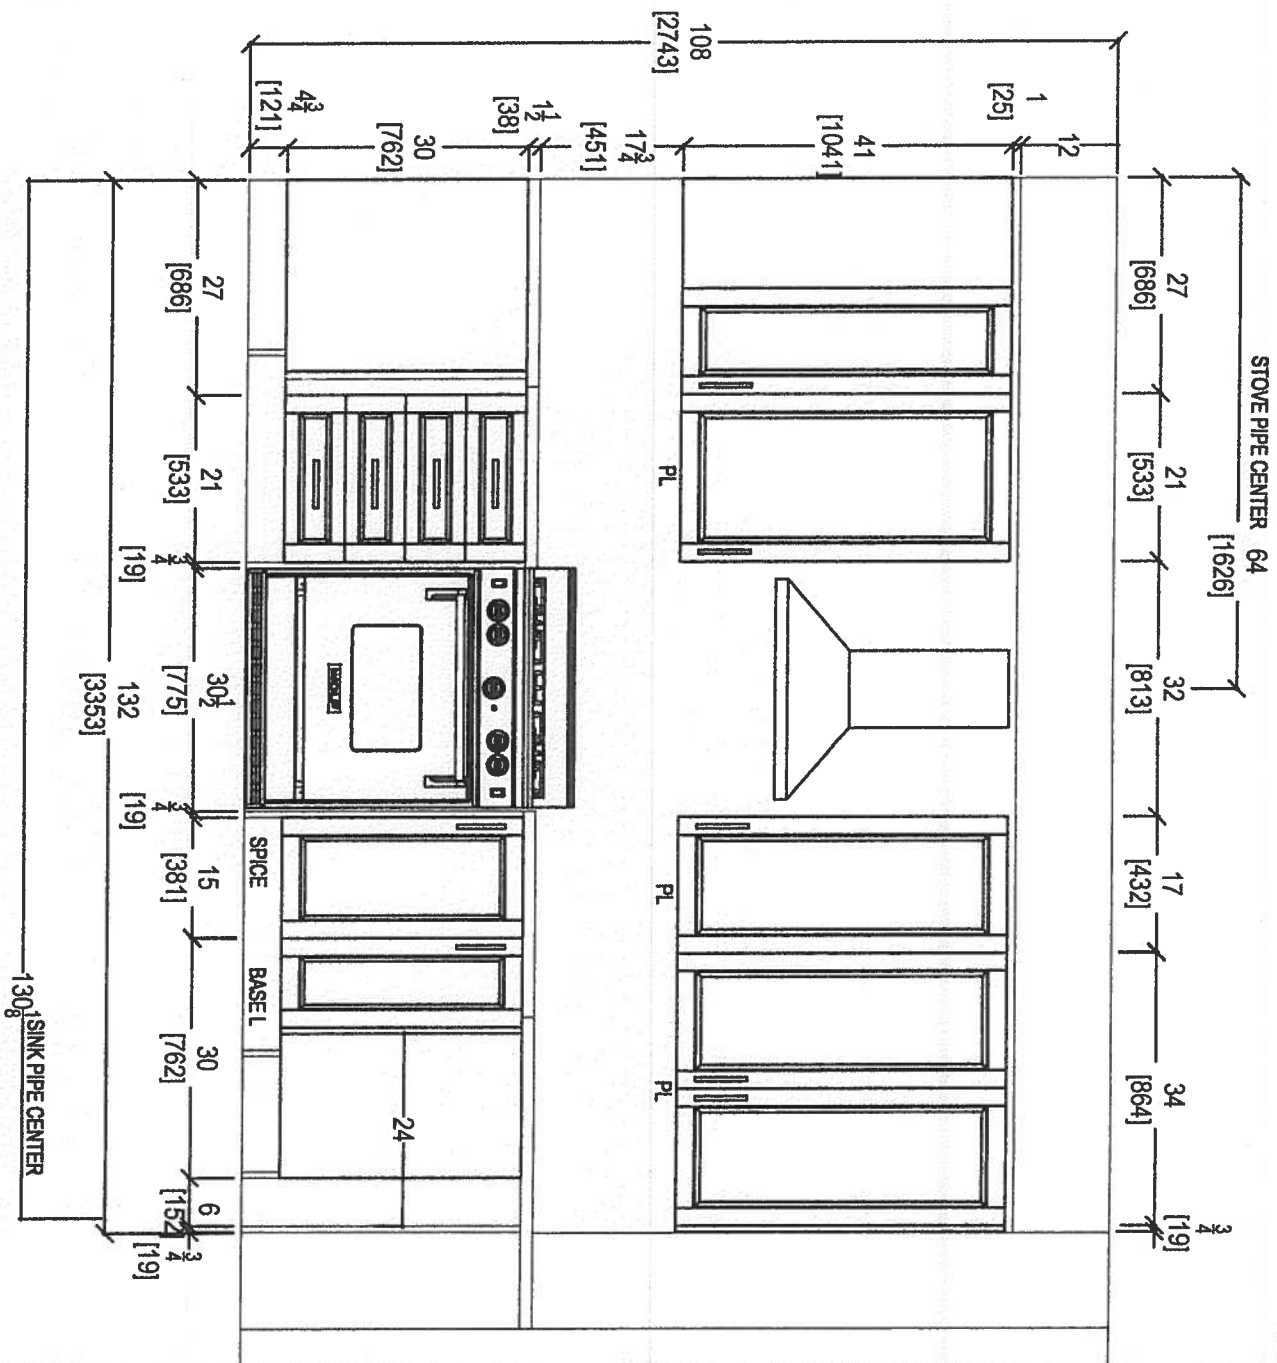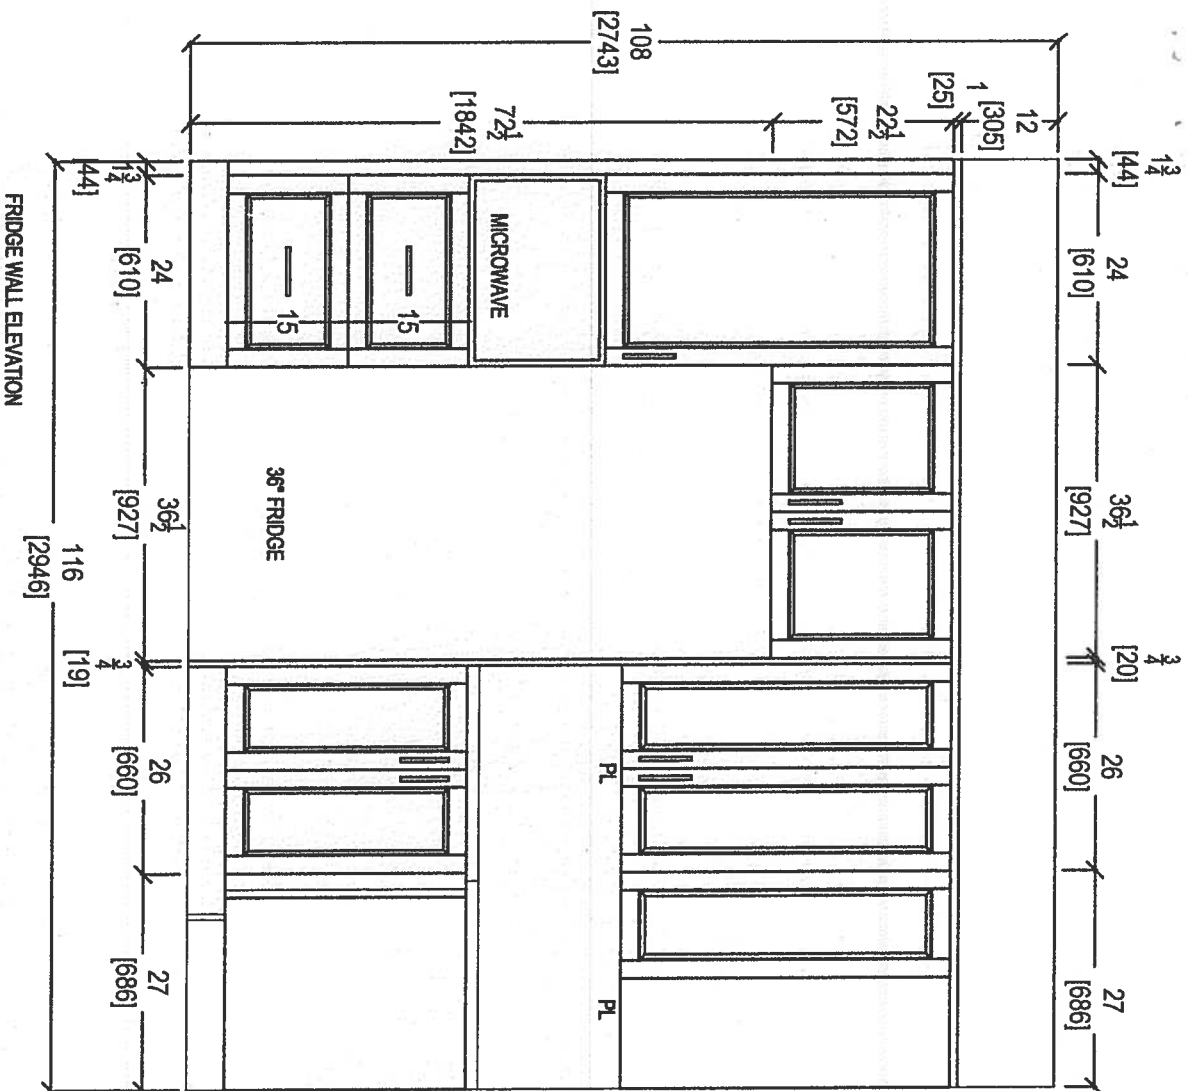


80 SANTE DRIVE, VAUGHAN, ON L4K 3C4,
T: 416.748.1811 F: 905.761.5801

CLIENT: ROYAL PINE HOMES	JOB NAME: UNIT 606 HMP	ROOM: KITCHEN	DRAWN BY: SK	COMMENTS:
SITE: HAMPTON PLACE	DOOR STYLE: —	DOOR HANDLE: —	SCALE: 1/2" = 1' - 0"	PLEASE NOTE ALL DIMENSIONS ARE NOT FINAL AND ARE SUBJECT TO CHANGE UPON FINAL SITE MEASURE
PHONE: —	FINISH: —	DRW HANDLE: —	DATE: REVISED APRIL 4, 2019	
EMAIL: —	SPECIES: —	TOP: —	PAGE:	

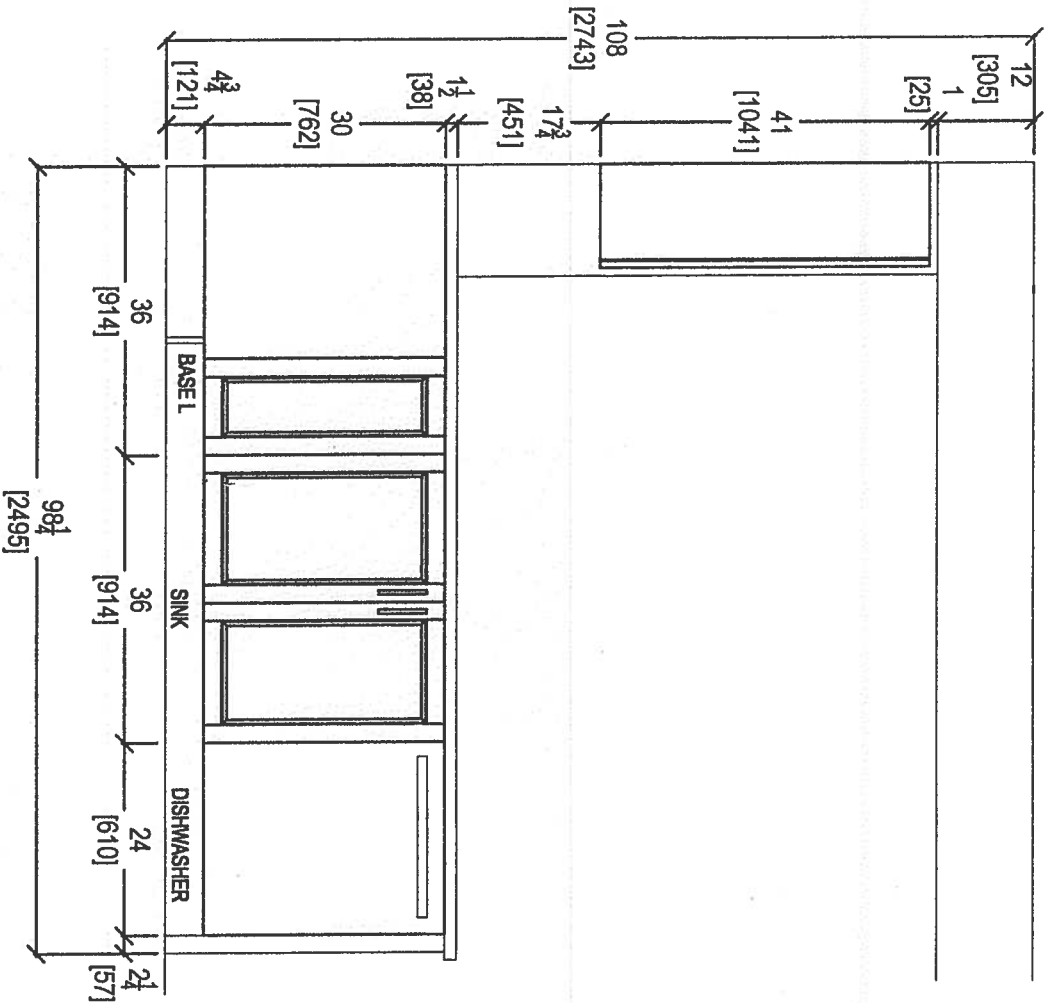

KITCHEN PENINSULA ELEVATION
FRONT VIEW

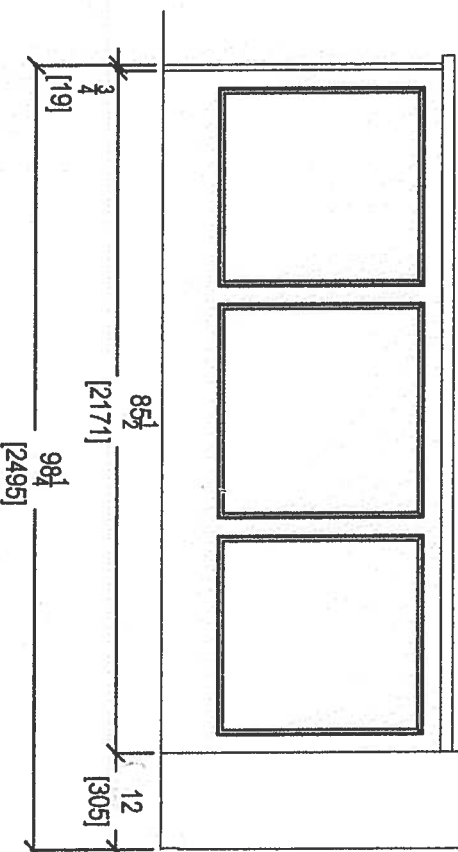


KITCHEN PENINSULA ELEVATION
REAR VIEW


your kitchen, your taste.
80 SANTE DRIVE, VAUGHAN, ON L4K 3C4,
T: 416.748.1811 F: 905.761.5801

CLIENT: ROYAL PINE HOMES	JOB NAME: UNIT 806 HMP	ROOM: KITCHEN	DRAWN BY: SK
SITE: HAMPTON PLACE	DOOR STYLE: —	DOOR HANDLE: —	SCALE: 1/2" = 1' - 0"
PHONE: —	FINISH: —	DRW HANDLE: —	DATE: REVISED APRIL 4, 2018
EMAIL: —	SPECIES: —	TOP: —	PAGE:



COMMENTS:
PLEASE NOTE ALL DIMENSIONS
ARE NOT FINAL AND ARE
SUBJECT TO CHANGE UPON
FINAL SITE MEASURE

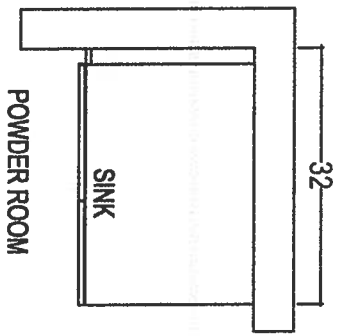

POWDER ROOM

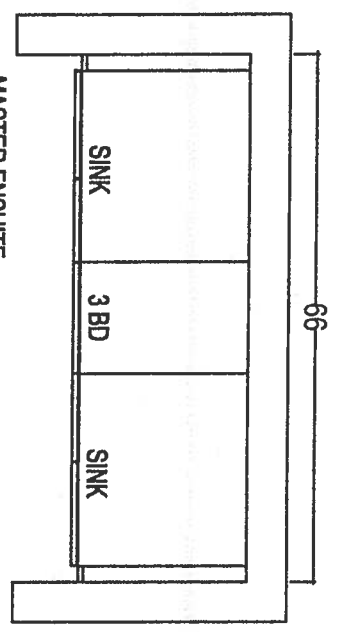

MASTER ENSUITE

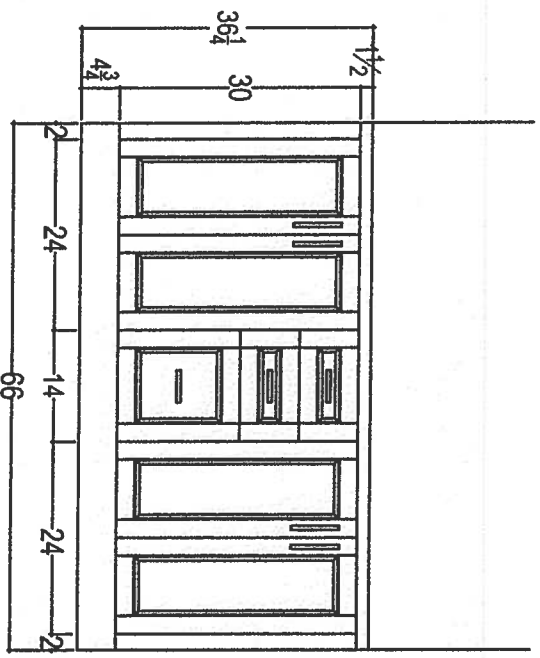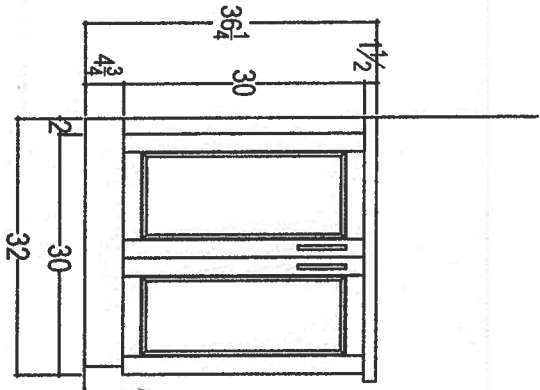

your kitchen, your taste.
80 SANTE DRIVE, VAUGHAN, ON L4K 3C4,
T: 416.748.1811 F: 905.761.5901

CLIENT: ROYAL PINE HOMES	JOB NAME: UNIT 606 HMP	ROOM: VANITIES	DRAWN BY: SK
SITE: HAMPTON PLACE	DOOR STYLE: --	DOOR HANDLE: --	SCALE: 1/2" = 1' - 0"
PHONE: --	FINISH: --	DRW HANDLE: --	DATE: REVISED APRIL 4, 2018
EMAIL: --	SPECIES: --	TOP: --	PAGE:

COMMENTS:

PLEASE NOTE ALL DIMENSIONS
ARE NOT FINAL AND ARE
SUBJECT TO CHANGE UPON
FINAL SITE MEASURE