




Noyac Bay

1,121 SQ FT *plus* 76 sq. ft. of balcony area


SUITE 609
ORIGINAL LAYOUT
INVENTORY SUITE

NEW


REVISED APR. 23.19

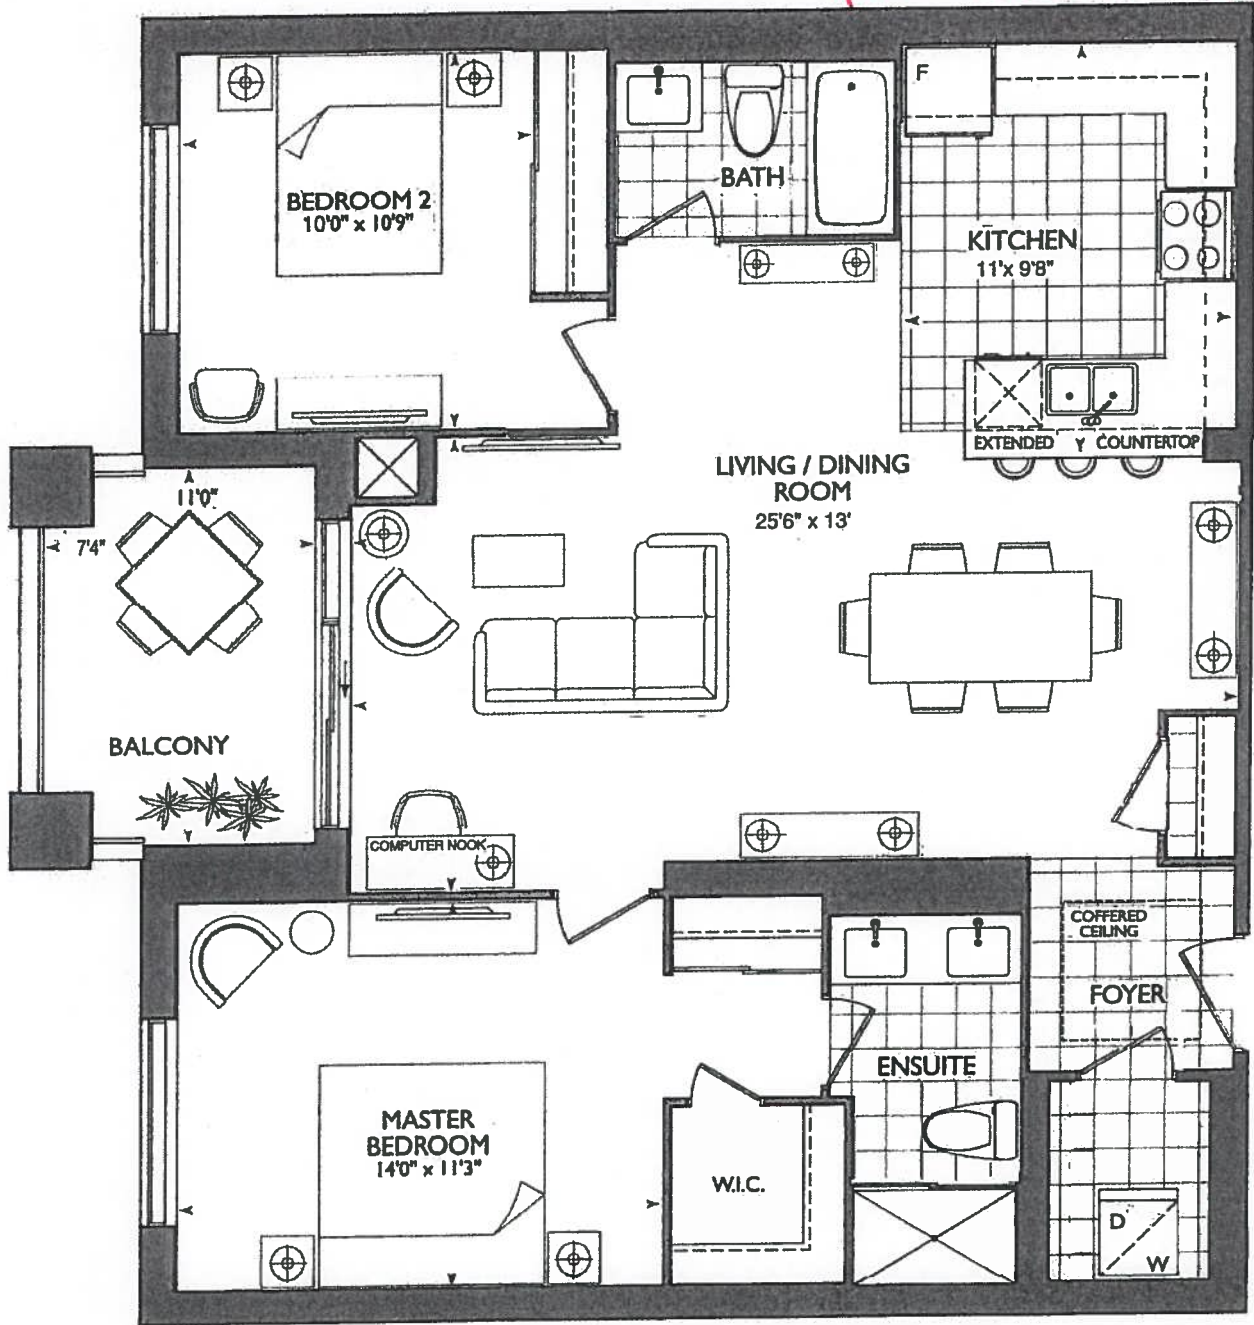

2ND FLOOR

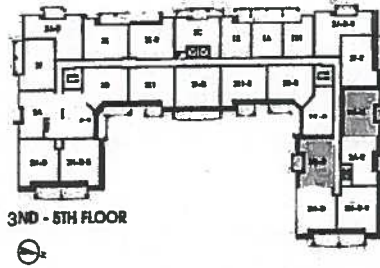

3ND - 5TH FLOOR

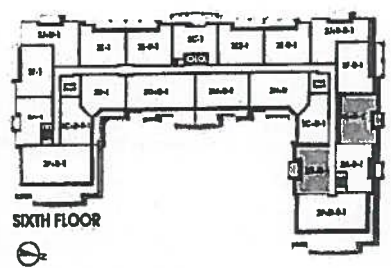


SIXTH FLOOR

Plans and specifications are subject to change without notice. Actual usable floor space may vary from the stated floor area. All renderings are artist's concept. E. & O. E.



* KITCHEN *

- STANDARD KITCHEN LAYOUT
- 1ST UPG. APPLIANCE PACKAGE WITH: 36" FRIDGE, CHIMNEY HOOD FAN, MICROWAVE SHELF
- 2 CAPPED PENDANT LIGHTS
- *-X5 puck lights*
- 61" STOVE CENTER
- 129" SINK PIPE CENTER
- x1 PLUG IN PENINSULA
- MAIN AND ENSUITE RAISED VANITYS 36 1/4" WITH 3" SPLASH
- OPTIONAL KITCHEN UPGRADES: MAGIC BASE CORNER' UPPER CORNER 'L' SHAPED CABINET
- *opt pantry w/ micro shelf*

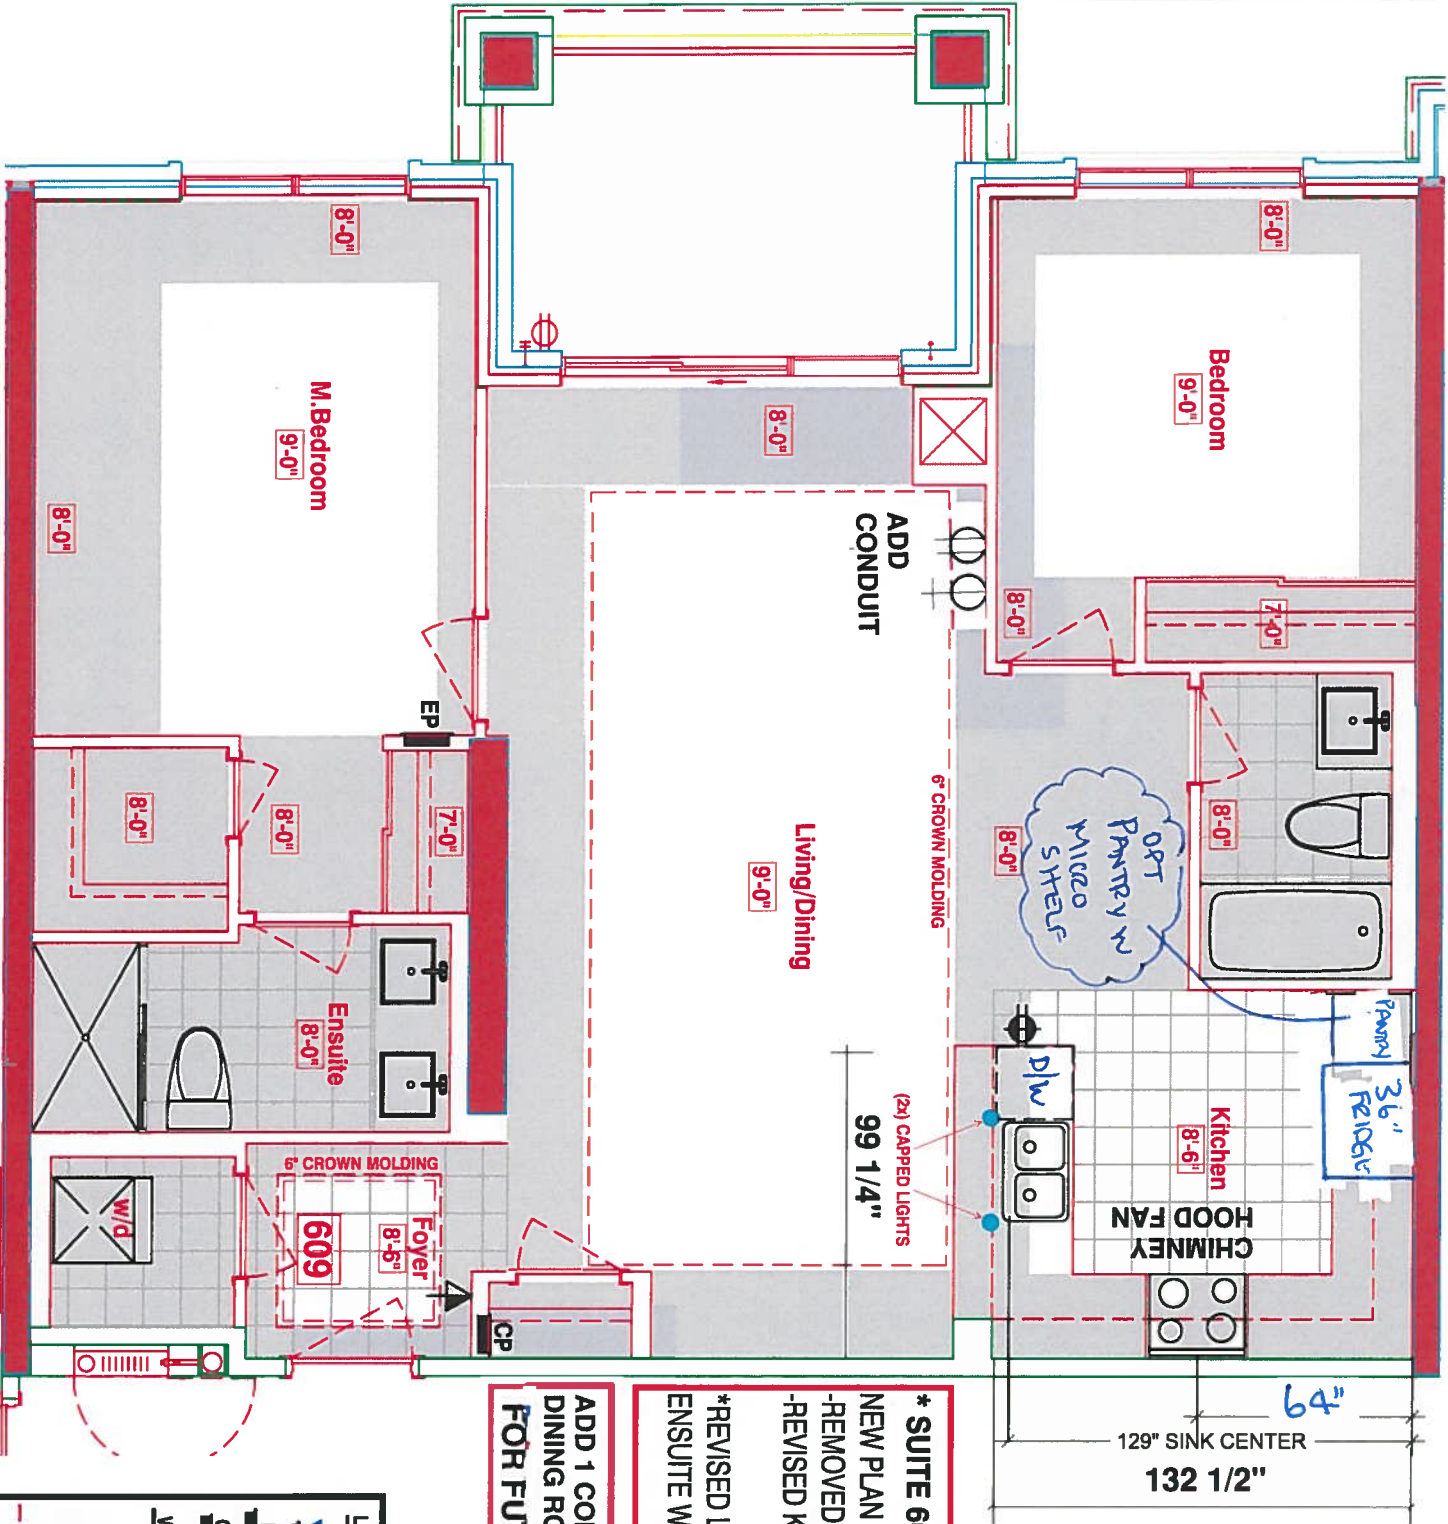

* SUITE 609 * (INVENTORY SUITE)

- NEW PLAN
- REMOVED DEN
- REVISED KITCHEN
- *REVISED LAUNDRY DOOR SWING & ENSUITE WALL AS PER THIS BROCHURE


ADD 1 CONDUIT IN LIVING/ DINING ROOM + PLUG + BLOCKING FOR FUTURE MOUNTED TV

LEGEND:	
	SECURITY PANEL
	ELECTRICAL PANEL
	COMMUNICATION PANEL
	WATER METER
	FRIDGE
	DROPPED AREA
	6" CROWN MOLDING

Suite
Hampton

Living Room

→ CONDUIT :

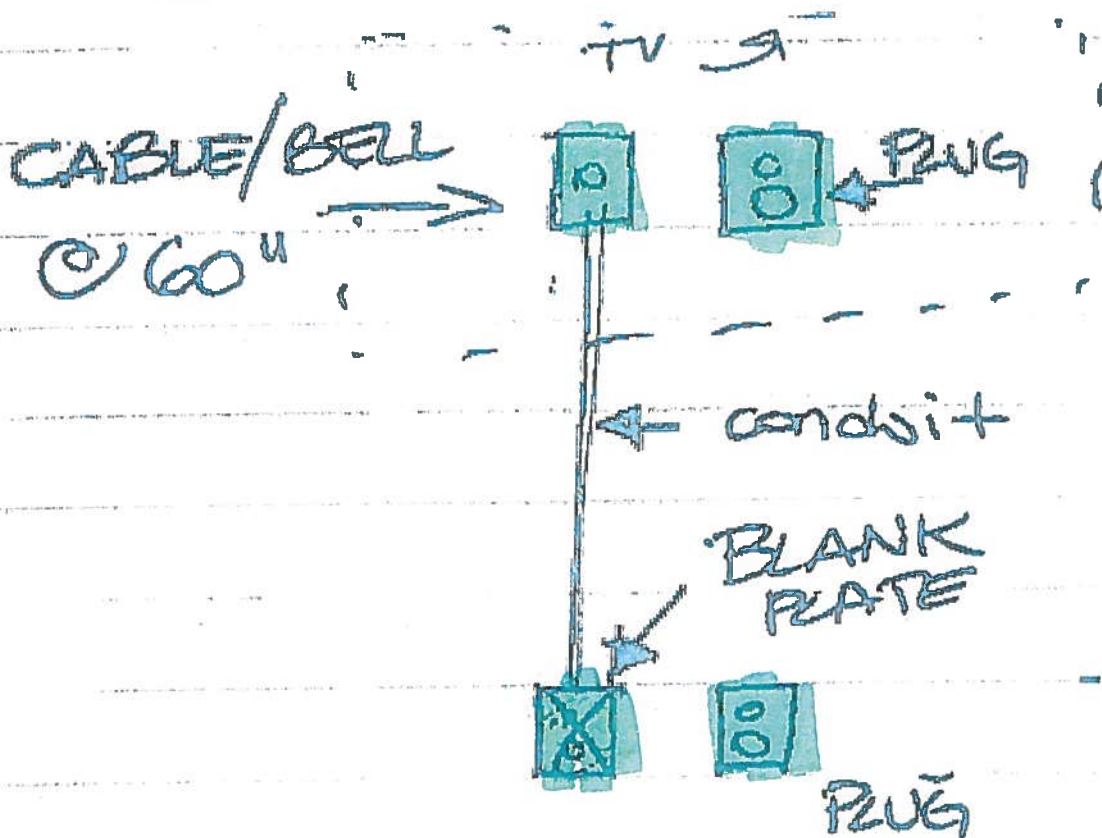


6003

Rev. April 14/19

- OPT W/6 KITCHEN LAYOUT
- 1ST UPGRADE APPLIANCE PKG w/ 36" RANGE, CHIMNEY HOOD FAN, MICAS IN PANTRY AND SILEX


- (x5) = PUCK LIGHTS
- (x2) = CAPPED PENDANT LIGHTS
- (x1) = PLUG PENNSULA
- POWDER ROOM + ENSUITE
- PANSER VANITIES
- 36 1/4" @ 3" SPLASH

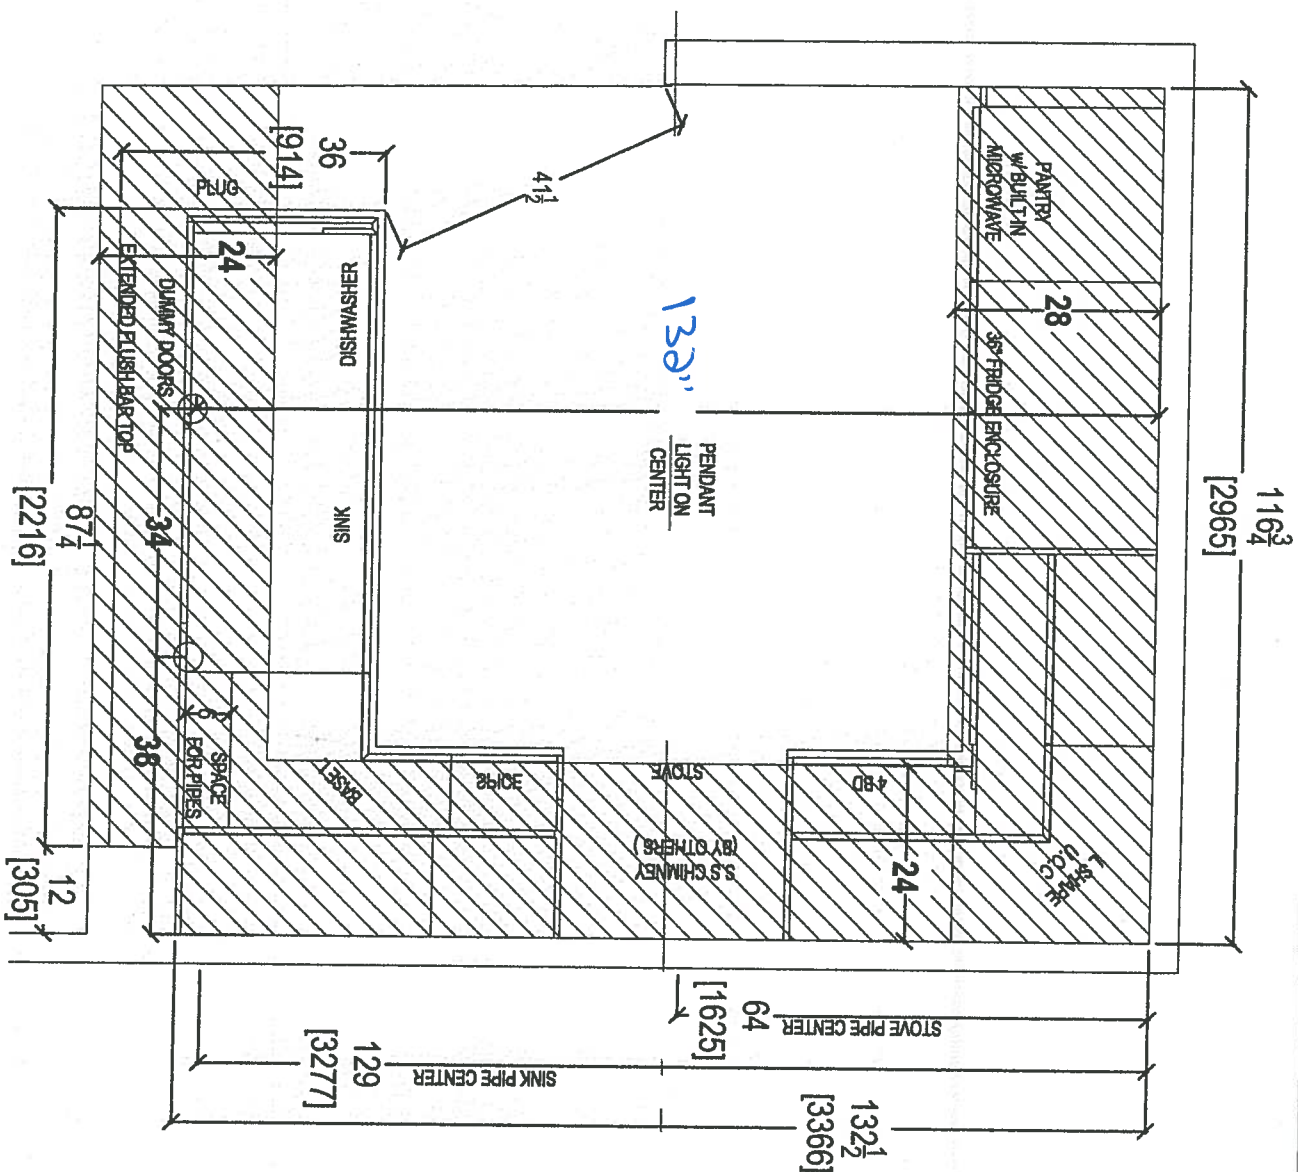

CLIENT: ROYAL PINE HOMES	JOB NAME: UNIT 608 HMP	ROOM: KITCHEN	DRAWN BY: SK	COMMENTS:
SITE: HAMPTON PLACE	DOOR STYLE: —	DOOR HANDLE: —	SCALE: 1/2" = 1'-0"	PLEASE NOTE ALL DIMENSIONS ARE NOT FINAL AND ARE SUBJECT TO CHANGE UPON FINAL SITE MEASURE
PHONE: —	FINISH: —	DRAW HANDLE: —	DATE: REVISED: APRIL 4, 2019	
EMAIL: —	SPECIES: —	TOP: —	PAGE:	





your kitchen, your taste.
80 SANTE DRIVE, VAUGHAN, ON L4K 3C4,
T: 416.748.1811 F: 905.781.3801

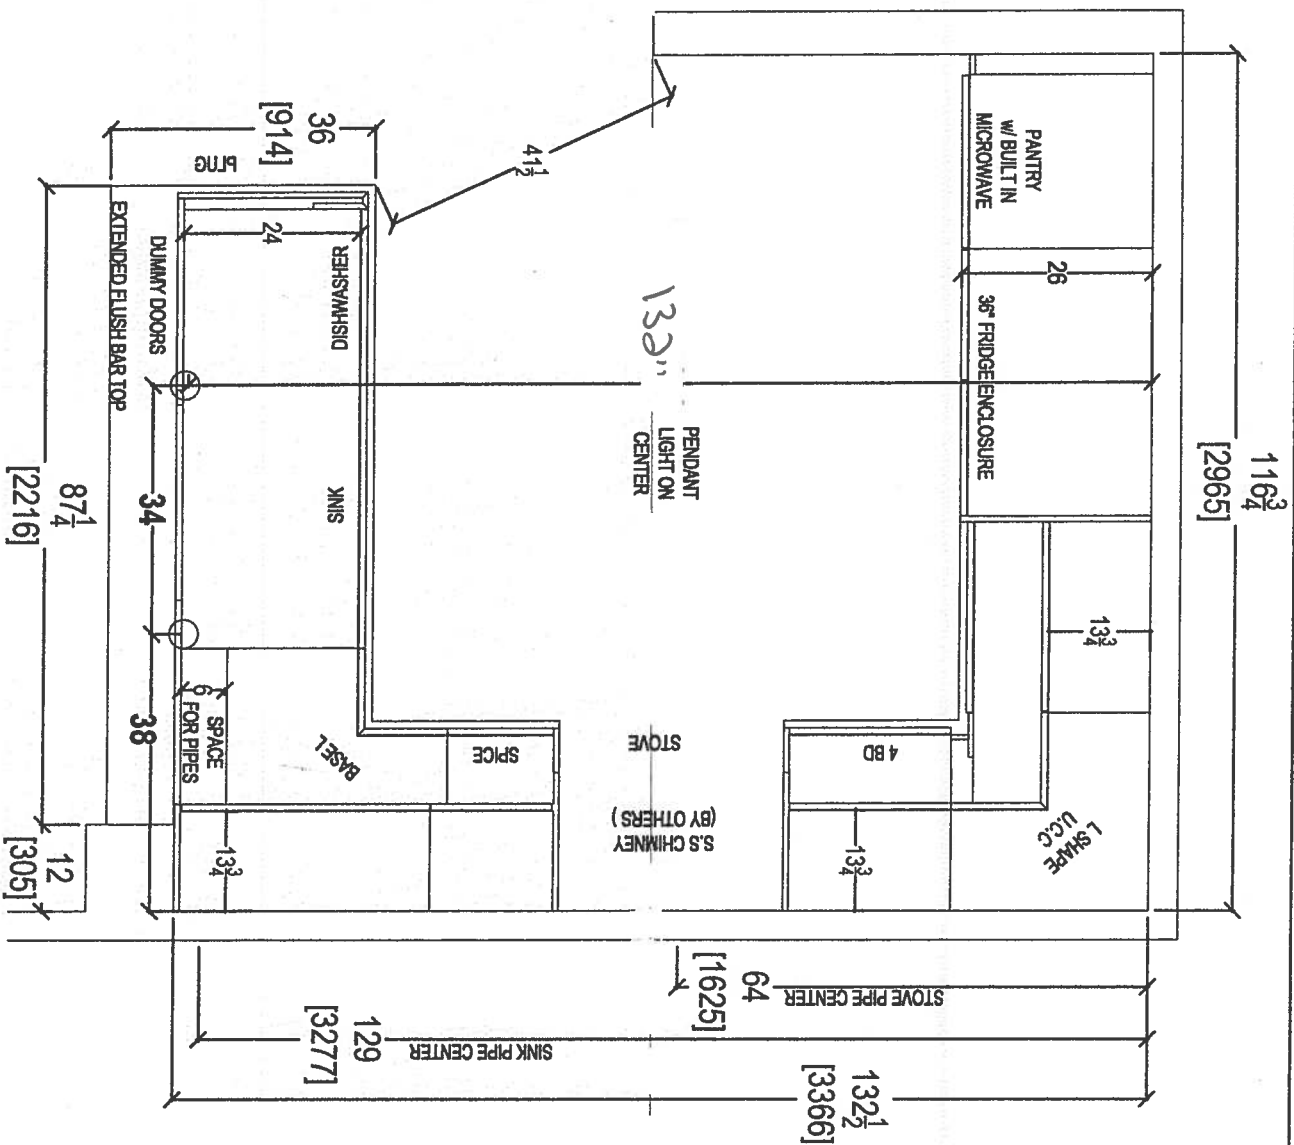


CLIENT: ROYAL PINE HOMES		JOB NAME: UNIT 808 HMP	ROOM: KITCHEN	DRAWN BY: SK	COMMENTS: PLEASE NOTE ALL DIMENSIONS ARE NOT FINAL AND ARE SUBJECT TO CHANGE UPON FINAL SITE MEASURE
SITE: HAMPTON PLACE	DOOR STYLE: —	DOOR HANDLE: —	SCALE: 1/2" = 1' - 0"		
PHONE: —	FINISH: —	DRW HANDLE: —	DATE: REVISED: APRIL 4, 2019		
EMAIL: —	SPECIES: —	TOP: —	PAGE:		




80 SANTE DRIVE, VAUGHAN, ON L4K 3C4,
T: 416.746.1811 F: 905.761.5901

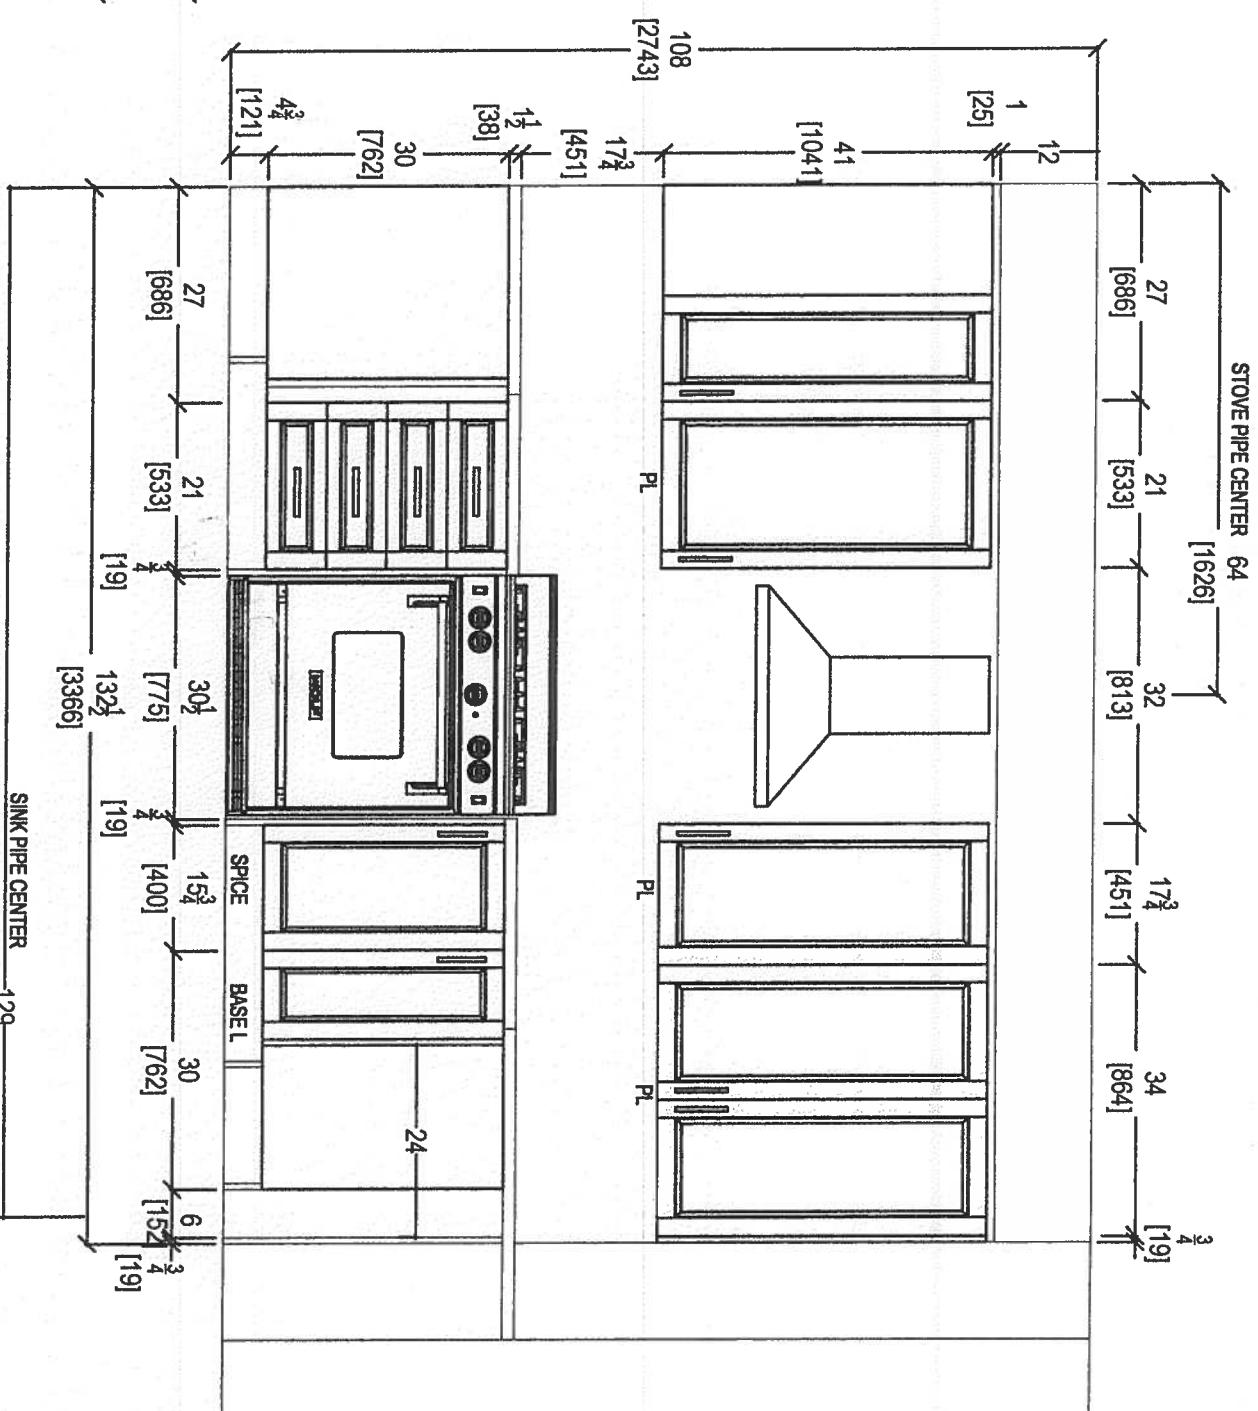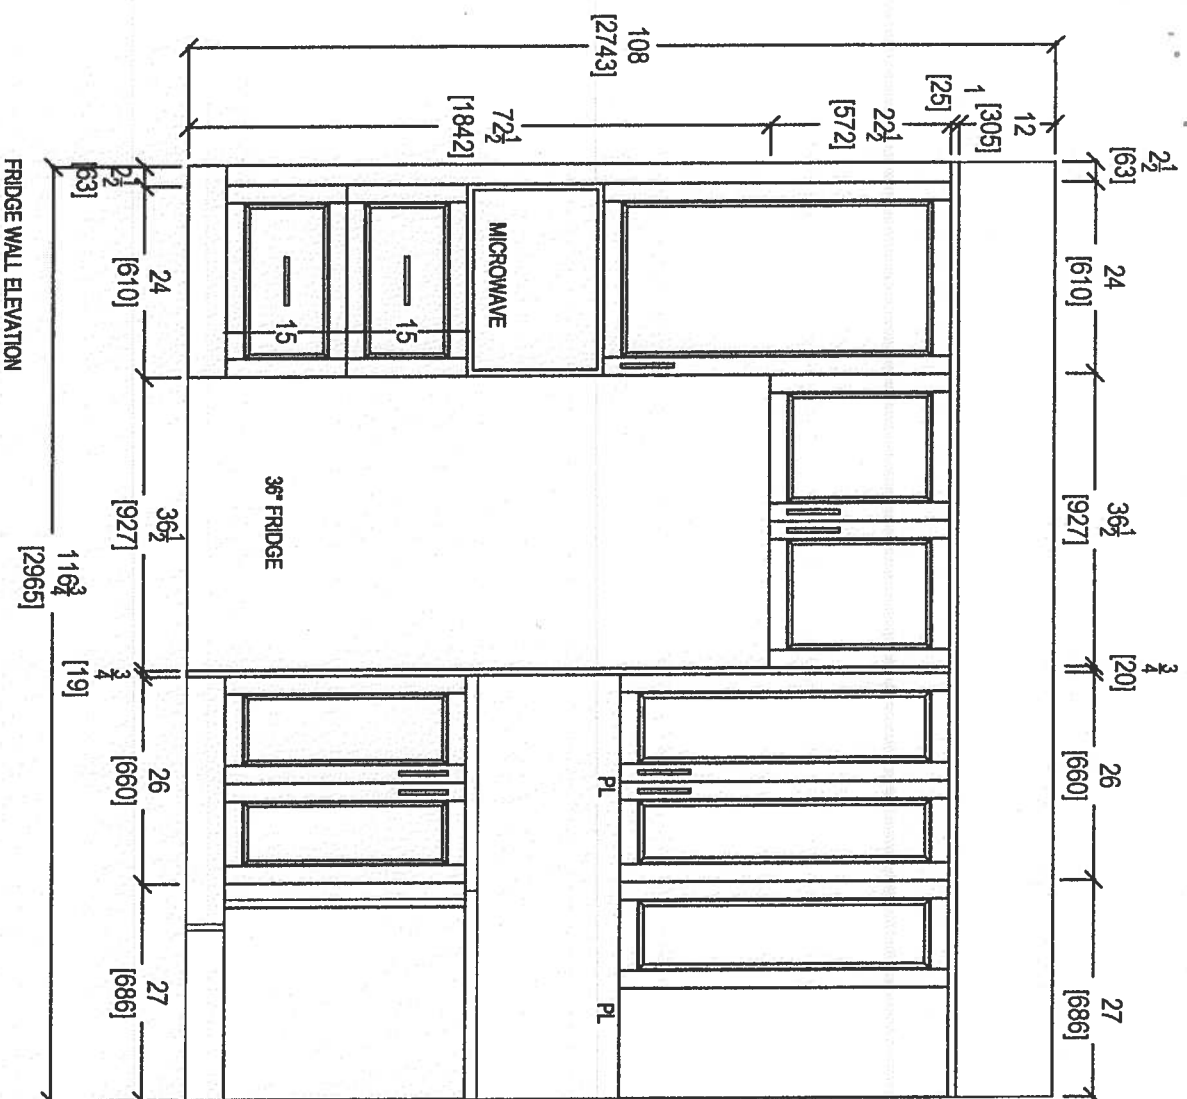

CLIENT: ROYAL PINE HOMES	JOB NAME: UNIT 609 HMP	ROOM: KITCHEN	DRAWN BY: SK	COMMENTS: PLEASE NOTE ALL DIMENSIONS ARE NOT FINAL AND ARE SUBJECT TO CHANGE UPON FINAL SITE MEASURE
SITE: HAMPTON PLACE	DOOR STYLE: ---	DOOR HANDLE: ---	SCALE: 1/2" = 1'-0"	
PHONE: ---	FINISH: ---	DRW HANDLE: ---	DATE: REVISED: APRIL 4, 2019	
EMAIL: ---	SPECIES: ---	TOP: ---	PAGE: ---	

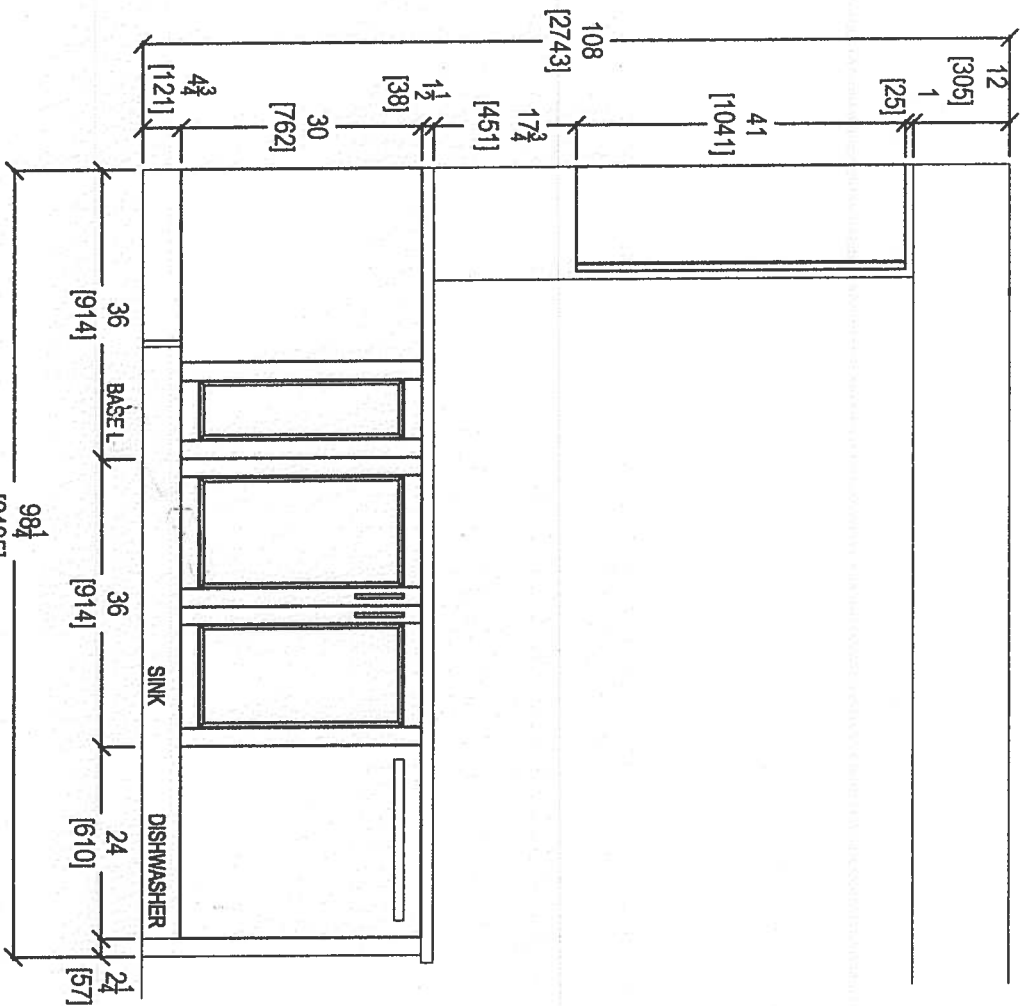

KITCHEN PENINSULA ELEVATION
FRONT VIEW

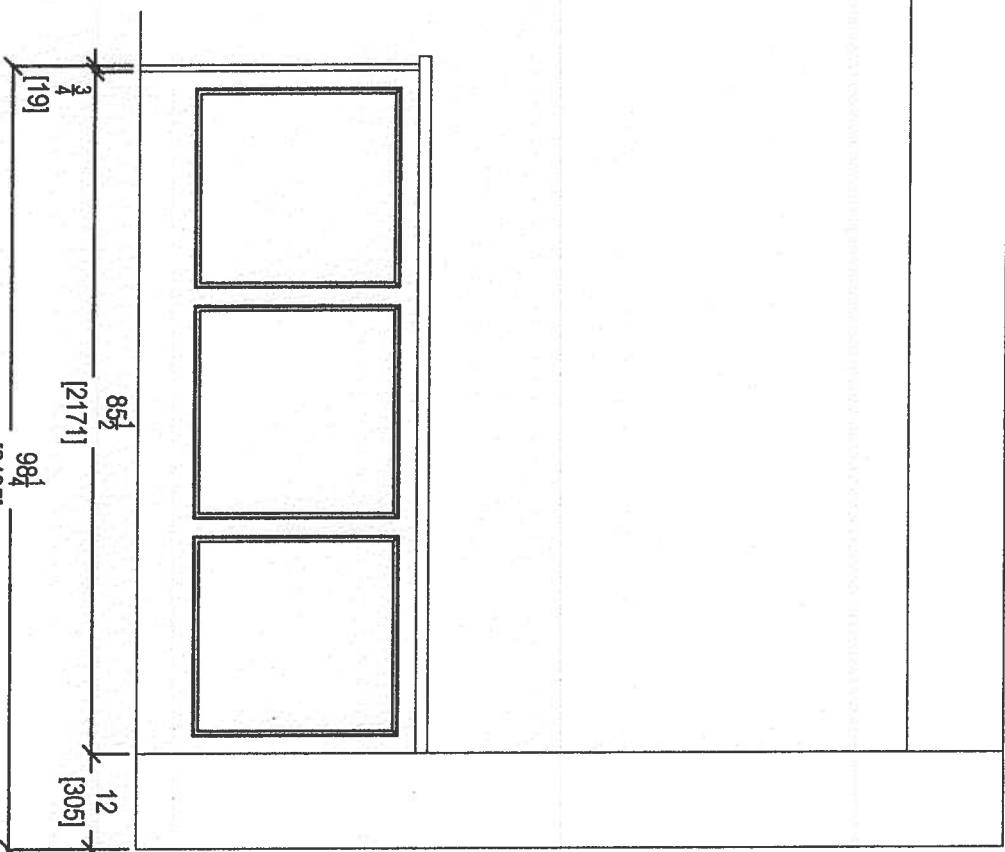

KITCHEN PENINSULA ELEVATION
REAR VIEW







80 SANTE DRIVE, VAUGHAN, ON L4K 3C4,
T: 416.748.1811 F: 905.761.5901

CLIENT: ROYAL PINE HOMES	JOB NAME: UNIT 609 HMP	ROOM: KITCHEN	DRAWN BY: SK
SITE: HAMPTON PLACE	DOOR STYLE: —	DOOR HANDLE: —	SCALE: 1/2" = 1'-0"
PHONE: —	FINISH: —	DRW HANDLE: —	DATE: REVISED, APRIL 4, 2019
EMAIL: —	SPECIES: —	TOP: —	PAGE:

COMMENTS:

PLEASE NOTE ALL DIMENSIONS
ARE NOT FINAL AND ARE
SUBJECT TO CHANGE UPON
FINAL SITE MEASURE

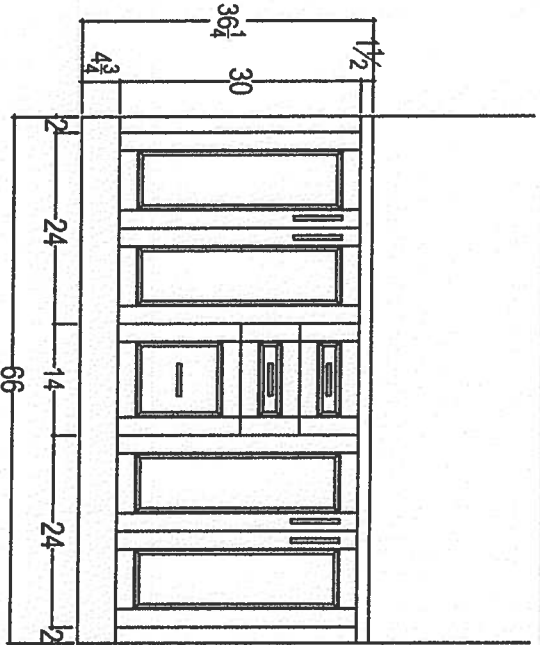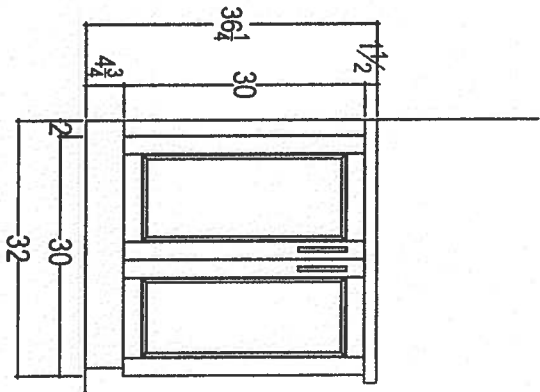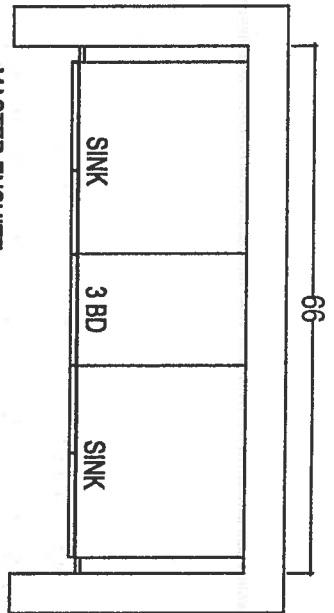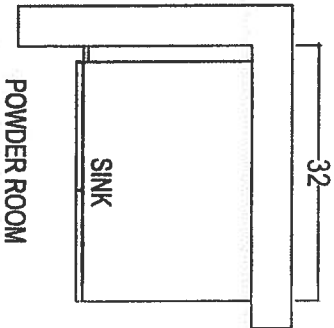

 your kitchen, your taste 80 SANTE DRIVE, VAUGHAN, ON L4K 3C4, T: 416.746.1811 F: 905.761.5901		CLIENT: ROYAL PINE HOMES		JOB NAME: UNIT 609 HMP		ROOM: VANITIES		DRAWN BY: SK		COMMENTS: PLEASE NOTE ALL DIMENSIONS ARE NOT FINAL AND ARE SUBJECT TO CHANGE UPON FINAL SITE MEASURE
SITE: HAMPTON PLACE		DOOR STYLE: —		DOOR HANDLE: —		SCALE: 1/2" = 1' - 0"				
PHONE: —		FINISH: —		DRW HANDLE: —		DATE: REVISED APRIL 4, 2019				
EMAIL: —		SPECIES: —		TOP: —		PAGE:				