

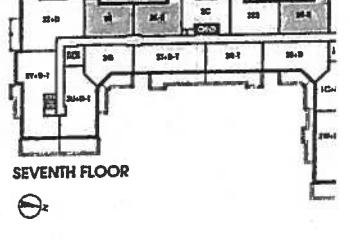
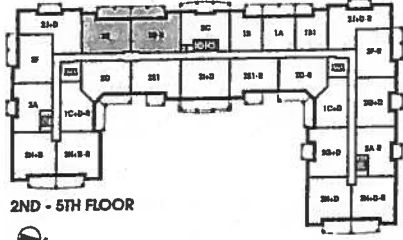


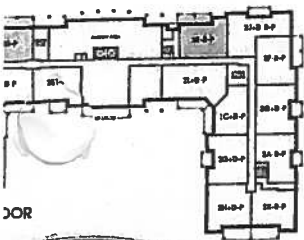

Flanders

ORIGINAL LAYOUT

1,059 SQ FT *plus 180 sq. ft. of balcony area*

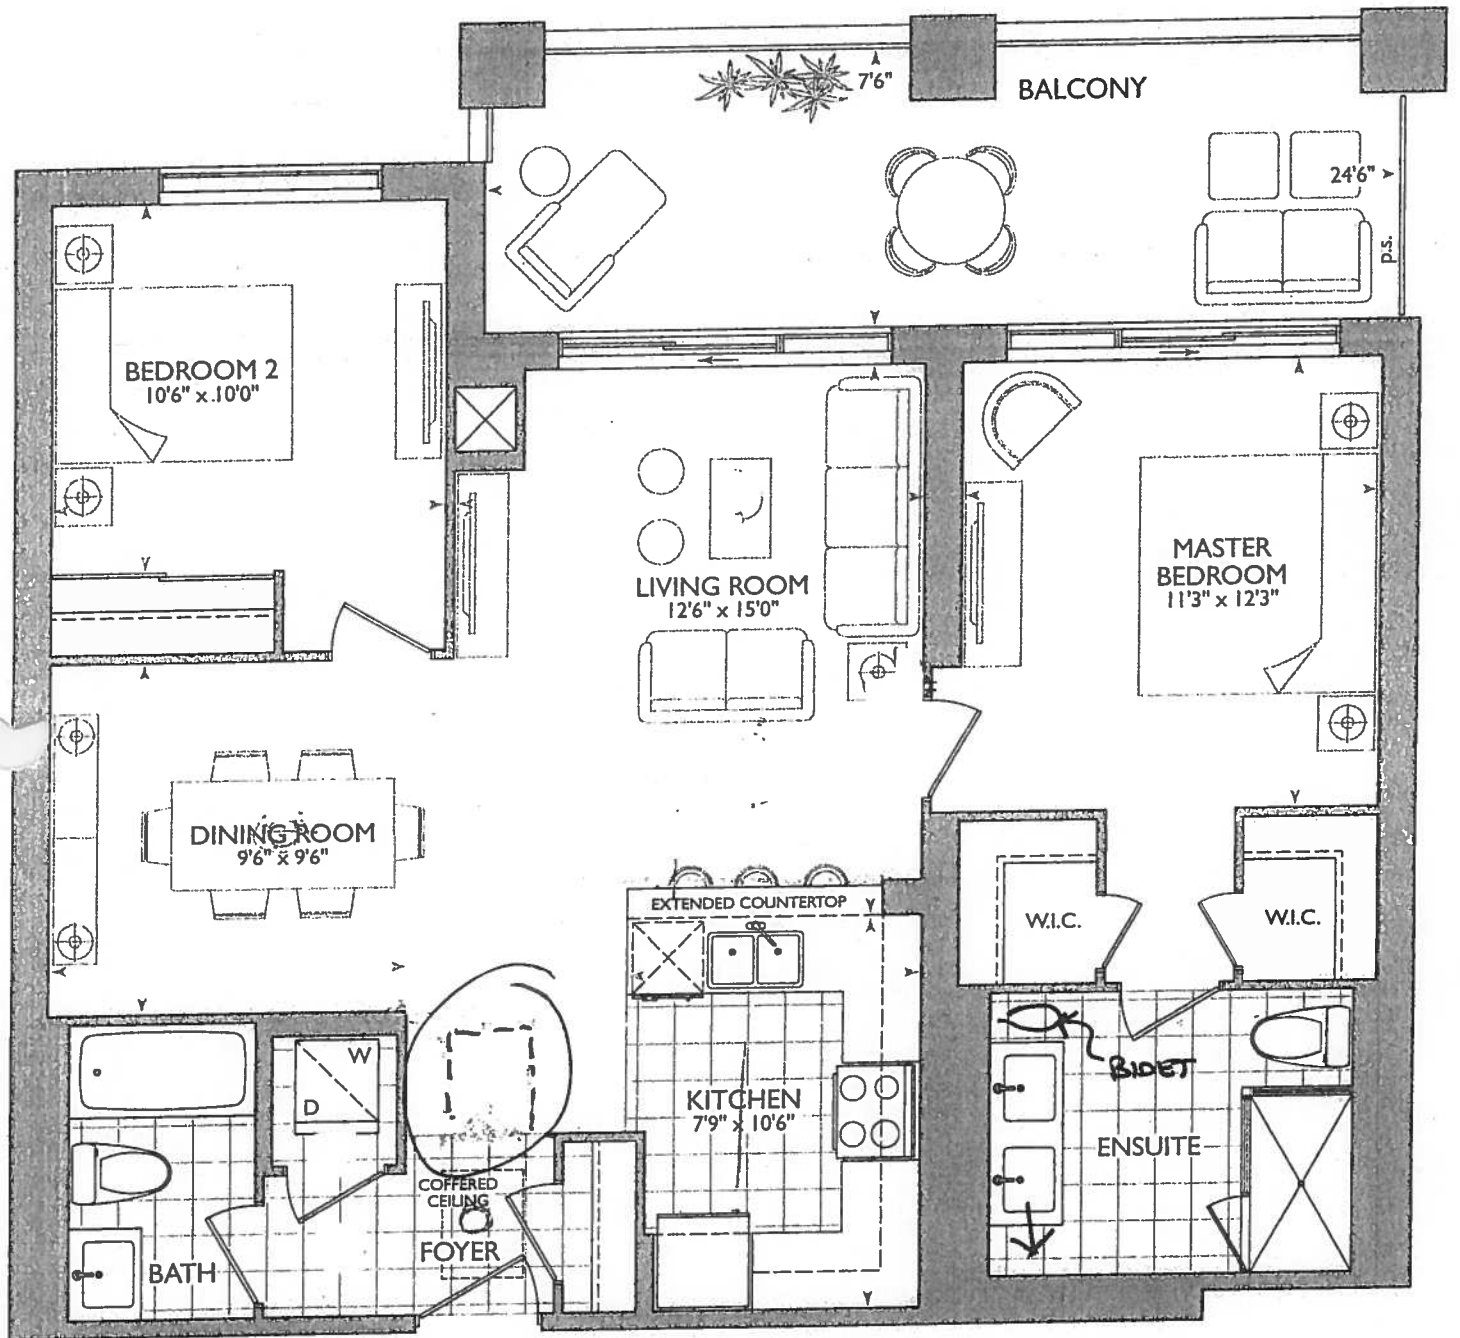


16

48

* ENSUITE ENLARGED
4" - ADDED 4" x 40"
WET WALL FOR
FAUCET.
REVISED W.I.C +
MASTER BEDRM
MEASUREMENTS.

4" x 40"
WET WALL
RECEIVED
FEB 10 2008

■ Royal Pine Homes ■ 25 Baker Hill Blvd – Stouffville, ON ■ Jan 10, 2018

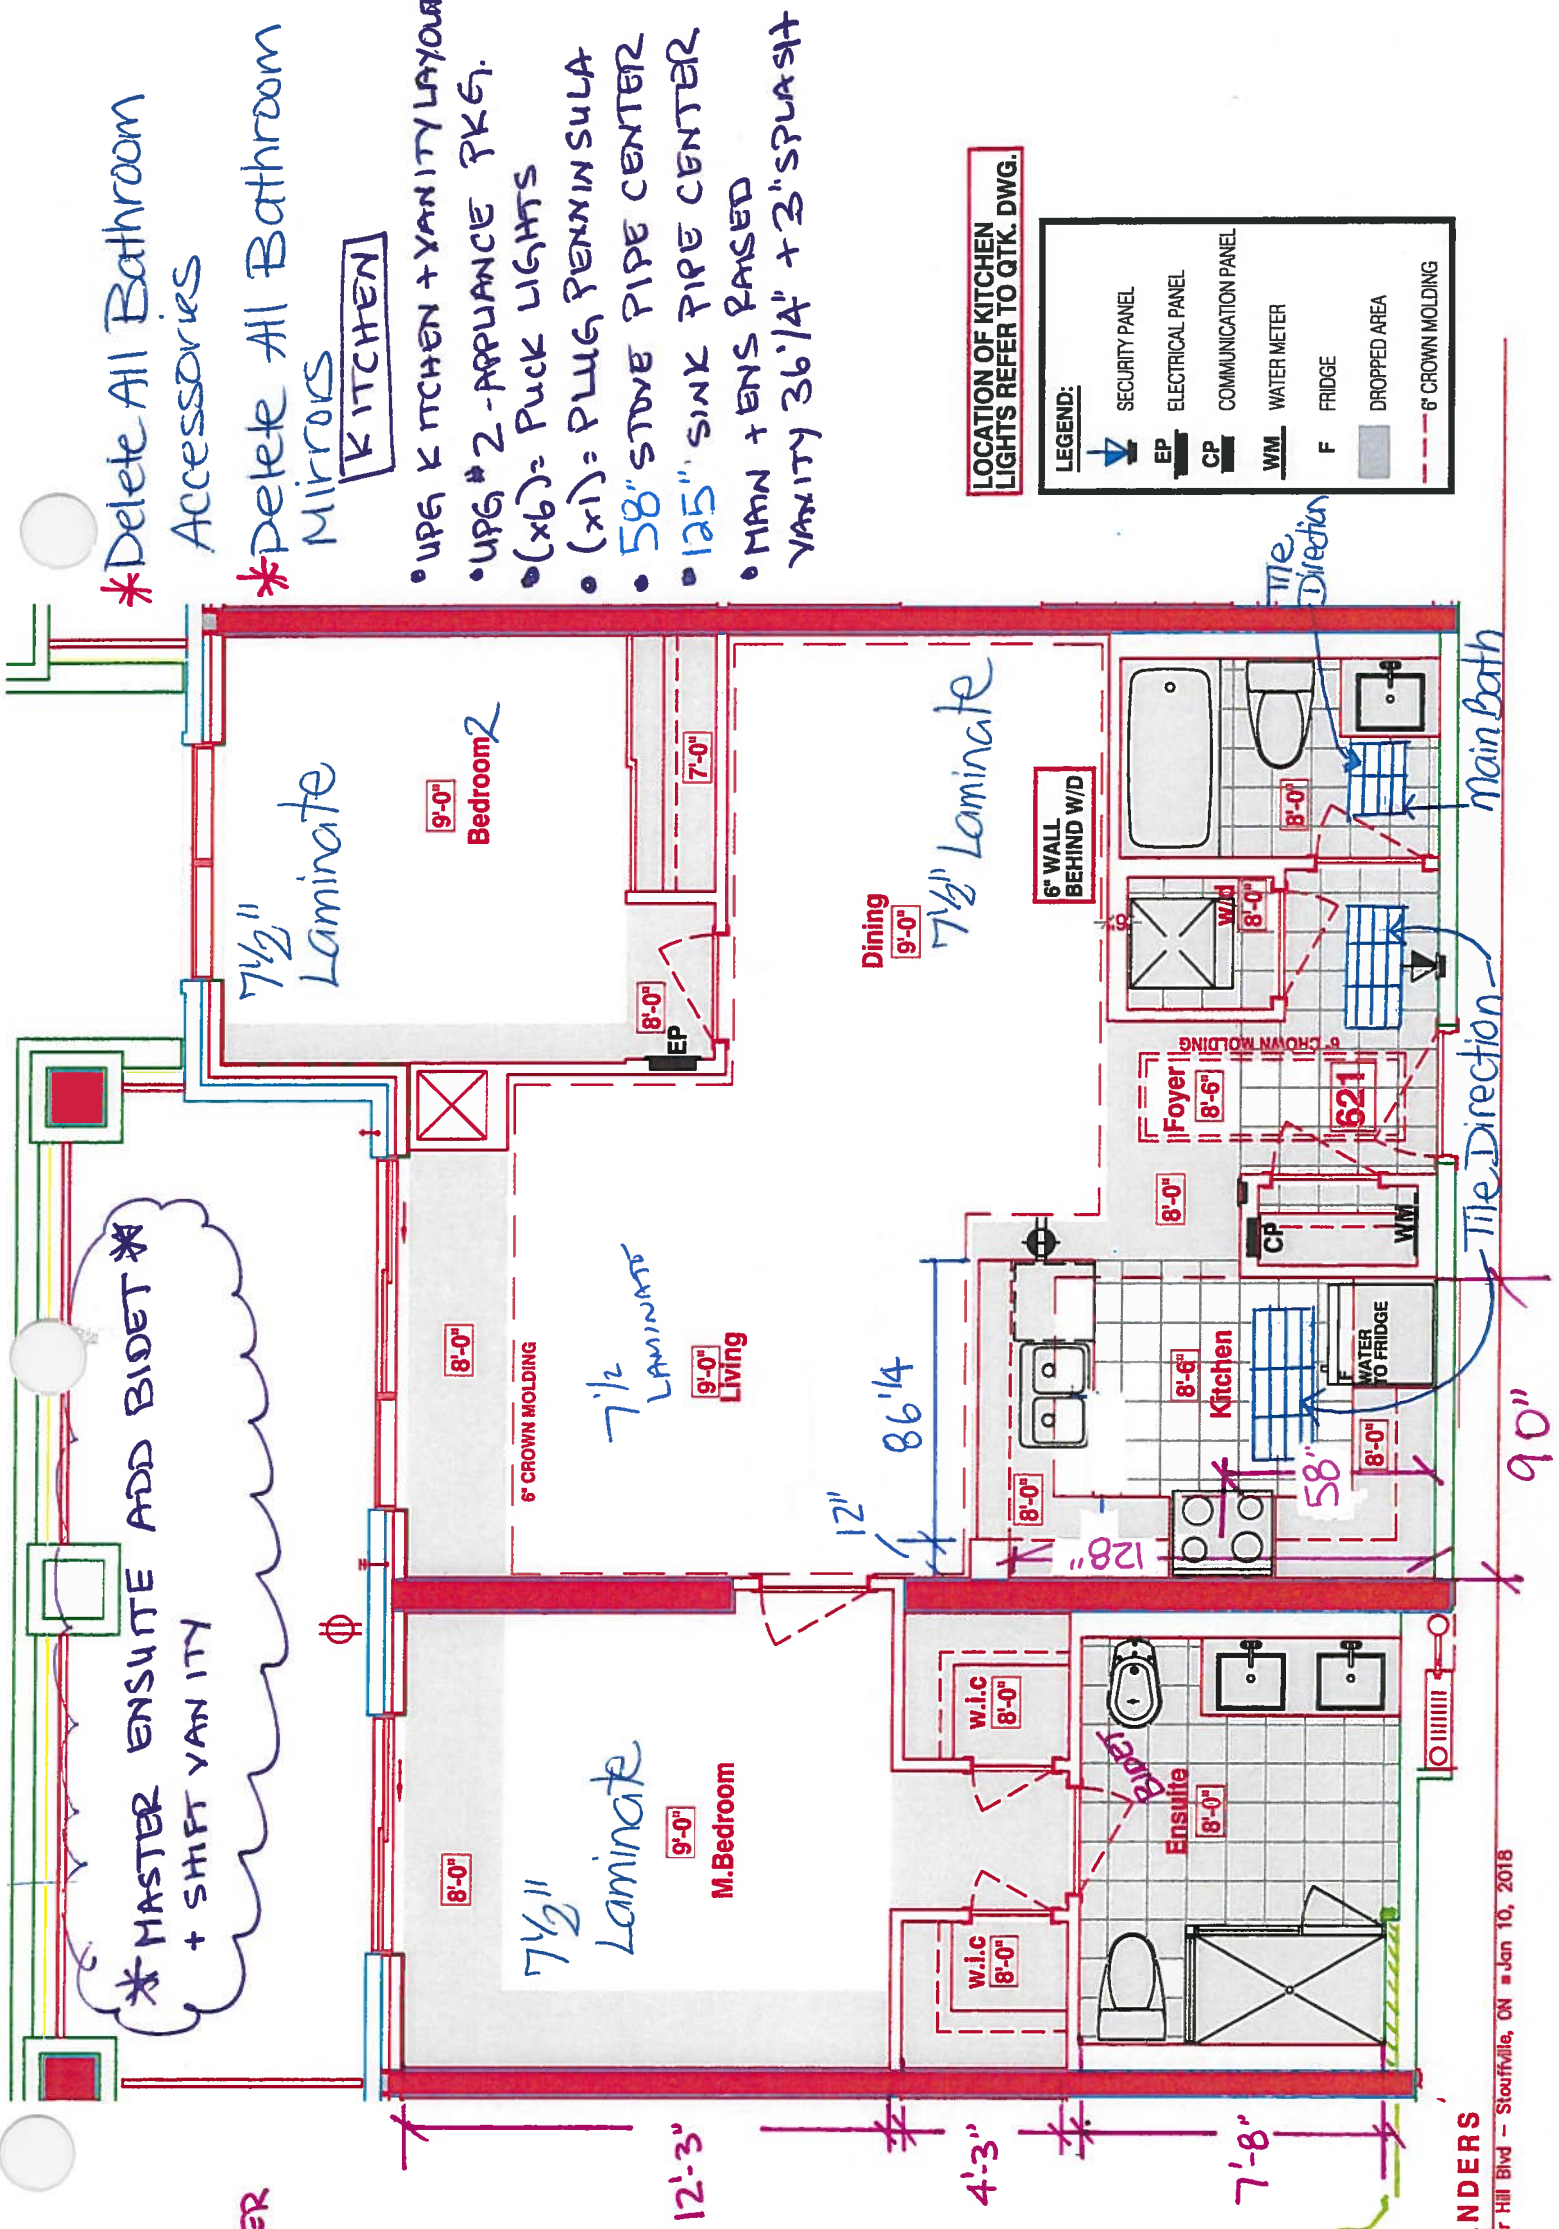

LOCATION OF KITCHEN LIGHTS REFER TO QTK. DWG.

LEGEND:

	SECURITY PANEL
	ELECTRICAL PANEL
	COMMUNICATION PANEL
	WATER METER
	FRIDGE
	DROPPED AREA
	6' CROWN MOLDING



book
SITE COPY

CONSTRUCTION SUMMARY

Hampton Place

PURCHASERS: GIUSEPPE SCALA and ROSALIA SCALA

TEL: RES.: 905-294-9665

LOT NUMBER	PHASE	HOUSE TYPE	CLOSING DATE	
621	1	FLANDERS(2E)	08-Nov-18	

Offer Workshee	VENDOR TO INSTALL COMPLETE BIDET AS PER PLAN Note:
-------------------	---

Upgrade	WATER LINE TO FRIDGE Note:
---------	-------------------------------



SITE COPY

CONSTRUCTION SUMMARY

Hampton Place

PURCHASERS: GIUSEPPE SCALA and ROSALIA SCALA

TEL: RES.: 905-294-9665

LOT NUMBER	PHASE	HOUSE TYPE	CLOSING DATE	
621	1	FLANDERS(2E)	08-Nov-18	

Date Added: 05-Mar-18Invoice Number: 7134

1 - CLARIFICATION - REFER TO APAS;
MASTER ENSUITE - BIDET FAUCET - DELTA COMPEL Bidet Faucet - Model # 44-LHP / H261 / RP3816 - Chrome (See Sketch)
Approved as per Vince C.

1 - PURCHASER AWARE AND ACCEPTS THAT ANY CHANGES MADE TO UPGRADES AFTER SIGNING THIS PURCHASERS EXTRA FORM ARE SUBJECT TO A MINIMUM ADMINISTRATION FEE OF \$1,000 PLUS A 10% HOLDBACK FEE.
Note:

Date Added: 05-Mar-18Invoice Number: 7121

30 - MAIN BATH - 1ST UPGRADE - PORCELAIN TILES - 12x24 H-STONE LIGHT GREY - To be installed throughout main bath floor (To be Installed Straight) (See Sketch)
Note: Includes Larger Size

1 - KITCHEN & BATHROOMS - SEE QUALITY TOPS & KITCHENS FOR ALL KITCHEN & BATHROOMS UPGRADES/LAYOUT. (See Attached QTK Paperwork)
Note:

1 - KITCHEN - CABINETRY HARDWARE - Install UPGRADE PACKAGE #1 - Style # 527-160 - To be installed throughout kitchen cabinetry, where applicable (See Sketch)
Note:

2 - KITCHEN - Install TWO (2) ADDITIONAL PUCK LIGHTS (Same Switch as Standard Puck Lights) at kitchen. To be installed below kitchen cabinetry, where applicable. (See Attached QTK Layout for Locations)
Purchaser Paying Difference for Additional Puck Lights - Standard Kitchen to Receive Four (4) Puck Lights - Upgrade Kitchen Requires Six (6) Puck Lights

1 - KITCHEN - Install Standard Stone Countertop - ASPEN TERRA WHITE - To be installed throughout kitchen, where applicable (Does not include stone backsplash) (See Sketch)
Note:

1 - KITCHEN - COUNTERTOP EDGING - Install UPGRADE " I " EDGE - To be installed throughout kitchen countertop, where applicable (See Sketch)
Note:

1 - DISCLAIMER - STONE COUNTERTOP;
KITCHEN - Stone slabs vary in size & all seams are visible & the fabricator reserves the right to position the seams as necessary.
Note:

1 - KITCHEN - Kitchen Sink - Install Standard Undermount Sink - BLANCO Horizon Plus U2 Undermount Sink (8") - Model # 401234
Note:

1 - KITCHEN - Kitchen Faucet - Install Standard Faucet - DELTA Chrome Pull-Out Kitchen Faucet (Single Hole) - Model # 469LF - Chrome
Note:

1 - APPLIANCE PACKAGE - Install Upgrade Appliance Package - UPGRADE PACKAGE #2 - To be installed throughout suite, where applicable (Sketch)

1 - MAIN BATH & MASTER ENSUITE - Install RAISED HEIGHT VANITY at Main Bath and Master Ensuite Vanities, where applicable (See Attached QTK Paperwork)
Note:

1 - MASTER ENSUITE - Install Standars Granite Countertop - BIANCO ANTICO - To be installed throughout master ensuite vanity countertop, where applicable (Includes 3" Splash) (See Sketch)
Note:



SITE COPY

CONSTRUCTION SUMMARY

Hampton Place

PURCHASERS: GIUSEPPE SCALA and ROSALIA SCALA

TEL: RES.: 905-294-9665

LOT NUMBER	PHASE	HOUSE TYPE	CLOSING DATE	
621	1	FLANDERS(2E)	08-Nov-18	

Date Added: 05-Mar-18 Invoice Number: 7121

1 - MAIN BATH - Install Standars Granite Countertop - BIANCO ANTICO - To be installed throughout main bath vanity countertop, where applicable (Includes 3" Splash) (See Sketch)

1 - CLARIFICATION;
MAIN BATH & MASTER ENSUITE - Install Standard 3" Splash throughout Main Bath and Master Ensuite vanity countertop, where applicable (See Sketch)
Note:

1 - DISCLAIMER - GRANITE COUNTERTOP;
MAIN BATH & MASTER ENSUITE - Due to the many variables that can affect the pattern, colour and/or design and "pitting" of natural products, granite installed will not be identical to the samples displayed.
Note: Every effort is made to provide granite countertops as close as possible but the vendor is not responsible for results which differ from the sample displayed. All countertop surfaces may have seams, and product pattern and shade can change in areas containing seams.

1 - DISCLAIMER - STONE COUNTERTOP;
MAIN BATH & MASTER ENSUITE - Stone slabs vary in size & all seams are visible & the fabricator reserves the right to position the seams as necessary.
Note:

1 - CLARIFICATION - REFER TO APAS;
MASTER ENSUITE - Install BIDET at Master Ensuite - CONTRAC - CALE 4 Hole Bidet (Does not include faucet) - Model #4830-BLX - White (See Sketcch)
Note:

1 - MASTER ENSUITE - TOILET - Install Upgrade Toilet - CONTRAC - CALI One Piece Elongated Toilet - Model # 4710-BOVU - White (See Sketch)

1 - CLARIFICATION;
MASTER ENSUITE - Purchaser accepts & acknowledges the standard frameless glass enclosure at master ensuite shower stall will NOT touch the ceiling and will receive a Standard Chrome Header. (See Sketch)
Note:

1 - CLARIFICATION;
MAIN BATH & MASTER ENSUITE - DELETE Do Not Install / Supply / Credit Purchaser for builders standard ceramic bathroom accessories (toilet paper, towel bar & soap dish) throughout all bathrooms where applicable.
Note: To Include; Main Bath & Master Ensuite (See Sketch)

1 - CLARIFICATION;
MAIN BATH & MASTER ENSUITE - DELETE Do Not Install / Supply / Credit Purchaser for builders' standard Bathroom Mirrors, throughout all bathrooms, where applicable. To Include; Main Bath and Master Ensuite. (See Sketch)
Note:

1 - PURCHASER HAS ATTENDED A COLOR APPOINTMENT AT THE DECOR CENTRE AND HAS DECLINED ANY ADDITIONAL UPGRADES. Purchaser accepts and acknowledges that there will be no further changes/additions/deletions to be made upon signing on February 20,2018
Note:

PURCHASER AWARE AND ACCEPTS THAT ANY CHANGES MADE TO UPGRADES AFTER SIGNING THIS PURCHASERS EXTRA CHARGES ARE SUBJECT TO A MINIMUM ADMINISTRATION FEE OF \$1,000 PLUS A 10% HOLDBACK FEE.
Note:

This Document is Extremely Time Sensitive - Printed 11 Apr 18 at 9:50

SELECTIVE CERAMIC

TILE, BATH & KITCHEN CENTRE

3550 LANGSTAFF RD., STE 160 WOODBRIDGE, ONTARIO L4L 9B7

TELEPHONE: 905 860 0222 FAX: 905 860 2076 E-MAIL: INFO@SELECTIVECERAMICS.COM

Amendment to the colour chart dated: _____

Lot No: Suite 621 Site: Hampton Place - Ph. 1

Purchaser(s): Giuseppe Scala and Rosalia Scala


Vender: Royal Pine

It is hereby understood and agreed between the undersigned parties that the following changes shall be made to the above mentioned colour chart, and except for such changes noted, all other items in the colour chart shall remain as started therein.

Delete: 1. 12x24 H Stone Light Grey → Foyer and Kitchen/Dine lte
2. 12x24 H Stone Light Grey → Main Bath Floor
3. 13x13 Rustic Grey → Master Ensuite Floor

Insert 1. 12x24 H Stone Medium Grey → Foyer and Kitchen/Dine lte
2. 12x24 H Stone Medium Grey → Main Bath Floor
3. 13x13 Nordique Ice → Master Ensuite Floor

Dated at Selective Ceramics Imports (Vaughan) this 1 day of May 2014

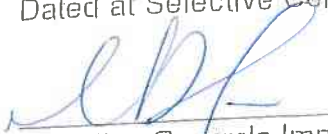
Selective Ceramic Imports Inc

Rosalia Scala
Purchaser

Giuseppe Scala
Purchaser

Revised: May 1, 2019

INTERIOR COLOUR SCHEME *

Purchasers GIUSEPPE SCALA & ROSALIA SCALA		Decor Consultant Melissa Di Marino	Model Type FLANDERS(2E)	Telephone Res. / Bus (905) 294-9665 /	Project Hampton Place	Closing Date 08/11/2018	Unit 621
--	--	---------------------------------------	----------------------------	--	--------------------------	----------------------------	-------------

Page 1 of 3

	Flooring	Wall Tile		
	Description	Main	Accent/Insert	Pattern
MASTER ENSUITE	13x13 Nordique Ice	8x10 GOLF GRIGIO (STD)	NONE	NONE
MAIN BATHROOM	12x24 H-Stone Medium Grey	8x10 GOLF GRIGIO (STD)	NONE	NONE
POWDER ROOM	N/A	N/A	N/A	N/A
KITCHEN / DINETTE	12x24 H-Stone Medium Grey	12x12 TwilightMocha GlassMosaics(STD)	NONE	NONE
FOYER	12x24 H-Stone Medium Grey	N/A	N/A	N/A
LAUNDRY	8x8 HLARA PINK (STD)	N/A	N/A	N/A
LIVING ROOM	7 1/2" TorleysForest - NorthernCordillera9687P (STD)			
DINING ROOM	7 1/2" TorleysForest - NorthernCordillera9687P (STD)			
DEN	N/A			
MASTER BEDROOM	7 1/2" TorleysForest - NorthernCordillera9687P (STD)			
BEDROOM 2	7 1/2" TorleysForest - NorthernCordillera9687P (STD)			
BEDROOM 3	N/A			
Notes				



* INTERIOR CLOSET SCHEME *

Purchasers GIUSEPPE SCALA & ROSALIA SCALA		Decor Consultant Melissa Di Marino	Model Type FLANDERS(2E)	Telephone Res. / Bus (905) 294-9665 /	Project Hampton Place	Closing Date 08/11/2018	Unit 621
--	--	---------------------------------------	----------------------------	--	--------------------------	----------------------------	-------------

Page 2 of 3

CABINETS, VANITIES AND COUNTERTOPS

Style	Countertop	Counter Edge	Handle / Knob
✓ CATEGORY 1 - FIBERBOARD - WHITE QT 1203 (STD)	✓ BIANCO ANTICO GRANITE (STD)	✓ 1" A" EDGE (STD)	B603-SC
✓ CATEGORY 1 - FIBERBOARD - WHITE QT 1203 (STD)	✓ BIANCO ANTICO GRANITE (STD)	✓ 1" A" EDGE (STD)	B603-SC
✓ N/A	✓ N/A	✓ N/A	N/A
✓ CATEGORY 1 - FIBERBOARD - WHITE QT 1203 (STD)	✓ ASPEN TERRA WHITE (STD)	✓ 1" A" EDGE (UPG)	527-160 UPG
✓ N/A	✓ N/A	✓ N/A	N/A
✓ N/A	✓ N/A	✓ N/A	N/A
✓ N/A	✓ N/A	✓ N/A	N/A

APPLIANCE PACKAGE
Upgrade Package #2
Std 31in Opening

PLUMBING FIXTURES



KITCHEN	Sink Model	✓ STANDARD
	Sink Faucet	✓ STANDARD
TOILETS	Master Ensuite	✓ UPG - Contrac Cali #4710-BOVU White
	Main Bathroom	✓ STANDARD
	Powder Room	✓ N/A
VANITY FAUCETS	Master Ensuite	✓ STANDARD
	Main Bathroom	✓ STANDARD
	Powder Room	✓ N/A
VANITY SINKS	Master Ensuite	✓ STANDARD
	Main Bathroom	✓ STANDARD
	Powder Room	✓ N/A
SHOWER STALL / TUBS	Master Ensuite Shower Stall	✓ STANDARD
	Master Ensuite Tub	✓ N/A
	Main Bathroom Tub	✓ STANDARD


Trim	Baseboard & Casing	STANDARD	Levers	STANDARD
	Interior Doors	STANDARD - CARRARA SMOOTH	Door Height	STANDARD
Cornice Moulding / Medallion				
Foyer	✓ STANDARD - #CTR-611	Fireplace	N/A	
Living Room	✓ STANDARD - #CTR-611	Location Flooring	N/A	
Dining Room	✓ STANDARD - #CTR-611	Style	N/A	
Den	N/A	Finish	N/A	
Master Bedroom	NONE	Marble	N/A	
Bedroom 2	NONE	Hearth	N/A	
Bedroom 3	N/A			

MISC. INSTALLATIONS	
Ceramic Accessories (installed by Vendor)	✓ ☐ Yes ☒ No
Bathroom Mirrors (installed by Vendor)	✓ ☐ Yes ☒ No
Wire Shelving - Closet (installed by Vendor)	✓ ☒ Yes ☐ No

Paint Throughout	Trim
Walls	STANDARD - BIRCH WHITE
	STANDARD - WHITE

Page 2 of 3

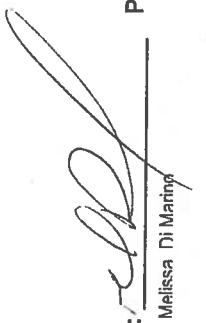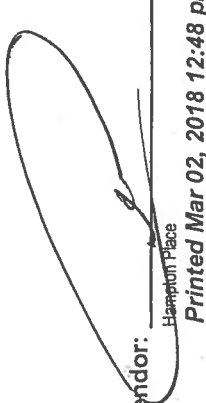Decor Consultant:  Melissa Di Marino
Purchaser:  ROSALIA SCALA
Purchaser:  ROSALIA SCALA
Vendor:  Hampton Place
Printed Mar 02, 2018 12:48 pm

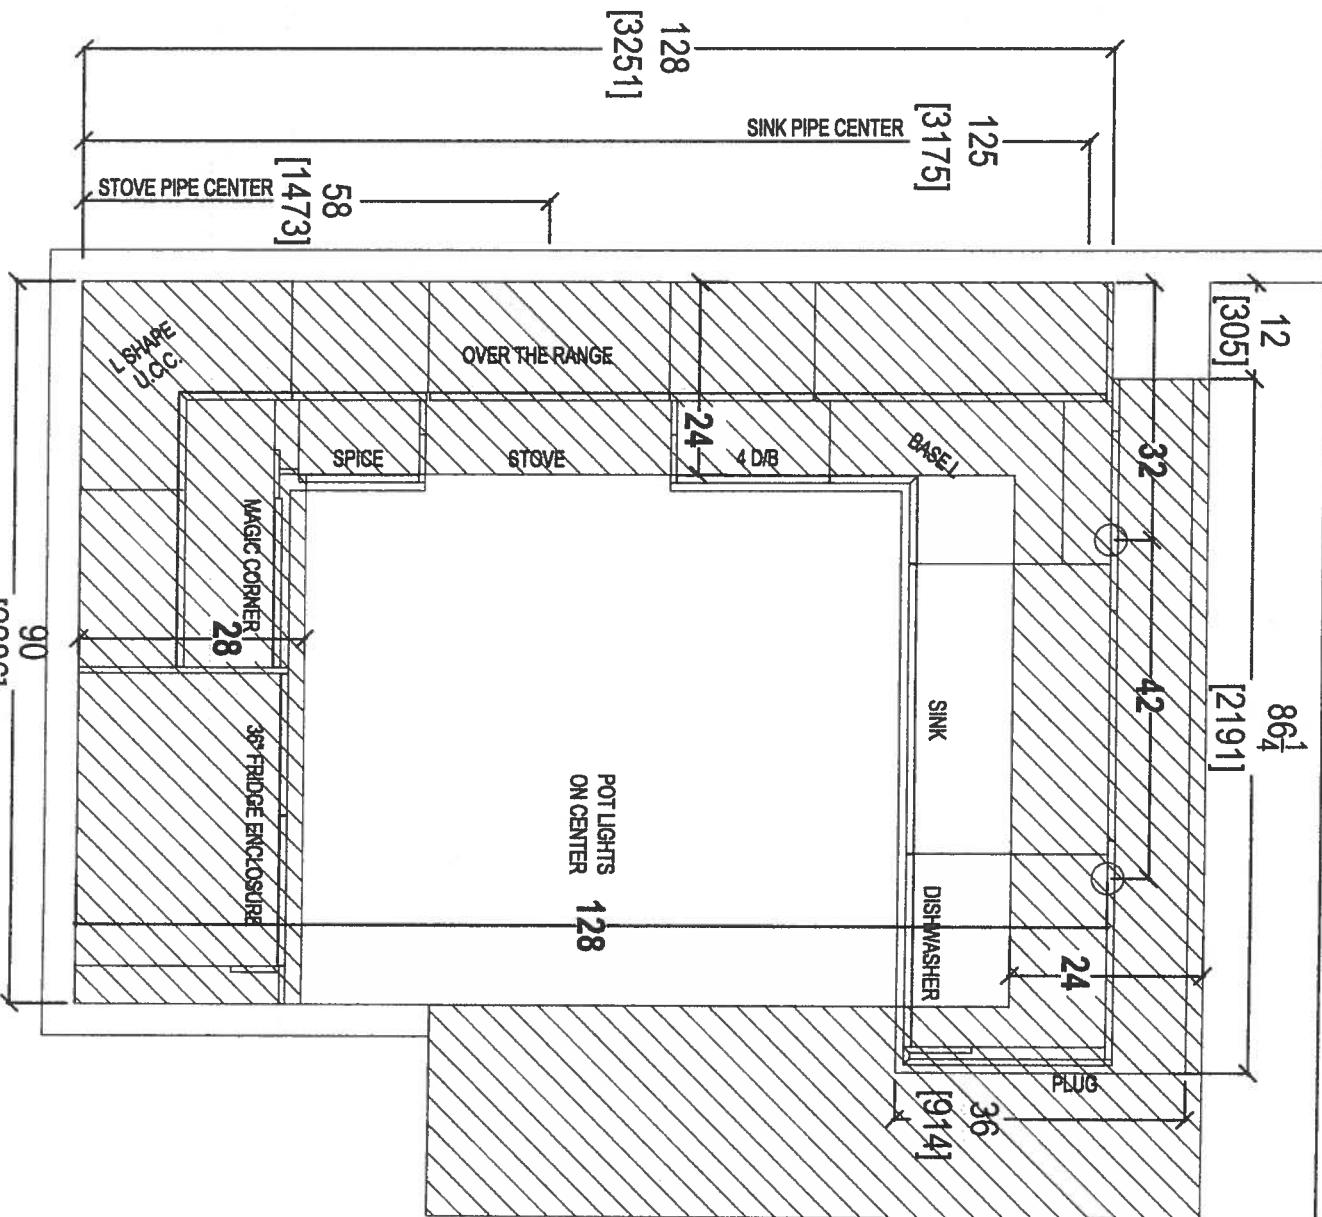

[2286]

CLIENT: ROYAL PINE HOMES		JOB NAME: UNIT 621 HMP		ROOM: KITCHEN		DRAWN BY: SK	
SITE: HAMPTON PLACE		LOT #:		DOOR HANDLE: —		SCALE: 1/2" = 1'-0"	
PHONE: —		FINISH: —		DRW HANDLE: —		DATE: MAY 1, 2018	
EMAIL: —		SPECIES: —		TOP: —		PAGE: —	


COMMENTS:

PLEASE NOTE ALL DIMENSIONS
ARE NOT FINAL AND ARE
SUBJECT TO CHANGE UPON
FINAL SITE MEASURE



80 SANTE DRIVE, VAUGHAN, ON L4K 3C4,
T: 416.746.1811 F: 905.761.5901

61

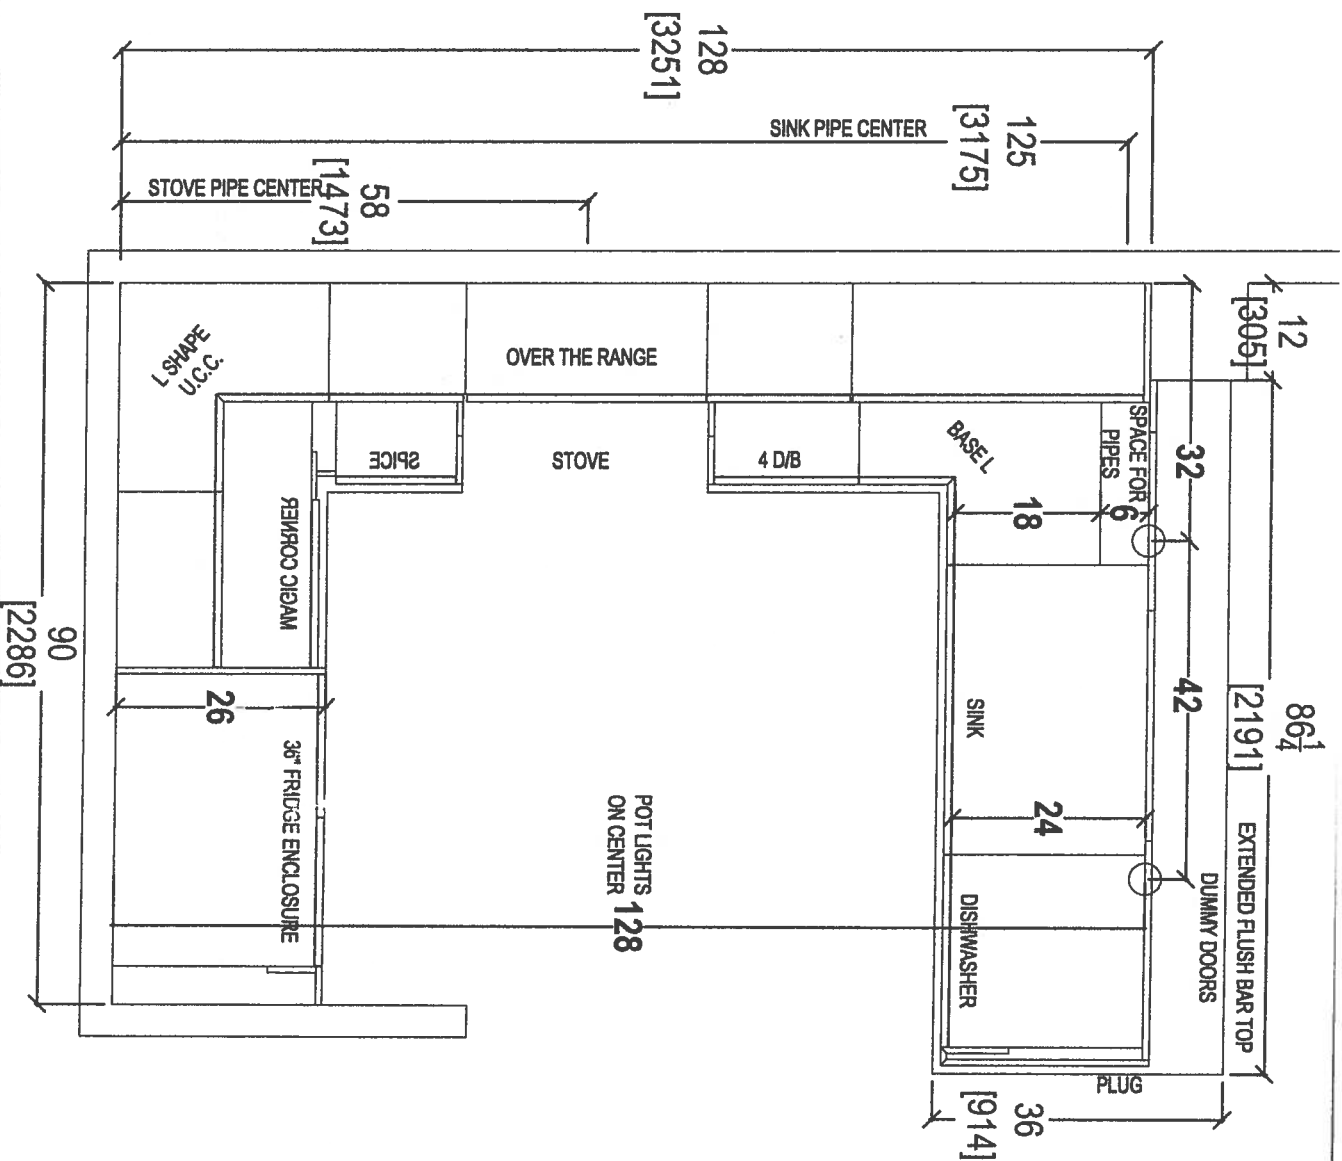

CLIENT: ROYAL PINE HOMES

JOB NAME: UNIT 621 HMP

ROOM: KITCHEN

DRAWN BY: SK

COMMENTS:

SITE: HAMPTON PLACE

LOT #:

DOOR HANDLE: —

SCALE: 1/2" = 1' - 0"

PHONE: —

FINISH: —

DRW HANDLE: —

DATE: MAY 1, 2018

EMAIL: —

SPECIES: —



TOP: —

PAGE: —

your kitchen, your taste.
80 SANTE DRIVE, VAUGHAN, ON L4K 3C4,
T: 416.746.1811 F: 905.781.5901

PLEASE NOTE ALL DIMENSIONS
ARE NOT FINAL AND ARE
SUBJECT TO CHANGE UPON
FINAL SITE MEASURE



GA

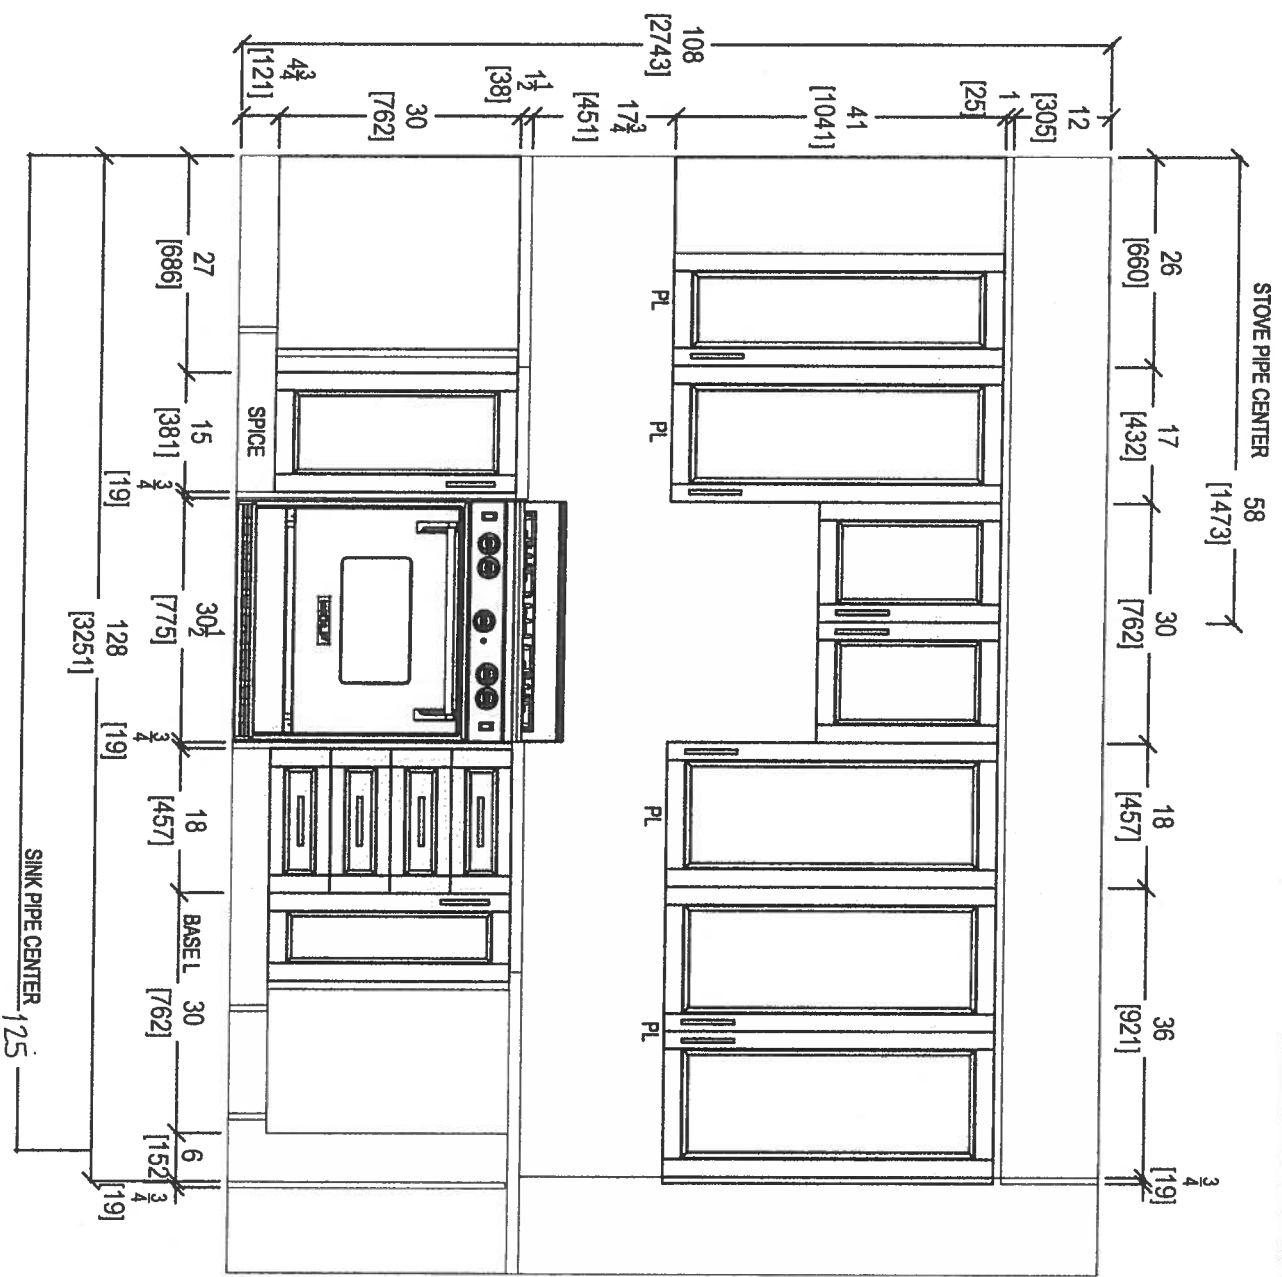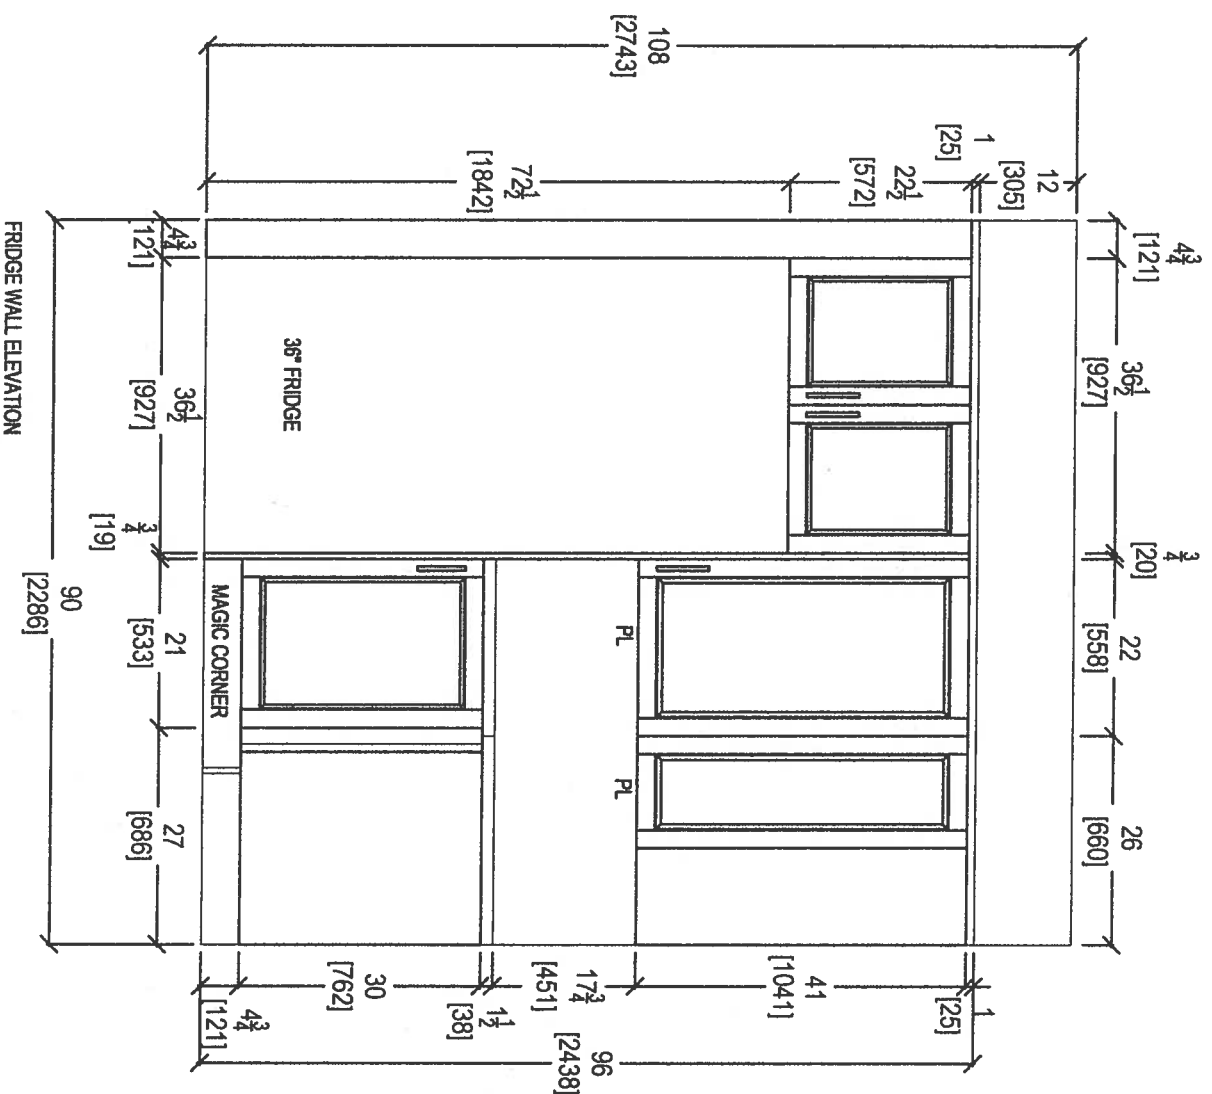

CLIENT: ROYAL PINE HOMES	JOB NAME: UNIT 621 HMP	ROOM: KITCHEN	DRAWN BY: SK	COMMENTS: PLEASE NOTE ALL DIMENSIONS ARE NOT FINAL AND ARE SUBJECT TO CHANGE UPON FINAL SITE MEASURE
SITE: HAMPTON PLACE	LOT #:	DOOR HANDLE: —	SCALE: 1/2" = 1' - 0"	
PHONE: —	FINISH: —	DRW HANDLE: —	DATE: MAY 1, 2018	
EMAIL: —	SPECIES: —	TOP: —	PAGE: —	
				

80 SANTE DRIVE, VAUGHAN, ON L4K 3C4,
T. 416 748 1811 E. 905 781 5801

PLEASE NOTE ALL DIMENSIONS ARE NOT FINAL AND ARE SUBJECT TO CHANGE UPON FINAL SITE MEASURE

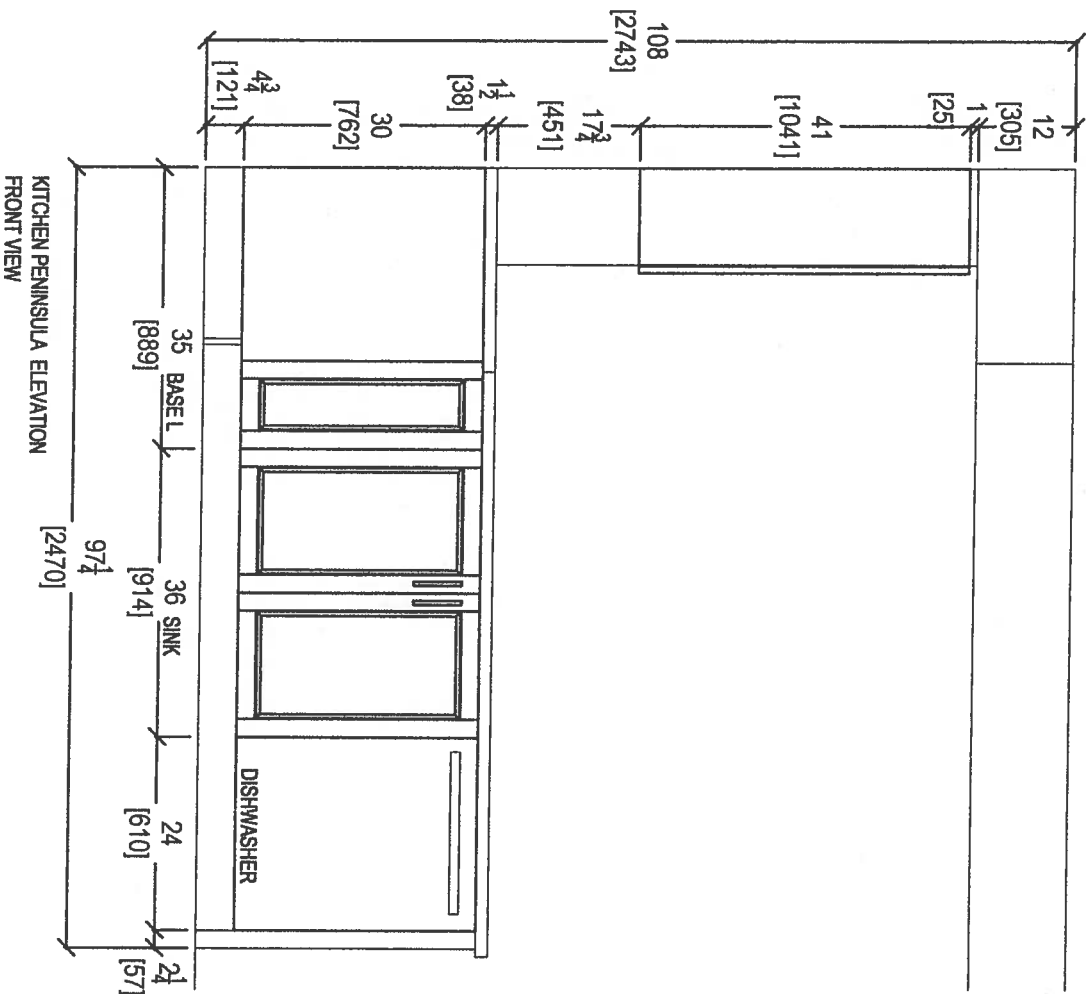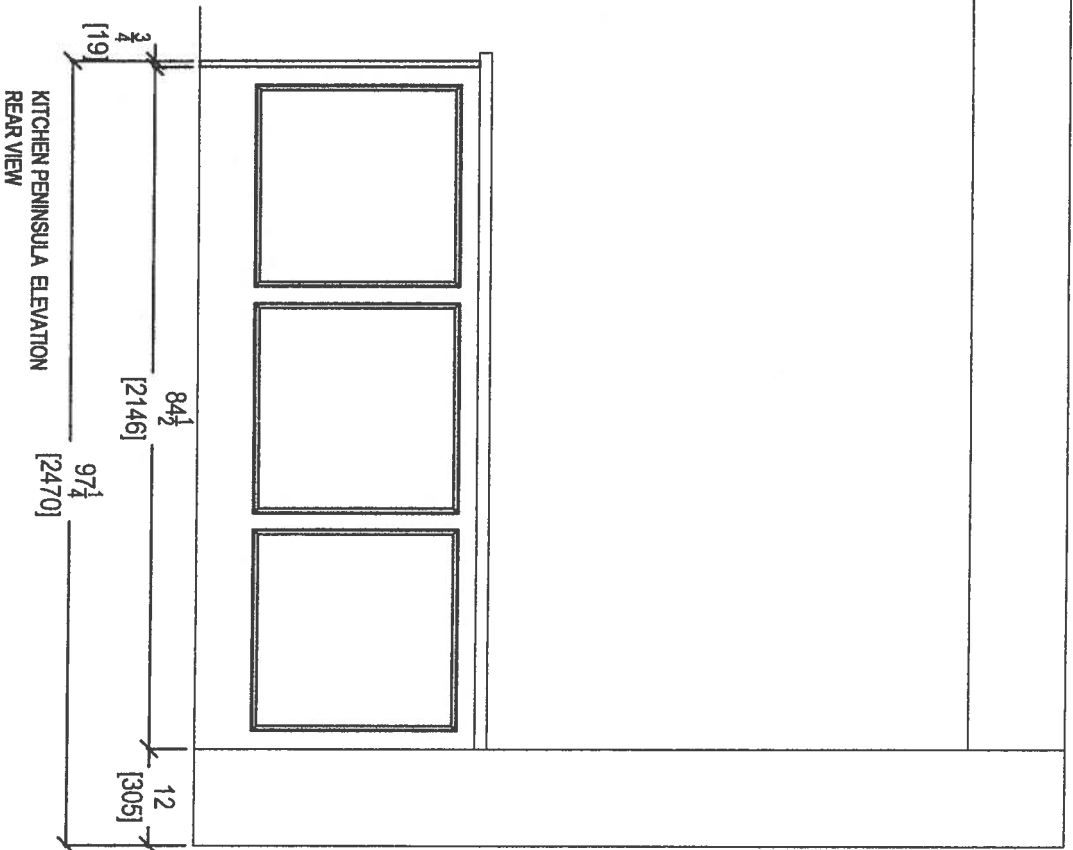



CLIENT: ROYAL PINE HOMES		JOB NAME: UNIT 624 HMP		ROOM: KITCHEN		DRAWN BY: SK	
SITE: HAMPTON PLACE		LOT #:		DOOR HANDLE: —		SCALE: 1/2" = 1'-0"	
PHONE: —		FINISH: —		DRW HANDLE: —		DATE: MAY 1, 2018	
EMAIL: —		SPECIES: —		TOP: —		PAGE: —	

COMMENTS:



PLEASE NOTE ALL DIMENSIONS
ARE NOT FINAL AND ARE
SUBJECT TO CHANGE UPON
FINAL SITE MEASURE



80 SANTE DRIVE, VAUGHAN, ON L4K 3C4,
T: 416.746.1811 F: 905.761.5901

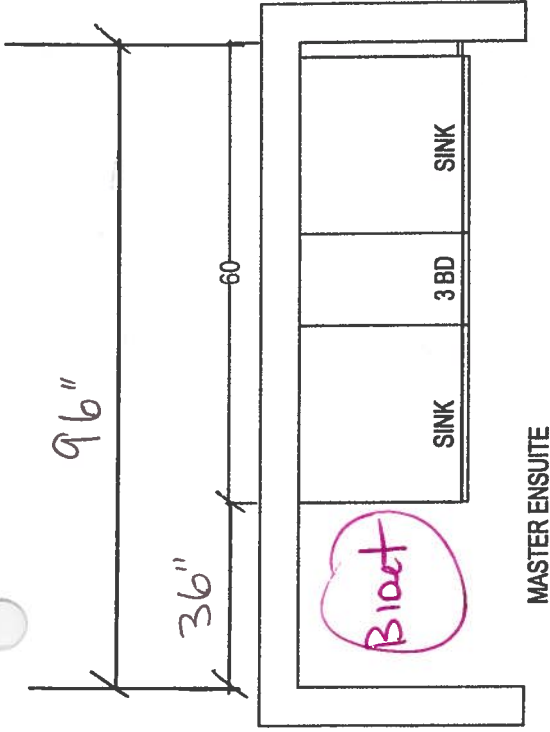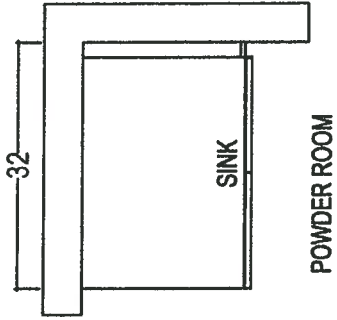

RANSO VANITIES
 (+) 3" SPLASH

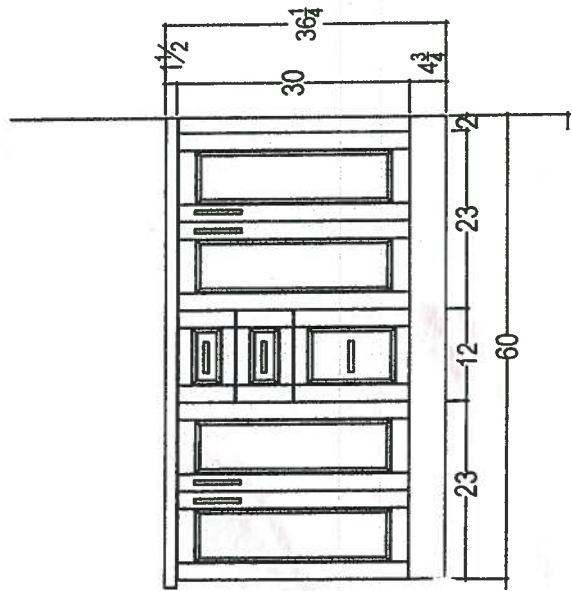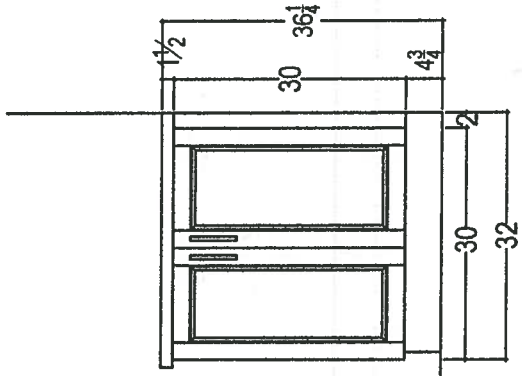

CLIENT: ROYAL PINE HOMES	JOB NAME: UNIT 621 HMP	ROOM:	VANITIES	DRAWN BY: SK	COMMENTS: PLEASE NOTE ALL DIMENSIONS ARE NOT FINAL AND ARE SUBJECT TO CHANGE UPON FINAL SITE MEASURE
SITE: HAMPTON PLACE	LOT #:	DOOR HANDLE:	—	SCALE: 1/2" = 1' - 0"	
PHONE: —	FINISH: —	DRW HANDLE:	—	DATE: MAY 1, 2018	
EMAIL: —	SPECIES: —	TOP:	—	PAGE: —	

Suite 621
Hampton

Upgrade
Package 2

L.S., G.S.

INSIDEADVANTAGE®



<http://www.insideadvantage.com>

Product Dimensions:

Height: 72
Width: 35 3/4
Depth: 30 1/4

Electrical Requirements:

15 Amps.

Available In:

- ☐ Stainless Steel
- ☒ Black
- ☐ White

KRFC302ESS

22 cu.ft. 36-Inch Width Counter Depth French Door Refrigerator
with Interior Dispense

KRFC302ESS

Key Features:

- ExtendFresh™ Temperature Management System
- Interior Water Dispenser
- Professionally-Inspired Design
- Produce Preserver
- Humidity-Controlled Crispers
- FreshChill™ Temperature-Controlled Full-Width Pantry
- Pull-Out Tri-Level Freezer Drawer
- SatinGlide® System
- LED Lighting
- Star-K Certified
- Automatic Ice Maker
- Max Cool



INVENTED
IN
AMERICA

Suite 621
Hampton

Upgrade
Package 2

2.3


45-

KSEB900ESS

KitchenAid

30-Inch 5-Element Electric Convection Slide-In
Range with Baking Drawer

<http://www.kitchenaid.com>

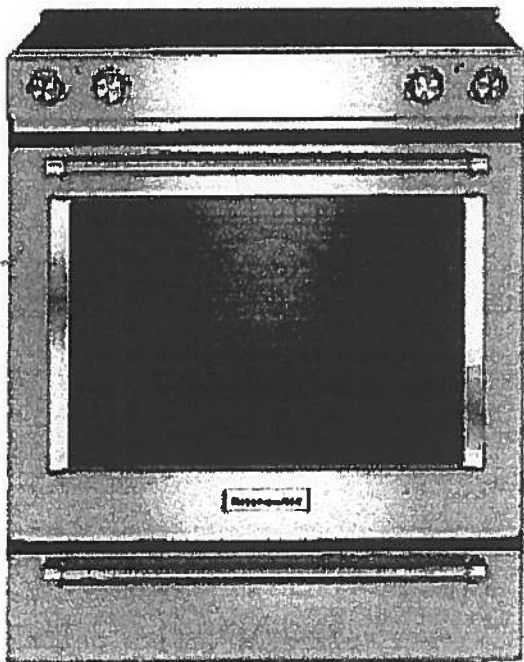

Key Features:

- Baking Drawer
- Even-Heat™ True Convection
- Wireless Probe
- Steam Rack
- 7.1 Cu Ft. Total Capacity
- 5 Cooking Elements Including a Warm Zone
- EasyConvect™ Conversion
- FIT Guarantee
- Aqualift®
- Glass Touch Controls
- Side Trim Accessory Kit

Product Dimensions:

Height: 36

Width: 29 7/8

Electrical Requirements:

40 Amps.

Additional Information:

[Use And Care Guide](#)

[Dimension Guide](#)

[Installation Guide](#)

[Warranty Certificate](#)

Available in:

- Black
- Stainless Steel
- White

INVESTED
IN
AMERICA

ADA
Compliant

©Registered trademark/TM Trademark of Whirlpool, U.S.A. © 2013 Whirlpool Corporation. All Rights Reserved.
All other trademarks are owned by their respective companies.
Because Whirlpool Corporation policy includes a continuous commitment to improve our products, we reserve
the right to change materials and specifications without notice. We also reserve the right to discontinue or
transition products without notice.
Manufacturer's Suggested Retail Price (MSRP) and Minimum Advertised Price (MAP) provided for reference
purposes only. Dealer alone determines advertised and retail prices
Created On: Tuesday, December 22, 2015 14:04:50

Suite 621
Hampton

Upgrade
Package 2

L.S. 

KMHP519ESS

1200-Watt Convection Microwave with High-Speed
Cooking - 30"

KitchenAid

<http://www.kitchenaid.com>

Key Features:

- High-Speed Cooking
- Convection Cooking
- Professionally-Inspired Design Including Handle, Badge, Graphics, Chrome Chamfer.
- Cookshield Finish
- Crispwave™ Technology and Crisper Pan
- 1200 Watts Power
- 1.9 Cu. Ft. Capacity
- Halogen Cavity Lights and Task Light
- Steam Cleaning Function
- Keep Warm Function
- Sound-Based Popcorn Function

Product Dimensions:

Height: 17 1/8

Width: 30

Depth: 17

Electrical Requirements:

15.


Additional Information:

[Use And Care](#)

[Dimension Guide](#)

[Installation Guide](#)

[Warranty](#)

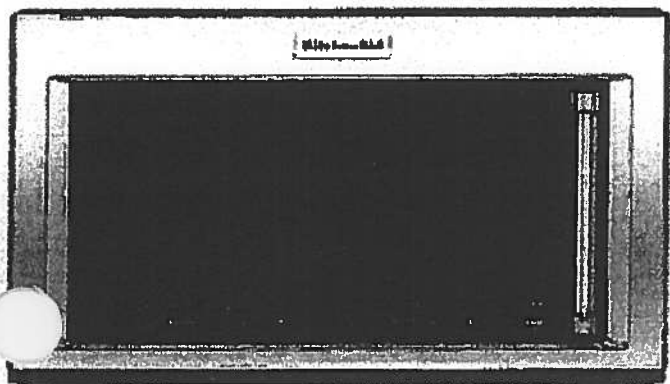

Available In:

☒ Stainless Steel

®Registered trademark/TM Trademark of Whirlpool, U.S.A. ©2016 Whirlpool Corporation All Rights Reserved All other trademarks are owned by their respective companies.

Because Whirlpool Corporation policy includes a continuous commitment to improve our products, we reserve the right to change materials and specifications without notice. We also reserve the right to discontinue or transition products without notice.

Manufacturer's Suggested Retail Price (MSRP) and Minimum Advertised Price (MAP) provided for reference purposes only. Dealer alone determines advertised and retail prices.

Suite 621
Hampton

Upgrade
Package 2

LS

SS

KDTM354ESS

KitchenAid

dBA Dishwasher with Clean Water Wash System

<http://www.kitchenaid.com>



Key Features:

- Clean Water Wash System
- ProScrub® Option
- Professionally-Inspired Design
- Advanced ProDry™ System
- ProWash™ Cycle
- SatinGlide® Max Rails (Upper Rack)
- Sliding Tines in the Lower Rack
- 2 Rows Fold-Down Tines in Upper Rack
- Fold-Down Tines in the Lower Rack
- 2 Fold-Down Cup Shelves with Integrated Stemware Holders
- Utility Basket (Upper Rack)
- Express Wash

Product Dimensions:

Height: 34 1/2

Width: 23 7/8

Depth: 24 3/4

Electrical Requirements:

15 Amps.

Additional Information:

[Use And Care Guide](#)

[Dimension Guide](#)

[Installation Guide](#)

[Energy Guide](#)

[Warranty Certificate](#)

Available in:

Stainless Steel

INVESTED
IN
AMERICA

®Registered trademark/TM Trademark of Whirlpool, U.S.A. © 2013 Whirlpool Corporation All Rights Reserved.
All other trademarks are owned by their respective companies.

Because Whirlpool Corporation policy includes a continuous commitment to improve our products, we reserve the right to change materials and specifications without notice. We also reserve the right to discontinue or transition products without notice.

Manufacturer's Suggested Retail Price (MSRP) and Minimum Advertised Price (MAP) provided for reference purposes only. Dealer alone determines advertised and retail prices.

Created On: Friday, March 04, 2016 16:36:55

Suite 621 Hampton Upgrade Package 2




WFW85HEFC

 **Whirlpool®**

4.5 cu. ft. Front Load Washer with TumbleFresh™
Option

<http://www.whirlpool.com>

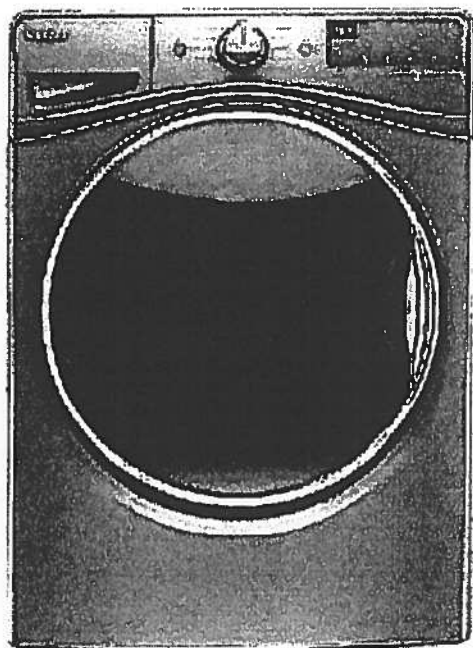

Key Features:

- TumbleFresh™ Option
- ColorLast™ Cycle
- Presoak Option
- EcoBoost™ Option
- Precision Dispense
- Steam Clean Option
- Adaptive Wash Technology
- Smooth Wave Stainless Steel Wash Basket
- 4.5 cu. ft. Capacity
- Undercounter Installation
- Add-A-Garment
- ENERGY STAR® Certified

Product Dimensions:

Height: 39 3/4

Width: 27

Depth: 33 5/16

Additional Information:

[Use And Care Guide](#)

[Dimension Guide](#)

[Installation Guide](#)

[Energy Guide](#)

[Warranty Certificate](#)

Available in:

- ☒ Chrome Shadow
☐ White

INVESTED
IN
AMERICA



©Registered trademark/TM Trademark of Whirlpool, U.S.A. © 2016 Whirlpool Corporation. All Rights Reserved.
All other trademarks are owned by their respective companies.
Because Whirlpool Corporation policy includes a continuous commitment to improve our products, we reserve the right to change materials and specifications without notice. We also reserve the right to discontinue or transition products without notice.
Manufacturer's Suggested Retail Price (MSRP) and Minimum Advertised Price (MAP) provided for reference purposes only. Dealer alone determines advertised and retail prices.
Created On: Wednesday, December 14, 2016 18:12:43

Suite 621
Hampton

Upgrade
Package 2


WED85HEFC



Whirlpool®

<http://www.whirlpool.com>

7.4 cu. ft. Electric Dryer with Quick Dry Cycle

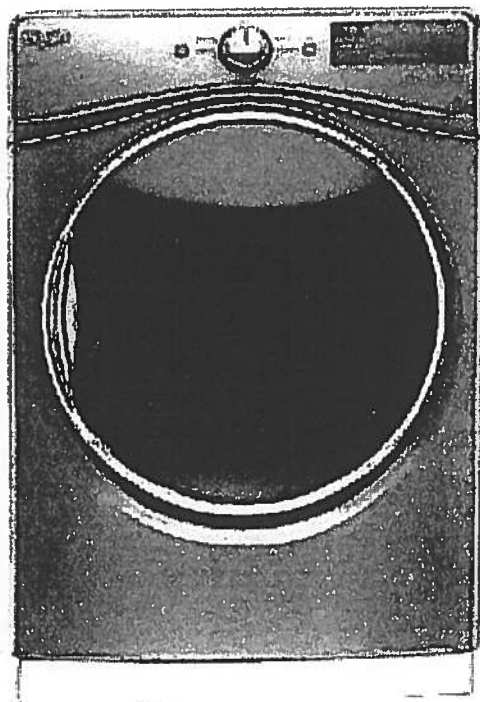

Key Features:

- Advanced Moisture Sensing System
- Tap Touch Controls with Memory
- EcoBoost™ Option
- Steam Refresh Cycle
- Wrinkle Shield™ Option
- Quad Baffles
- 7.4 Cu. Ft. Capacity
- Undercounter Installation
- ENERGY STAR® Qualified
- Sanitize Cycle
- Quick Dry Cycle

Product Dimensions:

Height: 39

Width: 27

Depth: 31

Additional Information:

[Use And Care Guide](#)

[Dimension Guide](#)

[Installation Guide](#)

[Warranty Certificate](#)

INVESTED
IN
AMERICA




©Registered trademark/TM Trademark of Whirlpool, U.S.A. © 2016 Whirlpool Corporation. All Rights Reserved
All other trademarks are owned by their respective companies
Because Whirlpool Corporation policy includes a continuous commitment to improve our products, we reserve the right to change materials and specifications without notice. We also reserve the right to discontinue or transition products without notice
Manufacturer's Suggested Retail Price (MSRP) and Minimum Advertised Price (MAP) provided for reference purposes only. Dealer alone determines advertised and retail prices
Created On: Thursday, March 23, 2017 17:33:37

Cale

Suite 621
Hampton

Master Ensuite

✓ 4830BLX 4 Hole Bic

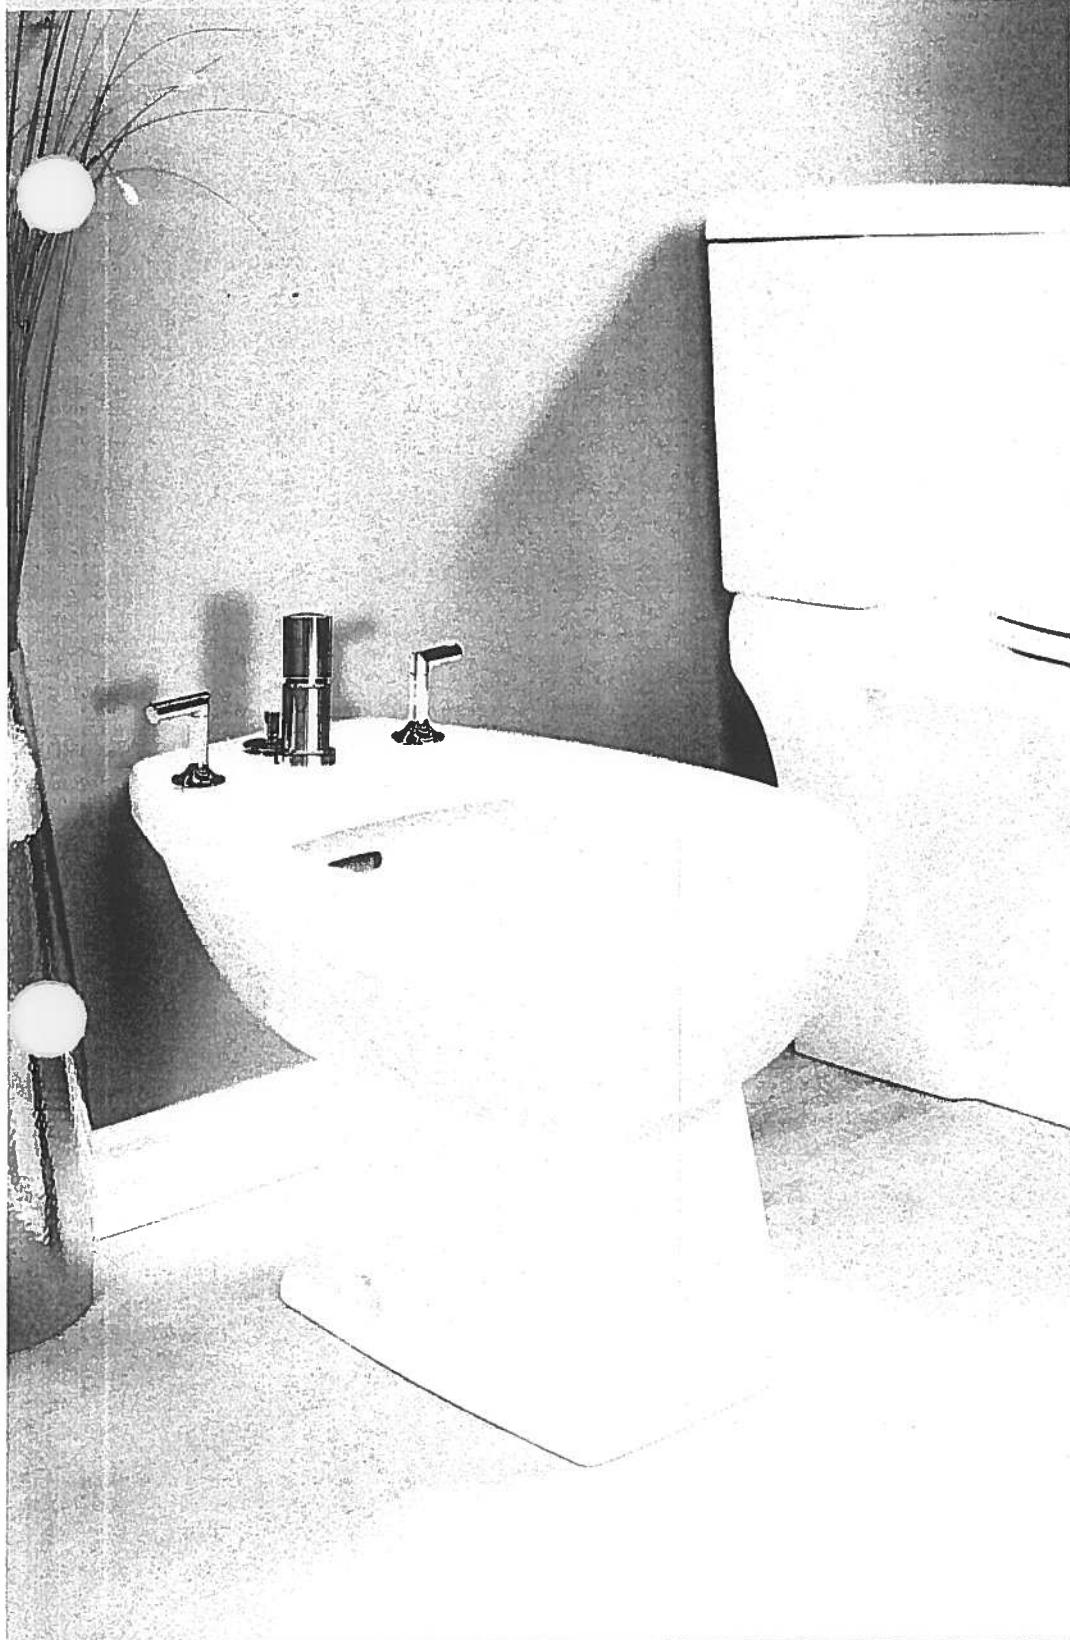

FEATURES

Vitreous china
15½" Bowl height
4 Holes (3 faucet holes with 8" center
and 1 small hole for pop-up rod)
Fits deck mounted fitting
Flushing rim
Vertical cleansing spray
Integral overflow
Faucet not included
14¾"(W) x 25¾"(D) x 15½"(H)

CERTIFICATIONS

IAPMO cUPC
ASME A112.19.2 / CSA B45.1-2008

COLOUR


Soft white

contrac.
www.contrag.ca


The images shown are a representation of the finish and color, and may not reflect every characteristic possible.

Suite 621 Hampton


Master Ensuite

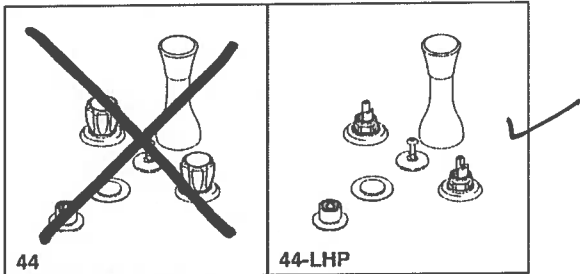

Submitted Model No.: _____
Specific Features: _____

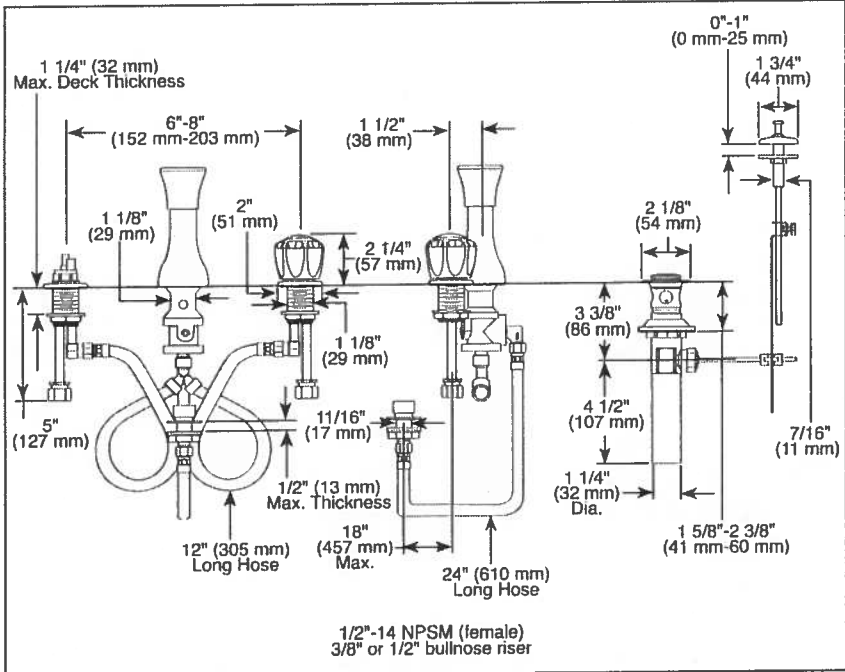

▲ Designate proper finish suffix
Available LHP Handle Options

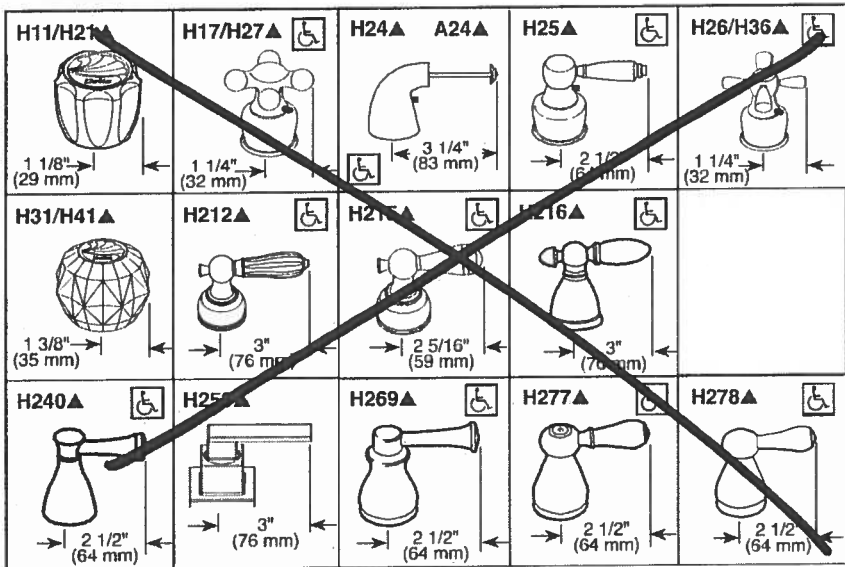

SPECIALTY FAUCETS

- Three Handle Bidet Valve
- Four Hole Installation

STANDARD SPECIFICATIONS:

- Solid fabricated brass end valves
- Widespread flexible mounting installation
- Clear knob handles with red/blue indicators or LHP-Less Handle Program. See handle options below.
- Directional handle for rim flush or rosette spray.
- Control mechanism is a rotating cylinder type with stainless steel plate and 180° rotation, with replaceable non-metallic seats operating in stainless steel lined sockets.
- Hot and cold stems are interchangeable.
- Temperature and volume controlled with handles.
- All operating parts shall be replaceable from the top.
- 3/8" O.D. copper tube inlets with 1/2"-14 NPSM adapters.
- Metal pop-up drain assembly.
- Model 44 series has vacuum breaker.
- For handle H253 you must also order RP62961, which contains 62480 base and 1713 bonnet.

WARRANTY

- Lifetime limited warranty on parts (other than electronic parts and batteries) and finishes; or, for commercial users, for 5 years from date of purchase.
- 5 year limited warranty on electronic parts (other than batteries); or, for commercial users, for 1 year from the date of purchase. No warranty is provided on batteries.

COMPLIES WITH:

- ASME A112.18.1 / CSA B125.1
- Indicates compliance to ICC/ANSI A117.1

Available LHP Handle Accent
Options with Matching Lift Knobs



See Attached For Handle



Delta reserves the right (1) to make changes in specifications and materials, and (2) to change or discontinue models, both without notice or obligation. Dimensions are for reference only. See current full-line price book or www.deltafaucet.com for finish options and product availability.

DSP-S-44 Rev. D


55 E. 111th Street, Indianapolis, Indiana 46280
350 South Edgeware Road, St. Thomas, CN N5P 4L1
© 2017 Masco Corporation of Indiana

Bidet Faucet with Vacuum Breaker



Addison

44-LHP / H292
44-SSLHP / H292SS

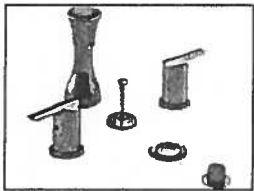



Cassidy

44-LHP / H297 / RP73818 / RP6060
44-SSLHP / H297SS / RP73818SS / RP6060
44-LHP / H295 / RP73818 / RP6060
44-SSLHP / H295SS / RP73818SS / RP6060



Linden

44-LHP / H294
44-SSLHP / H294SS



Compel

44-LHP / H261 / RP73816
~~# 44-SSLHP / H261SS / RP73816SS~~



Inisic

44-LHP / H259
44-SSLHP / H259SS



Dryden

44-LHP / H251 / RP52656
44-SSLHP / H251SS / RP52656SS



Zero

44-LHP / H253 / RP62961
44-SSLHP / H253SS / RP62961SS



Lahara

44-LHP / H238
44-SSLHP / H238SS



Zura

44-LHP / H274 / RP83944 / RP73816 (Finial)
44-SSLHP / H274SS / RP83944SS / RP73816SS (Finial)

Shown in Chrome & Brilliance® Stainless

Suite 621
Hampton

Master Ensuite

Suite 621 Hampton

Master Ensuite

CALI®

4.8Lpf / 1.28Gpf 1PC 16⁷/₈" HIGH ELONGATED

☒ 4718BOV Lined Tank

☐ 4710BOVU Unlined Tank

Product Specs:

- High efficiency toilet
- 4.8Lpf/1.28Gpf
- Elongated bowl with concealed skirted trapway
- Vitreous china
- 16⁷/₈" Plus Height bowl
- Soft white tank lever
- 12" (305mm) Rough-in
- 2" Fully glazed ball pass trapway
- 3" Flapper
- Siphon jet flush action
- Water surface (240mm x 170mm) 9¹/₂" x 6⁵/₈"
- Decorative chrome and soft white side caps included
- Smooth close toilet seat included

Overall Dimensions:

392mm (W) x 725mm (D) x 760mm (H)
15¹/₂" (W) x 28¹/₂" (D) x 29³/₄" (H)

Compliance Certifications:

Meets or exceeds the following:

- IAPMO cUPC
- US EPA WaterSense
- ASME A 12.19.2 / CSA B45.1-2013
- ADA Guidelines & ANSI A117.1
- MaP Tested 1000g
- LEED Compliant


Shipping:

Cube 9.39
GW 92.50lbs



Notes:

This toilet is designed to rough-in at a minimum dimension of 305mm (12") from finished wall to C/L of outlet. Supply line not included with fixture and must be ordered separately.
Important: Dimensions of fixtures are nominal and may vary within the range of tolerances established by ASME standard A112.19.2. These measurements are subject to change or cancellation. No responsibility is assumed for use of superseded or voided pages.
Products are designed to comply ADA/ANSI A117.1 Standard. It shall be the responsibility of the installer to comply with the local disability codes and standards prior to installing the product.

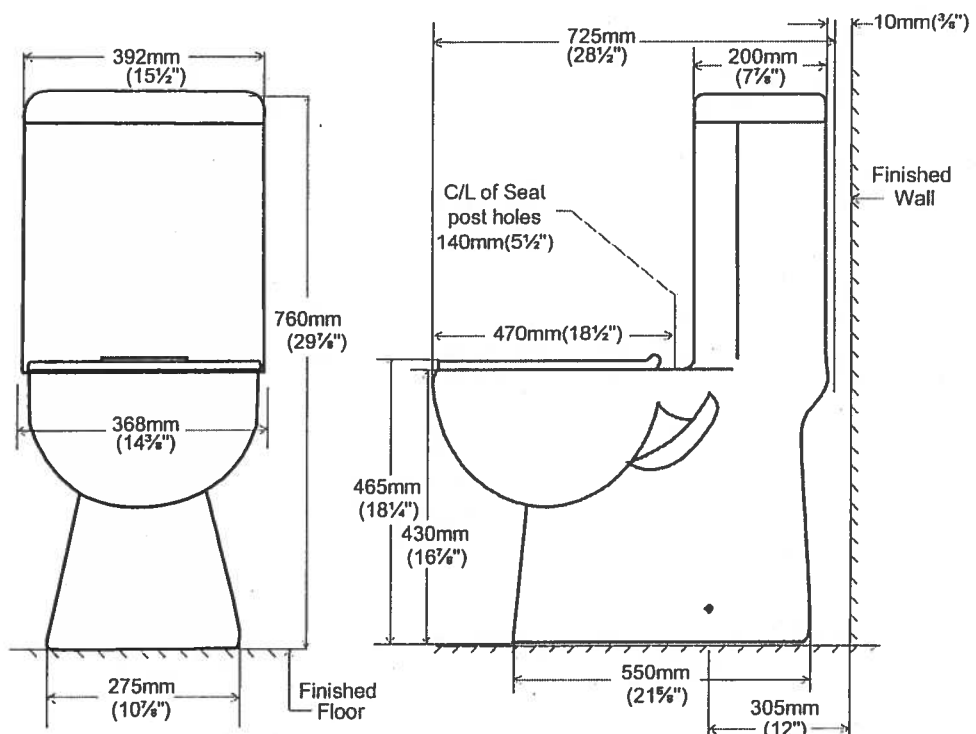

contrac

5970 Chedworth Way, Unit A, Mississauga, ON, Canada L5R 3V5
www.contrac.ca

Revised: January 2016

Countertop Edges

2.5. 2.5. 2.5.

CONNOLLY Marble & Granite Ltd.

EDGE
DETAILS

004


A.



STRAIGHT EDGE
(STANDARD - 3/4")

Standard:
Main Bath
Master Ensuite


I.

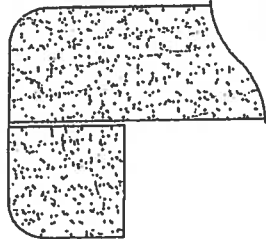

DOUBLE TOP "D" EDGE
(STANDARD - 1 1/2")

Upgrade:
Kitchen

M.

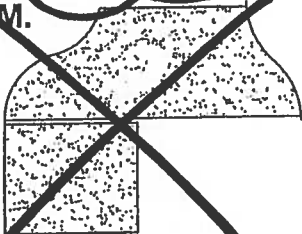

OGEE - SQUARE EDGE
(MED./HIGH - 1 1/2")

EDGING UP-GRADE OPTIONS