

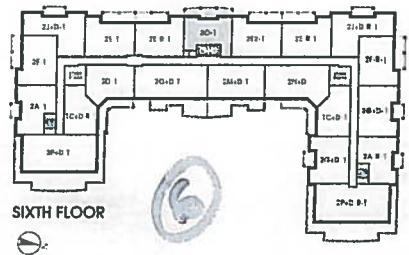


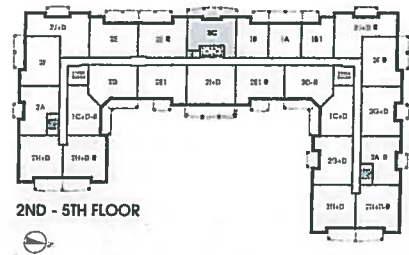

# Gardiners Bay

Suite 701  
ORIGINAL  
COPY

940 SQ FT plus 197 sq. ft. of balcony area

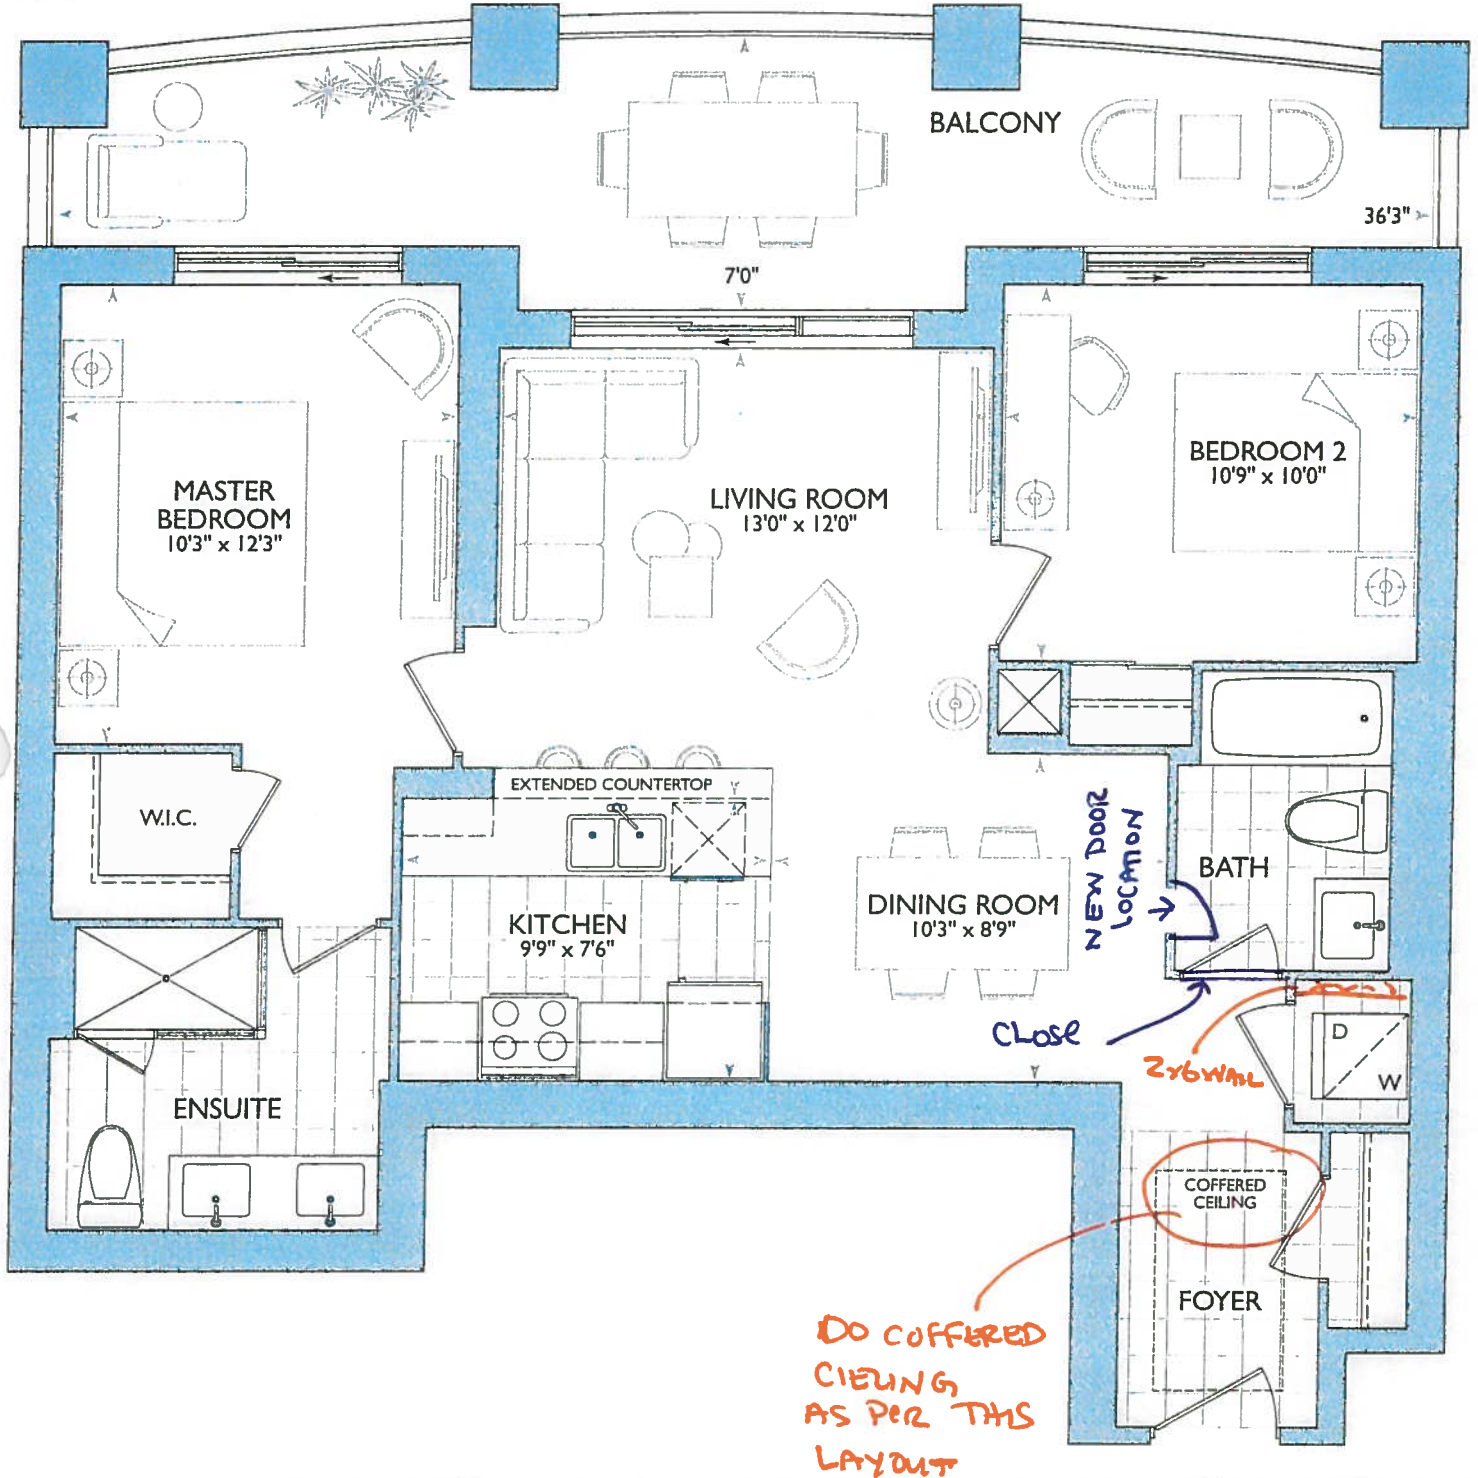

\* Foyer COFFERED CEILING.  
AS PER ORIGINAL LAYOUT

KITCHEN

- UPG #1 - KITCHEN LAYOUT
- UPG #1 - APPLIANCE PKGS.
- (x3) = PUCK LIGHTS
- (x1) = PLUG PENINSULA
- 43" STOVE PIPE CENTER
- 88" SINK PIPE CENTER
- MAIN + ENSUITE RAISED VANITIES 36 1/4" + 3" splash

RECEIVED  
March 1964**SUITE 701 - GARDINERS BAY**

■ HAMPTON PLACE ■ 25 Baker Hill Blvd - Stouffville, ON ■ Jan 31, 2018



Book  
SITE COPY

CONSTRUCTION SUMMARY

Hampton Place

PURCHASER: BEVERLEY L. REYNOLDS

TEL: RES.: 705-826-4238

| LOT NUMBER | PHASE | HOUSE TYPE    | CLOSING DATE |  |
|------------|-------|---------------|--------------|--|
| 701        | 1     | GARDINERS BAY | 13-Nov-18    |  |

|                    |                                                                         |
|--------------------|-------------------------------------------------------------------------|
| Offer<br>Worksheet | NO EXTRAS BEING PURCHASED WITH AGREEMENT OF PURCHASE AND SALE.<br>Note: |
|--------------------|-------------------------------------------------------------------------|

|                  |                                                                                                                                                      |
|------------------|------------------------------------------------------------------------------------------------------------------------------------------------------|
| Offer<br>Upgrade | PURCHASER TO RECEIVE \$15,000 IN UPGRADES (INCLUSIVE OF HST) TO BE USED AT THE DECOR CENTER<br>**AS PER AMMENDMENT DATED DECEMBER 6TH, 2015<br>Note: |
|------------------|------------------------------------------------------------------------------------------------------------------------------------------------------|

|                  |                                                                                |
|------------------|--------------------------------------------------------------------------------|
| Offer<br>Upgrade | TWO SINGLE PARKING UNITS SIDE BY SIDE IN LIEU OF TANDEM PARKING UNIT.<br>Note: |
|------------------|--------------------------------------------------------------------------------|



SITE COPY

CONSTRUCTION SUMMARY

Hampton Place

PURCHASER: BEVERLEY L. REYNOLDS

TEL: RES.: 705-826-4238

| LOT NUMBER | PHASE | HOUSE TYPE    | CLOSING DATE |
|------------|-------|---------------|--------------|
| 701        | 1     | GARDINERS BAY | 13-Nov-18    |

Date Added: 01-Feb-18      Invoice Number: 7105

1 - FOYER & KITCHEN - Install Standard Laminate Flooring in lieu of Standard Porcelain Tiles throughout Foyer and Kitchen, where applicable (See Sketch)  
Note:

1 - LAUNDRY ROOM - 1ST UPGRADE - CERAMIC TILES - 13x13 RUSTIC GREY - To be installed throughout laundry room floor (See Sketch)  
Note:

30 - MAIN BATH - 1ST UPGRADE - PORCELAIN TILES - 12x24 H-STONE LIGHT GREY - To be installed throughout main bath floor (To be Installed Straight) (See Sketch)  
Note: Includes Larger Size

60 - MASTER ENSUITE - 1ST UPGRADE - PORCELAIN TILES - 12x24 H-STONE LIGHT GREY - To be installed throughout master ensuite floor (To be Installed Straight) (See Sketch)  
Note: Includes Larger Size

1 - KITCHEN & BATHROOMS - SEE QUALITY TOPS & KITCHENS FOR ALL KITCHEN & BATHROOMS UPGRADES / LAYOUTS. - Upgrade Package #1 (See Attached QTK Paperwork)  
Note:

1 - KITCHEN - Install Standard Granite Countertop - BIANCO ANTICO - To be installed throughout kitchen, where applicable (Does not include granite backsplash) (See Sketch)  
Note:

1 - KITCHEN - COUNTERTOP EDGING - Install UPGRADE "I" EDGING - To be installed throughout kitchen countertop, where applicable (See Sketch)  
Note:

1 - DISCLAIMER - GRANITE COUNTERTOP;  
KITCHEN - Due to the many variables that can affect the pattern, colour and/or design and "pitting" of natural products, granite installed will not be identical to the samples displayed.  
Note: Every effort is made to provide granite countertops as close as possible but the vendor is not responsible for results which differ from the sample displayed. All countertop surfaces may have seams, and product pattern and shade can change in areas containing seams.

1 - DISCLAIMER - STONE COUNTERTOP;  
KITCHEN - Stone slabs vary in size & all seams are visible & the fabricator reserves the right to position the seams as necessary.  
Note:

1 - KITCHEN - Kitchen Sink - Install Upgrade Undermount Sink - BLANCO Quatrus R15 Undermount Sink - Model # 401519 (See Attached)  
Note:

1 - KITCHEN - Kitchen Faucet - Install Standard Faucet - DELTA Chrome Pull-Out Kitchen Faucet (Single Hole) - Model # 469LF - Chrome  
Note:

1 - APPLIANCE PACKAGE - Install Upgrade Appliance Package - UPGRADE PACKAGE #1 - To be installed throughout suite, where applicable (See Sketch)  
Note:

1 - KITCHEN - Install WATER LINE To FRIDGE at Kitchen (See Sketch)  
Note:

1 - MAIN BATH & MASTER ENSUITE - Install RAISED HEIGHT VANITY at Main Bath and Master Ensuite Vanities, where applicable (See Attached QTK Paperwork)  
Note:



SITE COPY

CONSTRUCTION SUMMARY

Hampton Place

PURCHASER: BEVERLEY L. REYNOLDS

TEL: RES.: 705-826-4238

| LOT NUMBER | PHASE | HOUSE TYPE    | CLOSING DATE |
|------------|-------|---------------|--------------|
| 701        | 1     | GARDINERS BAY | 13-Nov-18    |

Date Added: 01-Feb-18

Invoice Number: 7105

- 1 - CLARIFICATION;  
MAIN BATH & MASTER ENSUITE - Install Standard 3" Splash throughout Main Bath and Master Ensuite Vanity Cuontertop, where applicable (See Sketch)  
Note:
- 1 - DISCLAIMER - STONE COUNTERTOP;  
MAIN BATH & MASTER ENSUITE - Stone slabs vary in size & all seams are visible & the fabricator reserves the right to position the seams as necessary.  
Note:
- 1 - CLARIFICATION;  
MAIN BATH & MASTER ENSUITE - Install Standard Plumbing Fixtures throughout Main Bath and Master Ensuite, where applicable (See Sketch)  
Note:
- 1 - CLARIFICATION;  
MASTER ENSUITE - Purchaser accepts & acknowledges the standard frameless glass enclosure0 at master ensuite shower stall will NOT touch the ceiling and will receive a Standard Chrome Header. (See Sketch)  
Note:
- 1 - CLARIFICATION;  
MAIN BATH & MASTER ENSUITE - DELETE Do Not Install / Supply / Credit Purchaser for builders standard ceramic bathroom accessories (toilet paper, towel bar & soap dish) throughout all bathrooms where applicable.  
Note: To Include; Main Bath & Master Ensuite (See Sketch)
- 1 - BONUS PACKAGE - PURCHASER HAS APPLIED \$15,000.00 (Includes Taxes) WORTH OF UPGRADE PROMOTIONAL PACKAGE TOWARDS THE PURCHASE OF UPGRADES COMPLETED AT THE DECOR CENTRE.  
Note:
- 1 - PURCHASER HAS ATTENDED A COLOR APPOINTMENT AT THE DECOR CENTRE AND HAS DECLINED ANY ADDITIONAL UPGRADES. Purchaser accepts and acknowledges that there will be no further changes/additions/deletions to be made upon signing on February 1,2018  
Note:
- 1 - PURCHASER AWARE AND ACCEPTS THAT ANY CHANGES MADE TO UPGRADES AFTER SIGNING THIS PURCHASERS EXTRA FORM ARE SUBJECT TO A MINIMUM ADMINISTRATION FEE OF \$1,000 PLUS A 10% HOLDBACK FEE.  
Note:

This Document is Extremely Time Sensitive - Printed 7 May 18 at 17:14

 **SELECTIVE CERAMIC**  
TILE, BATH & KITCHEN CENTRE

3550 LANGSTAFF RD., STE 160 WOODBRIDGE, ONTARIO L4L 9E7

TELEPHONE: 906 860 0222 FAX: 906 860 2076 E-MAIL: INFO@SELECTIVECERAMICS.COM

Amendment to the colour chart dated: \_\_\_\_\_

Lot No: Suite 701 Site: Hampton Place

Purchaser(s): Beverley L. Reynolds


Vender: Royal Pine

It is hereby understood and agreed between the undersigned parties that the following changes shall be made to the aforementioned colour chart, and except for such changes noted, all other items in the colour chart shall remain as stated therein.

Delete: 1. 13x13 Rustic Grey - Laundry Room Floor  
2. 12x24 H-Stone Light Grey - Master Ensuite Floor and Main Bath Floor

Insert 1. 13x13 Asolena Bone - Laundry Room Floor  
2. 12x24 H-Stone Medium Grey - Master Ensuite Floor and Main Bath Floor

Dated at Selective Ceramics Imports (Vaughan) this 4 day of April 2019

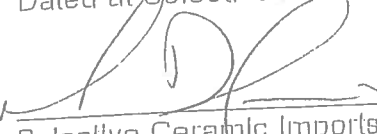  
Selective Ceramic Imports Inc

  
Purchaser

\_\_\_\_\_  
Purchaser



Revised: April 4, 2014

\* INTERIOR COLOUR SCHEME \*

Purchaser

Decor Consultant

Model Type

Telephone Res. / Bus

Project

Closing Date

Unit

BEVERLEY L. REYNOLDS

Melissa Di Marino

GARDINERS BAY

(705) 826-4238 /

Hampton Place

13/11/2018

701

Page 1 of 3

Flooring

Wall Tile

Description

Main

Accent/Insert

Pattern

12x24 H-Stone Medium Grey

8x10 NATURALE GRIGIO (STD)

NONE

NONE

12x24 H-Stone Medium Grey

8x10 NATURALE GRIGIO (STD)

NONE

NONE

POWDER ROOM

N/A

12x12

N/A

N/A

N/A

KITCHEN / DINETTE

7 1/2" Torley's Forest - Okanogan 9742P (UPG)

12x12 Twilight Mocha Glass Mosaics (STD)

NONE

NONE

BOYER

7 1/2" Torley's Forest - Okanogan 9742P (UPG)

N/A

N/A

N/A

AUNDRY

3x13 H-Stone Medium Grey

N/A

N/A

N/A

LIVING ROOM

7 1/2" Torley's Forest - Okanogan 9742P (STD)

12x12

N/A

N/A

N/A

DINING ROOM

7 1/2" Torley's Forest - Okanogan 9742P (STD)

N/A

N/A

N/A

DEN

N/A

N/A

N/A

N/A

MASTER BEDROOM

7 1/2" Torley's Forest - Okanogan 9742P (STD)

N/A

N/A

N/A

BEDROOM 2

7 1/2" Torley's Forest - Okanogan 9742P (STD)

N/A

N/A

N/A

BEDROOM 3

N/A

N/A

N/A

N/A

Notes

Page 1 of 3

Consultant:

Purchaser:

BEVERLEY L. REYNOLDS

Vendor:

Hampton Place  
Beverley L. Reynolds  
2018 12-10 PM



\* INTERIOR COLOUR SCHEME \*

|                                   |  |                                       |                             |                                          |                          |                            |             |
|-----------------------------------|--|---------------------------------------|-----------------------------|------------------------------------------|--------------------------|----------------------------|-------------|
| Purchaser<br>BEVERLEY L. REYNOLDS |  | Decor Consultant<br>Melissa Di Marino | Model Type<br>GARDINERS BAY | Telephone Res. / Bus<br>(705) 826-4238 / | Project<br>Hampton Place | Closing Date<br>13/11/2018 | Unit<br>701 |
|-----------------------------------|--|---------------------------------------|-----------------------------|------------------------------------------|--------------------------|----------------------------|-------------|

Page 2 of 3

CABINETS, VANITIES AND COUNTERTOPS

|                   | Style                                         | Countertop                                                      | Countertop Edge                                    | Handle / Knob | APPLIANCE PACKAGE     |
|-------------------|-----------------------------------------------|-----------------------------------------------------------------|----------------------------------------------------|---------------|-----------------------|
| MAIN BATHROOM     | CATEGORY 1 - FIBERBOARD - WHITE QT 1203 (STD) | <input checked="" type="checkbox"/> ASPEN TRIBECA (STD)         | <input type="checkbox"/> A " EDGE (STD)            | B603-SC       | Upgrade<br>Package #1 |
| MASTER ENSUITE    | CATEGORY 1 - FIBERBOARD - WHITE QT 1203 (STD) | <input checked="" type="checkbox"/> ASPEN TRIBECA (STD)         | <input checked="" type="checkbox"/> A " EDGE (STD) | B603-SC       |                       |
| POWDER ROOM       | N/A                                           | N/A                                                             | N/A                                                | N/A           |                       |
| KITCHEN / DINETTE | CATEGORY 1 - FIBERBOARD - WHITE QT 1203 (STD) | <input checked="" type="checkbox"/> BIANCO ANTICO GRANITE (STD) | <input checked="" type="checkbox"/> 1 " EDGE (UPG) | 16338-195     |                       |
| LAUNDRY ROOM      | N/A                                           | N/A                                                             | N/A                                                | N/A           |                       |
|                   |                                               |                                                                 |                                                    |               | Std 31in Opening      |
|                   |                                               |                                                                 |                                                    |               |                       |
|                   |                                               |                                                                 |                                                    |               |                       |

PLUMBING FIXTURES

|             |                                                                      |
|-------------|----------------------------------------------------------------------|
| KITCHEN     |                                                                      |
| Sink Model  | <input checked="" type="checkbox"/> UPG - Blanco Quatrus R15 #401519 |
| Sink Faucet | <input checked="" type="checkbox"/> STANDARD                         |

TOILETS

|                |                                              |
|----------------|----------------------------------------------|
| Master Ensuite | <input checked="" type="checkbox"/> STANDARD |
| Main Bathroom  | <input checked="" type="checkbox"/> STANDARD |
| Powder Room    | N/A                                          |

VANITY FAUCETS

|                |                                              |
|----------------|----------------------------------------------|
| Master Ensuite | <input checked="" type="checkbox"/> STANDARD |
| Main Bathroom  | <input checked="" type="checkbox"/> STANDARD |
| Powder Room    | N/A                                          |

VANITY SINKS

|                |                                              |
|----------------|----------------------------------------------|
| Master Ensuite | <input checked="" type="checkbox"/> STANDARD |
| Main Bathroom  | <input checked="" type="checkbox"/> STANDARD |
| Powder Room    | N/A                                          |

SHOWER STALL / TUBS

|                             |                                              |
|-----------------------------|----------------------------------------------|
| Master Ensuite Shower Stall | <input checked="" type="checkbox"/> STANDARD |
| Master Ensuite Tub          | N/A                                          |
| Main Bathroom Tub           | <input checked="" type="checkbox"/> STANDARD |

|                    |                                                               |
|--------------------|---------------------------------------------------------------|
| Trim               |                                                               |
| Baseboard & Casing | <input checked="" type="checkbox"/> STANDARD                  |
| Interior Doors     | <input checked="" type="checkbox"/> STANDARD - CARRARA SMOOTH |

|             |                                              |
|-------------|----------------------------------------------|
| Levers      | <input checked="" type="checkbox"/> STANDARD |
| Door Height | <input checked="" type="checkbox"/> STANDARD |

Cornice Moulding / Medallion

|                |                                                         |
|----------------|---------------------------------------------------------|
| Foyer          | <input checked="" type="checkbox"/> STANDARD - #CTR-611 |
| Living Room    | <input checked="" type="checkbox"/> STANDARD - #CTR-611 |
| Dining Room    | <input checked="" type="checkbox"/> STANDARD - #CTR-611 |
| Den            | N/A                                                     |
| Master Bedroom | NONE                                                    |
| Bedroom 2      | NONE                                                    |
| Bedroom 3      | N/A                                                     |

Fireplace

|                   |     |
|-------------------|-----|
| Fireplace         | N/A |
| Location Flooring | N/A |
| Style             | N/A |
| Finish            | N/A |
| Marble            | N/A |
| Hearth            | N/A |

MISC. INSTALLATIONS

Ceramic Accessories  
(Installed by Vendor)  
☒ Yes ☐ No

Bathroom Mirrors  
(Installed by Vendor)  
☒ Yes ☐ No

Wire Shelving - Closet  
(Installed by Vendor)  
☒ Yes ☐ No

Paint Throughout

|       |                                                            |
|-------|------------------------------------------------------------|
| Walls | <input checked="" type="checkbox"/> STANDARD - BIRCH WHITE |
| Trim  | <input checked="" type="checkbox"/> STANDARD - WHITE       |

Page 2 of 3

Decor Consultant:

Melissa Di Marino


Purchaser:

BEVERLEY L. REYNOLDS

Vendor:

Hampton Place


- UPG #1- KITCHEN PKG.
- UPG #1- APPLIANCE PKG.
- (x3)- PUCK LIGHTS
- (x1)- PLUG PENINSULA
- MAIN + ENSUITE RAISED VANITIES 36 1/4" + 3" SPLASH.

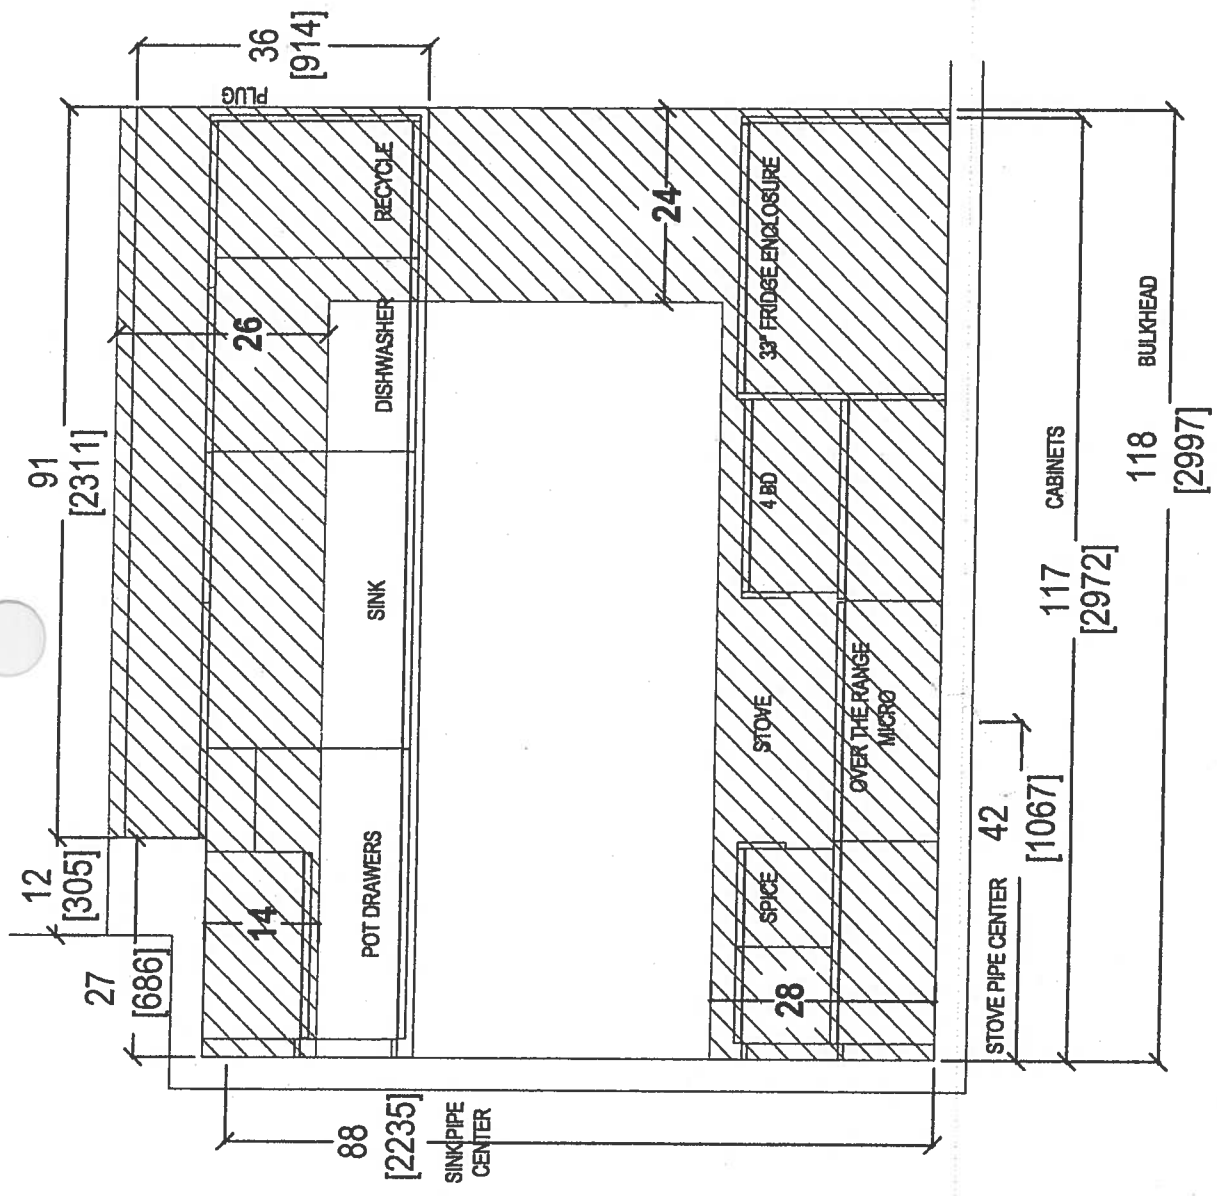


|  |                          |                        |                          |                       |                                                                                                             |
|--|--------------------------|------------------------|--------------------------|-----------------------|-------------------------------------------------------------------------------------------------------------|
|  | CLIENT: ROYAL PINE HOMES | JOB NAME: UNIT 701 HMP | ROOM: KITCHEN FLOOR PLAN | DRAWN BY: SK          | COMMENTS:<br><br>PLEASE NOTE ALL DIMENSIONS ARE NOT FINAL AND ARE SUBJECT TO CHANGE UPON FINAL SITE MEASURE |
|  | SITE: HAMPTON PLACE      | DOOR STYLE: —          | DOOR HANDLE: —           | SCALE: 1/2" = 1' - 0" |                                                                                                             |
|  | PHONE: —                 | FINISH: —              | DRW HANDLE: —            | DATE: APRIL 27, 2018  |                                                                                                             |
|  | EMAIL: —                 | SPECIES: —             | TOP: —                   | PAGE:                 |                                                                                                             |

- UPG #1 - KITCHEN LAYOUT
- UPG #1 - APPLIANCE PKG.
- (x3) = PUCK LIGHTS
- (x1) = PLUG PENINSULA

\* HALL + ENSUITE RAISED  
VANITY 36 1/4" + 3" SPLASH


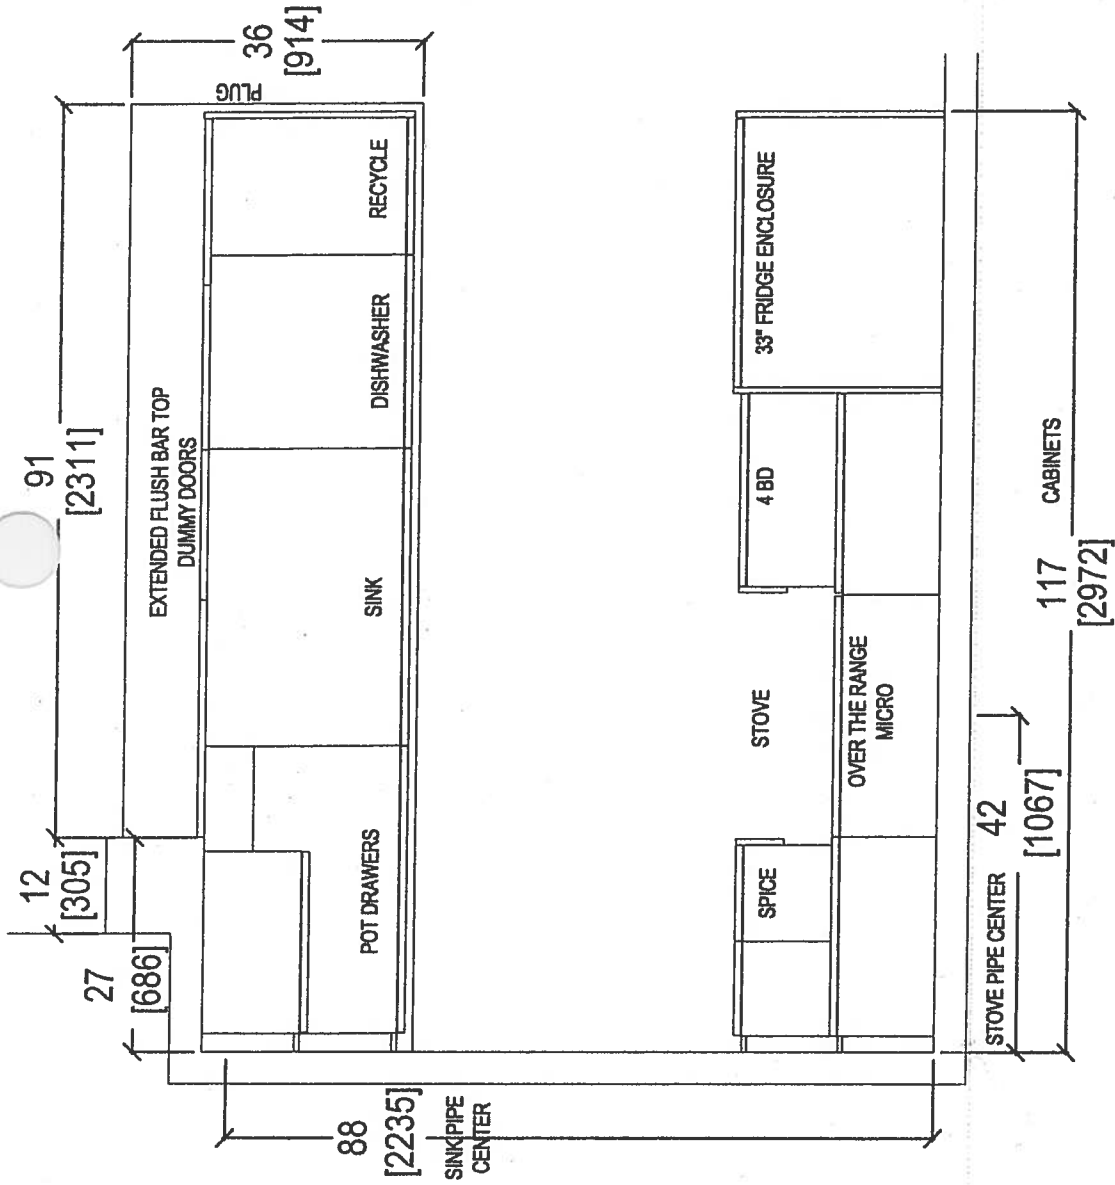


|                                                                                                                                                                                              |                          |                        |                          |                       |                                                                                                                                |
|----------------------------------------------------------------------------------------------------------------------------------------------------------------------------------------------|--------------------------|------------------------|--------------------------|-----------------------|--------------------------------------------------------------------------------------------------------------------------------|
| <br>your kitchen, your taste.<br>80 SANTE DRIVE VAUGHAN, ON L4K 3C4,<br>T: 416.748.1811 F: 905.781.5901 | CLIENT: ROYAL PINE HOMES | JOB NAME: UNIT 701 HMP | ROOM: KITCHEN FLOOR PLAN | DRAWN BY: SK          | COMMENTS:<br><br>PLEASE NOTE ALL DIMENSIONS<br>ARE NOT FINAL AND ARE<br>SUBJECT TO CHANGE UPON<br>FINAL SITE MEASURE<br><br>Cy |
|                                                                                                                                                                                              | SITE: HAMPTON PLACE      | DOOR STYLE: —          | DOOR HANDLE: —           | SCALE: 1/2" = 1' - 0" |                                                                                                                                |
|                                                                                                                                                                                              | PHONE: —                 | FINISH: —              | DRW HANDLE: —            | DATE: APRIL 27, 2018  |                                                                                                                                |
|                                                                                                                                                                                              | EMAIL: —                 | SPECIES: —             | TOP: —                   | PAGE:                 |                                                                                                                                |

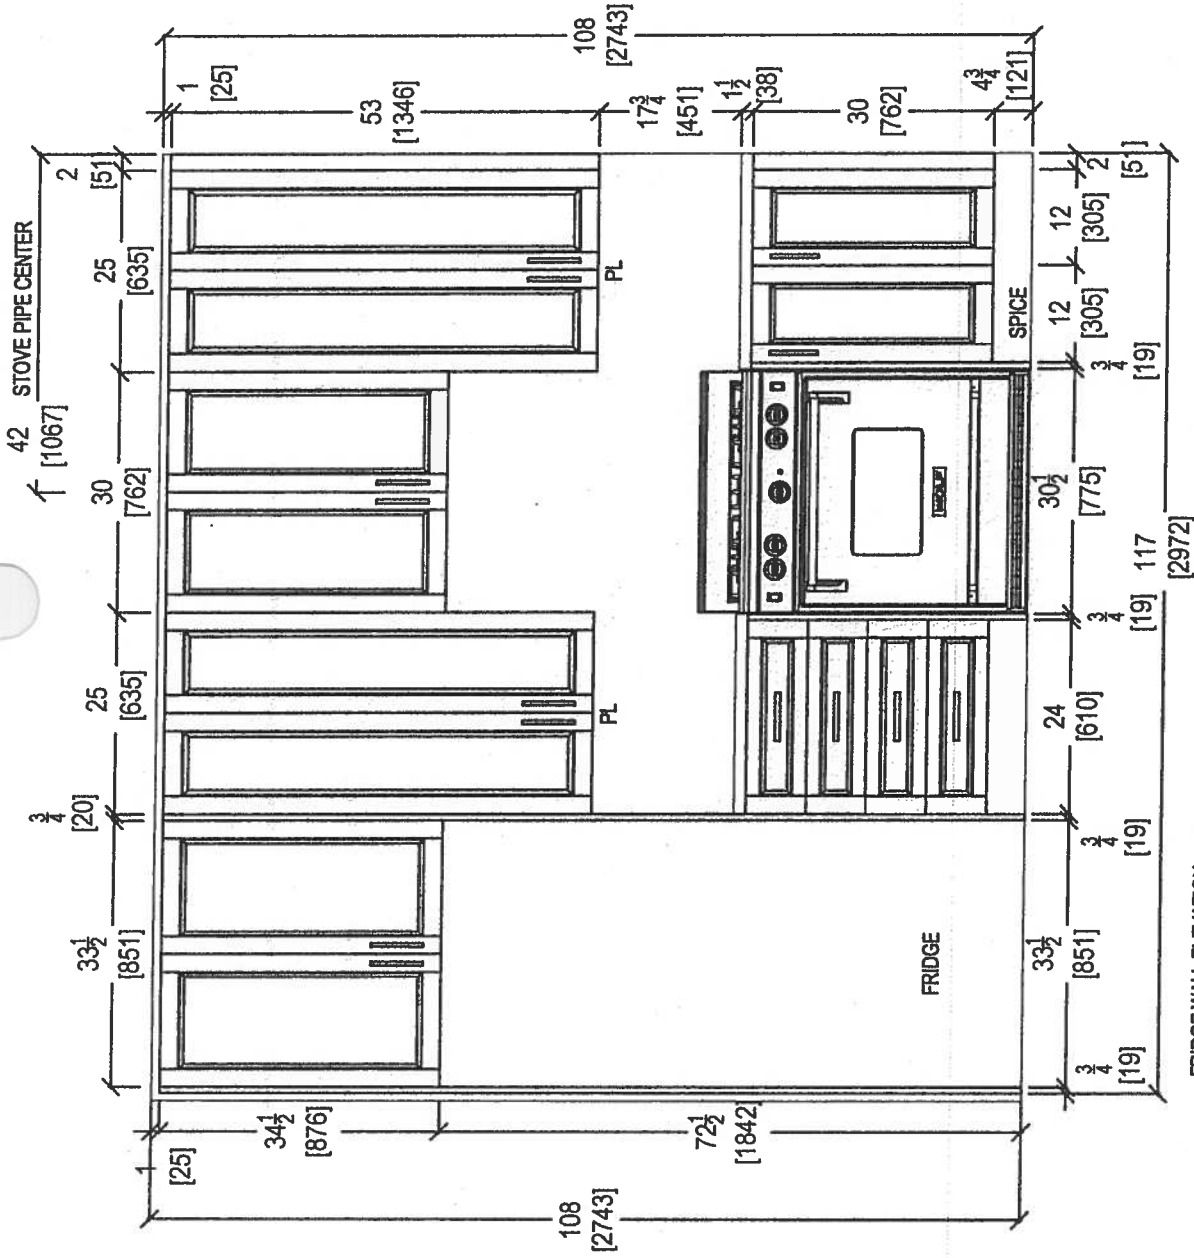

80 SANTE DRIVE, VAUGHAN, ON L4K 3C4,  
T: 416.748.1811 F: 905.781.5901


|                                                                         |                        |                |                       |                                                                                                                      |
|-------------------------------------------------------------------------|------------------------|----------------|-----------------------|----------------------------------------------------------------------------------------------------------------------|
| CLIENT: ROYAL PINE HOMES<br>SITE: HAMPTON PLACE<br>PHONE: —<br>EMAIL: — | JOB NAME: UNIT 701 HMP | ROOM: KITCHEN  | DRAWN BY: SK          | COMMENTS:<br><br>PLEASE NOTE ALL DIMENSIONS<br>ARE NOT FINAL AND ARE<br>SUBJECT TO CHANGE UPON<br>FINAL SITE MEASURE |
|                                                                         | DOOR STYLE: —          | DOOR HANDLE: — | SCALE: 1/2" = 1' - 0" |                                                                                                                      |
|                                                                         | FINISH: —              | DRW HANDLE: —  | DATE: APRIL 27, 2018  |                                                                                                                      |
|                                                                         | SPECIES: —             | TOP: —         | PAGE:                 |                                                                                                                      |

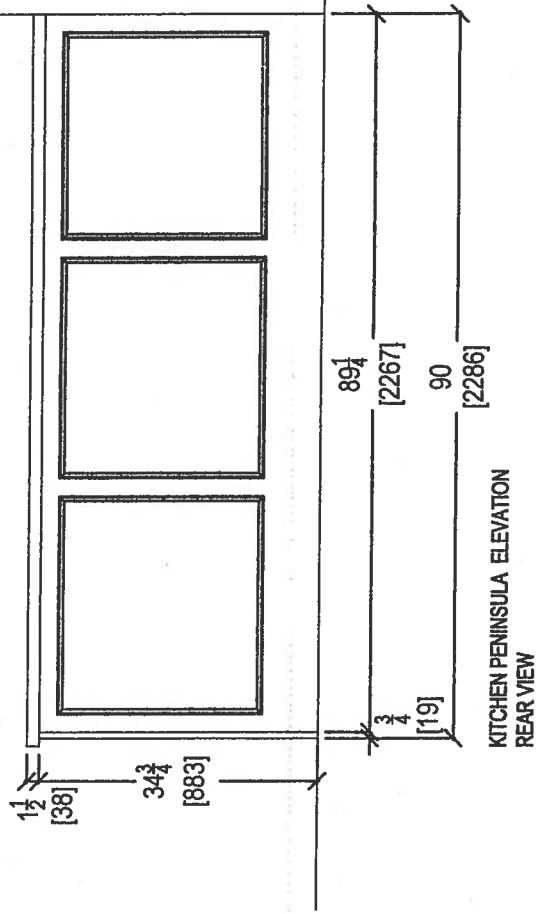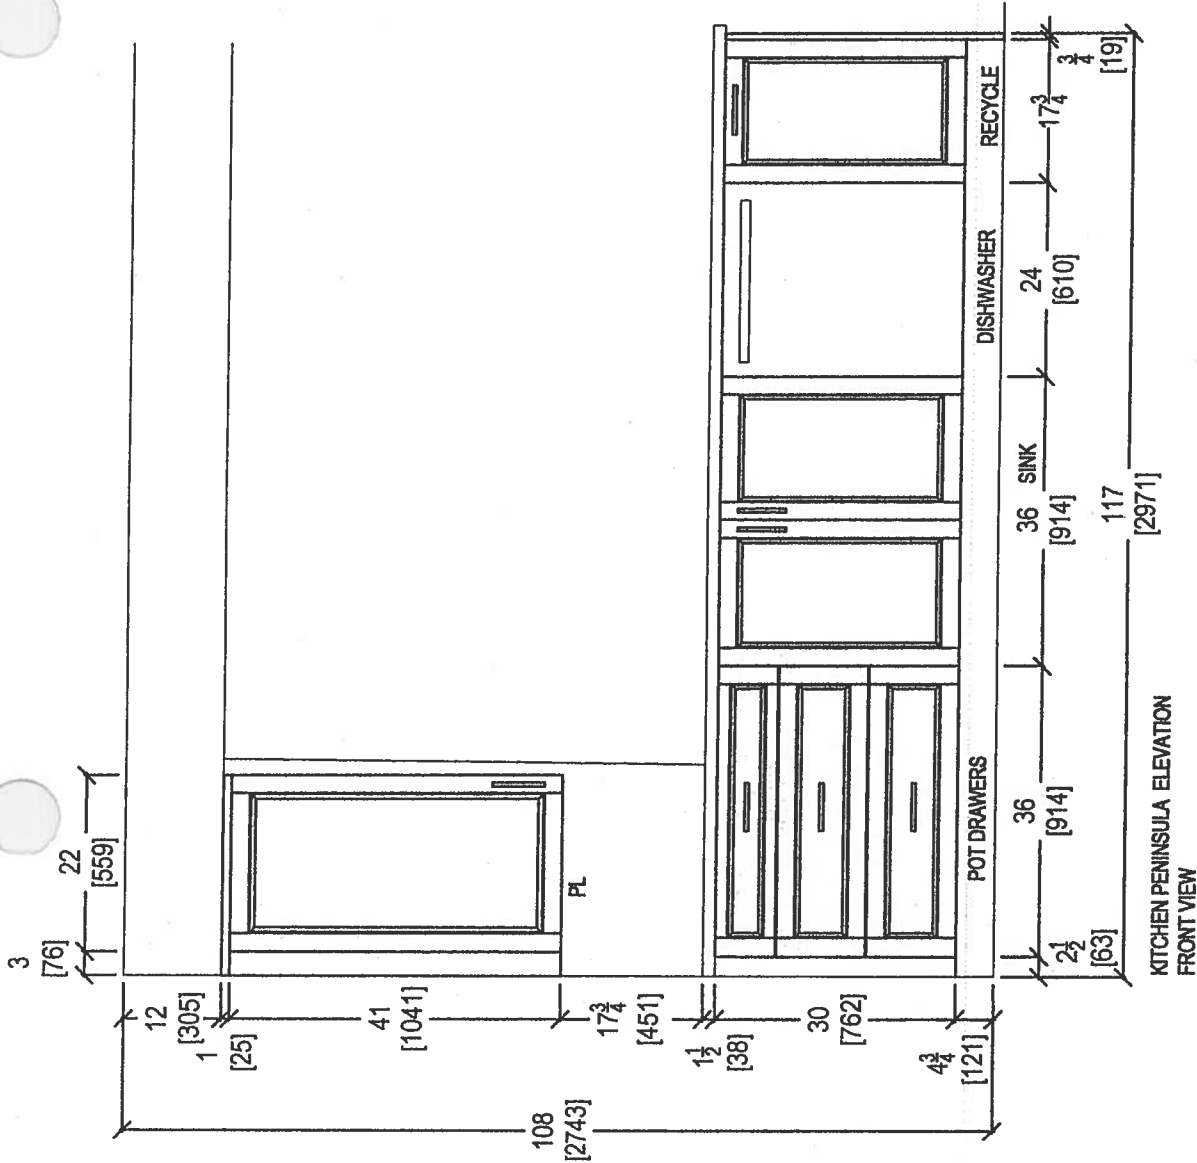

your kitchen, your taste.  
80 SANTE DRIVE, VAUGHAN, ON L4K 3C4,  
T: 416.746.1811 F: 905.781.5901



|                          |                        |                |                       |                                                                                                                      |
|--------------------------|------------------------|----------------|-----------------------|----------------------------------------------------------------------------------------------------------------------|
| CLIENT: ROYAL PINE HOMES | JOB NAME: UNIT 701 HMP | ROOM: KITCHEN  | DRAWN BY: SK          | COMMENTS:<br><br>PLEASE NOTE ALL DIMENSIONS<br>ARE NOT FINAL AND ARE<br>SUBJECT TO CHANGE UPON<br>FINAL SITE MEASURE |
| SITE: HAMPTON PLACE      | DOOR STYLE: —          | DOOR HANDLE: — | SCALE: 1/2" = 1' - 0" |                                                                                                                      |
| PHONE: —                 | FINISH: —              | DRW HANDLE: —  | DATE: APRIL 27, 2018  |                                                                                                                      |
| EMAIL: —                 | SPECIES: —             | TOP: —         | PAGE:                 |                                                                                                                      |

\* 2" SPLASH \*

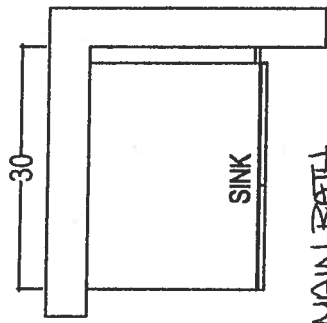


MAIN BATH

\* RAISED HEIGHT \*

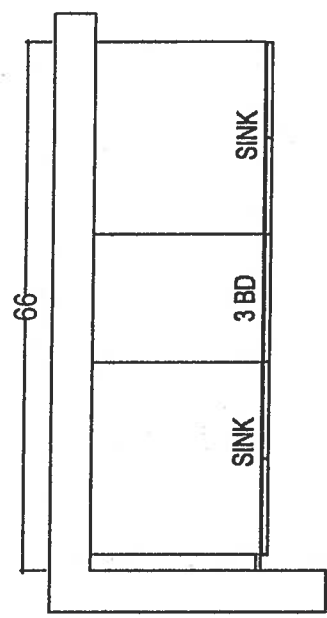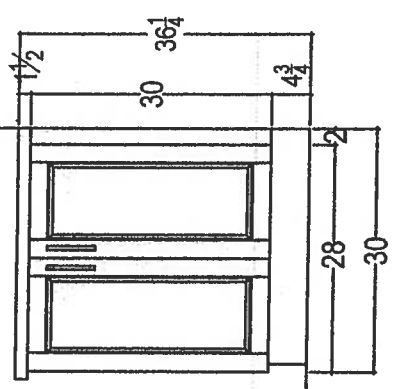

MASTER ENSUITE

\* RAISED HEIGHT \*

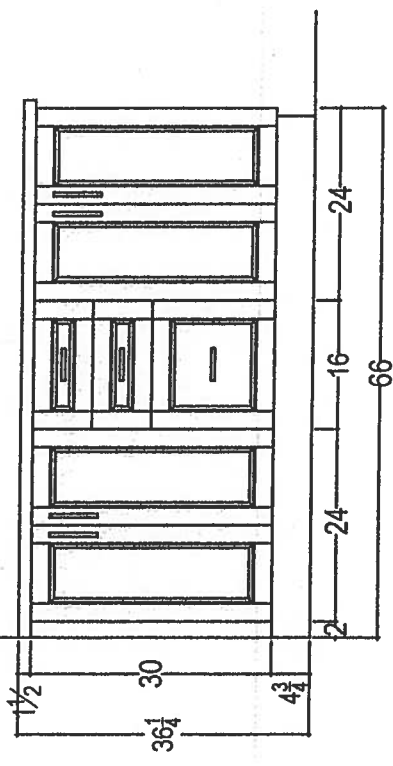

your kitchen, your taste.  
80 SANTE DRIVE, VAUGHAN, ON L4K 3C4,  
T: 416.746.1811 F: 905.761.5901

|                          |                        |               |                |                       |                                                                                                             |
|--------------------------|------------------------|---------------|----------------|-----------------------|-------------------------------------------------------------------------------------------------------------|
| CLIENT: ROYAL PINE HOMES | JOB NAME: UNIT 701 HMP | ROOM:         | DRAWN BY: SK   |                       | COMMENTS:<br><br>PLEASE NOTE ALL DIMENSIONS ARE NOT FINAL AND ARE SUBJECT TO CHANGE UPON FINAL SITE MEASURE |
|                          | SITE: HAMPTON PLACE    | DOOR STYLE: — | DOOR HANDLE: — | SCALE: 1/2" = 1' - 0" |                                                                                                             |
|                          | PHONE: —               | FINISH: —     | DRW HANDLE: —  | DATE: APRIL 27, 2018  |                                                                                                             |
|                          | EMAIL: —               | SPECIES: —    | TOP: —         | PAGE: —               |                                                                                                             |

Suite 701  
Hampton

WRB322DMBM

Upgrade  
Package I



Whirlpool

<http://www.whirlpool.com>

33-inches wide Bottom-Freezer Refrigerator with  
SpillGuard™ Glass Shelves - 22 cu. ft

Key Features:

- SpillGuard™ Glass Shelves
- Adaptive Defrost / *Factory Installed Icemaker*
- FreshFlow™ Produce Preserver
- LED Interior Lighting
- ENERGY STAR® Qualified

Product Dimensions:

Height: 70

Width: 32 5/8

Depth: 33 3/8

Electrical Requirements:

15


Additional Information:

[Use And Care Guide](#)

[Dimension Guide](#)

[Energy Guide](#)

[Warranty Certificate](#)

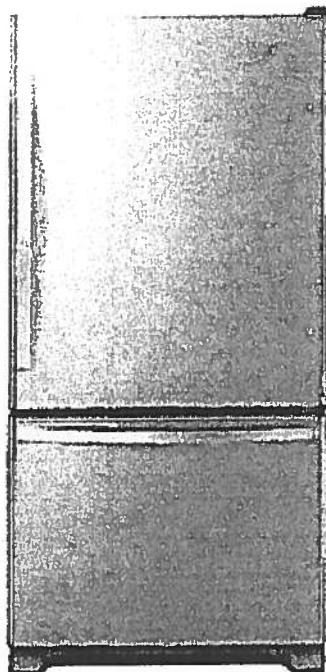

INVESTED  
IN  
AMERICA



©Registered trademark/TM Trademark of Whirlpool, U.S.A. © 2018 Whirlpool Corporation. All Rights Reserved.  
All other trademarks are owned by their respective companies.  
Because Whirlpool Corporation policy includes a continuous commitment to improve our products, we reserve the right to change materials and specifications without notice. We also reserve the right to discontinue transition products without notice.  
Manufacturer's Suggested Retail Price (MSRP) and Minimum Advertised Price (MAP) provided for reference purposes only. Dealer alone determines advertised and retail prices.  
Created On: Tuesday, March 14, 2017 11:30:08

Suite 701  
Hampton

Upgrade  
Package I




WEE745H0FS

Whirlpool

<http://www.whirlpool.com>

6.4 Cu. Ft. Slide-In Electric Range with True Convection

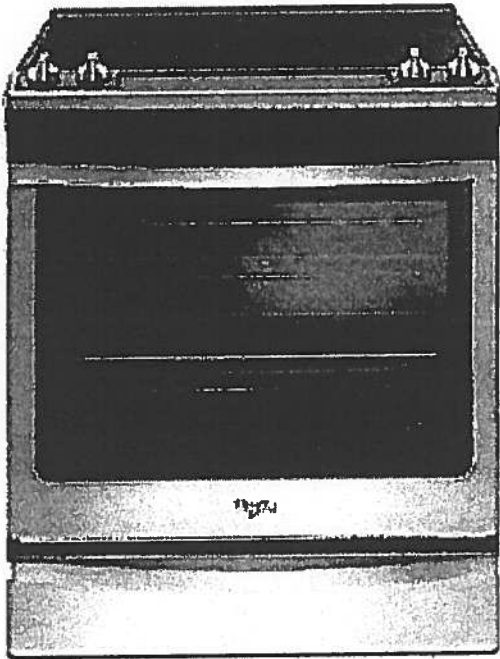

Key Features:

- Frozen Bake™ Technology
- True Convection Cooking
- FlexHeat™ Triple Radiant Element
- Convection Conversion
- AquaLift® Self-Cleaning Technology
- Temperature Sensor
- Rapid Preheat
- 6.4 Cu. Ft. Capacity
- Easy-Wipe Ceramic Glass Cooktop
- Large Oven Window
- Max Capacity Rack
- Hidden Bake Element

Product Dimensions:

Height: 36

Width: 29 7/8

Additional Information:

[Use And Care Guide](#)

[Dimension Guide](#)

[Installation Guide](#)

[Warranty Certificate](#)

INVESTED  
IN  
AMERICA

ADA  
Compliant

©Registered trademark/TM Trademark of Whirlpool, U.S.A. © 2016 Whirlpool Corporation. All Rights Reserved.  
All other trademarks are owned by their respective companies.  
Because Whirlpool Corporation policy includes a continuous commitment to improve our products, we reserve the right to change materials and specifications without notice. We also reserve the right to discontinue products without notice.  
Manufacturer's Suggested Retail Price (MSRP) and Minimum Advertised Price (MAP) provided for informational purposes only. Dealer alone determines advertised and retail prices.  
Created On: Friday, January 27, 2017 10:46:47

Suite 701  
Hampton

Upgrade  
Package 1



YWMH76719CS




<http://www.whirlpool.com>

1.9 cu. ft. Microwave Hood Combination with  
TimeSavor™ Plus True Convection

#### Key Features:

- TimeSavor™ Plus True Convection Cooking System
- Steam Cooking
- Sensor Cooking
- AccuPop™ Cycle
- CleanRelease® Non-Stick Interior
- SteamClean Option
- Integrated Hidden Vent and Console
- Auto Adapt Fan
- Recessed, Stoppable Glass Turntable
- Universal Microwave Steamer
- 1.9 cu. ft. Capacity
- 1,100 Watts Cooking Power

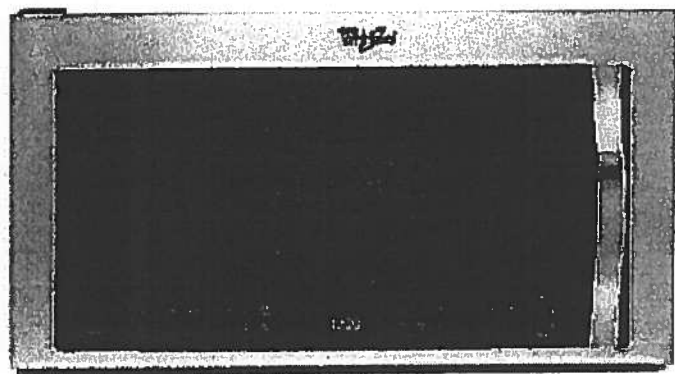

#### Product Dimensions:

Height: 17 1/8

Width: 29 15/16

Depth: 18 1/2

#### Electrical Requirements:

15 or 20. 120 V.

#### Additional Information:

Use And Care Guide

Installation Guide

Warranty Certificate

Available in:

 Stainless Steel



©Registered trademark/TM Trademark of Whirlpool, U.S.A. © 2013 Whirlpool Corporation. All Rights Reserved. All other trademarks are owned by their respective companies. Because Whirlpool Corporation policy includes a continuous commitment to improve our products, we reserve the right to change materials and specifications without notice. We also reserve the right to discontinue or transition products without notice. Manufacturer's Suggested Retail Price (MSRP) and Minimum Advertised Price (MAP) provided for reference purposes only. Dealer alone determines advertised and retail prices.  
Created On: Monday, March 14, 2016 13:16:48

# Suite 701 Hampton Upgrade Package 1

WDTA50SAHZ



## Whirlpool

<http://www.whirlpool.com>

Contemporary Design. Stainless Steel Tub  
Dishwasher with TotalCoverage Spray Arm

### Key Features:

- Sensor Cycle
- TotalCoverage Spray Arm
- 1-Hour Wash Cycle
- Tap Touch Controls

### Product Dimensions:

Height: 34 1/2

Width: 23 7/8

Depth: 24 1/2

### Additional Information:


[Use And Care](#)

[Dimension Guide](#)

[Installation Guide](#)

[Energy Guide](#)

[Warranty](#)

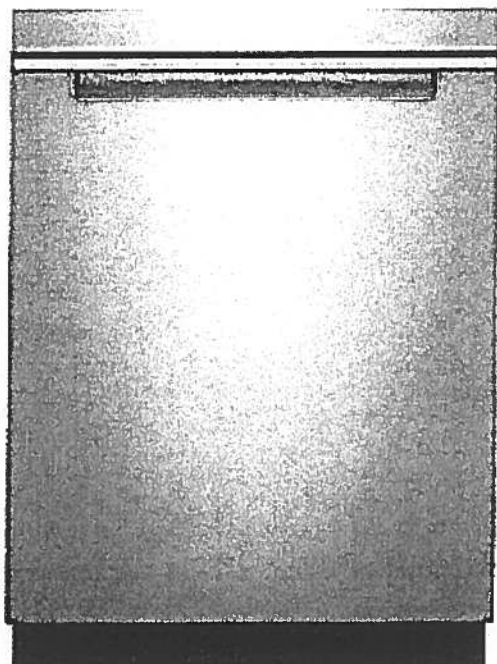

Available in:

● Black

Fingerprint Resistant Sunset Bronze

Fingerprint Resistant Black Stainless

○ White

Fingerprint Resistant Stainless Steel

INVESTED  
IN  
AMERICA



©Registered trademark/TM Trademark of Whirlpool, U.S.A. © 2016 Whirlpool Corporation. All Rights Reserved. All other trademarks are owned by their respective companies.

Because Whirlpool Corporation policy includes a continuous commitment to improve our products, we reserve the right to change materials and specifications without notice. We also reserve the right to discontinue or transition products without notice.

Manufacturer's Suggested Retail Price (MSRP) and Minimum Advertised Price (MAP) provided for reference purposes only. Dealer alone determines advertised and retail prices.

Suite 701  
Hampton

Upgrade  
Package I




WFW75HEFW



<http://www.whirlpool.com>

4.5 cu. ft. Front Load Washer with Precision  
Dispense

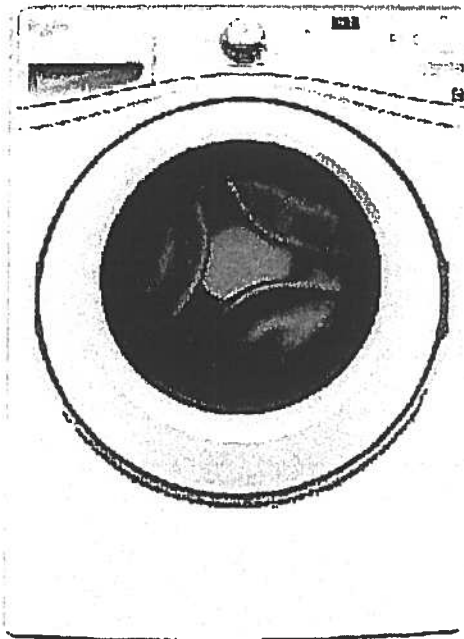

**Key Features:**

- Precision Dispense
- Adaptive Wash Technology
- Smooth Wave Stainless Steel Wash Basket
- 4.5 cu. ft. Capacity
- ENERGY STAR® Qualified

**Product Dimensions:**

Height: 39 3/4

Width: 27

Depth: 33 5/16

**Electrical Requirements:**

15 or 20. 120 V.

**Additional Information:**

[Use And Care Guide](#)

[Dimension Guide](#)

[Installation Guide](#)

[Energy Guide](#)

[Warranty Certificate](#)

INVESTED  
IN  
AMERICA



©Registered trademark/TM Trademark of Whirlpool, U S A. ©2013 Whirlpool Corporation All Rights Reserved  
All other trademarks are owned by their respective companies  
Because Whirlpool Corporation policy includes a continuous commitment to improve our products, we reserve the right to change materials and specifications without notice. We also reserve the right to discontinue or transition products without notice  
Manufacturer's Suggested Retail Price (MSRP) and Minimum Advertised Price (MAP) provided for reference purposes only. Dealer alone determines advertised and retail prices  
Created On: Wednesday, March 23, 2016 11:51:03

Suite 701  
Hampton

Upgrade  
Package 1




YWED75HEFW

8.5 cu. ft. Duet® High Efficiency Front Load Electric  
Dryer with ENERGY STAR®

MSRP: \$0.00

Whirlpool

<http://www.whirlpool.com>

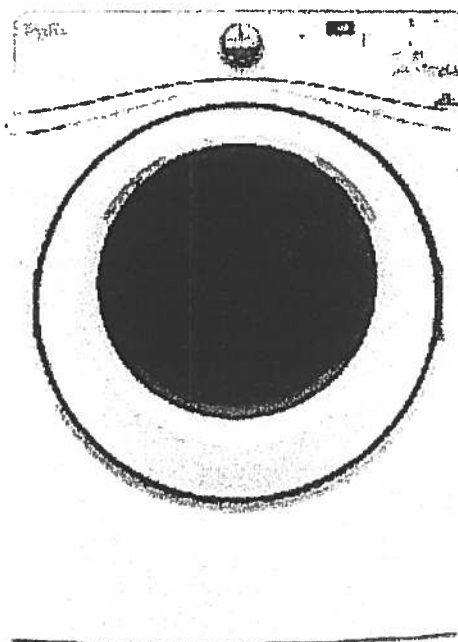

**Key Features:**

- Advanced Moisture Sensing System
- Quad Baffles
- Tap Touch Controls with Memory
- EcoBoost™ Option
- Wrinkle Shield™ Plus Option
- Undercounter Installation
- 7.4 Cu. Ft. Capacity
- ENERGY STAR® Qualified

**Product Dimensions:**

Height: 39

Width: 27

Depth: 31

**Additional Information:**

[Use And Care](#)

[Installation Guide](#)

[Warranty](#)

Available in:

☐ White

INVESTED  
IN  
AMERICA

ADA  
Compliant

©Registered trademark/TM Trademark of Whirlpool, U.S.A. © 2016 Whirlpool Corporation All Rights Reserved. All other trademarks are owned by their respective companies.

Because Whirlpool Corporation policy includes a continuous commitment to improve our products, we reserve the right to change materials and specifications without notice. We also reserve the right to discontinue or transition products without notice.


Manufacturer's Suggested Retail Price (MSRP) and Minimum Advertised Price (MAP) provided for reference purposes only. Dealer alone determines advertised and retail prices.

# Upgrade Kitchen Sinks




## BLANCO

Suite 701  
Hampton

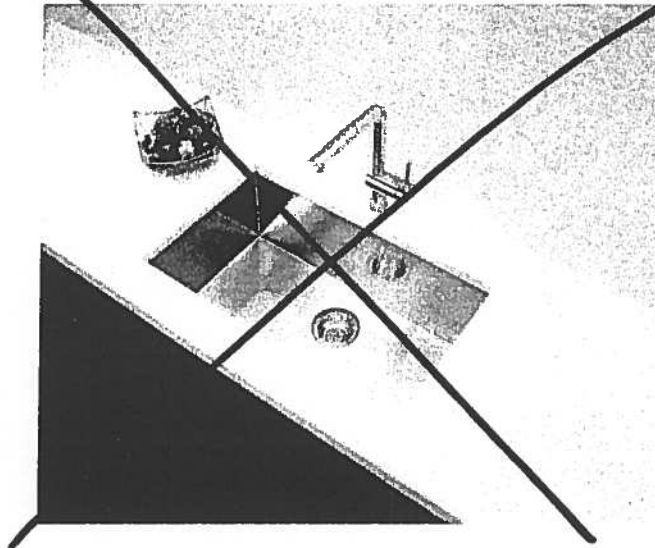

**Blanco Quatrus U Super Single  
Undermount Sink  
#401248**

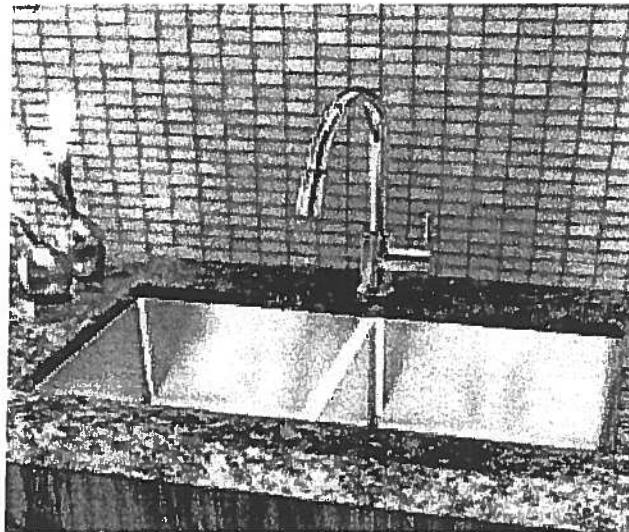

**Blanco Quatrus R15 Two Bowl  
Undermount Sink  
#401519**

# Countertop Edges

## Suite 701

## Hampton




**CONNOLLY** Marble & Granite Ltd.

EDGE  
DETAILS

004


A.

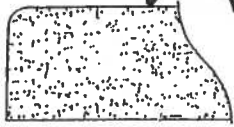

STRAIGHT EDGE  
(STANDARD - 3/4")

Standard:  
Main Bath  
Master Ensuite


I.

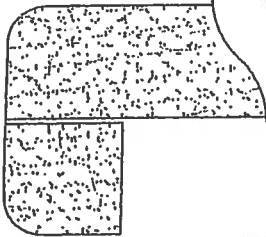

DOUBLE TOP "D" EDGE  
(STANDARD - 1 1/2")

Upgrade:  
Kitchen

M.

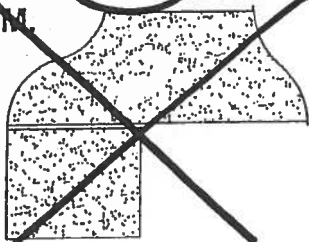

OGEE - SQUARE EDGE  
(MED./HIGH - 1 1/2")

EDGING UP-GRADE OPTIONS