

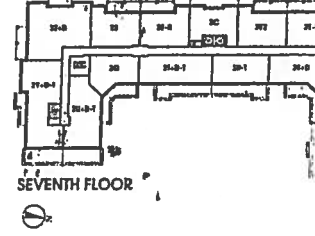
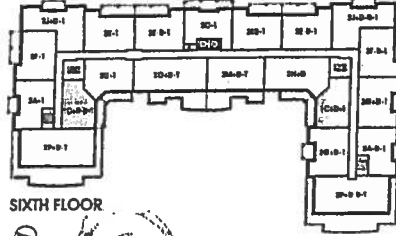
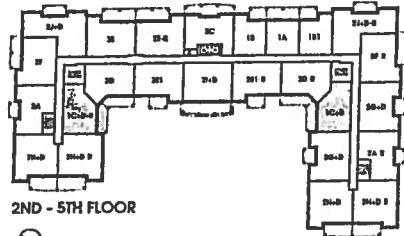


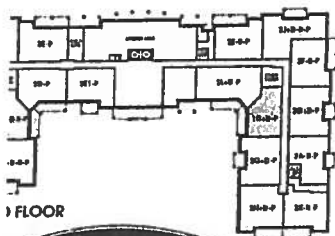

Sag Harbor

878 SQ FT *plus 119 sq. ft. of balcony area*


SUITE 318
ORIGINAL LAYOUT
INVENTORY
SUITE

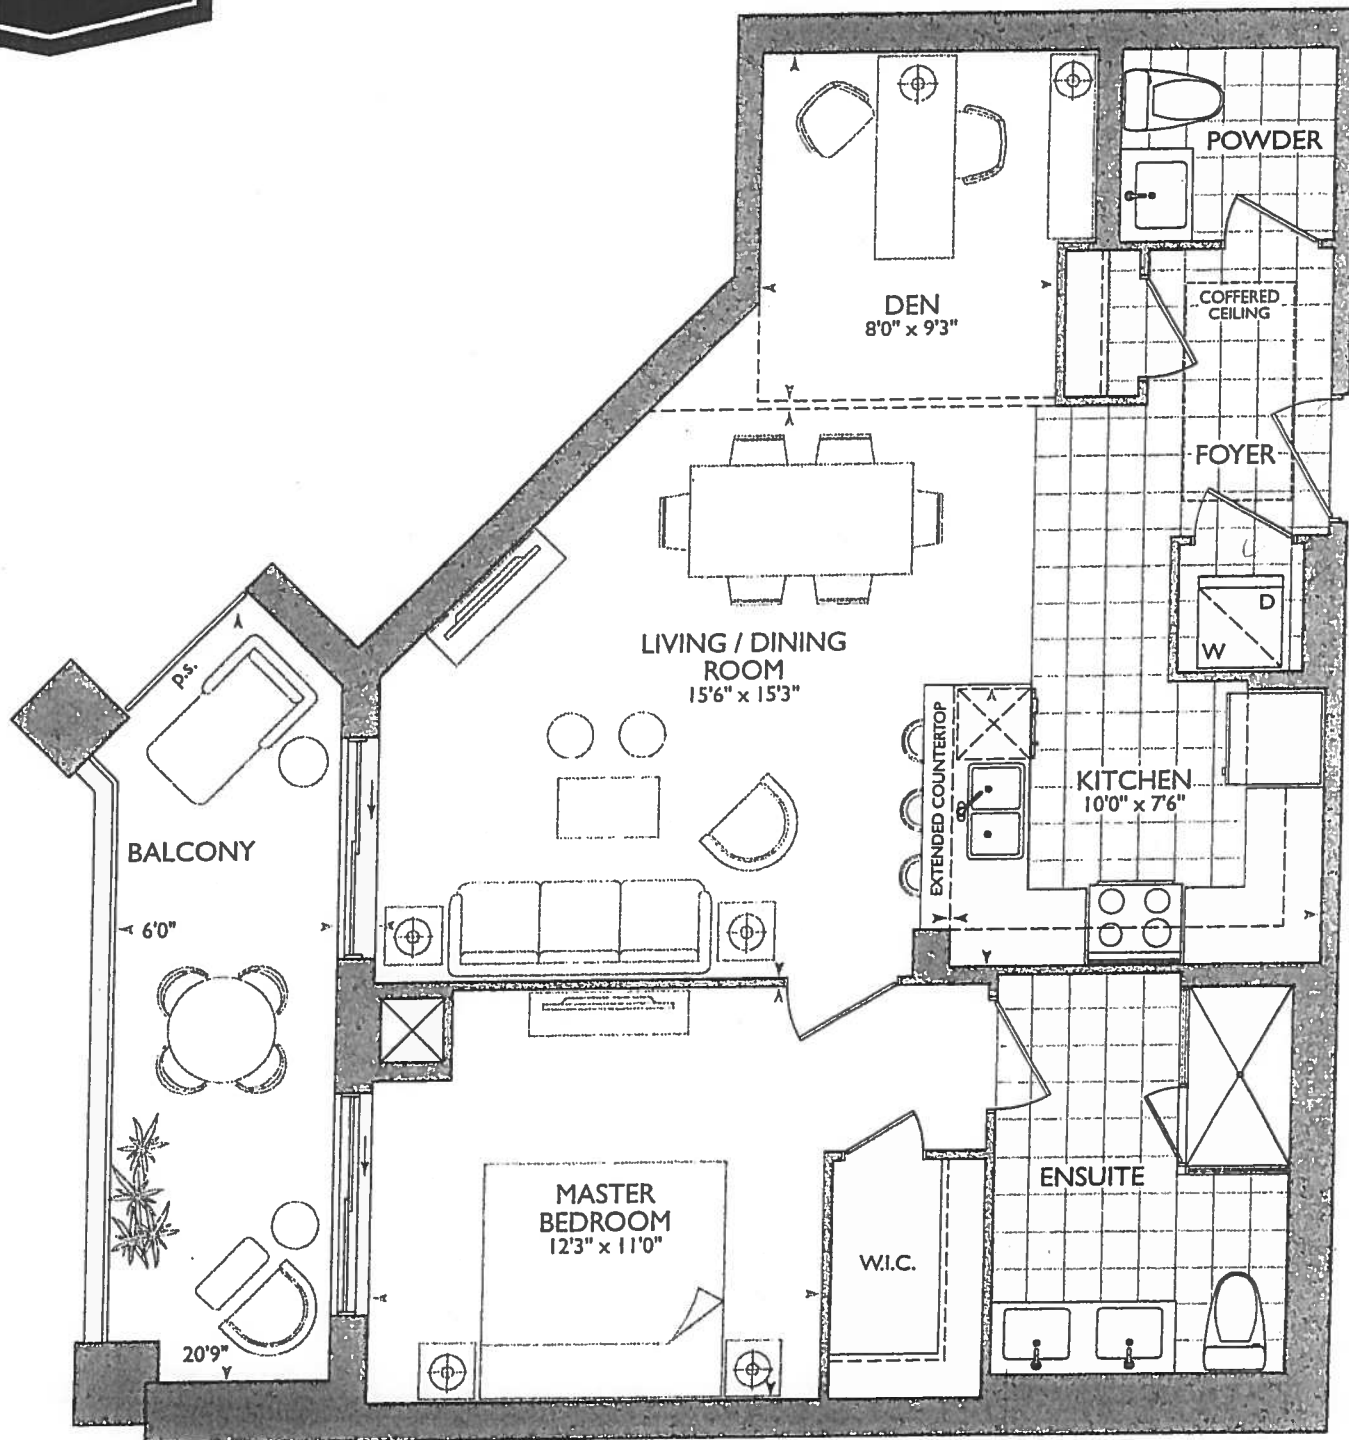

Suite 318
Inventory Suite

SUITE 318 - SAG HARBOUR

Royal Fine Homes • 25 Baker H^W Bld - Shornville, ON • Feb 14, 2018

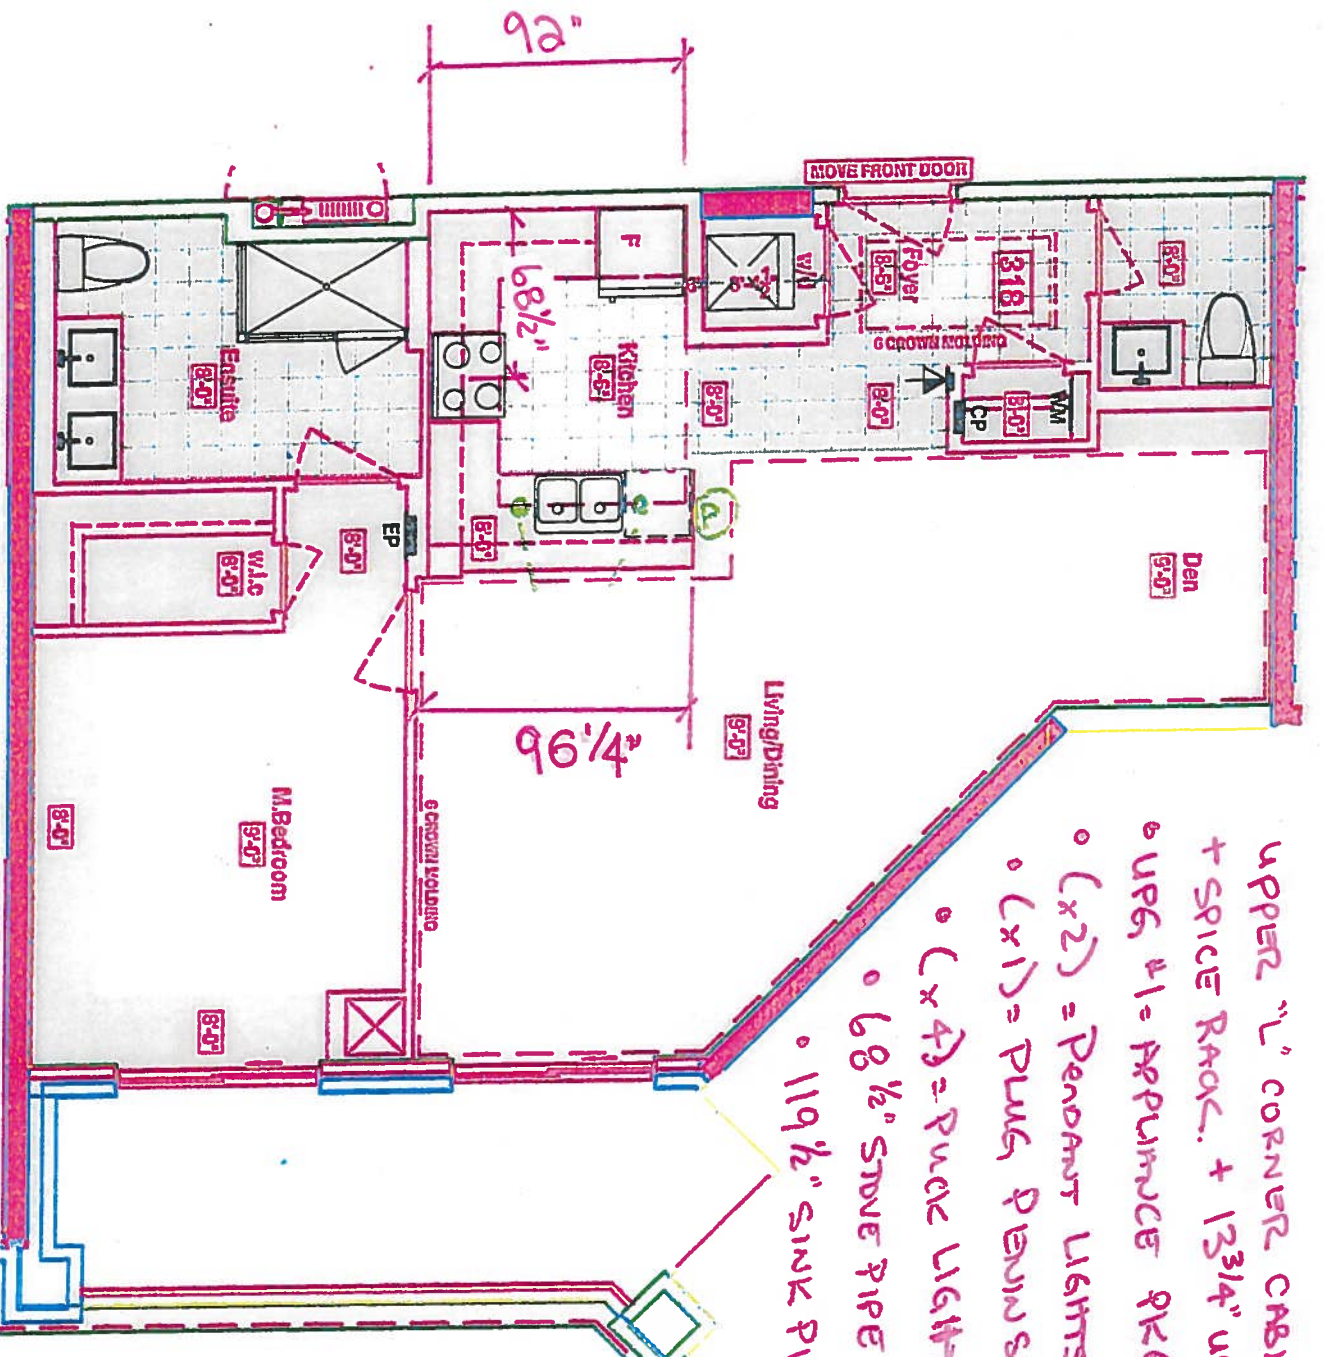

KITCHEN

UPPER "L" CORNER CABINET + BASE "L" CORNER CABINET
+ CORNER BACK + 13³/₄" UPG DEEP UPPEERS.

UP6 #1 - APPROXIMATE 9K5 IN 26" FIELD OF

- (x^2) = Pendant Lights

$$\langle x| = \langle \psi | U$$
$$\phi(x, A) = \text{Puck Lights}$$


• 60 1/2" stove pipe center

• 119 1/2" SINK PIPE CENTER

- * Powder Room + ENSUITE

36 1/4" VANITIES
23" SPLASH

* SEE CATK DESCRIPTION *
OF ALL UPGRADES
IN KITCHEN

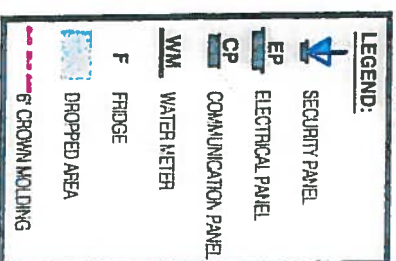

*VIEW ATK AREA
BREAKDOWN
FOR ALL
AREA'S



VINCE'S
SITE COPY

CONSTRUCTION SUMMARY

Braylea Investments Inc.

PURCHASER: INVENTORY SUITE_318_PH_1

TEL:

LOT NUMBER	PHASE	HOUSE TYPE	CLOSING DATE
318	1	SAG HARBOUR	07-Nov-19

Date Added: 30-Apr-19

Invoice Number: 7229

1 - KITCHEN- Install 1st Upgrade Appliance Package with 36" Fridge, as per Vendors Samples Note:
1 - KITCHEN- Install TWO (X2) Capped Ceiling Lights above the Kicthen sink on same switch, as per plan Note:
1 - KITCHEN- Install a Water Line For Fridge Note:

Date Added: 30-Apr-19

Invoice Number: 7228

1 - FOYER/KITCHEN- Delete the builders standard floor tile in teh Foyer and Kitchen Note:
1 - FOYER/ KITCHEN- Install the 71/2" TorleysForest Northern Cordillera Laminate flooring in the kitchen and Foyer, in lieu of the builders standard floor tile. Note:
1 - KITCHEN & BATHROOM- SEE QUALITY TOPS & KITCHENS FOR ALL KITCHEN & BATHROOMS UPGRADES/LAYOUTS (See attached Upgrade Package) Note:
1 - KITCHEN - Install ONE (X1) ADDITIONAL PUCK LIGHTS (Same Switch as Standard Puck Lights) at kitchen. To be installed below kitchen cabinetry, where applicable. (See Attached QTK Layout for Locations) Note: Purchaser Paying Difference for Additional Puck Lights - Standard Kitchen to Receive THREE (X3) Puck Lights - Upgrade Kitchen Requires FOUR (X4) Puck Lights
1 - KITCHEN - Install an Upgrade #1 Cabinet Package, throughout the kitchen - Install Category 3 QT4801 Stormy Monday Note:
1 - KITCHEN- Kitchen Counter top colour To Be Determined On Site With Connolly Marble Note:
1 - KITCHEN- Install an upgrade edge, throughout the kitchen, where applicable. Install Edge "I" Note:
1 - KITCHEN- Install the builders standard undermount sink in the kitchen- Install the BLANCO HORIZON Plus U2 (8") Undermount Sink- Model # 401234 Note:
1 - KITCHEN- Install the builders standard Faucet in the kitchen- Install the DELTA Chrome Pull-Out Kitchen Faucet (Single Hole) - Model # 469LF-Chrome Note:
1 - KITCHEN- **Kitchen Backsaplsh TO BE DETERMINED** Note:
34 - POWDER ROOM- Install the 24X24 DREAM WHITE upgarded floor tile in the Powder Room, in lieu of the builders standard floor tile. to be installed straight/stacked Note:
1 - POWDER ROOM- Instrall an upgraded cabinet in the Powder Room. Install Category 3 QT 4801Fibreboard Classic Grey Note:



SITE COPY

CONSTRUCTION SUMMARY

Braylea Investments Inc.

PURCHASER: INVENTORY SUITE_318_PH_1

TEL:

LOT NUMBER	PHASE	HOUSE TYPE	CLOSING DATE	
318	1	SAG HARBOUR	07-Nov-19	

Date Added: 30-Apr-19 Invoice Number: 7228

1 - POWDER ROOM- Powder Room Counter top colour To Be Determined On Site With Connolly Marble

Note:

1 - POWDER ROOM- Install an upgrade edge, throughout the kitchen, where applicable. Install Edge "I"

Note:

70 - MASTER ENSUITE- Install the 24X24 DREAM WHITE upgarded floor tile in the Master Ensuite in lieu of the builders standard floor tile. To be installed straight/stacked

Note:

70 - MASTER ENSUITE SHOWER STALL- Install the 12X24 DREAM WHITE upgarded floor tile in the Master Ensuite Shower Stall in lieu of the builders standard wall tile. To be installed straight/stackedand Horizontal

Note:

1 - MASTER ENSUITE- Instrall an upgraded cabinet in the Master Ensuite. Install Category 3 QT 1101 Fibreboard Classic Grey

Note:

1 - MASTER ENSUITE- Master Ensuite Counter top colour To Be Determined On Site With Connolly Marble

Note:

1 - MASTER ENSUITE- Install an upgrade edge, throughout the kitchen, where applicable. Install Edge "I"

Note:

16 - LAUNDRY ROOM- Install the 24X24 DREAM WHITE upgarded floor tile in the Laundry Room in lieu of the builders standard floor tile. to be installed straight/stacked

Note:

1 - CLARIFICATION-
MASTER ENSUITE / POWDER ROOM Install the builders standard Plumbing Fixtures throughout all bathrooms, where applicable. To Include the Master Ensuite & Powder Room

Note:

1 - CLARIFICATION:
MASTER ENSUITE & POWDER ROOM-Install RAISED VANITY HEIGHT at Powder Rm and Master Ensuite Vanities, where applicable (See attached QTK Upgrade paperwork and Layouts)

Note:

1 - CLARIFICATION-
MASTER ENSUITE / POWDER ROOM Install the Standard 3" Splash throughout all bathroom vanity counter tops, where applicable. To include the Powder Rm and the Master Ensuite

Note:

1 - CLARIFICATION-
Do not install or supply or credit the purchaser with the builders standard bathroom accessories, throughout ALL bathrooms. Includes: Toilet paper holder, soap dishes and towel racks

Note:

1 - KITCHEN/ POWDER ROOM/ MASTER ENSUITE- Stone slabs vary in size & all seams are visible & the fabricator reserves the right to position the seams as necessary.

Note:

Page 1 of 3Page 1 of 3

Vendor:



Purchaser		Decor Consultant	Model Type	Telephone Res. / Bus	Project	Closing Date	Unit
INVENTORY SUITE_318_PH_1		Laura Di Pede	SAG HARBOUR	/	Braylea Investments Inc.	07/11/2019	318

* INTERIOR COLOUR SCHEME *

Page 2 of 3

CABINETRY, VANITIES AND COUNTERTOPS

	Style	Countertop	Counter Edge	Handle / Knob
MAIN BATHROOM	N/A	N/A	N/A	N/A
MASTER ENSUITE	☒ CATEGORY 3 FIBERBOARD QT 1101 CLASSIC GREY (UPGD)	☒ **TBD**	☒ EDGE "1" (UPGD)	3487-128(Std)
POWDER ROOM	☒ CATEGORY 3 FIBERBOARD QT 4801 CLASSIC GREY (UPGD)	☒ **TBD**	☒ EDGE "1" (UPGD)	3487-128(Std)
KITCHEN / DINETTE	CATEGORY 3 FIBERBOARD QT 4801 STORMY MONDAY (UPGD)	☒ **TBD**	☒ EDGE "1" (UPGD)	3487-128(Std)
LAUNDRY ROOM				

APPLIANCE PACKAGE

APPLIANCE PACKAGE #1
-36" Fridge
Std 31in Opening

PLUMBING FIXTURES

KITCHEN	
Sink Model	☒ STANDARD
Sink Faucet	☒ STANDARD
TOILETS	
Master Ensuite	☒ STANDARD
Main Bathroom	N/A
Powder Room	☒ STANDARD
VANITY FAUCETS	
Master Ensuite	☒ STANDARD
Main Bathroom	N/A
Powder Room	☒ STANDARD
VANITY SINKS	
Master Ensuite	☒ STANDARD
Main Bathroom	N/A
Powder Room	☒ STANDARD
SHOWER STALL / TUBS	☒
Master Ensuite Shower Stall	STANDARD
Master Ensuite Tub	N/A
Main Bathroom Tub	N/A

Trim	Baseboard & Casing	Levers
	☒ STANDARD	☒ STANDARD
	☒ STANDARD	☒ STANDARD

Cornice Moulding / Medalion		Fireplace	
Foyer	☒ STANDARD CTR # 611	Fireplace	N/A
Living Room	☒ STANDARD CTR # 611	Location Flooring	N/A
Dining Room	☒ STANDARD CTR # 611	Style	N/A
Den	N/A	Finish	N/A
Master Bedroom	N/A	Marble	N/A
Bedroom 2	N/A	Hearth	N/A
Bedroom 3	N/A		

Paint Throughout	
Walls	☒ AF 5 FROSTINE
Trim	☒ WHITE

MISC. INSTALLATIONS

Ceramic Accessories (installed by Vendor)	☐ Yes ☒ No
Bathroom Mirrors (installed by Vendor)	☒ Yes ☐ No
Wire Shelving - Closet (installed by Vendor)	☒ Yes ☐ No

Page 2 of 3


Decor Consultant: _____ Purchaser: _____

Laura Di Pede

INVENTORY SUITE_318_PH_1

Vendor: _____

Braylea Investments Inc.

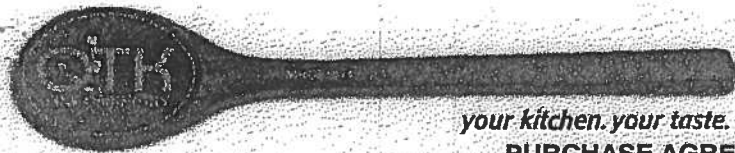

your kitchen. your taste.

PURCHASE AGREEMENT FORM

PURCHASER:		CONTRACTOR:	Braylea Investments Inc.
ADDRESS:		SITE:	HAMPTON PLACE
EMAIL:		MODEL TYPE:	SAG HARBOUR(1C+D)
PHONE #:		LOT #:	UNIT 318 HMP UPGRADE PKG 1
PHONE #:		DATE:	Apr 8, 2019 Q5197

The purchaser agrees to buy and Quality Tops & Kitchens Ltd. (QTK) agrees to sell and provide for the purchaser the following articles listed herein and with attached drawing in accordance to the terms and conditions described on the reverse of this agreement form.

ROOM	DESCRIPTION	CATEGORY
KITCHEN	DOOR STYLE: FINISH: SPECIES: DOOR HARDWARE: DRW HARDWARE: COUNTER TOP:	

ITEM #	QTY	DESCRIPTION	PRICE
VB	1	VALANCE BOX UPPERS & PUCK LIGHT CUTOUTS (ELEC. & LIGHTS NOT INCL.) - (OPTION PAID FOR BY BUILDER)	
FG2696	1	FRIDGE GABLE - 26" DEEP x 95-1/2"H - (OPTION PAID FOR BY BUILDER)	
FC2623	1	FRIDGE CABINET - 26" DEEP x 23"H - (OPTION PAID FOR BY BUILDER)	
BCR-MC1	1	MAGIC CORNER 1 PULL-OUT UNIT w/ 4 S.S. ANTI-SLIP BASKETS	
ULCC-14	1	UPPER L-SHAPE CORNER CABINET 26" x 26" - 13-3/4" DEEP	
UC-14WK	1	INCREASE DEPTH OF UPPER CABINET TO 13-3/4" DEEP (WHOLE KITCHEN) - 113 WHITE LP INTERIOR	
BLCC	1	BASE L-SHAPE CORNER CABINET w/ 1 ADJ. SHELF	
CUST-1	1	BLUM MOTION ANTI SLAM HINGES & 1 SET OF BLUM WHITE ANTARO DRAWER SLIDES	
CUST-2	1	PULL OUT SPICE UNIT w/ 2 FIXED BASKETS INCL. BLUM WHITE ANTARO ANTI SLAM SLIDES - 15" & 8" HIGH CLEARANCE	
ROOM SUMMARY:			

ROOM	DESCRIPTION	CATEGORY
POWDER ROOM VANITY	DOOR STYLE: FINISH: SPECIES: DOOR HARDWARE: DRW HARDWARE: COUNTER TOP:	

ITEM #	QTY	DESCRIPTION	PRICE
VB-RAISE8	1	RAISE VANITY HEIGHT TO 34-1/2" - PER VANITY (>61" LONG)	
CUST-1	1	BLUM MOTION ANTI SLAM HINGES	
ROOM SUMMARY:			

ROOM	DESCRIPTION	CATEGORY
ENSUITE VANITY	DOOR STYLE: FINISH: SPECIES: DOOR HARDWARE: DRW HARDWARE: COUNTER TOP:	

ITEM #	QTY	DESCRIPTION	PRICE
VB-RAISE8	1	RAISE VANITY HEIGHT TO 34-1/2" - PER VANITY (>61" LONG)	
CUST-1	1	BLUM MOTION ANTI SLAM HINGES & 1 SET OF BLUM MOTION WHITE ANTARO DRAWER SLIDES	
ROOM SUMMARY:			



your kitchen. your taste.

PURCHASE AGREEMENT FORM

Quality Tops & Kitchens Ltd.

80 Sante Drive, Vaughan, ON L4K 3C4

T 416.746.1811

F 905.761.5901

www.QTK.ca

info@qtk.ca

PURCHASER:		CONTRACTOR:	Braylea Investments Inc.
ADDRESS:		SITE:	HAMPTON PLAGE
EMAIL:		MODEL TYPE:	SAG HARBOUR(1C+D)
PHONE #:		LOT #:	UNIT 318 HMP UPGRADE PKG 1
PHONE #:		DATE:	Apr 8, 2019 Q5197



EXPECTED DELIVERY DATE	TBD	SUB-TOTAL:	
Customers please note all garbage bins, spice baskets, magic corner baskets and other accessories will only be delivered AFTER you move in the house. Please call us to request delivery of these items after you move in. Thank you. ALL CHANGES FINAL UPON SIGNING.		TOTAL:	
PLEASE READ ALL THE TERMS AND CONDITIONS ON THE ACCOMPANYING QTK TERMS & CONDITIONS DOCUMENT. BY SIGNING BELOW YOU AGREE TO RECEIVE THE ITEMS LISTED HEREIN AND PAY (ACCORDING TO QTK'S PAYMENT POLICY), AND HAVE READ AND UNDERSTOOD THE TERMS & CONDITIONS AS OUTLINED IN THE QTK TERMS & CONDITIONS DOCUMENT.		HST	
		GRAND TOTAL:	
DEPOSIT 1 DATE:		DEPOSIT 1:	
DEPOSIT 2 DATE:		DEPOSIT 2:	
BALANCE TO BE PAID IN FULL BY DUE DATE: CUSTOMER INITIAL(S):			

CUSTOMER SIGNATURE: _____

DATE: _____

CUSTOMER SIGNATURE: _____

DATE: _____

SALES REP NAME: Sheliza Khan Designs

QTK AUTHORIZED SIGNATURE: _____

(x1) - MAGIC BASE CORNER CABINET

(x1) - UPPER "L" SHAPE CORNER CABINET

(x1) - SPICE RACK

(x1) - BASE "L" CABINET STD.


• 13 3/4" UPG UPPER CABINETS

• (x4) = PUCK LIGHTS.

• (x2) = CAPPED PENDANTS

• (x1) = PLUG PENINSULA

* Powder Room + Ensuite
Raised Vanities
36 1/4" w 3" SPLASH

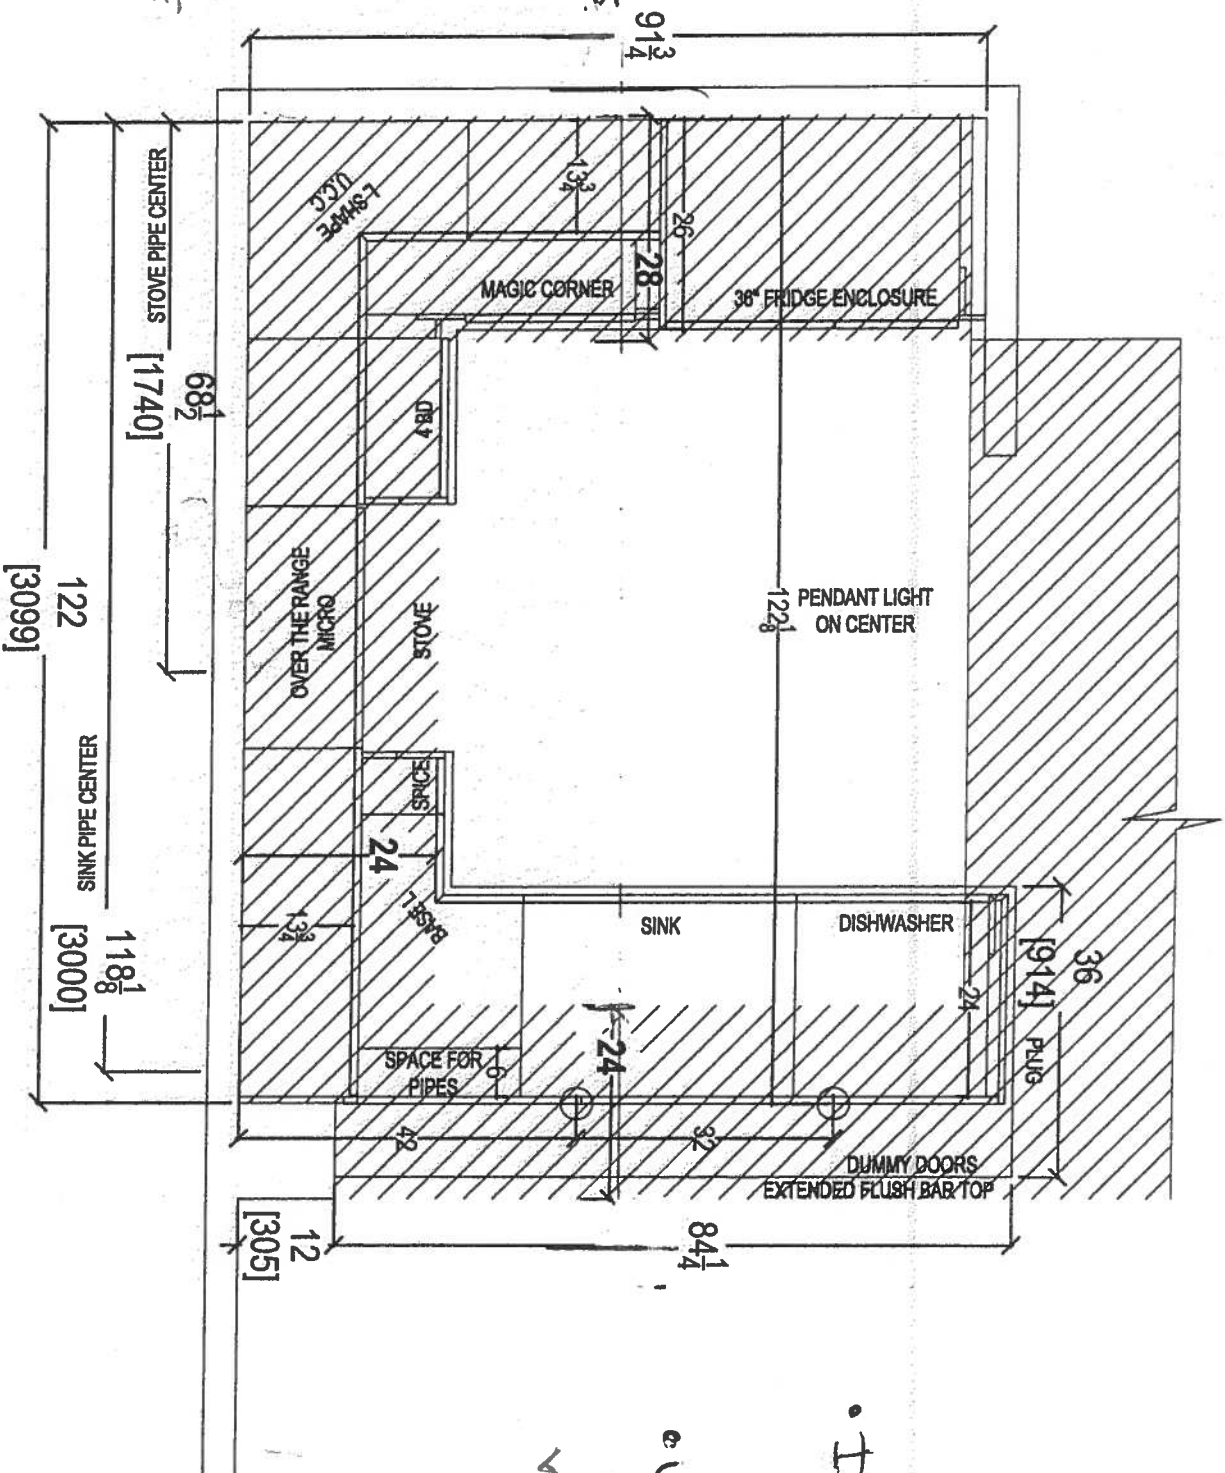

REVISED
APRIL 3 2019

318

• INVENTORY
Suite


• UPGR #1 =
APPROXIMATE PUCKS
w 36" FRIDGE

your kitchen, your taste.
80 SANTE DRIVE, VAUGHAN, ON L4K 3C4,
T: 416.746.1811 F: 905.761.5901





CLIENT: ROYAL PINE HOMES	JOB NAME: UNIT 318 HMP	ROOM: KITCHEN	DRAWN BY: SK
SITE: HAMPTON PLACE	DOOR STYLE: —	DOOR HANDLE: —	SCALE: 1/2" = 1' - 0"
PHONE: —	FINISH: —	DRW HANDLE: —	DATE: REVISED APRIL 3, 2018
EMAIL: —	SPECIES: —	TOP: —	PAGE: —

COMMENTS:
PLEASE NOTE ALL DIMENSIONS
ARE NOT FINAL AND ARE
SUBJECT TO CHANGE UPON
FINAL SITE MEASURE

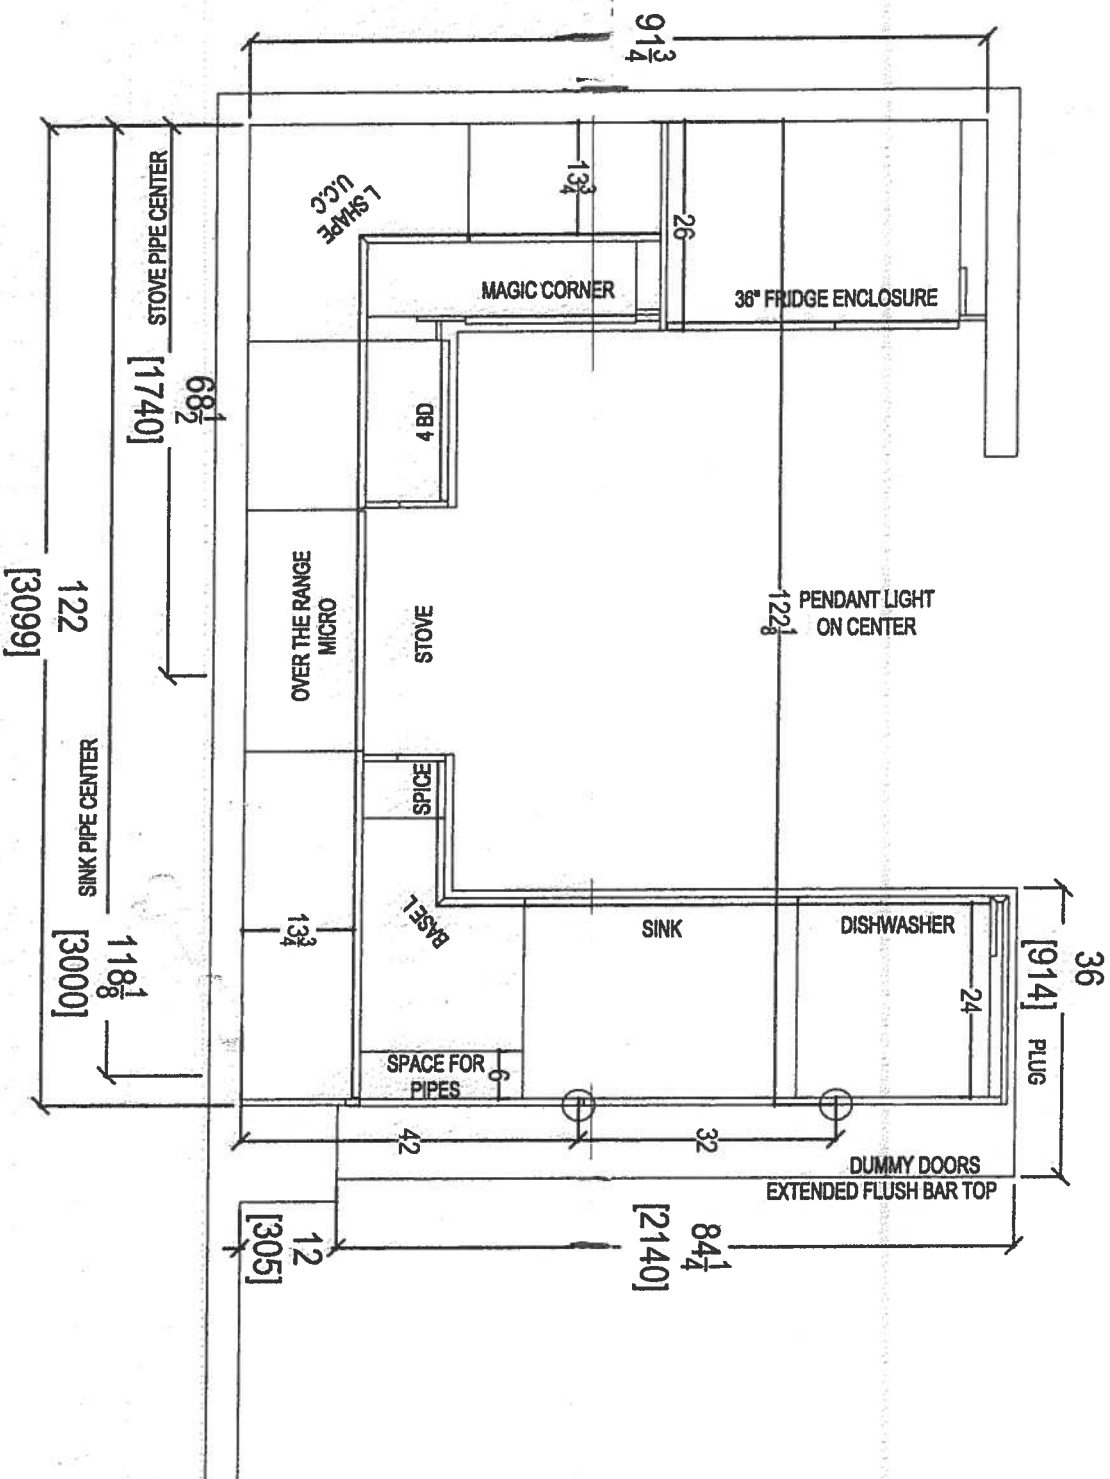


your kitchen, your taste.
80 SANTE DRIVE, VAUGHAN, ON L4K 3C4,
T: 416.748.1811 F: 905.761.5901


CLIENT: ROYAL PINE HOMES	JOB NAME: UNIT 318 HMP	ROOM: KITCHEN	DRAWN BY: SK	COMMENTS: PLEASE NOTE ALL DIMENSIONS ARE NOT FINAL AND ARE SUBJECT TO CHANGE UPON FINAL SITE MEASURE
SITE: HAMPTON PLACE	DOOR STYLE: —	DOOR HANDLE: —	SCALE: 1/2" = 1' - 0"	
PHONE: —	FINISH: —	DRW HANDLE: —	DATE: REVISED APRIL 3, 2019	
EMAIL: —	SPECIES: —	TOP: —	PAGE: —	

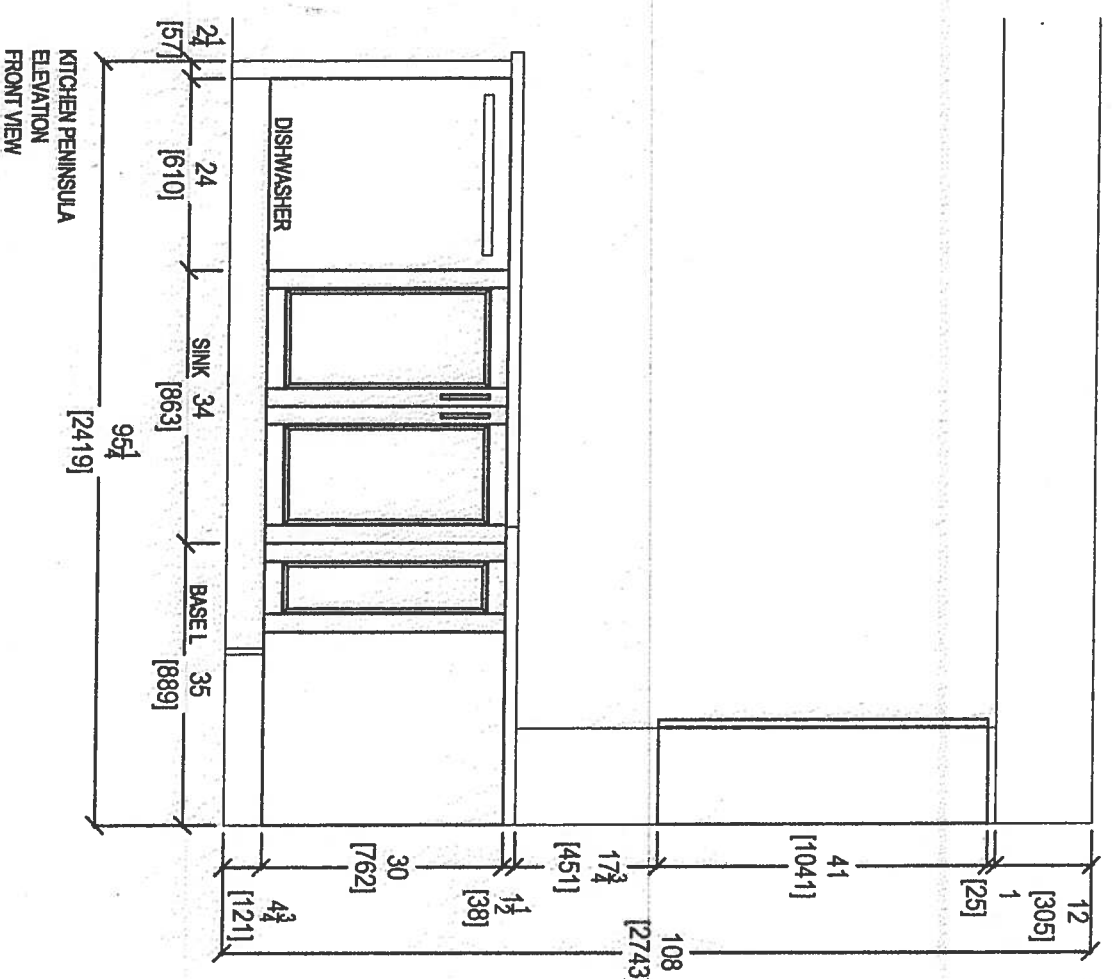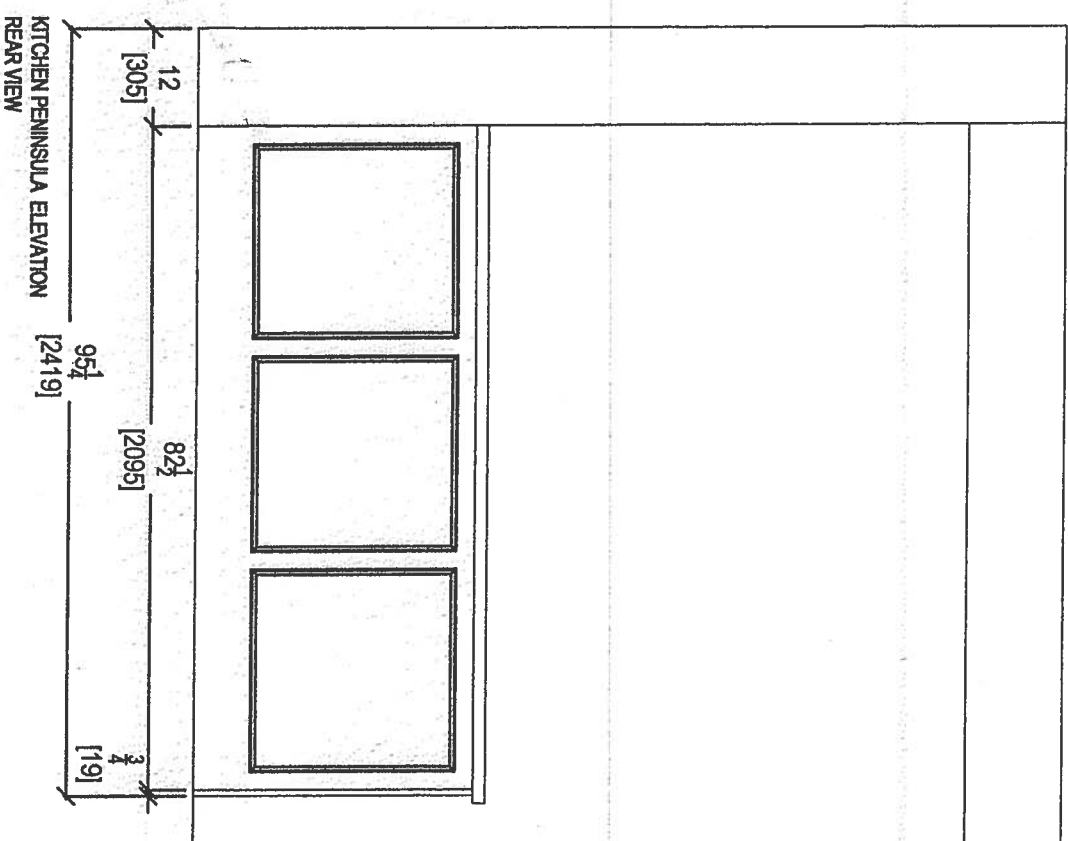


 <i>your kitchen, your taste.</i> 80 SANTE DRIVE, VAUGHAN, ON L4K 3C4, T: 416.746.1811 F: 905.761.5901					CLIENT: ROYAL PINE HOMES	JOB NAME: UNIT 318 HMP	ROOM: KITCHEN	DRAWN BY: SK	COMMENTS: PLEASE NOTE ALL DIMENSIONS ARE NOT FINAL AND ARE SUBJECT TO CHANGE UPON FINAL SITE MEASURE
SITE: HAMPTON PLACE		DOOR STYLE: —	DOOR HANDLE: —	SCALE: 1/2" = 1'-0"					
PHONE: —		FINISH: —	DRW HANDLE: —	DATE: REVISED APRIL 3, 2019					
EMAIL: —		SPECIES: —	TOP: —	PAGE: —					

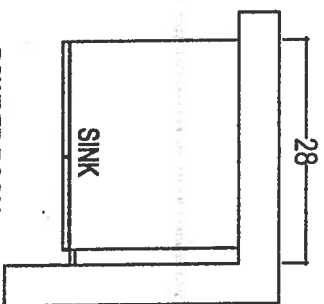

POWDER ROOM

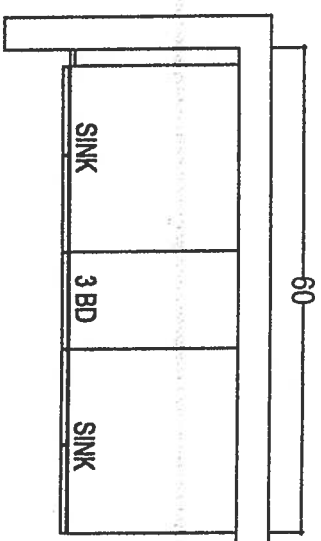

MASTER ENSUITE

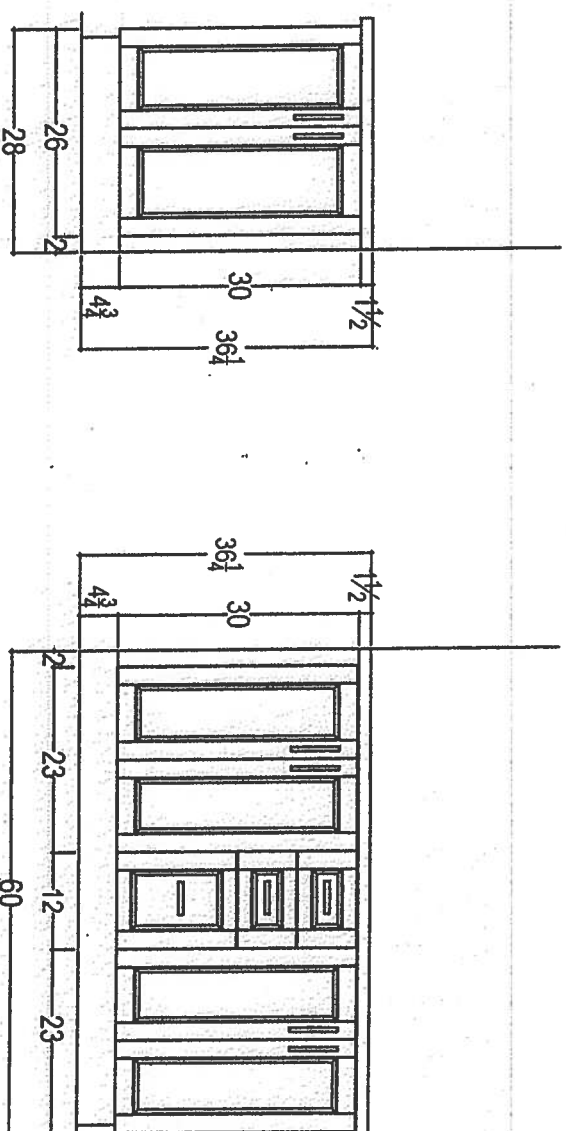

RAISED VANITIES w/ 3" SPLASH

your kitchen, your taste.
80 SANTE DRIVE, VAUGHAN, ON L4K 3C4,
T: 416.748.1811 F: 903.781.5601




CLIENT: ROYAL PINE HOMES	JOB NAME: UNIT 318 HMP	ROOM: VANITIES	DRAWN BY: SK
SITE: HAMPTON PLACE	DOOR STYLE: —	DOOR HANDLE: —	SCALE: 1/2" = 1'-0"
PHONE: —	FINISH: —	DRW HANDLE: —	DATE: REVISED APRIL 3, 2019
EMAIL: —	SPECIES: —	TOP: —	PAGE: —

COMMENTS:
PLEASE NOTE ALL DIMENSIONS
ARE NOT FINAL AND ARE
SUBJECT TO CHANGE UPON
FINAL SITE MEASURE

KRFC302ESS

22 cu.ft. 36-Inch Width Counter Depth French Door Refrigerator
with Interior Dispense

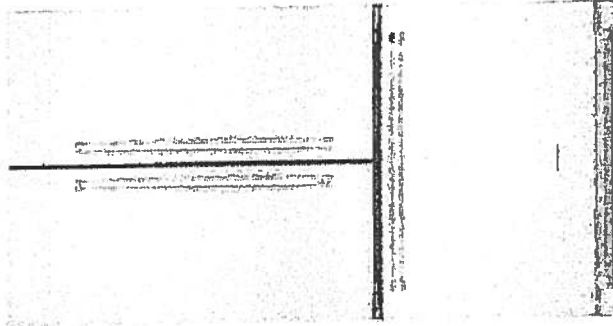

Whisper
AMERICA

KitchenAid®

<http://www.kitchenaid.com>

Product Dimensions:

Height: 72
Width: 35 3/4
Depth: 30 1/4

Electrical Requirements:

15 Amps.

Available In:

☐ Stainless Steel
☒ Black
☐ White

KRFC302ESS

Key Features:

- ExtendFresh™ Temperature Management System
- Interior Water Dispenser™
- Professionally-Inspired Design
- Produce Preserver
- Humidity-Controlled Crispers
- FreshChill™ Temperature-Controlled Full-Width Pantry
- Pull-Out Tri-Level Freezer Drawer
- SatinGlide® System
- LED Lighting
- Star-K Certified
- Automatic Ice Maker
- Max Cool

* Suite 318 *

Upgrade
Package 2 FRIDGE ONLY

* UPG #1- PKG.

W 36" FRIDGE


* Suite 318 *
Upgrade
Package!

WEE745H0FS

Whirlpool®

6.4 Cu. Ft. Slide-In Electric Range with True
Convection

<http://www.whirlpool.com>

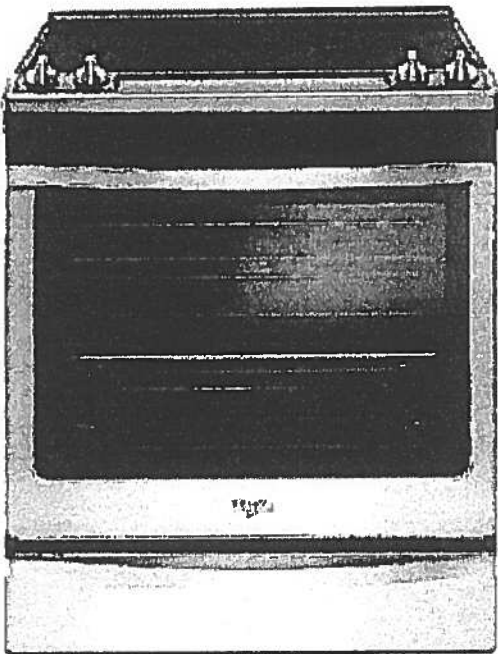

Key Features:

- Frozen Bake™ Technology
- True Convection Cooking
- FlexHeat™ Triple Radiant Element
- Convection Conversion
- AquaLift® Self-Cleaning Technology
- Temperature Sensor
- Rapid Preheat
- 6.4 Cu. Ft. Capacity
- Easy-Wipe Ceramic Glass Cooktop
- Large Oven Window
- Max Capacity Rack
- Hidden Bake Element

Product Dimensions:

Height: 36

Width: 29 7/8

Additional Information:

[Use And Care Guide](#)

[Dimension Guide](#)

[Installation Guide](#)

[Warranty Certificate](#)

INVESTED
IN
AMERICA



©Registered trademark/TM Trademark of Whirlpool, U.S.A. © 2016 Whirlpool Corporation. All Rights Reserved.
All other trademarks are owned by their respective companies.
Because Whirlpool Corporation policy includes a continuous commitment to improve our products, we reserve
the right to change materials and specifications without notice. We also reserve the right to discontinue or
transition products without notice.
Manufacturer's Suggested Retail Price (MSRP) and Minimum Advertised Price (MAP) provided for reference
purposes only. Dealer alone determines advertised and retail prices.
Created On: Friday, January 27, 2017 10:46:47

* Suite 318 *

part of
the family



FREE LOCAL DELIVERY

On all Orders Over \$498



60 DAY PRICE GUARANTEE

Means you Always Get the Best Price




LOCAL SHOWROOMS

With a Dedicated Service Team

APPLIANCES / KITCHEN / MICROWAVES

Whirlpool Stainless Steel Over-the-Range Convection Microwave (1.9 Cu. Ft.) - YWMHA9019HZ

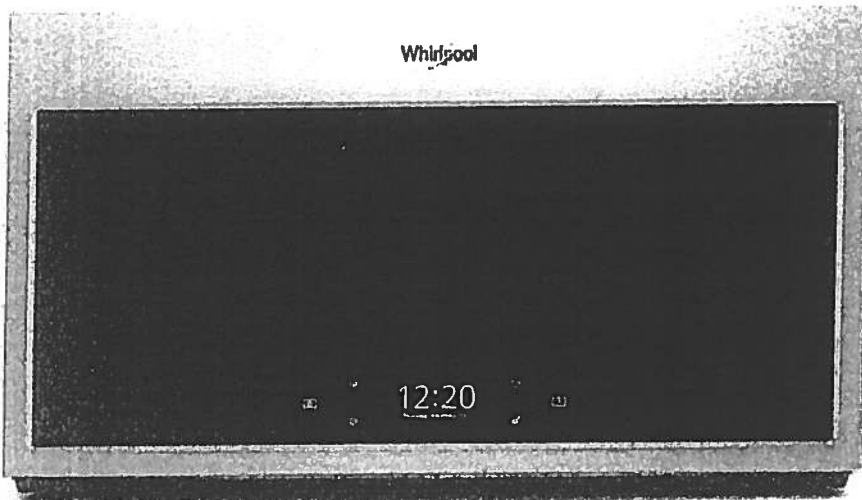

SKU: 13290594

Print This Page Share This

Hover/Touch to Zoom



Click to change image.

Whirlpool®

* Suite 318 *

Upgrade
Package 1

WDTA50SAHZ

Contemporary Design. Stainless Steel Tub
Dishwasher with TotalCoverage Spray Arm

Whirlpool®

<http://www.whirlpool.com>

Key Features:

- Sensor Cycle
- TotalCoverage Spray Arm
- 1-Hour Wash Cycle
- Tap Touch Controls

Product Dimensions:

Height: 34 1/2

Width: 23 7/8

Depth: 24 1/2

Additional Information:


[Use And Care](#)

[Dimension Guide](#)

[Installation Guide](#)

[Energy Guide](#)

[Warranty](#)

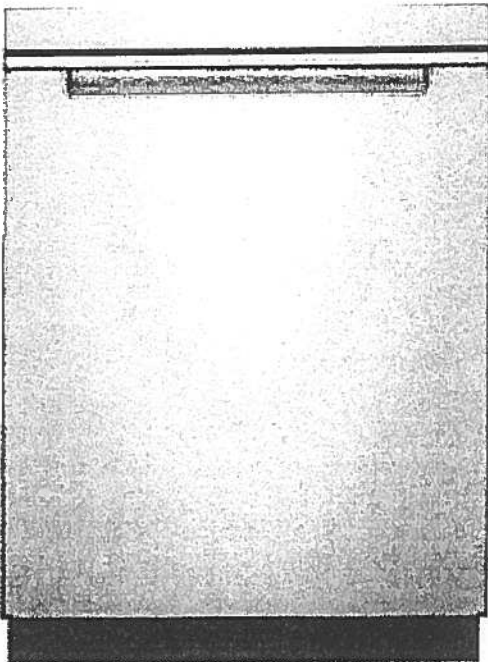

Available in:



Black

Fingerprint Resistant Sunset Bronze

Fingerprint Resistant Black Stainless



White

Fingerprint Resistant Stainless Steel

INVESTED
IN
AMERICA



©Registered trademark/TM Trademark of Whirlpool, U.S.A. © 2016 Whirlpool Corporation. All Rights Reserved. All other trademarks are owned by their respective companies.

Because Whirlpool Corporation policy includes a continuous commitment to improve our products, we reserve the right to change materials and specifications without notice. We also reserve the right to discontinue or transition products without notice.

Manufacturer's Suggested Retail Price (MSRP) and Minimum Advertised Price (MAP) provided for reference purposes only. Dealer alone determines advertised and retail prices.

Upgrade
Package!


* Suite 318 *

WFW75HEFW

4.5 cu. ft. Front Load Washer with Precision
Dispense



<http://www.whirlpool.com>

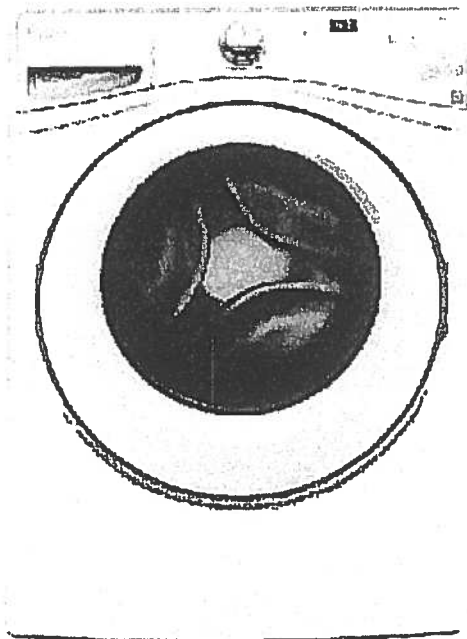

Key Features:

- Precision Dispense
- Adaptive Wash Technology
- Smooth Wave Stainless Steel Wash Basket
- 4.5 cu. ft. Capacity
- ENERGY STAR® Qualified

Product Dimensions:

Height: 39 3/4

Width: 27

Depth: 33 5/16

Electrical Requirements:

15 or 20. 120 V.

Additional Information:

[Use And Care Guide](#)

[Dimension Guide](#)

[Installation Guide](#)

[Energy Guide](#)

[Warranty Certificate](#)

INVESTED
IN
AMERICA



©Registered trademark/TM Trademark of Whirlpool, U.S.A. © 2013 Whirlpool Corporation. All Rights Reserved.
All other trademarks are owned by their respective companies.
Because Whirlpool Corporation policy includes a continuous commitment to improve our products, we reserve
the right to change materials and specifications without notice. We also reserve the right to discontinue or
transition products without notice.
Manufacturer's Suggested Retail Price (MSRP) and Minimum Advertised Price (MAP) provided for reference
purposes only. Dealer alone determines advertised and retail prices.
Created On: Wednesday, March 23, 2016 11:51:03

Upgrade Package 1

YWED75HEFW


*Suite 318 *

Whirlpool®

8.5 cu. ft. Duet® High Efficiency Front Load Electric
Dryer with ENERGY STAR®

<http://www.whirlpool.com>

MSRP: \$0.00

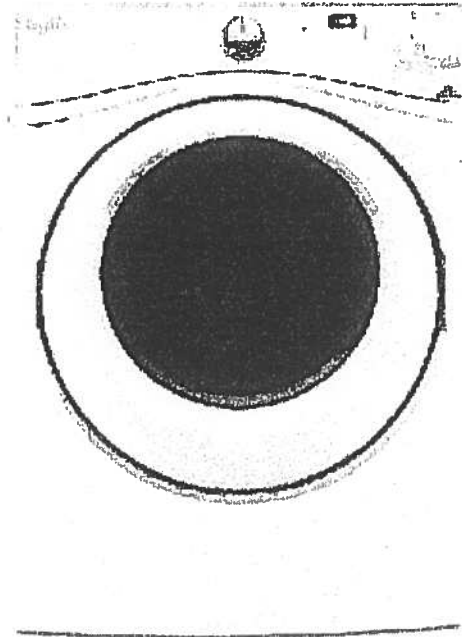

Key Features:

- Advanced Moisture Sensing System
- Quad Baffles
- Tap Touch Controls with Memory
- EcoBoost™ Option
- Wrinkle Shield™ Plus Option
- Undercounter Installation
- 7.4 Cu. Ft. Capacity
- ENERGY STAR® Qualified

Product Dimensions:

Height: 39

Width: 27

Depth: 31

Additional Information:

[Use And Care](#)

[Installation Guide](#)

[Warranty](#)

Available in:

 White

INVESTED
IN
AMERICA



®Registered trademark/TM Trademark of Whirlpool, U.S.A. © 2016 Whirlpool Corporation. All Rights Reserved. All other trademarks are owned by their respective companies.

Because Whirlpool Corporation policy includes a continuous commitment to improve our products, we reserve the right to change materials and specifications without notice. We also reserve the right to discontinue or transition products without notice.

Manufacturer's Suggested Retail Price (MSRP) and Minimum Advertised Price (MAP) provided for reference purposes only. Dealer alone determines advertised and retail prices.



Countertop Edges

* Suite 318 *

CONNOLLY Marble & Granite Ltd.


EDGE
DETAILS

004

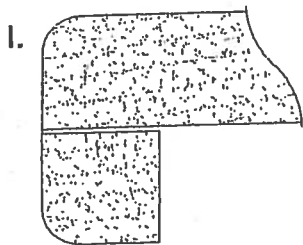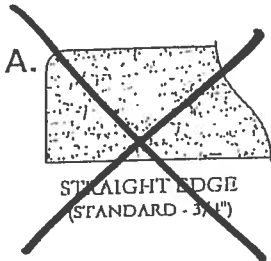

DOUBLE TOP "D" EDGE
(STANDARD - 1 1/2")

- * Kitchen
- * Master Ensuite
- * Powder Room

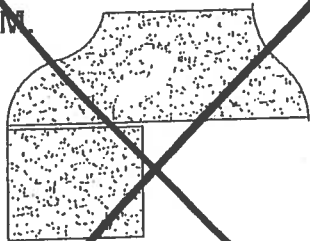

OGE - SQUARE EDGE
(MED./HIGH - 1 1/2")

EDGING UP-GRADE OPTIONS