








Sag Harbor

878 SQ FT *plus 119 sq. ft. of balcony area*

ORIGINAL Suite

Suite #418

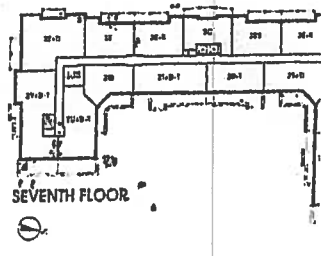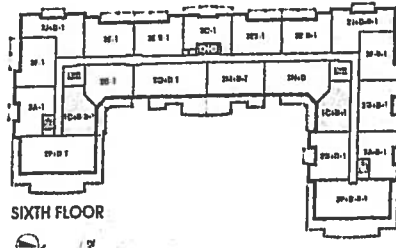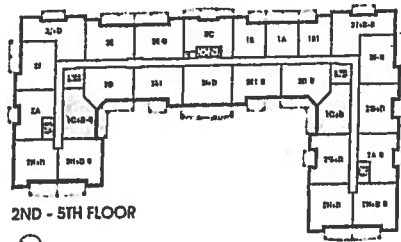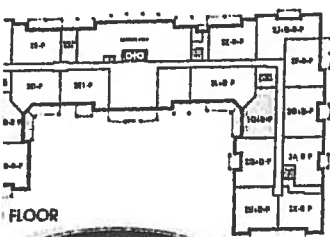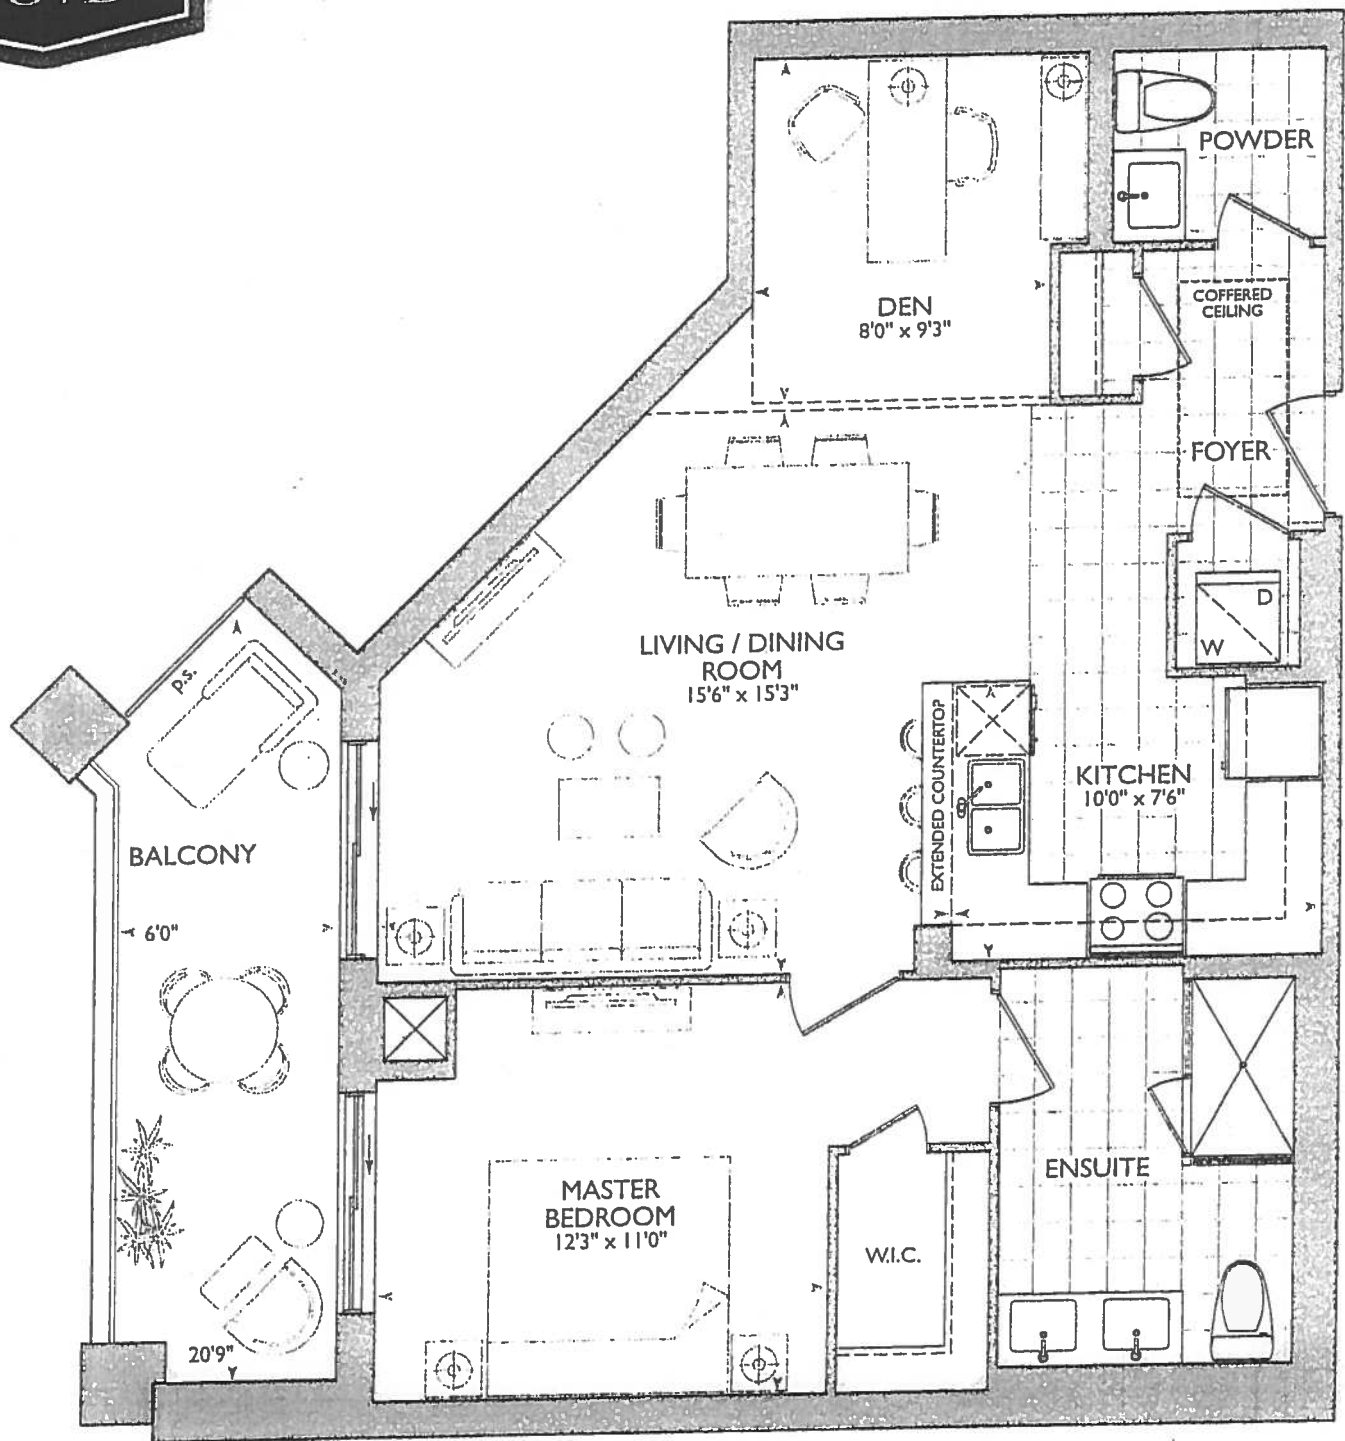


Suite 418

May 30, 2019



- Install Laminated Flooring Throughout Foyer + Kitchen
- Delete Standard Bathroom Accessories throughout Powder Room and Master Ensuite

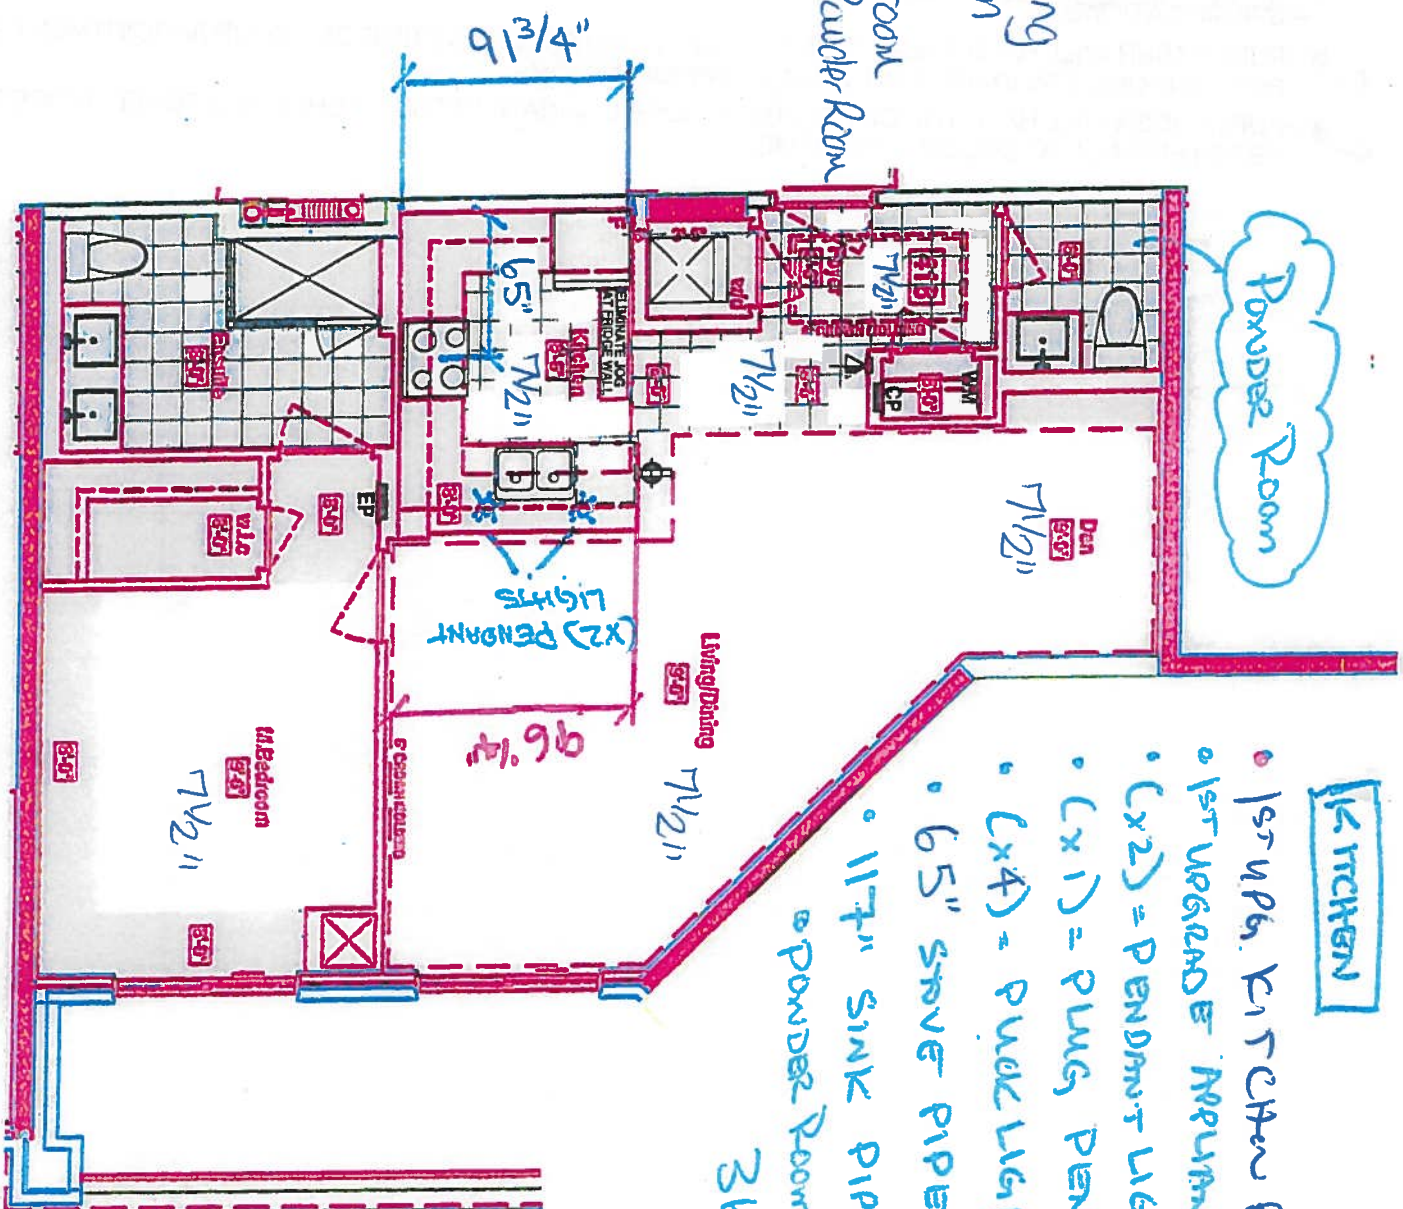

KITCHEN

- 1st UPG. KITCHEN PKG.
- 1st UPGRADE APPLIANCES PKG. w/ 36" FRIDGE
- (x2) = PENDANT LIGHTS
- (x1) = PLUG PENDANT LIGHT
- (x4) = PLUG LIGHTS
- 6.5" stove PIPE CENTER
- 11.7" SINK PIPE CENTER
- Powder Room @ ENSUITE Raised VANITIES
- 36 1/4" x 3" SPLASH

LEGEND:	
	SECURITY PANEL
	ELECTRICAL PANEL
	COMMUNICATION PANEL
	WATER METER
	FRIDGE
	DROPPED AREA
	CROWN MOLDING



VINCE'S
SITE COPY

CONSTRUCTION SUMMARY

Braylea Investments Inc.

PURCHASERS: LINDSAY KATHRYN HAMILTON and ALANA HAMILTON

TEL: RES.: 905-591-2572 BUS.: 647-987-0997

LOT NUMBER	PHASE	HOUSE TYPE	CLOSING DATE
418	1	SAG HARBOUR	08-Nov-19

Date Added: 30-May-19

Invoice Number: 7250

1 - FOYER & KITCHEN - Install Standard Laminate Flooring in lieu of standard porcelain tiles. To be installed throughout Foyer and Kitchen, where applicable (See Sketch)
Note: No Charge - As per Fonzie C.

1 - KITCHEN & BATHROOMS - SEE QUALITY TOPS & KITCHENS FOR ALL KITCHEN & BATHROOM UPGRADES / LAYOUTS. (See Attached QTK Paperwork)
Note:

1 - KITCHEN - Install Standard Granite Countertop - BIANCO ANTICO - To be installed throughout kitchen, where applicable. (does not include granite backsplash) (See Sketch)
Note:

1 - KITCHEN - Install Upgrade Countertop Edging - UPGRADE " I ' EDGE - To be installed throughout kitchen countertop, where applicable. (See Sketch)
Note:

1 - DISCLAIMER - GRANITE COUNTERTOP;
KITCHEN - Due to the many variables that can affect the pattern, colour and/or design and "pitting" of natural products, granite installed will not be identical to the samples displayed.
Note: Every effort is made to provide granite countertops as close as possible but the vendor is not responsible for results which differ from the sample displayed. All countertop surfaces may have seams, and product pattern and shade can change in areas containing seams.

1 - DISCLAIMER - STONE COUNTERTOP;
KITCHEN - Stone slabs vary in size & all seams are visible & the fabricator reserves the right to position the seams as necessary.
Note:

1 - KITCHEN - Kitchen Sink - Install Standard Undermount Sink - BLANCO Horizon Plus U2 Undermount Sink - Model # 401234
Note:

1 - KITCHEN - Kitchen Faucet - Install Standard Faucet - DELTA Chrome Pull-Out Kitchen Faucet (Single Hole) - Model # 469-LF - Chrome
Note:

1 - POWDER ROOM & MASTER ENSUITE - Install Standard Stone Countertop - ASPEN TERRA WHITE - To be installed throughout Powder Room and Master Ensuite Vanities, where applicable. (Includes 3" Splash) (See Sketch)
Note:

1 - DISCLAIMER - STONE COUNTERTOP;
POWDER ROOM & MASTER ENSUITE - Stone slabs vary in size & all seams are visible & the fabricator reserves the right to position the seams as necessary.
Note:

1 - CLARIFICATION;
POWDER ROOM & MASTER ENSUITE - Install Builders Standard Plumbing Fixtures throughout Powder Room and Master Ensuite, where applicable. (See Sketch)
Note:

1 - CLARIFICATION;
MASTER ENSUITE - Purchaser accepts & acknowledges the standard frameless glass at master ensuite shower stall will NOT touch the ceiling and will receive a Standard Chrome Header. (See Sketch)
Note:

1 - CLARIFICATION;
POWDER ROOM & MASTER ENSUITE - DELETE Do Not Install / Supply / Credit Purchaser for builders standard ceramic bathroom accessories (toilet paper, towel bar & soap dish) throughout all bathrooms where applicable.
Note: To Include; Powder Room & Master Ensuite (See Sketch)

1 - BONUS PACKAGE - PURCHASER HAS APPLIED \$5,000.00 (Includes Applicable Taxes) UPGRADE PROMOTIONAL PACKAGE HAS BEEN APPLIED TOWARDS THE PURCHASE OF UPGRADES COMPLETED AT THE DECOR CENTRE.
Note:



SITE COPY

CONSTRUCTION SUMMARY

Braylea Investments Inc.

PURCHASERS: LINDSAY KATHRYN HAMILTON and ALANA HAMILTON		TEL: RES.: 905-591-2572 BUS.: 647-987-0997	
---	--	--	--

LOT NUMBER 418	PHASE 1	HOUSE TYPE SAG HARBOUR	CLOSING DATE 08-Nov-19
-------------------	------------	---------------------------	---------------------------

Date Added: 30-May-19

Invoice Number: 7250

1 - PURCHASER HAS ATTENDED A COLOR APPOINTMENT AT THE DECOR CENTRE AND HAS DECLINED ANY ADDITIONAL UPGRADES. Purchaser accepts and acknowledges that there will be no further changes/additions/deletions to be made upon signing on May 30,2019 Note:
1 - PURCHASER AWARE AND ACCEPTS THAT ANY CHANGES MADE TO UPGRADES AFTER SIGNING THIS PURCHASERS EXTRA FORM ARE SUBJECT TO A MINIMUM ADMINISTRATION FEE OF \$1,000 PLUS A 10% HOLDBACK FEE. Note:

Date Added: 06-May-19

Invoice Number: 7240

1 - KITCHEN & BATHROOM- SEE QUALITY TOPS & KITCHENS FOR ALL KITCHEN & BATHROOMS UPGRADES/LAYOUTS (See attached Upgrade Package) Note: **PLEASE NOTE** THAT THE PURCHASER WILL HAVE AN OPTION FOR THE ABOVE UPGRADE PACKAGE
1 - KITCHEN - Install ONE (X1) ADDITIONAL PUCK LIGHTS (Same Switch as Standard Puck Lights) at kitchen. To be installed below kitchen cabinetry, where applicable. (See Attached QTK Layout for Locations) Note: Purchaser Paying Difference for Additional Puck Lights - Standard Kitchen to Receive THREE (X3) Puck Lights - Upgrade Kitchen Requires FOUR (X4) Puck Lights
34 - POWDER ROOM- Install an upgraded floor tile 24X24 CALACATTA POLISH, in lieu of the builders standard floor tile, throughout the Powder Room, where applicable Note:
16 - LAUNDRY ROOM- Install an upgraded floor tile 20X20 PULPIS GRIS in for the Laundry Room Floor, in lieu of the builders standard 8x8 floor tile, throughout the Laundry Room, where applicable Note:
70 - MASTER ENSUITE- Install an upgraded floor tile 24X24 CALACATTA POLISH, in lieu of the builders standard 13x13 floor tile, throughout the Master Ensuite, where applicable Note:
70 - MASTER ENSUITE- Install an upgraded floor tile 12x24 CALACATTA POLISH, in lieu of the builders standard 8x10 wall tile, throughout the Master Ensuite shower stall wall, where applicable Note:
1 - CLARIFICATION: MASTER ENSUITE & MAIN BATH-Install RAISED VANITY HEIGHT at Main Bath and Master Ensuite Vanities, where applicable (See attached QTK Upgrade paperwork and Layouts) Note: **PLEASE NOTE** THAT THE PURCHASER WILL HAVE AN OPTION FOR THE ABOVE UPGRADE PACKAGE
1 - CLARIFICATION- Do not install or supply or credit the purchaser with the builders standard bathroom accessories, throughout ALL bathrooms. Includes: Toilet paper holder, soap dishes and towel racks Note:
1 - KITCHEN & BATHROOM COUNTER TOP- **PLEASE NOTE** Purchaser to have the option to choose their selection at time of colour chart Note:

Date Added: 06-May-19

Invoice Number: 7216

1 - TWO (2) CAPPED CEILING LIGHTS ABOVE THE KITCHEN SINK ON THE SAME SWITCH, AS PER PLAN Note:
1 - 1ST UPGRADE APPLIANCE PACKAGE WITH 36 IN FRIDGE AS PER VENDORS SAMPLES Note:



SITE COPY

CONSTRUCTION SUMMARY

Braylea Investments Inc.

PURCHASERS: LINDSAY KATHRYN HAMILTON and ALANA HAMILTON

TEL: RES.: 905-591-2572 BUS.: 647-987-0997

LOT NUMBER	PHASE	HOUSE TYPE	CLOSING DATE	
418	1	SAG HARBOUR	08-Nov-19	

Date Added: 06-May-19

Invoice Number: 7216

1 - WATER LINE FOR FRIDGE

Note:

This Document is Extremely Time Sensitive - Printed 30 May 19 at 17:09



Revised: May 30, 2019

* INTERIOR COLOUR SCHEME *

Purchasers		Decor Consultant	Model Type	Telephone Res. / Bus	Project	Closing Date	Unit
LINDSAY KATHRYN HAMILTON & ALANA HAMILTON		Laura Di Pede	SAG HARBOUR	(905) 591-2572 / (647) 987-0997	Braylea Investments Inc.	08/11/2019	418

Page 1 of 3

	Flooring		Wall Tile		Accent/Insert	Pattern
	Description		Main			
✓ MASTER ENSUITE	24X24 CALACATTA POLISH(UPGS)	✓	12X24 Calacatta Polish (Upgd)(Horizontal)	N/A		N/A
MAIN BATHROOM	N/A		N/A	N/A		N/A
POWDER ROOM	24X24 CALACATTA POLISH(UPGS)	✓	N/A	N/A		N/A
✓ KITCHEN / DINETTE	7 1/2" TorleysForest - Okanogan 9742P (UPG)	✓	12x12 TwilightMocha GlassMosaics (STD)			
✓ FOYER	7 1/2" TorleysForest - Okanogan 9742P (UPG)	✓				
✓ LAUNDRY	20X20 PULPIS GRIS (UPGD)	✓				
LIVING ROOM	7 1/2" TorleysForest - Okanogan 9742P (STD)	✓				
DINING ROOM	7 1/2" TorleysForest - Okanogan 9742P (STD)	✓				
DEN	7 1/2" TorleysForest - Okanogan 9742P (STD)	✓				
MASTER BEDROOM	7 1/2" TorleysForest - Okanogan 9742P (STD)	✓				
BEDROOM 2	N/A					
BEDROOM 3	N/A					
Basement Landing						

Notes

Page 1 of 3

Consultant:  Laura Di Pede

Purchaser:  LINDSAY KATHRYN HAMILTON

Purchaser:  ALANA HAMILTON

Vendor:  Vendor:
Braylea Investments Inc.

Purchasers LINDSAY KATHRYN HAMILTON & ALANA HAMILTON		Decor Consultant Laura Di Pede	Model Type SAG HARBOUR	Telephone Res. / Bus (905) 591-2572 / (647) 987-0997	Project Braylea Investments Inc.	Closing Date 08/11/2019	Unit 418
---	--	-----------------------------------	---------------------------	---	-------------------------------------	----------------------------	-------------

Page 2 of 3

CABINETRY, VANITIES AND COUNTERTOPS

	Style	Countertop	Counter Edge	Handle / Knob
MAIN BATHROOM	N/A	N/A	N/A	N/A
MASTER ENSUITE	CATEGORY 2 - MAPLE - PISTACHIO QT 2503 (STD)	✓	ASPEN TERRA WHITE (STD)	✓
POWDER ROOM	CATEGORY 2 - MAPLE - PISTACHIO QT 2503 (STD)	✓	ASPEN TERRA WHITE (STD)	✓
KITCHEN / DINETTE	CATEGORY 1 - FIBERBOARD - WHITE QT 1203 (STD)	✓	BIANCO ANTICO GRANITE (STD)	✓
LAUNDRY ROOM	NA/	NA/	N/A	N/A

✓ APPLIANCE PACKAGE
Upgrade Package
\$1 with
36" Fridge
(See Attached Specs)
Std 31in Opening

PLUMBING FIXTURES


KITCHEN	Sink Model	✓ STANDARD
	Sink Faucet	✓ STANDARD
TOILETS	Master Ensuite	✓ STANDARD
	Main Bathroom	N/A
	Powder Room	✓ STANDARD
VANITY FAUCETS	Master Ensuite	✓ STANDARD
	Main Bathroom	N/A
	Powder Room	✓ STANDARD
VANITY SINKS	Master Ensuite	✓ STANDARD
	Main Bathroom	N/A
	Powder Room	✓ STANDARD
SHOWER STALL / TUBS	Master Ensuite Shower Stall	✓ STANDARD
	Master Ensuite Tub	N/A
	Main Bathroom Tub	N/A


Trim	Baseboard & Casing	STANDARD
	Interior Doors	STANDARD
	Levers	STANDARD
	Door Height	STANDARD

Cornice Moulding / Medallion	Fireplace	N/A
Foyer	Location Flooring	N/A
Living Room	Style	N/A
Dining Room	Finish	N/A
Den	Marble	N/A
Master Bedroom	Hearth	N/A
Bedroom 2		
Bedroom 3		

Paint Throughout	Trim
Walls	STANDARD - BIRCH WHITE
	STANDARD

Page 2 of 3

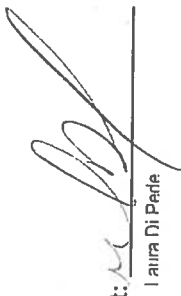Decor Consultant:  Laura Di Pede
Purchaser:  LINDSAY KATHRYN HAMILTON
Purchaser:  ALANA HAMILTON
Vendor: 

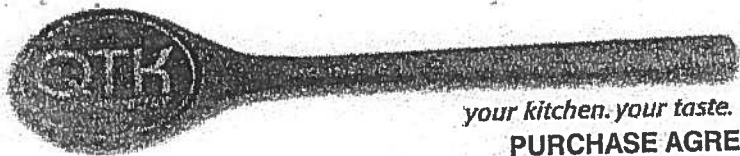

Quality Tops & Kitchens Ltd.
80 Sante Drive, Vaughan, ON L4K 3C4
T 416.746.1811 F 905.761.5901
www.QTK.ca info@qtk.ca

PURCHASE AGREEMENT FORM

PURCHASER:	Suite 418	CONTRACTOR:	Braylea Investments Inc.	
ADDRESS:	Hampton	SITE:	HAMPTON PLACE	
EMAIL:		MODEL TYPE:	SAG HARBOUR(1C+D)	
PHONE #:		LOT #:	418 HMP.	
PHONE #:		DATE:	Apr 29, 2019	Q5193

The purchaser agrees to buy and Quality Tops & Kitchens Ltd. (QTK) agrees to sell and provide for the purchaser the following articles listed herein and with attached drawing in accordance to the terms and conditions described on the reverse of this agreement form.

ROOM	DESCRIPTION	CATEGORY
KITCHEN	DOOR STYLE: FINISH: SPECIES: DOOR HARDWARE: DRW HARDWARE: COUNTER TOP: <i>See Colour Chart for Selections</i>	

ITEM #	QTY	DESCRIPTION	PRICE
VB	1	VALANCE BOX UPPERS & PUCK LIGHT CUTOUTS (ELEC. & LIGHTS NOT INCL.) - (OPTION PAID FOR BY BUILDER)	
FG2696	1	FRIDGE GABLE - 26" DEEP x 95-1/2"H - (OPTION PAID FOR BY BUILDER)	
FC2623	1	FRIDGE CABINET - 26" DEEP x 23"H - (OPTION PAID FOR BY BUILDER)	
BCR-MC1	1	MAGIC CORNER 1 PULL-OUT UNIT w/ 4 S.S. ANTI-SLIP BASKETS	
ULCC-14	1	UPPER L-SHAPE CORNER CABINET 26" x 26"- 13-3/4" DEEP	
UC-14WK	1	INCREASE DEPTH OF UPPER CABINET TO 13-3/4" DEEP (WHOLE KITCHEN) - 113 WHITE LP INTERIOR	
BLCC	1	BASE L-SHAPE CORNER CABINET w/ 1 ADJ. SHELF	
CUST-1	1	BLUM MOTION ANTI SLAM HINGES & 1 SET OF BLUM WHITE ANTARO DRAWER SLIDES.	
CUST-2	1	PULL OUT SPICE UNIT w/ 2 FIXED BASKETS INCL. BLUM WHITE ANTARO ANTI SLAM SLIDES - 15" & 8" HIGH CLEARANCE	
ROOM SUMMARY:			

ROOM	DESCRIPTION	CATEGORY
POWDER ROOM VANITY	DOOR STYLE: FINISH: SPECIES: DOOR HARDWARE: DRW HARDWARE: COUNTER TOP: Counter Top by Others	

ITEM #	QTY	DESCRIPTION	PRICE
VB-RAISE8	1	RAISE VANITY HEIGHT TO 34-1/2" - PER VANITY (>61" LONG) <i>(Upg. Included in APAs)</i>	
CUST-1	1	BLUM MOTION ANTI SLAM HINGES	
ROOM SUMMARY:			


ROOM	DESCRIPTION	CATEGORY
ENSUITE VANITY	DOOR STYLE: FINISH: SPECIES: FIBERBOARD DOOR HARDWARE: DRW HARDWARE: COUNTER TOP: Counter Top by Others	

ITEM #	QTY	DESCRIPTION	PRICE
VB-RAISE8	1	RAISE VANITY HEIGHT TO 34-1/2" - PER VANITY (>61" LONG) <i>(Upg. Included in APAs)</i>	
CUST-1	1	BLUM MOTION ANTI SLAM HINGES & 1 SET OF BLUM MOTION WHITE ANTARO DRAWER SLIDES	
ROOM SUMMARY:			

CUSTOMER INITIALS



CUSTOMER INITIALS

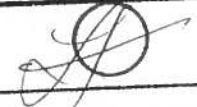



your kitchen. your taste.

PURCHASE AGREEMENT FORM

Quality Tops & Kitchens Ltd.
80 Sante Drive, Vaughan, ON L4K 3C4
T 416.746.1811 F 905.761.5901
www.QTK.ca info@qtk.ca

PURCHASER:		CONTRACTOR:	Braylea Investments Inc.	
ADDRESS:		SITE:	HAMPTON PLACE	
EMAIL:		MODEL TYPE:	SAG HARBOUR(1C+D)	
PHONE #:		LOT #:	418 HMP-	
PHONE #:		DATE:	Apr 29, 2019	Q5193

EXPECTED DELIVERY DATE	TBD	SUB-TOTAL:	
Customers please note all garbage bins, spice baskets, magic corner baskets and other accessories will only be delivered AFTER you move in the house. Please call us to request delivery of these items after you move in. Thank you. ALL CHANGES FINAL UPON SIGNING PLEASE READ ALL THE TERMS AND CONDITIONS ON THE ACCOMPANYING QTK TERMS & CONDITIONS DOCUMENT. BY SIGNING BELOW YOU AGREE TO RECEIVE THE ITEMS LISTED HEREIN AND PAY (ACCORDING TO QTK'S PAYMENT POLICY), AND HAVE READ AND UNDERSTOOD THE TERMS & CONDITIONS AS OUTLINED IN THE QTK TERMS & CONDITIONS DOCUMENT.		TOTAL:	
		HST	
		GRAND TOTAL	
DEPOSIT 1 DATE: _____		DEPOSIT 1:	
DEPOSIT 2 DATE: _____		DEPOSIT 2:	
BALANCE TO BE PAID IN FULL BY DUE DATE: _____		CUSTOMER INITIAL(S): _____	

CUSTOMER SIGNATURE: _____

DATE: May 30, 2019


CUSTOMER SIGNATURE: _____

DATE: May 30, 2019

SALES REP NAME: Sheliza Khan Designs

QTK AUTHORIZED SIGNATURE: _____


Bulkhead Layout

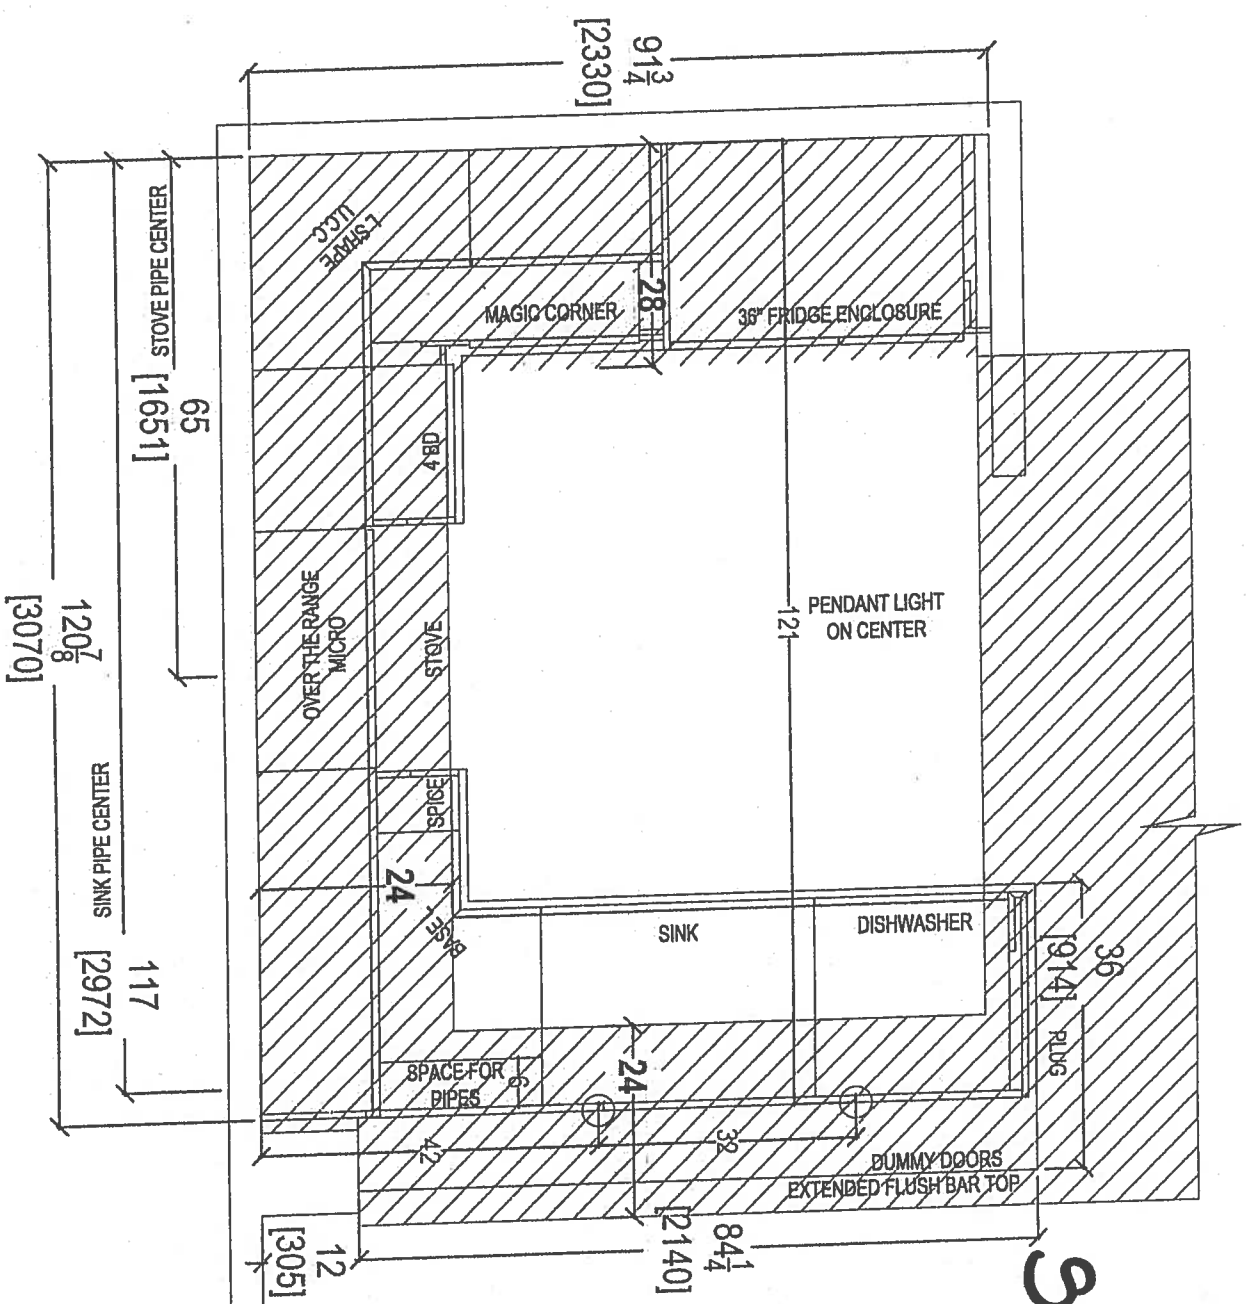

Suite

418

- (x2) - Pendants Lights
- (x1) - Plug Peninsula
- (x4) - Puck Lights
- * Powder Room +
- ENSUITE
- Range VANITIES
- 36" 1/4 + 3" splash
- * 1st NOB AND E
- 1st + Pockets

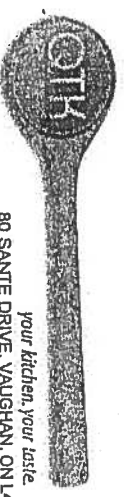


your kitchen, your taste.
80 SANTE DRIVE, VAUGHAN, ON L4K 3C4,
T: 416.746.1811 F: 905.761.5901

CLIENT: ROYAL PINE HOMES	JOB NAME: UNIT 418 HMP	ROOM: KITCHEN	DRAWN BY: SK	COMMENTS:
SITE: HAMPTON PLACE	DOOR STYLE: —	DOOR HANDLE: —	SCALE: 1/2" = 1'-0"	PLEASE NOTE ALL DIMENSIONS ARE NOT FINAL AND ARE SUBJECT TO CHANGE UPON FINAL SITE MEASURE
PHONE: —	FINISH: —	DRW HANDLE: —	DATE: REVISED APRIL 3, 2019	
EMAIL: —	SPECIES: —	TOP: —	PAGE: —	

Suite 418
Hampton

72- Rock Light (x4)

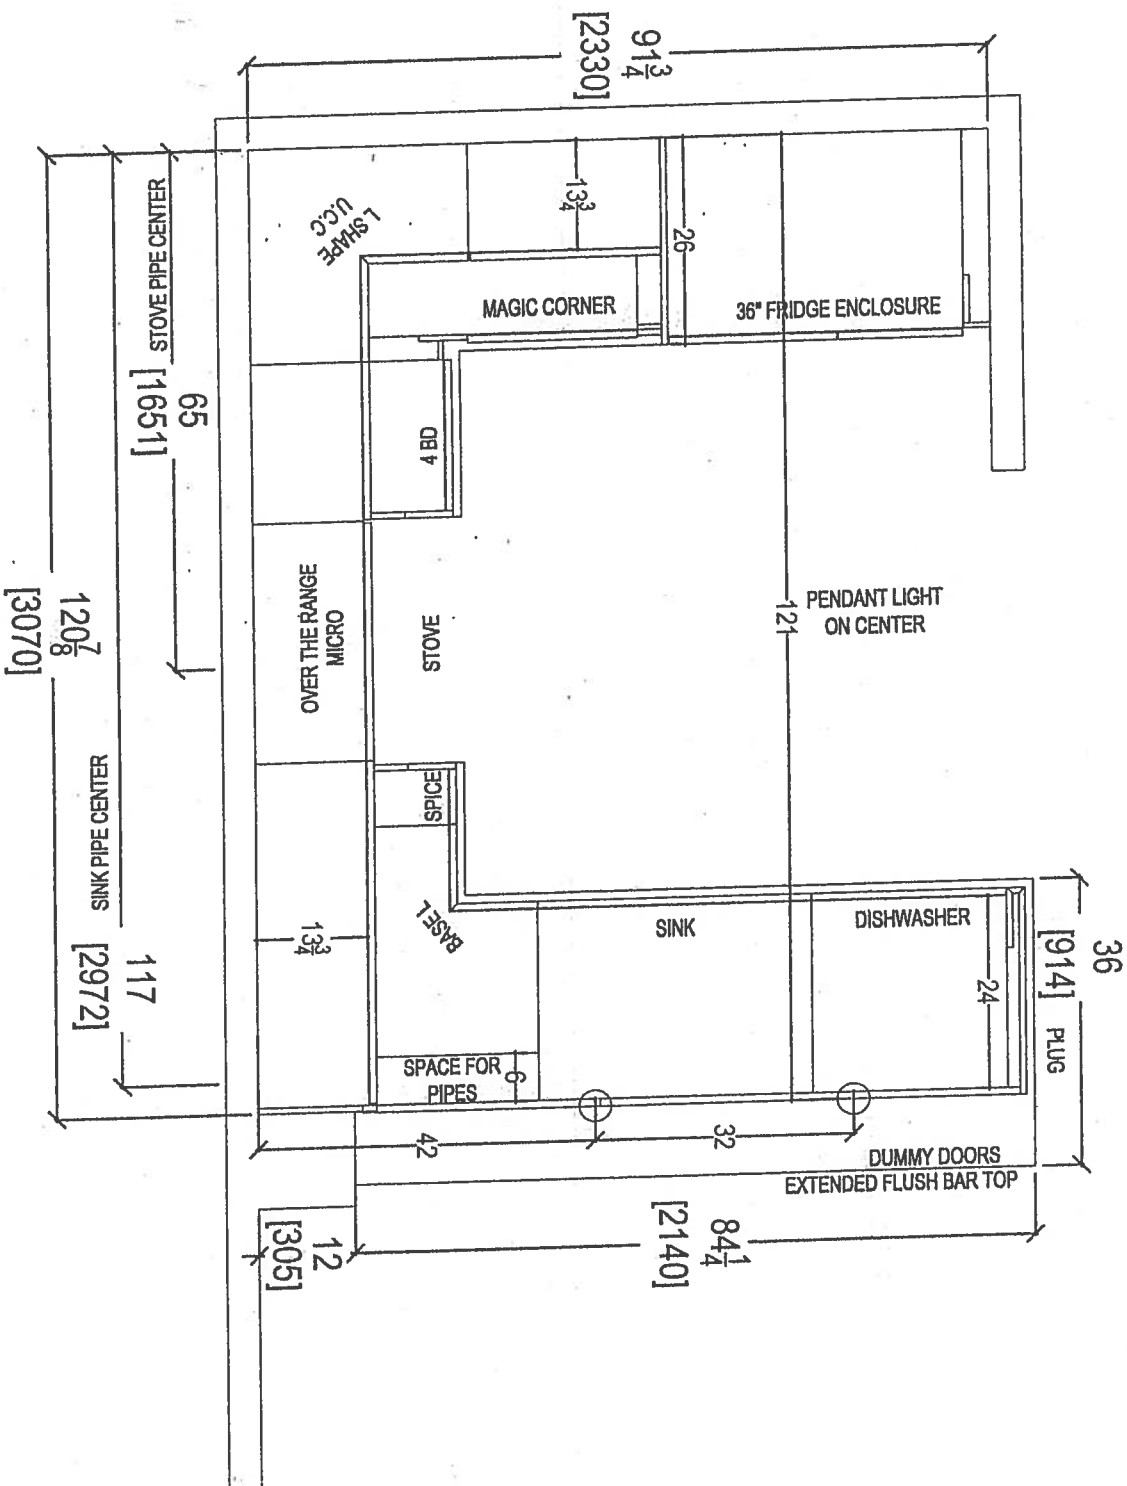



your kitchen, your taste
80 SANTE DRIVE, VAUGHAN, ON L4K 3C4,
T: 416.746.1811 F: 905.761.5801

CLIENT: ROYAL PINE HOMES	JOB NAME: UNIT 418 HMP	ROOM: KITCHEN	DRAWN BY: SK
SITE: HAMPTON PLACE	DOOR STYLE: —	DOOR HANDLE: —	SCALE: 1/2" = 1' - 0"
PHONE: —	FINISH: —	DRW HANDLE: —	DATE: REVISED APRIL 3, 2019
EMAIL: —	SPECIES: —	TOP: —	PAGE: —

COMMENTS:
PLEASE NOTE ALL DIMENSIONS
ARE NOT FINAL AND ARE
SUBJECT TO CHANGE UPON
FINAL SITE MEASURE

Suite 418 Hampton

PL-Rock Light (x4)

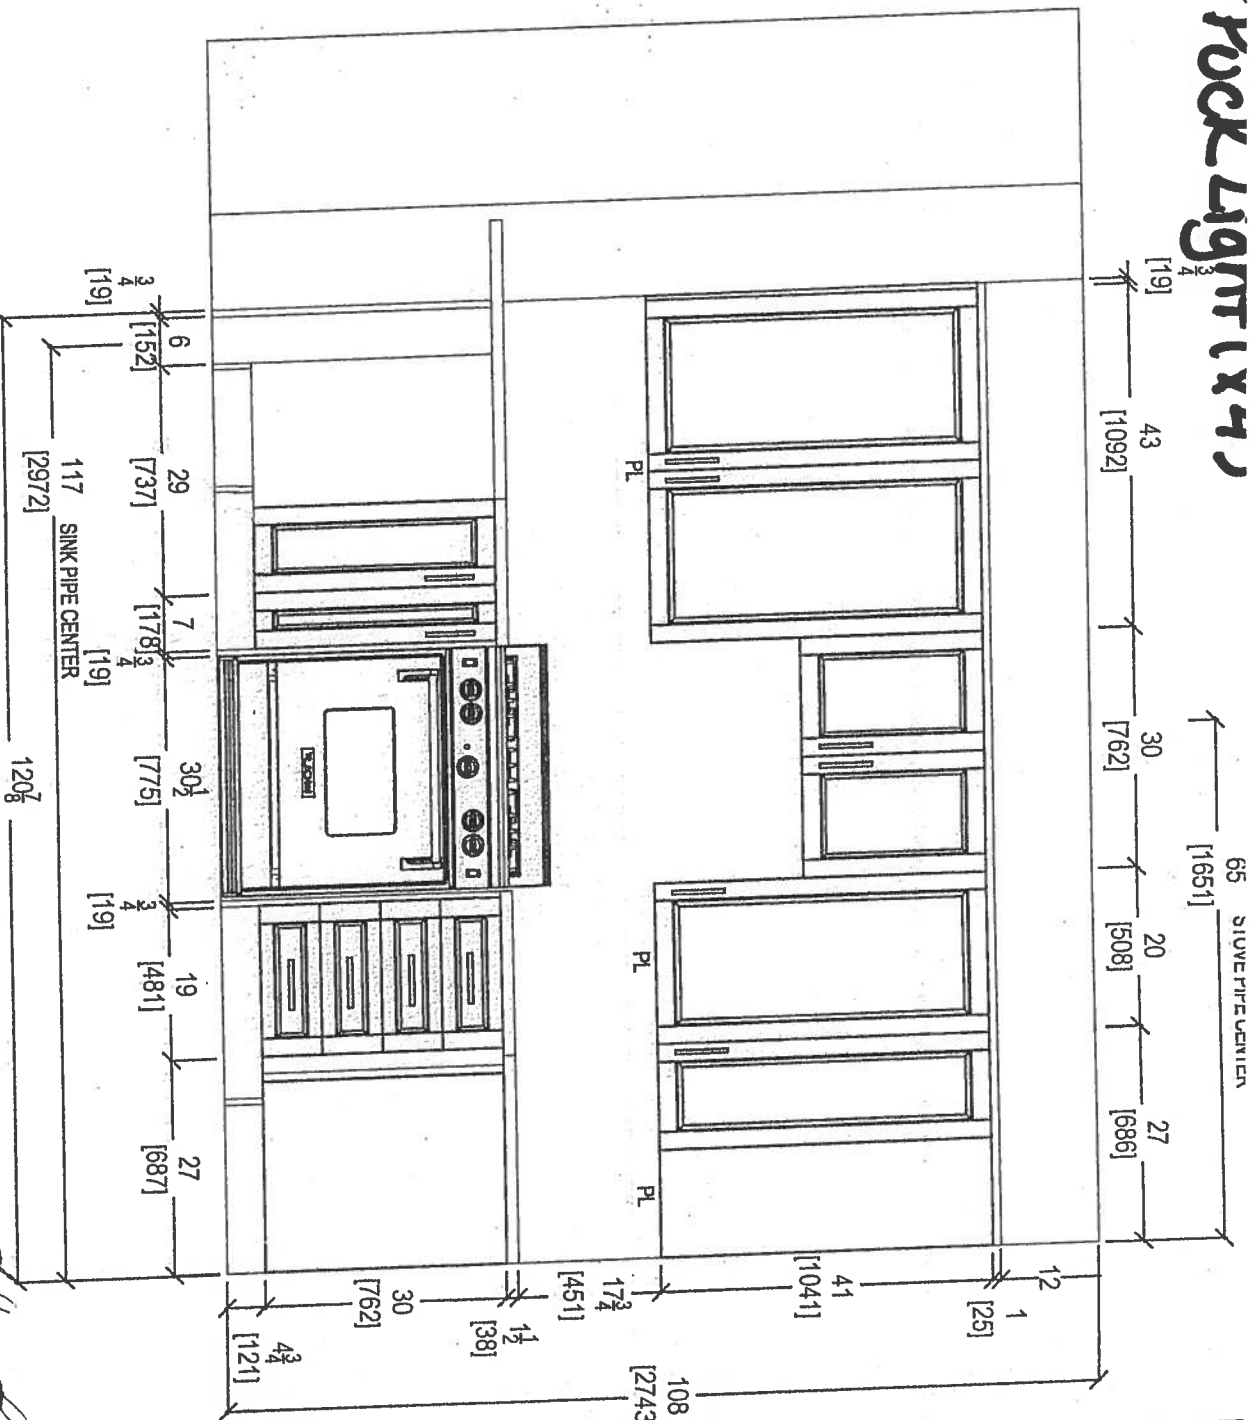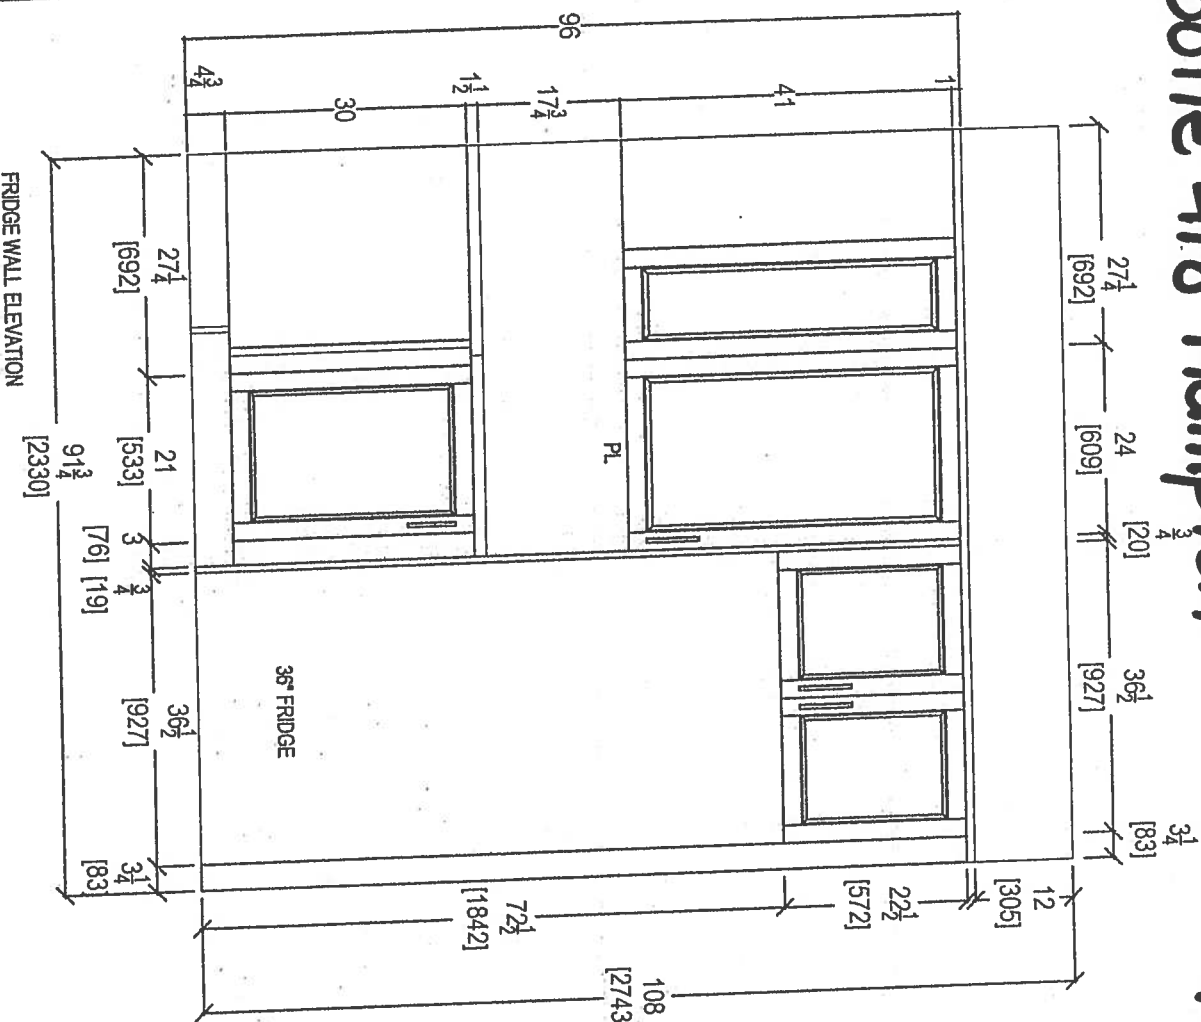


CLIENT: ROYAL PINE HOMES	JOB NAME: UNIT 418 HMP	ROOM: KITCHEN	DRAWN BY: SK	COMMENTS:
--------------------------	------------------------	---------------	--------------	-----------

SITE: HAMPTON PLACE	DOOR STYLE: ---	DOOR HANDLE: ---	SCALE: 1/2" = 1'-0"	PLEASE NOTE ALL DIMENSIONS ARE NOT FINAL AND ARE SUBJECT TO CHANGE UPON FINAL SITE MEASURE
PHONE: ---	FINISH: ---	DRW HANDLE: ---	DATE: REVISED APRIL 3, 2019	
EMAIL: ---	SPECIES: ---	TOP: ---	PAGE: ---	



80 SANTE DRIVE, VAUGHAN, ON L4K 3C4,
T: 416.746.1811 F: 905.761.5901

Suite 418 Hampton

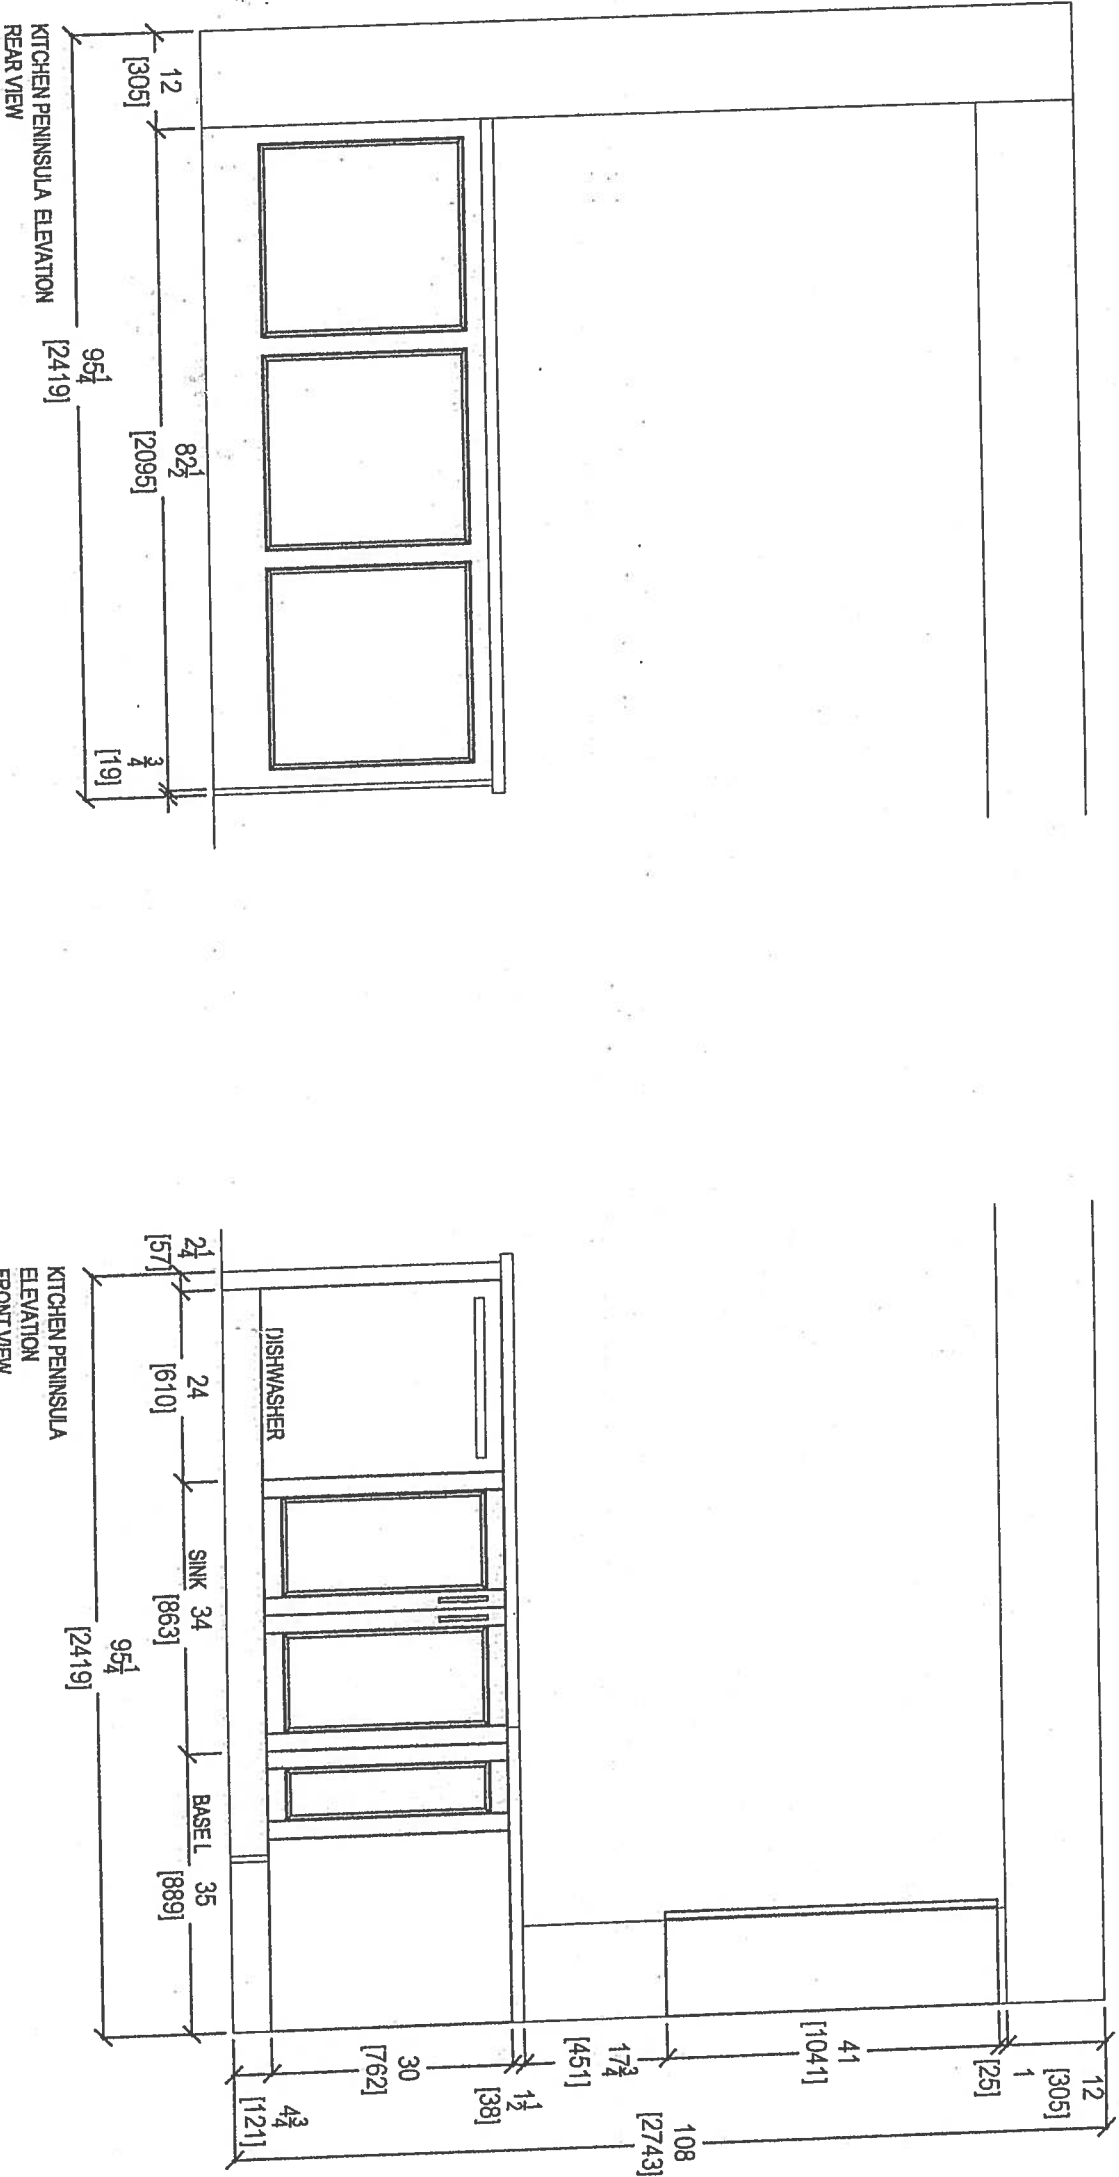


CLIENT: ROYAL PINE HOMES		JOB NAME: UNIT 418 HAMP		ROOM: KITCHEN		DRAWN BY: SK		COMMENTS: PLEASE NOTE ALL DIMENSIONS ARE NOT FINAL AND ARE SUBJECT TO CHANGE UPON FINAL SITE MEASURE	
SITE: HAMPTON PLACE		DOOR STYLE: —		DOOR HANDLE: —		SCALE: 1/2" = 1' - 0"			
PHONE: —		FINISH: —		DRAW HANDLE: —		DATE: REVISED APRIL 3, 2019			
EMAIL: —		SPECIES: —		TOP: —		PAGE: —			




80 SANTE DRIVE, VAUGHAN, ON L4K 3C4,
T: 416.748.1811 F: 905.761.5901



Suite 418 Hampton

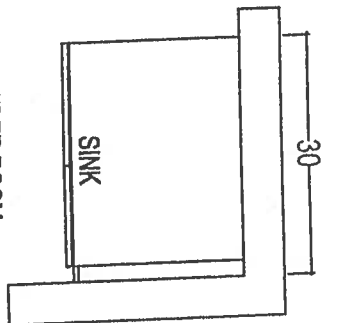

POWDER ROOM

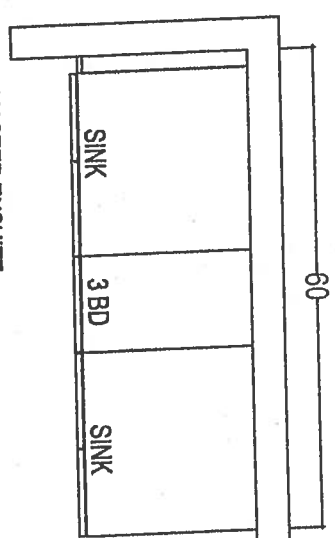

MASTER ENSUITE

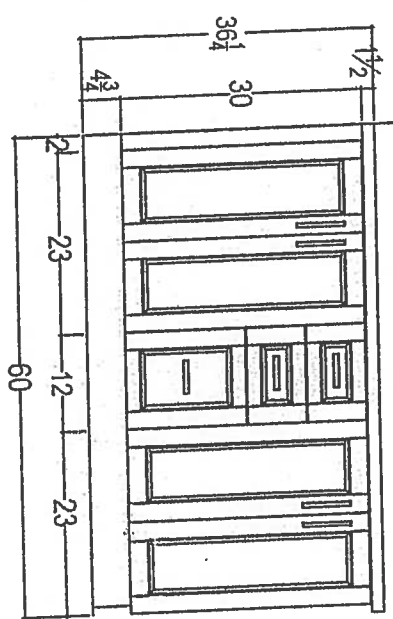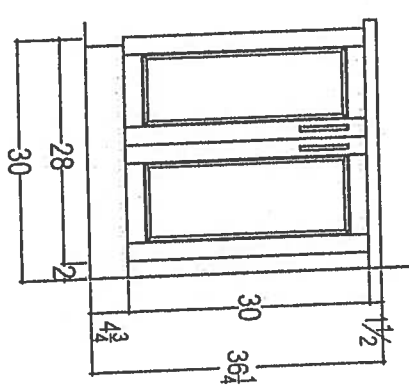

* RASED VANITIES w 3" SPLASH *

COMMENTS:

PLEASE NOTE ALL DIMENSIONS ARE NOT FINAL AND ARE SUBJECT TO CHANGE UPON FINAL SITE MEASURE

[Handwritten signatures]




80 SANTE DRIVE, VAUGHAN, ON L4K 3C4,
T: 416.746.1811 F: 905.761.5901

CLIENT: ROYAL PINE HOMES	JOB NAME: UNIT 418 HMP	ROOM: VANITIES	DRAWN BY: SK
SITE: HAMPTON PLACE	DOOR STYLE: —	DOOR HANDLE: —	SCALE: 1/2" = 1' - 0"
PHONE: —	FINISH: —	DRW HANDLE: —	DATE: REVISED: APRIL 3, 2019
EMAIL: —	SPECIES: —	TOP: —	PAGE: —

KRFC302ESS

22 cu.ft. 36-Inch Width Counter Depth French Door Refrigerator
with Interior Dispense

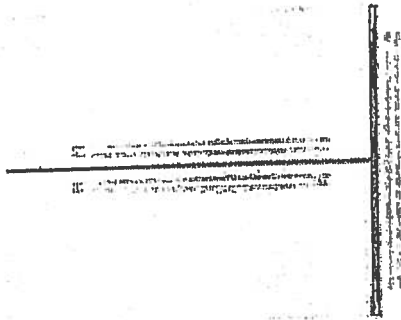

MADE IN
AMERICA

KRFC302ESS

Key Features:

- ExtendFresh™ Temperature Management System
- Interior Water Dispenser**
- Professionally-Inspired Design
- Produce Preserver
- Humidity-Controlled Crispers
- FreshChill™ Temperature-Controlled Full-Width Pantry
- Pull-Out Tri-Level Freezer Drawer
- SatinGlide® System
- LED Lighting
- Star-K Certified
- Automatic Ice Maker
- Max Cool

KitchenAid®

<http://www.kitchenaid.com>

Product Dimensions:

Height: 72
Width: 35 3/4
Depth: 30 1/4

Electrical Requirements:

15 Amps.

Available In:

- ☐ Stainless Steel
- ☒ Black
- ☐ White

Upgrade
Package 2



Suite 418
Hampton

Upgrade
Package!


WEE745H0FS



Whirlpool®

<http://www.whirlpool.com>

6.4 Cu. Ft. Slide-In Electric Range with True
Convection

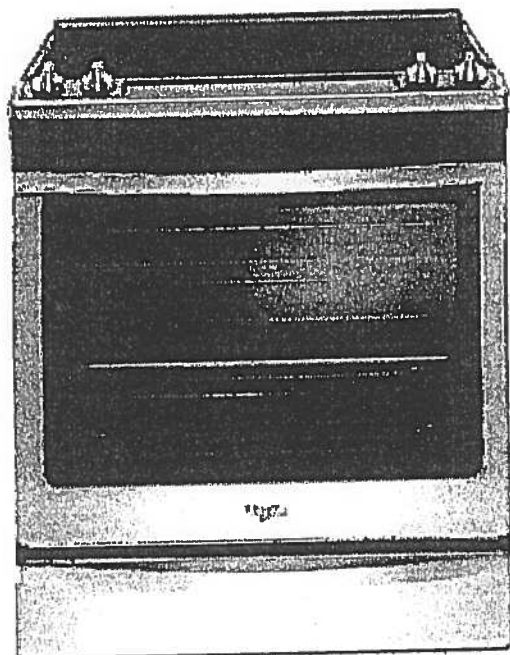

Key Features:

- Frozen Bake™ Technology
- True Convection Cooking
- FlexHeat™ Triple Radiant Element
- Convection Conversion
- AquaLift® Self-Cleaning Technology
- Temperature Sensor
- Rapid Preheat
- 6.4 Cu. Ft. Capacity
- Easy-Wipe Ceramic Glass Cooktop
- Large Oven Window
- Max Capacity Rack
- Hidden Bake Element

Product Dimensions:

Height: 36

Width: 29 7/8

Additional Information:

[Use And Care Guide](#)

[Dimension Guide](#)

[Installation Guide](#)

[Warranty Certificate](#)

INVESTED
IN
AMERICA



®Registered trademark/TM Trademark of Whirlpool, U.S.A. © 2016 Whirlpool Corporation. All Rights Reserved.
All other trademarks are owned by their respective companies.
Because Whirlpool Corporation policy includes a continuous commitment to improve our products, we reserve the right to change materials and specifications without notice. We also reserve the right to discontinue or transition products without notice.
Manufacturer's Suggested Retail Price (MSRP) and Minimum Advertised Price (MAP) provided for informational purposes only. Dealer alone determines advertised and retail prices.
Created On: Friday, January 27, 2017 10:46:47

Suite 418
Hampton



part of
the family



FREE LOCAL DELIVERY

On all Orders Over \$498



60 DAY PRICE GUARANTEE

Means you Always Get the Best Price




LOCAL SHOWROOMS

With a Dedicated Service Team

APPLIANCES / KITCHEN / MICROWAVES

Whirlpool Stainless Steel Over-the-Range Convection Microwave (1.9 Cu. Ft.) - YWMHA9019HZ

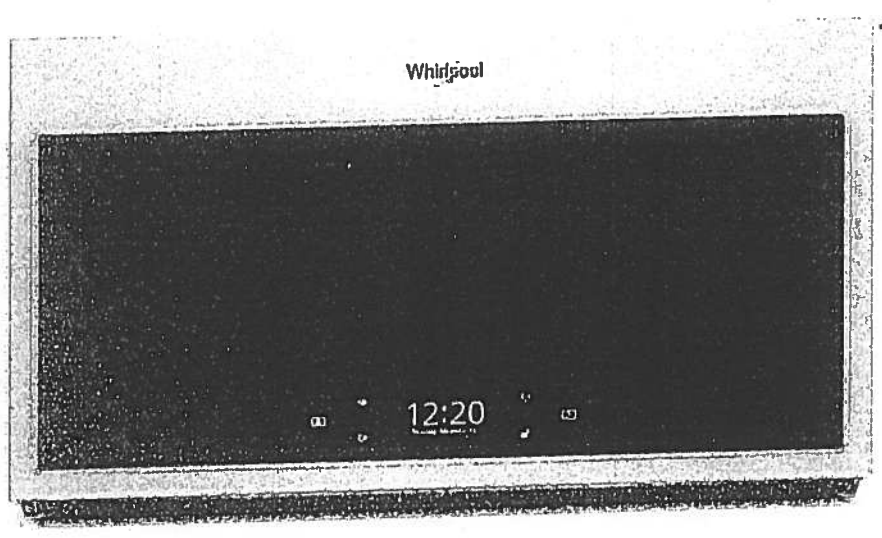

SKU: 13290594

Print This Page Share This

Hover/Touch to Zoom



Click to change image.



Suite 418
Hampton

Upgrade
Package 1



WDTA50SAHZ

Whirlpool®

Contemporary Design. Stainless Steel Tub
Dishwasher with TotalCoverage Spray Arm

<http://www.whirlpool.com>

Key Features:


- Sensor Cycle
- TotalCoverage Spray Arm
- 1-Hour Wash Cycle
- Tap Touch Controls

Product Dimensions:

Height: 34 1/2
Width: 23 7/8
Depth: 24 1/2

Additional Information:

[Use And Care](#)
[Dimension Guide](#)
[Installation Guide](#)
[Energy Guide](#)
[Warranty](#)

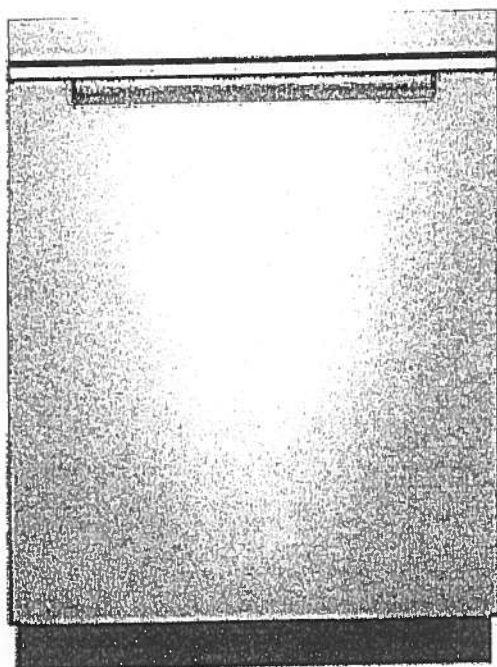

Available in:

● Black

Fingerprint Resistant Sunset Bronze

Fingerprint Resistant Black Stainless

○ White

Fingerprint Resistant Stainless Steel

INVESTED
IN
AMERICA



®Registered trademark/TM Trademark of Whirlpool, U.S.A. © 2016 Whirlpool Corporation. All Rights Reserved. All other trademarks are owned by their respective companies.

Because Whirlpool Corporation policy includes a continuous commitment to improve our products, we reserve the right to change materials and specifications without notice. We also reserve the right to discontinue or transition products without notice.

Manufacturer's Suggested Retail Price (MSRP) and Minimum Advertised Price (MAP) provided for reference purposes only. Dealer alone determines advertised and retail prices.

Suite 418
Hampton

Upgrade
Package!




WFW75HEFW



4.5 cu. ft. Front Load Washer with Precision
Dispense

<http://www.whirlpool.com>

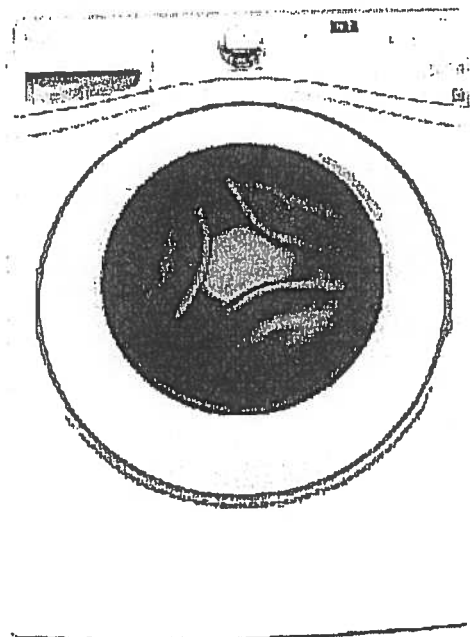

Key Features:

- Precision Dispense
- Adaptive Wash Technology
- Smooth Wave Stainless Steel Wash Basket
- 4.5 cu. ft. Capacity
- ENERGY STAR® Qualified

Product Dimensions:

Height: 39 3/4

Width: 27

Depth: 33 5/16

Electrical Requirements:

15 or 20. 120 V.

Additional Information:

[Use And Care Guide](#)

[Dimension Guide](#)

[Installation Guide](#)

[Energy Guide](#)

[Warranty Certificate](#)

INVESTED
IN
AMERICA



®Registered trademark/TM Trademark of Whirlpool, U.S.A. ©2013 Whirlpool Corporation. All Rights Reserved.
All other trademarks are owned by their respective companies.
Because Whirlpool Corporation policy includes a continuous commitment to improve our products, we reserve
the right to change materials and specifications without notice. We also reserve the right to discontinue or
transition products without notice.
Manufacturer's Suggested Retail Price (MSRP) and Minimum Advertised Price (MAP) provided for reference
purposes only. Dealer alone determines advertised and retail prices.
Created On: Wednesday, March 23, 2016 11:51:03

Suite 418 Hampton Upgrade Package 1




YWED75HEFW

Whirlpool®

<http://www.whirlpool.com>

8.5 cu. ft. Duet® High Efficiency Front Load Electric
Dryer with ENERGY STAR®

MSRP: \$0.00

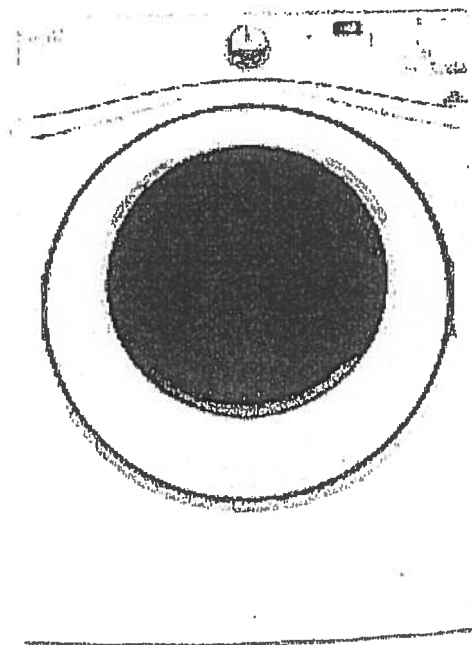

Key Features:

- Advanced Moisture Sensing System
- Quad Baffles
- Tap Touch Controls with Memory
- EcoBoost™ Option
- Wrinkle Shield™ Plus Option
- Undercounter Installation
- 7.4 Cu. Ft. Capacity
- ENERGY STAR® Qualified

Product Dimensions:

Height: 39

Width: 27

Depth: 31

Additional Information:

[Use And Care](#)

[Installation Guide](#)

[Warranty](#)

Available in:

☐ White

INVESTED
IN
AMERICA



®Registered trademark/TM Trademark of Whirlpool, U.S.A. © 2016 Whirlpool Corporation All Rights Reserved. All other trademarks are owned by their respective companies.

Because Whirlpool Corporation policy includes a continuous commitment to improve our products, we reserve the right to change materials and specifications without notice. We also reserve the right to discontinue or transition products without notice.

Manufacturer's Suggested Retail Price (MSRP) and Minimum Advertised Price (MAP) provided for reference purposes only. Dealer alone determines advertised and retail prices.