
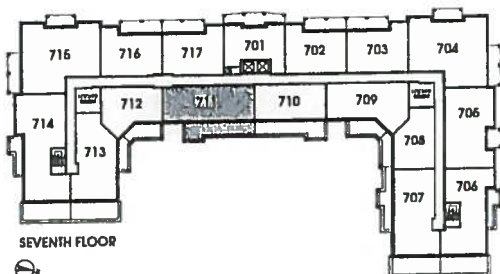


SCHEDULE "C"

Suite 711

ORIGINAL LAYOUT.

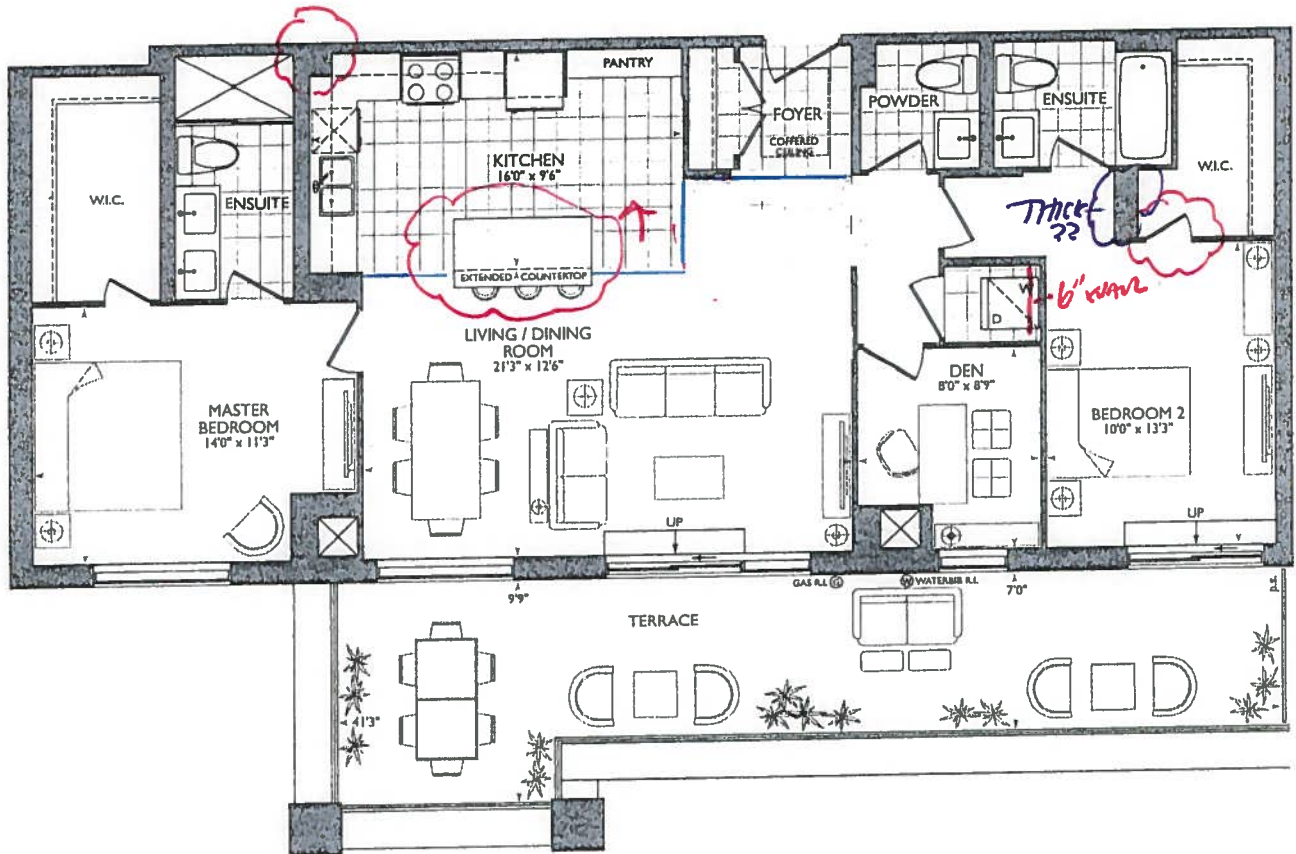

NORTH SEA

2T+D-T

2 Bedrooms & 2.5 Bathrooms Plus Den

10' Ceilings*

1301 sq.ft.

Plus 315 sq.ft. Terrace

Level No. 7

Unit No. 11

Suite No. 711

Purchaser Initials B.

Purchaser Initials

Date 28/07/16

Dimensions, specifications, tile floor patterns and architectural detailing (including window size and location) are approximate and subject to modifications without notice. Orientation of suite may be reversed and purchaser agrees to accept same. Actual usable floor space may vary from the stated floor area. *Ceiling heights are approximate and measured from top of floor slab to underside of floor above before finishes and excluding bulkheads and required drop ceilings. Exterior conditions and dimensions of balconies and terraces for similar suites may vary due to location and floor. E.&O.E.

VINCE'S COPY

Additions



PURCHASER'S EXTRAS (PE)
Hampton Place - Braylea Investments Inc.

PURCHASER: GEORGE MELO

TEL: RES.: 416-357-1989

LOT NUMBER	PHASE	HOUSE TYPE	REG. PLAN #		
711	1	NORTH SEA			

Item	QTY	Description	Addition to Purchase Price	
------	-----	-------------	----------------------------	--

1	✓	1 - BEDROOM #2 - Install ONE (1) Ceiling Light to entrance hallway of bedroom #2 and connect to existing light fixture (See Sketch) Note: Priced and Approved as-per Fonzie C.		
2	✓	1 - ENSUITE #2 - Install ONE (1) Shower Pot Light at ensuite #2 tub/shower enclosure. Connect shower pot light to vanity light on same switch (See Sketch) Note: Priced and Approved as per Fonzie C.		
3	✓	1 - DEN - Re-locate Data Outlet to wall that separates with laundry closet (See Sketch) Note: Priced and Approved as per Fonzie C.		
4	✓	1 - LIVING ROOM - Raise Standard Receptacle up to Approx. 60" AFF(Above Finished Floor) Centred, as marked on layout (See Sketch) Note: Priced and Approved as per Fonzie C.		
5	✓	1 - KITCHEN - DELETE ONE (1) Track Fixture and Box (See Sketch) Note: Priced and Approved as per Fonzie C.		
6	✓	1 - KITCHEN - Re-locate ONE (1) Kitchen Light Box to be centred over island, connect to existing switch (See Sketch) Note: Priced and Approved as per Fonzie C.		
7	✓	1 - KITCHEN - Install THREE (3) POT LIGHTS in kitchen on a New SEPERATE SWITCH. Switch to be ganged together with existing switch. (See Sketch) Note: Priced and Approved as per Fonzie C.		
8	✓	1 - KITCHEN - Install ONE (1) Additional PUCK LIGHT over sink in bottom of upper cabinet. (See Sketch) Standard is FOUR (4) Puck Lights, Purchaser to pay for ONE (1) Additional Puck Light Note: Priced and Approved as per Fonzie C.		
9	✓	1 - DINING ROOM - Re-locate ceiling light as marked on layout. (See Sketch) Note: Priced and Approved as per Fonzie C.		
10	✓	1 - PURCHASER AWARE AND ACCEPTS THAT ANY CHANGES MADE TO UPGRADES AFTER SIGNING THIS PURCHASERS EXTRA FORM ARE SUBJECT TO A MINIMUM ADMINISTRATION FEE OF \$1,000 PLUS A 10% HOLDBACK FEE. Note:		



	Sub Total
	HST
	Total

- In the event the work on the house has progressed beyond the point where the items covered by this extra cannot be installed without entailing any unusual expense, then this order is to be cancelled and any deposit paid in connection with the same is to be refunded to the Purchaser.
- The Vendor will undertake to incorporate the work covered by the sales extra in the construction of the house but will not be liable to the purchaser in any way, if for any reason the work covered by the extra is not carried out. In that event, any monies paid in connection with the same shall be returned to the Purchaser.
- It is understood and agreed that if for any reason whatsoever the transaction of Purchase and Sale is not completed, the total cost of extras ordered are not refundable to the Purchaser(s).
- Extras or changes will not be processed unless signed by the Vendor.
- These extras may not be amended without the written consent of Braylea Investments Inc..
- The Purchaser(s) and the Vendor acknowledge and agree that this form shall not be deemed to be part of the Agreement of Purchase and Sale entered into between them, nor an addendum thereto.
- No Estimates or orders will be accepted once construction has commenced.
- Prices are estimates only and guaranteed for a period of 5 days only.
- Any cancellations to this order, providing they can be cancelled, are subject to a \$500 minimum administration charge and a 10% cancellation charge for the total amount being cancelled.
- For Visa, Mastercard and Debit payments, transactions are identified on you statement as "SHERWAY CONSTRUCTION LTD", an Authorized Visa /Mastercard/Debit Merchant and authorized Royal Pine Homes company.

Payment Summary

Paid By	Amount	Detail
Amendment	\$2,994.50	
Total Payment:	\$2,994.50	


☐ Decor

☐ Builder

☐ Purchaser

Printed: 20-Jun-19 at 11:15 am

February 14, 2018

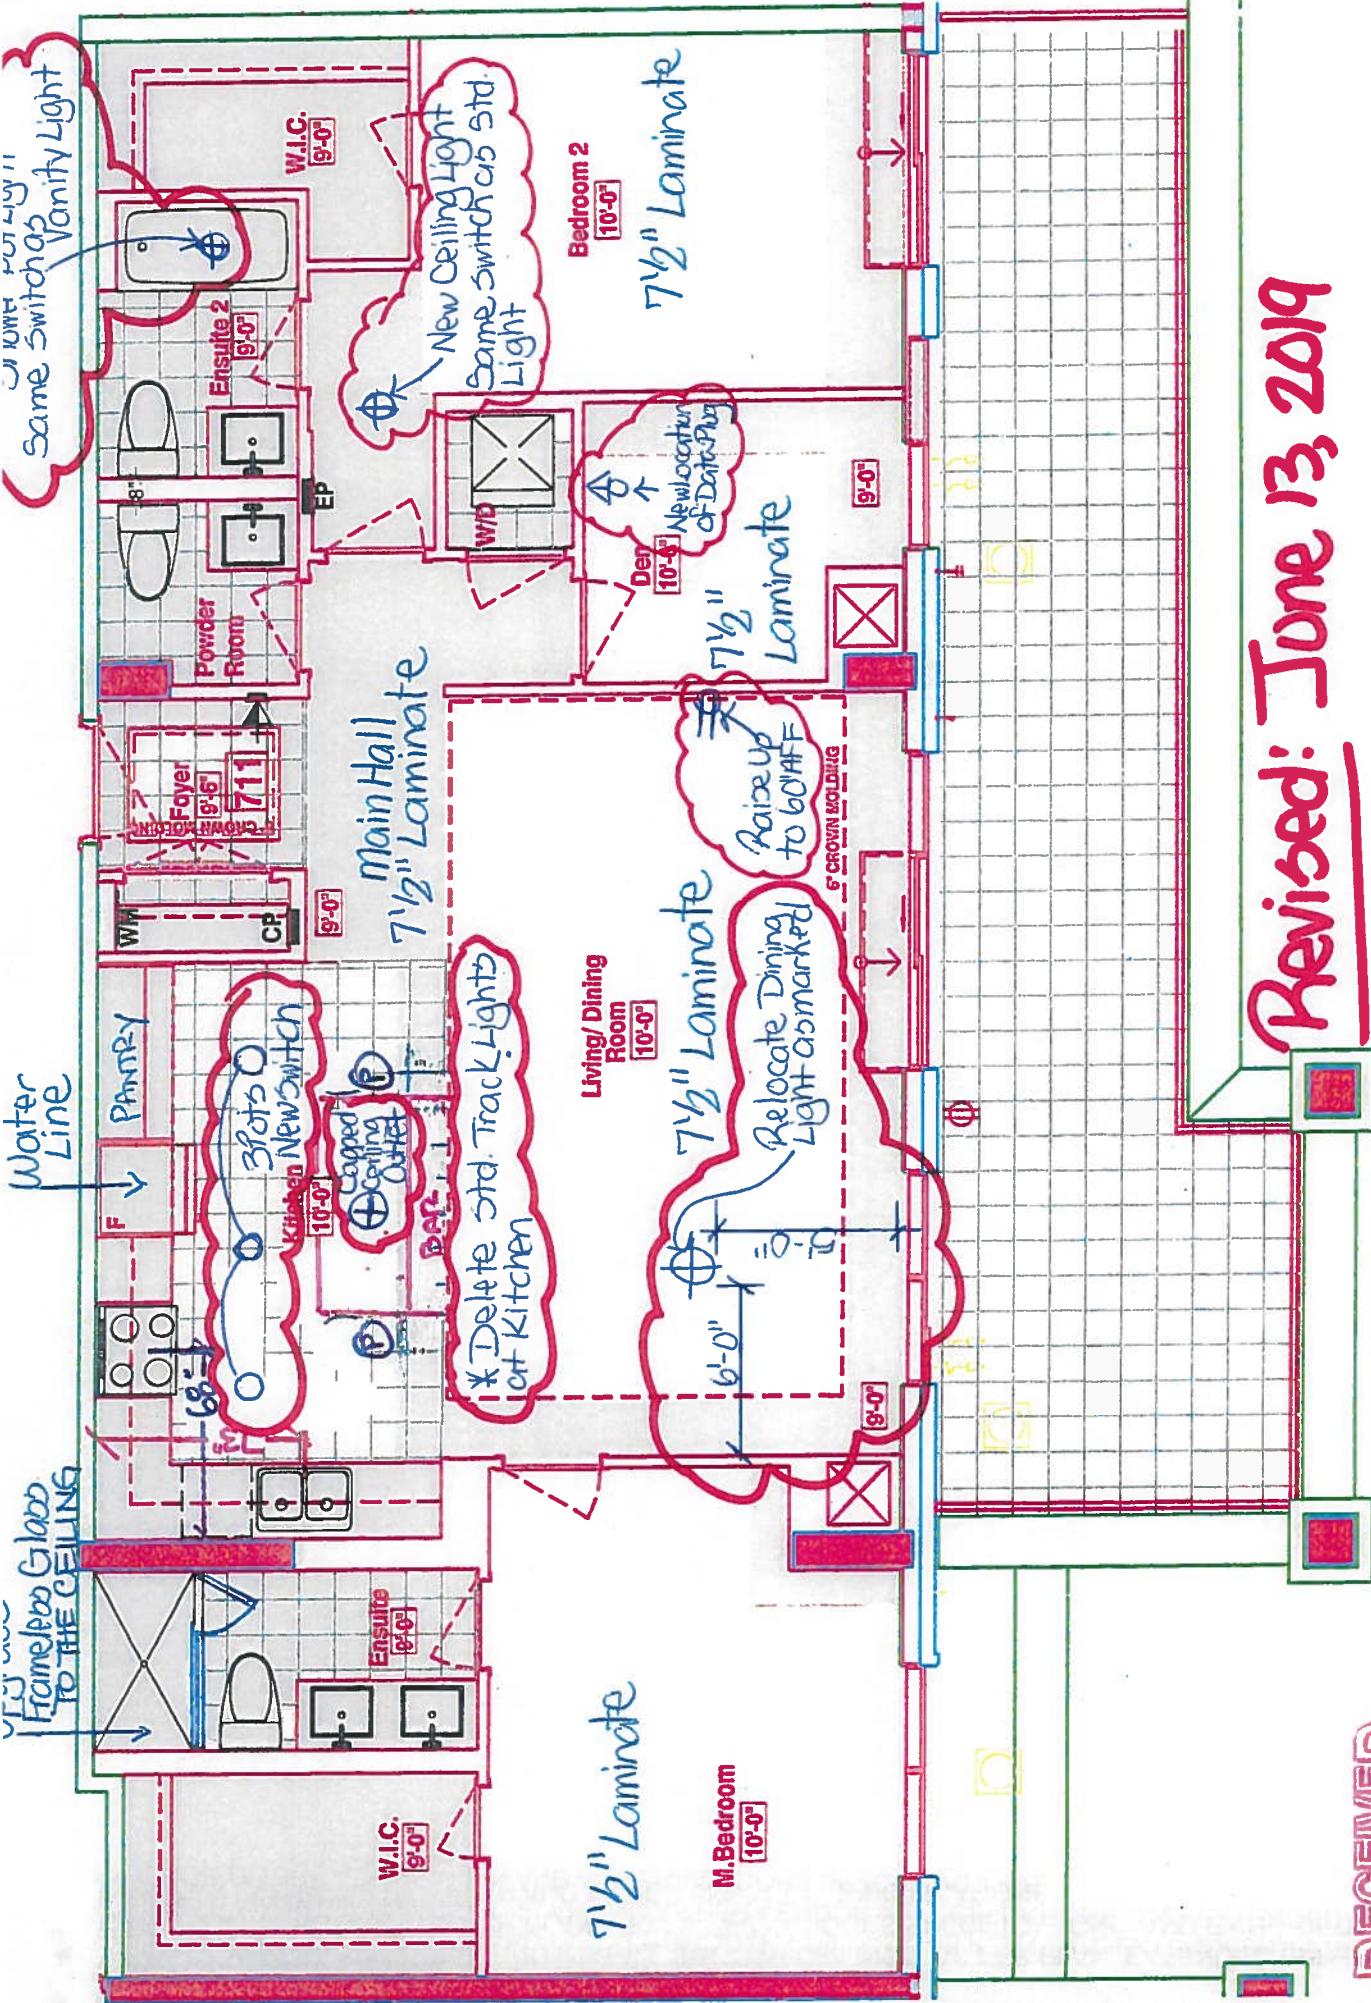

LOCATION OF KITCHEN LIGHTS REFER TO QTK. DWG.

LEGEND:	
	SECURITY PANEL
	ELECTRICAL PANEL
	COMMUNICATION PANEL
	WATER METER
	FRIDGE
	DROPPED AREA
	6" CROWN MOLDING

Revised: June 13, 2019

RECEIVED
Feb 14, 2018


SUITE 711-NORTH SEA

HAUPTON PLACE 25 Baker Hill Blvd - Stouffville, ON Jan 31, 2018

Suite 711 Hampton

Revised: June 13/19

* (x5) FICK LIGHTS

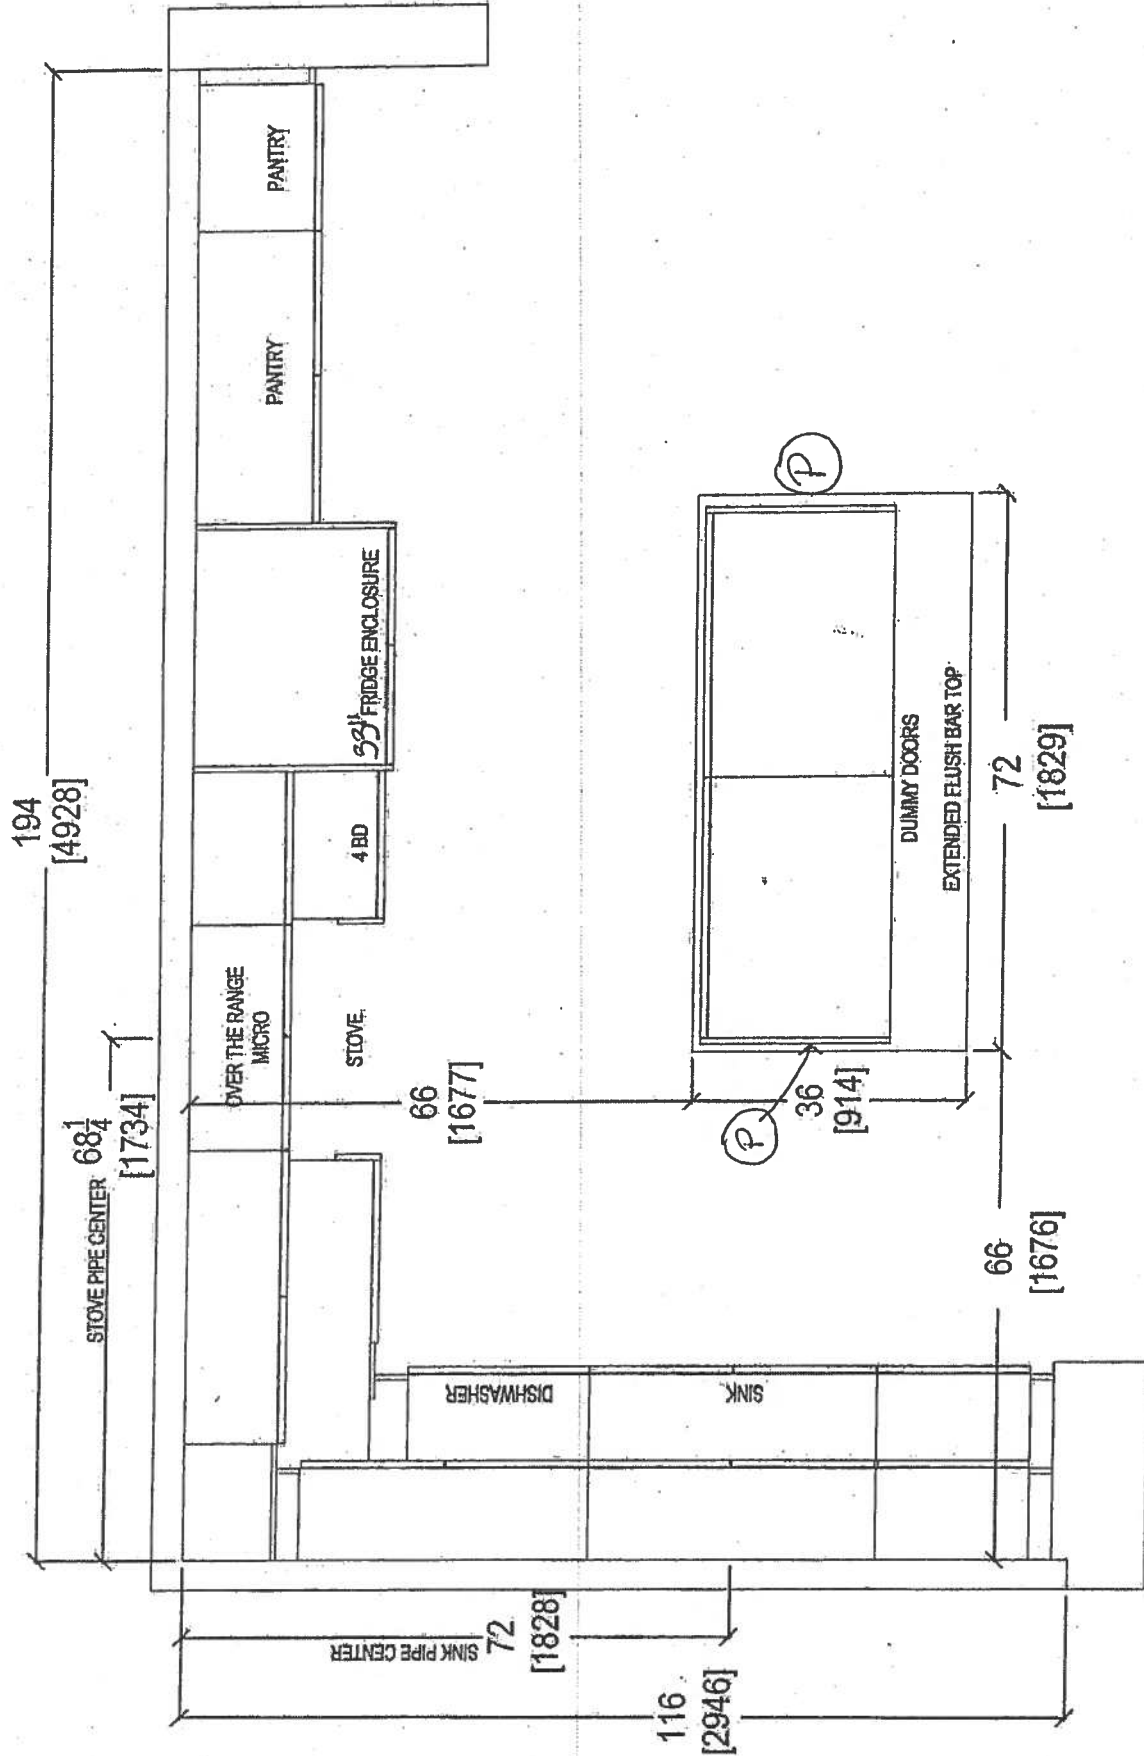


CUP
your kitchen your life
80 SANTE DRIVE, VAUGHAN, ON L4K 3C4
T: 416.746.1811 F: 905.761.5901

CLIENT: ROYAL PINE HOMES		JOB NAME: UNIT 711 HMP	ROOM	KITCHEN FLOOR PLAN	DRAWN BY: SK	COMMENTS: PLEASE NOTE ALL DIMENSIONS ARE NOT FINAL AND ARE SUBJECT TO CHANGE UPON FINAL SITE MEASURE	
SITE: HAMPTON PLACE	DOOR STYLE: —	DOOR HANDLE: —	DOOR HANDLE: —	SCALE: 1/2" = 1'-0"			
PHONE: —	FINISH: —	DRW HANDLE: —	DRW HANDLE: —	DATE: FEB 12 2018			
EMAIL: —	SPECIES: —	TOP: —	TOP: —	PAGE: —			

Suite 711 Hampton

* PL-Pock Light (x5) *

Revised: June 13/19

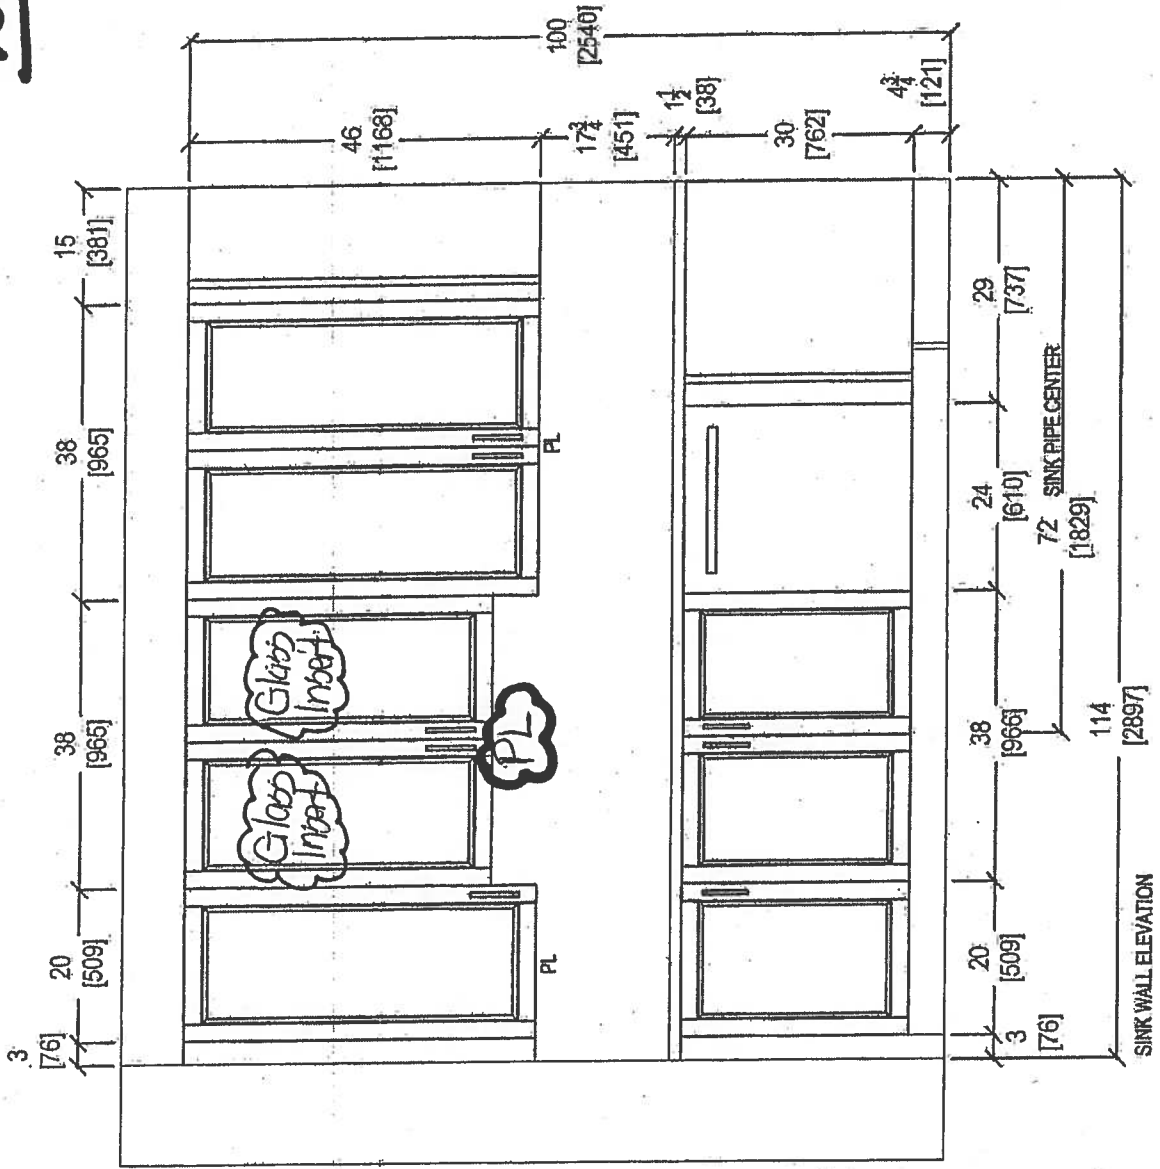


CLIENT: ROYAL PINE HOMES		JOB NAME: UNIT 711 HMP	ROOM: KITCHEN	DRAWN BY: SK	COMMENTS: PLEASE NOTE ALL DIMENSIONS ARE NOT FINAL AND ARE SUBJECT TO CHANGE UPON FINAL SITE MEASURE
SITE: HAMPTON PLACE	DOOR STYLE: —	DOOR HANDLE: —	SCALE: 1/2" = 1'-0"		
PHONE: —	FINISH: —	DRW HANDLE: —	DATE: FEB 12, 2018		
EMAIL: —	SPECIES: —	TOP: —	PAGE: —		



Suite 711 Hampton *PL-Pock Light (x5)*

Revised: June 13/19

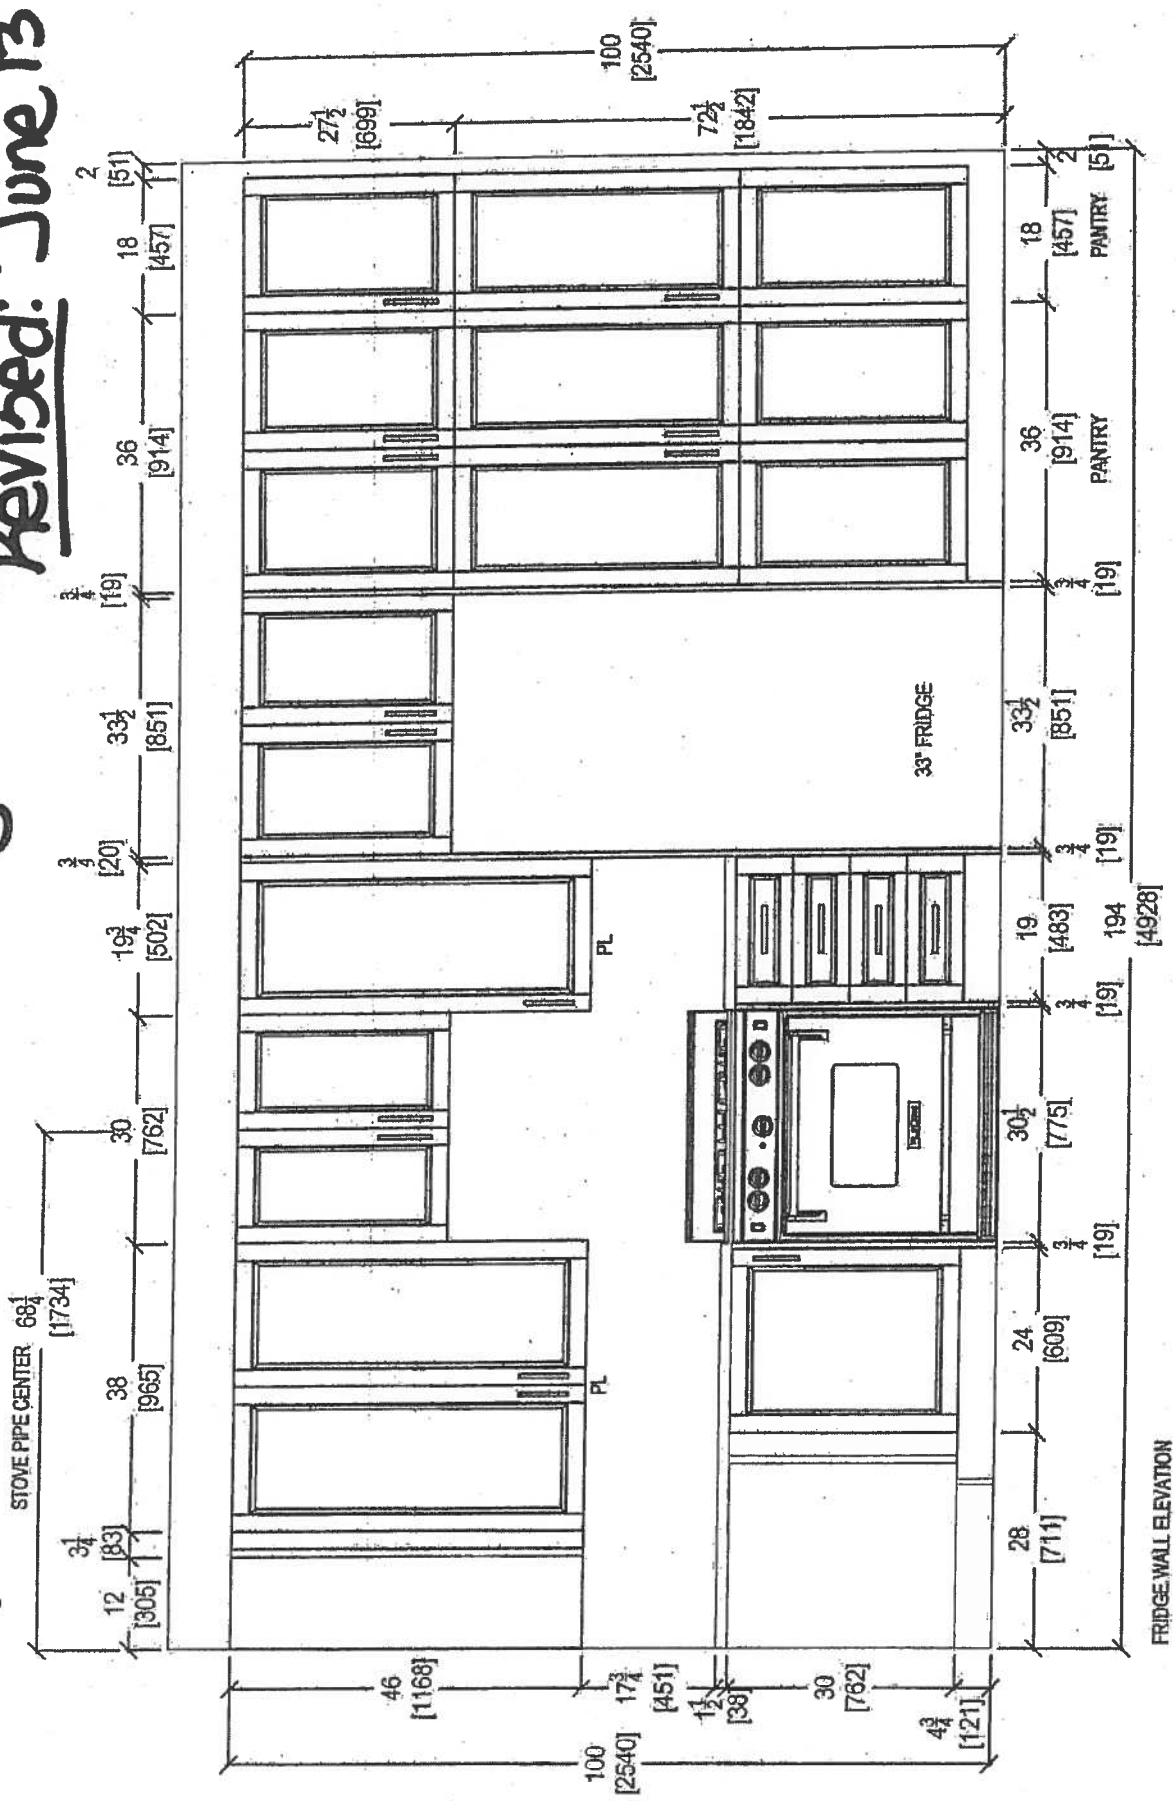

		CLIENT: ROYAL PINE HOMES		JOB NAME: UNIT 711 HMF	ROOM: KITCHEN	DRAWN BY: SK	COMMENTS: PLEASE NOTE ALL DIMENSIONS ARE NOT FINAL AND ARE SUBJECT TO CHANGE UPON FINAL SITE MEASURE	
		SITE: HAMPTON PLACE		DOOR STYLE: —	DOOR HANDLE: —	SCALE: 1/2" = 1'-0"		
		PHONE: —		FINISH: —	DRW HANDLE: —	DATE: FEB 12, 2018		
		EMAIL: —		SPECIES: —	TOP: —	PAGE: —		



Book
~~SITE~~ COPY

CONSTRUCTION SUMMARY

Hampton Place

PURCHASER: GEORGE MELO

TEL: RES.: 416-357-1989

LOT NUMBER	PHASE	HOUSE TYPE	CLOSING DATE	
711	1	NORTH SEA	19-Nov-18	

Offer	PURCHASER TO RECEIVE \$10,000(INCLUDES APPLICABLE TAXES) WORTH OF UPGRADES AT THE DECOR CENTER AT TIME OF COLOUR CHART.			
Workshee	Note:			
Offer	VENDOR AGREES TO SUPPLY AND INSTALL SMOOTH CEILINGS, AS PER PLAN, EXTENDED UPPER CABINETRY IN KITCHEN AS PER PLAN AND AS PER VENDORS SPECIFICATIONS, AND EXTENDED INTERIOR DOORS AS PER PLAN AND AS PER VENDORS SPECIFICATIONS.			
Workshee	Note:			



SITE COPY

CONSTRUCTION SUMMARY
Hampton Place

PURCHASER: GEORGE MELO

TEL: RES.: 416-357-1989

LOT NUMBER	PHASE	HOUSE TYPE	CLOSING DATE
711	1	NORTH SEA	19-Nov-18

Date Added: 14-Feb-18 Invoice Number: 7112

1 - INTERIOR DOORS - Install UPGRADE INTERIOR DOORS - TRADITIONAL - CLASSIQUE, SMOOTH - To be installed throughout suite, where applicable (See Sketch) Note:
20 - LAUNDRY ROOM - 2ND UPGRADE - PORCELAIN TILES - 20x20 PULPIS GRIS - To be installed throughout laundry room floor (To be Installed Straight) (See Sketch) Note: Includes Larger Size
1 - KITCHEN & BATHROOMS - Purchaser has DECLINED All Upgrades offered during decor appointment at the decor centre for kitchen & bathroom cabinetry. Standard Kitchen Layout & Standard Bathroom Vanities to be installed as per standard plan. (See Sketch) Note:
2 - KITCHEN - CABINETS - Install TWO (2) GLA 920/4 GLASS INSERTS, CLEAN CUT - To be installed at double door cabinet above kitchen sink. (See Sketch) Note:
1 - KITCHEN - CABINETS - CABINET INTERIOR - Install UPGRADE CABINET INTERIORS TO 510 (COCOA) LP LAMINATE (Whole Kitchen) - To be installed throughout all applicable kitchen cabinetry. (See Sketch) Note:
1 - DISCLAIMER - MATCHING INTERIOR; KITCHEN - Purchaser accepts and acknowledges the upgrade cabinet interior will NOT be an exact match to kitchen cabinetry selected. Note: Vendor is Exempt.
1 - APPLIANCE PACKAGE - Install Upgrade Appliance Package - UPGRADE PACKAGE #1 - To be installed throughout suite, where applicable. (See Sketch) Note:
1 - KITCHEN - Install WATER LINE To FRIDGE at Kitchen (See Sketch) Note:
1 - KITCHEN - Install Standard Granite Countertop - BIANCO ANTICO - To be installed throughout kitchen, where applicable. (does not include granite backsplash) (See Sketch) Note:
1 - DISCLAIMER - GRANITE COUNTERTOP; KITCHEN - Due to the many variables that can affect the pattern, colour and/or design and "pitting" of natural products, granite installed will not be identical to the samples displayed. Note: Every effort is made to provide granite countertops as close as possible but the vendor is not responsible for results which differ from the sample displayed. All countertop surfaces may have seams, and product pattern and shade can change in areas containing seams.
1 - DISCLAIMER - STONE COUNTERTOP; KITCHEN - Stone slabs vary in size & all seams are visible & the fabricator reserves the right to position the seams as necessary. Note:
1 - KITCHEN - Kitchen Sink - Install Upgrade Undermount Sink - BLANCO Quatrus U Super Single Undermount Sink - Model #401248 (See Attached) Note:
1 - KITCHEN - Kitchen Faucet - Install Upgrade Faucet - DELTA MATEO Pull-Down Kitchen Faucet (Single Hole) - Model # 9183-DST - Chrome (See Attached) Note:
1 - POWDER ROOM - Install Standard Granite Countertop - BIANCO ANTICO - To be installed throughout powder room vanity, where applicable. (Includes 3" Splash) (See Sketch) Note:



SITE COPY

CONSTRUCTION SUMMARY
Hampton Place

PURCHASER: GEORGE MELO

TEL: RES.: 416-357-1989

LOT NUMBER	PHASE	HOUSE TYPE	CLOSING DATE
711	1	NORTH SEA	19-Nov-18

Date Added: 14-Feb-18 Invoice Number: 7112

1 - ENSUITE #2 - Install Standard Granite Countertop - BIANCO ANTICO - To be installed throughout ensuite #2 vanity, where applicable. (Includes splash) (See Sketch)
Note:

1 - CLARIFICATION;
ALL BATHROOMS - Install Standard 3" Splash throughout all bathroom vanity countertops, where applicable. To Include; Powder Room, Ensuite #2 and Master Ensuite (See Sketch)
Note:

1 - DISCLAIMER - GRANITE COUNTERTOP;
POWDER ROOM & ENSUITE #2 - Due to the many variables that can affect the pattern, colour and/or design and "pitting" of natural products, granite installed will not be identical to the samples displayed
Note: Every effort is made to provide granite countertops as close as possible but the vendor is not responsible for results which differ from the sample displayed. All countertop surfaces may have seams, and product pattern and shade can change in areas containing seams.

1 - DISCLAIMER - STONE COUNTERTOP;
POWDER ROOM / ENSUITE #2 / MASTER ENSUITE - Stone slabs vary in size & all seams are visible & the fabricator reserves the right to position the seams as necessary.
Note:

1 - MASTER ENSUITE - Install Upgrade FRAMELESS GLASS ENCLOSURE To Extend Up To TOUCH the Ceiling at Master Ensuite Shower Stall (See Sketch)
Note:

1 - CLARIFICATION;
ALL BATHROOMS - Install Standard Plumbing Fixtures throughout all bathrooms, where applicable. To Include; Powder Room, Ensuite #2 and Master Ensuite (See Sketch)
Note:

1 - CLARIFICATION;
ALL BATHROOMS - DELETE Do Not Install / Supply / Credit Purchaser for builders standard ceramic bathroom accessories (toilet paper, towel bar & soap dish) throughout all bathrooms where applicable.
Note: To Include; Powder Room, Ensuite #2 and Master Ensuite (See Sketch)

1 - BONUS PACKAGE - PURCHASER HAS APPLIED \$10,000.00 (Includes Taxes) WORTH OF UPGRADE PROMOTIONAL PACKAGE TOWARDS THE PURCHASE OF UPGRADES COMPLETED AT THE DECOR CENTRE.
Note:

1 - PURCHASER HAS ATTENDED A COLOR APPOINTMENT AT THE DECOR CENTRE AND HAS DECLINED ANY ADDITIONAL UPGRADES. Purchaser accepts and acknowledges that there will be no further changes/additions/deletions to be made upon signing on February 14,2018
Note:

1 - PURCHASER AWARE AND ACCEPTS THAT ANY CHANGES MADE TO UPGRADES AFTER SIGNING THIS PURCHASERS EXTRA FORM ARE SUBJECT TO A MINIMUM ADMINISTRATION FEE OF \$1,000 PLUS A 10% HOLDBACK FEE.
Note:

This Document is Extremely Time Sensitive - Printed 10 May 18 at 16:05



Purchaser
GEORGE MELO

ecor Consulta
Melissa Di Marino

Model Type
NORTH SEA

Telephone Res. / Bus
(416) 357-1989 /

Project Hampton Place

Closing Date	Unit
19/11/2018	711

Page 1 of 3

	Flooring		Wall Tile		
	Description		Main	Accent/Insert	Pattern
MASTER ENSUITE	13x13 RUSTIC GREY (STD)	✓	8x10 GOLF GRIGIO (STD)	NONE	NONE
MAIN BATHROOM	N/A		N/A	N/A	N/A
ENSUITE #2	13x13 HELLO SILVER (STD)	✓	8x10 CARRARA MATT (STD)	NONE	NONE
POWDER ROOM	13x13 SEAL GREY (STD)	✓	N/A	N/A	N/A
KITCHEN / DINETTE	20x20 PULPIS GRIS (STRAIGHT) (STD)	✓	12x12 Twilight Mocha Glass Mosaics (STD)	NONE	NONE
FOYER	20x20 PULPIS GRIS (STRAIGHT) (STD)	✓	N/A	N/A	N/A
LAUNDRY	20x20 PULPIS GRIS (STRAIGHT) (UPG)	✓	N/A	N/A	N/A
MAIN HALL	7 1/2" Torleys Forest - Northern Cordillera 9687P (STD)	✓	N/A	N/A	N/A

Notes

Page 1 of 3

Consultant: MCK
Melissa Di Marino

Purchaser: _____
GEORGE MELO

Vendor: _____ Hampton Place

Lot: 711 Project: Hampton Place Model: NORTH SEA

Printed Feb 08, 2018 1:16 pm



* INTERIOR CLOSING SCHEME *

Purchaser GEORGE MELO	Decor Consultant Melissa Di Martino	Model Type NORTH SEA	Telephone Res. / Bus (416) 357-1989 /	Project Hampton Place	Closing Date 19/11/2018	Unit 711
--------------------------	--	-------------------------	--	--------------------------	----------------------------	-------------

Page 2 of 3

CABINETRY, VANITIES AND COUNTERTOPS

	Style	Countertop	Counter Edge	Handle / Knob
Ensuite #2	CATEGORY 2 - MAPLE - BRAZILNUT QT 2101 (STD)	☒	BIANCO ANTICO GRANITE (STD)	☒ A " EDGE (STD) 16338-195
MASTER ENSUITE	CATEGORY 2 - MAPLE - CHESTNUT QT 2503 (STD)	☒	ASPEN TERRA WHITE (STD)	☒ A " EDGE (STD) 16338-195
POWDER ROOM	CATEGORY 2 - MAPLE - CHESTNUT QT 2503 (STD)	☒	BIANCO ANTICO GRANITE (STD)	☒ A " EDGE (STD) 16338-195
KITCHEN / DINETTE	CATEGORY 2 - MAPLE - CHESTNUT QT 2503 (STD)	☒	BIANCO ANTICO GRANITE (STD)	☒ A " EDGE (STD) 16338-195
LAUNDRY ROOM	N/A		N/A	N/A

APPLIANCE PACKAGE

Upgrade Package #1

Std 31in Opening

PLUMBING FIXTURES

KITCHEN	Sink Model	UPGRADE - Blanco Quattru #401248
	Sink Faucet	UPGRADE - Delta Mateo #9183DST
TOILETS	Master Ensuite	STANDARD
	Ensuite #2	STANDARD
	Powder Room	STANDARD
VANITY FAUCETS	Master Ensuite	STANDARD
	Ensuite #2	STANDARD
	Powder Room	STANDARD
VANITY SINKS	Master Ensuite	STANDARD
	Ensuite #2	STANDARD
	Powder Room	STANDARD
SHOWER STALL / TUBS	Master Ensuite Shower Stall	STANDARD
	Master Ensuite Tub	N/A
	Ensuite #2, Tub	STANDARD

Trim

Baseboard & Casing	STANDARD
Interior Doors	UPGRADE - CLASSIQUE SMOOTH

Levers

Door Height	STANDARD
-------------	----------

Cornice Moulding / Medallion

Foyer	STANDARD - #CTR-611
Living Room	STANDARD - #CTR-611
Dining Room	STANDARD - #CTR-611
Den	NONE
Master Bedroom	NONE
Bedroom 2	NONE
Bedroom 3	N/A

Fireplace

Fireplace	N/A
Location Flooring	N/A
Style	N/A
Finish	N/A
Marble	N/A
Hearth	N/A


MISC. INSTALLATIONS


Ceramic Accessories (installed by Vendor)	☒ Yes ☐ No
Bathroom Mirrors (installed by Vendor)	☒ Yes ☐ No
Wire Shelving - Closet (installed by Vendor)	☒ Yes ☐ No


Paint Throughout

Walls	STANDARD - CAMEO WHITE
Trim	STANDARD - WHITE


Page 2 of 3

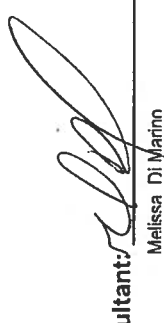Decor Consultant:  Melissa Di Martino

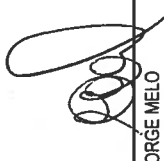
Purchaser:  GEORGE MELO

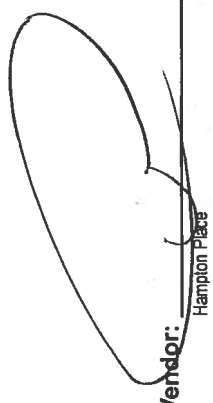Vendor:  Hampton Place

OUTLET
HAMPTON

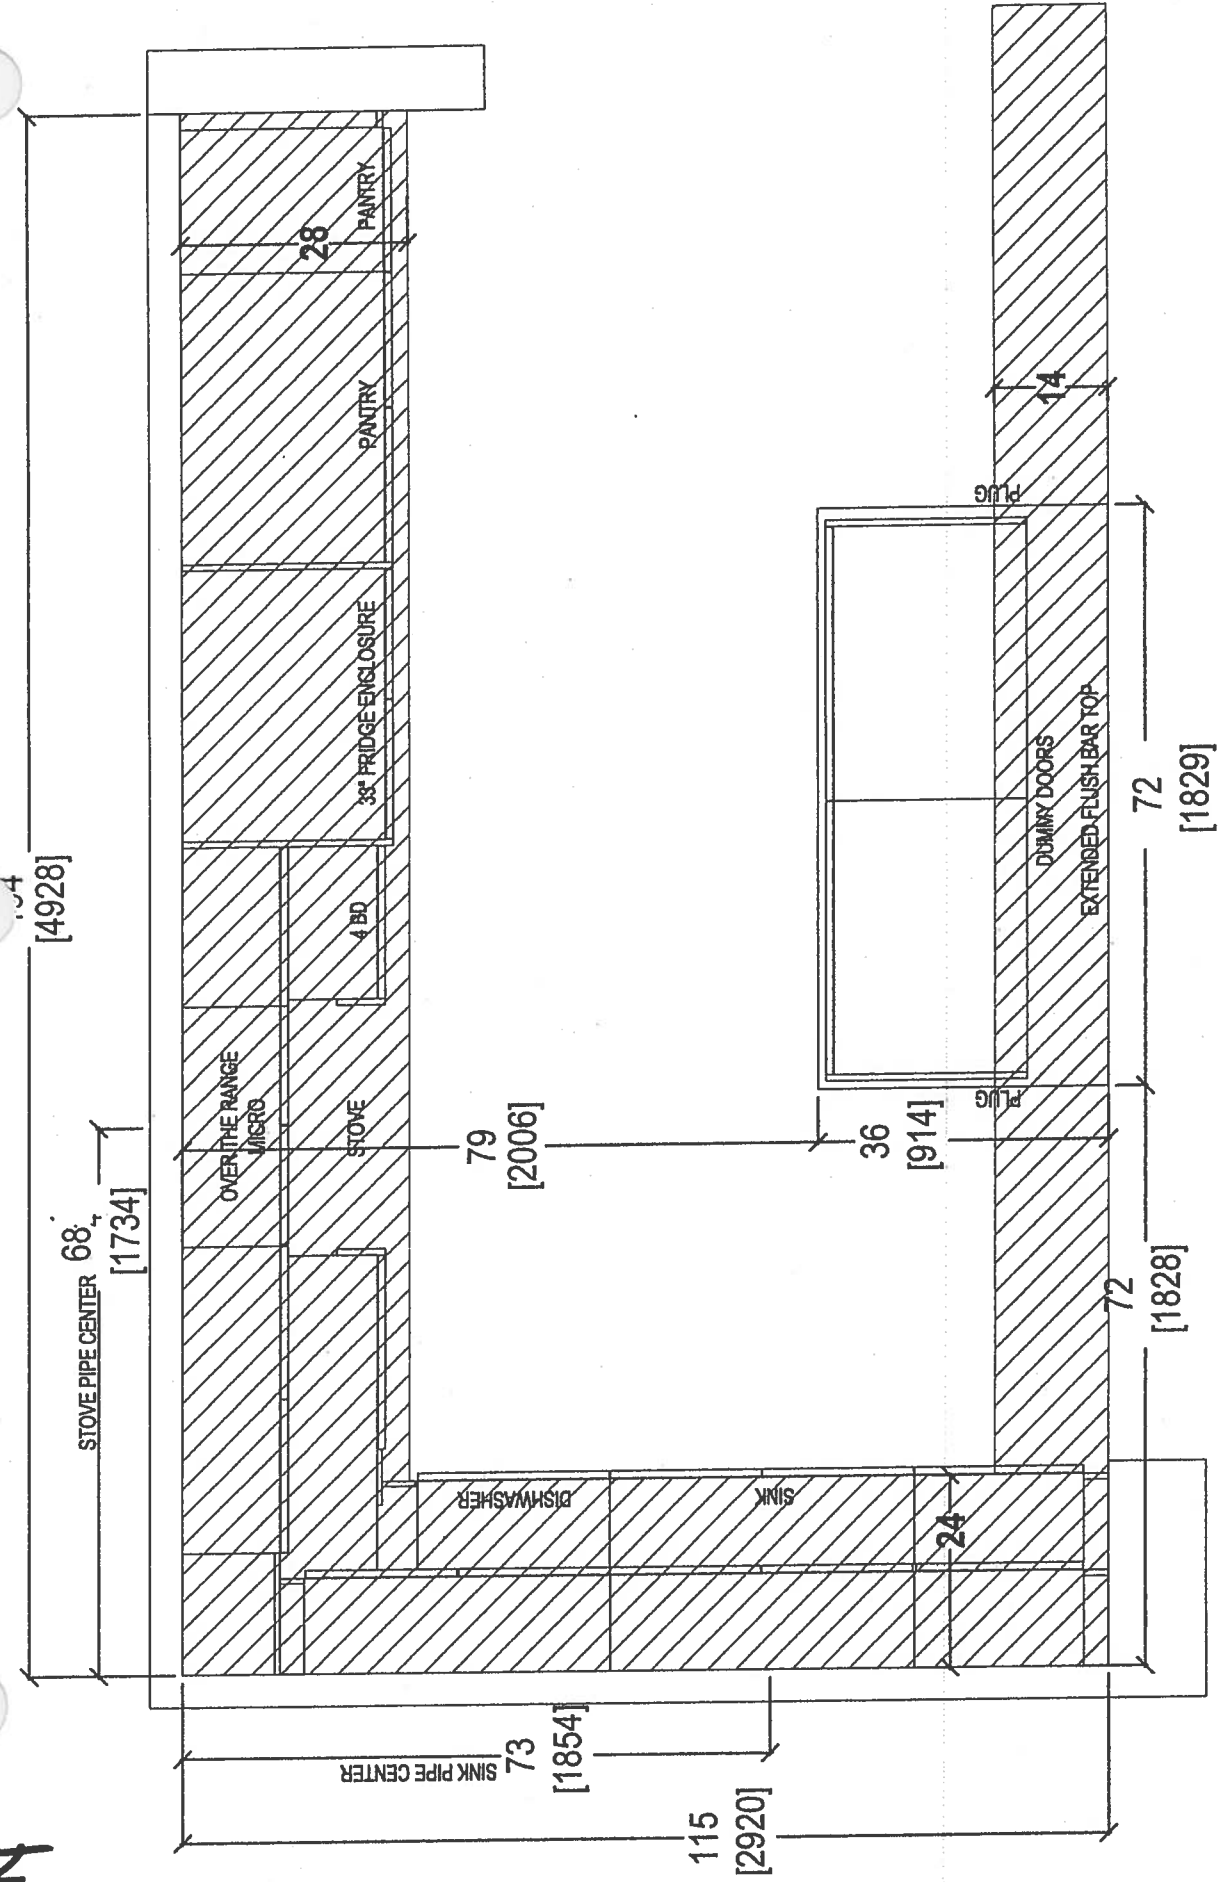

	CLIENT: ROYAL PINE HOMES		JOB NAME: UNIT 711 HMP	ROOM:	KITCHEN FLOOR PLAN	DRAWN BY: SK	COMMENTS: PLEASE NOTE ALL DIMENSIONS ARE NOT FINAL AND ARE SUBJECT TO CHANGE UPON FINAL SITE MEASURE	
	SITE: HAMPTON PLACE	DOOR STYLE: —	DOOR HANDLE: —	DOOR HANDLE: —	SCALE: 1/2" = 1' - 0"			
	PHONE: —	FINISH: —	DRW HANDLE: —	DRW HANDLE: —	DATE: APRIL 28, 2018			
	EMAIL: —	SPECIES: —	TOP: —	TOP: —	PAGE: —			

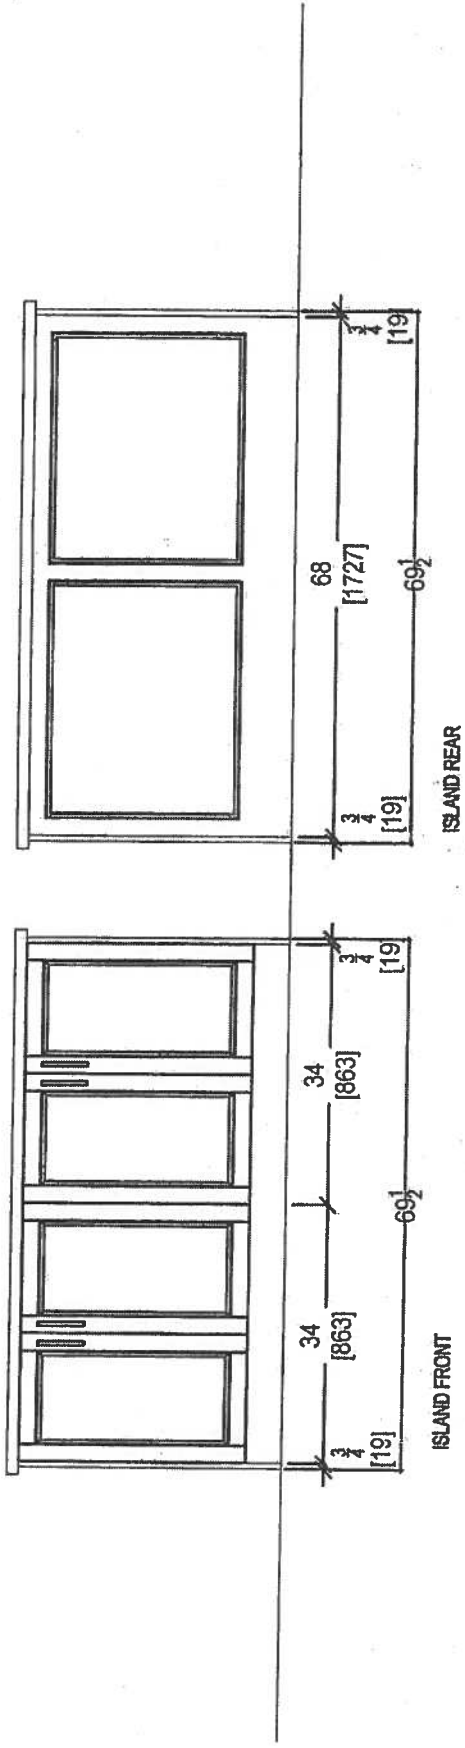







QTH



80 SANTE DRIVE, VAUGHAN, ON L4K 3C4,
T: 416.746.1811 F: 905.761.5901

 your kitchen, your taste. 80 SANTE DRIVE, VAUGHAN, ON L4K 3C4, T: 416.746.1811 F: 905.761.5801		CLIENT: ROYAL PINE HOMES	JOB NAME: UNIT 711 HMP	ROOM: KITCHEN	DRAWN BY: SK	COMMENTS: PLEASE NOTE ALL DIMENSIONS ARE NOT FINAL AND ARE SUBJECT TO CHANGE UPON FINAL SITE MEASURE
SITE: HAMPTON PLACE		DOOR STYLE: —	DOOR HANDLE: —	SCALE: 1/2" = 1' - 0"		
PHONE: —		FINISH: —	DRW HANDLE: —	DATE: FEB 12, 2018		
EMAIL: —		SPECIES: —	TOP: —	PAGE: —		

INSTALL 3" SPRAY

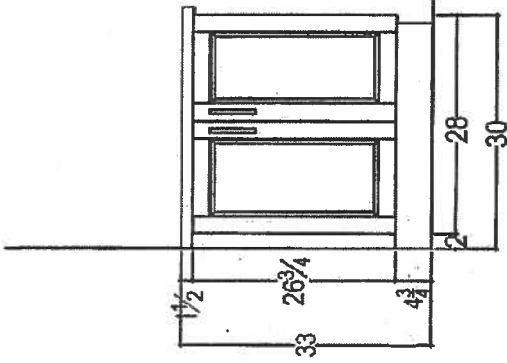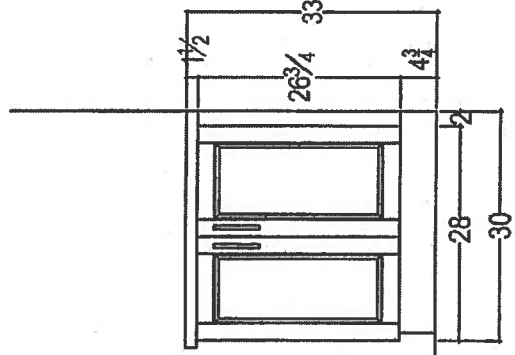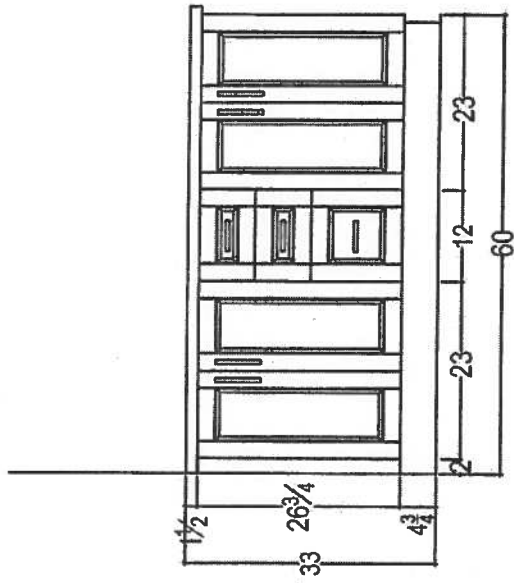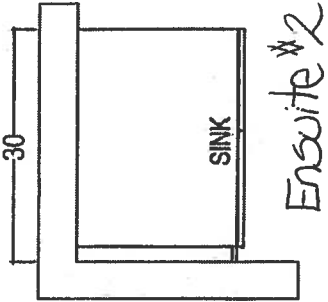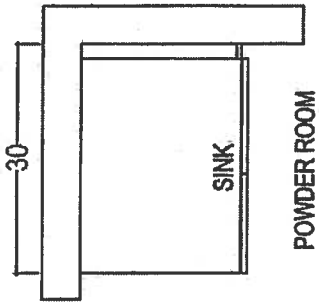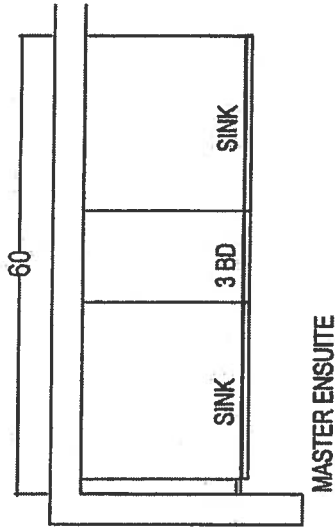

00



80 SANTE DRIVE, VAUGHAN, ON L4K 3C4,
T: 416.746.1811 F: 905.761.5901

CLIENT: ROYAL PINE HOMES	JOB NAME: UNIT 711 HMP	ROOM:	VANITIES	DRAWN BY: SK	COMMENTS: PLEASE NOTE ALL DIMENSIONS ARE NOT FINAL AND ARE SUBJECT TO CHANGE UPON FINAL SITE MEASURE
SITE: HAMPTON PLACE	DOOR STYLE: —	DOOR HANDLE: —	SCALE: 1/2" = 1' - 0"		
PHONE: —	FINISH: —	DRW HANDLE: —	DATE: FEB 12, 2018		
EMAIL: —	SPECIES: —	TOP: —	PAGE: —		

Suite 711
Hampton

Upgrade
Package I

WRB322DMBM



Whirlpool®

33 1/2 inches wide Bottom-Freezer Refrigerator with
SpillGuard™ Glass Shelves - 22 cu. ft

<http://www.whirlpool.com>

Key Features:

- SpillGuard™ Glass Shelves
- Adaptive Defrost / *Factory Installed Icemaker*
- FreshFlow™ Produce Preserver
- LED Interior Lighting
- ENERGY STAR® Qualified

Product Dimensions:

Height: 70

Width: 32 5/8

Depth: 33 3/8

Electrical Requirements:

15


Additional Information:

[Use And Care Guide](#)

[Dimension Guide](#)

[Energy Guide](#)

[Warranty Certificate](#)

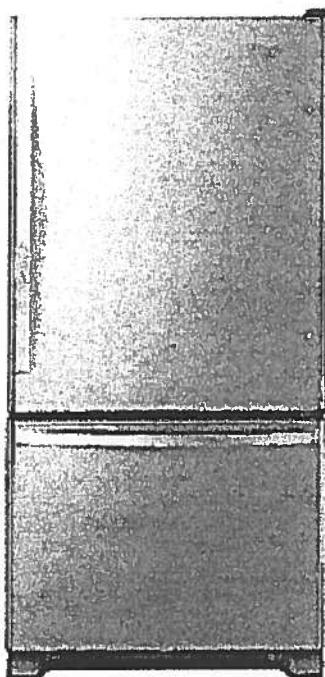

INVESTED
IN
AMERICA



©Registered trademark/TM Trademark of Whirlpool, U.S.A. © 2018 Whirlpool Corporation. All Rights Reserved.
All other trademarks are owned by their respective companies.

Because Whirlpool Corporation policy includes a continuous commitment to improve our products, we reserve the right to change materials and specifications without notice. We also reserve the right to discontinue or transition products without notice.

Manufacturer's Suggested Retail Price (MSRP) and Minimum Advertised Price (MAP) provided for reference purposes only. Dealer alone determines advertised and retail prices.

Created On: Tuesday, March 14, 2017 11:30:08

Suite 711
Hampton

Upgrade
Package 1



WEE745H0FS

Whirlpool®

<http://www.whirlpool.com>

6.4 Cu. Ft. Slide-In Electric Range with True
Convection



Key Features:

- Frozen Bake™ Technology
- True Convection Cooking
- FlexHeat™ Triple Radiant Element
- Convection Conversion
- AquaLift® Self-Cleaning Technology
- Temperature Sensor
- Rapid Preheat
- 6.4 Cu. Ft. Capacity
- Easy-Wipe Ceramic Glass Cooktop
- Large Oven Window
- Max Capacity Rack
- Hidden Bake Element

Product Dimensions:

Height: 36

Width: 29 7/8

Additional Information:

[Use And Care Guide](#)

[Dimension Guide](#)

[Installation Guide](#)

[Warranty Certificate](#)

INVESTED
IN
AMERICA



®Registered trademark/TM Trademark of Whirlpool, U.S.A. © 2016 Whirlpool Corporation. All Rights Reserved.
All other trademarks are owned by their respective companies.
Because Whirlpool Corporation policy includes a continuous commitment to improve our products, we reserve the right to change materials and specifications without notice. We also reserve the right to discontinue or transition products without notice.
Manufacturer's Suggested Retail Price (MSRP) and Minimum Advertised Price (MAP) provided for reference purposes only. Dealer alone determines advertised and retail prices.
Created On: Friday, January 27, 2017 10:46:47

Suite 711
Hampton

Upgrade
Package 1



YWMH76719CS



<http://www.whirlpool.com>

9 cu. ft. Microwave Hood Combination with
TimeSavor™ Plus True Convection

Key Features:

- TimeSavor™ Plus True Convection Cooking System
- Steam Cooking
- Sensor Cooking
- AccuPop™ Cycle
- CleanRelease® Non-Stick Interior
- SteamClean Option
- Integrated Hidden Vent and Console
- Auto Adapt Fan
- Recessed, Stoppable Glass Turntable
- Universal Microwave Steamer
- 1.9 cu. ft. Capacity
- 1,100 Watts Cooking Power

Product Dimensions:

Height: 17 1/8

Width: 29 15/16

Depth: 18 1/2

Electrical Requirements:

15 or 20. 120 V.

Additional Information:


Use And Care Guide

Installation Guide

Warranty Certificate

Available in:

 Stainless Steel

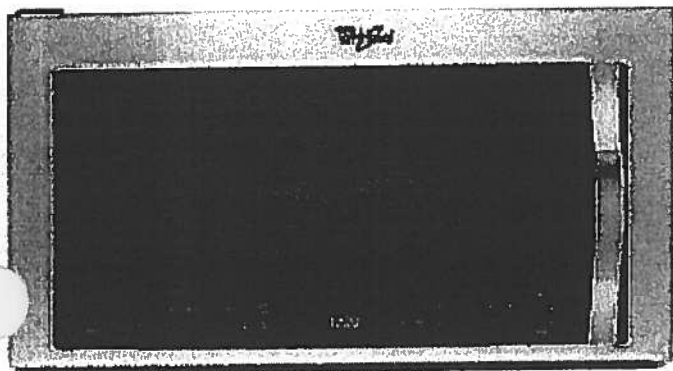

©Registered trademark/TM Trademark of Whirlpool, U.S.A. © 2013 Whirlpool Corporation. All Rights Reserved.
All other trademarks are owned by their respective companies.
Because Whirlpool Corporation policy includes a continuous commitment to improve our products, we reserve the right to change materials and specifications without notice. We also reserve the right to discontinue or transition products without notice.
Manufacturer's Suggested Retail Price (MSRP) and Minimum Advertised Price (MAP) provided for reference purposes only. Dealer alone determines advertised and retail prices.
Created On: Monday, March 14, 2016 13:16:48

Suite 711 Hampton Upgrade Package 1

WDTA50SAHZ



Whirlpool®

<http://www.whirlpool.com>

Contemporary Design. Stainless Steel Tub
Dishwasher with TotalCoverage Spray Arm

Key Features:


- Sensor Cycle
- TotalCoverage Spray Arm
- 1-Hour Wash Cycle
- Tap Touch Controls

Product Dimensions:

Height: 34 1/2
Width: 23 7/8
Depth: 24 1/2

Additional Information:

[Use And Care](#)
[Dimension Guide](#)
[Installation Guide](#)
[Energy Guide](#)
[Warranty](#)

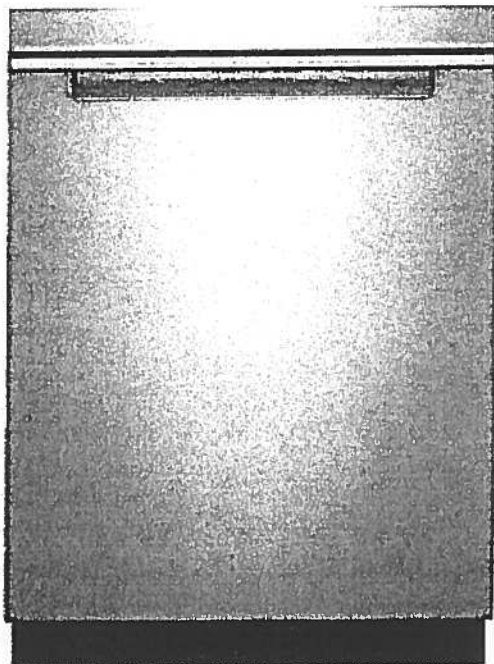

Available in:

● Black

Fingerprint Resistant Sunset Bronze

Fingerprint Resistant Black Stainless

○ White

Fingerprint Resistant Stainless Steel

INVESTED
IN
AMERICA



®Registered trademark/TM Trademark of Whirlpool, U.S.A. © 2016 Whirlpool Corporation. All Rights Reserved. All other trademarks are owned by their respective companies.

Because Whirlpool Corporation policy includes a continuous commitment to improve our products, we reserve the right to change materials and specifications without notice. We also reserve the right to discontinue or transition products without notice.

Manufacturer's Suggested Retail Price (MSRP) and Minimum Advertised Price (MAP) provided for reference purposes only. Dealer alone determines advertised and retail prices.

Suite 711
Hampton

Upgrade
Package 1




WFW75HEFW



<http://www.whirlpool.com>

5 cu. ft. Front Load Washer with Precision
Dispense

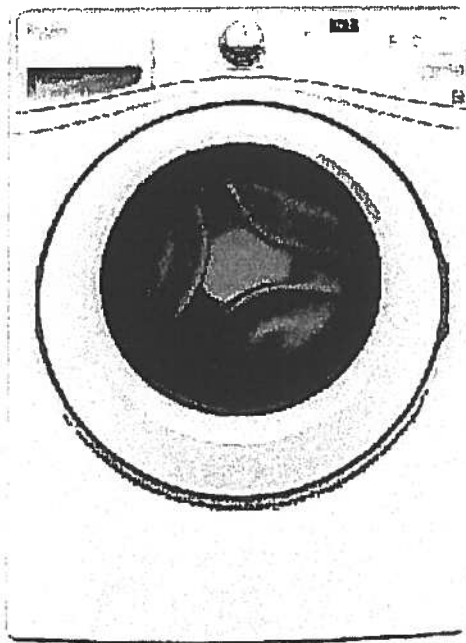

Key Features:

- Precision Dispense
- Adaptive Wash Technology
- Smooth Wave Stainless Steel Wash Basket
- 4.5 cu. ft. Capacity
- ENERGY STAR® Qualified

Product Dimensions:

Height: 39 3/4

Width: 27

Depth: 33 5/16

Electrical Requirements:

15 or 20. 120 V.

Additional Information:

[Use And Care Guide](#)

[Dimension Guide](#)

[Installation Guide](#)

[Energy Guide](#)

[Warranty Certificate](#)

INVESTED
IN
AMERICA



®Registered trademark/TM Trademark of Whirlpool, U S A. ©2013 Whirlpool Corporation. All Rights Reserved.
All other trademarks are owned by their respective companies.
Because Whirlpool Corporation policy includes a continuous commitment to improve our products, we reserve the right to change materials and specifications without notice. We also reserve the right to discontinue or transition products without notice.
Manufacturer's Suggested Retail Price (MSRP) and Minimum Advertised Price (MAP) provided for reference purposes only. Dealer alone determines advertised and retail prices.
Created On: Wednesday, March 23, 2016 11:51:03

Suite 711
Hampton

Upgrade
Package 1



YWED75HEFW

Whirlpool®

<http://www.whirlpool.com>

5 cu. ft. Duet® High Efficiency Front Load Electric
Dryer with ENERGY STAR®

MSRP: \$0.00

Key Features:

- Advanced Moisture Sensing System
- Quad Baffles
- Tap Touch Controls with Memory
- EcoBoost™ Option
- Wrinkle Shield™ Plus Option
- Undercounter Installation
- 7.4 Cu. Ft. Capacity
- ENERGY STAR® Qualified

Product Dimensions:

Height: 39

Width: 27


Depth: 31

Additional Information:

[Use And Care](#)

[Installation Guide](#)

[Warranty](#)

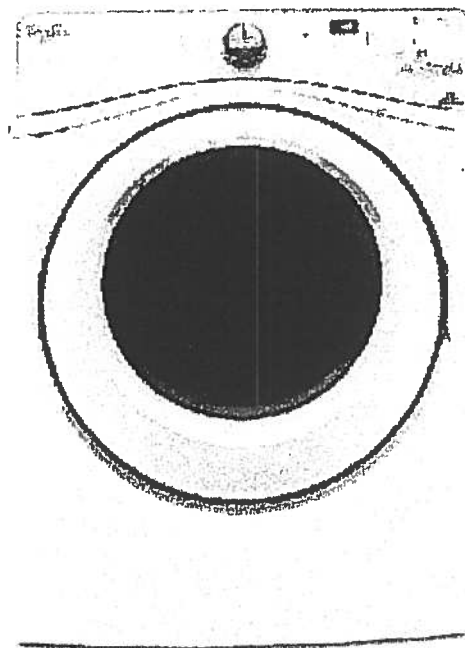

Available in:

☐ White

INVESTED
IN
AMERICA

ADA
Compliant

®Registered trademark/TM Trademark of Whirlpool, U.S.A. © 2016 Whirlpool Corporation All Rights Reserved. All other trademarks are owned by their respective companies.

Because Whirlpool Corporation policy includes a continuous commitment to improve our products, we reserve the right to change materials and specifications without notice. We also reserve the right to discontinue or transition products without notice.


Manufacturer's Suggested Retail Price (MSRP) and Minimum Advertised Price (MAP) provided for reference purposes only. Dealer alone determines advertised and retail prices.

Upgrade Kitchen Sinks




BLANCO

Suite 711
Hampton

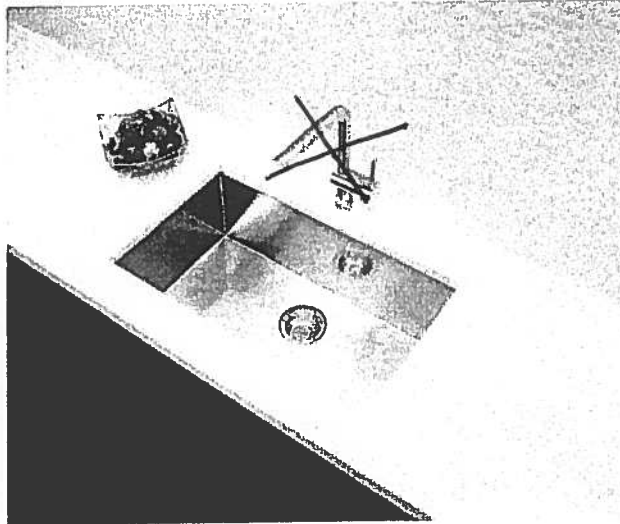

**Blanco Quatrus U Super Single
Undermount Sink
#401248**

See UPG. Faucet

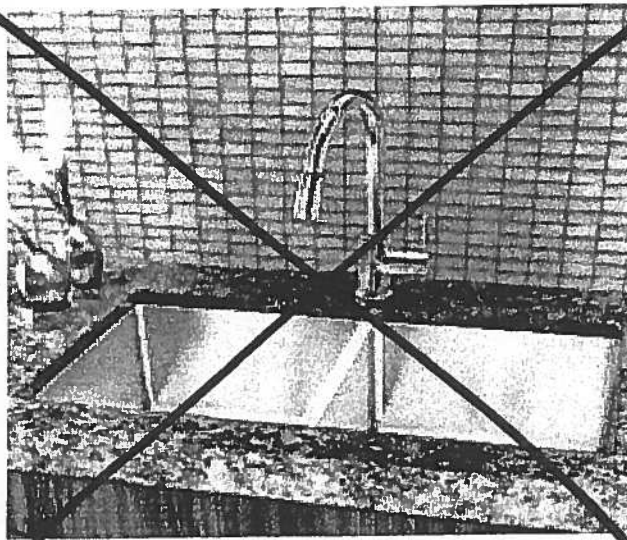


**Blanco Quatrus R15 Two Bowl
Undermount Sink
#401519**




Boite 711
Hampton


KITCHEN UPGRADE OPTIONS

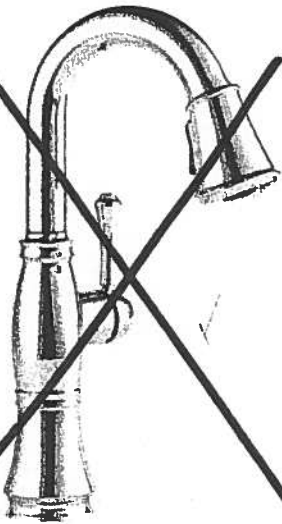

Delta Cassidy Pull Down Kitchen
#9997-DST

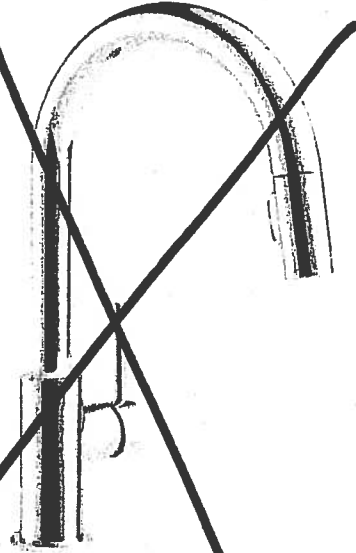

Delta Trinsic Pull Down Kitchen
#9159-DST

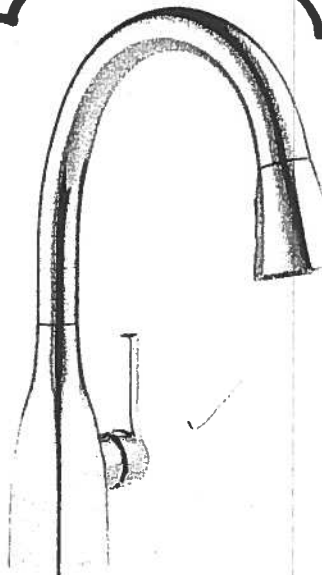

Delta Mateo Pull Down Kitchen
#9183-DST

RECEIVED
APR 4 2005

Countertop Edges

Suite 711

Hampton

February 14, 2018



CONNOLLY

Marble & Granite Ltd.

EDGE DETAILS


004

A.




STRAIGHT EDGE
(STANDARD - 3/4")

Standard:
Kitchen
Powder Room
Master Ensuite
Ensuite #2

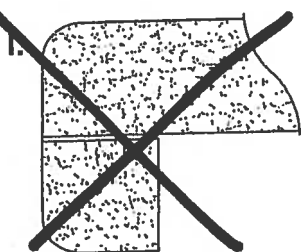

DOUBLE TOP "D" EDGE
(STANDARD - 1 1/2")

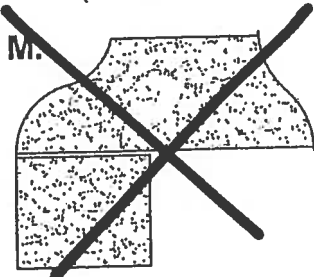

OGEE - SQUARE EDGE
(MED./HIGH - 1 1/2")

EDGING UP-GRADE OPTIONS