

WHE +15



Wainscott ORIGINAL LAYDUT.

1,379 SQ FT plus 317 sq. ft. of terrace area

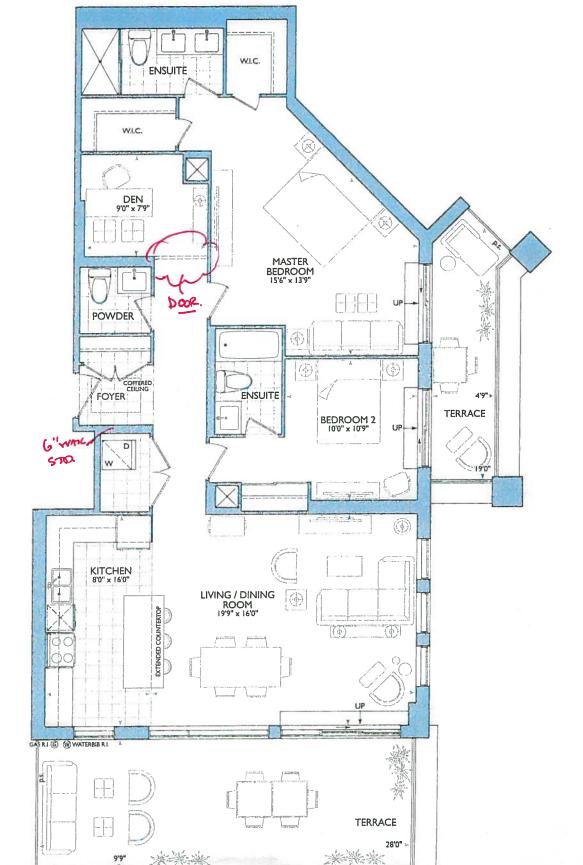

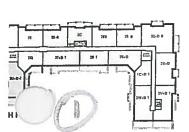





PURCHASER'S EXTRAS (PE)

ADDITION

Hampton Place - Braylea Investments Inc.

PURCHASERS: ALAN I. HERSH and ANNE HERSH

TEL: RES.: 905-737-0750 BUS.: 416-568-1231

	UMBER 13	PHASE 1	HOUSE TYPE WAINSCOTT	REG. PLAN #	
ltem	QTY		Description		Addition to Purchase Price
1	Lights) applicate	at kitchen. To be inst ble. (See Attached Q7	(X1) ADDITIONAL PUCK LIGHTS (Sam alled below upper cabinet (Above the sink FK Layout for Location) * THERE WILL NOW BE A TOTAL ITCHEN	() in the kitchen , where	
2	SIGNIN	G THIS PURCHASE	AND ACCEPTS THAT ANY CHANGES ERS EXTRA FORM ARE SUBJECT TO A F \$1,000. PLUS A 10% HOLDBACK FEE	MINIMUM	ER
	8				Ab Total IST tal
thi	s order is to e Vendor wi	be cancelled and any dep ill undertake to incorpora work covered by the extr	progressed beyond the point where the items cover to sit paid in connection with the same is to be refure the work covered by the sales extra in the contains not carried out. In that event, any monies paid to the same whether the transaction of Purchase	nded to the Purchaser. struction of the house but will not t I in connection with the same shall t	be liable to the purchaser in any way, if for be returned to the Purchaser.

- It is understood and agreed that if for any reason whatsoever the transaction of Purcha the Purchaser(s).

- Extras or changes will not be processed unless signed by the Vendor.
 These extras may not be amended without the written consent of Braylea Investments Inc..
 The Purchaser(s) and the Vendor acknowledge and agree that this form shall not be deemed to be part of the Agreement of Purchase and Sale entered into between them, 6.

- nor an addendum thereto.

 No Estimates or orders will be accepted once construction has commenced.

 Prices are estimates only and guaranteed for a period of 5 days only.


 Any cancellations to this order, providing they can be cancelled, are subject to a \$500 minimum administration charge and a 10% cancellation charge for the total


				J.	
Bonus Package From Bonus Total PE# 7,116 - March 16 2018 PE# 7,153 - April 24, 2018 Remaining Balance		Sale dated June 03, 20	17		
Payment Summary Paid By Amendment Total Payment:	Amount	<u>Detail</u>			

		24-Jul-19	VENDOR:	
ANNE HERSH		DATE		PER: Braylea Investments Inc.
	u 3			

Decor	Builder	Purchaser	Printed: 24-Jul-19 at 10:06 am
•			*******Enter GST number*****

PURCHASER:

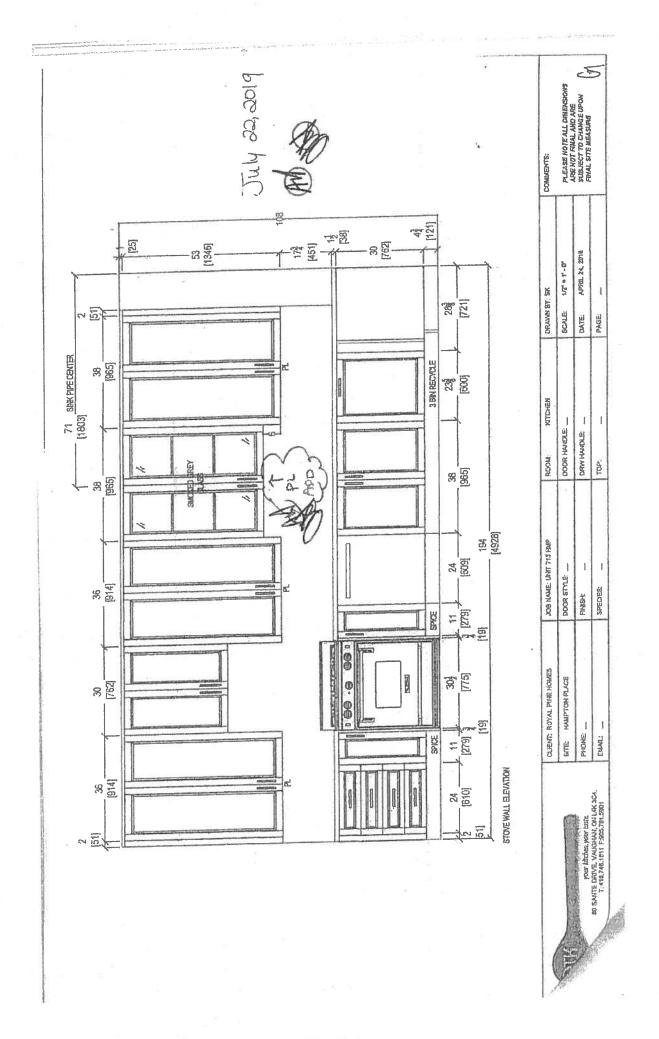

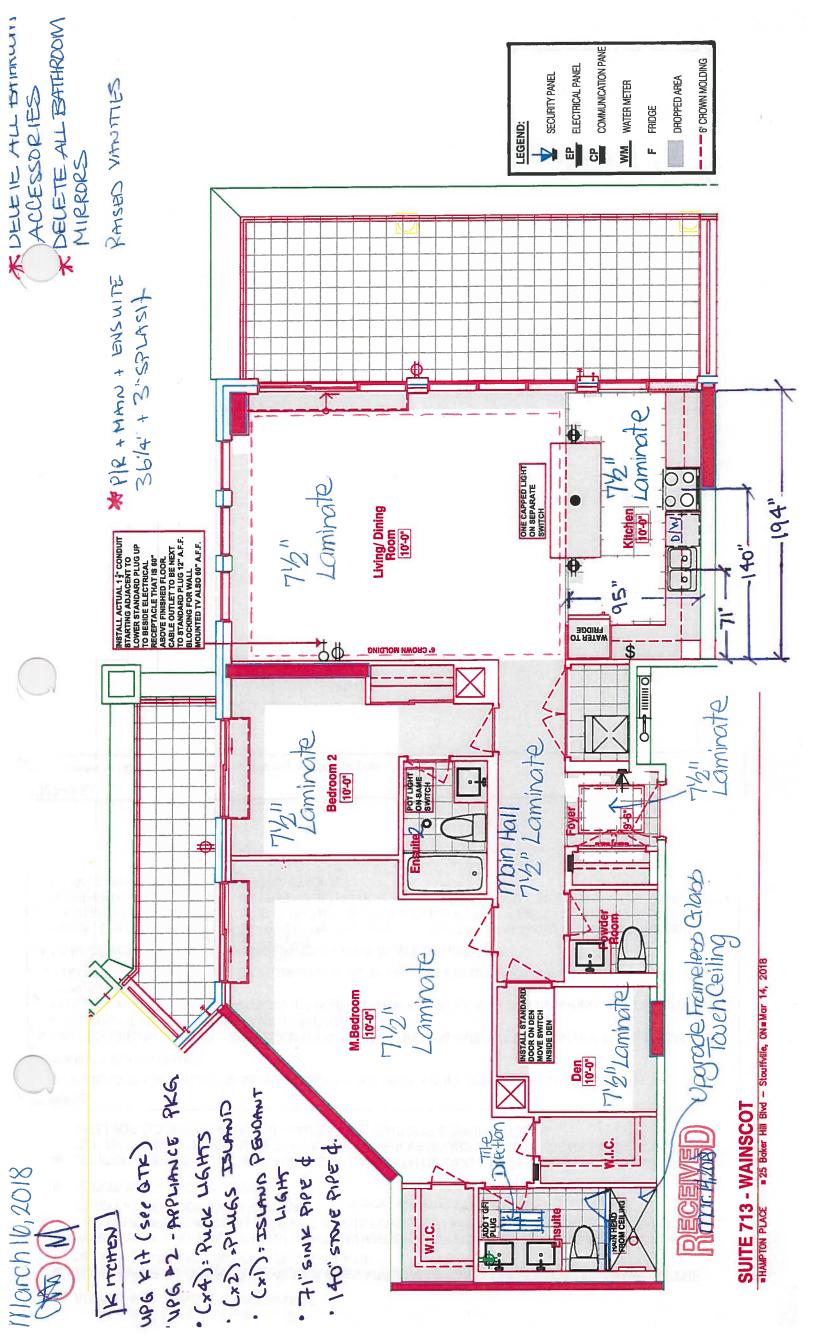



LOT NUMBER PHASE



CONSTRUCTION SUMMARY

Hampton Place

HOUSE TYPE

PURCHASERS: ALAN I. HERSH and ANNE HERSH

TEL: RES.: 905-737-0750 BUS.: 416-568-1231

CLOSING DATE

	ABER	I I	WAINSCOTT	20-Nov-18						
			Mindoori							
Offer	ADDIT	IONAL	- SINGLE PARKING UNIT	40.40.40.40.40.40.40.40.40.40.40.40.40.4						
Lorkshee	Note:									
	<u> </u>									
Orier	PURCE	IASER T	O RECEIVE \$5,000(INCLUDES APPLICABLE TAXES) WORTH	OF UPGRADES AT THE DECOR						
			IME OF COLOUR CHART.	,						
Vorkshee	Note:									
			· · · · · · · · · · · · · · · · · · ·							
Offer	PURCE	IASER V	WILL HAVE THE OPTION TO CHANGE TILES TO STANDARD	LAMINATE FLOORING, AS PER						
			ANDARD SAMPLES, IN THE FOYER AND KITCHEN AT THE T	TME OF THE COLOUR CHART AT NO						
V-ul-d	ADDITIONAL CHARGE Note:									
Vorkshee	Note.									
Offer	LADDIT	TAIGNE	LOCKED IDEE							
		IONAL	- LOCKER UNIT							
Vorkshee	Note:									
	<u> </u>									
Offer			EES TO SUPPLY AND INSTALL SMOOTH CEILINGS, AS PËR N KITCHEN AS PER PLAN AND AS PER VENDORS SPECIFICA							
			N KITCHEN AS PER PLAN AND AS PER VENDORS SPECIFICA R PLAN AND AS PER VENDORS SPECIFICATIONS.	THORS, AND EXTENDED INTERIOR						
Vorkshee	Note:	JADIL	CIEMVIND ADIEK VENDORD DI EDITORITORO.							
Offer	IVENDO	OR TO I	NSTALL STANDARD DOOR ON DEN AS PER ATTACHED PLA	N.						
Upgrade	Note:									
орышио										
Offer	RAINH	EAD FR	OM CEILING IN MASTER ENSUITE SHOWER, FROM VENDO	RS STANDARD SAMPLES						
rade	Note:									
Offer	WATE	R LINE	TO FRIDGE							
	Note:	K DII ID	10114562							
Opgrade										
Offer	CADDE	D CEIL	NG OUTLET, CENTERED OVER ISLAND, ON SEPARATE SW	TTCH (SWITCH TO BE LOCATED IN						
Office			OTHER KITCHEN LIGHT SWITCHES)	TICH (SWITCH TO BE LOCATED IN						
Upgrade	Note:		orizina di zioni a mi oriza)							
Offer	ONE (1) POT L	IGHT TO BE CENTERED BETWEEN BATHROOM WALL AND	TUB IN BEDROOM 2 ENSUITE (NOT						
	ON SEI		SWITCH)	,						
Upgrade	Note:									
	<u></u>									
Offer	ADDIT	IONAL	GFI RECEPTACLE ON SHARED WALL IN MASTER ENSUITE,	AS PER SKETCH						
Upgrade	Note:									
-	<u> </u>									
Offer	VENDO	OR NOT	TO INSTALL CERAMIC ACCESSORIES IN ALL BATHROOMS							
Upgrade	Note:									
Offer	INSTAI	LL ACT	UAL 2 INCH CONDUIT STARTING ADJACENT TO LOWER ST	ANDARD PLUG UP TO BESIDE						
	ELECT	RICAL I	RECEPTACLE THAT IS 60 INCHES ABOVE FINISHED FLOOR.	CABLE OUTLET TO BE NEXT TO						
			JUG 12 INCHES ABOVE FINISHED FLOOR. BLOCKING FOR V	VALL MOUNTED TV ALSO 60 JULE						
ade	Note:	4BOVE	FINISHED FLOOR (LIVING ROOM)							



SITE COPY

CONSTRUCTION SUMMARY

Hampton Place

PURCHASERS: ALAN I. HERSH and ANNE HERSH

TEL: RES.: 905-737-0750 BUS.: 416-568-1231

LOT NUMBER	PHASE	HOUSE TYPE	CLOSING DATE	
713	1	WAINSCOTT	20-Nov-18	

Date Added: 24-Apr-18

Invoice Number: 7153

- CLARIFICATION:

BATHROOMS - DELETE Do Not Install / Supply / Credit Purchaser for builders' standard Bathroom Mirrors, throughout all bathrooms, where icable. To Include; Powder Room, Ensuite #2 and Master Ensuite (See Sketch)

Note:

1 - PURCHASER AWARE AND ACCEPTS THAT ANY CHANGES MADE TO UPGRADES AFTER SIGNING THIS PURCHASERS EXTRA FORM ARE SUBJECT TO A MINIMUM ADMINISTRATION FEE OF \$1,000 PLUS A 10% HOLDBACK FEE. Note:

Date Added: 16-Mar-18

Invoice Number: 7116

1 - CLARIFICATION - REFER TO APAS;

FOYER & KITCHEN - Install Standard Laminate Flooring throughout Foyer and Kitchen in lieu of builders standard porcelain tiles. (See Sketch) Note:

1 - CLARIFICATION; REFER TO APAS;

LIVINGROOM - Standard electrical outlet to be installed at standard height beside conduit pipe Additional electrical outlet to be installed beside conduit pipe & standard cable rough-in Approx. 60" AFF (See Attached Sketch)

Note: As per Vince at Head-Office

1 - LAUNDRY ROOM - 1ST UPGRADE - CERAMIC TILES - 13x13 RUSTIC GREY - To be installed throughout laundry room floor (See Sketch)

Note:

MASTER ENSUITE - 1ST UPGRADE - PORCELAIN TILES - 12x24 H-STONE LIGHT GREY - To be installed throughout master ensuite : (To be Installed Straight) (See Sketch)

Note: Includes Larger Size

105 - MASTER ENSUITE - 1ST UPGRADE - PORCELAIN TILES - 12x24 H-STONE LIGHT GREY - To be installed throughout master ensuite shower stall. (To be Installed Horizontally / Stacked) (See Sketch)

Note: Includes Larger Size

1 - KITCHEN & BATHROOMS - SEE QUALITY TOPS & KITCHENS FOR ALL KITCHEN & BATHROOMS UPGRADES / LAYOUT. (See Attached QTK Paperwork)

Note:

1 - KITCHEN - CABINETRY HARDWARE - UPGRADE PACKAGE #1 - HANDLE STYLE # 53529-G10 - To be installed throughout kitchen cabinetry, where applicable. (See Sketch)

Note:

1 - APPLIANCE PACKAGE - Install Upgrade Appliance Package - UPGRADE PACKAGE #2 - To be installed throughout suite, where applicable. (See Sketch)

Note:

1 - KITCHEN - 2ND UPGRADE - CAESARSTONE COUNTERTOP - 5141 FROSTY CARRINA - To be installed throughout kitchen, where applicable (Does not include backsplash) (See Sketch)

Note:

)=

1 - KITCHEN - COUNTERTOP EDGING - Install UPGRADE " I " EDGING - To be installed throuhgout kitchen countertop, where applicable. (See Sketch)

Note:

1 - DISCLAIMER - STONE COUNTERTOP;

KITCHEN - Stone slabs vary in size & all seams are visible & the fabricator reserves the right to position the seams as necessary. Note:

1 - KITCHEN - Kitchen Backsplash - DELETE - Do Not Install / Supply or Credit Purchaser for Builders Standard Kitchen Backsplash (See Sketch)

Note:



SITE COPY

CONSTRUCTION SUMMARY

Hampton Place

PURCHASERS: ALAN I. HERSH and ANNE HERSH

TEL: RES.: 905-737-0750 BUS.: 416-568-1231

I OTT NUMBER	PHASE	HOUSE TYPE	CLOSING DATE	
LOT NUMBER 713	I 1	WAINSCOTT	20-Nov-18	

Date Added: 16-Mar-18

Invoice Number: 7116

KITCHEN - Kitchen Sink - Install Upgrade Undermount Sink - BLANCO Quatrus U Super Single Undermount Sink - Model # 401248 (See hed)

. .Jle:

1 - KITCHEN - Kitchen Faucet - Install Standard Faucet - DELTA Chrome Pull-Out Kitchen Faucet (Single Hole) - Model # 469LF - Chrome Note:

1 - CLARIFICATION;

ALL BATHROOMS - Install RAISED VANITY HEIGHT throughout all bathroom vanities, where applicable. To Include; Powder Room, Master Ensuite and Ensuite #2 (See Attached QTK Paperwork)

Note:

1 - CLARIFICATION;

ALL BATHROOMS - Install Standard 3" Splash throughout all bathroom vanity countertops, where applicable. To Include; Powder Room, Ensuite #2 and Master Ensuite (See Sketch)

Note:

1 - DISCLAIMER - STONE COUNTERTOP;

POWDER ROOM / ENSUITE #2 / MASTER ENSUITE - Stone slabs vary in size & all seams are visible & the fabricator reserves the right to position the seams as necessary.

Note:

1 - MASTER ENSUITE - Install FRAMELESS GLASS SHOWER ENCLOSURE at Master Ensuite shower stall. Glass to Extend Up to TOUCH the wiling (See Sketch)

1 - CLARIFICATION - REFER TO APAS;

MASTER ENSUITE - Install Rain Shower Head from Ceiling at Master Ensuite Shower Stall - DELTA - Shower Trim and Hansgrohe Slide Bar with Handheld and Ceiling Mount Showerhead

Note: Model # R10000 / T13020-CDN/27454002 / 277440 / RP52382 / RP46870 / RP6025 / R11000 / T11800 - Chrome (See Sketch)

1 - CLARIFICATION;

ALL BATHROOMS - Install Standard Plumbing Fixtures throughout all bathrooms, where applicable. To Include; Powder Room, Ensuite #2 and Master Ensuite (See Sketch)

Note:

IVUIC.

1 - BONUS PACKAGE - PURCHASER HAS APPLIED \$5,000.00 (Includes Taxes) WORTH OF UPGRADE PROMOTIONAL PACKAGE TOWARDS THE PURCHASE OF UPGRADES COMPLETED AT THE DECOR CENTRE.

Note:

1 - PURCHASER HAS ATTENDED A COLOR APPOINTMENT AT THE DECOR CENTRE AND HAS DECLINED ANY ADDITIONAL UPGRADES. Purchaser accepts and acknowledges that there will be no further changes/additions/deletions to be made upon signing on March 16,2018 Note:

1 - PURCHASER AWARE AND ACCEPTS THAT ANY CHANGES MADE TO UPGRADES AFTER SIGNING THIS PURCHASERS EXTRA FORM ARE SUBJECT TO A MINIMUM ADMINISTRATION FEE OF \$1,000 PLUS A 10% HOLDBACK FEE.

**Vote:

This Document is Extremely Time Sensitive - Printed 7 May 18 at 16:12



3550 LANGSTAFF IID., STE 160 WOODBILLOGE, ONTAILO LIL 9157 TELEPHONE: 905 050 0222 DAK: 906 060 2076 E-MAIL: INPO@SELECTIVECENAMICS.COM Site: Vender: It is hereby understood and agreed between the undersigned parties that the following changes shall be made to the above mentioned colour chart, and except for such changes noted, all other liems in the colour chart shall remain as started therein. Delete: Selective Ceramicy Imports (Vaughan) links Selective Ceramic Imports inc Purchaser

TO MILET		* INTERIOR C	COLOUR SCHEME *米人和	TITAL - ADDI -	\$PING本	
ALAN I. HERSH	Purchasers ALAN I. HERSH & ANNE HERSH	mo Model Type	Telephone Res. / Bus (905) 737-0750 / (416) 568-1231	Project Hampton Place	Closing Date	Unit
Page 1 of 3	Flooring	-Wall Tile			01000	710
MASTER ENSUITE	12x24 + Store Herium fire	Main 12x24 Foto Notillim Giola	Accent/Insert	Pattern		
MAIN BATHROOM		N/A	All			
ENSUITE #2	13x13 RUSTIC GREY (STD)	8x10 GOLF GRIGIO (STD)	NONE	NONE		
POWDER ROOM	13x13 RUSTIC GREY (STD)	N/A	N/A			
KITCHEN / DINETTE	7 1/2" TorleysForest -NorthernCordillera9687P (STD)	DELETE - Do Not Install / Supply / Credit	NONE	NONE		
FOYER	7 1/2" TorleysForest -NorthernCordillera9687P (STD)	N/A	N/A	NIA		
LAUNDRY	13x13 RUSTIC GREY (UPG)	NA	N/A	NIA		
MAIN HALL	7 1/2" TorleysForest -NorthernCordillera9687P (STD)	N/A	N/A	N/A		
LIVING ROOM	7 1/2" TorleysForest -NorthernCordillera9687P (STD)					
DINING ROOM	7 1/2" TorleysForest -NorthernCordillera9687P (STD)	Notes				
Dinx	7 1/2" TorleysForest -NorthernCordillera9687P (STD)					
MASTER BEDROOM	7 1/2" TorleysForest -NorthernCordillera9687P (STD)					
BEDROOM 2	7 1/2" TorleysForest -NorthernCordillera9687P (STD)	* 0 1 2 1	111) [
BEDROOM 3	N/A	> Truck	内で以上代記し、1317米	87.*		
			多			
					ă	
		Page 1 of 3				

Lot: 713 Project: Hampton Place Model: WAINSCOTT

Consultant:

Melissa Di Marino

Purchaser: _

ALAN I. HERSH

Purchaser:

ANNE HERSH

Vendor:

Hampton Place
Printed Mar 16, 2018 2:18 pm

ALAN I. HERSH & ANNE HERSH

Purchasers

Decor Consultant Melissa Di Marino

WAINSCOTT

Model Type

* INTERIOR CC - UR SCHEME *

(905) 737-0750 / (416) 568-1231 Telephone Res. / Bus

Hampton Place **Project**

Closing Date


20/11/2018


Unit 713

3	
Ö	
N	
a)	
9	
Œ	


	APPLIAN O O	1		53529-G10 UPCD Std 31in Opening				MISC. INSTALLATIONS——Ceramic Accessories	(installed by vendor) Yes No	Bathroom Mirrors (installed by Vendor)	Wire Shelving - Closet (installed by Vendor) Yes No	*			Vendór:	Deine of Man de 2040 2:40
	Handle / Knob	16338-195	B603-SC	53529-G10	N/A]									
	Counter Edge	Y EDGE (STD)	A' EDGE (STD)	V "I" EDGE (UPG)	N/A			Levers STANDARD		ace ice on Flooring	Marbie N/A Hearth N/A		O - WHITE	(Purchaser	ANNE HEKKH
	TE (STD)	Y (STD)	Y (STD)	aesarStone (Up				Lev		Firepla Firepla Location Style	Ma Hez	Trim	STANDARD - WHITE		No.	перед
	Countertop ASPEN TERRA WHITE (STD)	ASPEN CYRUS GREY (STD)	A ASPEN CYRUS GREY (STD)	(2) V 5141 FrostyCarrina C	N/A			ARA SMOOTH						7	Purchaser:	יייכור.
				laze GAT4801 (Up				OSTANDARD CARRARA SMOOTH		y Medalion STANDARD -#CTR-611 STANDARD -#CTR-611 STANDARD -#CTR-611	NONE NONE N/A		CH WHITE			Melissa I II Mapmo
	2503 (STD)	T 1203 (STD)	T 1203 (STD)	White w/SKyLinenG			1	Baseboard & Casing STANDARD Interior Doors		Foyer Living Room STANDARD STANDARD Dining Room STANDARD NOVE	Master Bedroom Bedroom 2 Bedroom 3	Paint Throughout	STANDARD - BIRCH WHITE	Page 2 of 3	Decor Consultant:	MER
SUCTOBELIA SOCIAL	Style CATEGORY 2 - MAPLE - PISTACHIO QT 2503 (STD)	CATEGORY 1 - FIBERBOARD - WHITE QT 1203 (STD)	CATEGORY 1 - FIBERBOARD - WHITE QT 1203 (STD)	Category 18 Floarboard Classilibite w 19Ky Line (1922 OFT 1801 (Upp) 1 5141 Frosty Carrina Caesar Stone (Upp)	N/A			IDG - Blance Oustruc #401248	STANDARD	VSTANDARD VSTANDARD VSTANDARD	V STANDARD V STANDARD V STANDARD	STANDARD	✓ STANDARD			Place Model: WAINSCOTT
CABINETOV VANITIES AND		MASTER ENSUITE	POWDER ROOM	KITCHEN / DINETTE	LAUNDRY ROOM	51	PI IMBING FIXTIBES	KITCHEN Sink Model	Sink Faucet	TOILETS Master Ensuite Eハンバーや や2 Powder Room	VANITY FAUCETS Master Ensuite En会が下できる	VANITY SINKS Master Ensuite	Ensuite *2 Powder Room	SHOWER STALL / TUBS	Master Ensuite Shower Staff STANDARD Master Ensuite Tub JSTANDARD	Lot: 713 Project: Hampton Place Model: WAINSCOTT


Printed Mar 16, 2018 2:18 pm

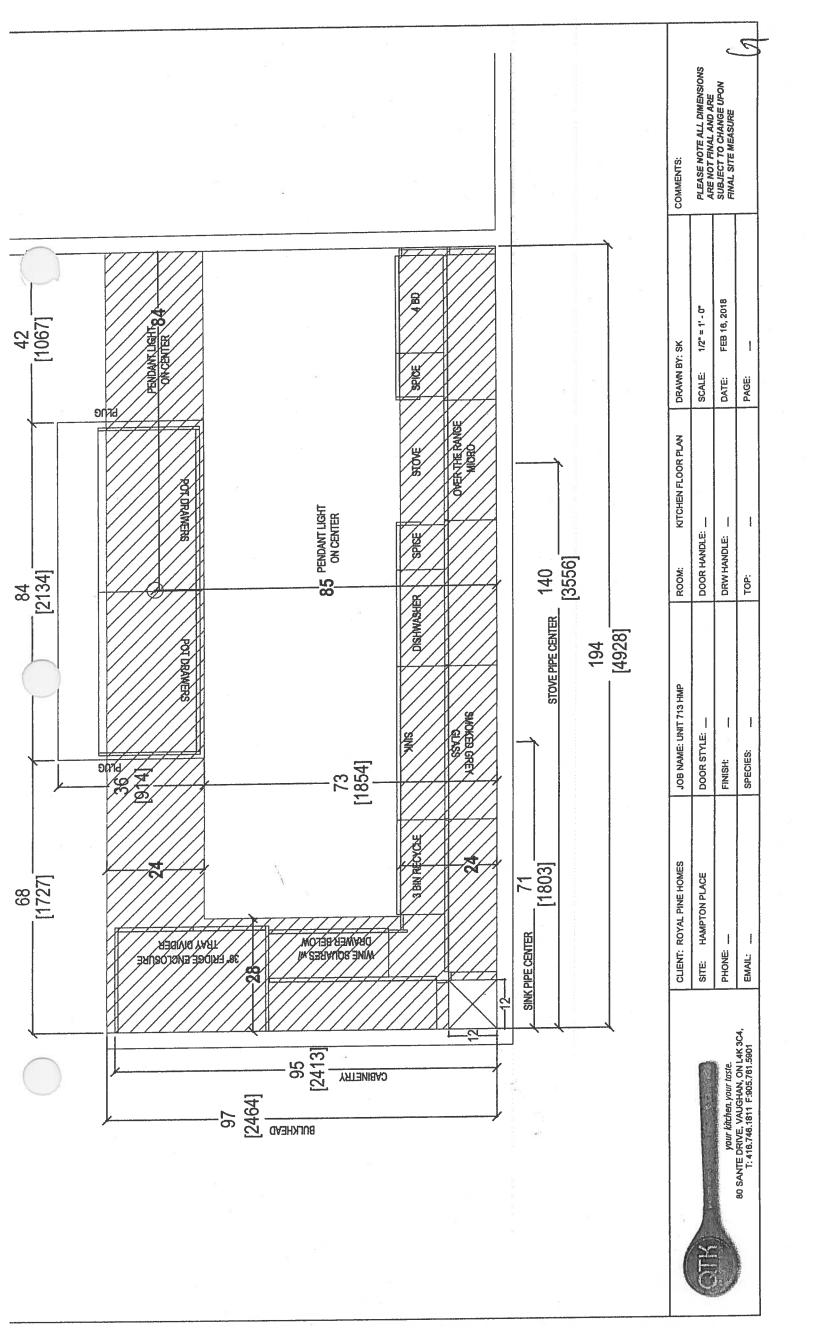


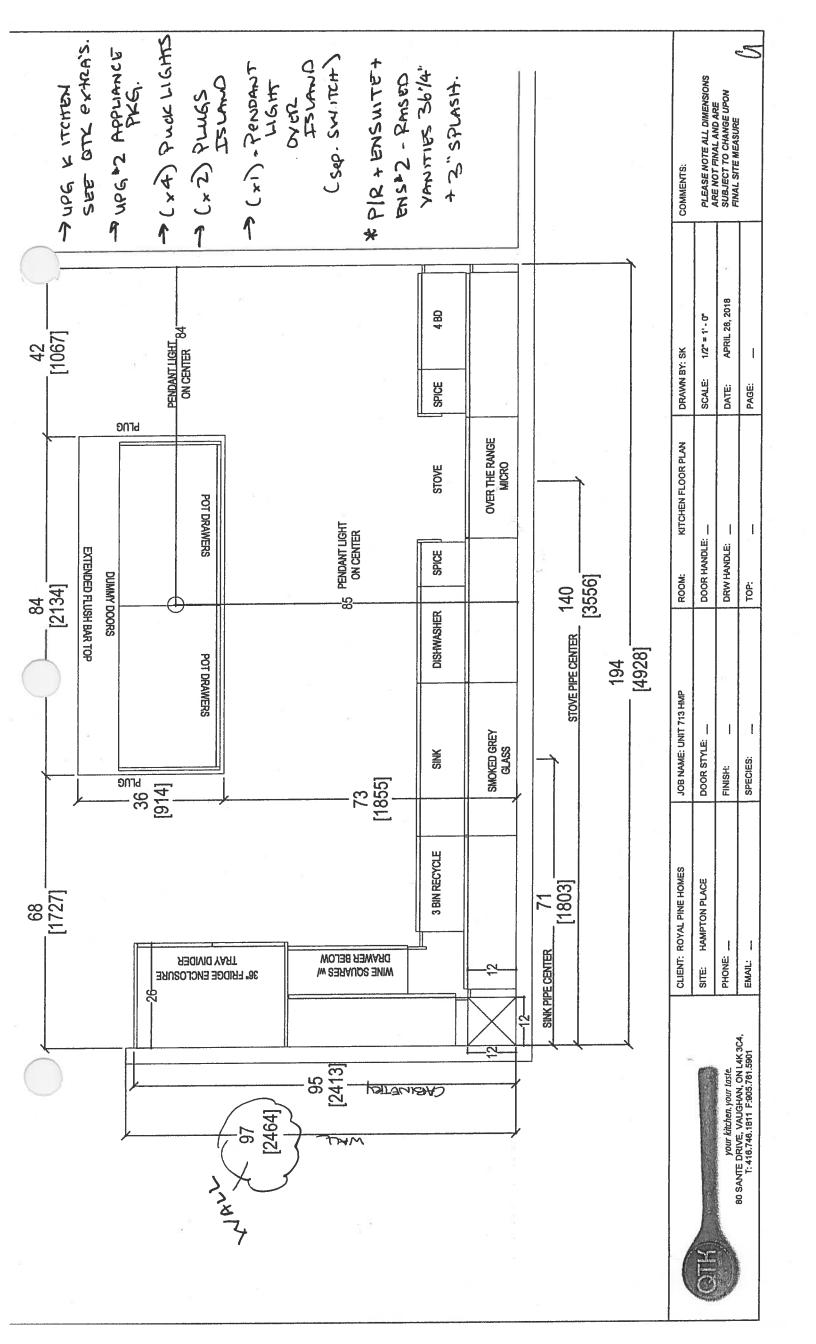

REFER TO PAGE 3 CHANGE TO PUCK LIGHTS JULY 2019

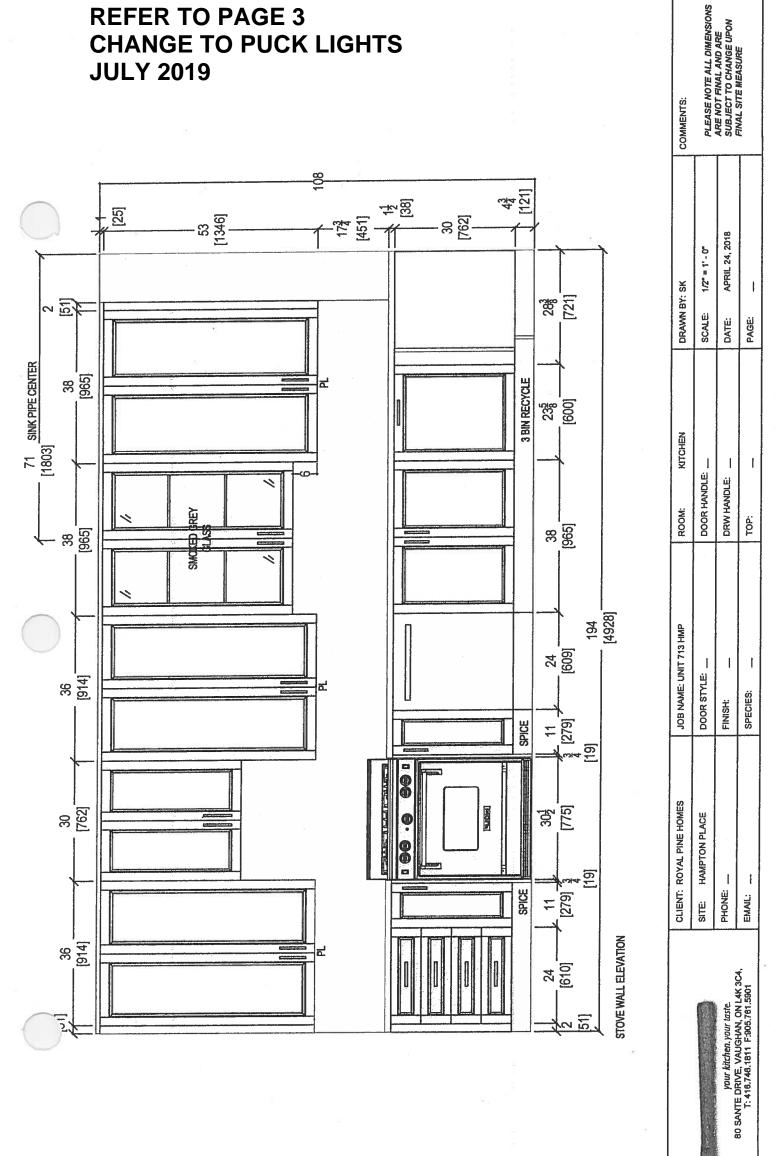

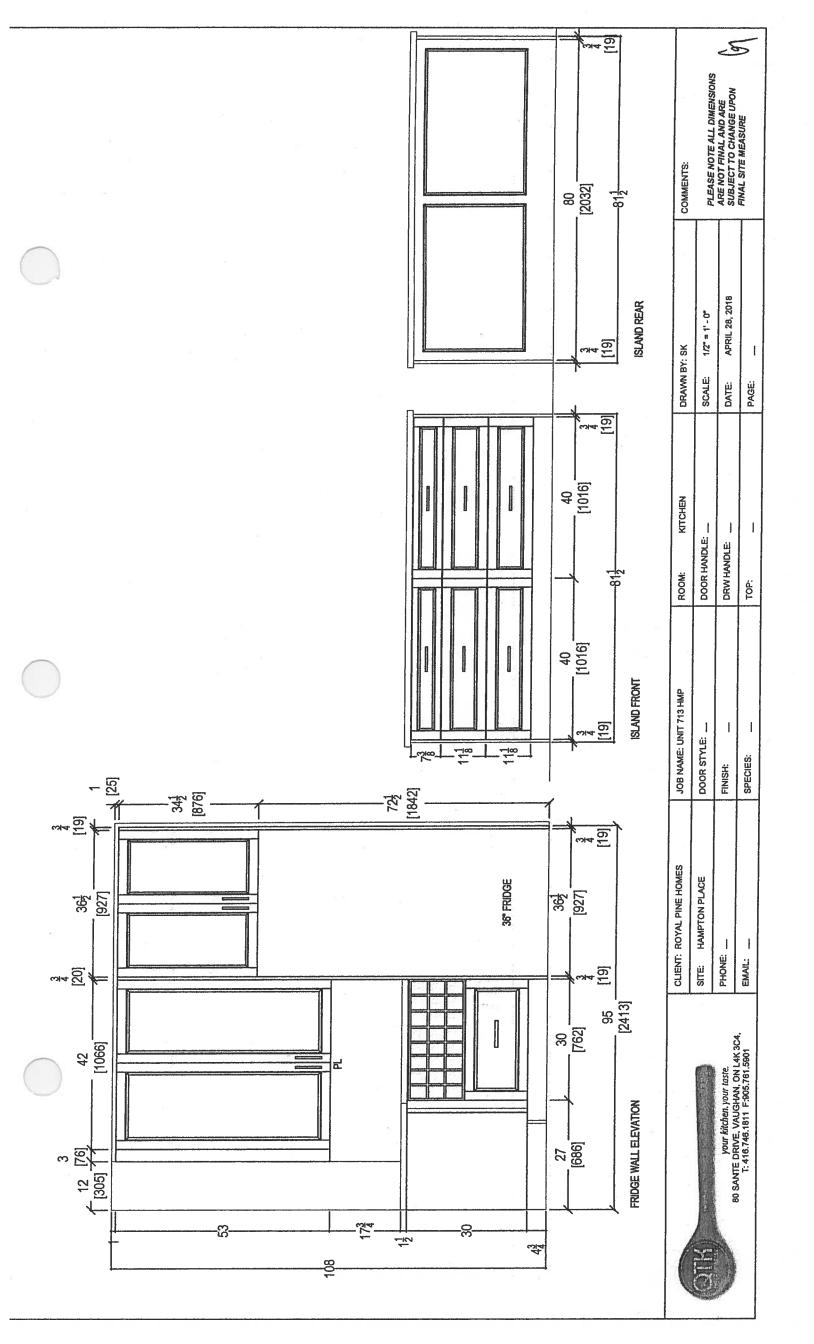

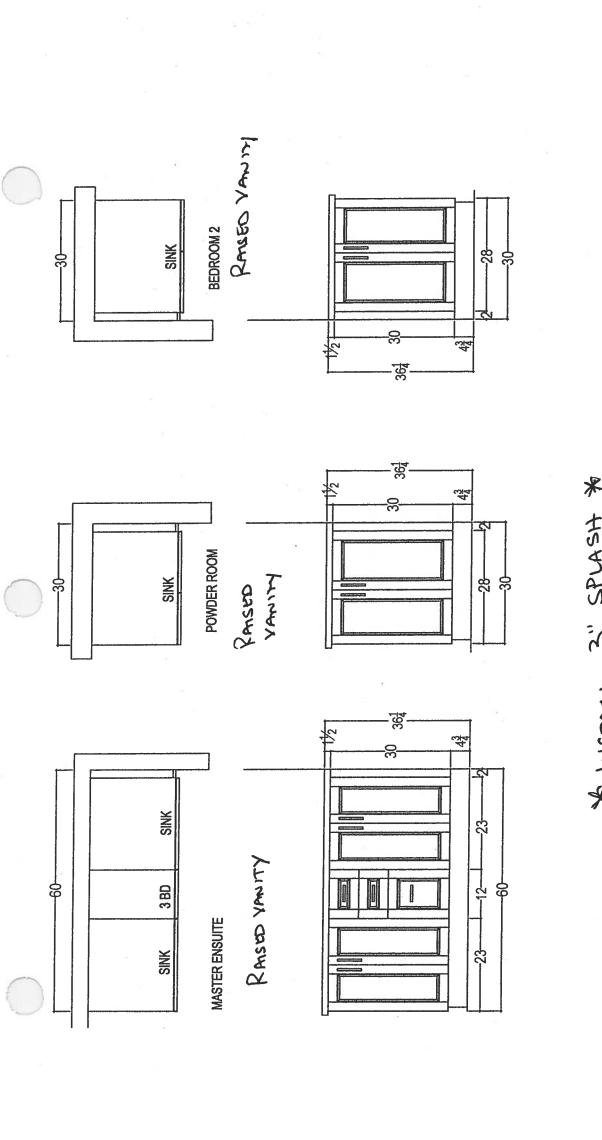

* INSTITUTE 3" SPLAST *

COMMENTS:	PLEASE NOTE ALL DIMENSIONS	SUBJECT TO CHANGE UPON /	FINAL SITE MEASURE
DRAWN BY: SK	SCALE: 1/2"=1'-0"	DATE: APRIL 28, 2018	PAGE:
ROOM: VANITIES	DOOR HANDLE:	DRW HANDLE:	TOP:
JOB NAME: UNIT 713 HMP	DOOR STYLE:	FINISH:	SPECIES:
CLIENT: ROYAL PINE HOMES	SITE: HAMPTON PLACE	PHONE:	EMAIL:
		your kitchen, your taste.	T: 418.748.1811 F:905.761.5901

Product Dimensions: Height: 72 Width: 35 3/4 Depth: 30 1/4

Upgrade Package 2





Electrical Requirements:

Black **White**

15 Amps.

OStainless Steel

Available In:

KRFC302ESS

而是是这种人的是不是是一种的,我们也是不是是一个,我们也是一个人,我们也是一个人,我们也是一个人,我们也是一个人,我们也是一个人,我们也是一个人,我们也是一个人, 一个人,我们也是一个人,我们也是一个人,我们也是一个人,我们也是一个人,我们也是一个人,我们也是一个人,我们也是一个人,我们也是一个人,我们也是一个人,我们也是

KRFC302ESS

22 cu.ft. 36-Inch Width Counter Depth French Door Refrigerator

with Interior Dispense

- ExtendFresh" Temperature Management System Key Features:
 - 🐯 Interior Water Dispenser**
- Professionally-Inspired Design

 - Produce Preserver
- FreshChill Temperature-Controlled Full-Width Pantry **Humidity-Controlled Crispers**
 - Pull-Out Tri-Level Freezer Drawer
 - SatinGlide® System
 - LED Lighting
- Star-K Certified
- 🏖 Automatic Ice Maker 🖚

Because Whiripcol Corporation policy includes a continuous commitment to improve our products, we reserve the right to change materials and specifications without notice. We also reserve the right to

Steg Registered undernate/TM Trademark of Whirlpool U.S.A. 🗜 2013 Whirlpool Corporation All Rights Reserved - All other trademarks are owned by their respective companie

Cested On: Wednesday, April 22, 2015 15.5104


Suite 713 Hampton

KSEB900ESS



J0-Inch 5-Element Electric Convection Slide-In Range with Baking Drawer

http://www.kilchenaid.com

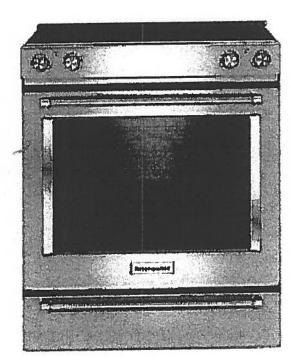

Key Features:

- · Baking Drawer
- Even-Heat™ True Convection
- Wireless Probe
- Steam Rack
- 7.1 Cu Ft. Total Capacity
- 5 Cooking Elements Including a Warm Zone
- EasyConvect[™] Conversion
- FIT Guarantee
- Aqualift®
- Glass Touch Controls
- Side Trim Accessory Kit

Product Dimensions:

Height: 36

Width: 29 7/8

Electrical Requirements:

40 Amps.

Additional Information:

Use And Care Guide

Dimension Guide

Installation Guide

Warranty Certificate

Available in:

Black

OStainless Steel

OWhite

AMERICA



se Whitipool Corpora

right to change materials and specifications without notice.

transition products without notice.

transition products without notice.

transition products without notice.

MAP) provided for release suggested Retail Price (MSRP) and Minimum Advertised Price (MAP) provided for release suggested Retail Prices (MSRP) and Minimum Advertised and retail prices.

Created On: Tuesday, December 22, 2015 14;04.50

Suite 713 Hampton Upgrade Package 2

-





KMHP519ESS

00-Watt Convection Microwave with High-Speed Cooking - 30"

KitchenAid'

http://www.kitchenald.com

Key Features:

- High-Speed Cooking
- Convection Cooking
- Professionally-Inspired Design Including Handle, Badge, Graphics, Chrome Chamfer.
- Cookshield Finish
- Crispwave[™] Technology and Crisper Pan
- 1200 Watts Power
- 1.9 Cu. Ft. Capacity
- · Halogen Cavity Lights and Task Light
- Steam Cleaning Function
- Keep Warm Function
- · Sound-Based Popcorn Function

Product Dimensions:

Height: 17 1/8

Width: 30

Depth: 17

Electrical Requirements:

15.

Additional Information:

Use And Care

Dimension Guide

Installation Guide

Warranty

Available in:

Stainless Steel

Because Whirlpool Corporation policy includes a continuous commitment to improve our products, we reserve the right to change materials and specifications without notice. We also reserve the right to discontinue or transition products without notice

Manufacturer's Suggested Retail Price (MSRP) and Minimum Advertised Price (MAP) provided for reference purposes only. Dealer alone determines advertised and retail prices.

Suite 713 Upgrade Hampton Package 2

 
KDTM354ESS



KitchenAid^{*}

http://www.kitchenaid.com

4 dBA Dishwasher with Clean Water Wash System



- · Clean Water Wash System
- ProScrub® Option
- · Professionally-Inspired Design
- Advanced ProDry™ System
- ProWash™ Cycle
- SatinGlide® Max Rails (Upper Rack)
- Sliding Tines in the Lower Rack
- 2 Rows Fold-Down Tines in Upper Rack
- Fold-Down Tines in the Lower Rack
- 2 Fold-Down Cup Shelves with Integrated Stemware Holders
- Utility Basket (Upper Rack)
- Express Wash

Product Dimensions:

Height: 34 1/2

Width: 23 7/8

Depth: 24 3/4

Electrical Requirements:

15 Amps.

Additional Information:


Use And Care Guide

Dimension Guide

Installation Guide

Energy Guide

Warranty Certificate

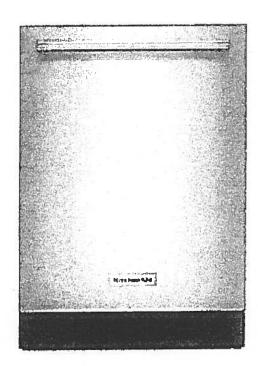

Available in:

OStainless Steel

INVESTED AMERICA

@Registered trademark/TM Tra-

Because Whirlpool Corporation policy the right to change materials and s

Registered trademark/TM Trademark of Whitipool, U.S.A. © 2013 Whitipool Corporation. All Rights Reserved
All other trademarks are owned by their respective companies.

Because Whitipool Corporation policy includes a continuous commitment to improve our products, we reserve
the right to change materials and specifications without notice. We also reserve the right to discontinue or
transition products without notice.

Menufacturer's Suggested Retal Price (MSRP) and Minhmum Advertised Price (MAP) provided for reference
purposes only. Dealer alone determines advertised and retail prices

Created On: Friday, March 04, 2016 16:36:55

Suite 713 Hampton


Upgrade Package 2

WED85HEFC

Whirlpool*

4 cu. ft. Electric Dryer with Quick Dry Cycle

http://www.whirlpool.com

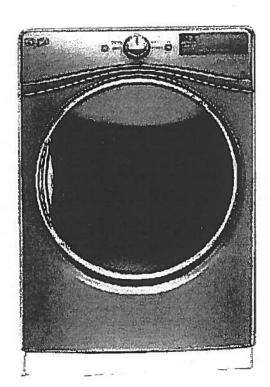

Key Features:

- Advanced Moisture Sensing System
- Tap Touch Controls with Memory
- EcoBoost™ Option
- Steam Refresh Cycle
- Wrinkle Shield™ Option
- Quad Baffles
- 7.4 Cu. Ft. Capacity
- Undercounter Installation
- ENERGY STAR® Qualified
- Sanitize Cycle
- Quick Dry Cycle

Product Dimensions:

Height: 39

Width: 27

Depth: 31

Additional Information:

Use And Care Guide

Dimension Guide

Installation Guide

Warranty Certificate

AMERICA



®Registered trademark/TM Trademark of Whiripool, U.S.A. © 2018 Whiripool Corporation, All Rights Reserved All other trademarks are owned by their respective companies

Because Whirlpool Corporation policy includes a continuous commitment to improve our products, we reserve the right to change materials and specifications without notice. We also reserve the right to discontinue or products and products without notice.

Manufacturer's Suggested Retail Price (MSRP) and Minimum Advertised Price (MAP) provided for reference purposes only. Dealer alone determines advertised and retail prices

Created On: Thursday, March 23, 2017 17:33-37


Suite 713 Hampton Upgrade Package 2

WFW85HEFC

cu. ft. Front Load Washer with TumbleFresh™ option



http://www.whirlpool.com

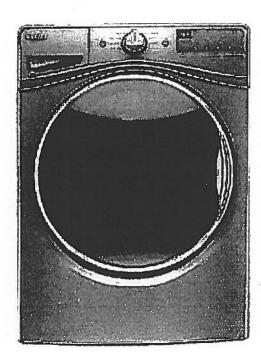

Key Features:

- TumbleFresh™ Option
- ColorLast™ Cycle
- · Presoak Option
- EcoBoost™ Option
- Precision Dispense
- Steam Clean Option
- Adaptive Wash Technology
- · Smooth Wave Stainless Steel Wash Basket
- 4.5 cu. ft. Capacity
- Undercounter Installation
- Add-A-Garment
- ENERGY STAR® Certified

Product Dimensions:

Height: 39 3/4

Width: 27

Depth: 33 5/16

Additional Information:

Use And Care Guide

Dimension Guide

Installation Guide

Energy Guide

Warranty Certificate

Available in:


OChrome Shadow **OWhite**

AMERICA



transition products without notice. ma's Suggested Retail Price (MSRP) and Minimum Advertised Price (MAP) provided for re purposes only. Dealer alone determines advertised and retail r Created On. Wednesday, December 14, 2016 18:12:43

Upgrade Kitchen Sinks

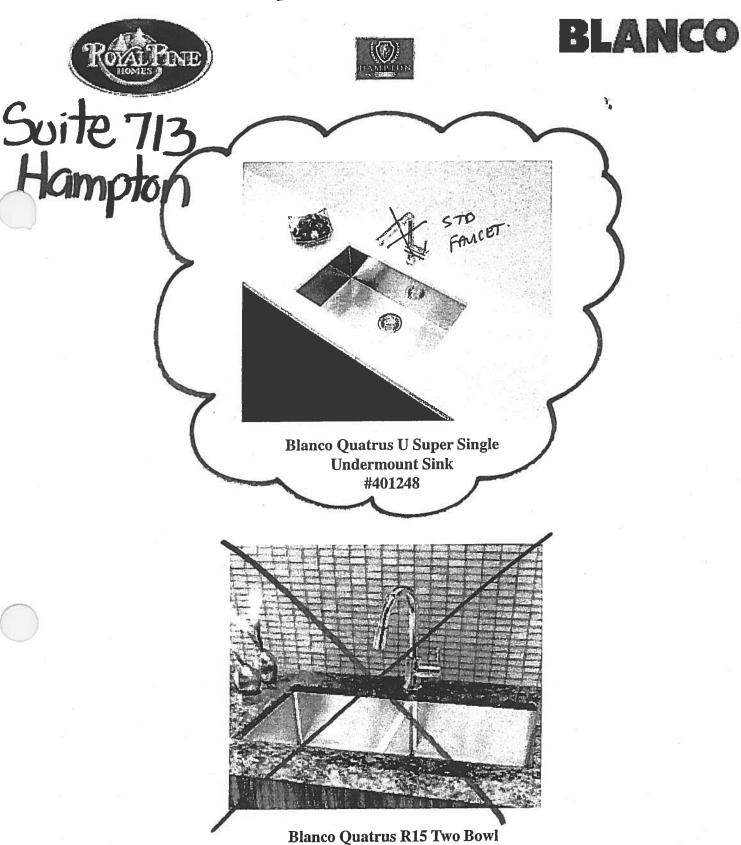

Centon Sales Corp. 400 Mathezon Blvd. Unit # 30, Mississauga, Ont. LAZ 1N8 Tel: 905-629-7072 Fax: 905-629-2131

Undermount Sink #401519


· Stanclard ·






A DELTA

Suite 713 Hampton

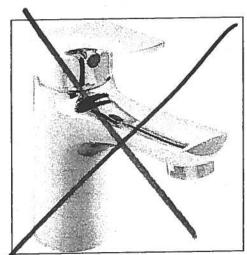

Delta Wynne Chrome Single Lever Lavatory Faucet With Pop Up

Haster Ensuite Shower Stall

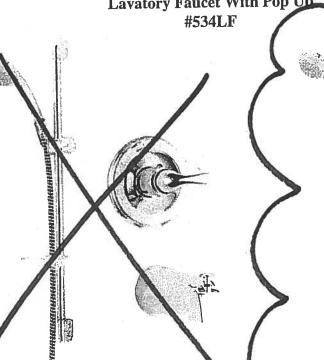

Delta Shower Trim with Tub Spout and Hansgrohe Slide Bar with Handheld #R10000/T13020-CDN/2001-TP/27454002/ CEILING Mount Showerhead 27744000

FROM CELUNG.

Delta Shower Trim Hansgrohe Slide Bar with Handheld and #R10000/T13020-CDN/27454002/ 27744000/RP52382/RP46870/RP6025/ R11000/T11800

Centron Sales Corp. 400 Matheson Blvd. Unit # 30, Mississauga, Ont.

4Z 1N8 Tel: 905-629-7072 Fox: 905-629-200

Suite 713 Hampton

Living Room

	9
CONDU	
· · · · · · · · · · · · · · · · · · ·	
CABLE/BELL CO GO"	S Pug
060",	
menter septembility in manufact militer as all organism exacts that the separate man the constitution of the second constitution	- cendsit
	BLANK
gangganggangangan an an appgada da lau, ah mganahin shadi ana Ni, ba Alaa shaan shaan i badh sadaan a lau analli sh	D. V-


Countertop Edges Suite 713 Hampton



CONNOLLY Marble & Granite Ltd.


EDGE DETAILS

004

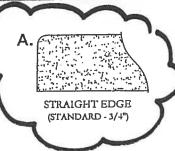

Standard:

Powder Room Master Ensuite Ensuite \$2

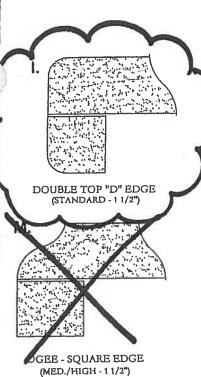

EDGING UP-GRADE OPTIONS