



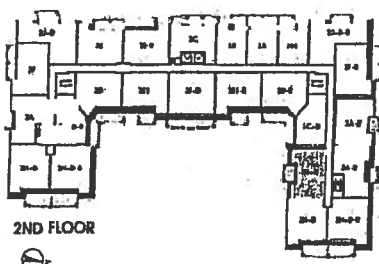


Noyac Bay

1,121 SQ FT *plus 76 sq. ft. of balcony area*


SUITE 311
ORIGINAL LAYO.
INVENTORY SUI
NEW.

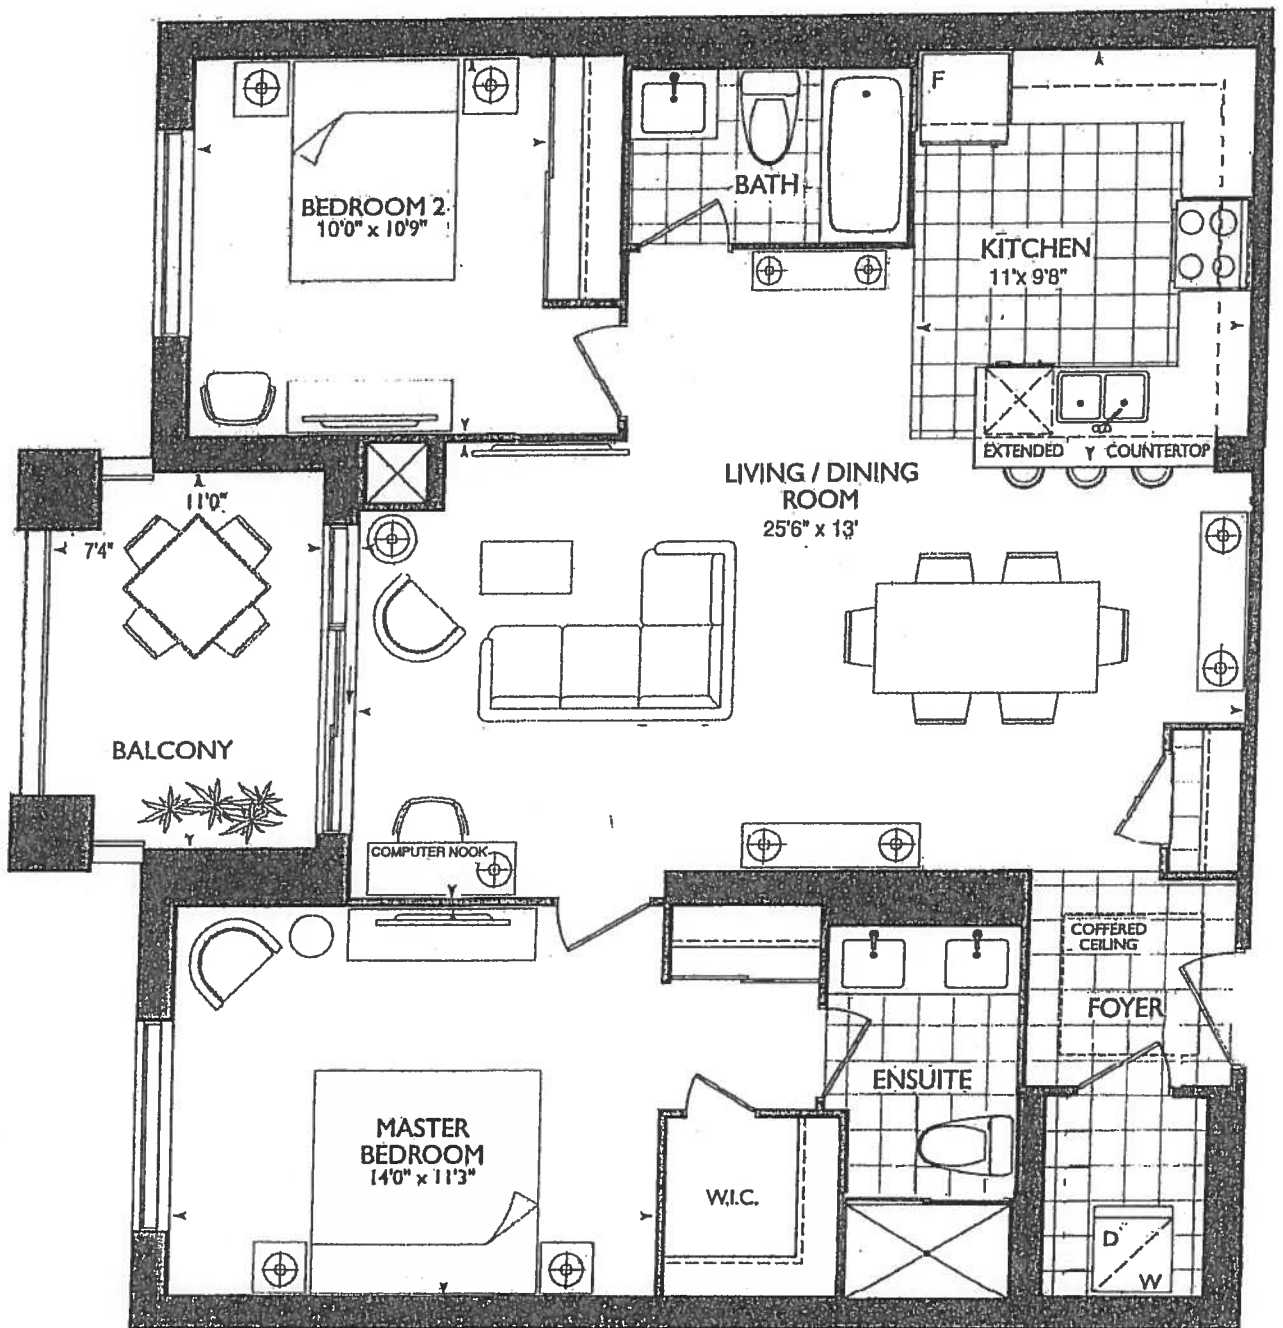

2ND FLOOR

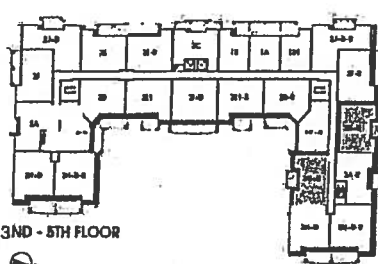

3ND - 5TH FLOOR

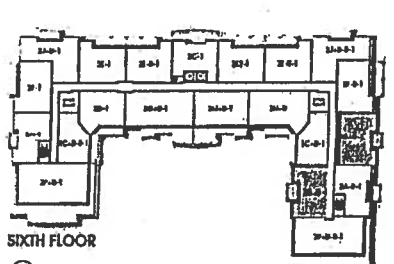

SIXTH FLOOR




Plans and specifications are subject to change without notice. Actual usable floor space may vary from the stated floor area. All renderings are artist's concept. E. & O. E.

*** KITCHEN ***

- 1ST UPGRADE APPLANCE PKGS w/ 36" FRIDGE & CHIMNEY HOOD FAN & MICRO SHELF IN PANTRY
- (x2) = PENDANT LIGHTS
- (x5) = PUCK LIGHTS
- (x1) = PENINSULA PLUGS
- 64" = STOVE PIPE CENTER
- 129" SINK PIPE CENTER

* Powder Room + ENSUITE 36" x 48" RANSEO VANITIES NO CHARGE & 3" SPLASH

*VIEW GTR BREAKS FOR ALL KITCHEN UPGRADES

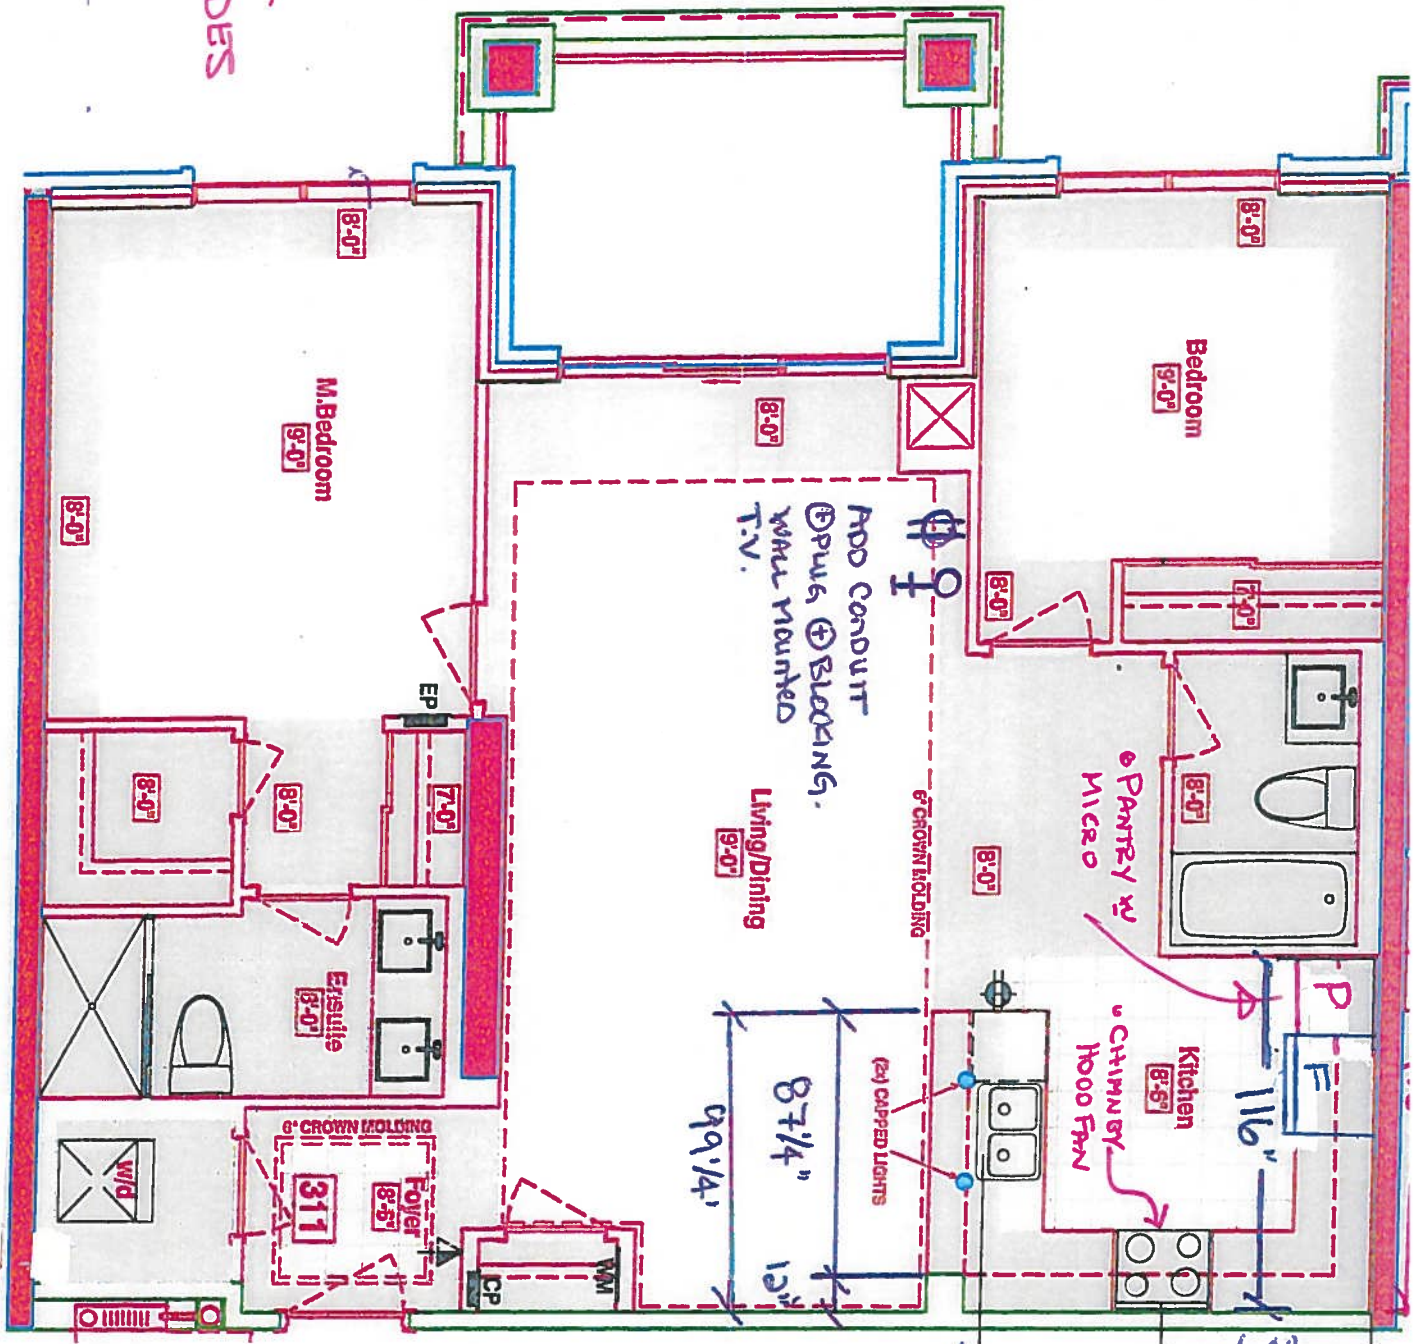

LEGEND:

	SECURITY PANEL
	ELECTRICAL PANEL
	COMMUNICATION PANEL
	WATER METER
	FRIDGE
	DROPPED AREA
	CROWN MOLDING

*** SUITE 311 * (INVENTORY SUITE)**
 NEW PLAN
 -REMOVED DEN
 -REVISED KITCHEN
 *REVISED LAUNDRY DOOR SWING & ENSUITE WALL AS PER THIS BROCHURE

*LIVING ROOM CONDUIT / PLUG / BLOCKING. FOR FUTURE WALL MOUNTED T.V.



VINCE'S
SITE COPY

CONSTRUCTION SUMMARY

Braylea Investments Inc.

PURCHASER: INVENTORY Suite_311_PH_1

TEL:

LOT NUMBER	PHASE	HOUSE TYPE	CLOSING DATE
311	1	NOYAC BAY	07-Nov-19

Date Added: 30-Apr-19

Invoice Number: 7230

1 - KITCHEN- Install 1st Upgrade Appliance Package with 36" Fridge, as per Vendors Samples

Note:

1 - KITCHEN- Install TWO (X2) Capped Ceiling Lights above the Kicthen sink on same switch, as per plan

Note:

1 - KITCHEN- Install a Water Line For Fridge

Note:

1 - LIVING ROOM- Install a Conduit and Blocking For Wall Mounted TV (60 Inches above FF) in the Living Room as Per Plan

Note:

1 - KITCHEN- Instll a Stainless Steel Chminey Hood Fan and Microwave Shelf with Trim Kit In Lieu Of the Standard Combination Microwave/Hood Fan (Includes Electrical) As per Vendors Specifications and Samples

Note:

1 - Supply and INstall the Panasonic Microwave Model # ST765S with the Trim Kit Model # NNTK714SS

Note:

Date Added: 30-Apr-19

Invoice Number: 7213

80 - FOYER- Install the 24x24 VERMONT SILVER in the foyer, in lieu of the builders standard

Note:

1 - KITCHEN- Delete the builders standard floor tile and install the 7 1/2" Torlys Forest Okanogan EE-F-9742-P

Note:

1 - KITCHEN-Install the Torleys Forest Collection 7 1/2" Laminate Northern Cordillera 9687-P , to be installed in the kitchen in lieu of the builders standard floor tile

Note:

1 - KITCHEN & BATHROOM- SEE QUALITY TOPS & KITCHENS FOR ALL KITCHEN & BATHROOMS UPGRADES/LAYOUTS (See attached Upgrade Package)

Note:

1 - KITCHEN - Install ONE (X1) ADDITIONAL PUCK LIGHTS (Same Switch as Standard Puck Lights) at kitchen. To be installed below kitchen cabinetry, where applicable. (See Attached QTK Layout for Locations)

Note: Purchaser Paying Difference for Additional Puck Lights - Standard Kitchen to Receive FOUR (X4) Puck Lights - Upgrade Kitchen Requires FIVE (X5) Puck Lights

1 - KITCHEN - Install an Upgrade #1 Cabinet Package, throughout the kitchen - Install Category 3 QT4401 White

Note:

1 - KITCHEN- Install an Upgrade Package #1 handles for kicthen, to be installed throughout, where aplicable, in lieu of the builders standard

Note:

1 - KITCHEN- ** Kitchen Backsplash TO BE DETERMINED**

Note:

1 - KITCHEN- Kitchen Counter top colour To Be Determined On Site With Connolly Marble

Note:



SITE COPY

CONSTRUCTION SUMMARY

Braylea Investments Inc.

PURCHASER: INVENTORY Suite_311_PH_1

TEL:

LOT NUMBER	PHASE	HOUSE TYPE	CLOSING DATE	
311	1	NOYAC BAY	07-Nov-19	

Date Added: 30-Apr-19

Invoice Number: 7213

1 - KITCHEN- Install an upgrade edge, throughout the kitchen, where applicable. Install Edge "I" Note:
1 - KITCHEN- Install the builders standard undermount sink in the kitchen- Install the BLANCO HORIZON Plus U2 (8") Undermount Sink- Model # 401234 Note:
1 - KITCHEN- Install the builders standard Faucet in the kitchen- Install the DELTA Chrome Pull-Out Kitchen Faucet (Single Hole) - Model # 469LF-Chrome Note:
1 - MASTER ENSUITE- Install an upgraded cabinet in the Master Ensuite. Install Category 3 QT 1101 White Fibreboard Note:
1 - MASTER ENSUITE- Master Ensuite Counter top colour To Be Determined On Site With Connolly Marble Note:
1 - MASTER ENSUITE- Install an upgrade edge, throughout the Master Ensuite, where applicable. Install Edge "I" Note:
50 - MASTER ENSUITE FLOOR- Install an upgrade 24X24 LANCASTER GREY floor tile in the Master Ensuite, in lieu of the builders standard floor tile. To be installed straight/stacked Note:
95 - MASTER ENSUITE - Install an upgrade 12X24 PURE WHITE floor tile in the Master Ensuite shower stall, in lieu of the builders standard wall tile. To be installed Horizontal/ stacked Note:
30 - MAIN BATH FLOOR- Install a 1st upgrade 12X24 CEMENTINE BIANCO floor tile in the Main Bath, in lieu of the builders standard floor tile. To be installed straight/stacked Note:
75 - MAIN BATH TUB SHOWER- Install a 1st upgrade 12X24 CEMENTINE BIANCO floor tile in the Main Bath Tub Shower Walls, in lieu of the builders standard wall tile. To be installed Horizontal/stacked Note:
1 - MAIN BATH- Install an upgraded cabinet in the Main Bath. Install Category 3 QT 4801 Fibreboard White Note:
1 - MAIN BATH- Main Bath Counter top colour To Be Determined On Site With Connolly Marble Note:
1 - MAIN BATH- Install an upgrade edge, throughout the Main Bath, where applicable. Install Edge "I" Note:
40 - LAUNDRY ROOM - Install a 2nd upgrade floor tile in the Laundry Room, in lieu of the builders standard floor tile Note:
1 - CLARIFICATION- MASTER ENSUITE / MAIN BATH- Install the builders standard Plumbing Fixtures throughout all bathrooms, where applicable. To Include the Master Ensuite & Main Bath Note:



SITE COPY

CONSTRUCTION SUMMARY

Braylea Investments Inc.

PURCHASER: INVENTORY Suite_311_PH_1

TEL:

LOT NUMBER	PHASE	HOUSE TYPE	CLOSING DATE	
311	1	NOYAC BAY	07-Nov-19	

Date Added: 30-Apr-19

Invoice Number: 7213

1 - CLARIFICATION;
ALL BATHROOMS - DELETE Do Not Install / Supply / Credit Purchaser for builders standard ceramic bathroom accessories (toilet paper, towel bar & soap dish) throughout all bathrooms where applicable.
Note: To Include; Main Bath & Master Ensuite (See Sketch)

1 - CLARIFICATION-
MASTER ENSUITE / MAIN BATH- Install the Standard 3" Splash throughout all bathroom vanity counter tops, where applicable. To include the Main Bath and the Master Ensuite
Note:

1 - KITCHEN/ MASTER ENSUITE/ MAIN BATH- Stone slabs vary in size & all seams are visible & the fabricator reserves the right to position the seams as necessary.
Note:

1 - CLARIFICATION:
MASTER ENSUITE & MAIN BATH-Install RAISED VANITY HEIGHT at Main Bath and Master Ensuite Vanities, where applicable (See attached QTK Upgrade paperwork and Layouts)
Note:

1 - PURCHASER AWARE AND ACCEPTS THAT ANY CHANGES MADE TO UPGRADES AFTER SIGNING THIS PURCHASERS EXTRA FORM ARE SUBJECT TO A MINIMUM ADMINISTRATION FEE OF \$1,000. PLUS A 10% HOLDBACK FEE.
Note:

This Document is Extremely Time Sensitive - Printed 30 Apr 19 at 14:57



Purchaser	Decor Consultant	Model Type	Telephone Res. / Bus	Project	Closing Date	Unit
INVENTORY Suite_311_PH_1	Laura Di Pede	NOYAC BAY	/	Braylea Investments Inc.	07/11/2019	311

* INTERIOR COLOUR SCHEME *

Page 2 of 3

* Revised August 7 / 19 *

CABINETRY, VANITIES AND COUNTERTOPS	Style	Countertop	Counter Edge	Handle / Knob	APPLIANCE PACKAGE
MAIN BATHROOM	☒ CATEGORY 3 FIBERBOARD QT 4801 WHITE (UPGD)	☒ Terra White	☒ 1" EDGE (UPGD)	☒ 3487 128(Sid)	Appliance Package #1
MASTER ENSUITE	☒ CATEGORY 3 FIBERBOARD QT 1101 WHITE (UPGD)	☒ Terra White	☒ 1" EDGE (UPGD)	☒ 3487 128(Sid)	- 36" Fridges
POWDER ROOM	N/A	N/A	N/A	N/A	- Chimney Hood Fan
KITCHEN / DINETTE	☒ CATEGORY 3 FIBERBOARD QT 4401 CLASSIC GREY (UPGD)	☒ Aspen Venetino Gray	☒ 1" EDGE (UPGD)	☒ 527160 Upgd	- Micro Shelf
LAUNDRY ROOM	N/A	N/A	N/A	N/A	Sid 31in Opening

PLUMBING FIXTURES	Trim	Levers	Door Height	MISC. INSTALLATIONS
KITCHEN	Baseboard & Casing ☒ STANDARD	☒ STANDARD	STANDARD	Ceramic Accessories (installed by Vendor) ☐ Yes ☒ No
Sink Model	☒ STANDARD			Bathroom Mirrors (installed by Vendor) ☐ Yes ☒ No
Sink Faucet	☒ STANDARD			Wire Shelving - Closet (installed by Vendor) ☒ Yes ☐ No
TOILETS	Master Ensuite ☒ STANDARD	☒ STANDARD - CTR #611	Fireplace ☐ N/A	
	Main Bathroom ☒ STANDARD	☒ STANDARD - CTR #611	Location Flooring ☐ N/A	
	Powder Room ☐ N/A	☒ STANDARD - CTR #611	Style ☐ N/A	
		Den ☐ N/A	Finish ☐ N/A	
VANITY FAUCETS	Master Ensuite ☒ STANDARD	Master Bedroom ☐ N/A	Marble ☐ N/A	
	Main Bathroom ☒ STANDARD	Bedroom 2 ☐ N/A	Hearth ☐ N/A	
	Powder Room ☐ N/A	Bedroom 3 ☐ N/A		
VANITY SINKS	Master Ensuite ☒ STANDARD			
	Main Bathroom ☒ STANDARD			
	Powder Room ☐ N/A			
SHOWER STALL / TUBS	Master Ensuite Shower Stall ☒ STANDARD			
	Master Ensuite Tub ☐ N/A			
	Main Bathroom Tub ☒ STANDARD			

Paint Throughout	Trim
Walls ☐ AF 5 FROSTINE	☒ STANDARD

Decor Consultant: _____ Purchaser: _____

Vendor: _____



* INTERIOR COLOUR SCHEME *

Purchaser	Decor Consultant	Model Type	Telephone Res. / Bus	Project	Closing Date	Unit
INVENTORY Suite_311_PH_1	Laura Di Pedo	NOYAC BAY	/	Braylea Investments Inc.	07/11/2019	311

Page 1 of 3

	Flooring	Wall Tile	Main	Accent/Insert	Pattern
✓ MASTER ENSUITE	Description 24X24 LANCASTER GREY (UPGD)		12X24 PURE WHITE (Straight/Horizontal)	N/A	N/A
✓ MAIN BATHROOM	12X24 CEMENTINE BIANCO (Straight/UPGD)	✓	12X24 Cementine Bianco (Straight/Horizontal)	N/A	N/A
POWDER ROOM					
	N/A		N/A	N/A	N/A
KITCHEN / DINETTE	71/2" Torlys Forest Okanogan EE-F-9742-P		TBD ?????		
✓ FOYER	24X24 VERMONT SILVER (UPGD)		N/A	N/A	N/A
✓ LAUNDRY	24X24 VERMONT SILVER (UPGD)		N/A	N/A	N/A
LIVING ROOM	71/2" Torlys Forest Okanogan EE-F-9742-P (STD)	✓			
✓ DINING ROOM	71/2" Torlys Forest Okanogan EE-F-9742-P (STD)	✓			
MASTER BEDROOM	71/2" Torlys Forest Okanogan EE-F-9742-P (STD)	✓			
✓ BEDROOM 2	71/2" Torlys Forest Okanogan EE-F-9742-P (STD)	✓			
BEDROOM 3	N/A				
Basement Landing	N/A				

Notes
KITCHEN BACKSPLASH TO BE DETERMINED **

Page 1 of 3



your kitchen. your taste.

PURCHASE AGREEMENT FORM

Quality Tops & Kitchens Ltd.
80 Sante Drive, Vaughan, ON L4K 3C4
T 416.746.1811 F 905.761.5901
www.QTK.ca info@qtk.ca

PURCHASER:		CONTRACTOR:	Braylea Investments Inc.
ADDRESS:		SITE:	HAMPTON PLACE
EMAIL:		MODEL TYPE:	NOYAC BAY (2G+D)
PHONE #:		LOT #:	UNIT 311 HMP UPGRADE PKG 1
PHONE #:		DATE:	Apr 8, 2019 Q5178

The purchaser agrees to buy and Quality Tops & Kitchens Ltd. (QTK) agrees to sell and provide for the purchaser the following articles listed herein and with attached drawing in accordance to the terms and conditions described on the reverse of this agreement form.

ROOM	DESCRIPTION	CATEGORY
KITCHEN	DOOR STYLE: FINISH: SPECIES: DOOR HARDWARE: DRW HARDWARE: COUNTER TOP:	


ITEM #	QTY	DESCRIPTION	PRICE
VB	1	VALANCE BOX UPPERS & PUCK LIGHT CUTOUTS (ELEC. & LIGHTS NOT INCL.) - (OPTION PAID FOR BY BUILDER)	
FG2696	1	FRIDGE GABLE - 26" DEEP x 95-1/2"H - (OPTION PAID FOR BY BUILDER)	
FC2623	1	FRIDGE CABINET - 26" DEEP x 23"H - (OPTION PAID FOR BY BUILDER)	
BLCC	1	BASE L-SHAPE CORNER CABINET w/ 1 ADJ. SHELF	
BCR-MC1	1	MAGIC CORNER 1 PULL-OUT UNIT w/ 4 S.S. ANTI-SLIP BASKETS	
ULCC-14	1	UPPER L-SHAPE CORNER CABINET 26" x 26" - 13-3/4" DEEP	
UC-14WK	1	INCREASE DEPTH OF UPPER CABINET TO 13-3/4" DEEP (WHOLE KITCHEN) - 113 WHITE LP INTERIOR	
CUST-1	1	BLUM MOTION ANTI SLAM HINGES & 1 SET OF BLUM WHITE ANTARO DRAWER SLIDES	
CUST-2	1	PULL OUT SPICE UNIT w/ 2 FIXED BASKETS INCL. BLUM WHITE ANTARO ANTI SLAM SLIDES - 15" & 8" HIGH CLEARANCE	
CUST-3	1	TALL CABINET w/ 1 OPENING FOR MICROWAVE & 2 DRAWERS BELOW (SPECS REQUIRED)	
ROOM SUMMARY:			

ROOM	DESCRIPTION	CATEGORY
POWDER ROOM VANITY	DOOR STYLE: FINISH: SPECIES: DOOR HARDWARE: DRW HARDWARE: COUNTER TOP:	

ITEM #	QTY	DESCRIPTION	PRICE
VB-RAISE8	1	RAISE VANITY HEIGHT TO 34-1/2" - PER VANITY (>61" LONG)	
CUST-1	1	BLUM MOTION ANTI SLAM HINGES	
ROOM SUMMARY:			

ROOM	DESCRIPTION	CATEGORY
ENSUITE VANITY	DOOR STYLE: FINISH: SPECIES: DOOR HARDWARE: DRW HARDWARE: COUNTER TOP:	

ITEM #	QTY	DESCRIPTION	PRICE
VB-RAISE8	1	RAISE VANITY HEIGHT TO 34-1/2" - PER VANITY (>61" LONG)	
CUST-1	1	BLUM MOTION ANTI SLAM HINGES & 1 SET OF BLUM MOTION WHITE ANTARO DRAWER SLIDES	
ROOM SUMMARY:			

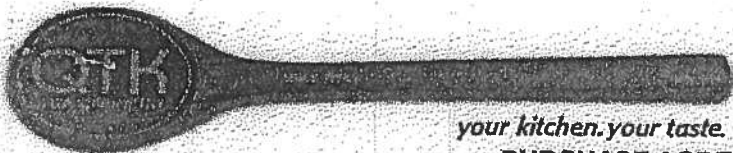


your kitchen. your taste.

Quality Tops & Kitchens Ltd.
80 Sante Drive, Vaughan, ON L4K 3C4
T 416.746.1811 F 905.761.5901
www.QTK.ca info@qtk.ca

PURCHASE AGREEMENT FORM

PURCHASER:		CONTRACTOR:	Braylea Investments Inc.	
ADDRESS:		SITE:	HAMPTON PLACE	
EMAIL:		MODEL TYPE:	NOYAC BAY (2G+D)	
PHONE #:		LOT #:	UNIT 311 HMP UPGRADE PKG 1	
PHONE #:		DATE:	Apr 8, 2019	Q5178

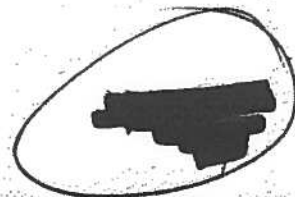

EXPECTED DELIVERY DATE	TBD	SUB-TOTAL:	
Customers please note all garbage bins, spice baskets, magic corner baskets and other accessories will only be delivered AFTER you move in the house. Please call us to request delivery of these items after you move in. Thank you. ALL CHANGES FINAL UPON SIGNING PLEASE READ ALL THE TERMS AND CONDITIONS ON THE ACCOMPANYING QTK TERMS & CONDITIONS DOCUMENT. BY SIGNING BELOW YOU AGREE TO RECEIVE THE ITEMS LISTED HEREIN AND PAY (ACCORDING TO QTK'S PAYMENT POLICY), AND HAVE READ AND UNDERSTOOD THE TERMS & CONDITIONS AS OUTLINED IN THE QTK TERMS & CONDITIONS DOCUMENT.		TOTAL:	
		HST	
		GRAND TOTAL:	
DEPOSIT 1 DATE:		DEPOSIT 1:	
DEPOSIT 2 DATE:		DEPOSIT 2:	
BALANCE TO BE PAID IN FULL BY DUE DATE: _____ CUSTOMER INITIAL(S): _____			

CUSTOMER SIGNATURE: _____

DATE: _____

CUSTOMER SIGNATURE: _____


DATE: _____

SALES REP NAME: Shellza Khan Designs

QTK AUTHORIZED SIGNATURE: 

- (x1) = BASE "L" CABINET
- (x1) = UPPER "L" SHAPE CORNER CABINET
- (x1) = PANTRY w/ BUILT-IN MICROW SHELF
- (x1) SPICE RACK.

- (x5) = PUCK LIGHTS
- (x2) = CAPPED PENDANTS
- (x1) = PUNG. PENINSULA
- Powder Room + BATHS
- PANTRY VANITIES 36 1/4" w/ 3" SPLASH
- 13 3/4" UPPER CABINETS UPG. Deep.

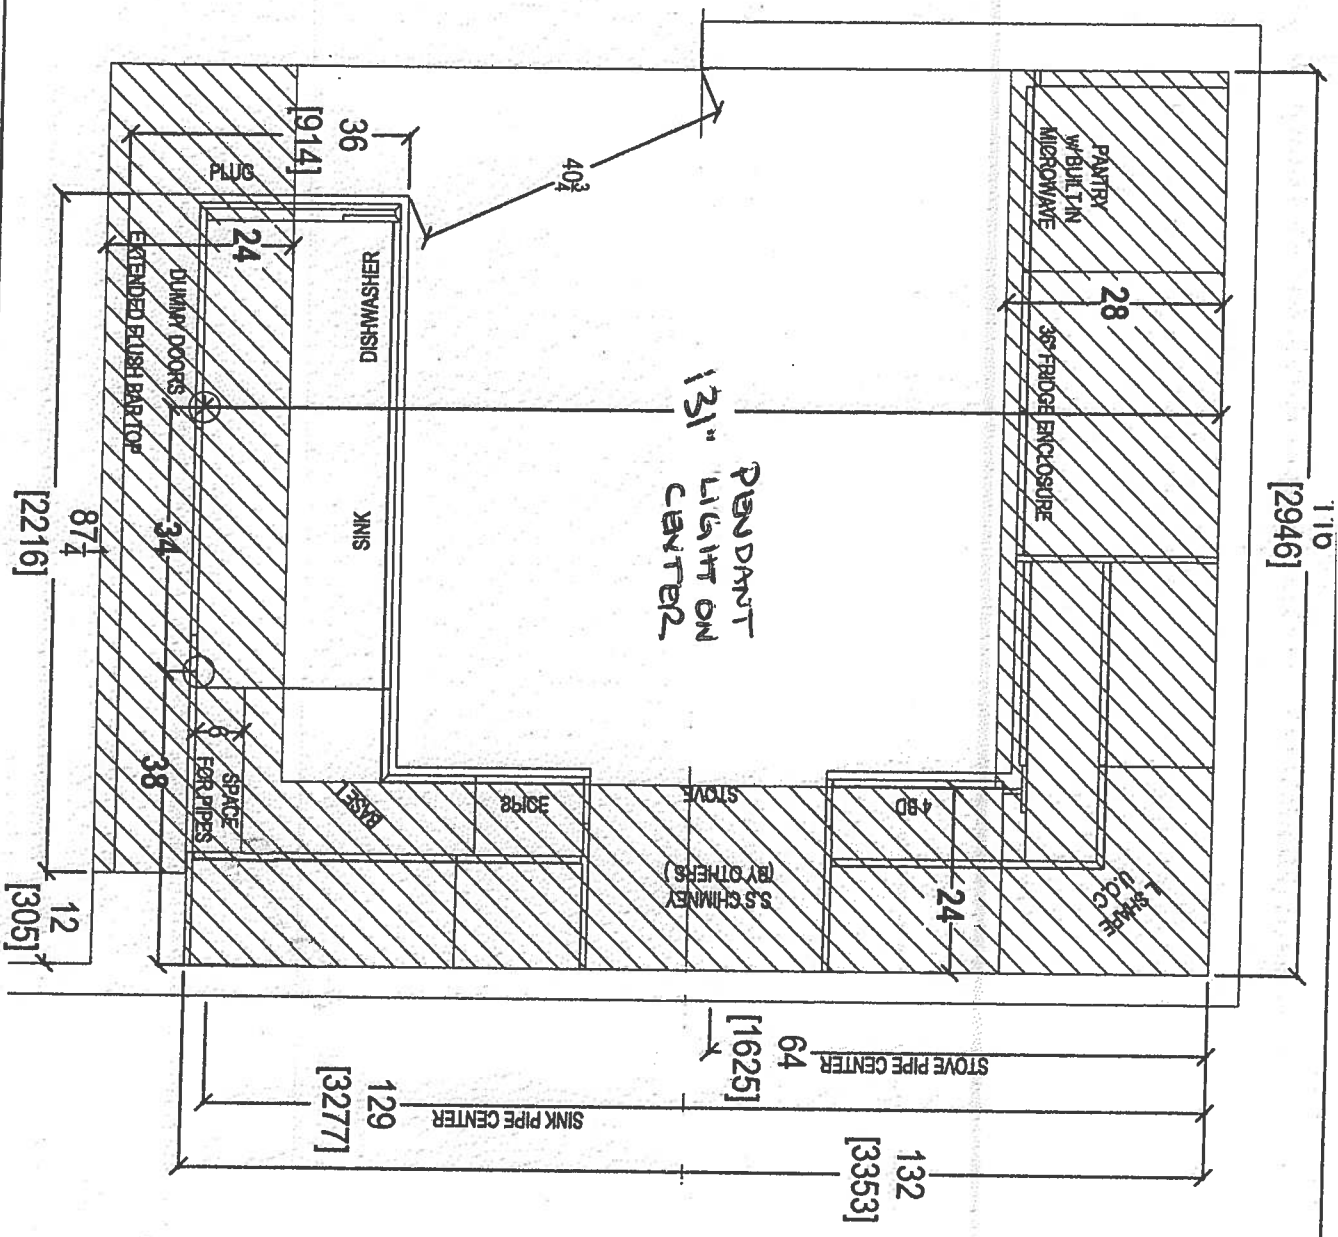


REVISED
APRIL 30 2019
311
INVENTORY SUITE
1st UPG APPLIANCE PKG.
w/ 36" FRIDGE +
CHIMNEY HOOD FAN +
MICROWAVE IN PANTRY
IN SHELVE



80 SANTE DRIVE, VAUGHAN, ON L4K 3C4,
T: 416.746.1811 F: 905.761.5801


CLIENT: ROYAL PINE HOMES	UNIT 311 HMP	ROOM: KITCHEN	DRAWN BY: SK	COMMENTS:
SITE: HAMPTON PLACE	DOOR STYLE: —	DOOR HANDLE: —	SCALE: 1/2" = 1'-0"	PLEASE NOTE ALL DIMENSIONS ARE NOT FINAL AND ARE SUBJECT TO CHANGE UPON FINAL SITE MEASURE
PHONE: —	FINISH: —	DRW HANDLE: —	DATE: REVISED APRIL 2, 2019	
EMAIL: —	SPECIES: —	TOP: —	PAGE: —	

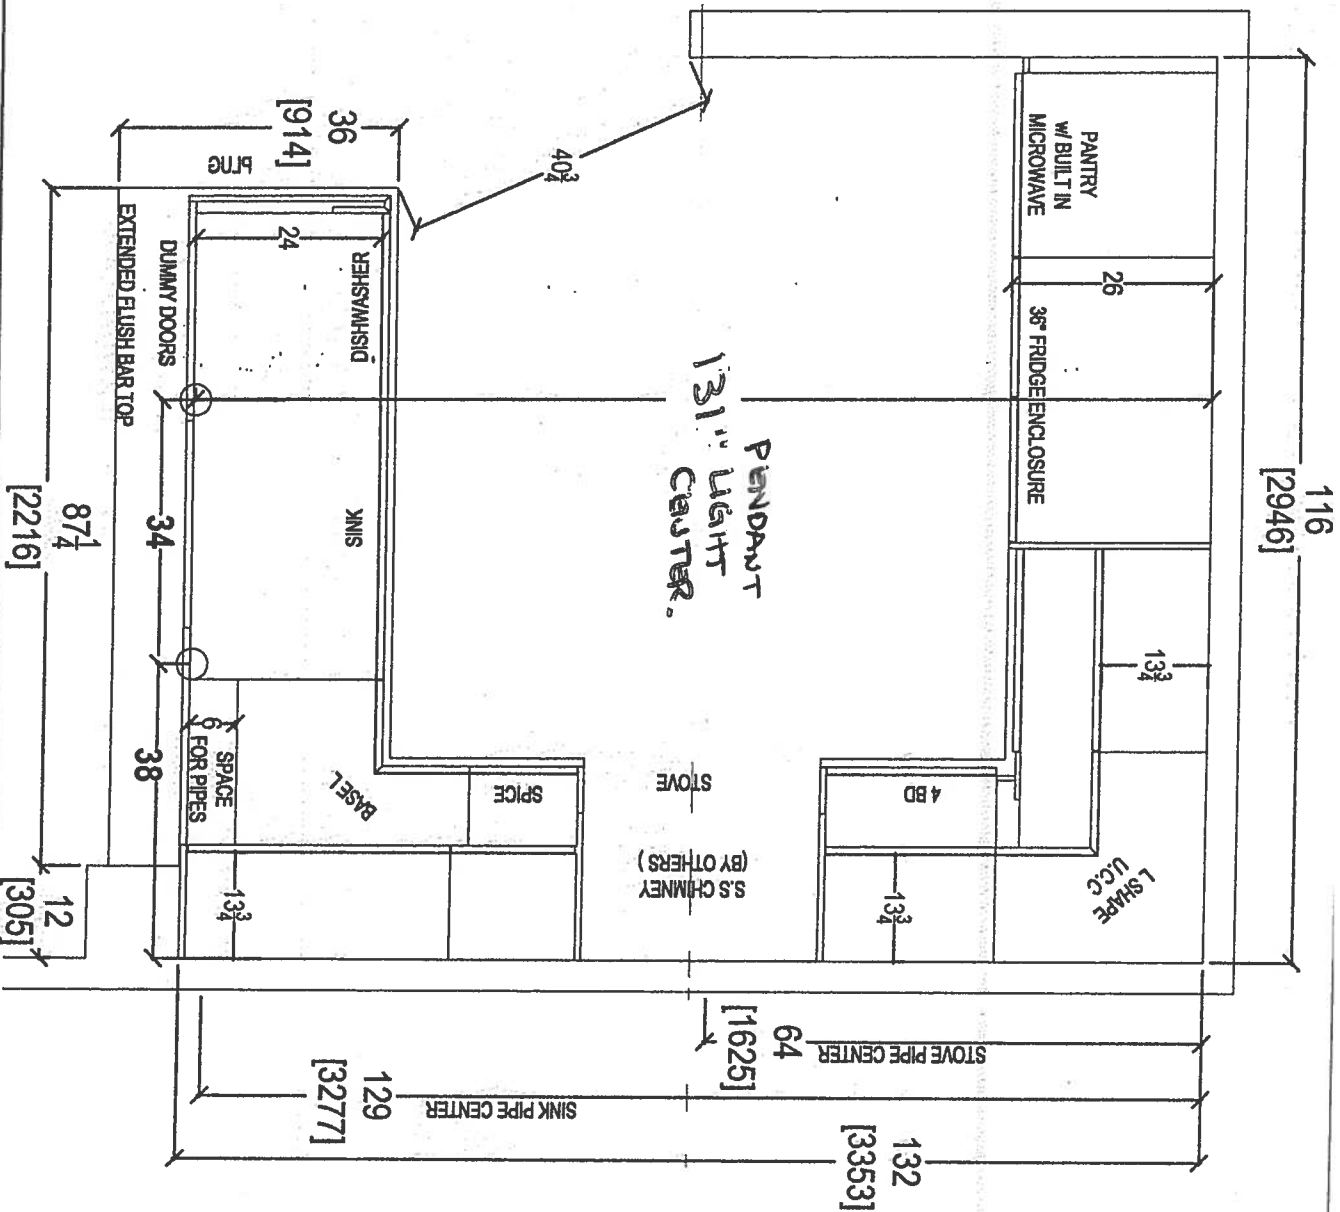


OTK

your kitchen, your taste.
80 SANTE DRIVE, VAUGHAN, ON L4K 3C4,
T: 416.746.1811 F: 905.761.5801

CLIENT: ROYAL PINE HOMES	UNIT 311 HMP	ROOM: KITCHEN	DRAWN BY: SK	COMMENTS:
SITE: HAMPTON PLACE	DOOR STYLE: —	DOOR HANDLE: —	SCALE: 1/2" = 1'-0"	PLEASE NOTE ALL DIMENSIONS ARE NOT FINAL AND ARE SUBJECT TO CHANGE UPON FINAL SITE MEASURE
PHONE: —	FINISH: —	DRW HANDLE: —	DATE: REVISED APRIL 2, 2019	
EMAIL: —	SPECIES: —	TOP: —	PAGE: —	

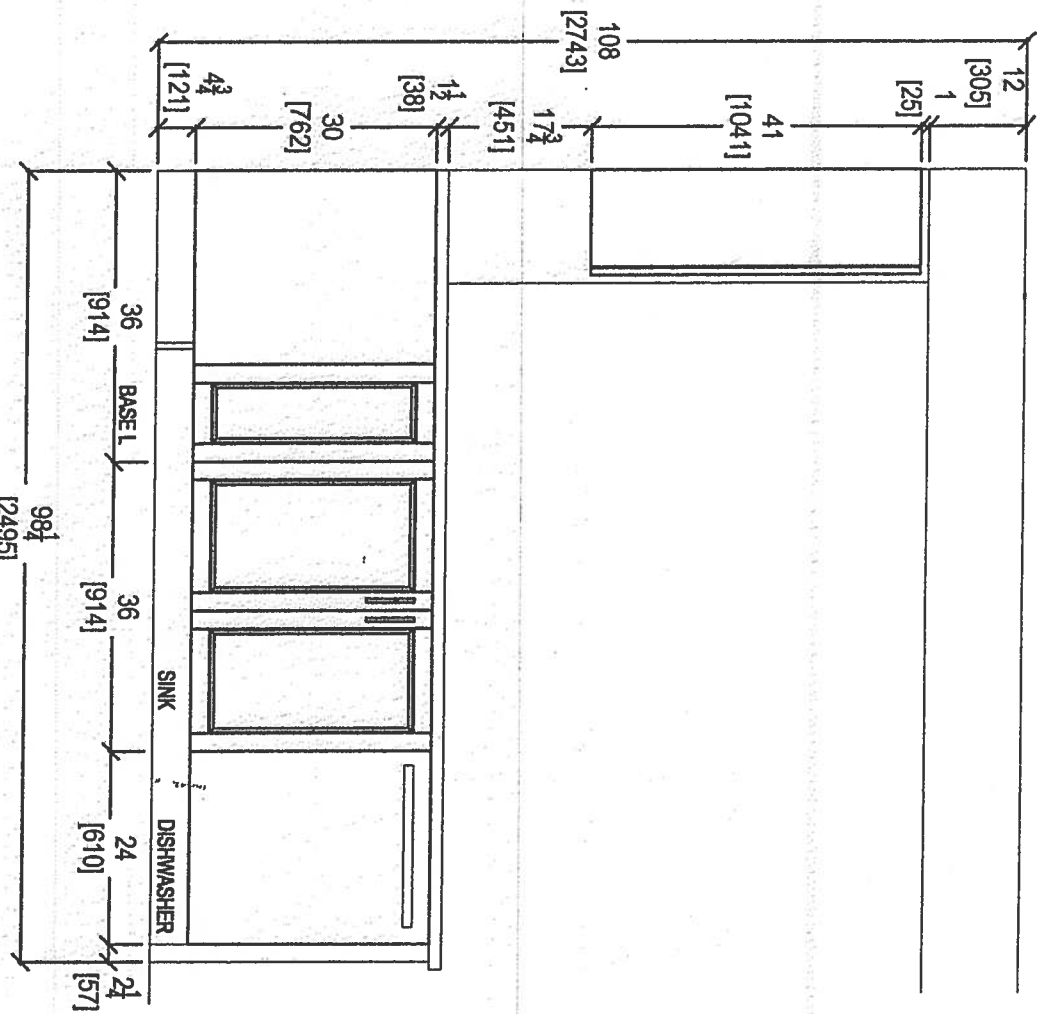

KITCHEN PENINSULA ELEVATION
FRONT VIEW

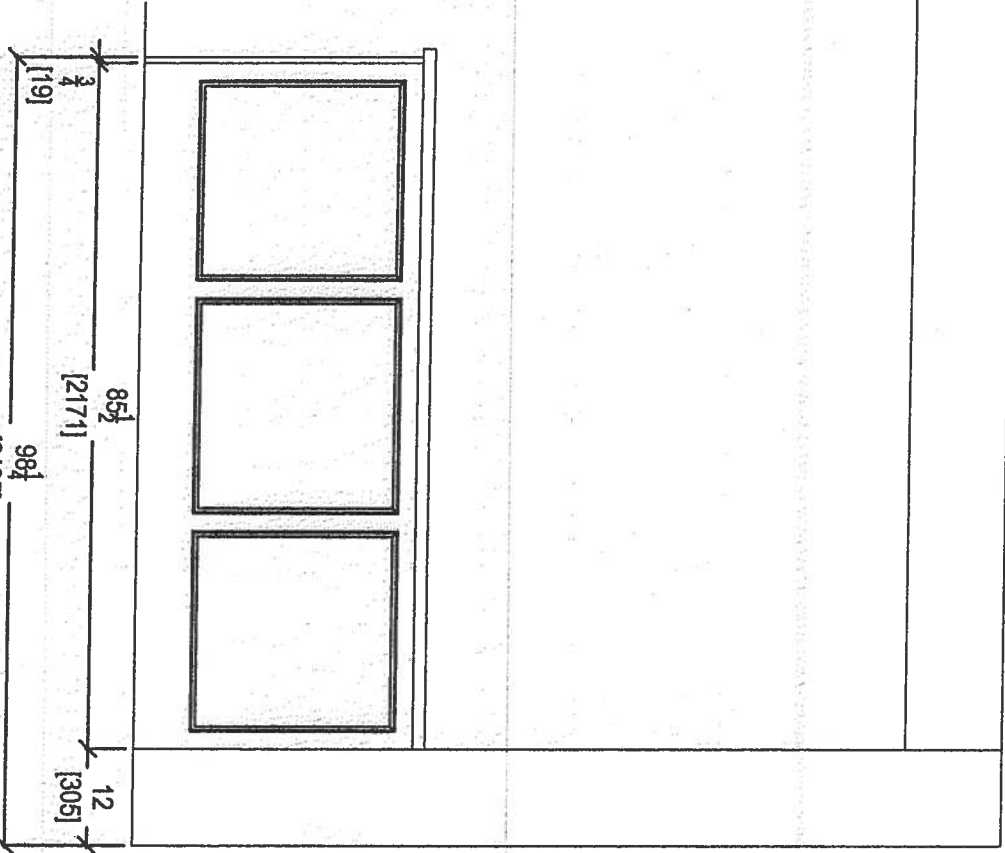


KITCHEN PENINSULA ELEVATION
REAR VIEW




80 SANTE DRIVE, VAUGHAN, ON L4K 3C4,
T: 416.746.1811 F: 905.781.5801

CLIENT: ROYAL PINE HOMES	UNIT 311 HMP	ROOM: KITCHEN	DRAWN BY: SK
SITE: HAMPTON PLACE	DOOR STYLE: —	DOOR HANDLE: —	SCALE: 1/2" = 1'-0"
PHONE: —	FINISH: —	DRW HANDLE: —	DATE: REVISED APRIL 2, 2019
EMAIL: —	SPECIES: —	TOP: —	PAGE: —



COMMENTS:
PLEASE NOTE ALL DIMENSIONS
ARE NOT FINAL AND ARE
SUBJECT TO CHANGE UPON
FINAL SITE MEASURE

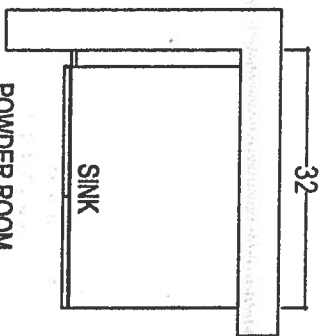

POWDER ROOM

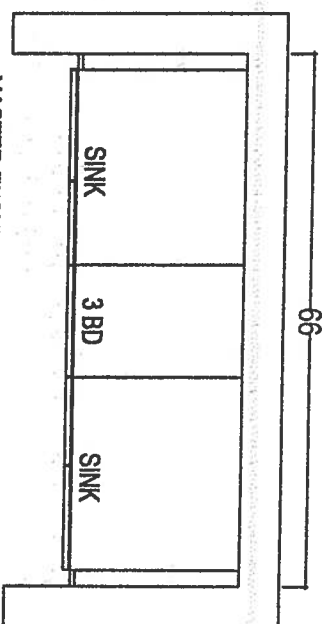

MASTER ENSUITE

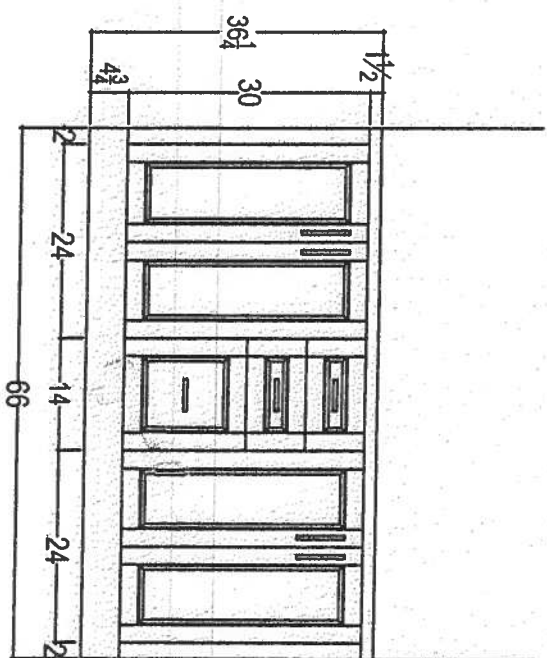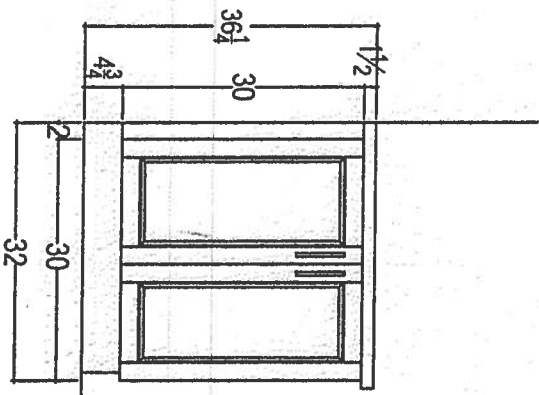

RAISED VANITIES w 3" SPLASH.




your kitchen, your taste.
80 SANTE DRIVE, VAUGHAN, ON L4K 3C4,
T: 416.746.1811 F: 905.761.5901

CLIENT: ROYAL PINE HOMES	JOB NAME: UNIT 311 HMP	ROOM: VANITIES	DRAWN BY: SK	COMMENTS:
SITE: HAMPTON PLACE	DOOR STYLE: —	DOOR HANDLE: —	SCALE: 1/2" = 1' - 0"	PLEASE NOTE ALL DIMENSIONS ARE NOT FINAL AND ARE SUBJECT TO CHANGE UPON FINAL SITE MEASURE
PHONE: —	FINISH: —	DRW HANDLE: —	DATE: REVISED APRIL 2, 2019	
EMAIL: —	SPECIES: —	TOP: —	PAGE: —	

KRFC302ESS

22 cu.ft. 36-Inch Width Counter Depth French Door Refrigerator with Interior Dispense

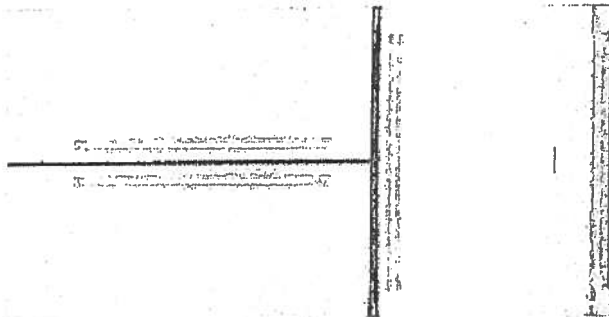

MADE IN
AMERICA

KitchenAid®

<http://www.kitchenaid.com>

KRFC302ESS

Key Features:

- ExtendFresh™ Temperature Management System
- Interior Water Dispense™
- Professionally-Inspired Design
- Produce Preserver
- Humidity-Controlled Crispers
- FreshChill™ Temperature-Controlled Full-Width Pantry
- Pull-Out Tri-Level Freezer Drawer
- SatinGlide® System
- LED Lighting
- Star-K Certified
- Automatic Ice Maker
- Max Cool

Product Dimensions:

Height: 72
Width: 35 3/4
Depth: 30 1/4

Electrical Requirements:

15 Amps.

Available In:

- ☐ Stainless Steel
☒ Black
☐ White

* Suite 311 * - UPG PACKAGE
#1.
w 36"
REFRIG
+++
Upgrade
Package 2

* Suite 311 *


Upgrade
Package!

WEE745H0FS

6.4 Cu. Ft. Slide-In Electric Range with True
Convection

Whirlpool®

<http://www.whirlpool.com>

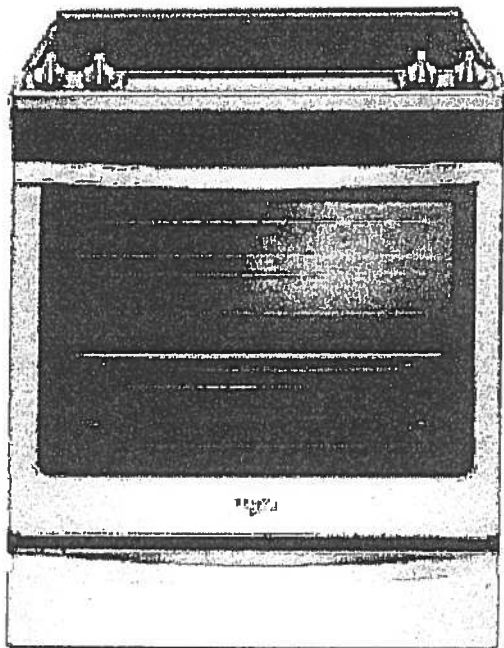

Key Features:

- Frozen Bake™ Technology
- True Convection Cooking
- FlexHeat™ Triple Radiant Element
- Convection Conversion
- AquaLift® Self-Cleaning Technology
- Temperature Sensor
- Rapid Preheat
- 6.4 Cu. Ft. Capacity
- Easy-Wipe Ceramic Glass Cooktop
- Large Oven Window
- Max Capacity Rack
- Hidden Bake Element

Product Dimensions:

Height: 36

Width: 29 7/8

Additional Information:

[Use And Care Guide](#)

[Dimension Guide](#)

[Installation Guide](#)

[Warranty Certificate](#)

INVESTED
IN
AMERICA



©Registered trademark/TM Trademark of Whirlpool, U.S.A. © 2016 Whirlpool Corporation. All Rights Reserved.
All other trademarks are owned by their respective companies.
Because Whirlpool Corporation policy includes a continuous commitment to improve our products, we reserve
the right to change materials and specifications without notice. We also reserve the right to discontinue or
transition products without notice.
Manufacturer's Suggested Retail Price (MSRP) and Minimum Advertised Price (MAP) provided for reference
purposes only. Dealer alone determines advertised and retail prices.
Created On: Friday, January 27, 2017 10:46:47

NN-ST765S Countertop - Panasonic Canada

Suite 311

Our website uses cookies and similar tools to improve its performance and enhance your user experience. By continuing to use this website without changing your settings you consent to their use. To find out more about the cookies we use or how to change your settings, please see our cookies policy. [OK](#) [Learn more.](#)

Panasonic

\$225 + HST

Consumer

Business

Store

Support

About Us

FRANÇAIS

Search



Countertop NN-ST765S

Price \$ 329.99

SHOP NOW

Microwave Ovens > Countertop

NN-ST765S

Evolved Genius® Microwave with Cyclonic Inverter Technology

- 1,200 W High Cooking Power
- Genius Sensor Cooking with 14 Categories
- 10-level Power Settings
- 3-multi-stage Cooking
- Sensor Reheat
- Cyclonic Inverter Technology
- Full LED Lighting System



Overview

Features

Specs


Accessories

Where to Buy


Support

New Cyclonic Inverter Technology

Evenly Cooked

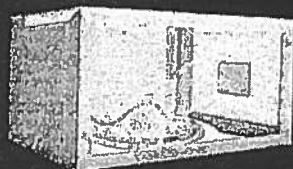

Cyclonic Inverter

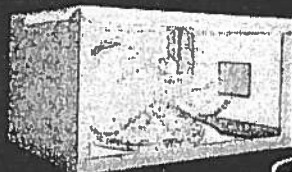


INVERTER


Meat



Fish

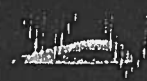

Chicken

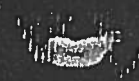

Milk



NN-ST765S Countertop - Panasonic Canada

3

1.6 cu. ft.
Oven capacity

1200 Watt
Cooking power

304 x 555 x 493 mm
Exterior dimensions (H x W x D)

SEE ALL SPECS

NN-TK722S
27" Trim kit for NN-ST765S

NN-TK732S
30" Trim kit for NN-ST765S

NN-TK714SS
24" Trim kit for NN-ST765S

SPECIFICATIONS		Popcorn Button	Yes
		Quick Minute	Yes
		Cavity Dimensions (W x D x H)	Approx. 418 x 470 x 228 mm 15.7 x 18.5 x 8.3 inch
		Unit Dimensions (W x D x H)	555 x 493 x 304 mm 21.9 x 19.4 x 12 inch
		Carton Dimensions (W x D x H)	627 x 540 x 360 mm
ACCESSORIES	TRIM KITS	27" Model Number	NN-TK722S
		30" Model Number	NN-TK732S
	Accessory		Glass Tray

Copyright ©Panasonic Canada Inc.




Microwave Ovens Countertop
Countertop NN-ST765S

MODEL & SIZE	Model Number	NN-ST765S
	Type	Family-size
	Installation	Countertop or built-in
	Oven Capacity	1.6 cu. ft.
	Cooking Power	1200W
	Turntable Diameter	380mm
PANASONIC TECHNOLOGY	Panasonic Inverter	Cyclonic Inverter
	Genius Sensor	Genius®
DESIGN	Color	Stainless Steel
	Control Panel	Touch pad
	Display Panel	New 4 Digit + Icon LCD / Green
STYLE	Door Window	Clear Black
	Door Release	Push Open
	Oven Interior	Paint White
PERFORMANCE	Multi-stage Cooking	3 stage
PROGRAMMABLE FEATURES	Sensor Cook	Yes
	Sensor Reheat	Yes
	Auto Cook/Reheat	Yes
	More / Less Control	Yes
	Inverter Turbo Defrost	Yes
	Keep Warm Button	Yes

NINST 7655-

Trim Kit
NNTK714SS \$189

- 2. Installation Diagram
- 2. Schéma d'installation
- 2. Diagrama de instalación

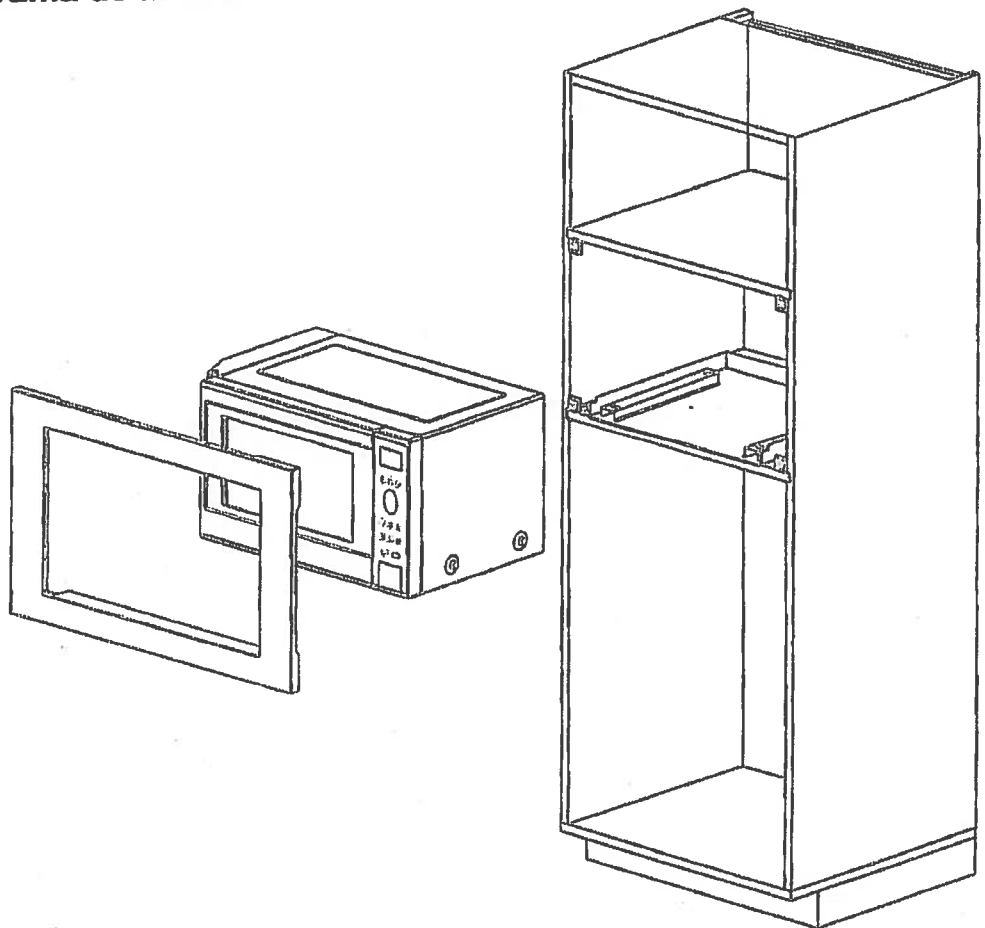


Trim Kit Dimensions	
Width	596 mm (23 1/2")
Height	410 mm (16 1/8")
Depth (Thickness)	20 mm (3/4")

Dimensions du nécessaire d'encastrement	
Largeur	596 mm (23 1/2 po)
Hauteur	410 mm (16 1/8 po)
Profondeur (épaisseur)	20 mm (3/4 po)

Dimensiones del juego de acabados	
Ancho	23 1/2" (596 mm)
Altura	16 1/8" (410 mm)
Profundidad (grosor)	3/4" (20 mm)

3. Cabinet Diagram and Dimensions
3. Schéma de l'armoire et dimensions
3. Dimensiones y diagrama del gabinete

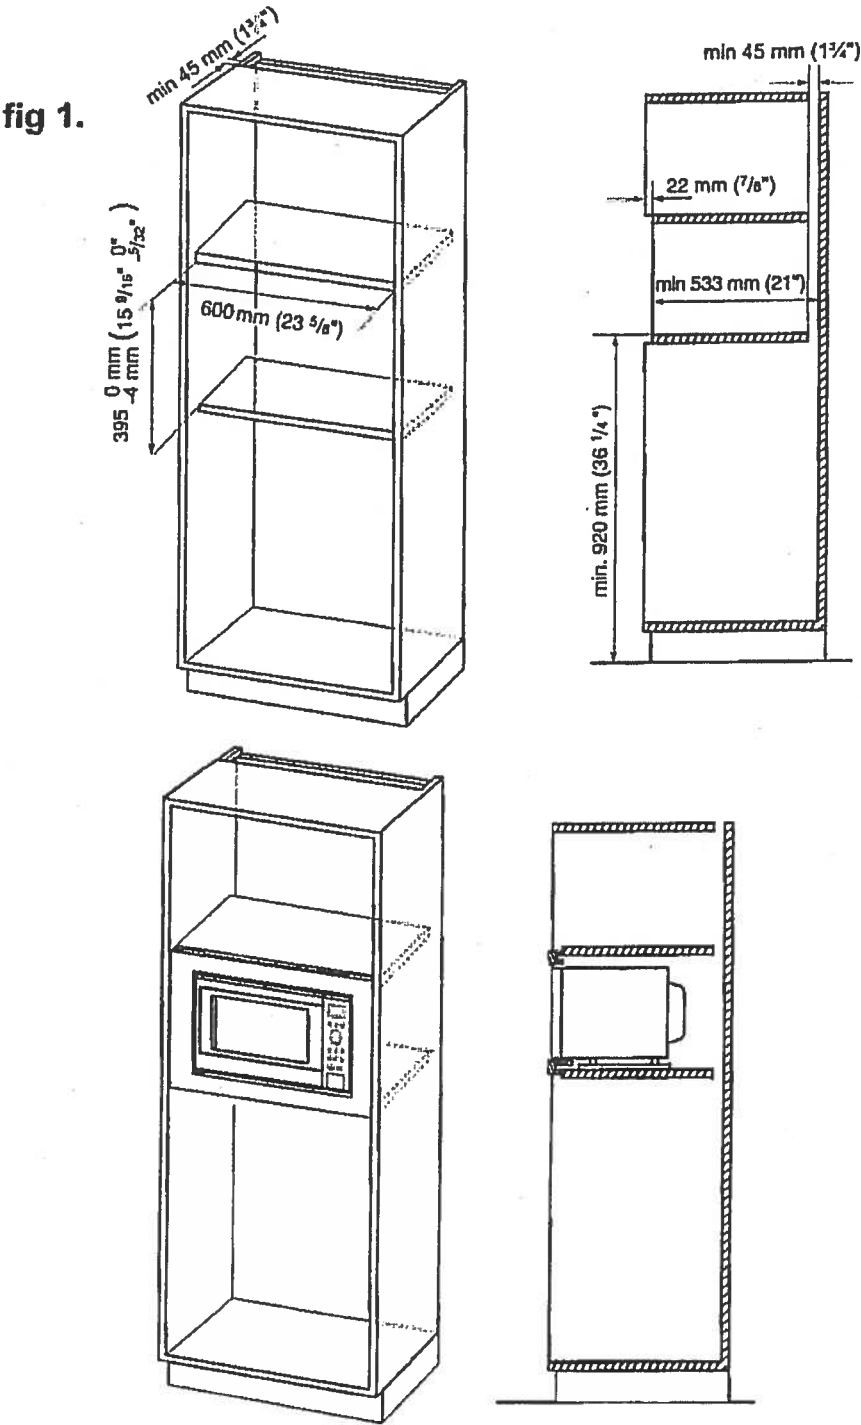

*Suite 311 *

4/3/2018

Hoods From Collection Potenza Vulcano | Falmec

U.S.A. (/en_us/) - Select Country (/en_us/country/)

Catalogues (/en_us/catalog/) Downloads (/en_us/downloads/) Reserved area (http://portal.falmec.com/) Contacts (/en_us/contacts/)

Search Q


falmec
(/en_us/)

PRODUCTS COMPANY (/EN_US/COMPANY/) FALMEC WORLD (/EN_US/FALMEC_WORLD/)

NEWS & PRESS (/EN_US/NEWS/)

HOME (/EN_US/) > HOODS (/EN_US/TYPOLOGY/HOODS-1/) > POTENZA (/EN_US/TYPOLOGY/HOODS-1/COLLECTION/POTENZA-15/) > VULCANO

SHARE THIS PRODUCT

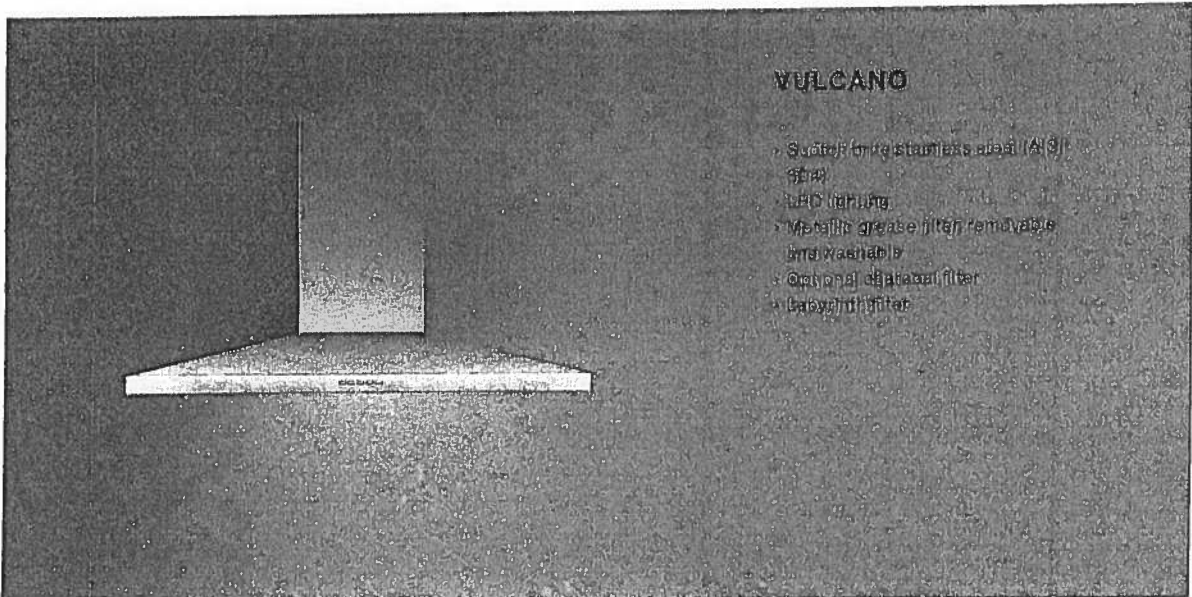

VARIANTS

FPVUL30W3SS /
Vulcano Wall 30"
(76 cm) 280 CFM

FPVUX36W6SS /
VulcanoXL Wall 36"
(90cm) 600 CFM

FPVUL24W3SS /
Vulcano Wall 24"
(60 cm) 280 CFM

FPVUX30W6SS /
VulcanoXL Wall 30"
(76 cm) 600 CFM

TECHNICAL FEATURES

Installation type
Wall
Dimensions
76 cm / 30 in
Features
Scotch brite stainless steel (AISI 304)
Electronic control
Metallic grease filter, removable and washable
Optional charcoal filter
Labyrinth filter
Finish
Scotch brite stainless steel (AISI 304)
Motor
450 m³/h / 280 cfm
Type of control
Electronic control
Speed settings

ACCESSOIRES

KACL.510#1
Extension H700 - Wall
KACL.512#1
Extension H960 - Wall
KACL.B15
Protective cleaning cloths for stainless steel (box 10 pcs)
103050107
Square charcoal filter - Type 3

CONSUMPTION

Maximum consumption
150 W
Current
120V 60Hz
Frequency

PACKAGING

Gross weight
20 Kg
Net weight
15 Kg
Volumes
0.30 m³
Packaging size
Length: 995 mm
Height: 595 mm
Depth: 510 mm

COOKIE POLICY

We use cookies on "www.falmecnorthamerica.com". If you continue to use "www.falmecnorthamerica.com" you will be agreeing to the website General Terms and Conditions of Use, Privacy Policy and the use of cookies while using the website. To find out more about cookies and how to change your preferences please see our Cookie Policy (http://www.falmecnorthamerica.com/en_us/cookie/).

Lighting
Led 2x1,2 W - 3200 K

DOWNLOAD TECHNICAL SHEET

* Suite 311 *

Upgrade
Package 1

WDTA50SAHZ

Whirlpool®

<http://www.whirlpool.com>

Contemporary Design. Stainless Steel Tub
Dishwasher with TotalCoverage Spray Arm

Key Features:

- Sensor Cycle
- TotalCoverage Spray Arm
- 1-Hour Wash Cycle
- Tap Touch Controls

Product Dimensions:

Height: 34 1/2

Width: 23 7/8

Depth: 24 1/2

Additional Information:


[Use And Care](#)

[Dimension Guide](#)

[Installation Guide](#)

[Energy Guide](#)

[Warranty](#)

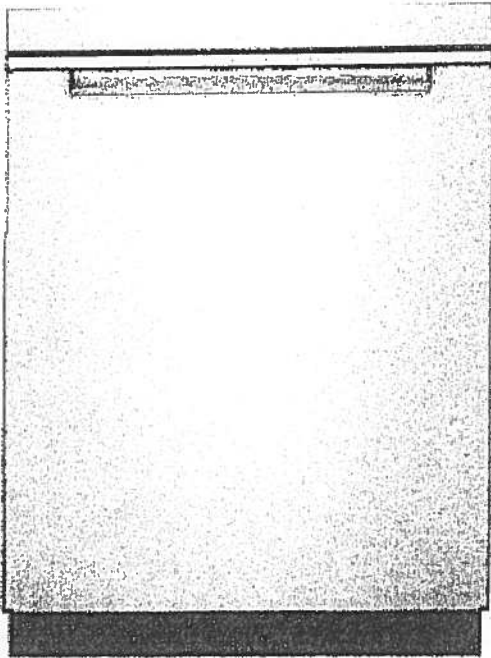

Available in:

☒ Black

Fingerprint Resistant Sunset Bronze

Fingerprint Resistant Black Stainless

☐ White

Fingerprint Resistant Stainless Steel

INVESTED
IN
AMERICA



©Registered trademark/TM Trademark of Whirlpool, U.S.A. © 2016 Whirlpool Corporation. All Rights Reserved. All other trademarks are owned by their respective companies.

Because Whirlpool Corporation policy includes a continuous commitment to improve our products, we reserve the right to change materials and specifications without notice. We also reserve the right to discontinue or transition products without notice.

Manufacturer's Suggested Retail Price (MSRP) and Minimum Advertised Price (MAP) provided for reference purposes only. Dealer alone determines advertised and retail prices.

Upgrade
Package I


* Suite 311 *

WFW75HEFW

4.5 cu. ft. Front Load Washer with Precision
Dispense



<http://www.whirlpool.com>

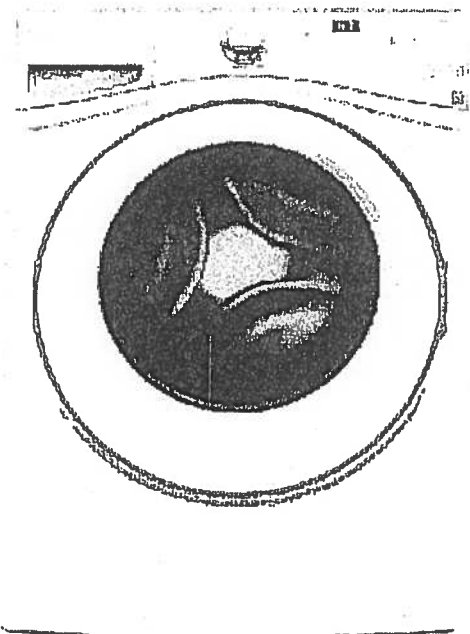

Key Features:

- Precision Dispense
- Adaptive Wash Technology
- Smooth Wave Stainless Steel Wash Basket
- 4.5 cu. ft. Capacity
- ENERGY STAR® Qualified

Product Dimensions:

Height: 39 3/4

Width: 27

Depth: 33 5/16

Electrical Requirements:

15 or 20. 120 V.

Additional Information:

[Use And Care Guide](#)

[Dimension Guide](#)

[Installation Guide](#)

[Energy Guide](#)

[Warranty Certificate](#)

INVESTED
IN
AMERICA



®Registered trademark/TM Trademark of Whirlpool, U S A. ©2013 Whirlpool Corporation All Rights Reserved.
All other trademarks are owned by their respective companies.
Because Whirlpool Corporation policy includes a continuous commitment to improve our products, we reserve
the right to change materials and specifications without notice. We also reserve the right to discontinue or
transition products without notice.
Manufacturer's Suggested Retail Price (MSRP) and Minimum Advertised Price (MAP) provided for reference
purposes only. Dealer alone determines advertised and retail prices.
Created On: Wednesday, March 23, 2016 11:51:03

Upgrade
Package I

Suite 311

YWED75HEFW

Whirlpool®

8.5 cu. ft. Duet® High Efficiency Front Load Electric
Dryer with ENERGY STAR®

<http://www.whirlpool.com>

MSRP: \$0.00

Key Features:

- Advanced Moisture Sensing System
- Quad Baffles
- Tap Touch Controls with Memory
- EcoBoost™ Option
- Wrinkle Shield™ Plus Option
- Undercounter Installation
- 7.4 Cu. Ft. Capacity
- ENERGY STAR® Qualified

Product Dimensions:

Height: 39

Width: 27


Depth: 31

Additional Information:

Use And Care

Installation Guide

Warranty

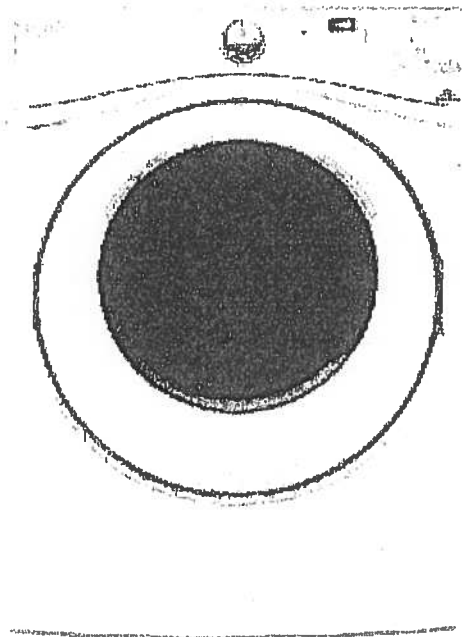

Available in:

☐ White

INVESTED
IN
AMERICA



®Registered trademark/TM Trademark of Whirlpool, U.S.A. © 2016 Whirlpool Corporation. All Rights Reserved. All other trademarks are owned by their respective companies.


Because Whirlpool Corporation policy includes a continuous commitment to improve our products, we reserve the right to change materials and specifications without notice. We also reserve the right to discontinue or transition products without notice.

Manufacturer's Suggested Retail Price (MSRP) and Minimum Advertised Price (MAP) provided for reference purposes only. Dealer alone determines advertised and retail prices.

Suite
Hampton

Living Room

→ CONDUIT =

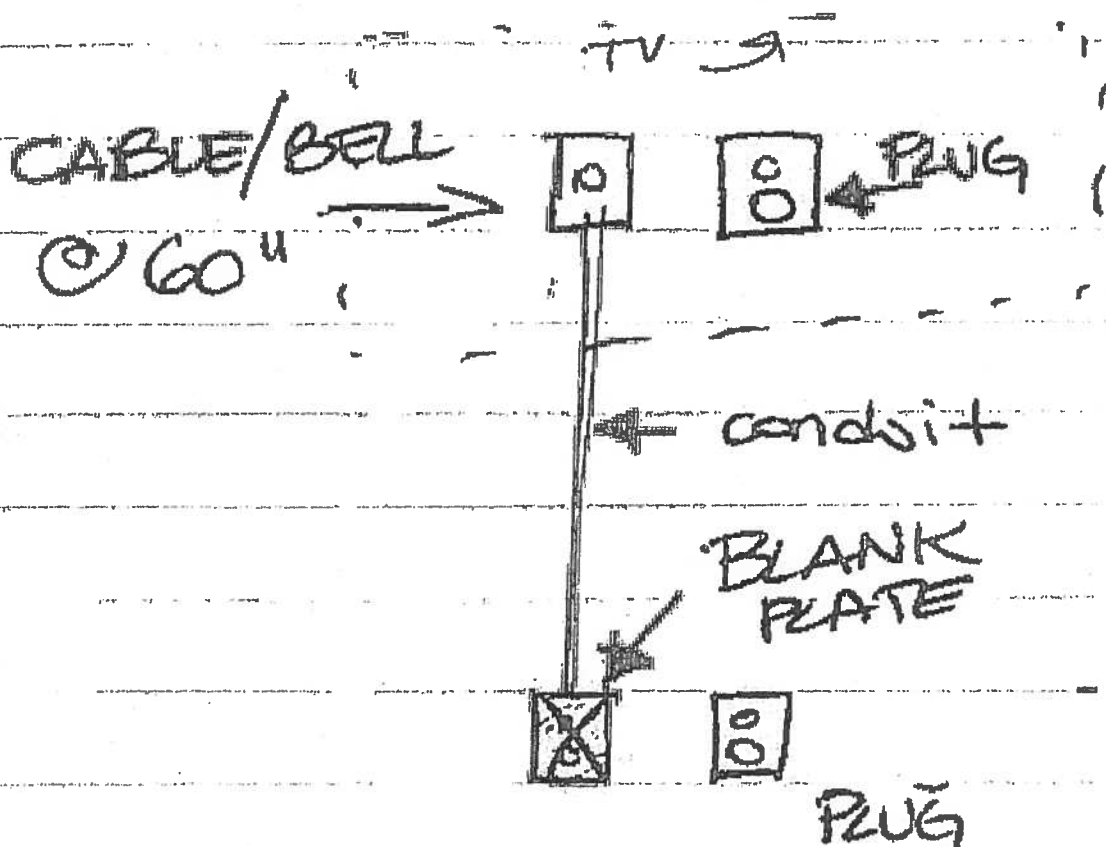

Countertop Edges

* Suite 311 *

CONNOLLY Marble & Granite Ltd.

EDGE
DETAILS


004

A.



STRAIGHT EDGE
(STANDARD - 3/4")


I.

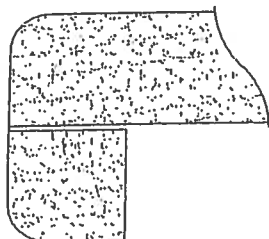

DOUBLE TOP "D" EDGE
(STANDARD - 1 1/2")

- * Kitchen
- * Master Ensuite
- * Main Bath

M.

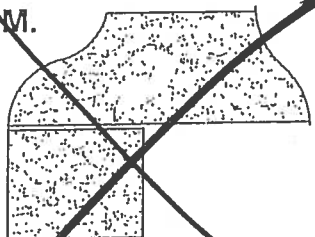

OGEE - SQUARE EDGE
(MED./HIGH - 1 1/2")

EDGING UP-GRADE OPTIONS