



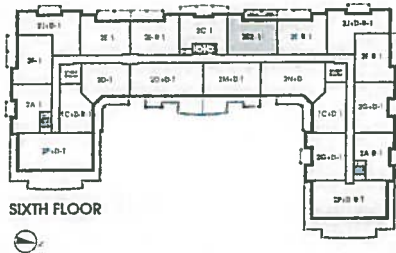

# Flanders

SUITE 702  
ORIGINAL LAYOUT

1,039 SQ FT *plus 180 sq. ft. of balcony area*

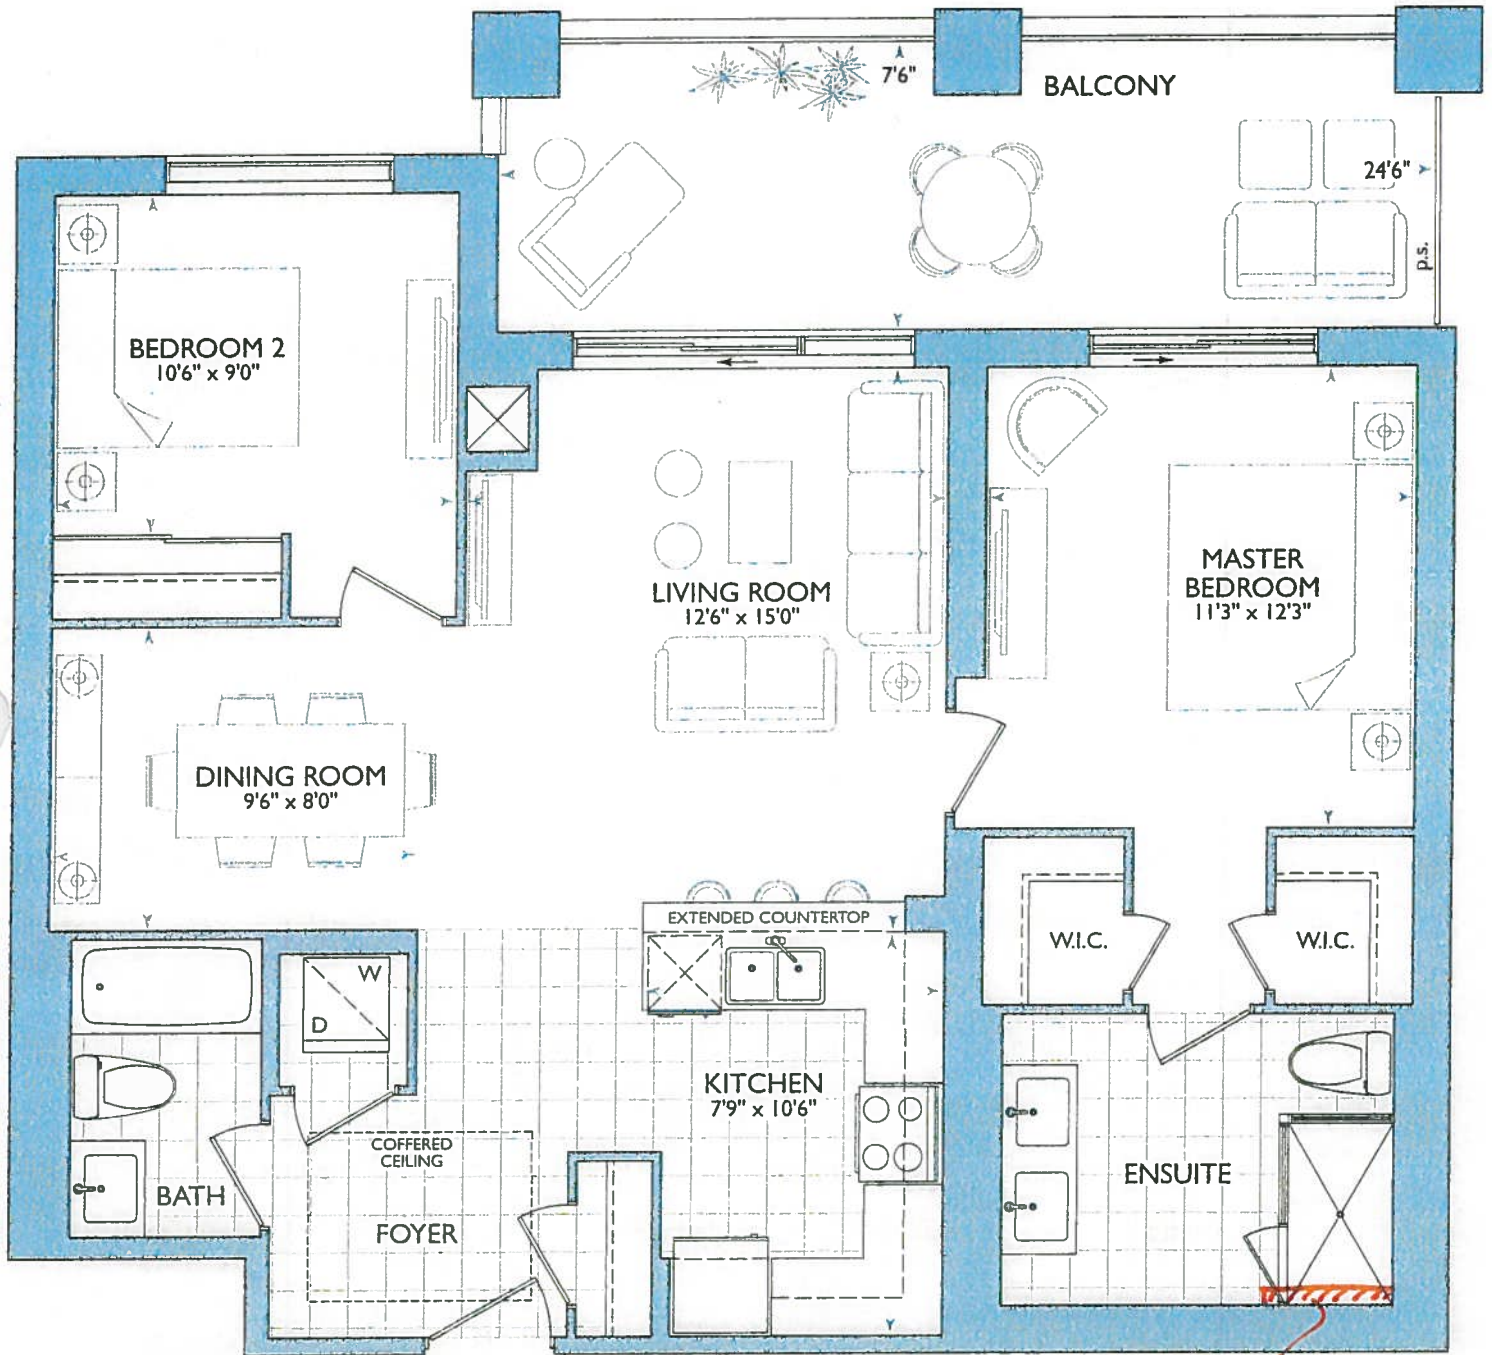

SIXTH FLOOR



SEVENTH FLOOR

4" x 40" WET  
WALL  
ADDED FOR  
FAUCET.





**PURCHASER'S EXTRAS (PE)**  
Hampton Place - Braylea Investments Inc.

PURCHASERS: JASODRA B. RAMPERSAD and BRYAN G. THORNE

TEL: RES.: 416-335-9670 BUS.: 647-502-5645

| LOT NUMBER | PHASE | HOUSE TYPE    | REG. PLAN # |  |  |
|------------|-------|---------------|-------------|--|--|
| 702        | 1     | FLANDERS(2E2) |             |  |  |

| Item | QTY | Description                                                                                                                                                                                          | Addition to Purchase Price |
|------|-----|------------------------------------------------------------------------------------------------------------------------------------------------------------------------------------------------------|----------------------------|
| 1    |     | 1 - MAIN BATH- Relocate the Potlight from Main Bath ceiling (Refer to the Purchase & Sale Agreement) and install the potlight over the Main Bath Tub<br>Note: As per Fonzie                          |                            |
| 2    |     | 1 - LIVING ROOM- Raise TV receptacle in Living Room- As per Site<br>Note:                                                                                                                            |                            |
| 3    |     | 1 - PURCHASER AWARE AND ACCEPTS THAT ANY CHANGES MADE TO UPGRADES AFTER SIGNING THIS PURCHASERS EXTRA FORM ARE SUBJECT TO A MINIMUM ADMINISTRATION FEE OF \$1,000. PLUS A 10% HOLDBACK FEE.<br>Note: |                            |



Sub Total  
GST  
Total

This is a request to price the above extras/upgrades in accordance with the following terms and conditions:

- In the event the work on the house has progressed beyond the point where the items covered by this extra cannot be installed without entailing any unusual expense, then this order is to be cancelled and any deposit paid in connection with the same is to be refunded to the Purchaser.
- The Vendor will undertake to incorporate the work covered by the sales extra in the construction of the house but will not be liable to the purchaser in any way, if for any reason the work covered by the extra is not carried out. In that event, any monies paid in connection with the same shall be returned to the Purchaser.
- It is understood and agreed that if for any reason whatsoever the transaction of Purchase and Sale is not completed, the total cost of extras ordered are not refundable to the Purchaser(s).
- Extras or changes will not be processed unless signed by the Vendor.
- These extras may not be amended without the written consent of Braylea Investments Inc..
- The Purchaser(s) and the Vendor acknowledge and agree that this form shall not be deemed to be part of the Agreement of Purchase and Sale entered into between them, nor an addendum thereto.
- No Estimates or orders will be accepted once construction has commenced.
- Prices are estimates only and guaranteed for a period of 5 days only.
- Any cancellations to this order, providing they can be cancelled, are subject to a \$500 minimum administration charge and a 10% cancellation charge for the total amount being cancelled.
- For Visa, Mastercard and Debit payments, transactions are identified on you statement as "SHERWAY CONSTRUCTION LTD", an Authorized Visa /Mastercard/Debit Merchant and authorized Royal Pine Homes company.

**Payment Summary**

| Paid By        | Amount   | Detail |
|----------------|----------|--------|
| Amendment      | \$04.00  |        |
| Amendment      | \$791.00 |        |
| Total Payment: |          |        |

**Bonus Package From Agreement of Purchase and Sale dated April 29, 2017**

Bonus Total  
PE# 7,096 - January  
25, 2018  
Remaining Balance

PURCHASER:

JASODRA B. RAMPERSAD  
  
BRYAN G. THORNE

31-Jul-19  
DATE

PURCHASER:

31-Jul-19  
DATE

CONSULTANT:

Laura Di Pedo

VENDOR:

PER: Braylea Investments Inc.

☐ Decor

☐ Builder

☐ Purchaser

Printed: 31-Jul-19 at 12:18 pm

January 25, 2018

SR BT


KITCHEN

- STD KITCHEN LAYOUT
- UPGRADE APPLIANCE PKG.
- (x4) = PUCK LIGHTS
- (x1) = PLUG PENINSULA
- (x3) = POTS OVER PENINSULA (sep. SWITCH SEE GTK LAYOUT)
- 6' STOVE PIPE CENTER
- 12.5" SINK PIPE CENTER

→ Delete Ceramic Accessories at:  
Main Bath + Master Ensuite

→ Delete Mirrors at: Main bath +  
Master Ensuite

\* ENSUITE ENLARGED  
4" - ADD 4" x 40" WET  
WALL FOR SHOWER  
FAUCET SEE REVISED  
W.I.C. + MASTER BEDRM  
MEASUREMENTS

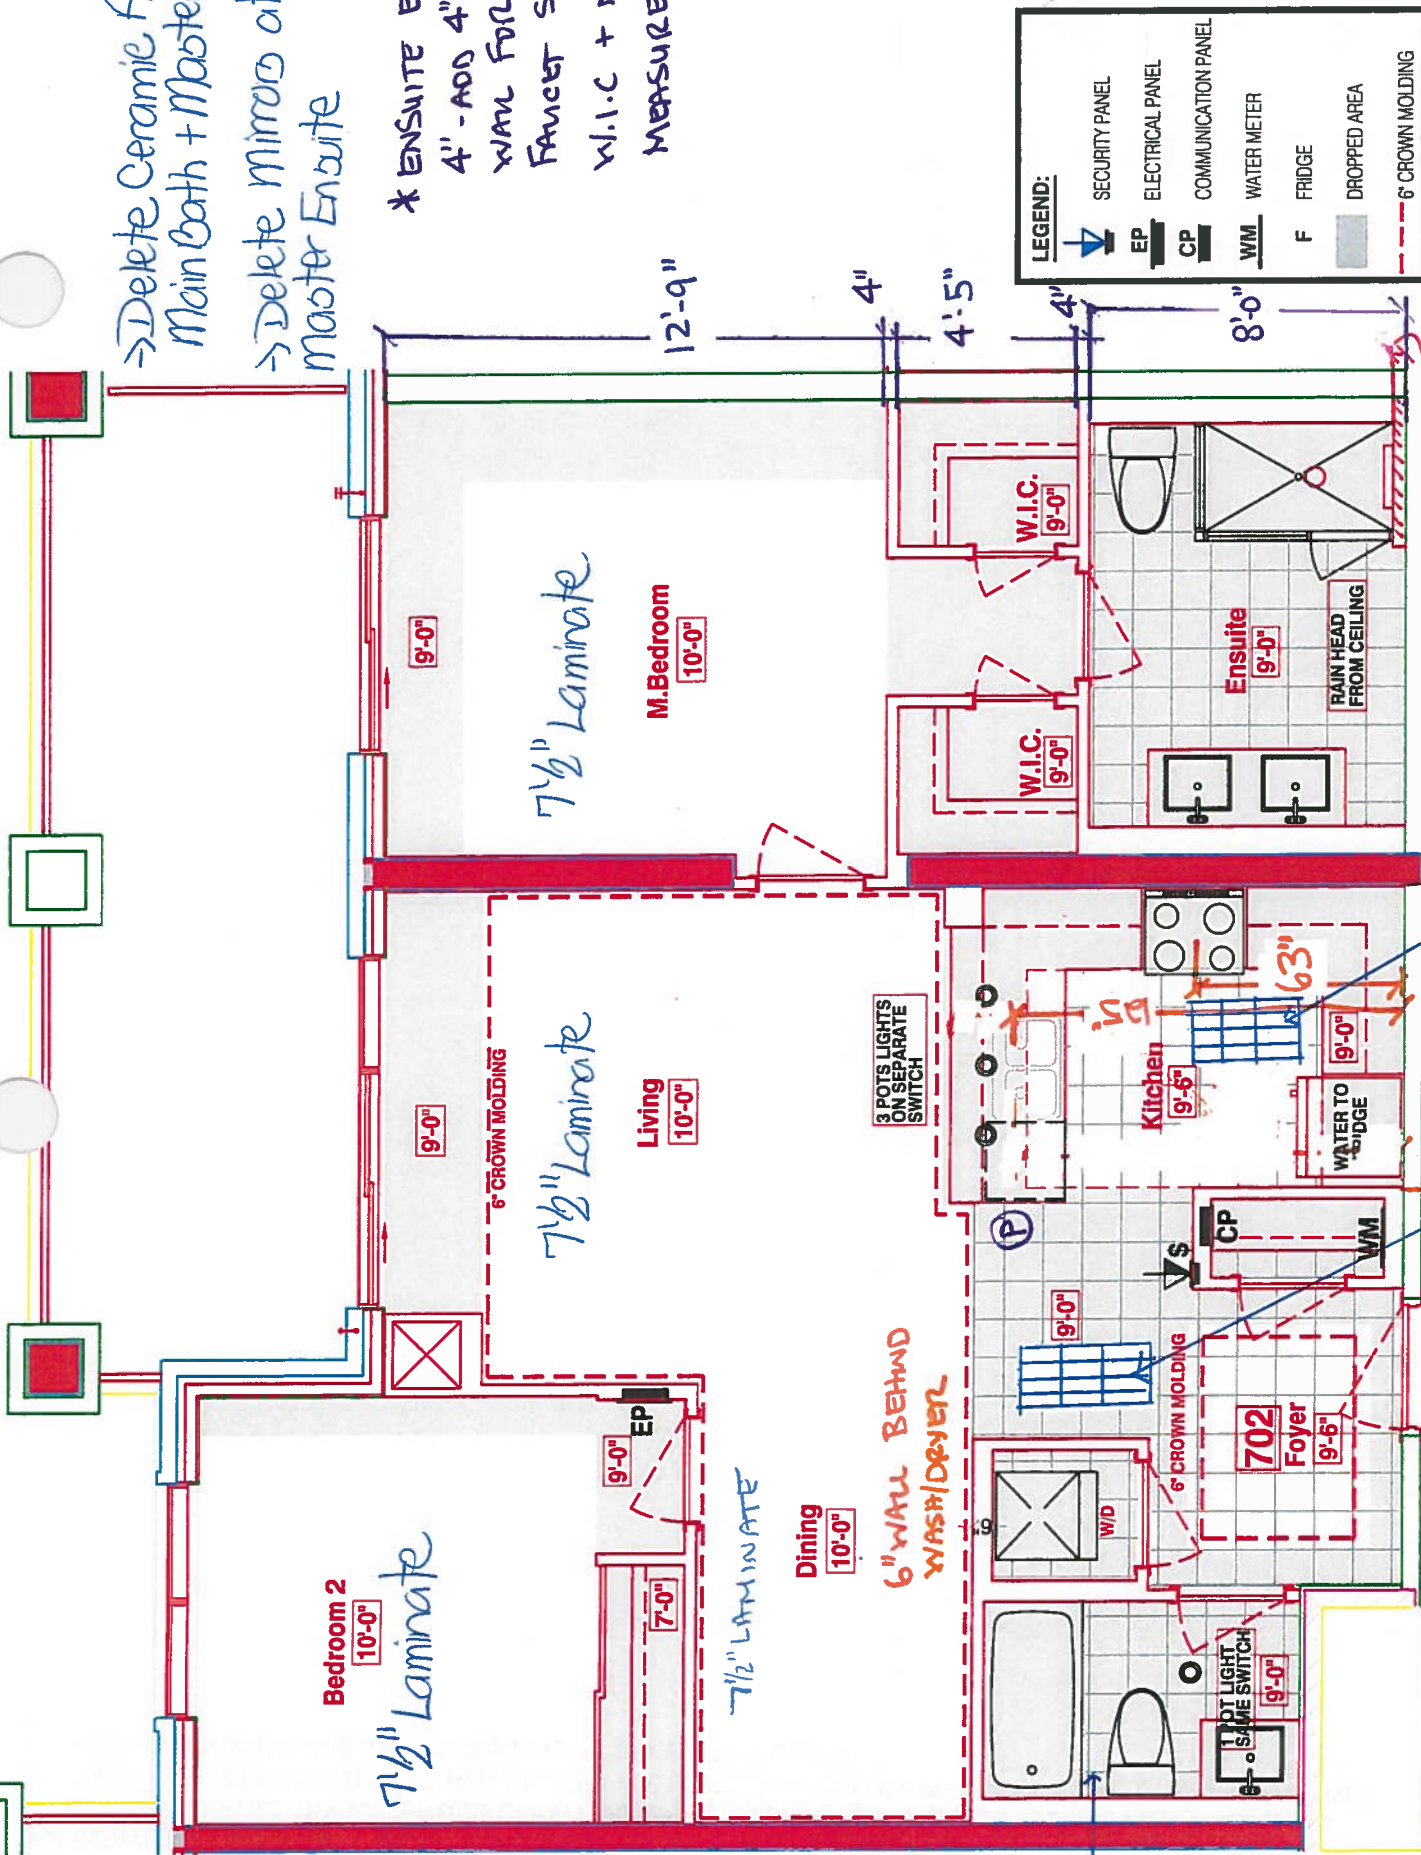

SUITE 702 - FLANDERS

25 Baker Hill Blvd - Stouffville, ON Jan 25, 2018

RECEIVED  
1/25/2018



Book  
SITE COPY

## CONSTRUCTION SUMMARY

Hampton Place

PURCHASERS: JASODRA B. RAMPERSAD and BRYAN G. THORNE

TEL: RES.: 416-335-9670 BUS.: 647-502-5645

| LOT NUMBER | PHASE | HOUSE TYPE    | CLOSING DATE |
|------------|-------|---------------|--------------|
| 702        | 1     | FLANDERS(2E2) | 12-Nov-18    |

|          |                                     |                                                 |
|----------|-------------------------------------|-------------------------------------------------|
| Offer    | <input checked="" type="checkbox"/> | SIDE BY SIDE PARKING IN LIEU OF TANDEM PARKING. |
| Workshee |                                     | Note:                                           |

|          |                                     |                                                                                                                                                                                       |
|----------|-------------------------------------|---------------------------------------------------------------------------------------------------------------------------------------------------------------------------------------|
| Offer    | <input checked="" type="checkbox"/> | <del>PURCHASER WILL HAVE THE OPTION TO CHANGE THE STANDARD TILE IN THE FOYER AND KITCHEN TO STANDARD LAMINATE AS PER VENDORS SAMPLES AT TIME OF DECOR APPOINTMENT AT NO CHARGE.</del> |
| Workshee |                                     | Note:                                                                                                                                                                                 |

|          |                                     |                                                                                                                        |
|----------|-------------------------------------|------------------------------------------------------------------------------------------------------------------------|
| Offer    | <input checked="" type="checkbox"/> | PURCHASER TO RECEIVE \$5,000(INCLUDES APPLICABLE TAXES) WORTH OF UPGRADES AT THE DECOR CENTER AT TIME OF COLOUR CHART. |
| Workshee |                                     | Note:                                                                                                                  |

|          |                                     |                          |
|----------|-------------------------------------|--------------------------|
| Offer    | <input checked="" type="checkbox"/> | ADDITIONAL - LOCKER UNIT |
| Workshee |                                     | Note:                    |

|         |                                     |                       |
|---------|-------------------------------------|-----------------------|
| Offer   | <input checked="" type="checkbox"/> | WATER LINE FOR FRIDGE |
| Upgrade |                                     | Note:                 |

|         |                                     |                                                                                                              |
|---------|-------------------------------------|--------------------------------------------------------------------------------------------------------------|
| Offer   | <input checked="" type="checkbox"/> | INSTALL POTLIGHT IN MAIN BATH CENTERED BETWEEN BATH AND WALL BY SINK AS PER SKETCH. (NOT ON SEPARATE SWITCH) |
| Upgrade |                                     | Note:                                                                                                        |

|         |                                     |                                                              |
|---------|-------------------------------------|--------------------------------------------------------------|
| Offer   | <input checked="" type="checkbox"/> | INSTALL RAINHEAD FROM CEILING FROM VENDORS STANDARD SAMPLES. |
| Upgrade |                                     | Note:                                                        |

|         |                                     |                                                                                                                                                                                                                                                                                                           |
|---------|-------------------------------------|-----------------------------------------------------------------------------------------------------------------------------------------------------------------------------------------------------------------------------------------------------------------------------------------------------------|
| Offer   | <input checked="" type="checkbox"/> | INSTALL 3 POTLIGHTS ABOVE SINK ON SEPARATE SWITCH. ONE POTLIGHT CENTERED BETWEEN EXTENDED WALL (BY EXTENDED COUNTERTOP) AND END OF PENINSULA. OTHER TWO POTLIGHTS SHOULD BE CENTERED BETWEEN CENTER POTLIGHT AND END OF PENINSULA AND CENTER POTLIGHT AND EXTENDED WALL AS PER SKETCH ON SEPARATE SWITCH. |
| Upgrade |                                     | Note:                                                                                                                                                                                                                                                                                                     |



## CONSTRUCTION SUMMARY

## Hampton Place

**PURCHASERS: JASODRA B. RAMPERSAD and BRYAN G. THORNE**

**TEL: RES.: 416-335-9670 BUS.: 647-502-5645**

|            |       |               |              |  |
|------------|-------|---------------|--------------|--|
| LOT NUMBER | PHASE | HOUSE TYPE    | CLOSING DATE |  |
| 702        | 1     | FLANDERS(2E2) | 12-Nov-18    |  |

**Date Added: 25-Jan-18**

**Invoice Number: 7096**

**1 - CLARIFICATION - REFER TO APAS;**  
**FOYER & KITCHEN - Install Standard Porcelain Tiles throughout Foyer and Kitchen, where applicable (See Sketch)**

**1 - KITCHEN & BATHROOMS - Purchaser has DECLINED All Upgrades offered during decor appointment at the decor centre for kitchen & bathroom cabinetry. Standard Kitchen Layout & Standard Bathroom Vanities to be installed as per standard plan. (See Sketch)**  
**Note:**

**1 - KITCHEN - Install Standard Granite Countertop - BIANCO ANTICO - To be installed throughout kitchen, where applicable. (Does not include granite backsplash) (See Sketch)**  
**Note:**

**1 - KITCHEN - COUNTERTOP EDGING -** Install UPGRADE " M " EDGING - To be installed throughout kitchen countertop, where applicable. (See Sketch)  
Note:

**1 - DISCLAIMER - GRANITE COUNTERTOP;**  
**KITCHEN -** Due to the many variables that can affect the pattern, colour and/or design and "pitting" of natural products, granite installed will not be identical to the samples displayed.  
**Note:** Every effort is made to provide granite countertops as close as possible but the vendor is not responsible for results which differ from the sample displayed. All countertop surfaces may have seams, and product pattern and shade can change in areas containing seams.

**1 - DISCLAIMER - STONE COUNTERTOP;**  
**KITCHEN - Stone slabs vary in size & all seams are visible & the fabricator reserves the right to position the seams as necessary.**  
**Note:**

KITCHEN - Kitchen Sink - Install Upgrade Undermount Sink - BLANCO Quatrus U Super Single Undermount Sink - Model # 401248 (See Attached)

Note:

**1 - KITCHEN - Kitchen Faucet - Install Upgrade Faucet - DELTA MATEO Pull-Down Kitchen Faucet (Single Hole) - Model # 9183DST - Chrome**  
**(See Attached)**  
**Note:**

**1 - APPLIANCE PACKAGE - Install Upgrade Appliance Package - UPGRADE PACKAGE # 1 - To be installed throughout suite, where applicable**  
**(See Sketch)**  
**Note:**

**1 - MAIN BATH - Install Standard Granite Countertop - BIANCO ANTICO - To be installed throughout main bath vanity, where applicable. (Includes 3" Splash) (See Sketch)**  
**Note:**

**1 - MASTER ENSUITE - Install Standard Granite Countertop - BIANCO ANTICO - To be installed throughout master ensuite vanity, where applicable. (Includes 3" Splash) (See Sketch)**  
**Note:**

**1 - CLARIFICATION;**  
**MAIN BATH & MASTER ENSUITE -** Install Standard 3" Splash throughout Main Bath and Master Ensuite Vanity Countertop, where applicable.  
 (See Sketch)  
 .e:

**1 - DISCLAIMER - GRANITE COUNTERTOP;**  
**MAIN BATH & MASTER ENSUITE** - Due to the many variables that can affect the pattern, colour and/or design and "pitting" of natural products, granite installed will not be identical to the samples displayed  
**Note:** Every effort is made to provide granite countertops as close as possible but the vendor is not responsible for results which differ from the sample displayed. All countertop surfaces may have seams, and product pattern and shade can change in areas containing seams.



SITE COPY

CONSTRUCTION SUMMARY

Hampton Place

PURCHASERS: JASODRA B. RAMPERSAD and BRYAN G. THORNE TEL: RES.: 416-335-9670 BUS.: 647-502-5645

| LOT NUMBER | PHASE | HOUSE TYPE    | CLOSING DATE |
|------------|-------|---------------|--------------|
| 702        | 1     | FLANDERS(2E2) | 12-Nov-18    |

Date Added: 25-Jan-18 Invoice Number: 7096

1 - DISCLAIMER - STONE COUNTERTOP;  
MAIN BATH & MASTER ENSUITE - Stone slabs vary in size & all seams are visible & the fabricator reserves the right to position the seams as necessary.  
Note:

1 - CLARIFICATION;  
MASTER ENSUITE - Purchaser accepts & acknowledges the standard frameless glass enclosure at master ensuite shower stall will NOT touch the ceiling and will receive a Standard Chrome Header. (See Sketch)  
Note:

1 - CLARIFICATION - REFER TO APAS;  
MASTER ENSUITE - Install Rain Shower Head from Ceiling at Master Ensuite Shower Stall - DELTA - Shower Trim and Hansgrohe Slide Bar with Handheld and Ceiling Mount Showerhead  
Note: Model # R10000 / T13020-CDN/27454002 / 277440 / RP52382 / RP46870 / RP6025 / R11000 / T11800 - Chrome (See Sketch)

2 - MASTER ENSUITE - VANITY FAUCET - Install Upgrade Faucet - DELTA TRINSIC Single Handle Lavatory Faucet (Single Hole) - Model # 559LF-MPU - Chrome (x2 Sinks) (See Sketch)  
Note:

1 - MAIN BATH - VANITY FAUCET - Install Upgrade Faucet - DELTA TRINSIC Single Handle Lavatory Faucet (Single Hole) - Model # 559LF-MPU - Chrome (x1 Sink) (See Sketch)  
Note:

1 - CLARIFICATION;  
MAIN BATH & MASTER ENSUITE - DELETE Do Not Install / Supply / Credit Purchaser for builders standard ceramic bathroom accessories (toilet paper, towel bar & soap dish) throughout all bathrooms where applicable.  
Note: To Include; Main Bath & Master Ensuite (See Sketch)

1 - CLARIFICATION;  
MAIN BATH & MASTER ENSUITE - DELETE Do Not Install / Supply / Credit Purchaser for builders standard Bathroom Mirrors, throughout all bathrooms, where applicable. To Include; Main Bath and Master Ensuite. (See Sketch)  
Note:

1 - BONUS PACKAGE - PURCHASER HAS APPLIED \$5,000.00 (Includes Taxes) WORTH OF UPGRADE PROMOTIONAL PACKAGE TOWARDS THE PURCHASE OF UPGRADES COMPLETED AT THE DECOR CENTRE.  
Note:

1 - PURCHASER HAS ATTENDED A COLOR APPOINTMENT AT THE DECOR CENTRE AND HAS DECLINED ANY ADDITIONAL UPGRADES. Purchaser accepts and acknowledges that there will be no further changes/additions/deletions to be made upon signing on January 25,2018  
Note:

1 - PURCHASER AWARE AND ACCEPTS THAT ANY CHANGES MADE TO UPGRADES AFTER SIGNING THIS PURCHASERS EXTRA FORM ARE SUBJECT TO A MINIMUM ADMINISTRATION FEE OF \$1,000 PLUS A 10% HOLDBACK FEE.  
Note:

This Document is Extremely Time Sensitive - Printed 10 May 18 at 16:04

 **SELECTIVE CERAMIC**  
TILE, BATH & KITCHEN CENTRE

3550 LANGSTAFF RD., STE 160 WOODBRIDGE, ONTARIO L4L 9M7

TELEPHONE: 905 860 0222 FAX: 905 860 2076 E-MAIL: INFO@SELECTIVECERAMICS.COM

Amendment to the colour chart dated: \_\_\_\_\_

Lot No: Suite 102

Site: Hampton Place

Purchaser(s): Jasodra B. Rampersad & Bryan E. Thorne

Vender: Royal Pine


It is hereby understood and agreed between the undersigned parties that the following changes shall be made to the above mentioned colour chart, and except for such changes noted, all other items in the colour chart shall remain as started therein.


Delete: 1. 12x24 H Stone Light Grey - Foyer & Kitchen / Dinette Floor


Insert

1. 12x24 H - Stone Medium Grey - Foyer & Kitchen / Dinette Floor

Dated at Selective Ceramics Imports (Vaughan) this 1<sup>st</sup> day of April 2019

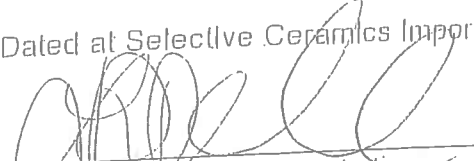  
Selective Ceramic Imports Inc.

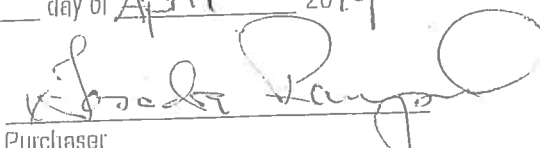  
Purchaser

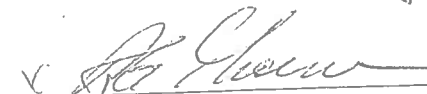  
Purchaser



JASODRA B. RAMPERSAD & BRYAN G. THORNE

Purchasers

Decor Consultant

Melissa Di Marino

\* INTERIOR COLOUR SCHEME

\* RESOLUTION \*

Model Type

FLANDERS(2E2)

Telephone Res. / Bus

(416) 335-9670 / (647) 502-5645

Project

Hampton Place

Closing Date

12/11/2018

Unit

702

Page 1 of 3

MASTER ENSUITE

MAIN BATHROOM

POWDER ROOM

KITCHEN / DINETTE

FOYER

LAUNDRY

LIVING ROOM

DINING ROOM

DEN

MASTER BEDROOM

BEDROOM 2

BEDROOM 3

Flooring

Description

13x13 SEAL GREY (STD)

13x13 SEAL GREY (STD)

N/A

12x24 H-Stone Medium Grey

8x8 BEHRAM PINK (STD)

7 1/2" Torley's Forest-Northern Cordillera 9687P (STD)

7 1/2" Torley's Forest-Northern Cordillera 9687P (STD)

N/A

7 1/2" Torley's Forest-Northern Cordillera 9687P (STD)

7 1/2" Torley's Forest-Northern Cordillera 9687P (STD)

N/A

Wall Tile

Main

8x10 GOLF GRIGIO (STD)

8x10 GOLF GRIGIO (STD)

N/A

12x12 TwilightMocha GlassMosaics (STD)

N/A

N/A

Accent/Insert

NONE

NONE

N/A

NONE

N/A

N/A

Pattern

NONE

NONE

N/A

NONE

N/A

N/A

Notes

\* Reselection April 1<sup>st</sup>, 2019 \*

Page 1 of 3

Consultant:

Melissa Di Marino

Purchaser:

JASODRA B. RAMPERSAD

Purchaser:

BRYAN G. THORNE

Vendor:

Hampton Place


Printed Jan 25, 2018 11:39 am





- STD KITCHEN LAYOUT
- WDG #1 - APPLIANCE PKG.
- (x4) - PUCK LIGHTS
- (x1) - PLUG PENINSULA
- (x3) - POTS OVER PENINSULA  
(Sep. SWITCH)





|                          |                        |                |                       |              |                                                                                                                      |
|--------------------------|------------------------|----------------|-----------------------|--------------|----------------------------------------------------------------------------------------------------------------------|
| CLIENT: ROYAL PINE HOMES | JOB NAME: UNIT 702 HMP | ROOM:          | KITCHEN FLOOR PLAN    | DRAWN BY: SK | COMMENTS:<br><br>PLEASE NOTE ALL DIMENSIONS<br>ARE NOT FINAL AND ARE<br>SUBJECT TO CHANGE UPON<br>FINAL SITE MEASURE |
| SITE: HAMPTON PLACE      | DOOR STYLE: —          | DOOR HANDLE: — | SCALE: 1/2" = 1' - 0" |              |                                                                                                                      |
| PHONE: —                 | FINISH: —              | DRW HANDLE: —  | DATE: APRIL 27, 2018  |              |                                                                                                                      |
| EMAIL: —                 | SPECIES: —             | TOP: —         | PAGE: —               |              |                                                                                                                      |
|                          |                        |                |                       |              |                                                                                                                      |

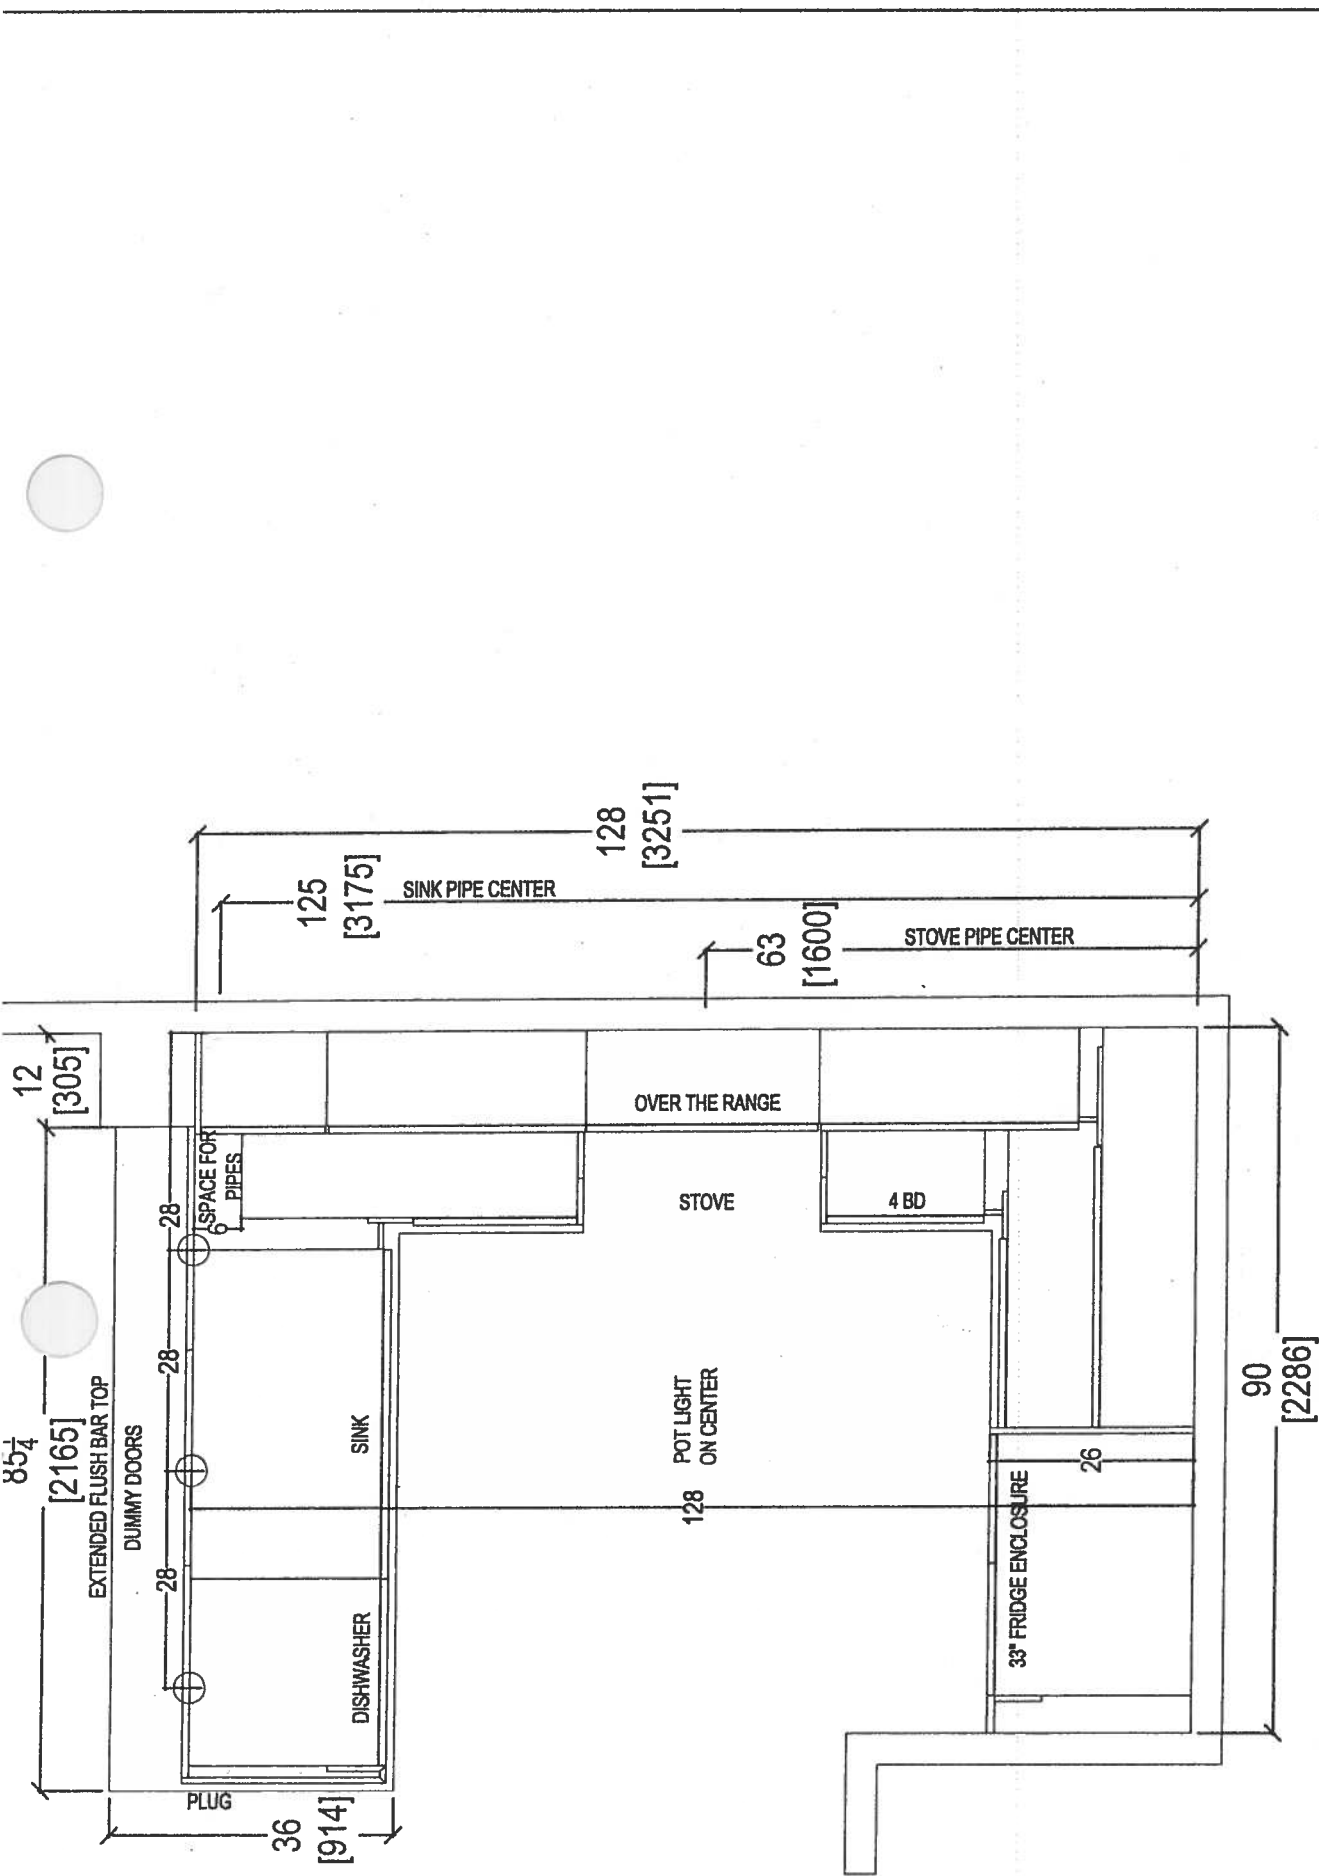

|                                                                                                                                                                                                            |                          |               |                        |                |                       |              |                                                                                                                      |
|------------------------------------------------------------------------------------------------------------------------------------------------------------------------------------------------------------|--------------------------|---------------|------------------------|----------------|-----------------------|--------------|----------------------------------------------------------------------------------------------------------------------|
|  <p><i>your kitchen, your taste.</i><br/>80 SANTE DRIVE, VAUGHAN, ON L4K 3C4,<br/>T: 416.748.1811 F: 905.781.5901</p> | CLIENT: ROYAL PINE HOMES |               | JOB NAME: UNIT 702 HMP | ROOM:          | KITCHEN FLOOR PLAN    | DRAWN BY: SK | COMMENTS:<br><br>PLEASE NOTE ALL DIMENSIONS<br>ARE NOT FINAL AND ARE<br>SUBJECT TO CHANGE UPON<br>FINAL SITE MEASURE |
|                                                                                                                                                                                                            | SITE: HAMPTON PLACE      | DOOR STYLE: — | DOOR HANDLE: —         | DOOR HANDLE: — | SCALE: 1/2" = 1' - 0" |              |                                                                                                                      |
|                                                                                                                                                                                                            | PHONE: —                 | FINISH: —     | DRW HANDLE: —          | DRW HANDLE: —  | DATE: APRIL 27, 2018  |              |                                                                                                                      |
|                                                                                                                                                                                                            | EMAIL: —                 | SPECIES: —    | TOP: —                 | TOP: —         | PAGE: —               |              |                                                                                                                      |
|                                                                                                                                                                                                            |                          |               |                        |                |                       |              |                                                                                                                      |

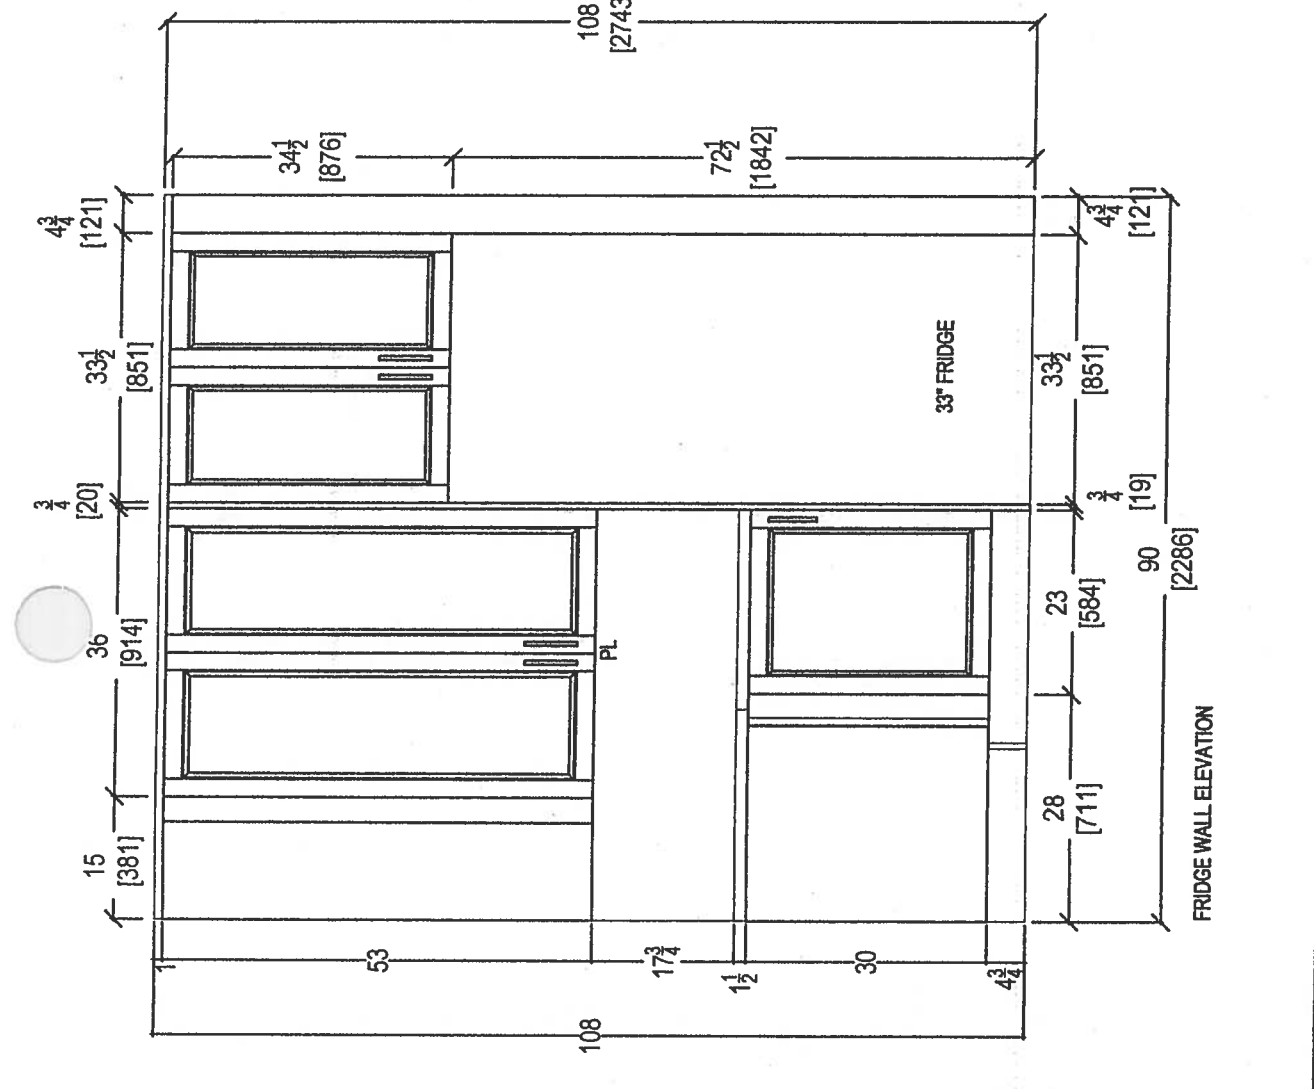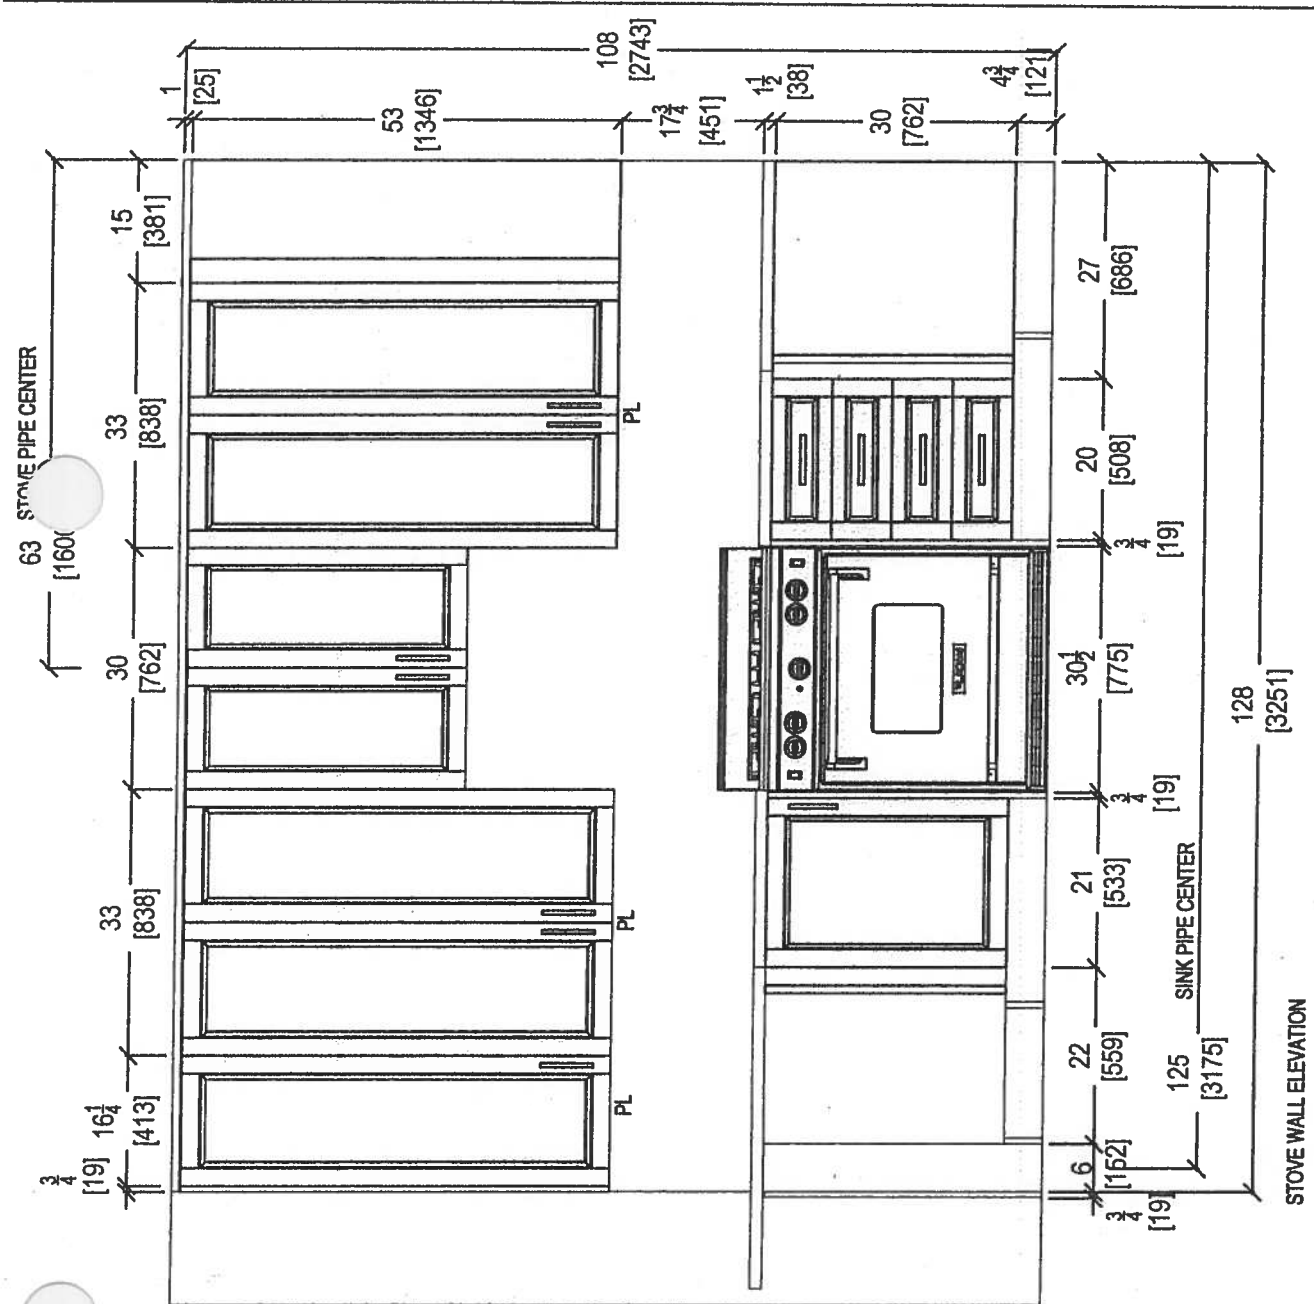

|                                                                                                                                                                                                        |                          |  |                        |                |  |                       |                                                                                                                    |
|--------------------------------------------------------------------------------------------------------------------------------------------------------------------------------------------------------|--------------------------|--|------------------------|----------------|--|-----------------------|--------------------------------------------------------------------------------------------------------------------|
|  <p>your kitchen, your taste.</p> <p>80 SANTE DRIVE, VAUGHAN, ON L4K 3C4.<br/>T: 416.748.1811 F: 905.781.5901</p> | CLIENT: ROYAL PINE HOMES |  | JOB NAME: UNIT 702 HMP | ROOM: KITCHEN  |  | DRAWN BY: SK          | <p>COMMENTS:</p> <p>PLEASE NOTE ALL DIMENSIONS ARE NOT FINAL AND ARE SUBJECT TO CHANGE UPON FINAL SITE MEASURE</p> |
|                                                                                                                                                                                                        | SITE: HAMPTON PLACE      |  | DOOR STYLE: —          | DOOR HANDLE: — |  | SCALE: 1/2" = 1' - 0" |                                                                                                                    |
|                                                                                                                                                                                                        | PHONE: —                 |  | FINISH: —              | DRW HANDLE: —  |  | DATE: APRIL 27, 2018  |                                                                                                                    |
|                                                                                                                                                                                                        | EMAIL: —                 |  | SPECIES: —             | TOP: —         |  | PAGE: —               |                                                                                                                    |

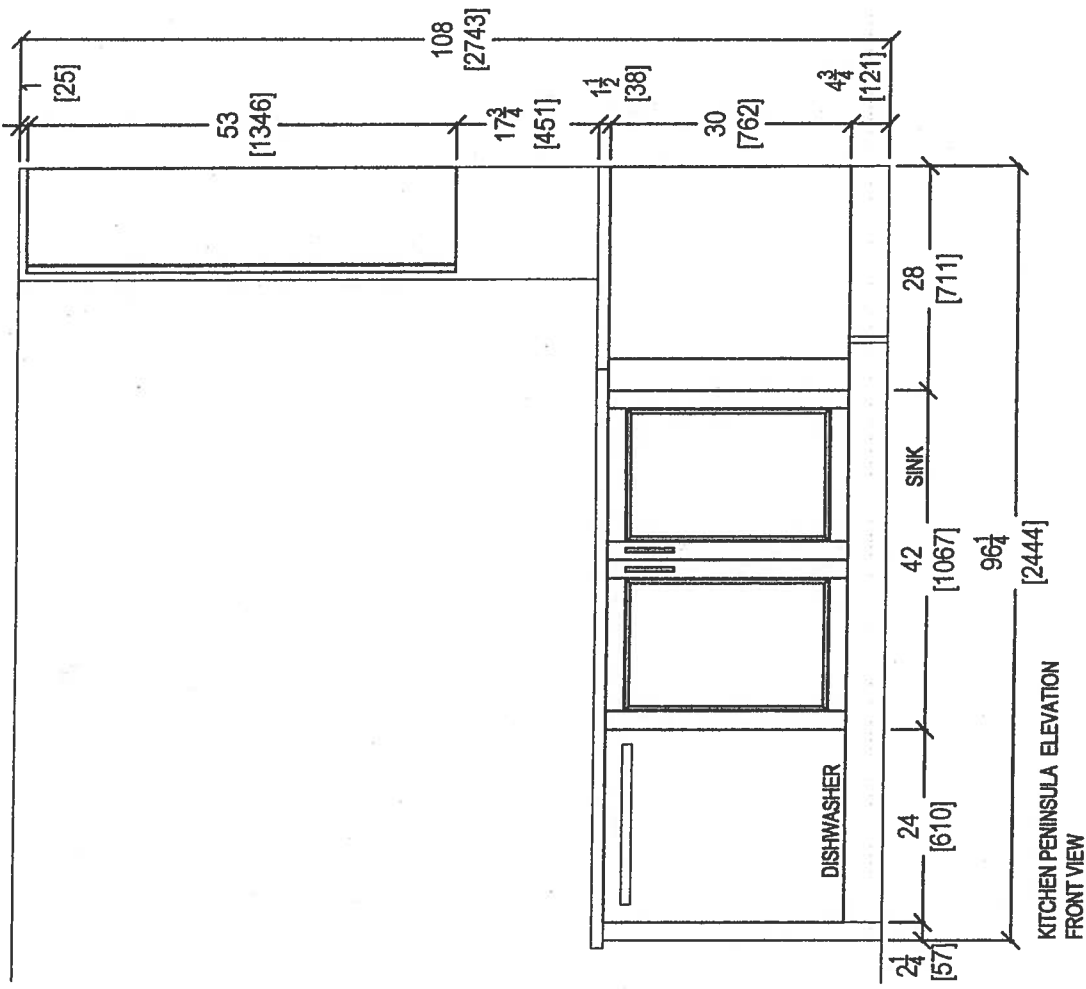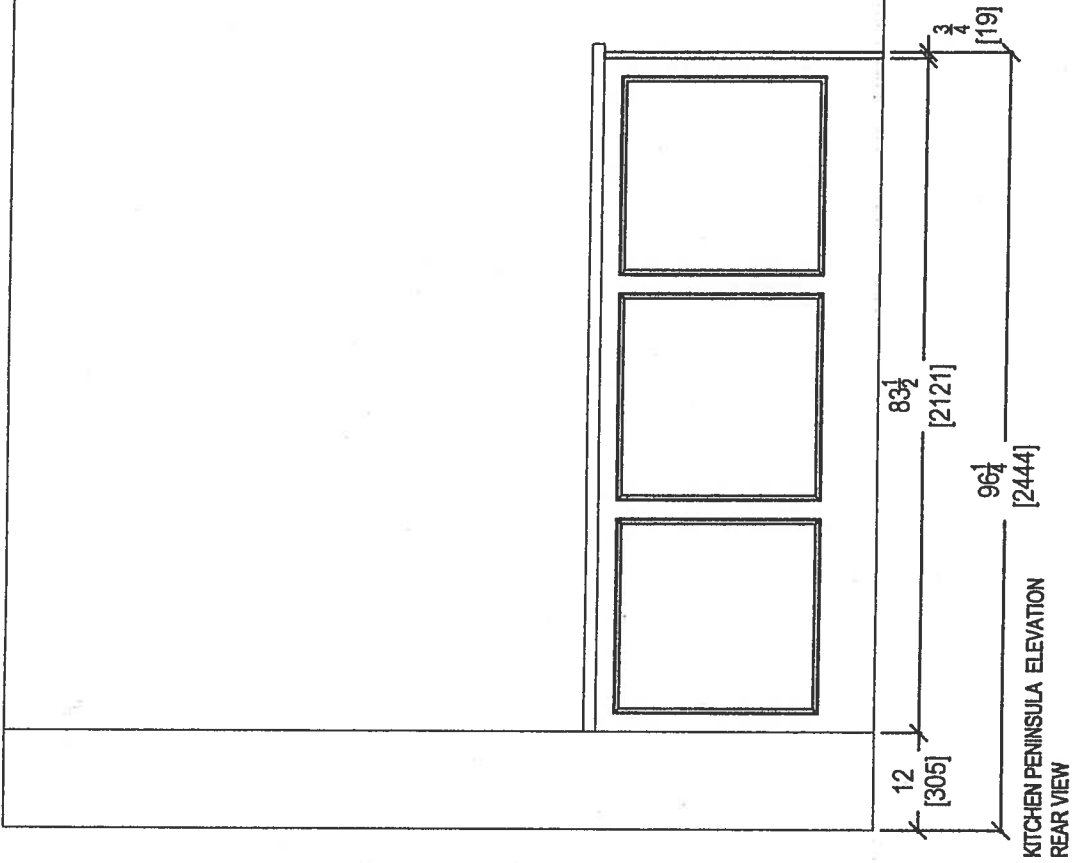




your kitchen, your taste.  
80 SANTE DRIVE, VAUGHAN, ON L4K 3C4,  
T: 416.746.1811 F: 905.761.5901


|                                                                             |                        |                  |                       |                                                                                                                      |
|-----------------------------------------------------------------------------|------------------------|------------------|-----------------------|----------------------------------------------------------------------------------------------------------------------|
| CLIENT: ROYAL PINE HOMES<br>SITE: HAMPTON PLACE<br>PHONE: ---<br>EMAIL: --- | JOB NAME: UNIT 702 HMP | ROOM: KITCHEN    | DRAWN BY: SK          | COMMENTS:<br><br>PLEASE NOTE ALL DIMENSIONS<br>ARE NOT FINAL AND ARE<br>SUBJECT TO CHANGE UPON<br>FINAL SITE MEASURE |
|                                                                             | DOOR STYLE: ---        | DOOR HANDLE: --- | SCALE: 1/2" = 1' - 0" |                                                                                                                      |
|                                                                             | FINISH: ---            | DRW HANDLE: ---  | DATE: APRIL 27, 2018  |                                                                                                                      |
|                                                                             | SPECIES: ---           | TOP: ---         | PAGE: ---             |                                                                                                                      |

69



\* Insull 3" Splash \*

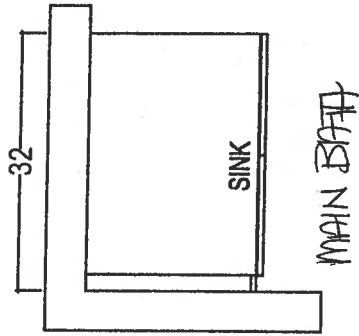

MAIN BATH

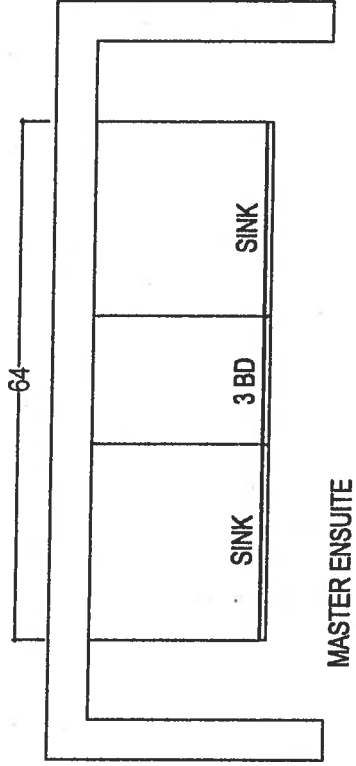

MASTER ENSUITE

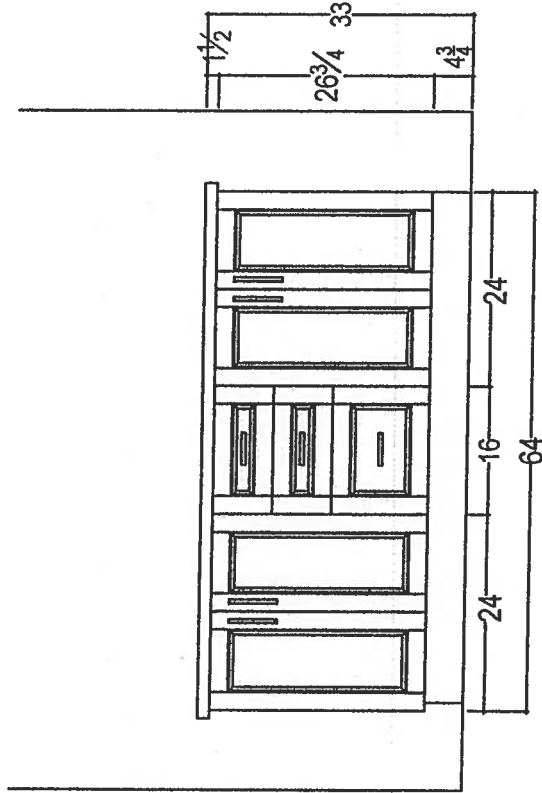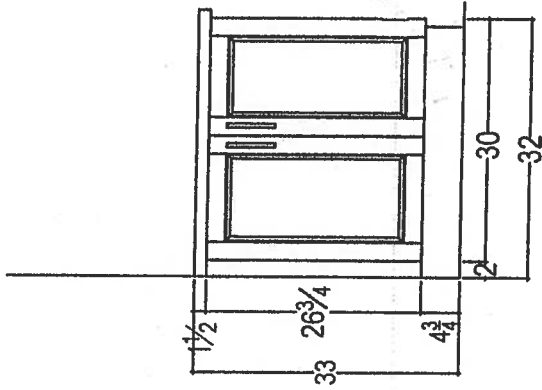

80 SANTE DRIVE, VAUGHAN, ON L4K 3C4,  
T: 416.746.1811 F: 905.781.5901

|                          |  |                        |                |                       |              |                                                                                                                      |
|--------------------------|--|------------------------|----------------|-----------------------|--------------|----------------------------------------------------------------------------------------------------------------------|
| CLIENT: ROYAL PINE HOMES |  | JOB NAME: UNIT 702 HMP | ROOM:          | VANITIES              | DRAWN BY: SK | COMMENTS:<br><br>PLEASE NOTE ALL DIMENSIONS<br>ARE NOT FINAL AND ARE<br>SUBJECT TO CHANGE UPON<br>FINAL SITE MEASURE |
| SITE: HAMPTON PLACE      |  | DOOR STYLE:            | DOOR HANDLE: — | SCALE: 1/2" = 1' - 0" |              |                                                                                                                      |
| PHONE: —                 |  | FINISH: —              | DRW HANDLE: —  | DATE: APRIL 27, 2018  |              |                                                                                                                      |
| EMAIL: —                 |  | SPECIES: —             | TOP: —         | PAGE: —               |              |                                                                                                                      |

Suite 702  
Hampton

WRB322DMBM

Upgrade  
Package I



Whirlpool®

33-inches wide Bottom-Freezer Refrigerator with  
SpillGuard™ Glass Shelves - 22 cu. ft

<http://www.whirlpool.com>

Key Features:

- SpillGuard™ Glass Shelves
- Adaptive Defrost / *Factory Installed Ice Maker*
- FreshFlow™ Produce Preserver
- LED Interior Lighting
- ENERGY STAR® Qualified

Product Dimensions:


Height: 70  
Width: 32 5/8  
Depth: 33 3/8

Electrical Requirements:

15

Additional Information:

[Use And Care Guide](#)  
[Dimension Guide](#)  
[Energy Guide](#)  
[Warranty Certificate](#)

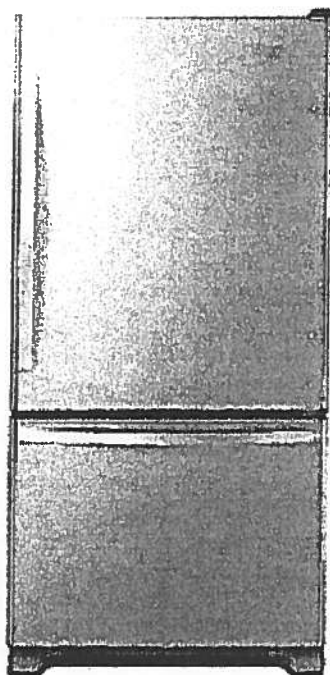

INVESTED  
IN  
AMERICA



©Registered trademark/TM Trademark of Whirlpool, U.S.A. © 2016 Whirlpool Corporation. All Rights Reserved.  
All other trademarks are owned by their respective companies.

Because Whirlpool Corporation policy includes a continuous commitment to improve our products, we reserve the right to change materials and specifications without notice. We also reserve the right to discontinue or transition products without notice.

Manufacturer's Suggested Retail Price (MSRP) and Minimum Advertised Price (MAP) provided for reference purposes only. Dealer alone determines advertised and retail prices.

Created On: Tuesday, March 14, 2017 11:30:08

# Suite 702 Hampton

WEE745H0FS

## Upgrade Package I



# Whirlpool®

6.4 Cu. Ft. Slide-In Electric Range with True Convection

<http://www.whirlpool.com>



### Key Features:

- Frozen Bake™ Technology
- True Convection Cooking
- FlexHeat™ Triple Radiant Element
- Convection Conversion
- AquaLift® Self-Cleaning Technology
- Temperature Sensor
- Rapid Preheat
- 6.4 Cu. Ft. Capacity
- Easy-Wipe Ceramic Glass Cooktop
- Large Oven Window
- Max Capacity Rack
- Hidden Bake Element

### Product Dimensions:

Height: 36

Width: 29 7/8

### Additional Information:

[Use And Care Guide](#)

[Dimension Guide](#)

[Installation Guide](#)

[Warranty Certificate](#)

INVESTED  
IN  
AMERICA

ADA  
Compliant

®Registered trademark/TM Trademark of Whirlpool, U.S.A. © 2016 Whirlpool Corporation. All Rights Reserved.  
All other trademarks are owned by their respective companies.  
Because Whirlpool Corporation policy includes a continuous commitment to improve our products, we reserve the right to change materials and specifications without notice. We also reserve the right to discontinue or transition products without notice.  
Manufacturer's Suggested Retail Price (MSRP) and Minimum Advertised Price (MAP) provided for reference purposes only. Dealer alone determines advertised and retail prices.  
Created On: Friday, January 27, 2017 10:46:47

Suite 702  
Hampton

Upgrade  
Package 1



YWMH76719CS



<http://www.whirlpool.com>

1.9 cu. ft. Microwave Hood Combination with  
TimeSavor™ Plus True Convection

**Key Features:**

- TimeSavor™ Plus True Convection Cooking System
- Steam Cooking
- Sensor Cooking
- AccuPop™ Cycle
- CleanRelease® Non-Stick Interior
- SteamClean Option
- Integrated Hidden Vent and Console
- Auto Adapt Fan
- Recessed, Stoppable Glass Turntable
- Universal Microwave Steamer
- 1.9 cu. ft. Capacity
- 1,100 Watts Cooking Power

**Product Dimensions:**

Height: 17 1/8

Width: 29 15/16

Depth: 18 1/2

**Electrical Requirements:**

15 or 20. 120 V.

**Additional Information:**


[Use And Care Guide](#)

[Installation Guide](#)

[Warranty Certificate](#)

Available in:

 Stainless Steel

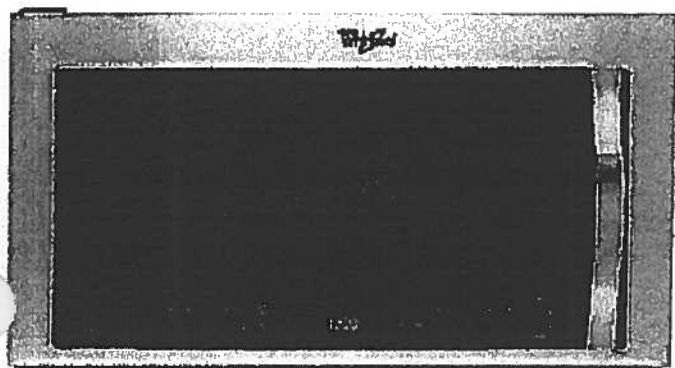

©Registered trademark/TM Trademark of Whirlpool, U.S.A. © 2013 Whirlpool Corporation. All Rights Reserved.  
All other trademarks are owned by their respective companies.  
Because Whirlpool Corporation policy includes a continuous commitment to improve our products, we reserve the right to change materials and specifications without notice. We also reserve the right to discontinue or transition products without notice.  
Manufacturer's Suggested Retail Price (MSRP) and Minimum Advertised Price (MAP) provided for reference purposes only. Dealer alone determines advertised and retail prices.  
Created On: Monday, March 14, 2016 13:16:48

# Suite 702 Hampton Upgrade Package 1

WDTA50SAHZ



## Whirlpool®

<http://www.whirlpool.com>

Contemporary Design. Stainless Steel Tub  
Dishwasher with TotalCoverage Spray Arm

### Key Features:

- Sensor Cycle
- TotalCoverage Spray Arm
- 1-Hour Wash Cycle
- Tap Touch Controls

### Product Dimensions:

Height: 34 1/2

Width: 23 7/8

Depth: 24 1/2

### Additional Information:


[Use And Care](#)

[Dimension Guide](#)

[Installation Guide](#)

[Energy Guide](#)

[Warranty](#)

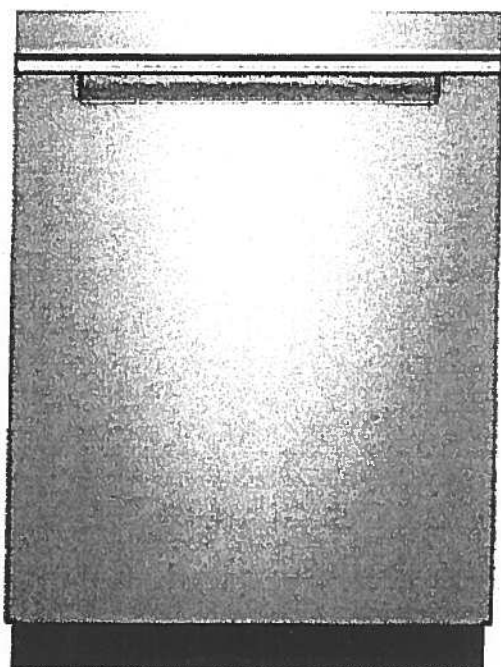

Available in:

● Black

Fingerprint Resistant Sunset Bronze

Fingerprint Resistant Black Stainless

○ White

Fingerprint Resistant Stainless Steel

INVESTED  
IN  
AMERICA



©Registered trademark/TM Trademark of Whirlpool, U.S.A. © 2016 Whirlpool Corporation. All Rights Reserved. All other trademarks are owned by their respective companies.

Because Whirlpool Corporation policy includes a continuous commitment to improve our products, we reserve the right to change materials and specifications without notice. We also reserve the right to discontinue or transition products without notice.

Manufacturer's Suggested Retail Price (MSRP) and Minimum Advertised Price (MAP) provided for reference purposes only. Dealer alone determines advertised and retail prices.

# Suite 702 Upgrade Hampton Package I




WFW75HEFW



<http://www.whirlpool.com>

1.5 cu. ft. Front Load Washer with Precision Dispense

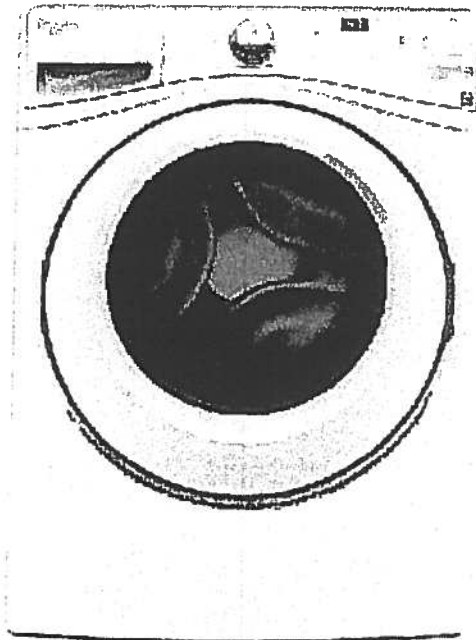

## Key Features:

- Precision Dispense
- Adaptive Wash Technology
- Smooth Wave Stainless Steel Wash Basket
- 4.5 cu. ft. Capacity
- ENERGY STAR® Qualified

## Product Dimensions:

Height: 39 3/4

Width: 27

Depth: 33 5/16

## Electrical Requirements:

15 or 20. 120 V.

## Additional Information:

[Use And Care Guide](#)

[Dimension Guide](#)

[Installation Guide](#)

[Energy Guide](#)

[Warranty Certificate](#)

INVESTED  
IN  
AMERICA



©Registered trademark/TM Trademark of Whirlpool, U.S.A. ©2013 Whirlpool Corporation All Rights Reserved.  
All other trademarks are owned by their respective companies.  
Because Whirlpool Corporation policy includes a continuous commitment to improve our products, we reserve the right to change materials and specifications without notice. We also reserve the right to discontinue or transition products without notice.  
Manufacturer's Suggested Retail Price (MSRP) and Minimum Advertised Price (MAP) provided for reference purposes only. Dealer alone determines advertised and retail prices.  
Created On: Wednesday, March 23, 2016 11:51:03

# Suite 702 Hampton

# Upgrade Package 1




YWED75HEFW

8.5 cu. ft. Duet® High Efficiency Front Load Electric  
Dryer with ENERGY STAR®

MSRP: \$0.00

# Whirlpool®

<http://www.whirlpool.com>

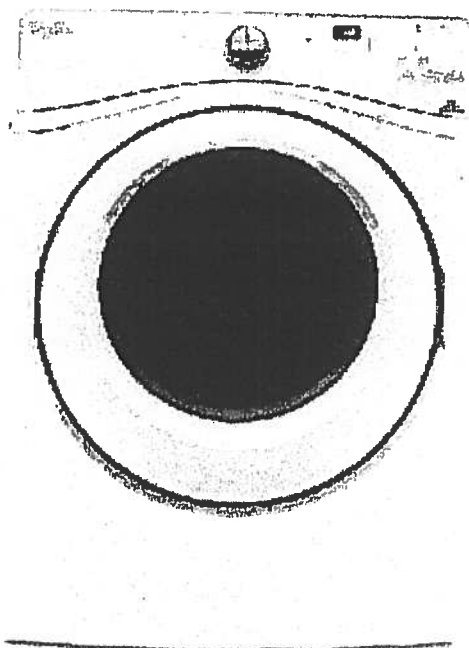

#### Key Features:

- Advanced Moisture Sensing System
- Quad Baffles
- Tap Touch Controls with Memory
- EcoBoost™ Option
- Wrinkle Shield™ Plus Option
- Undercounter Installation
- 7.4 Cu. Ft. Capacity
- ENERGY STAR® Qualified

#### Product Dimensions:

Height: 39

Width: 27

Depth: 31

#### Additional Information:

[Use And Care](#)

[Installation Guide](#)

[Warranty](#)

Available in:

☐ White

INVESTED  
IN  
AMERICA

ADA  
Compliant

®Registered trademark/TM Trademark of Whirlpool, U.S.A. © 2016 Whirlpool Corporation. All Rights Reserved. All other trademarks are owned by their respective companies.

Because Whirlpool Corporation policy includes a continuous commitment to improve our products, we reserve the right to change materials and specifications without notice. We also reserve the right to discontinue or transition products without notice.


Manufacturer's Suggested Retail Price (MSRP) and Minimum Advertised Price (MAP) provided for reference purposes only. Dealer alone determines advertised and retail prices.

# Upgrade Kitchen Sinks



**BLANCO**

Suite 702  
Hampton

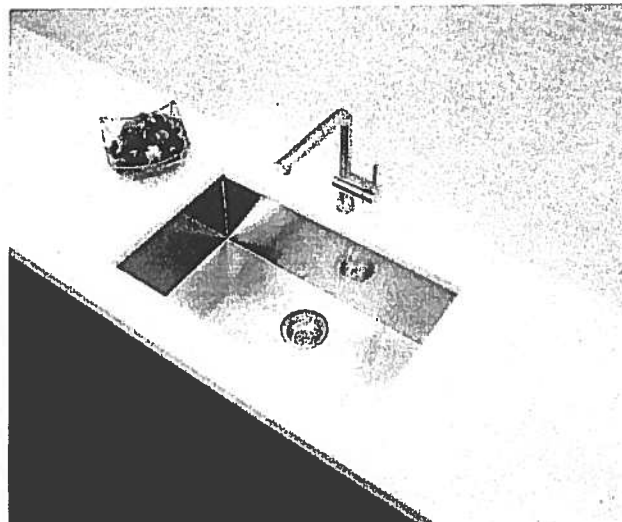

**Blanco Quatrus U Super Single  
Undermount Sink  
#401248**



**Blanco Quatrus R15 Two Bowl  
Undermount Sink  
#401519**


Centon Sales Corp. 400 Matheson Blvd. Unit # 30, Mississauga, Ont. L4Z 1N8 Tel: 905-629-7072 Fax: 905-629-2131

✓




Suite 702  
Hampton


KITCHEN UPGRADE OPTIONS

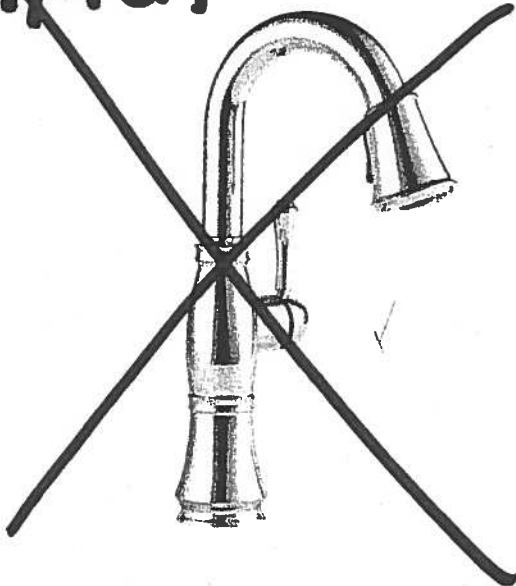

Delta Cassidy Pull Down Kitchen  
#9997-DST

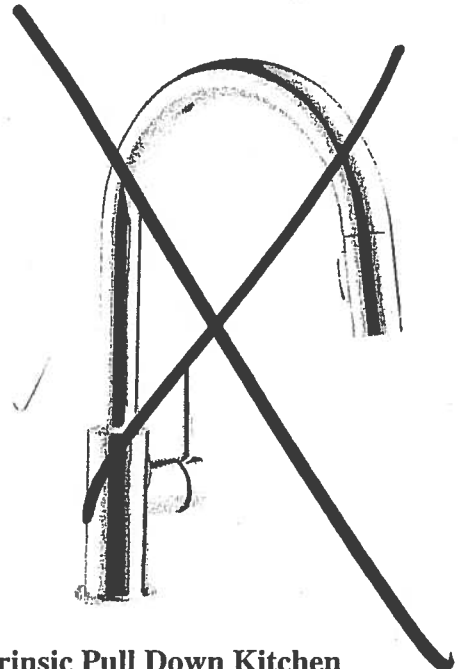

Delta Trinsic Pull Down Kitchen  
#9159-DST

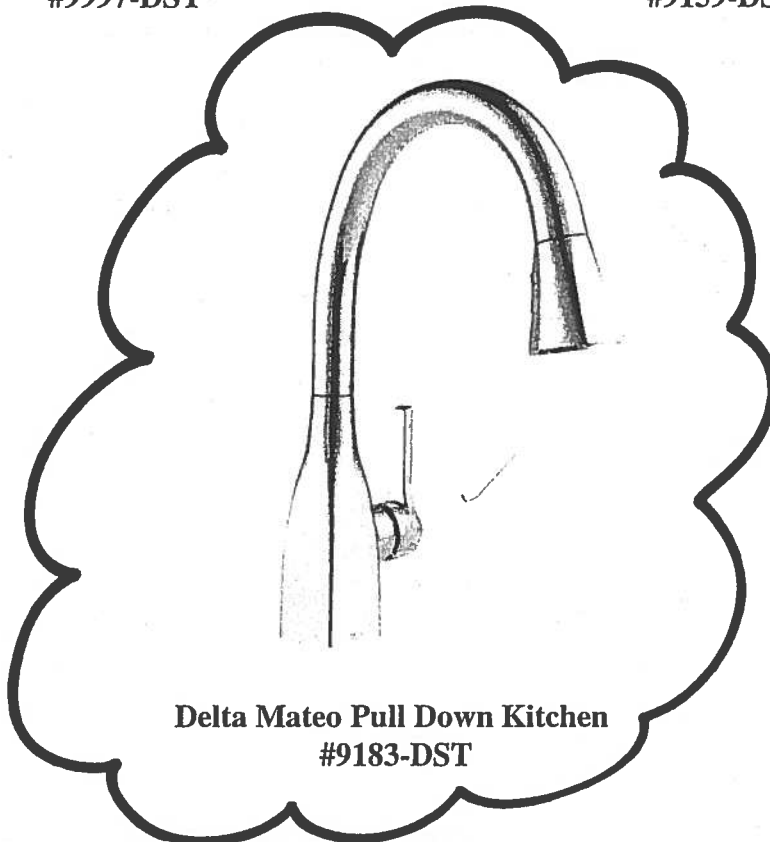


Delta Mateo Pull Down Kitchen  
#9183-DST

RECEIVED  
APR 15 2005

Standard




Suite 702  
Hampton

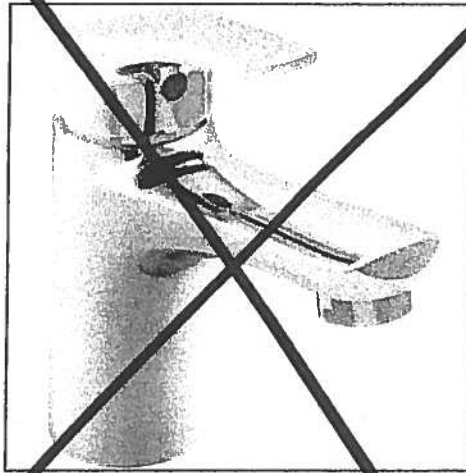

Delta Wynne Chrome Single Lever  
Lavatory Faucet With Pop Up  
#534LF

Master Ensuite  
Shower Stall

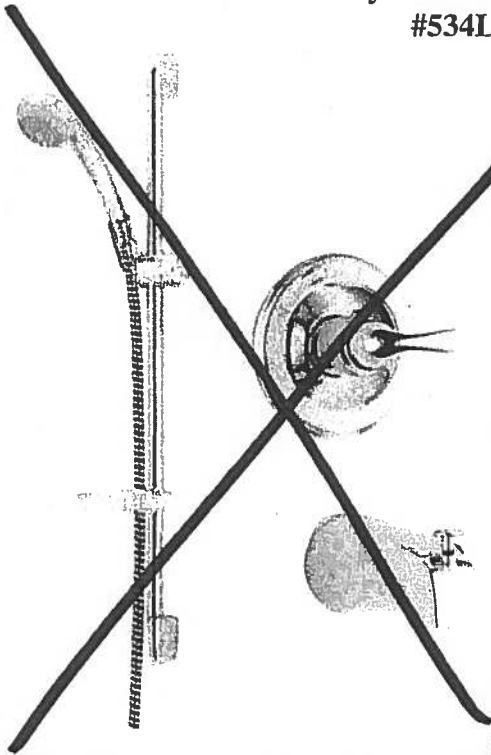

Delta Shower Trim with Tub Spout and  
Hansgrohe Slide Bar with Handheld  
#R10000/T13020-CDN/2001-TP/27454002/  
27744000



Delta Shower Trim with ~~Handheld~~ and  
Hansgrohe Slide Bar with Handheld and  
Ceiling Mount Showerhead  
#R10000/T13020-CDN/27454002/  
27744000/RP52382/RP46870/RP6025/  
R11000/T11800




Suite 702  
Hampton

UPGRADE OPTION 2  
PACKAGE

Main Bath (x1)  
Master Ensuite  
(x2)



Delta Trinsic Single Hole Lav  
#559LF-MPU

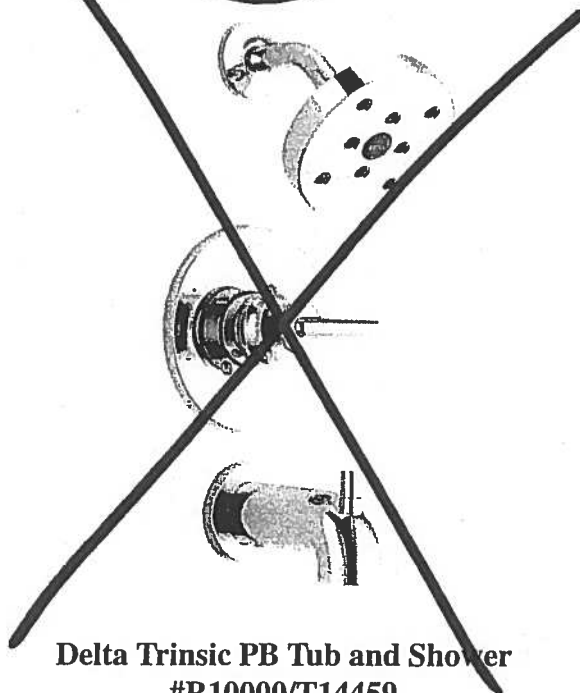

Delta Trinsic PB Tub and Shower  
#R10000/T14459

Countertop Edges  
Suite 702  
Hampton

JR

BT

CONNOLLY Marble & Granite Ltd.

EDGE  
DETAILS


004

A.




STRAIGHT EDGE  
(STANDARD - 3/4")

Standard:  
Main Bath  
Master Ensuite

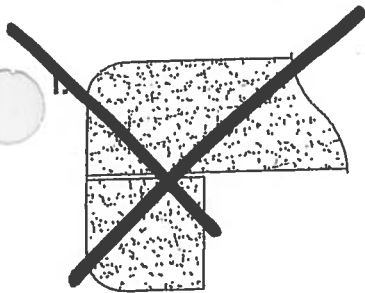

SQUARE TOP 1 1/2" EDGE  
(STANDARD - 1 1/2")

M.

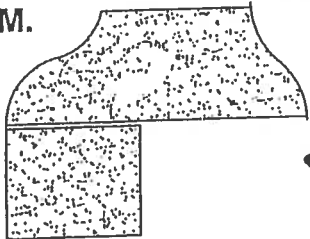

OGEE - SQUARE EDGE  
(MED./HIGH - 1 1/2")

Upgrade:  
Kitchen

EDGING UP-GRADE OPTIONS