






Peconic Bay

SUITE 608
ORIGINAL LAYOUT

1,686 SQ FT plus 905 sq. ft. of terrace area

Revised Laundry.

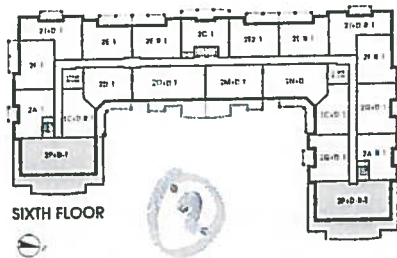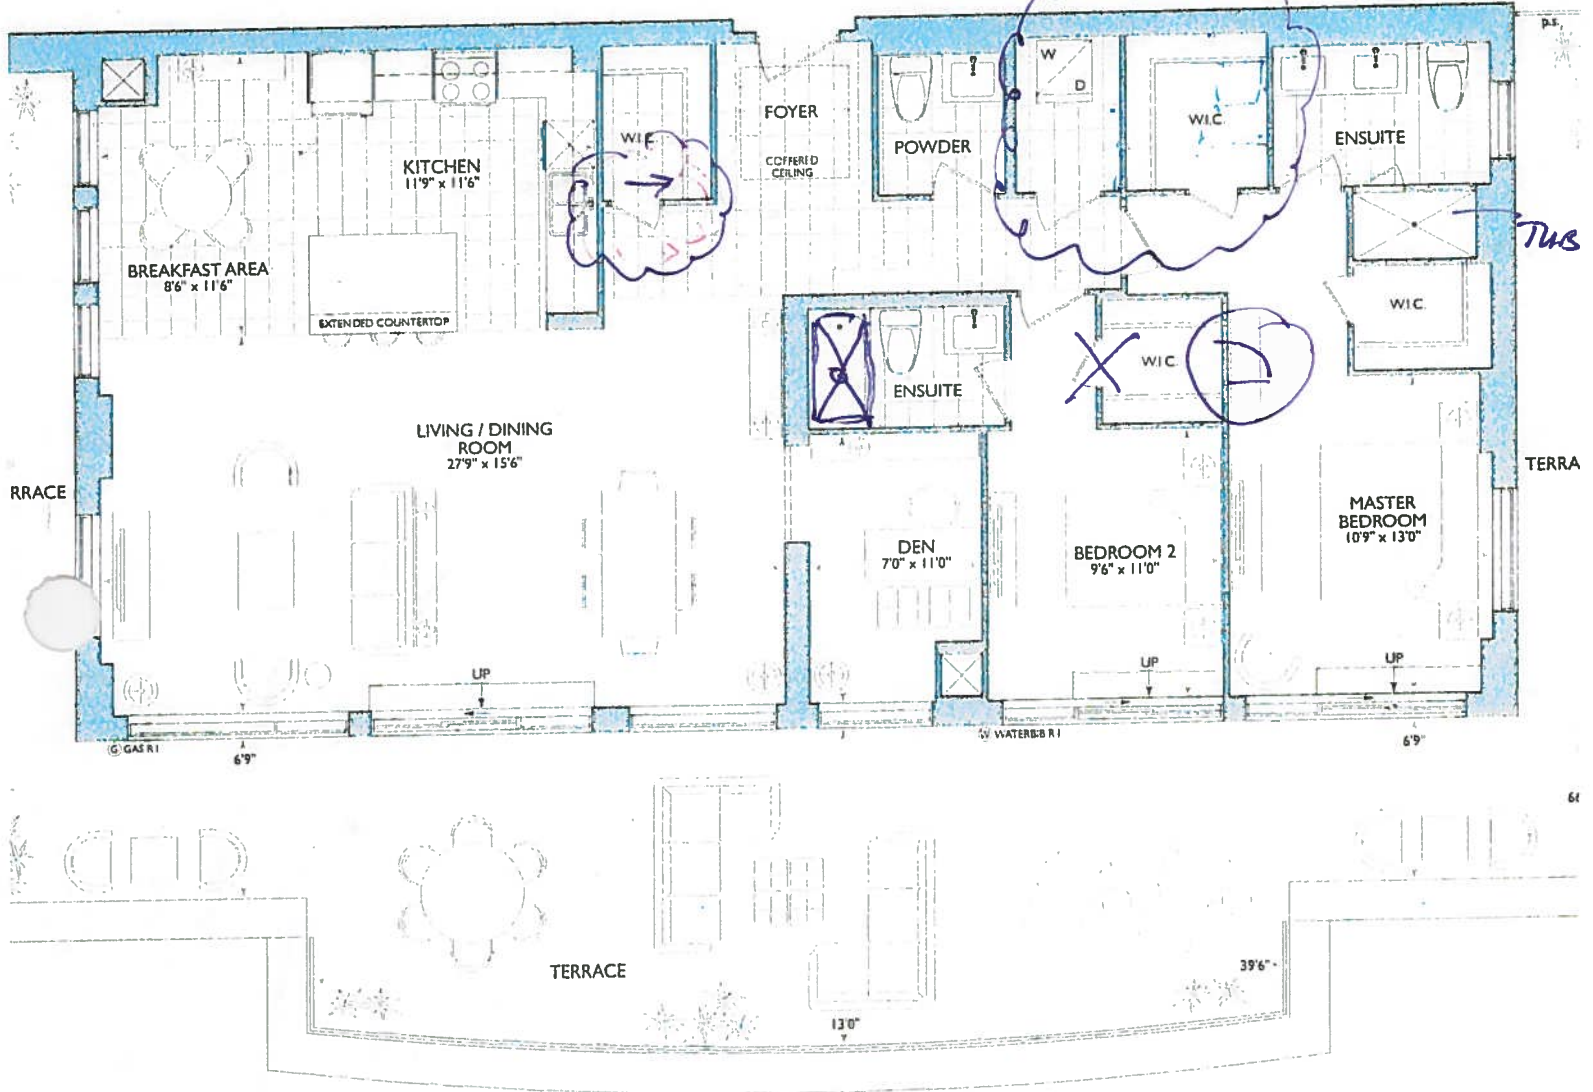

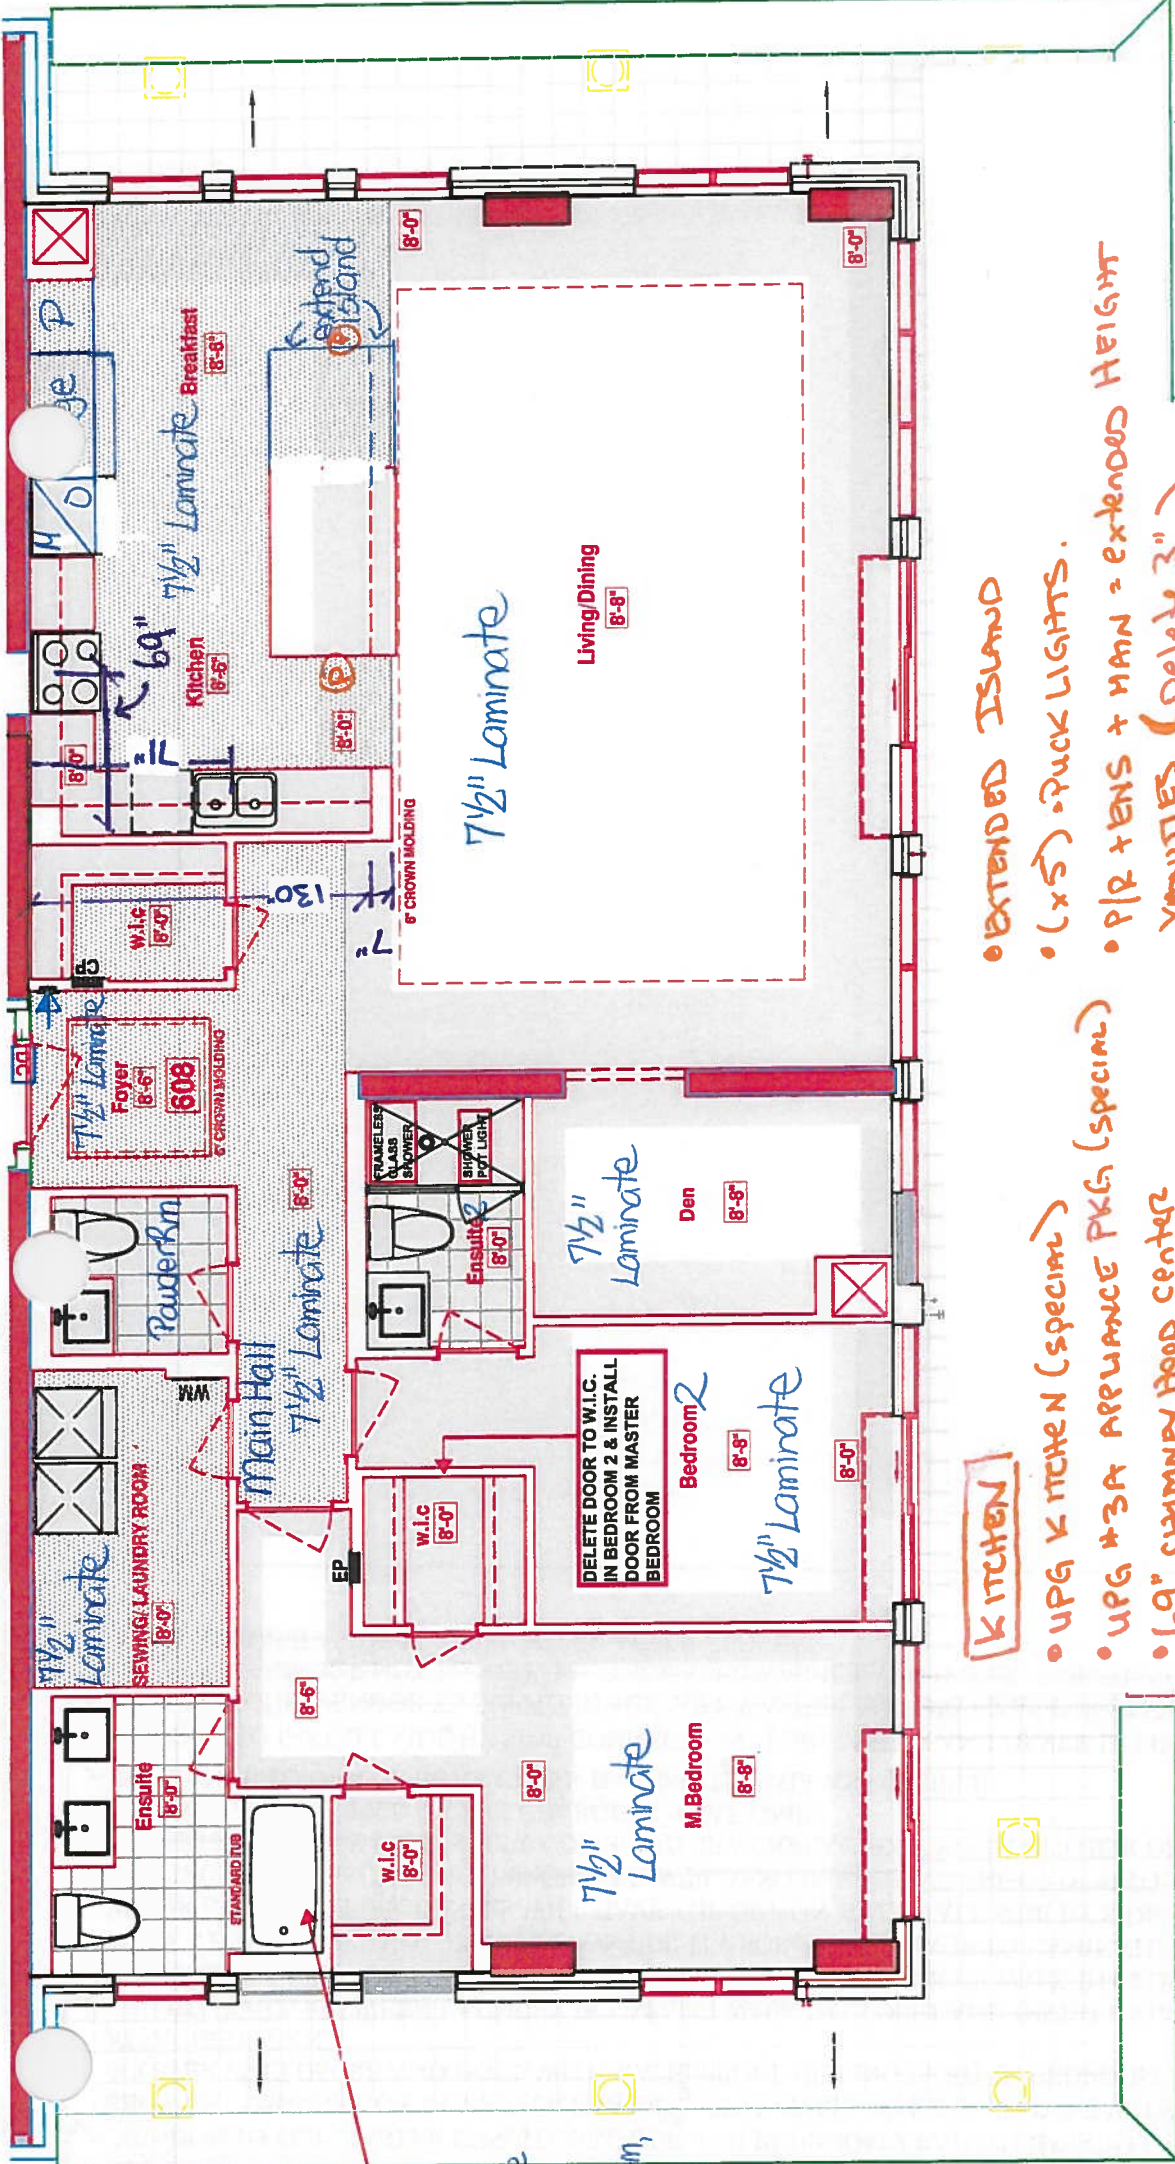

- SEWING/LAUNDRY ROOM**
DELETE WALL BETWEEN LAUNDRY & WALK IN CLOSET
- INSTALL STD. LAMINATE FLOORING IN KITCHEN, BREAKFAST AREA, W.I.C. AND HALLWAY**
- INSTALL SIDE BY SIDE CONNECTIONS FOR WASHER/ DRYER IN LIEU OF STACKABLE CONNECTIONS.**
- REPLACE MASTER ENSUITE SHOWER WITH BEDROOM 2 BATHTUB INSTALL FRAMELESS GLASS SHOWER**

delete Ceramic Accessories
Powder Room, Master Ensuite
Insuite #2

delete Mirrors; Powder Room,
Master Ensuite, Ensuite #2

Kitchen-Install
Water Line to Fridge

LEGEND:	
	SECURITY PANEL
	ELECTRICAL PANEL
	COMMUNICATION PANEL
	WATER METER
	FRIDGE
	DROPPED AREA
	6" CROWN MOLDING

- KITCHEN**
- UPG KITCHEN (SPECIM)
 - UPG #3A APPLANCE PKG (SPECIM)
 - 6" CHIMNEY HOOD CENTER
 - 71" SINK CENTER
 - (x2) = PLUGS ISLAND
- EXTENDED ISLAND**
- (x5) = PUCK LIGHTS.
 - P/R + ENS + MAIN = EXTENDED HEIGHT VANITIES (DELETE 3" SPLASH)

LOCATION OF KITCHEN LIGHTS REFER TO QTK. DWG.

RECEIVED
R. Condo, 2018

May 23, 2018

SUITES 608 - PECONIC BAY

Royal Pine Homes 25 Baker Hill Blvd - Stouffville, ON Jan 10, 2018



PURCHASER'S EXTRAS (PE)
Hampton Place - Braylea Investments Inc.

PURCHASERS: DONALD BRADFORD and NADINE BRADFORD

TEL: RES.: 905-887-6812

LOT NUMBER	PHASE	HOUSE TYPE	REG. PLAN #		
608	1	PECONIC BAY			

Item	QTY	Description	Addition to Purchase Price
1		1 - LAUNDRY ROOM- Purchaser accepts and acknowledges that the Laundry Room door will swing out towards the Master Bedroom, as per the original brochure Note: As per Fonzie	
2		1 - PURCHASER AWARE AND ACCEPTS THAT ANY CHANGES MADE TO UPGRADES AFTER SIGNING THIS PURCHASERS EXTRA FORM ARE SUBJECT TO A MINIMUM ADMINISTRATION FEE OF \$1,000. PLUS A 10% HOLDBACK FEE. Note:	



Sub Total
HST
Total

- In the event the work on the house has progressed beyond the point where the items covered by this extra cannot be installed without entailing any unusual expense, then this order is to be cancelled and any deposit paid in connection with the same is to be refunded to the Purchaser.
- The Vendor will undertake to incorporate the work covered by the sales extra in the construction of the house but will not be liable to the purchaser in any way, if for any reason the work covered by the extra is not carried out. In that event, any monies paid in connection with the same shall be returned to the Purchaser.
- It is understood and agreed that if for any reason whatsoever the transaction of Purchase and Sale is not completed, the total cost of extras ordered are not refundable to the Purchaser(s).
- Extras or changes will not be processed unless signed by the Vendor.
- These extras may not be amended without the written consent of Braylea Investments Inc..
- The Purchaser(s) and the Vendor acknowledge and agree that this form shall not be deemed to be part of the Agreement of Purchase and Sale entered into between them, nor an addendum thereto.
- No Estimates or orders will be accepted once construction has commenced.
- Prices are estimates only and guaranteed for a period of 5 days only.
- Any cancellations to this order, providing they can be cancelled, are subject to a \$500 minimum administration charge and a 10% cancellation charge for the total amount being cancelled.
- For Visa, Mastercard and Debit payments, transactions are identified on you statement as "SHERWAY CONSTRUCTION LTD", an Authorized Visa /Mastercard/Debit Merchant and authorized Royal Pine Homes company.

Payment Summary

<u>Paid By</u>	<u>Amount</u>	<u>Detail</u>
Amendment		
Total Payment:		

Bonus Package From Agreement of Purchase and Sale dated June 27, 2016

Bonus Total
PE# 7,156 - May 23,
2018
Remaining Balance

PURCHASER: _____
DONALD BRADFORD

09-Sep-19
DATE

CONSULTANT: _____
Laura Di Pede

PURCHASER: _____
NADINE BRADFORD

09-Sep-19
DATE

VENDOR: _____
PER: Braylea Investments Inc.

☐ Decor

☐ Builder

☐ Purchaser

Printed: 9-Sep-19 at 9:28 am



PURCHASER'S EXTRAS (PE)
Hampton Place - Braylea Investments Inc.

PURCHASERS: DONALD BRADFORD and NADINE BRADFORD

TEL: RES.: 905-887-6812

LOT NUMBER	PHASE	HOUSE TYPE	REG. PLAN #		
608	1	PECONIC BAY			
Item	QTY	Description	Addition to Purchase Price		
1		1 - KITCHEN- Purchaser accepts and acknowledges that the cook top style/model included in Appliance Package #3A has been replaced with the KitchenAid Model KCES950HSS Note:			
2		1 - PURCHASER AWARE AND ACCEPTS THAT ANY CHANGES MADE TO UPGRADES AFTER SIGNING THIS PURCHASERS EXTRA FORM ARE SUBJECT TO A MINIMUM ADMINISTRATION FEE OF \$1,000. PLUS A 10% HOLDBACK FEE. Note:			



Sub Total
HST
Total

This is a request to price the above extras/upgrades in accordance with the following terms and conditions:

- In the event the work on the house has progressed beyond the point where the items covered by this extra cannot be installed without entailing any unusual expense, then this order is to be cancelled and any deposit paid in connection with the same is to be refunded to the Purchaser.
- The Vendor will undertake to incorporate the work covered by the sales extra in the construction of the house but will not be liable to the purchaser in any way, if for any reason the work covered by the extra is not carried out. In that event, any monies paid in connection with the same shall be returned to the Purchaser.
- It is understood and agreed that if for any reason whatsoever the transaction of Purchase and Sale is not completed, the total cost of extras ordered are not refundable to the Purchaser(s).
- Extras or changes will not be processed unless signed by the Vendor.
- These extras may not be amended without the written consent of Braylea Investments Inc..
- The Purchaser(s) and the Vendor acknowledge and agree that this form shall not be deemed to be part of the Agreement of Purchase and Sale entered into between them, nor an addendum thereto.
- No Estimates or orders will be accepted once construction has commenced.
- Prices are estimates only and guaranteed for a period of 5 days only.
- Any cancellations to this order, providing they can be cancelled, are subject to a \$500 minimum administration charge and a 10% cancellation charge for the total amount being cancelled.
- For Visa, Mastercard and Debit payments, transactions are identified on you statement as "SHERWAY CONSTRUCTION LTD", an Authorized Visa /Mastercard/Debit Merchant and authorized Royal Pine Homes company.

Payment Summary

<u>Paid By</u>	<u>Amount</u>	<u>Detail</u>
----------------	---------------	---------------

Total Payment: _____

Bonus Package From Agreement of Purchase and Sale dated June 27, 2016

Bonus Total
PE# 7,156 - May 23,
2018
Remaining Balance _____

PURCHASER:

DONALD BRADFORD

17-Jul-19
DATE

CONSULTANT:

Laura Di Fede

PURCHASER:

NADINE BRADFORD

17-Jul-19
DATE

VENDOR:

PER: Braylea Investments Inc.

☐ Decor

☐ Builder


☐ Purchaser

Printed: 17-Jul-19 at 11:50 am

Hampton
Suite 608



HOME > PRODUCTS > KCES950HSS

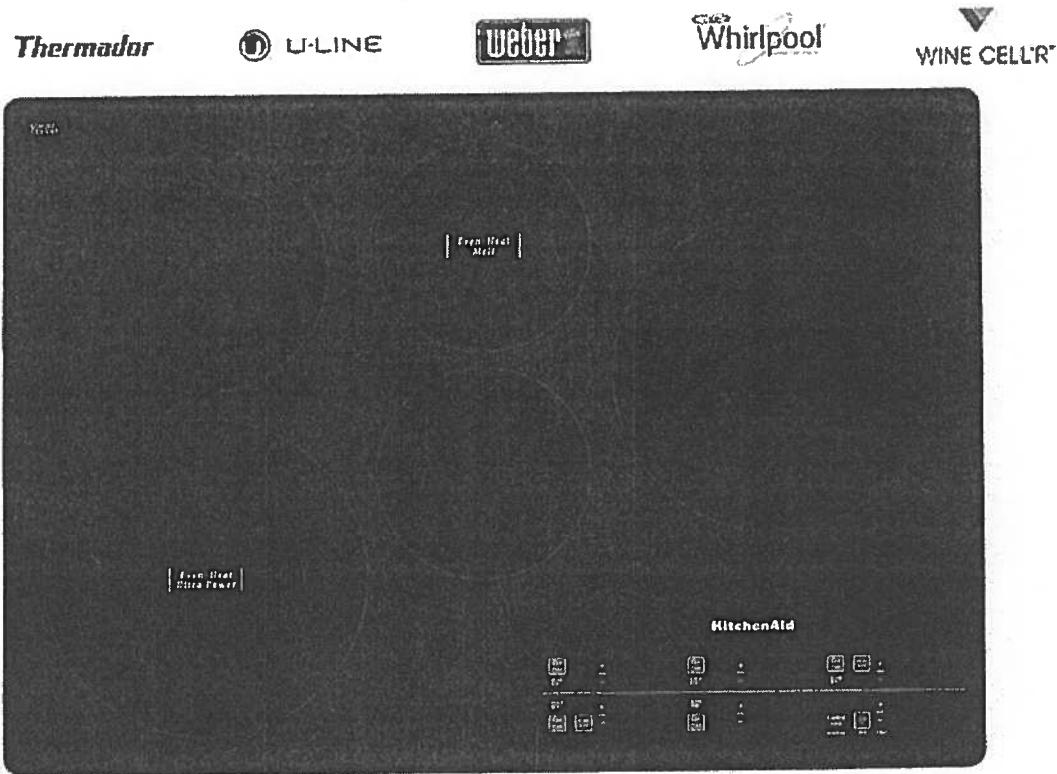

✕ COMPARE

f Facebook

t Twitter

KCES950HSS **KitchenAid®**

Clarification



PURCHASER'S EXTRAS (PE)

Hampton Place - Braylea Investments Inc.

PURCHASERS: DONALD BRADFORD and NADINE BRADFORD

TEL: RES.: 905-887-6812

LOT NUMBER	PHASE	HOUSE TYPE	REG. PLAN #		
608	1	PECONIC BAY			
Item	QTY	Description	Addition to Purchase Price		
1		1 - KITCHEN- Purchaer accepts and acknowledges that the Chimney Style exhaust fan chosen at time of colour chart has been replaced with the Falmec Vulcano Note: As per Head Office			
2		1 - PURCHASER AWARE AND ACCEPTS THAT ANY CHANGES MADE TO UPGRADES AFTER SIGNING THIS PURCHASERS EXTRA FORM ARE SUBJECT TO A MINIMUM ADMINISTRATION FEE OF \$1,000. PLUS A 10% HOLDBACK FEE. Note:			



Sub Total

HST

Total

1. In the event the work on the house has progressed beyond the point where the items covered by this extra cannot be installed without entailing any unusual expense, then this order is to be cancelled and any deposit paid in connection with the same is to be refunded to the Purchaser.
2. The Vendor will undertake to incorporate the work covered by the sales extra in the construction of the house but will not be liable to the purchaser in any way, if for any reason the work covered by the extra is not carried out. In that event, any monies paid in connection with the same shall be returned to the Purchaser.
3. It is understood and agreed that if for any reason whatsoever the transaction of Purchase and Sale is not completed, the total cost of extras ordered are not refundable to the Purchaser(s).
4. Extras or changes will not be processed unless signed by the Vendor.
5. These extras may not be amended without the written consent of Braylea Investments Inc..
6. The Purchaser(s) and the Vendor acknowledge and agree that this form shall not be deemed to be part of the Agreement of Purchase and Sale entered into between them, nor an addendum thereto.
7. No Estimates or orders will be accepted once construction has commenced.
8. Prices are estimates only and guaranteed for a period of 5 days only.
9. Any cancellations to this order, providing they can be cancelled, are subject to a \$500 minimum administration charge and a 10% cancellation charge for the total amount being cancelled.
10. For Visa, Mastercard and Debit payments, transactions are identified on you statement as "SHERWAY CONSTRUCTION LTD", an Authorized Visa /Mastercard/Debit Merchant and authorized Royal Pine Homes company.

Payment Summary

Paid By

Amount

Detail

Amendment

Total Payment:

Bonus Package From Agreement of Purchase and Sale dated June 27, 2016

Bonus Total

PE# 7,156 - May 23,
2018

Remaining Balance

PURCHASER:

DONALD BRADFORD

17-Jun-19

DATE

CONSULTANT:

Laura Di Pede

PURCHASER:

NADINE BRADFORD

17-Jun-19

DATE

VENDOR:

PER: Braylea Investments Inc.

☐ Decor

☐ Builder

☐ Purchaser

Printed: 17-Jun-19 at 11:48 am



Book
SITE COPY

CONSTRUCTION SUMMARY

Hampton Place

PURCHASERS: DONALD BRADFORD and NADINE BRADFORD

TEL: RES.: 905-887-6812

LOT NUMBER	PHASE	HOUSE TYPE	CLOSING DATE
608	1	PECONIC BAY	01-Nov-18

Offer	2 SINGLE PARKING SPACES IN LIEU OF TANDEM.
Workshee	Note:

Offer	PURCHASER TO RECEIVE \$10,000(INCLUDES APPLICABLE TAXES) WORTH OF UPGRADES AT THE DECOR CENTER AT TIME OF COLOUR CHART.
Workshee	Note:

Offer	INSTALL STANDARD LAMINATE IN LIEU OF TILE IN THE KITCHEN, BREAKFAST AREA, WALK IN CLOSET AND HALLWAY AS PER ATTACHED PLAN.
Upgrade	Note:

Offer	DELETE DOOR TO WALK IN CLOSET IN BEDROOM 2 AND INSTALL DOOR FROM MASTER BEDROOM AS PER ATTACHED PLAN.
Upgrade	Note:

Offer	VENDOR TO FLIP MASTER ENSUITE SHOWER AND BEDROOM 2 BATHTUB.(INSTALL DEEP SOAKER TUB/ SHOWER COMBINATION IN MASTER ENSUITE)AND INSTALL WALK IN SHOWER WITH FRAMELESS GLASS SHOWER ENCLOSURE AND DOOR WITH WATERPROOF CEILING LIGHT IN BEDROOM 2 ENSUITE AS PER ATTACHED PLAN.
Upgrade	Note:

Offer	DELETE WALL BETWEEN LAUNDRY ROOM AND WALK IN CLOSET AND INSTALL STANDARD LAMINATE FLOORING AS PER VENDORS STANDARD SAMPLES. DELETE DOOR OF WALK IN CLOSET AS PER ATTACHED PLAN. VENDOR WILL NOT TAKE RESPONSIBILITY FOR ANY DAMAGE TO LAMINATE FLOORING DUE TO WATER LEAKAGE. PURCHASERS WILL HAVE THE OPTION TO INSTALL SIDE BY SIDE WASHING MACHINE AND DRYER AFTER CLOSING. PURCHASER WILL ALSO HAVE THE OPTION TO ADD ELECTRICAL
Upgrade	OUTLETS FOR A FEE IN THIS NEW COMBINED SEWING/LAUNDRY ROOM AT THEIR DECOR APPOINTMENT AND WILL BE NOTIFIED OF THE CHARGE AT THAT TIME.

Offer	ENTRANCE TO DEN TO BE AS CLOSE TO ENSUITE WALL AS POSSIBLE
Upgrade	Note: #2

Offer	VENDOR TO INSTALL SIDE BY SIDE CONNECTIONS FOR WASHER AND DRYER IN LIEU OF STACKABLE CONNECTIONS. VENDOR TO SUPPLY STACKABLE WASHER AND DRYER AS PER STANDARD APPLIANCE PACKAGE. VENDOR NOT TO INSTALL STACKABLE WASHER AND DRYER. PURCHASER TO SUPPLY AND
Upgrade	Note:

Offer	VENDOR TO FLIP MASTER ENSUITE SHOWER AND BEDROOM 2 BATHTUB. INSTALL DEEP SOAKER TUB/ SHOWER COMBINATION IN MASTER ENSUITE AND INSTALL WALK IN SHOWER WITH FRAMELESS GLASS SHOWER ENCLOSURE AND DOOR WITH WATERPROOF CEILING LIGHT IN BEDROOM 2 ENSUITE AS PER
Upgrade	Note:

Offer	DELETE WALL BETWEEN LAUNDRY ROOM AND WALK IN CLOSET AND INSTALL STANDARD LAMINATE FLOORING AS PER VENDORS STANDARD SAMPLES. DELETE DOOR OF WALK IN CLOSET AS PER ATTACHED PLAN. VENDOR WILL NOT TAKE RESPONSIBILITY FOR ANY DAMAGE TO LAMINATE FLOORING DUE TO
Upgrade	Note:

Offer	VENDOR TO INSTALL SIDE BY SIDE CONNECTIONS FOR WASHER AND DRYER IN LIEU OF STACKABLE CONNECTIONS. VENDOR TO SUPPLY STACKABLE WASHER AND DRYER AS PER STANDARD APPLIANCE PACKAGE. VENDOR NOT TO INSTALL STACKABLE WASHER AND DRYER. PURCHASER TO SUPPLY AND I
Upgrade	Note:



SITE COPY

CONSTRUCTION SUMMARY

Hampton Place

PURCHASERS: DONALD BRADFORD and NADINE BRADFORD

TEL: RES.: 905-887-6812

LOT NUMBER	PHASE	HOUSE TYPE	CLOSING DATE
608	1	PECONIC BAY	01-Nov-18

Date Added: 23-May-18 Invoice Number: 7156

1 - CLARIFICATION - REFER TO APAS; DELETE - LAUNDRY ROOM - Vendor to Supply Stackable Washer and Dryer as per Standard Appliance Package. Vendor Not to Install Stackable Washer & Dryer, Purchaser to Supply & Install Side by Side Washer/Dryer After Closing Note:
1 - INSTALL; LAUNDRY ROOM - Vendor to Supply and Install Side By Side Washer/Dryer from Selected Upgrade Appliance Package. (See Below Item # for Upgrade Appliance Package Details) Note:
1 - KITCHEN & BATHROOMS - SEE QUALITY TOPS & KITCHENS FOR ALL KITCHEN & BATHROOMS UPGRADES / LAYOUTS. (See Attached QTK Paperwork) Note:
1 - KITCHEN - Install ADDITONAL Standard Countertop - ASPEN TRIBECA - To be installed throughout kitchen, where applicable (does not include stone backsplash) (Includes CookTop Cut-Out) (See Sketch) Note: Priced as per Orlando at Connolly
1 - KITCHEN - COUNTERTOP EDGING - Install UPGRADE " I " EDGING - To be installed throughout kitchen countertop, where applicable (See Sketch) Note: Priced as per Orlando at Connolly
1 - DISCLAIMER - STONE COUNTERTOP; KITCHEN - Stone slabs vary in size & all seams are visible & the fabricator reserves the right to position the seams as necessary. Note:
KITCHEN - Kitchen Backsplash - Install ADDITIONAL STANDARD BACKSPLASH - 12x12 TWILIGHT MOCHA GLASS MOSAICS - To be installed above cook-top behind chimney hood fan. To touch underside of bulk-head above cook-top. (See Sketch) Note: Priced as per Fil at AV Tile
1 - KITCHEN - Kitchen Sink - Install Standard Undermount Sink - BLANCO Horizon Plus U2 Undermount Sink (8") - Model # 401234 Note:
1 - KITCHEN - Kitchen Faucet - Install Standard Faucet - DELTA Chrome Pull-Out Kitchen Faucet (Single Hole) - Model# 469-LF - Chrome Note:
1 - APPLIANCE PACKAGE - Install Upgrade Appliance Package - UPGRADE PACKAGE #3A - To be installed throughout suite, where applicable (See Sketch) Note: Priced as per Vince at Head-Office *Above Pricing to Include; Additional Electrical (Including Panel Upgrade) to Accommodate Kitchen Appliances*
1 - KITCHEN - Install WATER LINE To FRIDGE at Kitchen (See Sketch) Note:
1 - CLARIFICATION; ALL BATHROOMS - Install RAISED HEIGHT VANITY throughout all bathroom vanities, where applicable. To Include; Powder Room, Master Ensuite and Ensuite #2 (See Attached QTK Paperwork) Note:
1 - POWDER ROOM - Install Standard Granite Countertop - BIANCO ANTICO - To be installed throughout powder room vanity, where applicable (Does Not Include 3" Splash) (See Sketch) Note:
1 - POWDER ROOM - COUNTERTOP EDGING - Install UPGRADE " I " EDGING - To be installed throughout powder room vanity countertop, where applicable (See Sketch) Note:



SITE COPY

CONSTRUCTION SUMMARY

Hampton Place

PURCHASERS: DONALD BRADFORD and NADINE BRADFORD

TEL: RES.: 905-887-6812

LOT NUMBER 608	PHASE 1	HOUSE TYPE PECONIC BAY	CLOSING DATE 01-Nov-18	
-------------------	------------	---------------------------	---------------------------	--

Date Added: 23-May-18

Invoice Number: 7156

1 - ENSUITE #2 - Install Standard Granite Countertop - BIANCO ANTICO - To be installed throughout ensuite #2 vanity, where applicable (Does Not Include 3" Splash) (See Sketch)
Note:

1 - CLARIFICATION;
ALL BATHROOMS - Purchaser Requested to DELETE Standard 3" Splash throughout all bathroom vanity countertops, where applicable. To Include; Powder Room, Master Ensuite & Ensuite #2 (See Sketch)
Note:

1 - DISCLAIMER - GRANITE COUNTERTOP;
POWDER ROOM & ENSUITE #2 - Due to the many variables that can affect the pattern, colour and/or design and "pitting" of natural products, granite installed will not be identical to the samples displayed
Note: Every effort is made to provide granite countertops as close as possible but the vendor is not responsible for results which differ from the sample displayed. All countertop surfaces may have seams, and product pattern and shade can change in areas containing seams.

1 - DISCLAIMER - STONE COUNTERTOP;
ALL BATHROOMS - Stone slabs vary in size & all seams are visible & the fabricator reserves the right to position the seams as necessary.
Note:

1 - CLARIFICATION;
ENSUITE #2 - Purchaser accepts & acknowledges the standard frameless glass at ensuite #2 shower stall will NOT touch the ceiling and will receive a Standard Chrome Header. (See Sketch)
Note:

1 - CLARIFICATION;
ALL BATHROOMS - Install Standard Plumbing Fixtures throughout all bathrooms, where applicable. To Include; Powder Room, Master Ensuite and Ensuite #2 (See Sketch)
Note:

1 - CLARIFICATION;
ALL BATHROOMS - DELETE Do Not Install / Supply / Credit Purchaser for builders standard ceramic bathroom accessories (toilet paper, towel bar & soap dish) throughout all bathrooms where applicable.
Note: To Include; Powder Room, Master Ensuite and Ensuite #2 (See Sketch)

1 - CLARIFICATION;
ALL BATHROOMS - DELETE Do Not Install / Supply / Credit Purchaser for builders' standard Bathroom Mirrors, throughout all bathrooms, where applicable. To Include; Powder Room, Master Ensuite and Ensuite #2 (See Sketch)
Note:

1 - BONUS PACKAGE - PURCHASER HAS APPLIED \$10,000.00 (Includes Taxes) WORTH OF UPGRADE PROMOTIONAL PACKAGE TOWARDS THE PURCHASE OF UPGRADES COMPLETED AT THE DECOR CENTRE.
Note:

1 - PURCHASER HAS ATTENDED A COLOR APPOINTMENT AT THE DECOR CENTRE AND HAS DECLINED ANY ADDITIONAL UPGRADES. Purchaser accepts and acknowledges that there will be no further changes/additions/deletions to be made upon signing on May 23,2018
Note:

1 - PURCHASER AWARE AND ACCEPTS THAT ANY CHANGES MADE TO UPGRADES AFTER SIGNING THIS PURCHASERS EXTRA FORM ARE SUBJECT TO A MINIMUM ADMINISTRATION FEE OF \$1,000 PLUS A 10% HOLDBACK FEE.

This Document is Extremely Time Sensitive - Printed 29 May 18 at 10:12



Unit

608

Pattern

Notes

Hampton Place

Printed May 22, 2018 2:11 pm



* INTERIOR OUR SCHEME *

Purchasers		Decor Consultant	Model Type	Telephone Res. / Bus	Project	Closing Date	Unit
DONALD BRADFORD & NADINE BRADFORD		Melissa Di Martino	PECONIC BAY	(905) 887-6812 /	Hampton Place	01/11/2018	608

Page 2 of 3

CABINETRY, VANITIES AND COUNTERTOPS

	Style	Countertop		Counter Edge	Handle / Knob
		✓			
Ensuite #2	CATEGORY 1 - FIBERBOARD - WHITE QT 1203 (STD)	✓	BIANCO ANTICO GRANITE (STD)	"A" EDGE (STD)	16338-195
MASTER ENSUITE	CATEGORY 2 - MAPLE - CHESTNUT QT 2503 (STD)	✓	ASPEN TERRA WHITE (STD)	"A" EDGE (STD)	16338-195
POWDER ROOM	CATEGORY 1 - LP LAMINATE - CHIOSTRO QT 1022 (STD)	✓	BIANCO ANTICO GRANITE (STD)	"I" EDGE (UPG)	3487-128
KITCHEN / DINETTE	CATEGORY 2 - LP LAMINATE - SKYE QT 1022 (STD)	✓	ASPEN TRIBECA (STD)	"I" EDGE (UPG)	3487-128
LAUNDRY ROOM	N/A		N/A	N/A	N/A

APPLIANCE PACKAGE
Upgrade #3A
Package

Std 31in Opening

PLUMBING FIXTURES

KITCHEN	✓ STANDARD
Sink Model	✓ STANDARD
Sink Faucet	✓ STANDARD
TOILETS	✓ STANDARD
Master Ensuite	✓ STANDARD
Ensuite #2	✓ STANDARD
Powder Room	✓ STANDARD
VANITY FAUCETS	✓ STANDARD
Master Ensuite	✓ STANDARD
Ensuite #2	✓ STANDARD
Powder Room	✓ STANDARD
VANITY SINKS	✓ STANDARD
Master Ensuite	✓ STANDARD
Ensuite #2	✓ STANDARD
Powder Room	✓ STANDARD
SHOWER STALL / TUBS	✓
Ensuite #2 Shower Stall	✓ STANDARD
Master Ensuite Tub	✓ STANDARD
Main Bathroom Tub	N/A

Trim	Baseboard & Casing	Levers
Interior Doors	STANDARD - CARRARA, SMOOTH	Door Height
		STANDARD


Cornice Moulding / Medallion	Fireplace
Foyer	N/A
Living Room	N/A
Dining Room	N/A
Den	N/A
Master Bedroom	N/A
Bedroom 2	N/A
Bedroom 3	N/A

Paint Throughout	Trim
Walls	STANDARD - BIRCH WHITE
	STANDARD - WHITE

MISC. INSTALLATIONS	Ceramic Accessories (installed by Vendor)
✓	☐ Yes ☒ No
✓	Bathroom Mirrors (installed by Vendor)
✓	☐ Yes ☒ No
✓	Wire Shelving - Closet (installed by Vendor)
✓	☒ Yes ☐ No


Page 2 of 3

Decor Consultant: Melissa Di Martino
Purchaser: DONALD BRADFORD
Purchaser: NADINE BRADFORD
Vendor: Hampton Place
Printed May 22, 2018 2:11 pm

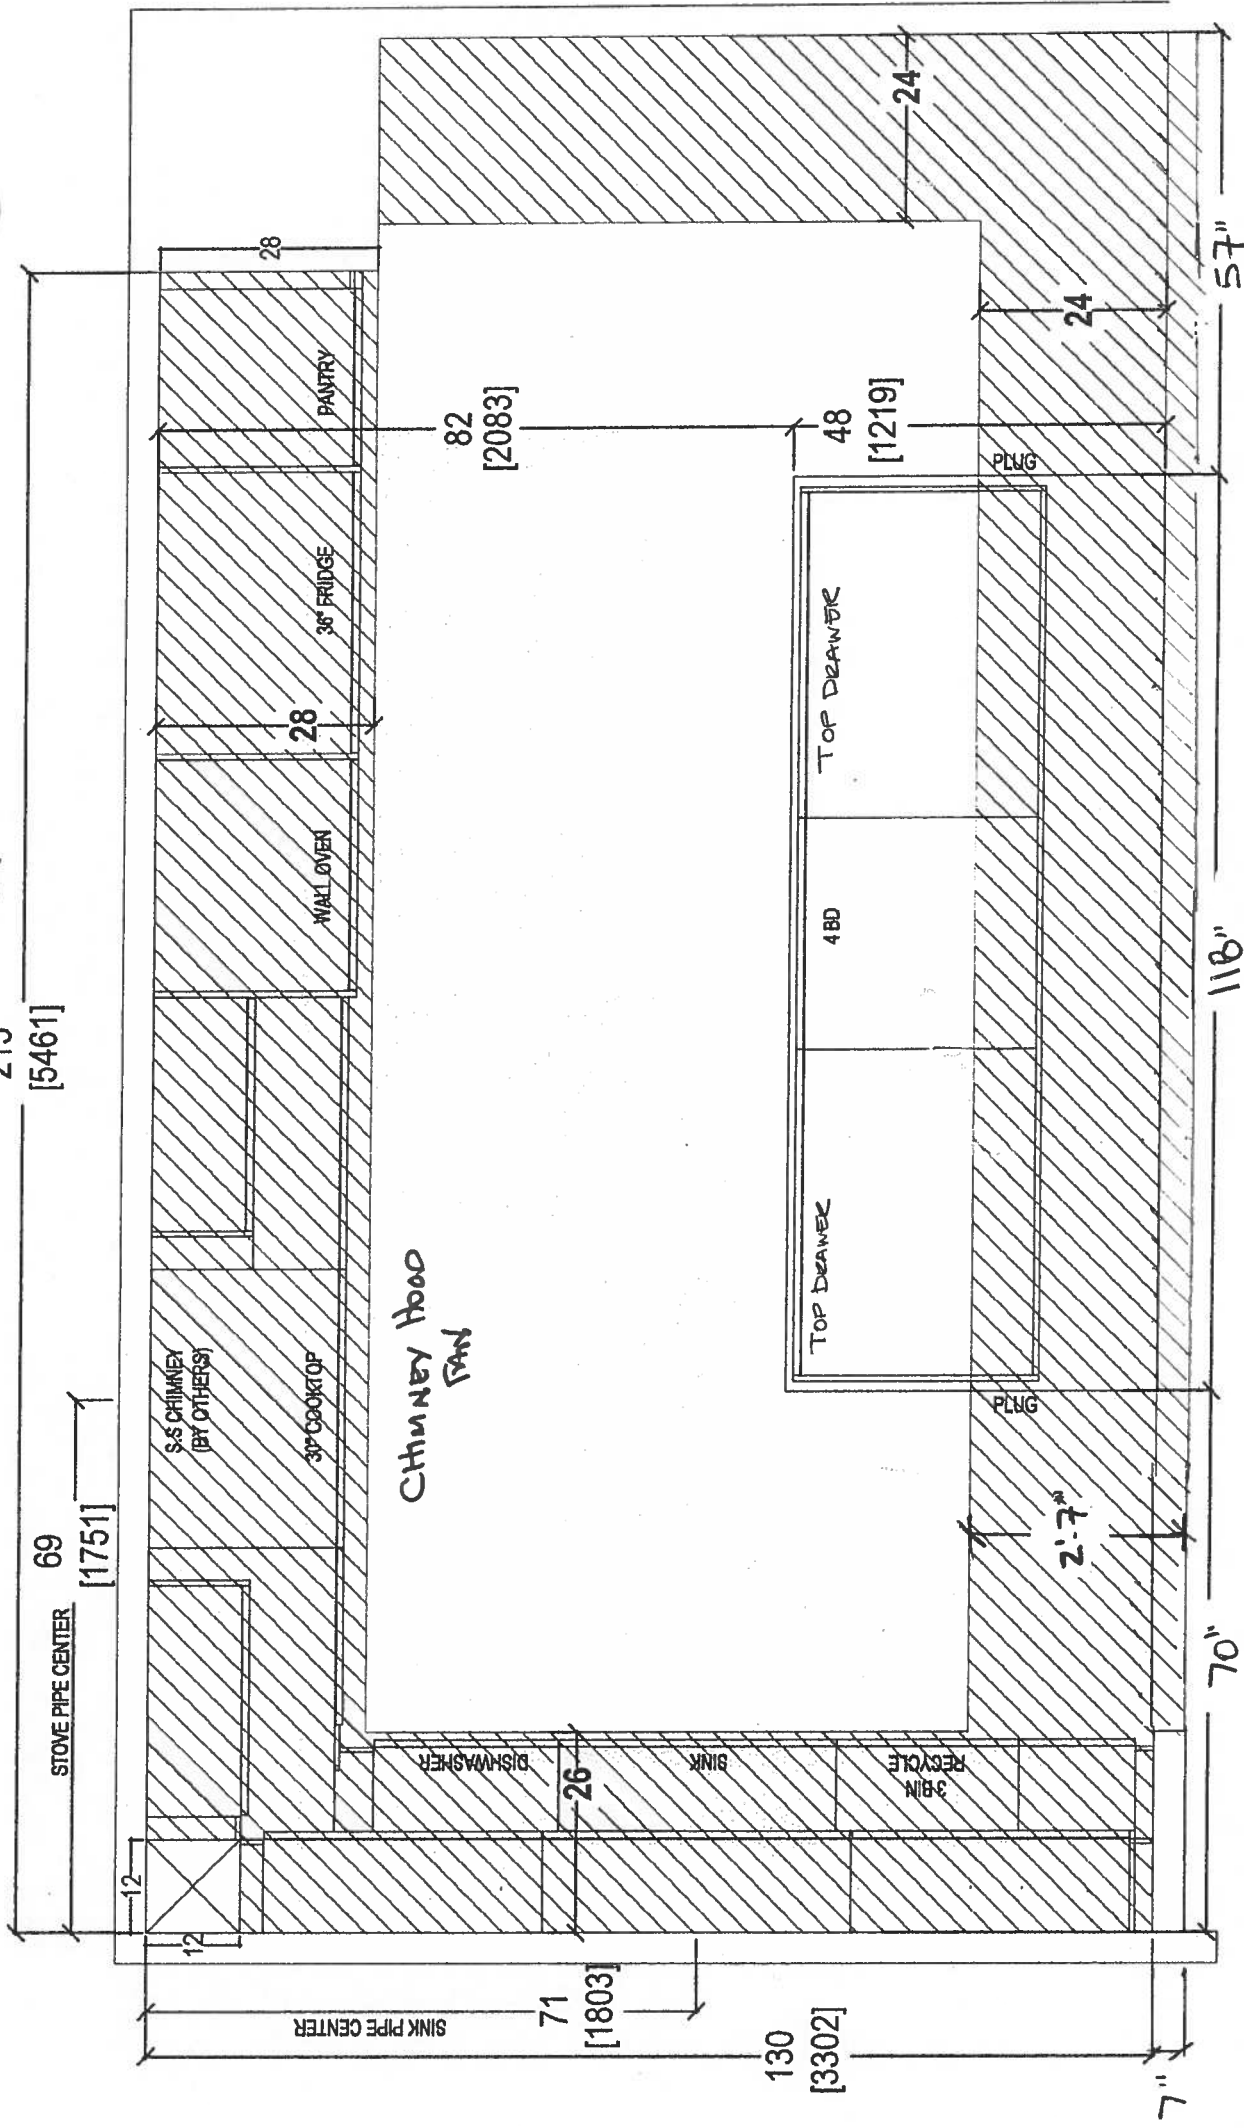

 your kitchen, your taste. 80 SANTE DRIVE, VAUGHAN, ON L4K 3C4, T: 416.746.1811 F: 905.761.5901	CLIENT: ROYAL PINE HOMES	JOB NAME: UNIT 808 HMP	ROOM: KITCHEN BULKHEAD PLAN	DRAWN BY: SK	COMMENTS:
	SITE: HAMPTON PLACE	DOOR STYLE: —	DOOR HANDLE: —	SCALE: 1/2" = 1' - 0"	
	PHONE: —	FINISH: —	DRW HANDLE: —	DATE: MAY22, 2018	
	EMAIL: —	SPECIES: —	TOP: —	PAGE: —	


Suite 608 Hampton

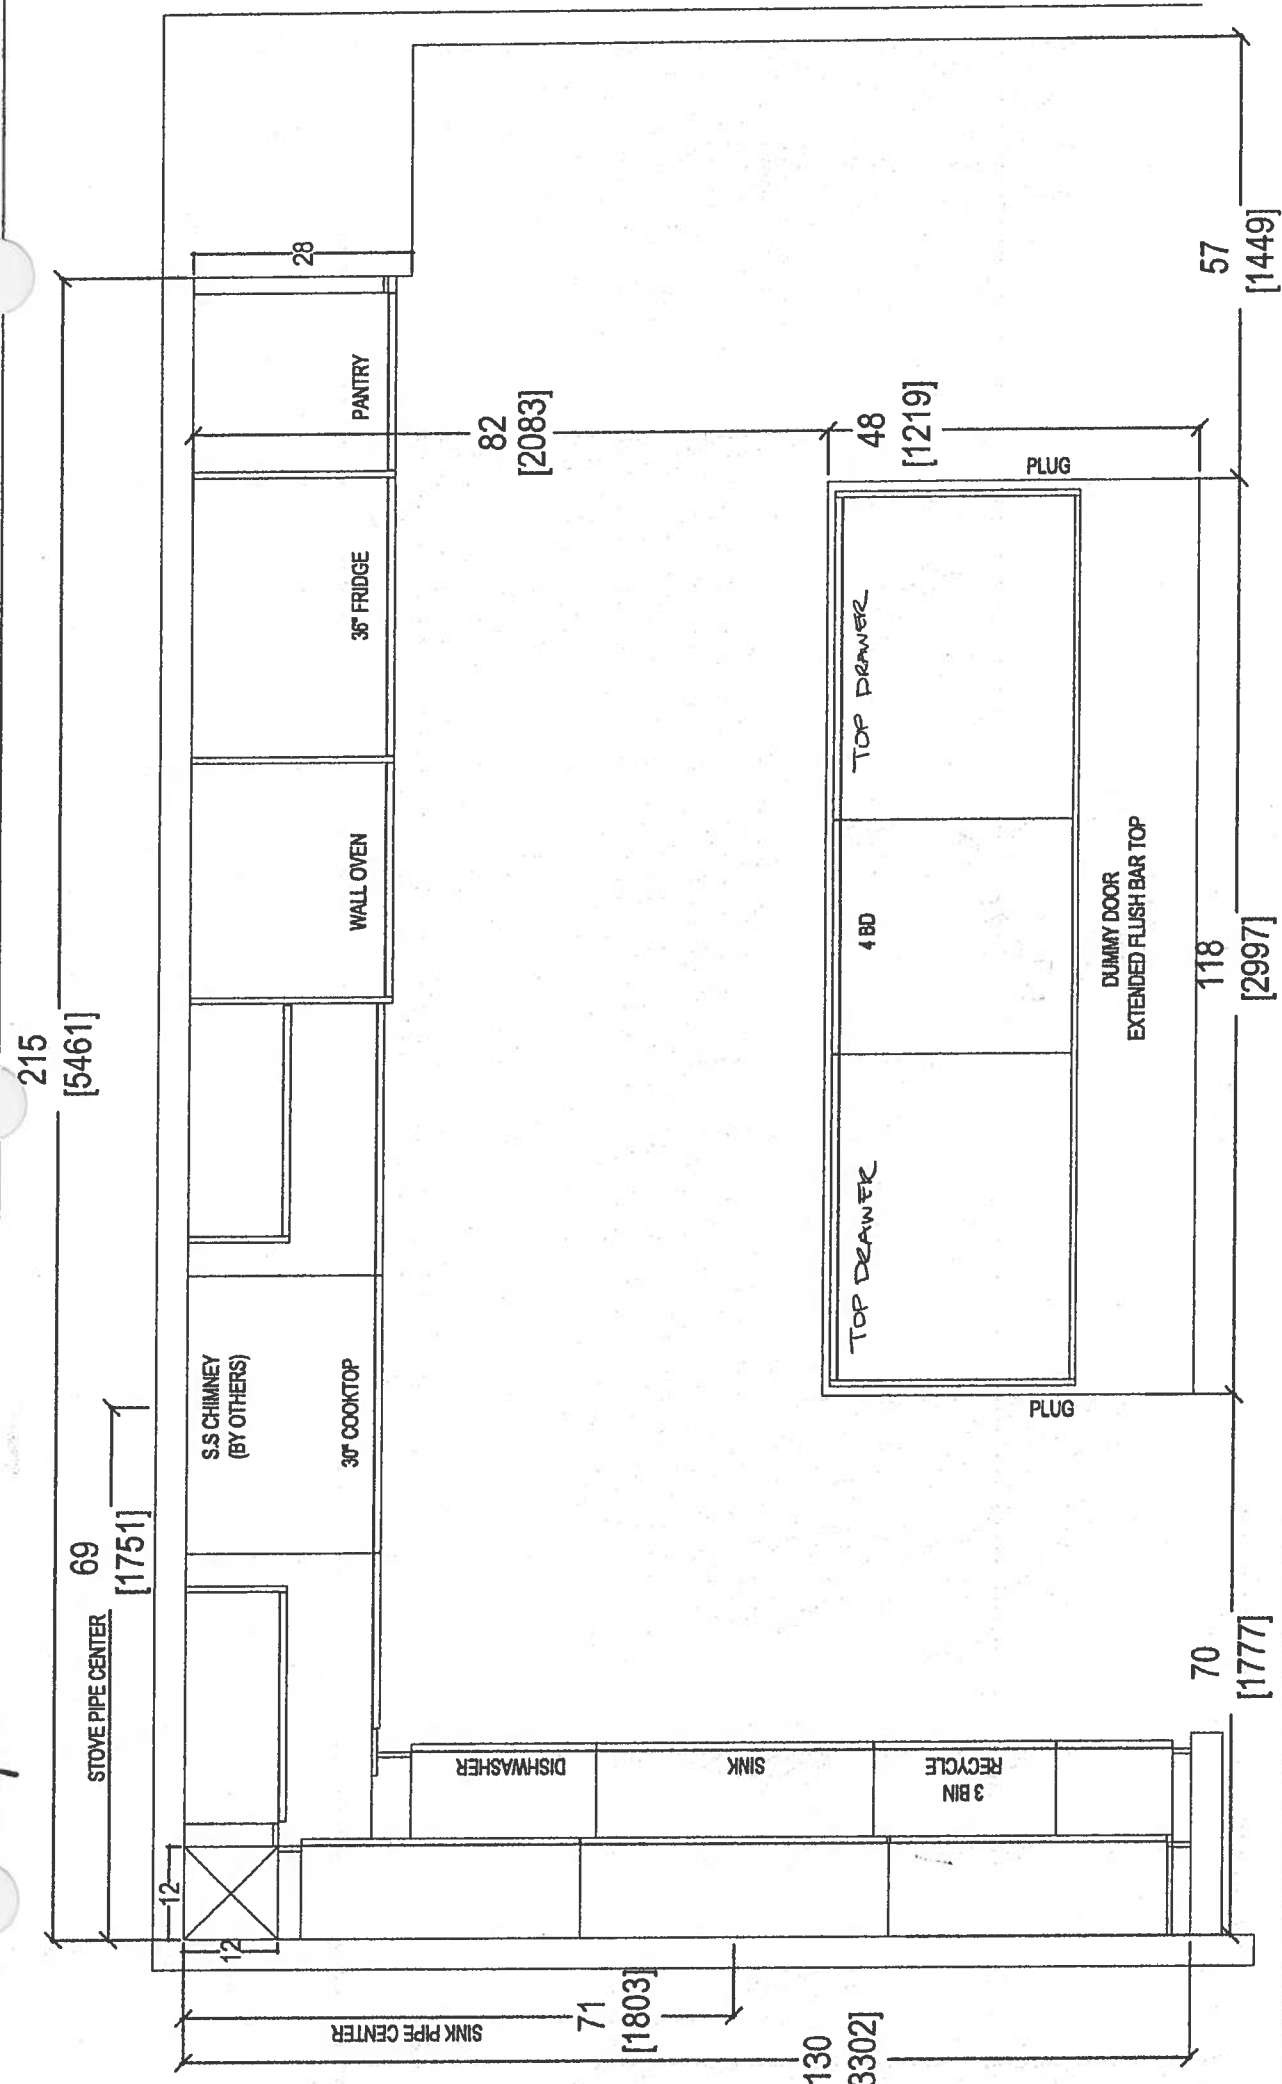

your kitchen, your taste. 80 SANTE DRIVE, VAUGHAN, ON L4K 3C4. T: 416.746.1811 F: 905.761.5901		CLIENT: ROYAL PINE HOMES		JOB NAME: UNIT 608 HMP		ROOM: KITCHEN FLOOR PLAN		DRAWN BY: SK		COMMENTS:	
SITE: HAMPTON PLACE		DOOR STYLE: —		DOOR HANDLE: —		SCALE: 1/2" = 1' - 0"					
PHONE: —		FINISH: —		DRW HANDLE: —		DATE: MAY 4, 2018					
EMAIL: —		SPECIES: —		TOP: —		PAGE: —					

Suite 608 Hampton

PL-Puck Light
(x5)

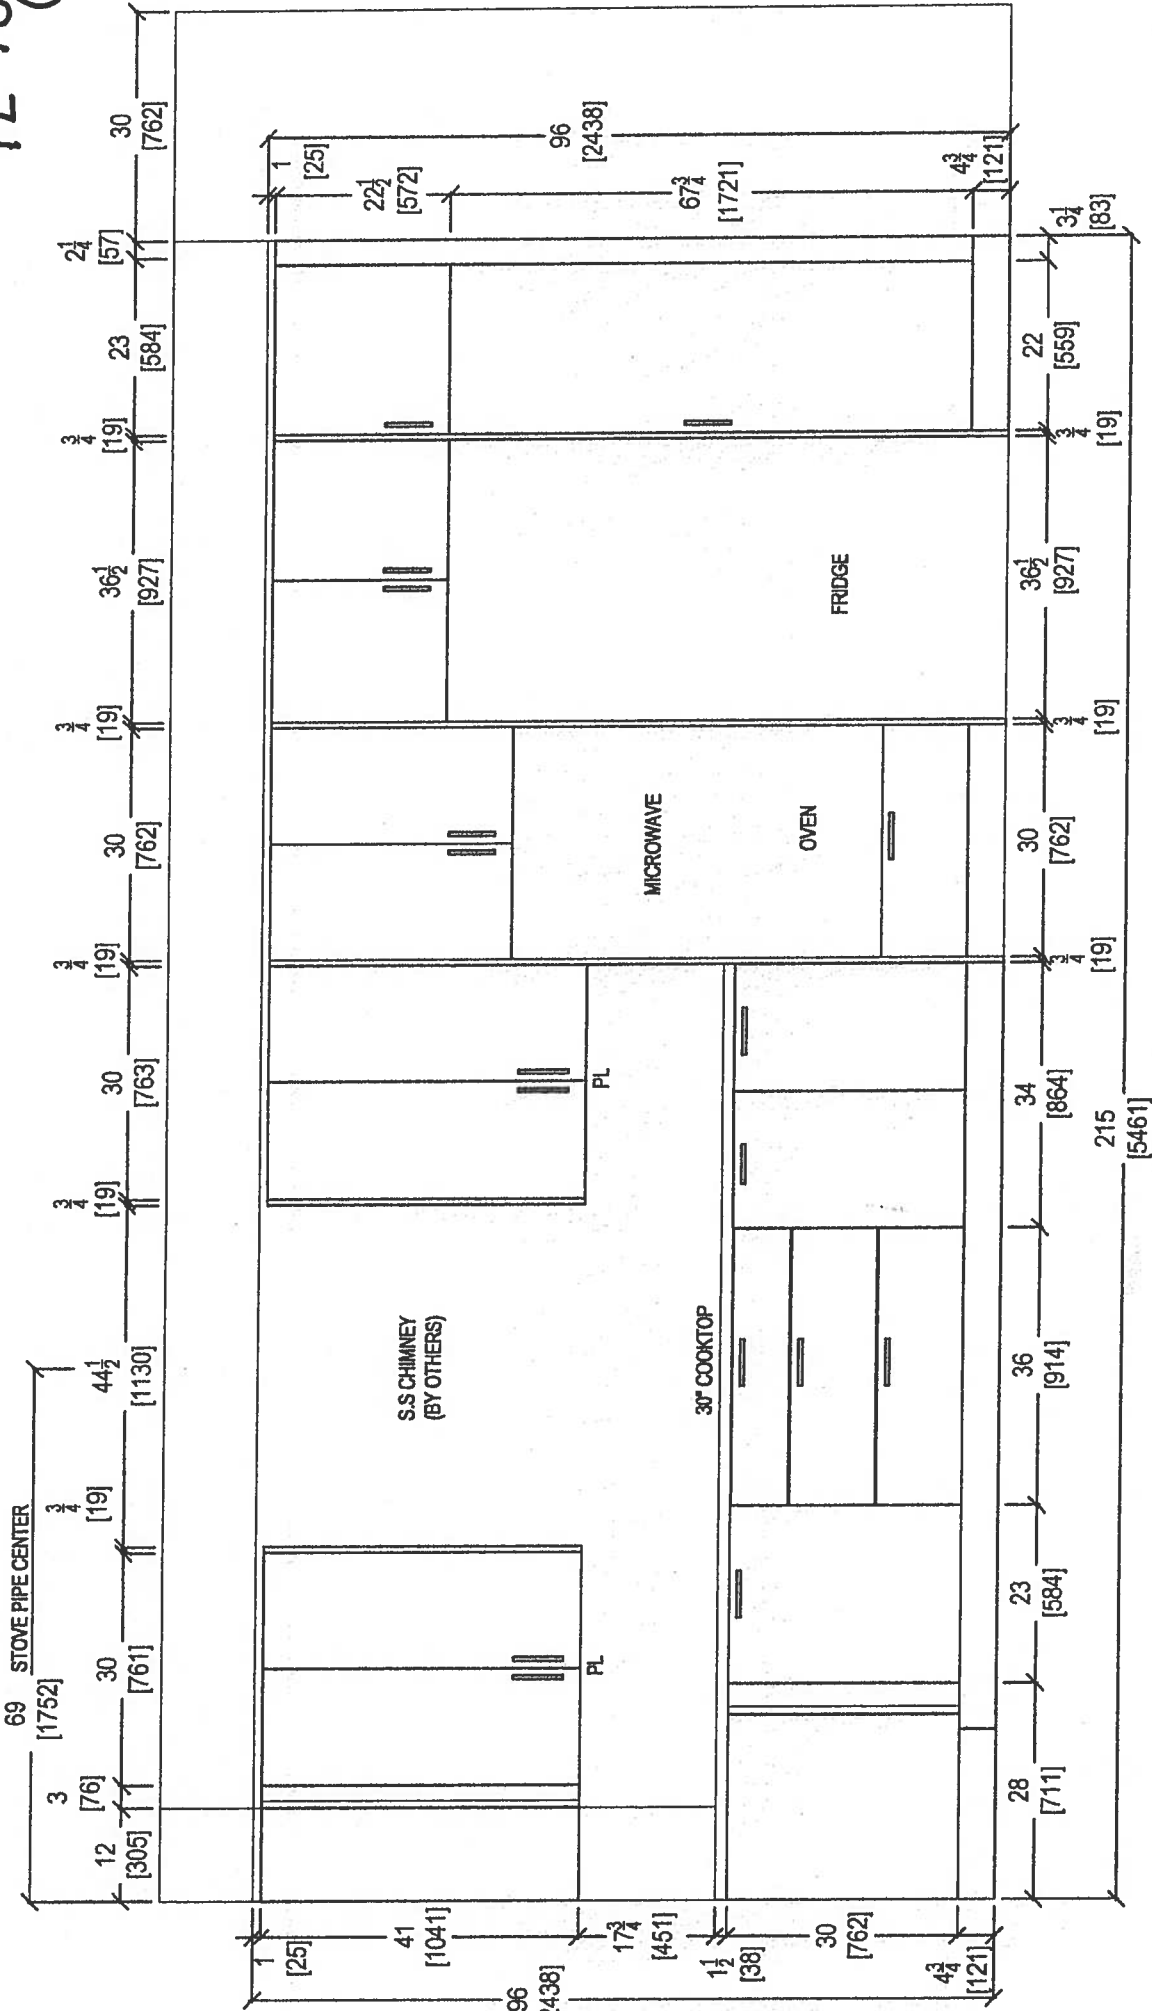

STOVE WALL ELEVATION


 your kitchen, your taste 80 SANTE DRIVE, VAUGHAN, ON L4K 3C4, T: 416.746.1811 F: 905.761.5901	CLIENT: ROYAL PINE HOMES		JOB NAME: UNIT 608 HMP	ROOM: KITCHEN	DRAWN BY: SK	COMMENTS: 
	SITE: HAMPTON PLACE		DOOR STYLE: —	DOOR HANDLE: —	SCALE: 1/2" = 1' - 0"	
	PHONE: —		FINISH: —	DRW HANDLE: —	DATE: MAY 4, 2018	
	EMAIL: —		SPECIES: —	TOP: —	PAGE: —	

Suite 608



amptn

PL - Rock Light (x5)

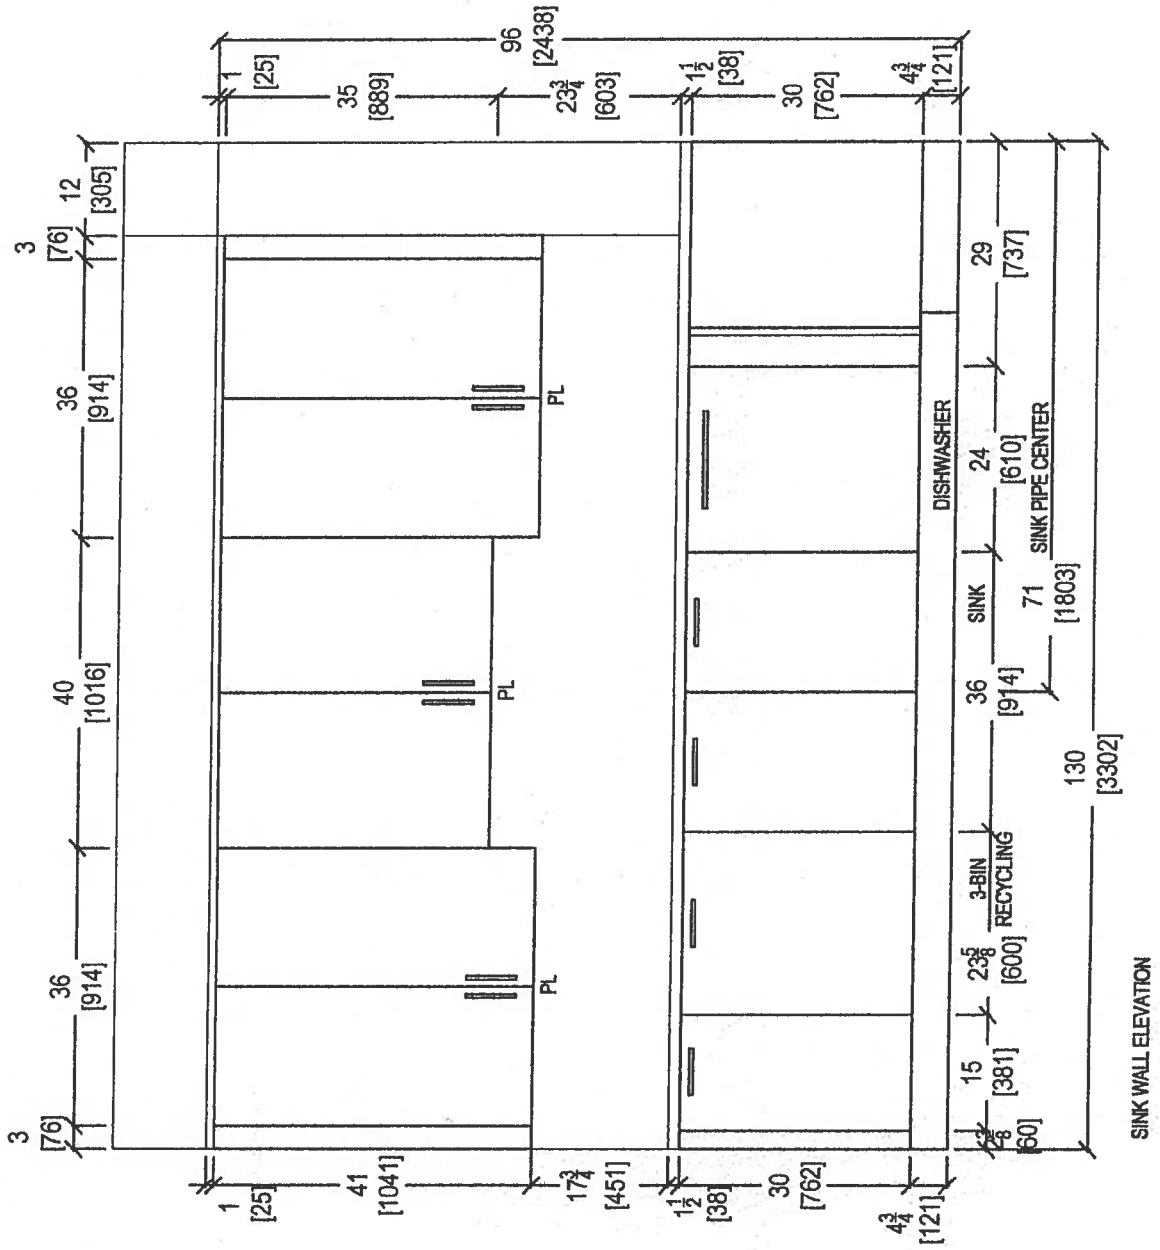

your kitchen your taste.
80 SANTE DRIVE, VAUGHAN, ON L4K 3C4,
T: 416.746.1811 F: 905.761.5901

CLIENT: ROYAL PINE HOMES
SITE: HAMPTON PLACE
PHONE: —
EMAIL: —


JOB NAME: UNIT 808 HMP
DOOR STYLE: —
FINISH: —
SPECIES: —

ROOM: KITCHEN
DOOR HANDLE: —
DRW HANDLE: —
TOP: —


DRAWN BY: SK
SCALE: 1/2" = 1' - 0"
DATE: MAY 4, 2018
PAGE: —

COMMENTS:



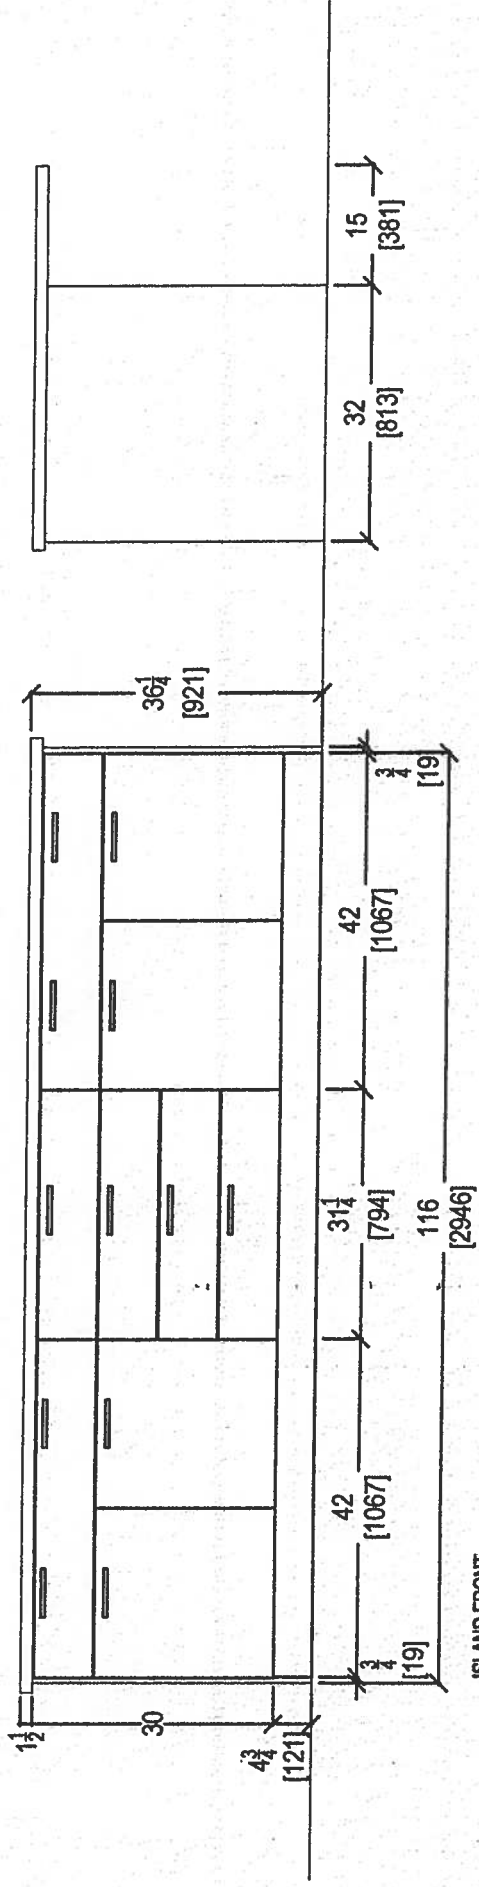

ISLAND FRONT

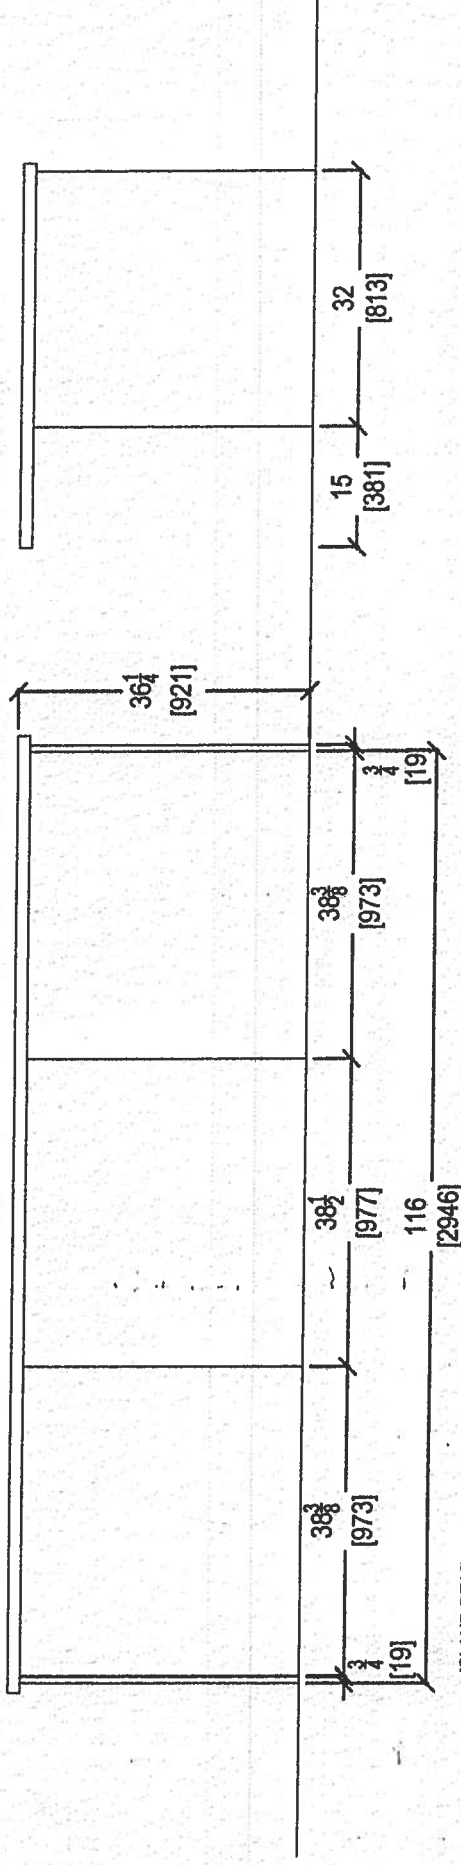


ISLAND REAR



80 SANTE DRIVE VAUGHAN, ON L4K 3C4,
T: 416.746.1811 F:905.761.5901



CLIENT: ROYAL PINE HOMES		JOB NAME: UNIT 808 HMP	ROOM: KITCHEN	DRAWN BY: SK	COMMENTS:
SITE: HAMPTON PLACE		DOOR STYLE: —	DOOR HANDLE: —	SCALE: 1/2" = 1' - 0"	
PHONE: —		FINISH: —	DRW HANDLE: —	DATE: MAY 4, 2018	
EMAIL: —		SPECIES: —	TOP: —	PAGE: —	

Delete 3" Splash

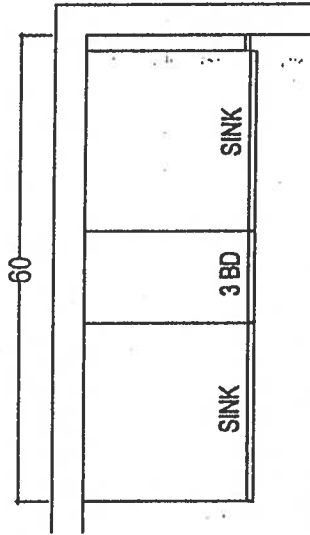



MASTER ENSUITE

*Raised Height

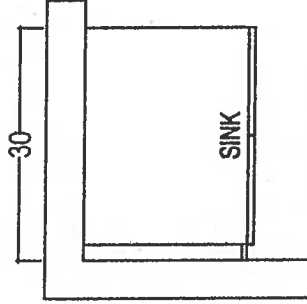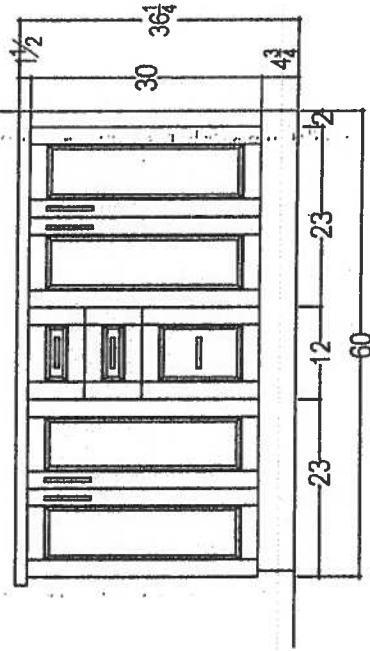


POWDER ROOM

*Raised Height

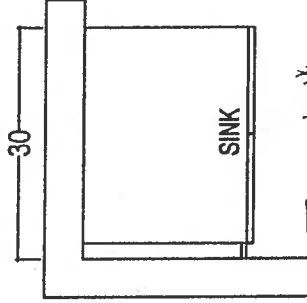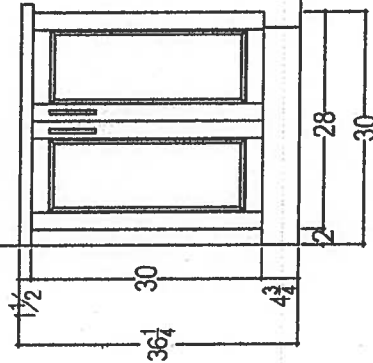

ENSUITE #2

*Raised Height

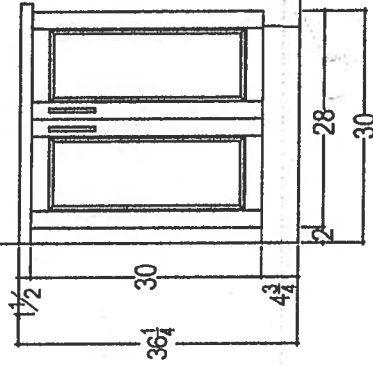

your kitchen, your taste.
80 SANTE DRIVE, VAUGHAN, ON L4K 3C4,
T: 416.746.1811 F: 905.761.5601

CLIENT: ROYAL PINE HOMES

SITE: HAMPTON PLACE

PHONE: —

EMAIL: —

JOB NAME: UNIT 608 HMP

DOOR STYLE: —

FINISH: —

SPECIES: —

ROOM: VANITIES

DOOR HANDLE: —

DRW HANDLE: —

TOP: —

DRAWN BY: SK

SCALE: 1/2" = 1'-0"

DATE: APRIL 27, 2018


PAGE: —

COMMENTS:



KRFC302ESS

22 cu.ft. 36-Inch Width Counter Depth French Door Refrigerator
with Interior Dispense

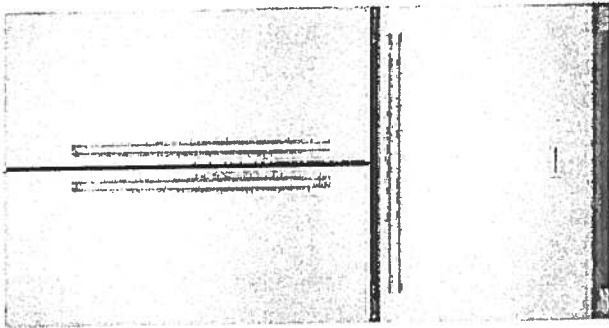

MASTED
IN
AMERICA

KitchenAid®

<http://www.kitchenaid.com>

Product Dimensions:

Height: 72
Width: 35 3/4
Depth: 30 1/4

Electrical Requirements:

15 Amps.

Available In:

- ☐ Stainless Steel
- ☒ Black
- ☐ White

KRFC302ESS

Key Features:

- ExtendFresh™ Temperature Management System
- Interior Water Dispenser
- Professionally-Inspired Design
- Produce Preserver
- Humidity-Controlled Crispers
- FreshChill™ Temperature-Controlled Full-Width Pantry
- Pull-Out Tri-Level Freezer Drawer
- SatinGlide® System
- LED Lighting
- Star-K Certified
- Automatic Ice Maker
- Max Cool

Suite 608
Hampton

Upgrade
Package 3A



Because Whirlpool Corporation policy includes a continuous commitment to improve our products, we reserve the right to change materials and specifications without notice. We also reserve the right to discontinue or transition products without notice.

21eq, Registered trademark/TM Trademark of Whirlpool, U.S.A. © 2013 Whirlpool Corporation. All Rights Reserved. All other trademarks are owned by their respective companies.

Created On Wednesday, April 22, 2015 15:51:04



KitchenAid® 30" Electric Cooktop with 5 Elements and Touch-Activated Controls

KCES950HSS

Available Finishes/Colours



KCES950HBL
Black



KCES950HSS
Stainless Steel

Dimensions

Depth	21 3/4
Height	5 1/4
Width	30 13/16
Cutout Depth	20 3/8
Cutout Width	29 1/16

Performance

Fuel Type	Electric
-----------	----------

Design

Hot Surface Indicator	Yes
-----------------------	-----

This 30" electric cooktop delivers exceptional results and looks good doing it with a CookShield finish that helps prevent scratches to the glass. Performance is provided by a 10" Even-Heat™ UltraPower™ Element with Simmer Setting, a 6" Even-Heat™ Elements with Melt Setting, and 10" 1/6" Ultra Power™ Double-Ring Round Element designed to accommodate both large stock pots and six-inch sauté pans with ease and handle rapid boiling, searing and wok cooking.

Top Features

10" 1/6" Even-Heat™ Ultra Power™ Element with Simmer Setting

6" Even-Heat™ Element with Melt Setting

CookShield Finish for Glass Surface

Manuals & Literature:



Use and Care



Installation Instructions



Other




Warranty


- The cooktop should be installed away from strong draft areas, such as windows, doors, fans or strong heating vents. The cooktop should be located for convenient use in the kitchen.
- Use the countertop opening dimensions that are given with these Installation Instructions. Given dimensions are minimum clearances and provide 0" (0 cm) clearance.
- Grounded electrical supply is required. See "Electrical Requirements" section.

IMPORTANT: To avoid damage to your cabinets, check with your builder or cabinet supplier to make sure that the materials used will not discolor, delaminate, or sustain other damage.

Product Dimensions

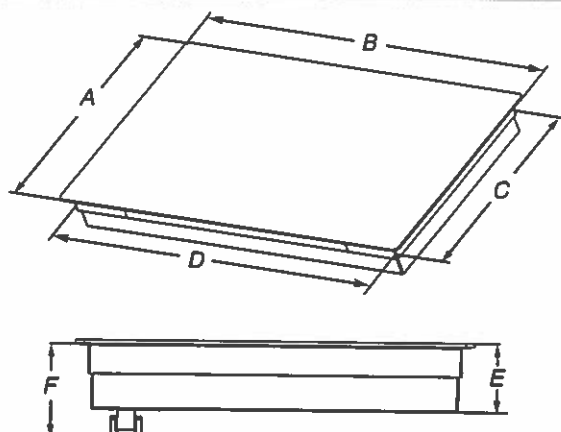


- A. Glass depth - black and white models - 21 3/4" (55.2 cm)
Glass depth - stainless steel models - 22 1/8" (56.4 cm)
- B. Glass width - 24" (60.9 cm) models - 23 13/16" (60.5 cm)
Glass width - 30" (76.2 cm) models - 30 13/16" (78.4 cm)
Glass width - 36" (91.4 cm) models - 36 5/16" (92.3 cm)
- C. Frame depth - 20 3/16" (51.6 cm)
- D. Frame width - 24" (60.9 cm) models - 21 59/64" (55.7 cm)
Frame width - 30" (76.2 cm) models - 29" (73.7 cm)
Frame width - 36" (91.4 cm) models - 34 7/16" (87.5 cm)
- E. Cooktop height with bottom heat shield - 3 7/8" (9.8 cm)
Cooktop height lighted knobs - 4 13/16" (12.55 cm)
- F. Cooktop height including conduit (located at rear of cooktop, right side) - 5" (12.7 cm)
Cooktop height lighted knobs, including conduit (located at rear of cooktop, right side) - 6 1/16" (15.4 cm)

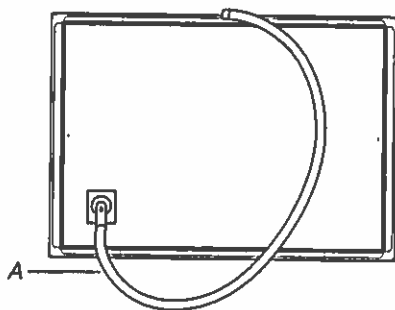

A. Location of Power Cord (length of power cord is 48" (121.9 cm), including the conduit)

Cabinet Dimensions

IMPORTANT: If installing a range hood or microwave hood combination above cooking surface, follow the range hood or microwave hood combination installation instructions for dimensional clearances above the cooktop surface.

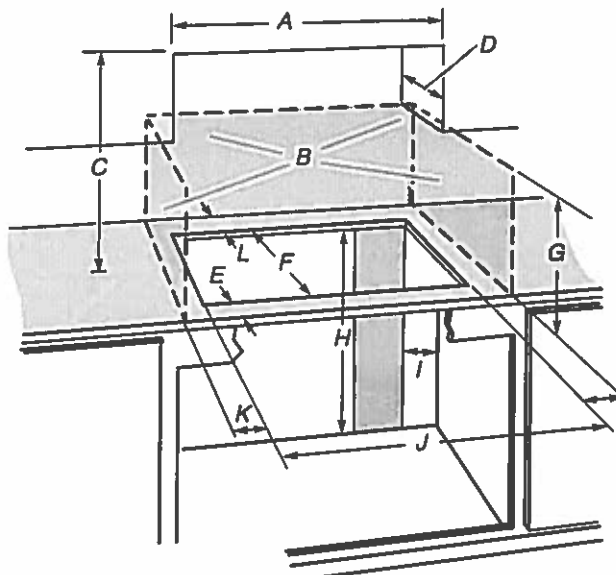

- A. 24" (60.9 cm) on 24" models; 30" (76.2 cm) on 30" models; 36" (91.4 cm) on 36" models
- B. Combustible area above countertop (shown by dashed box above)
- C. 30" (76.2 cm) minimum clearance between top of cooktop platform and bottom of uncovered wood or metal cabinet (24" [61 cm] minimum clearance if bottom of wood or metal cabinet is covered by not less than 1/4" [0.6 cm] flame retardant millboard covered with not less than No. 28 MSG sheet steel, 0.015" [0.04 cm] stainless steel, or 0.024" [0.06 cm] aluminum or 0.020" [0.05 cm] copper)
- D. 13" (33 cm) recommended upper cabinet depth
- E. 2" (5.1 cm)
- F. 20 1/2" (52.0 cm) recommended cutout.
Will fit in cutout from 20 3/8" - 20 9/16" (51.8 - 52.2 cm).
- G. 18" (45.7 cm) minimum clearance from upper cabinet to countertop within minimum horizontal clearances to cooktop
- H. Junction box or outlet: 7" (17.8 cm) minimum from top of countertop
- I. Junction box or outlet: 9" (23.0 cm) maximum from right side of cabinet
- J. 29 1/2" (74.9 cm) recommended cutout on 30" (76.2 cm) models.
Will fit in cutout from 29 1/8" - 29 9/16" (73.8 - 75.1 cm) on 30" (76.2 cm) models.
35 1/2" (90.2 cm) recommended cutout on 36" (91.4 cm) models.
Will fit in cutout from 34 9/16" - 35 3/16" (87.8 - 90.3 cm) on 36" (91.4 cm) models.
22 5/16" (56.67 cm) recommended cutout on 24" (61.0 cm) models.
Will fit in cutout from 22 1/4" - 22 3/7" (56.4 - 57.0 cm) on 24" (61.0 cm) models.
- K. 2 1/2" (6.35 cm) minimum distance to nearest left and right side combustible surface above cooktop
- L. 1 1/2" (3.81 cm) minimum clearance between back wall and countertop

NOTES: After making the countertop cutout, some installations may require notching down the base cabinet side walls to clear the cooktop base. To avoid this modification, use a base cabinet with sidewalls wider than the cutout.

If cabinet has a drawer, a 5 1/2" (14.0 cm) depth clearance from the top of the countertop to the top of the drawer (or other obstruction) in base cabinet is required.

Electrical Requirements

⚠ WARNING



Electrical Shock Hazard

Disconnect power before servicing.

Use 8 gauge copper wire.

Electrically ground cooktop.

Failure to follow these instructions can result in death, fire, or electrical shock.

If codes permit and a separate ground wire is used, it is recommended that a qualified electrical installer determine that the ground path and wire gauge are in accordance with local codes.

Check with a qualified electrical installer if you are not sure the cooktop is properly grounded.

Make sure that the electrical connection and wire size are adequate and in conformance with the National Electrical Code, ANSI/NFPA 70-latest edition or CSA Standards C22.1-94, Canadian Electrical Code, Part 1 and C22.2 No. 0-M91-latest edition, and all local codes and ordinances.


A copy of the above code standards can be obtained from:

National Fire Protection Association
1 Batterymarch Park
Quincy, MA 02169-7471
CSA International
8501 East Pleasant Valley Road
Cleveland, OH 44131-5575

Before You Make the Electrical Connection:

To properly install your cooktop, you must determine the type of electrical connection you will be using and follow the instructions provided for it here.

Use a 3-wire or 4-wire, single phase, 120/208 V or 120/240 V, 60 Hz, AC only. The model/serial number rating plate is located on the metal cabinet underneath the cooktop. See the following illustration.

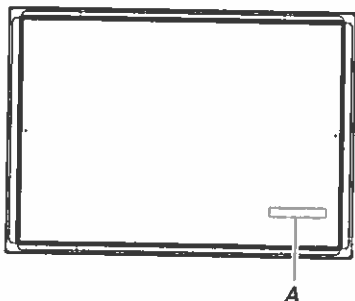

A. Model/serial number plate

- The cooktop is rated for 120/208 V or 120/240 V. Some models have a neutral (white) wire.

For power requirements, refer to the following table:

Family Model Number	Electrical Ratings at 60 Hz	
	208 V~	240 V~
WCE55US0H	5.0 kW	6.7 kW
WCE55US4H	5.0 kW	6.7 kW
WCE55US6H	6.0 kW	8.0 kW
WCE77US0H	6.4 kW	8.5 kW
WCE77US6H	6.4 kW	8.5 kW
WCE97US0H	6.8 kW	9.1 kW
WCE97US6H	6.8 kW	9.1 kW
MEC8830H	6.5 kW	8.6 kW
MEC8836H	7.4 kW	9.9 kW
KCES550H	7.9 kW	10.5 kW
KCES556H	7.9 kW	10.5 kW
KCES950H	7.2 kW	9.6 kW
KCES956H	7.2 kW	9.6 kW
JEC3430H	6.4 kW	8.5 kW
JEC3536H	7.9 kW	10.5 kW
JEC4424H	5.5 kW	7.3 kW
JEC4430H	7.2 kW	9.6 kW
JEC4536H	7.2 kW	9.6 kW

- The cooktop should be connected directly to the junction box through flexible, armored or nonmetallic sheathed, copper cable. The flexible, armored cable extending from the fuse box or circuit breaker box should be connected directly to the junction box.
 - Locate the junction box to allow as much slack as possible between the junction box and the cooktop so that the cooktop can be moved if servicing becomes necessary in the future.
 - Do not cut the conduit. Use the length of conduit provided. A UL listed or CSA approved conduit connector must be provided at each end of the power supply cable (at the cooktop and at the junction box). A listed conduit connector is already provided at the cooktop.
 - If the house has aluminum wiring follow the procedure below:
Connect the aluminum wiring using special connectors and/or tools designed and UL listed for joining copper to aluminum.
- Follow the electrical connector manufacturer's recommended procedure. Aluminum/copper connection must conform with local codes and industry accepted wiring practices.

INSTALLATION INSTRUCTIONS

Prepare Cooktop for Installation

⚠ WARNING


Excessive Weight Hazard

Use two or more people to move and install cooktop.
Failure to do so can result in back or other injury.

Decide on the final location for the cooktop. Avoid drilling into or severing existing wiring during installation.


1. Using 2 or more people, place the cooktop upside down on a covered surface using the foam end posts from the packaging. Make sure that the knobs are not resting on the foam.
2. Remove foam strip roll from the package containing literature. The roll contains four 1/4" (0.64 cm) strips of foam. Remove one strip at a time. Apply the foam strip adhesive around bottom of the four edges of the cooktop glass, following the edges of the glass.

NOTE: The foam strip helps avoid damage to the underside of the cooktop glass from debris and helps the cooktop sit flat on uneven counters.

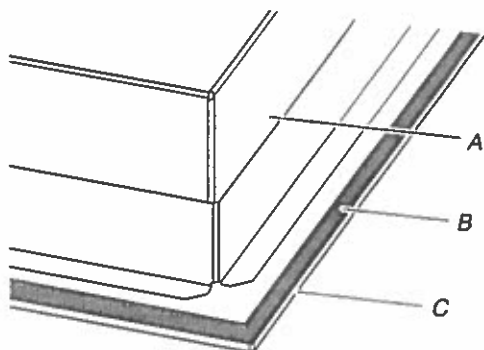

A. Cooktop base
B. 1/4" (0.64 cm) Foam strip
C. Cooktop

NOTE: For some models with trim on the front glass edge, apply the foam strip side down around bottom of the cooktop glass only on LEFT, RIGHT and BACK SIDE.

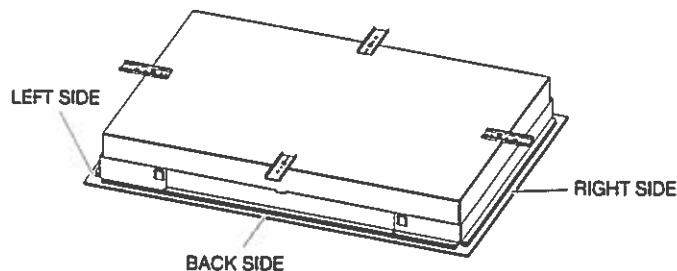

Install Cooktop

Style 1: Cooktop over undercounter built-in oven

IMPORTANT: Clamping brackets should not be used.


1. Using 2 or more people, place cooktop right side up into the cutout.

NOTE: Make sure that the front edge of the cooktop is parallel to the front edge of the countertop. If repositioning is needed, lift entire cooktop up from cutout to avoid scratching the countertop.

Style 2: Cooktop over cabinets

1. Determine whether your cabinet construction provides clearance for installing clamping brackets at cooktop base ends.

24" (60.9 cm), 30" (76.2 cm) and 36" (91.4 cm) traditional models

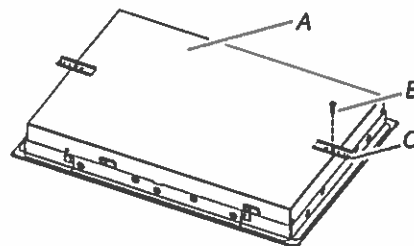


A. Cooktop base bottom
B. Attachment screw
C. Clamping bracket

2. The clamping brackets can be installed before or after the cooktop is placed into the cutout. Complete the following steps for the option you choose.

Installing Brackets Before Placing Cooktop in Cutout

1. Using 2 or more people, place the cooktop upside down on a covered surface using the foam end posts from the packaging. Make sure that the knobs are not resting on the foam.
2. Remove the attachment screws for the bracket locations from the bottom of the cooktop base.
3. Select bracket mounting holes that will allow the bracket to extend far enough out from the cooktop for the installation of 2½" (6.4 cm) clamping screws. See the "Attach Cooktop to Countertop" section for illustration of clamping screw installation.

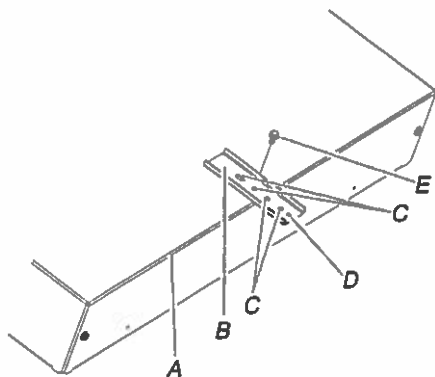

- A. Edge of cooktop base bottom
- B. Clamping bracket
- C. Bracket mounting holes
- D. Bracket clamping hole
- E. Attachment screw


4. Attach brackets to cooktop base bottom with bracket attachment screws using the bracket mounting holes selected in Step 3.
5. Rotate brackets so they do not extend beyond edge of cooktop base.
6. Tighten attachment screws enough to hold brackets in place when cooktop is placed in cutout.
7. Using 2 or more people, turn the cooktop right side up and place in cutout.
NOTE: Make sure that the front edge of the cooktop is parallel to the front edge of the countertop. If repositioning is needed, lift entire cooktop up from cutout to avoid scratching the countertop.
8. Loosen the screws and rotate the brackets so that they are perpendicular to the edge of the cooktop base and extend beyond its edge. Securely tighten screws.

Installing Brackets After Placing Cooktop in Cutout

1. Using 2 or more people, place cooktop right side up into the cutout.

NOTE: Make sure that the front edge of the cooktop is parallel to the front edge of the countertop. If repositioning is needed, lift entire cooktop up from cutout to avoid scratching the countertop.

2. Remove the attachment screws for the selected bracket locations from the bottom of the cooktop base.
3. Select bracket mounting holes that will allow the bracket to extend far enough out from the cooktop for the installation of 2½" (6.4 cm) clamping screws.

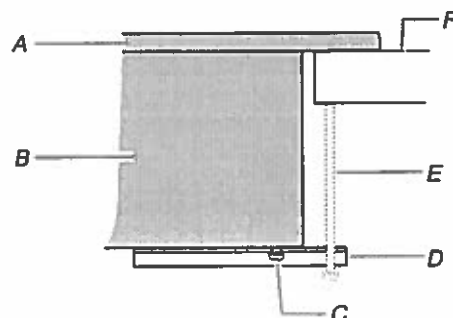

- A. Cooktop
- B. Cooktop base
- C. Attachment screw
- D. Clamping bracket (extends far enough beyond cooktop base to allow installation of clamping screws)
- E. 2½" (6.4 cm) clamping screw (to be installed in "Attach Cooktop to Countertop")
- F. Countertop

4. Attach brackets to cooktop base bottom with bracket attachment screws using the bracket mounting holes selected in Step 3. Securely tighten screws.

Make Electrical Connection

⚠ WARNING



Electrical Shock Hazard

Disconnect power before servicing.

Use 8 gauge copper wire.


Electrically ground cooktop.


Failure to follow these instructions can result in death, fire, or electrical shock.

This cooktop is manufactured with a frame connected, green or bare ground wire. Connect the cooktop cable to the junction box through the UL listed or CSA approved conduit connector.

Electrical Connection Options

For cooktops with a 4-wire cable

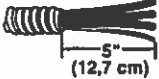If your home has:	And you will be connecting to:	Go to Section:
4-wire direct 	A fused disconnect or circuit breaker box	4-Wire Cable from Power Supply to 4-Wire Cable from Cooktop

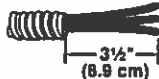3-wire direct 	A fused disconnect or circuit breaker box	3-Wire Cable from Power Supply to 4-Wire Cable from Cooktop
--	---	---


For cooktops with a 3-wire cable:

If your home has:	And you will be connecting to:	Go to Section:
4-wire direct 	A fused disconnect or circuit breaker box	4-Wire Cable from Power Supply to 3-Wire Cable from Cooktop

3-wire direct 	A fused disconnect or circuit breaker box	3-Wire Cable from Power Supply to 3-Wire Cable from Cooktop
--	---	---

4-Wire Cable from Power Supply to 4-Wire Cable from Cooktop

IMPORTANT: Use the 4-wire cable from power supply where local codes do not permit connecting the frame-ground conductor to the neutral (white) junction box wire.

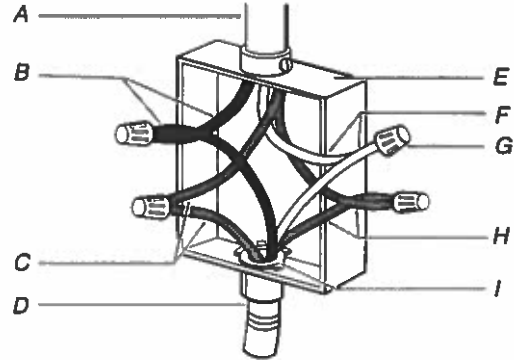


- A. 4-wire cable from power supply
- B. Black wires
- C. Bare or green wires
- D. 4-wire cable from cooktop
- E. Junction box
- F. White wires
- G. UL listed wire connector
- H. Red wires
- I. UL listed or CSA approved conduit connector

1. Disconnect power.
2. Remove junction box cover, if present.
3. Connect the flexible cable conduit from the cooktop to the junction box using a UL listed or CSA approved connector for 1/2" (1.3 cm) conduit.
4. Tighten screws on conduit connector if present.
5. Connect the two black wires together using the UL listed wire connectors.
6. Connect the two red wires together using the UL listed wire connectors.
7. Connect the two white wires together using the UL listed wire connectors.
8. Connect the green or bare ground wire from the cooktop cable to the green or bare ground wire (in the junction box) using the UL listed wire connectors.
9. Install junction box cover.
10. Reconnect power.

3-Wire Cable from Power Supply to 4-Wire Cable from Cooktop

IMPORTANT: Use the 3-wire cable from power supply where local codes permit connecting the frame-ground conductor to the neutral (white) junction box wire:

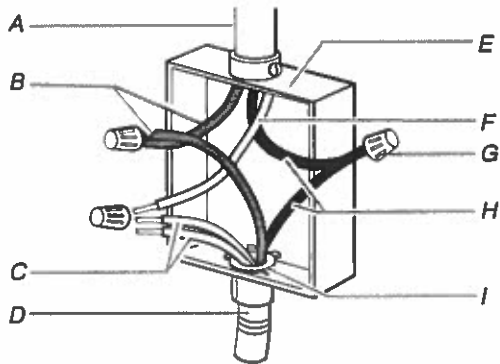


- | | |
|--|--|
| A. 3-wire cable from power supply | F. White wire (from power supply) |
| B. Red wires | G. UL listed wire connector |
| C. White and green or bare ground wires (from cooktop) | H. Black wires |
| D. 4-wire cable from cooktop | I. UL listed or CSA approved conduit connector |
| E. Junction box | |

1. Disconnect power.
2. Remove junction box cover, if present.
3. Connect the flexible, cable conduit from the cooktop to the junction box using UL listed or CSA approved conduit connector.
4. Tighten screws on conduit connector if present.
5. Connect the two black wires together using the UL listed wire connectors.
6. Connect the two red wires together using the UL listed wire connectors.
7. Connect the green or bare and white cooktop cable wires to the white (neutral) wire in the junction box using the UL listed wire connectors.
8. Connect the green or bare ground wire from the cooktop cable to the green or bare ground wire (in the junction box) using the UL listed wire connectors.
9. Install junction box cover.
10. Reconnect power.

4-Wire Cable from Power Supply to 3-Wire Cable from Cooktop

IMPORTANT: Use the 4-wire cable from power supply where local codes do not permit connecting the frame-ground conductor to the neutral (white) junction box wire:

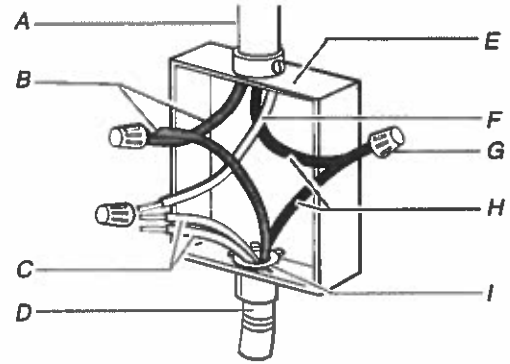

- | | |
|---|--|
| A. 4-wire cable from power supply | F. White wire (from power supply) |
| B. Red wires | G. UL listed wire connector |
| C. Green or bare ground wire (from cooktop) | H. Black wires |
| D. 3-wire cable from cooktop | I. UL listed or CSA approved conduit connector |
| E. Junction box | |

1. Disconnect power.
2. Remove junction box cover, if present.
3. Connect the flexible cable conduit from the cooktop to the junction box using a UL listed or CSA approved conduit connector.
4. Tighten screws on conduit connector if present.
5. Connect the two black wires together using the UL listed wire connectors.
6. Connect the two red wires together using the UL listed wire connectors.
7. Connect the green or bare ground wire from the cooktop cable to the green or bare ground wire (in the junction box) using the UL listed wire connectors.
8. Put a UL listed wire connector on the end of the white wire.
NOTE: Do not connect the bare ground wire to the neutral (white) wire in the junction box.
9. Install junction box cover.
10. Reconnect power.

Suite 608 Upgrade Hampton Package 3A




KOCE500ESS

KitchenAid®

KitchenAid® 30" Combination Wall Oven with
Even-Heat™ True Convection (Lower Oven)

<http://www.kitchenaid.com>

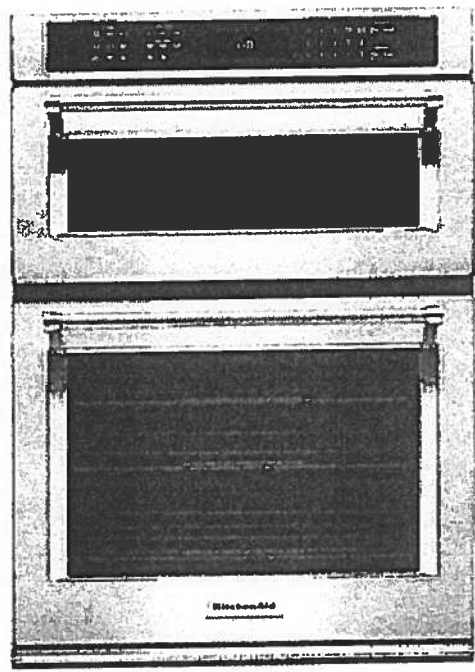

Key Features:

- Even-Heat™ True Convection Oven (lower oven)
- Microwave Convection Cooking (upper oven)
- Professionally-Inspired Design
- Temperature Probe
- EasyConvect™ Conversion System
- 5.0 Cu. Ft. Total Capacity (lower oven)
- 1.4 Cu. Ft. Capacity (upper oven)
- Crispwave™ Microwave Technology and Crisper Pan (upper oven)
- SatinGlide™ Roll-Out Extension Rack (lower oven)

Product Dimensions:

Height: 42 1/2
Width: 30
Depth: 26 7/8

Electrical Requirements:

40 Amps.

Additional Information:

- Use And Care Guide
- Dimension Guide
- Installation Guide
- Warranty Certificate

Available in:

- Black
- Black Stainless
- Stainless Steel
- White

INVESTED
IN
AMERICA

©Registered trademark/TM Trademark of Whirlpool, U.S.A. © 2013 Whirlpool Corporation. All Rights Reserved.
All other trademarks are owned by their respective companies.
Because Whirlpool Corporation policy includes a continuous commitment to improve our products, we reserve the right to change materials and specifications without notice. We also reserve the right to discontinue or transition products without notice.
Manufacturer's Suggested Retail Price (MSRP) and Minimum Advertised Price (MAP) provided for reference purposes only. Dealer alone determines advertised and retail prices.
Created On: Tuesday, September 22, 2015 16:37:35

Suite 608 Upgrade Hampton Package 3A



KDTM354ESS

KitchenAid



dBA Dishwasher with Clean Water Wash System

<http://www.kitchenaid.com>



Key Features:

- Clean Water Wash System
- ProScrub® Option
- Professionally-Inspired Design
- Advanced ProDry™ System
- ProWash™ Cycle
- SatinGlide® Max Rails (Upper Rack)
- Sliding Tines in the Lower Rack
- 2 Rows Fold-Down Tines in Upper Rack
- Fold-Down Tines in the Lower Rack
- 2 Fold-Down Cup Shelves with Integrated Stemware Holders
- Utility Basket (Upper Rack)
- Express Wash

Product Dimensions:

Height: 34 1/2
Width: 23 7/8
Depth: 24 3/4

Electrical Requirements:

15 Amps.

Additional Information:

- [Use And Care Guide](#)
- [Dimension Guide](#)
- [Installation Guide](#)
- [Energy Guide](#)
- [Warranty Certificate](#)

Available in:

 Stainless Steel

INVESTED
IN
AMERICA

©Registered trademark/TM Trademark of Whirlpool, U.S.A. © 2013 Whirlpool Corporation. All Rights Reserved
All other trademarks are owned by their respective companies.
Because Whirlpool Corporation policy includes a continuous commitment to improve our products, we reserve the right to change materials and specifications without notice. We also reserve the right to discontinue or transition products without notice.
Manufacturer's Suggested Retail Price (MSRP) and Minimum Advertised Price (MAP) provided for reference purposes only. Dealer alone determines advertised and retail prices.
Created On: Friday, March 04, 2016 16:36:55

U.S.A. (EN (/en_us/)) - Select Country (/en_us/country/)

Catalogues (/en_us/catalog/) Downloads (/en_us/downloads/) Reserved area (http://portal.falmec.com/) Contacts (/en_us/contacts/)

Search Q

Suite 608 Hampton
Revised: April 4, 2019


falmec
(/en_us/)

PRODUCTS COMPANY (/EN_US/COMPANY/) FALMEC WORLD (/EN_US/FALMEC_WORLD/)

NEWS & PRESS (/EN_US/NEWS/)

HOME (/EN_US/) > HOODS (/EN_US/TYPOLOGY/HOODS-1/) > POTENZA (/EN_US/TYPOLOGY/HOODS-1/COLLECTION/POTENZA-15/) > VULCANO

SHARE THIS PRODUCT

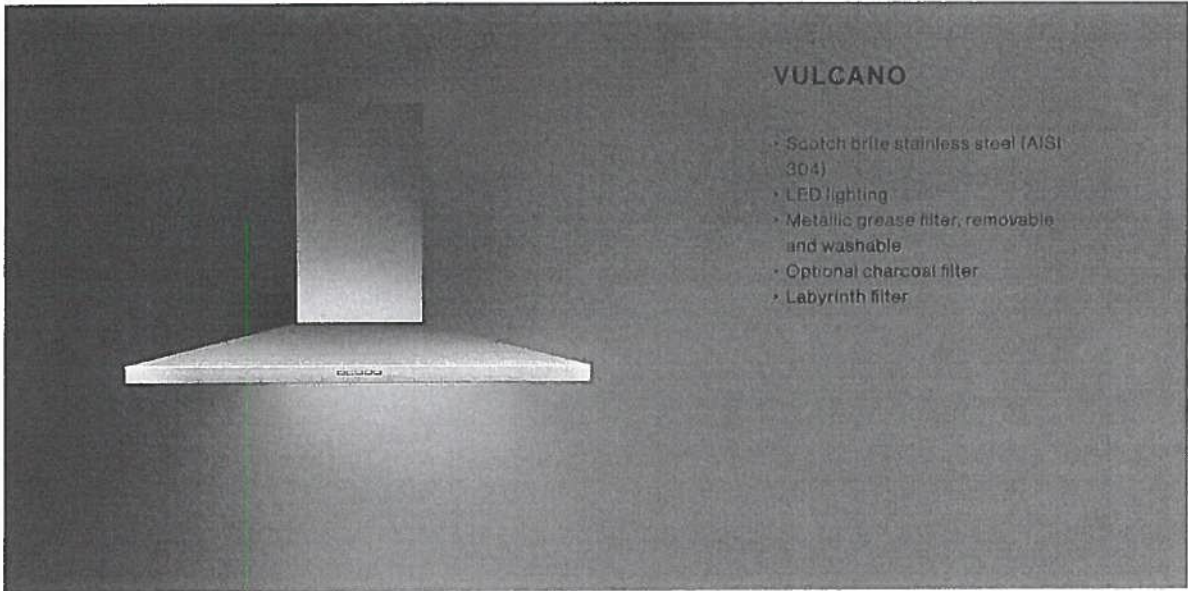

VARIANTS

FPVUL30W3SS / Vulcano Wall 30" (76 cm) 280 CFM
FPVUX36W6SS / VulcanoXL Wall 36" (90cm) 600 CFM
FPVUL24W3SS / Vulcano Wall 24" (60 cm) 280 CFM
FPVUX30W6SS / VulcanoXL Wall 30" (76 cm) 600 CFM

TECHNICAL FEATURES

Installation type
Wall
Dimensions
76 cm / 30 in
Features
Scotch brite stainless steel (AISI 304)
Electronic control
Metallic grease filter, removable and washable
Optional charcoal filter
Labyrinth filter
Finish
Scotch brite stainless steel (AISI 304)
Motor
450 m³/h / 280 cfm
Type of control
Electronic control
Speed settings
Lighting
Led 2x1,2 W - 3200 K

ACCESSOIRES

KACL.510#1
Extension H700 - Wall
KACL.512#1
Extension H960 - Wall
KACL.815
Protective cleaning cloths for stainless steel (box 10 pcs)
103050107
Square charcoal filter - Type 3

CONSUMPTION

Maximum consumption
150 W
Current
120V 60Hz
Frequency

PACKAGING

Gross weight
20 Kg
Net weight
15 Kg
Volumes
0.30 m³
Packaging size
Length: 995 mm
Height: 595 mm
Depth: 510 mm

COOKIE POLICY

We use cookies on "www.falmecnorthamerica.com". If you continue to use "www.falmecnorthamerica.com" you will be agreeing to the website General Terms and Conditions of Use, Privacy Policy and the use of cookies while using the website. To find out more about cookies and how to change your preferences please see our Cookie Policy (http://www.falmecnorthamerica.com/en_us/cookie/).


[DOWNLOAD TECHNICAL SHEET](#)

Minimum distance
Electric hob: 52 cm
Gas hob: 60 cm


Download pdf (<https://falmec-catprod1.falmec.com/technical-specifications/515/en-US>)

[View all downloads](#)

Suite 608 Hampton
Revised: April 4, 2019

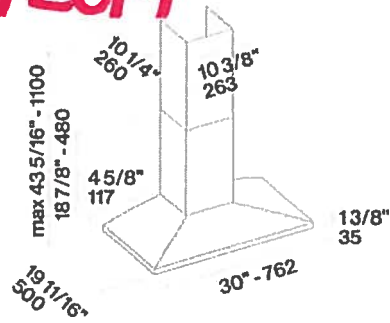

GALLERY

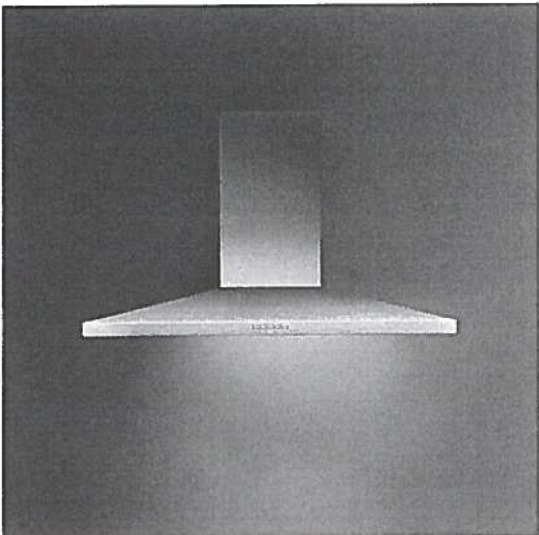

(/artcms/admin/upBoxImages/3238/1492233205.jpg)

DOWNLOADS

Instruction manual
wall
(.pdf - 2.71Mb)
(<https://falmec-catprod1.falmec.com/files/3738.pdf>)

Suite 608 Upgrade Hampton Package 3A




WFW85HEFC



<http://www.whirlpool.com>

4.5 cu. ft. Front Load Washer with TumbleFresh™ option

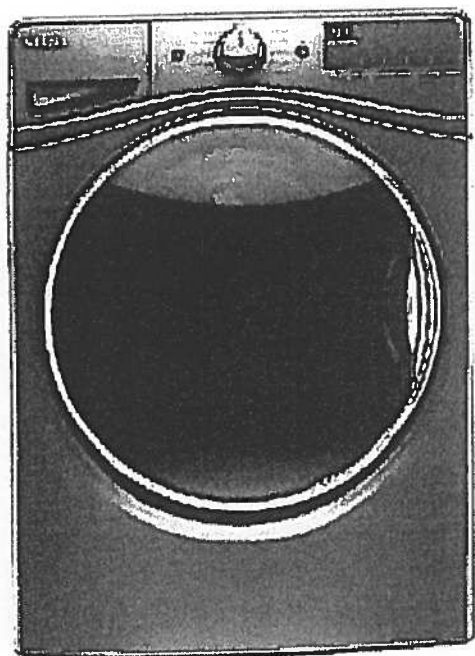

Key Features:

- TumbleFresh™ Option
- ColorLast™ Cycle
- Presoak Option
- EcoBoost™ Option
- Precision Dispense
- Steam Clean Option
- Adaptive Wash Technology
- Smooth Wave Stainless Steel Wash Basket
- 4.5 cu. ft. Capacity
- Undercounter Installation
- Add-A-Garment
- ENERGY STAR® Certified

Product Dimensions:

Height: 39 3/4

Width: 27

Depth: 33 5/16

Additional Information:

[Use And Care Guide](#)

[Dimension Guide](#)

[Installation Guide](#)

[Energy Guide](#)

[Warranty Certificate](#)

Available in:

- ☒ Chrome Shadow
☐ White

INVESTED
IN
AMERICA



©Registered trademark/TM Trademark of Whirlpool, U.S.A. © 2016 Whirlpool Corporation. All Rights Reserved.
All other trademarks are owned by their respective companies.
Because Whirlpool Corporation policy includes a continuous commitment to improve our products, we reserve the right to change materials and specifications without notice. We also reserve the right to discontinue or transition products without notice.
Manufacturer's Suggested Retail Price (MSRP) and Minimum Advertised Price (MAP) provided for reference purposes only. Dealer alone determines advertised and retail prices.
Created On: Wednesday December 14, 2016 18:12:43

Suite 608 Upgrade Hampton Package 3A




WED85HEFC

Whirlpool®

<http://www.whirlpool.com>

7.4 cu. ft. Electric Dryer with Quick Dry Cycle

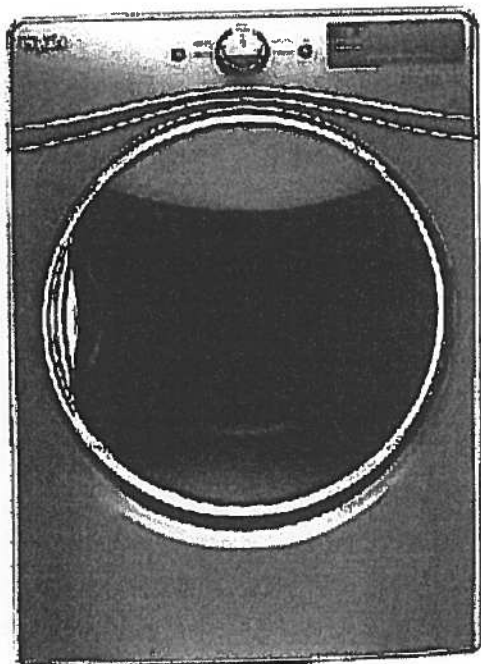

Key Features:

- Advanced Moisture Sensing System
- Tap Touch Controls with Memory
- EcoBoost™ Option
- Steam Refresh Cycle
- Wrinkle Shield™ Option
- Quad Baffles
- 7.4 Cu. Ft. Capacity
- Undercounter Installation
- ENERGY STAR® Qualified
- Sanitize Cycle
- Quick Dry Cycle

Product Dimensions:

Height: 39

Width: 27

Depth: 31

Additional Information:

[Use And Care Guide](#)

[Dimension Guide](#)

[Installation Guide](#)

[Warranty Certificate](#)

INVESTED
IN
AMERICA



©Registered trademark/TM Trademark of Whirlpool, U.S.A. © 2016 Whirlpool Corporation. All Rights Reserved.
All other trademarks are owned by their respective companies.
Because Whirlpool Corporation policy includes a continuous commitment to improve our products, we reserve the right to change materials and specifications without notice. We also reserve the right to discontinue or transition products without notice.
Manufacturer's Suggested Retail Price (MSRP) and Minimum Advertised Price (MAP) provided for reference purposes only. Dealer alone determines advertised and retail prices.
Created On: Thursday, March 23, 2017 17:33:37

Countertop Edges Suite 608 Hampton



CONNOLLY Marble & Granite Ltd.

**EDGE
DETAILS**

004


A.



STRAIGHT EDGE
(STANDARD - 3/4")


Standard:
Master Ensuite
Ensuite #2

I.

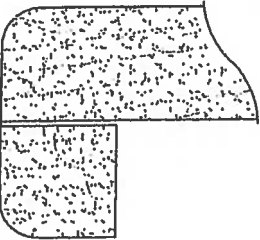

DOUBLE TOP "D" EDGE
(STANDARD - 1 1/2")

Upgrade:
Kitchen
Powder Room

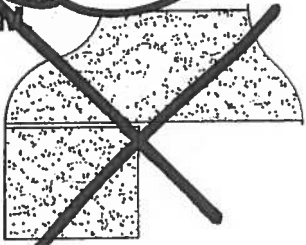

OGEE - SQUARE EDGE
(MED./HIGH - 1 1/2")

EDGING UP-GRADE OPTIONS