
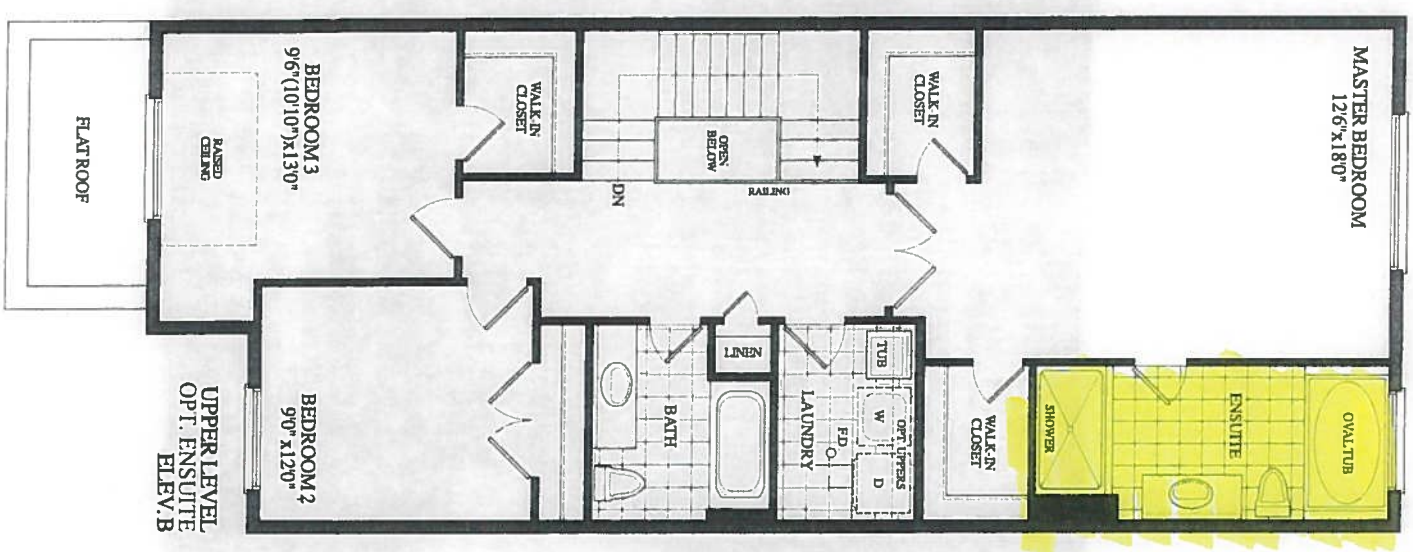
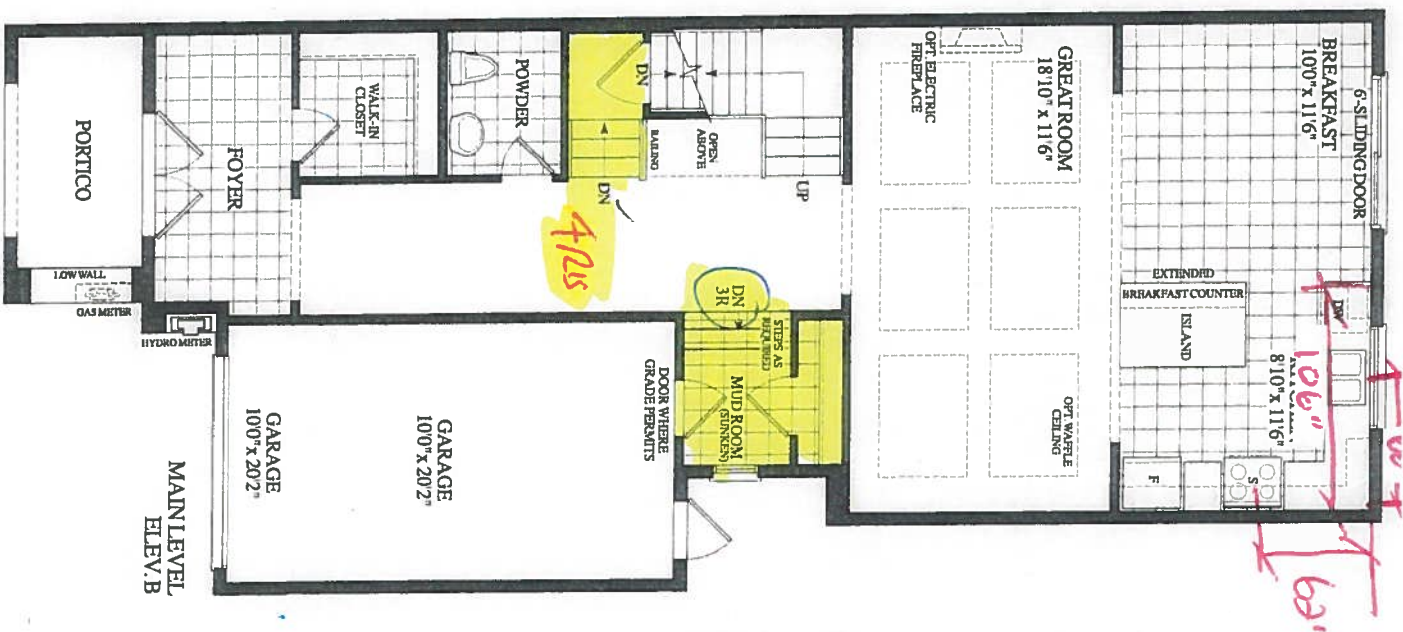


BLOCK 3 LOT 4 EL. B OPT BSUITE
MORNING GLORY
(22-01)

2020 SQ. FT.
(INCLUDES 12 SQ. FT. OF OPEN AREA)

Inventory suite

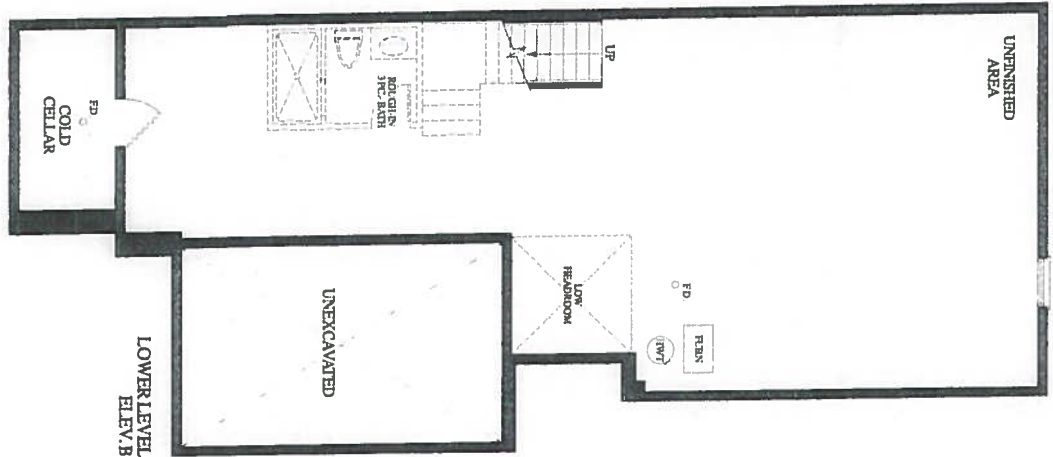

Dimensions, specifications, and materials shown are approximate only. They may vary at an additional charge. All provided information is subject to change without notice. Please refer to the actual drawings for details.

ROYALPINEHOMES.COM