


Original

2140 SQ. FT.
(INCLUDES 10 SQ. FT. OF OPEN AREA)

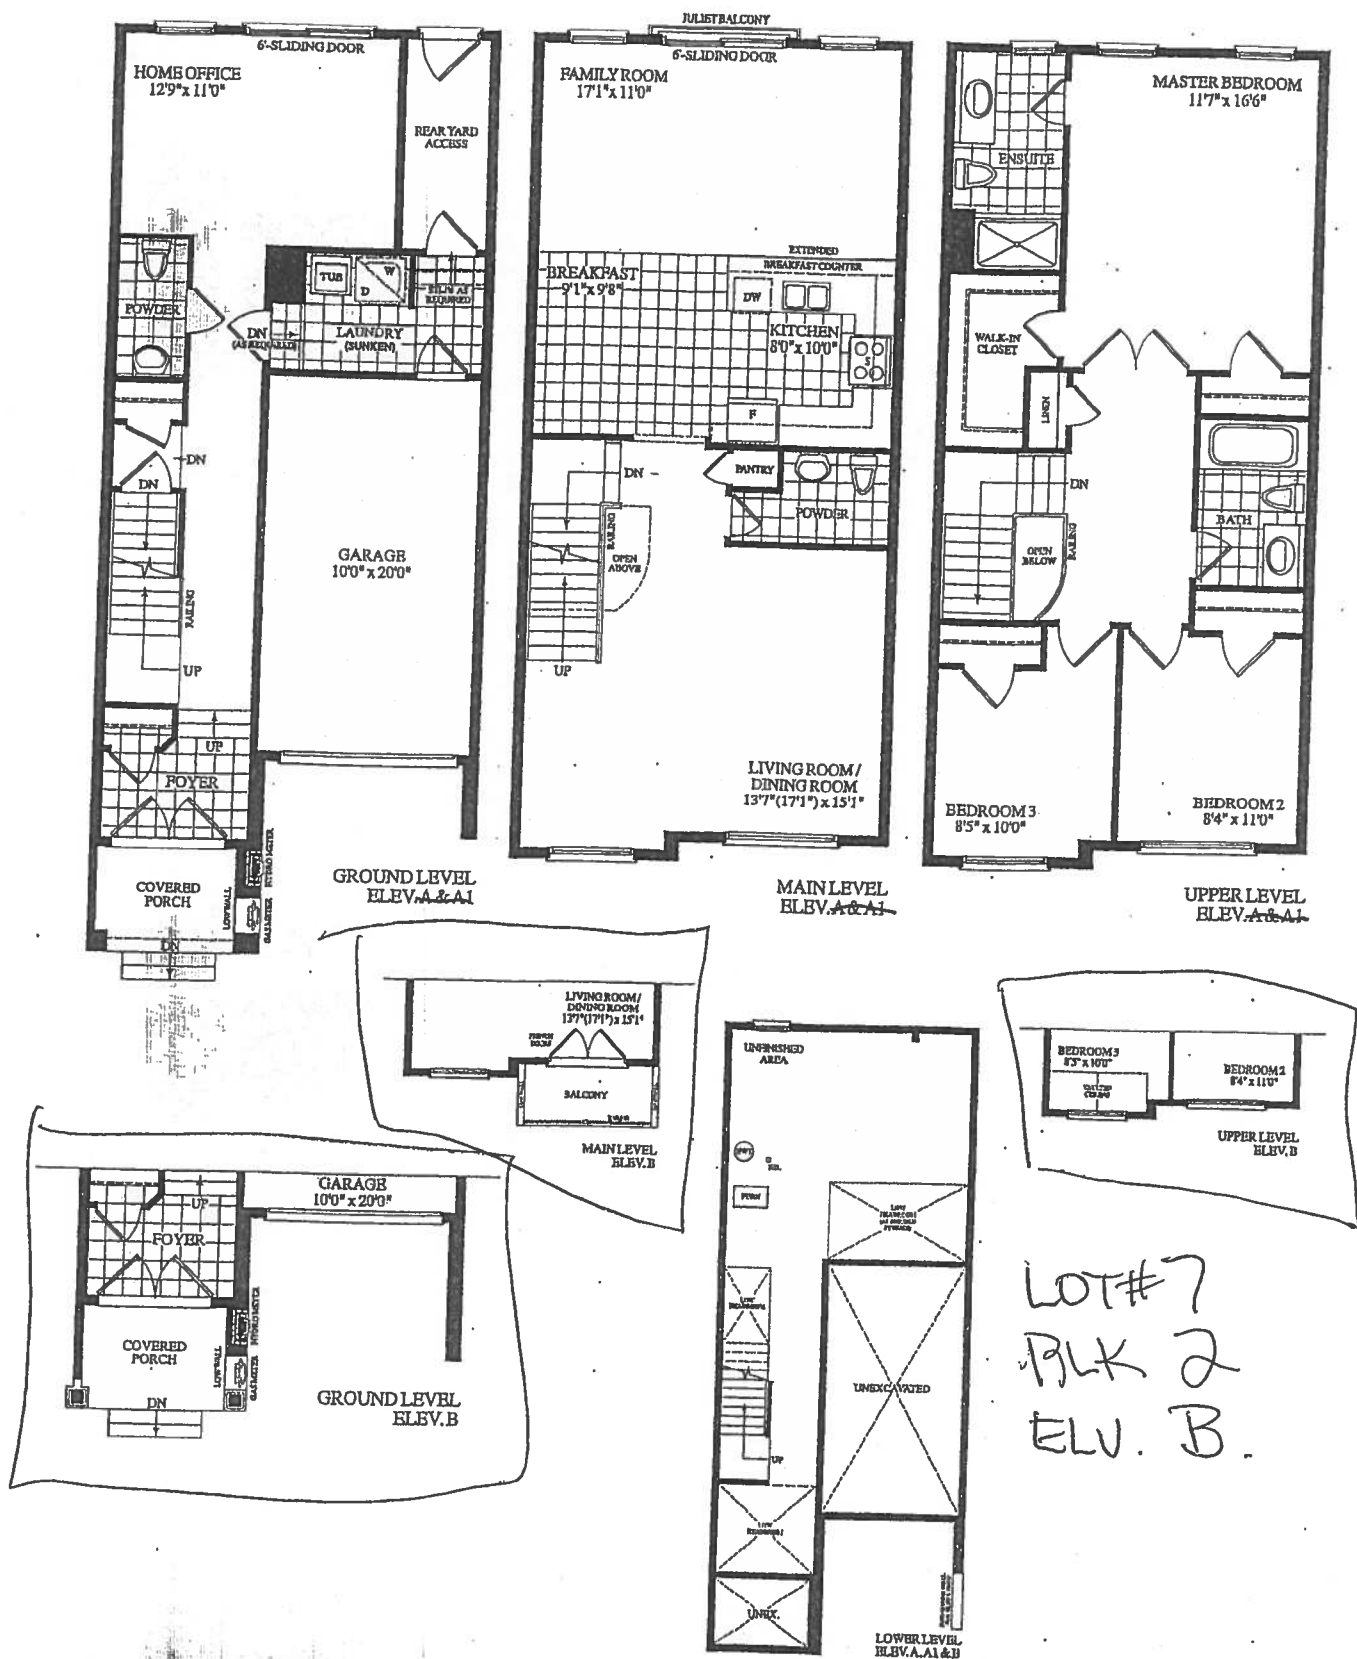

LOT#7
BLK 2
ELV. B.

A.L. S.L. 

Description - Vendor to Supply and Install the Following as Per Purchase Price

- BONUS PACKAGE -PURCHASER TO RECEIVE \$10,000 (INCLUSIVE OF TAXES) WORTH OF UPGRADES AT DECOR CENTRE AT TIME OF COLOUR CHART
- BONUS PACKAGE OF 5 APPLIANCES TO INCLUDE FRIDGE, STOVE, DISHWASHER, WASHER AND DRYER AS PER VENDORS SAMPLES
- CHOICE OF COLOUR (FROM VENDORS SAMPLES) FOR 7 1/2 INCH LAMINATE ENGINEERED FLOORING IN ALL AREAS NOT COVERED WITH CERAMIC TILES ON MAIN/GROUND LEVEL, INCLUDING STAIR LANDINGS AS PER PLAN

BLK. 2 LOT 7 EL.B





CHESTNUT

(18-03)

2140 SQ. FT.

(INCLUDES 10 SQ. FT. OF OPEN AREA)

STANDARD FLOOR LEVELS

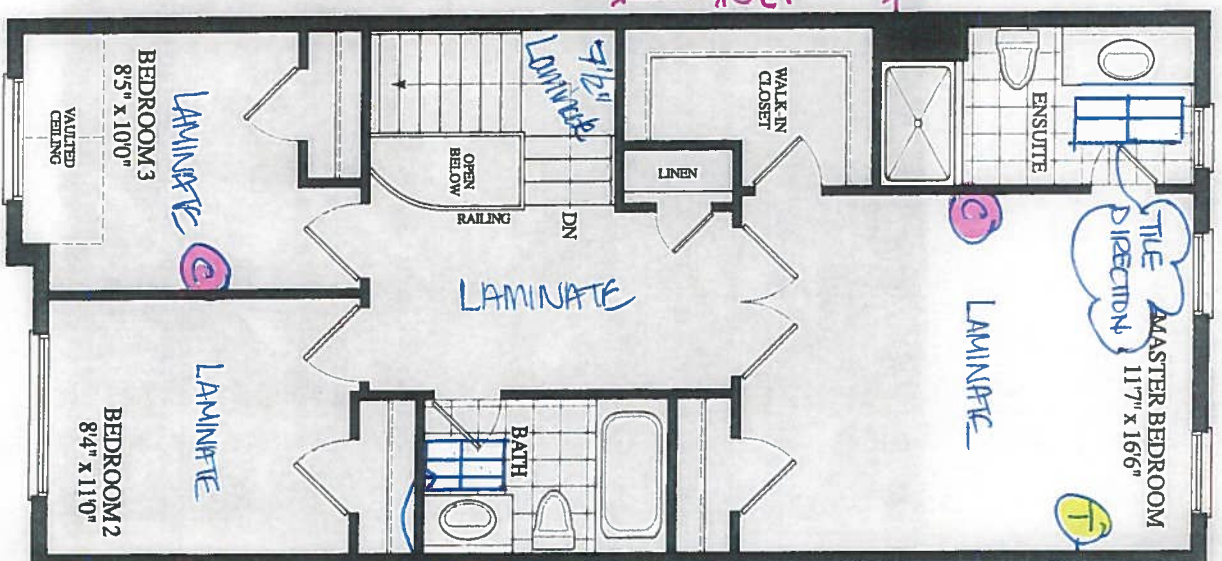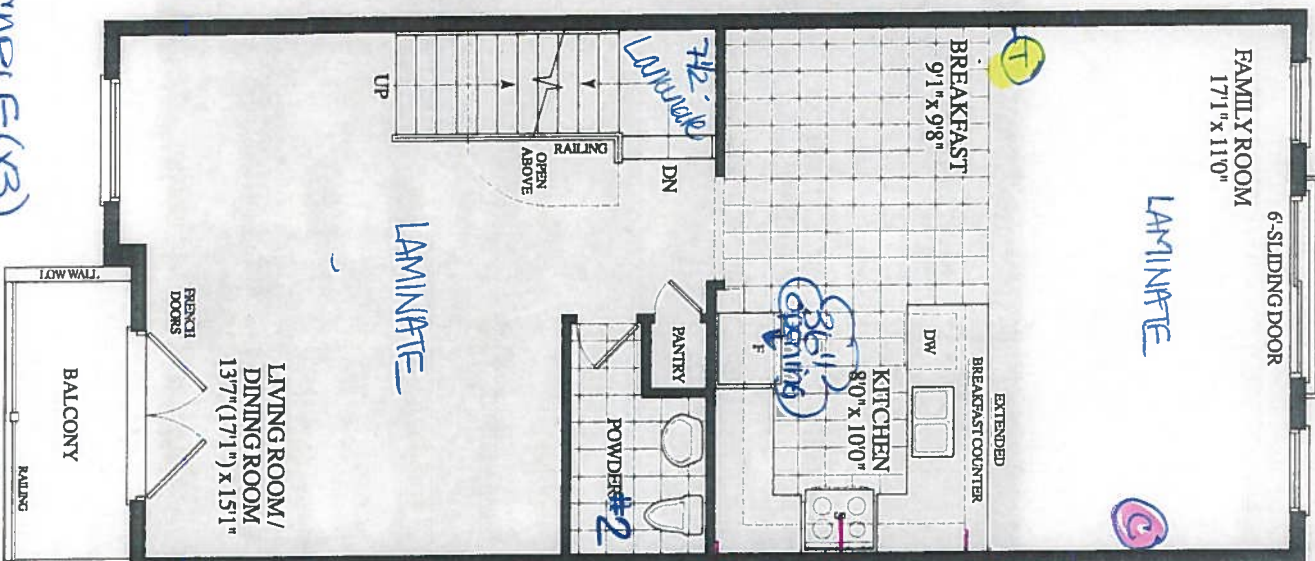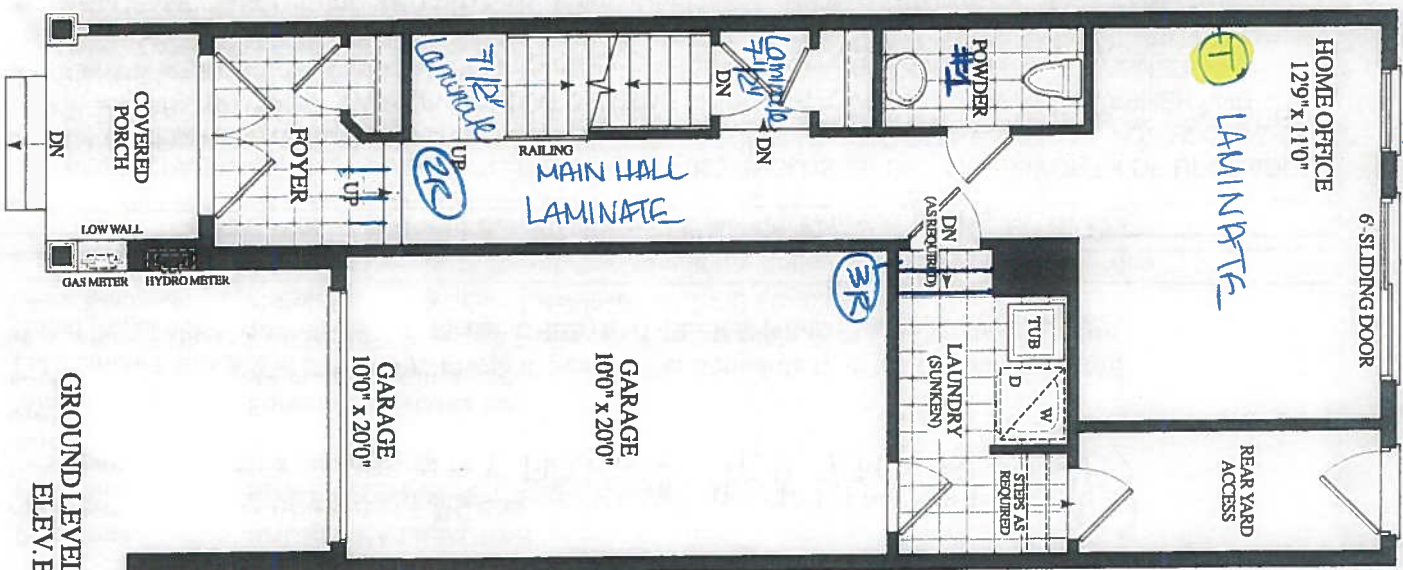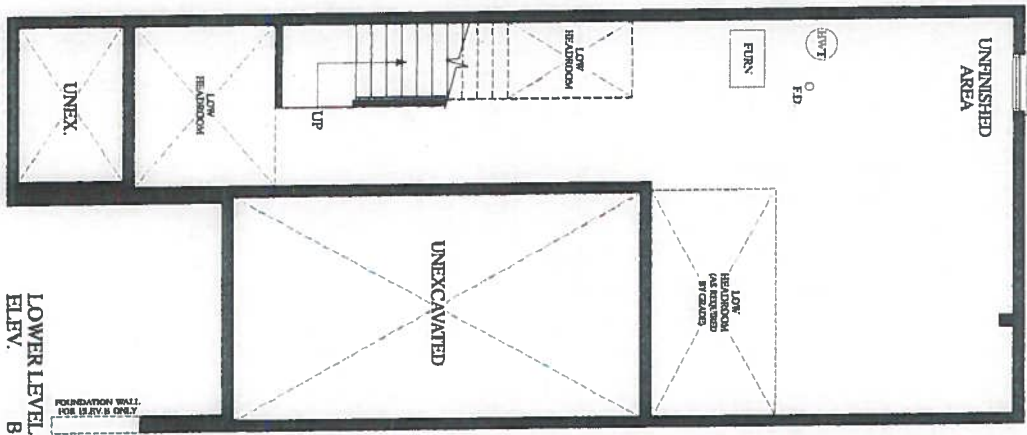



Window

SITE COPY

CONSTRUCTION SUMMARY

Forestside Estates Inc.

PURCHASERS: ANURADHA LILMOHAN and TAMESHWAR NAUTH LILMOHAN

TEL: RES.: 647-463-7453

LOT NUMBER	PHASE	HOUSE TYPE	CLOSING DATE	
7 Block 2	6	CHESTNUT-ELEV B	14-Feb-20	

Offer	BONUS PACKAGE -PURCHASER TO RECEIVE \$10,000 (INCLUSIVE OF TAXES) WORTH OF UPGRADES AT DECOR CENTRE AT TIME OF COLOUR CHART
Workshee	Note:

Offer	BONUS PACKAGE OF 5 APPLIANCES TO INCLUDE FRIDGE, STOVE, DISHWASHER, WASHER AND DRYER AS PER VENDORS SAMPLES
Workshee	Note:

Offer	CHOICE OF COLOUR (FROM VENDORS SAMPLES) FOR 7 1/2 INCH LAMINATE ENGINEERED FLOORING IN ALL AREAS NOT COVERED WITH CERAMIC TILES ON MAIN/GROUND LEVEL, INCLUDING STAIR LANDINGS AS PER PLAN.
Workshee	Note:



WINDOW

SITE COPY

CONSTRUCTION SUMMARY				
Forestside Estates Inc.				
PURCHASERS: ANURADHA LILMOHAN and TAMESHWAR NAUTH LILMOHAN			TEL: RES.: 647-463-7453	
LOT NUMBER	PHASE	HOUSE TYPE	CLOSING DATE	
7 Block 2	6	CHESTNUT-ELEV B	14-Feb-20	

Date Added: 06-Nov-19 Invoice Number: 7317

1 - SStandard Cable and Telephoen Rough in (See Sketch) Note:
1 - APPLIANCE PACKAGE- Install Standard Appliance Package To be installed throughout the home, where applicable Note:
1 - THERMOFOIL CABINET - The purchaser was advised and therefore accepts and acknowledges that by installing thermofoil cabinets in the kitchen, they may result in the cabinet peeling due to the vapor and moisture of the stove and dishwasher. Note:
1 - KITCHEN- Install the builders standard Top mount sink in the kitchen- Install the BLANCO HORIZON 2.0 (8") Top mount Sink- Model # 401124 Note:
1 - KITCHEN- Install the builders standard Faucet in the kitchen- Install the DELTA Chrome Down Kitchen Faucet (Single Hole) - Model # 976 LF Chrome Note:
1 - KITCHEN Accommodate the fridge opening for a future 36" wide fridge. Note: Purchaser accepts and acknowledges that the builders standard fridge will be 30" wide.
573 - UPPER LEVEL-Install the Torleys Forest Laminate 7 1/2" Acadian EE-F-9743-P, throughout the second (Upper Level), in lieu of the builders standard carpet. To be installed on the Upper Hall, Master Bedroom, Bedroom #2 and #3 Note:
2 - STAIRS- Stain the oak staircase to the Vintage Red Oak "Graphite" WITH IRON PICKETS , throughout TWO (X2) Flights of stairs- Ground Level to Main Level, Main Level to Upper Level Note:
1 - STAIRS-Install an Upgrade 1A Stairs package throughout applicable staircases (x2) Ground Level to Main level, Main level to Upper Level, to include: Handrail: CDR 3" Oak Pickets: Single Collar/ Alt Black Post: TYPE 900 3 1/2" Oak Note:
1 - STAIRCASE VS FLOORING WOOD SPECIES DIFFERENCE: STAIRCASE - The purchaser was advised and therefore accepts and acknowledges that the wood species of the staircase and flooring chosen do not match. This difference may result in a stain colour variance. Note: The purchaser agrees that the vendor is to be exempt from any and all claims by the purchaser regarding this colour variance.
1 - STAIRCASE VS FLOORING STAINING DIFFERENCE: STAIRCASE - The purchaser was advised and therefore accepts and acknowledges that the stain of the staircase and flooring chosen do not match. This difference might result in an undesirable colour variance Note: The purchaser agrees that the vendor is to be exempt from any and all claims by the purchaser regarding this colour variance.
52 - GROUND LEVEL FOYER- Install a 2nd Upgrade 20x20 floor tile, throughout the Ground Level foyer floor, in lieu of the builders standard Note:
32 - POWDER ROOM #1 (GROUND LEVEL)-Install a 2nd Upgrade 20x20 floor tile, throughout the Powder Room #1 floor, in lieu of the builders standard Note:
185 - KITCHEN/BREAKFAST- Install a 3rd Upgrade 24x24 porcelain floor tile, throughout the Kitchen/Breakfast area, in lieu of the builders standard Note:



WINDOWN
SITE COPY

CONSTRUCTION SUMMARY			
Forestside Estates Inc.			
PURCHASERS: ANURADHA LILMOHAN and TAMESHWAR NAUTH LILMOHAN			
TEL: RES.: 647-463-7453			

LOT NUMBER	PHASE	HOUSE TYPE	CLOSING DATE	
7 Block 2	6	CHESTNUT-ELEV B	14-Feb-20	

Date Added: 06-Nov-19 Invoice Number: 7317

40 - POWDER ROOM- Install a 3rd Upgrade 24x24 floor tile, throughout the Powder Room #2 floor, in lieu of the builders standard Note:
52 - MASTER ENSUITE- Install a 1st Upgrade 12x24 floor tile, throughout the Master Ensuite floor, in lieu of the builders standard. Installed Straight/Stacked Note: **PLEASE NOTE** Install the builders standard wall tile in teh shower stall
34 - MAIN BATH- Install a 1st Upgrade 12x24 floor tile, throughout the Maain Bath floor, in lieu of the builders standard. Installed Straight/Stacked Note: **PLEASE NOTE** Install the builders standard wall tile in the tub shower.
1 - CLARIFICATION- MASTER ENSUITE / MAIN BATH/POWDER ROOM#1 & POWDER ROOM #2- Install the builders standard Plumbing Fixtures throughout all bathrooms, where applicable. Note:
1 - CLARIFICATION- Do not install or supply or credit the purchaser with the builders standard bathroom accessories, throughout ALL bathrooms. Includes: Toilet paper holder, soap dishes and towel racks Note:
1 - PURCHASER HAS ATTENDED A STRUCTURAL AND COLOR APPOINTMENT AT THE DECOR CENTRE AND HAS DECLINED ANY ADDITIONAL UPGRADES. Note:
1 - PURCHASER AWARE AND ACCEPTS THAT ANY CHANGES MADE TO UPGRADES AFTER SIGNING THIS PURCHASERS EXTRA FORM ARE SUBJECT TO A MINIMUM ADMINISTRATION FEE OF \$1,000. PLUS A 10% HOLDBACK FEE. Note:

This Document is Extremely Time Sensitive - Printed 21 Nov 19 at 10:40



INTERIOR COLOUR SCHEME *

Purchasers
ANURADHA LILMOHAN & TAMESHWAR NAUTH LILMOHAN

Decor Consultant
Laura Di Pepe

Model and Elevation
CHESTNUT-ELEV B

Telephone Res. / Bus
(647) 463-7453 /

Project
Forestside Estates Inc.

Closing Date
14/02/2020

Property
7 Block 2

Page 1 of 3

	Flooring	Wall Tile	Accent/Insert	Border / Listello	Pattern	Plumbing
Master Ensuite	✓ Description 12X24 Cementite Bianco-Straight/Stacked (Upgd) ✓	Main 8X10 CARRARA MATT (STD)	N/A	N/A	N/A	WHITE
Main Bathroom	✓ 12X24 Cementite Bianco-Stright/Stacked (Upgd) ✓	8X10 CARRARA MATT (STD)	N/A	N/A	N/A	WHITE
Powder Room #1	✓ 20X20 CALCATTA GRIS (UPGD)	N/A	N/A	N/A	N/A	WHITE
Powder Room #2	✓ 24X24 STATUARIO VENATO (UPGD)	N/A	N/A	N/A	N/A	WHITE
Kitchen/Breakfast	✓ 24X24 STATUARIO VENATO (UPGD)	3X6 Subway White Stacked (STD)	N/A	N/A	N/A	WHITE
Laundry(Grnd Level)	✓ 13X13 SEAL GREY (STD)	N/A				STD
Foyer	✓ 20X20 CALCATTA GRIS (UPGD)					STD
Main Hall	✓ Torleys Forest 7 1/2" Acadian EE-F-9743-P (STD)	Railings and Stairs				
Family Room	✓ Torleys Forest 7 1/2" Acadian EE-F-9743-P (STD)	Railings	✓ Vintage Oak Graphite CDR 3" (UPGD)	Landing - Upper	✓ Forest Acadian EE-F-9743-P (STD) (X2)	NO
Living Room	✓ Torleys Forest 7 1/2" Acadian EE-F-9743-P (STD)	Pickets	✓ Single Collar / Alt Plain Black (UPGD)	Landing - Lower	✓ Forest Acadian EE-F-9743-P (STD)	NO
Dining Room	✓ Torleys Forest 7 1/2" Acadian EE-F-9743-P (STD)	Posts	✓ Vintage Oak Graphite TYPE 900 3 1/2" (Upgd)	Ledge - Upper	N/A	NO
Home Office	✓ Torleys Forest 7 1/2" Acadian EE-F-9743-P (STD)	Stringers	✓ Vintage Oak Graphite	Ledge - Lower	N/A	NO
Upper Hall	✓ Torleys Forest 7 1/2" Acadian EE-F-9743-P (Upgd)	Treads	✓ Vintage Oak Graphite			NO
Master Bedroom	✓ Torleys Forest 7 1/2" Acadian EE-F-9743-P (Upgd)	Risers	✓ Vintage Oak Graphite			NO
Bedroom 2	✓ Torleys Forest 7 1/2" Acadian EE-F-9743-P (Upgd)	Runner	NO			NO
Bedroom 3	✓ Torleys Forest 7 1/2" Acadian EE-F-9743-P (Upgd)	Trim				
Rear Yard Access	✓ STANDARD	Baseboard & Casing	STANDARD	Knobs	✓ PEWTER STRAIGHT LEVER	
		Front Door Glass	STANDARD	Hinges	✓ STANDARD	
		Interior Doors	STANDARD	Grip Set	STANDARD	
		Notes				

Page 1 of 3

Consultant:

Laura Di Pepe

Purchaser:

ANURADHA LILMOHAN

Purchaser:

TAMESHWAR NAUTH LILMOHAN

Vendor:

Forestside Estates Inc.



* INTERIOR COLOUR SCHEME *

Purchasers
ANURADHA LILMOHAN & TAMESHWAR NAUTH LILMOHAN

Decor Consultant
Laura Di Pede

Model and Elevation
CHESTNUT-ELEV B

Telephone Res. / Bus
(647) 463-7453 /

Project
Forestside Estates Inc.

Closing Date
14/02/2020

Property
7 Block 2

Page 2 of 3

Interior Paint

Description

Cabinet

Style

Countertop

Counter Edge

Handle / Knob

COOL WHITE

EURO MELAMINE WF-392 LICORICE (STD)

P-394CA ARCTIC SNOW (STD)

N/A

4443-140

COOL WHITE

EURO MELAMINE WF-392 LICORICE (STD)

P-394CA ARCTIC SNOW (STD)

N/A

4443-140

COOL WHITE

N/A

N/A

N/A

N/A

COOL WHITE

N/A

N/A

N/A

N/A

COOL WHITE

NY THERMOFOIL WHITE (STD)

P-394CA ARCTIC SNOW (STD)

N/A

65017-195

COOL WHITE

N/A

N/A

N/A

N/A

COOL WHITE

N/A

N/A

N/A

N/A

COOL WHITE

N/A

N/A

N/A

N/A

COOL WHITE

N/A

N/A

N/A

N/A

COOL WHITE

SEE NOTES

N/A

N/A

N/A

COOL WHITE

None

N/A

N/A

N/A

COOL WHITE

Std 30in

N/A

N/A

N/A

Dishwasher Cabinet

N/A

N/A

N/A

COOL WHITE

Fireplace

N/A

N/A

N/A

COOL WHITE

Fireplace

N/A

N/A

N/A

Location Flooring

N/A

N/A

N/A

COOL WHITE

Style

N/A

N/A

N/A

Finish

N/A

N/A

N/A

COOL WHITE

Marble

N/A

N/A

N/A

Hearth

N/A

N/A

N/A

COOL WHITE

Fireplace

N/A

N/A

N/A

Notes

**APPLIANCE PACKAGE- Install Standard Appliance Package To be installed throughout the home

**WHITE EXHAUST FAN IN KITCHEN

* 36" Fridge Opening for Future Fridge

44 51

Page 2 of 3

Decor Consultant:

Purchaser:

Purchaser:

Vendor:

Laura Di Pede

ANURADHA LILMOHAN

TAMESHWAR NAUTH LILMOHAN



KITCHENS & FINE CABINETRY LTD
8111 Jane St. Unit 10
Concord, Ontario L4K 4L7
Tel. (905) 669-7028
Fax. (905) 669-7903
email: designstudio@villakitchens.ca
www.villakitchens.ca


CLIENT: ROYAL PINE HOMES
PROJECT: FORESTSIDE
ADDRESS: RP-FS(6)-07 BLK 02
MODEL: CHESTNUT 1803 ELEV. AA1/B

KITCHEN

Oct 31, 2019
6077 Block 2.



EXTRAS:
1. LARGER OPENING FOR 36" FRIDGE

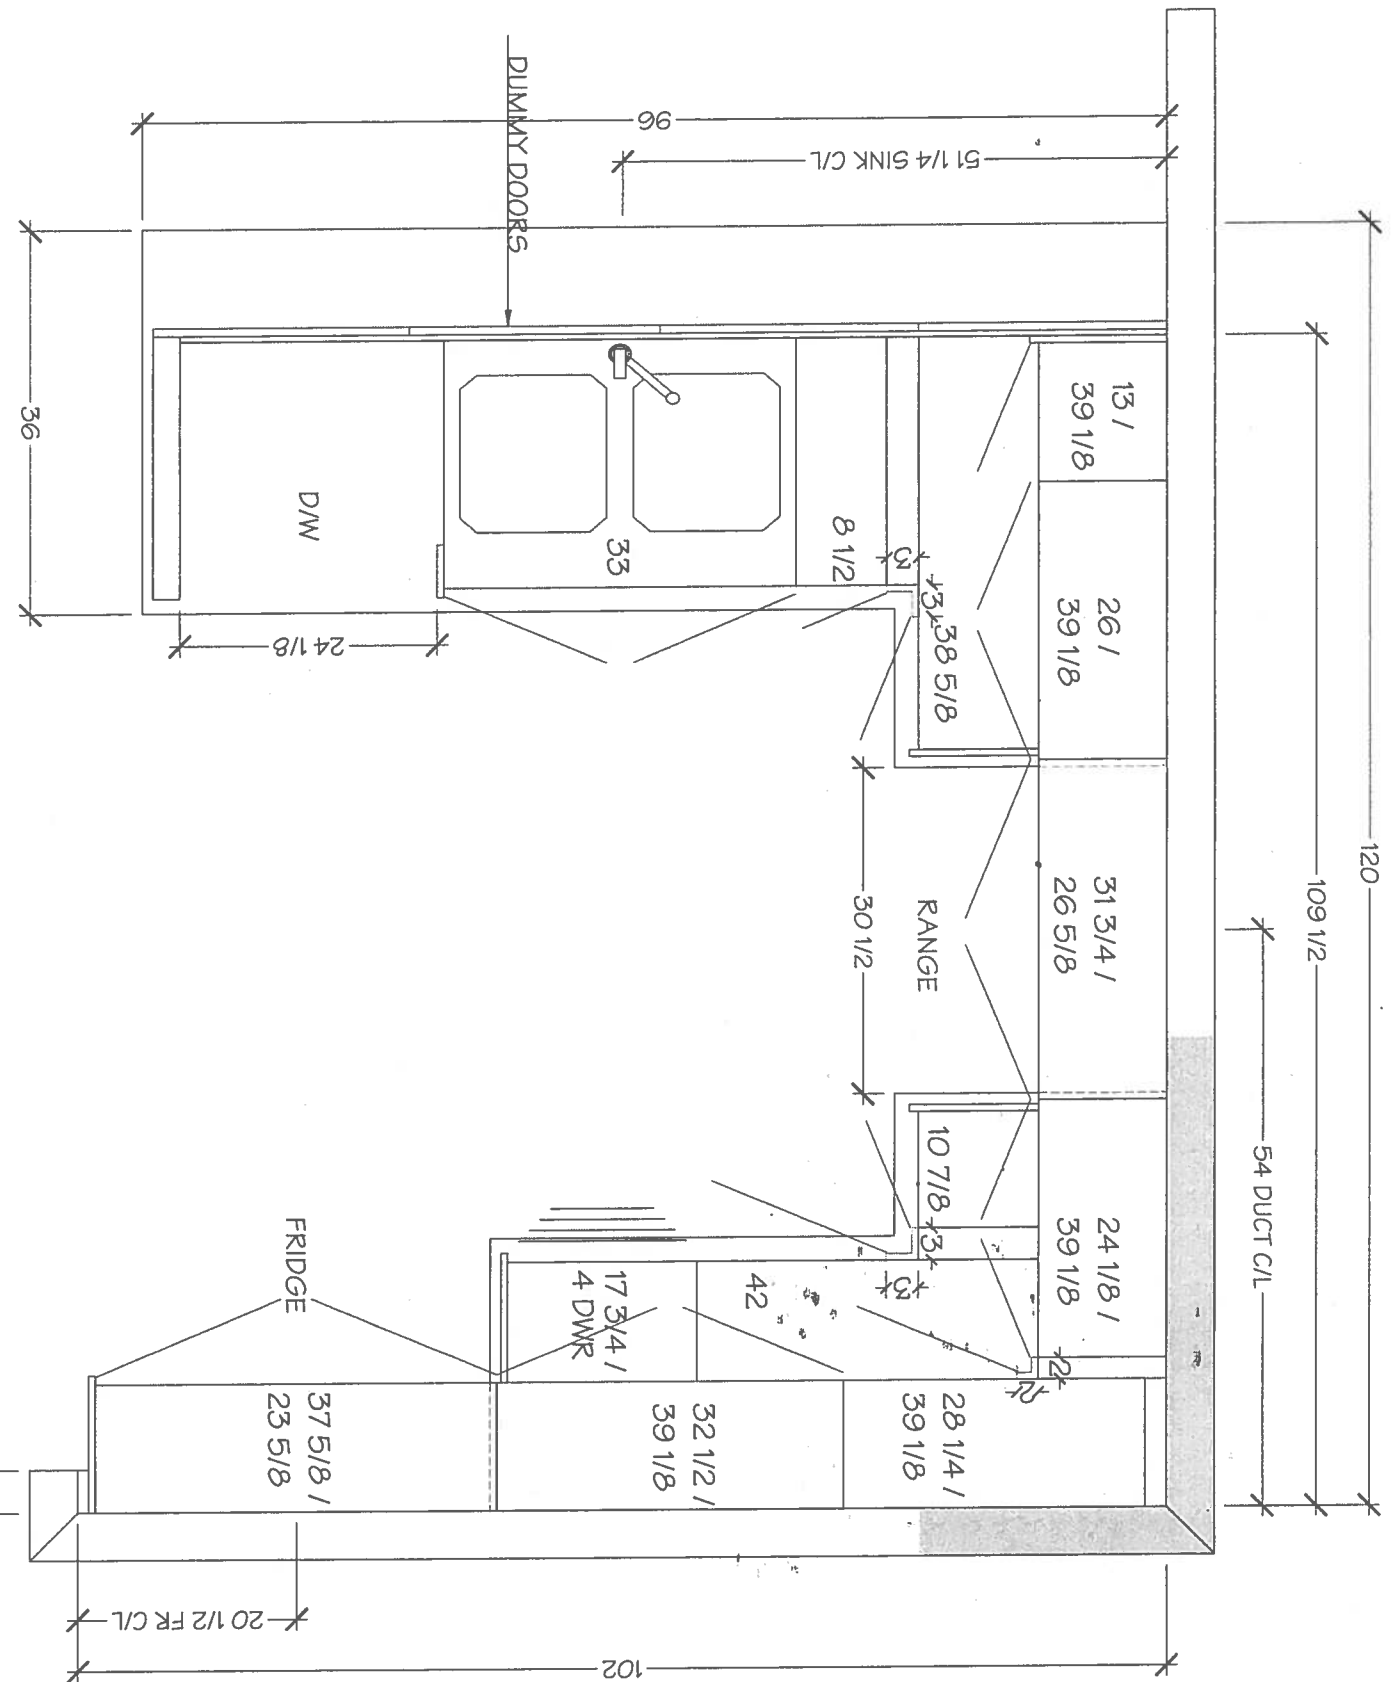

DRAWN BY: DIDI

DATE: OCTOBER 30/2019

REVISION:

PAGE: 1 OF 6



KITCHENS & FINE CABINETRY LTD

8111 Jane St. Unit 10
Concord, Ontario L4K 4L7
Tel. (905) 669-7028
Fax. (905) 669-7903
email: designstudio@villakitchens.ca
www.villakitchens.ca

CLIENT: ROYAL PINE HOMES
PROJECT: FORESTSIDE
ADDRESS: RP-FS(6)-07 BLK 02
MODEL: CHESTNUT 1803 ELEV. AA1/B

KITCHEN

Oct 31, 2019

lot 7 Block 2




EXTRAS:

1. LARGER OPENING FOR 36" FRIDGE

DRAWN BY: DIDI
DATE: OCTOBER 30/2019

REVISION:

PAGE: 2 OF 6

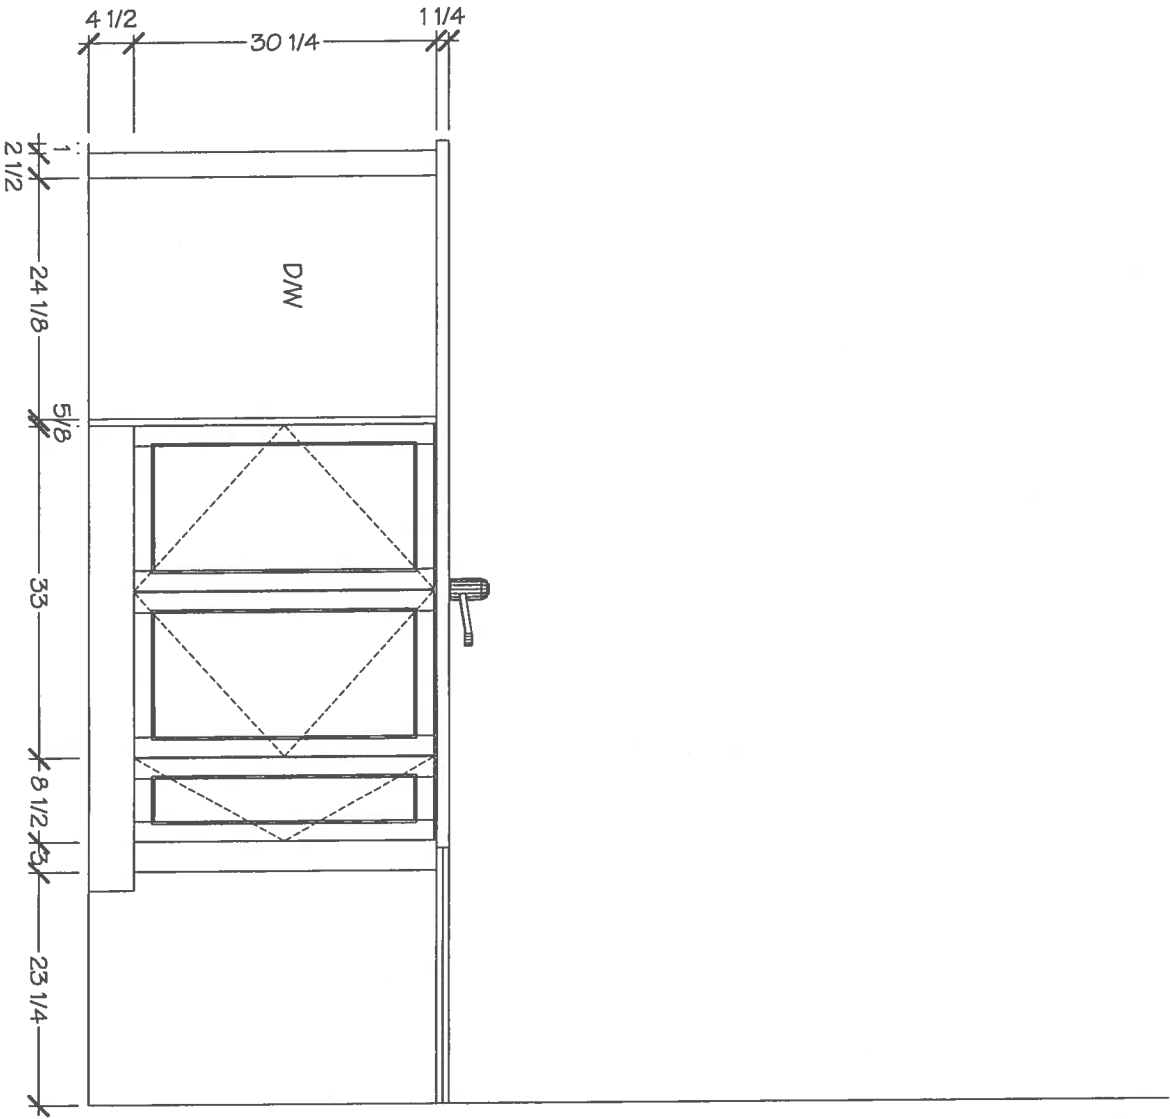

Vila

KITCHENS & FINE CABINETRY LTD

8111 Jane St. Unit 10
Concord, Ontario L4K 4L7
Tel. (905) 669-7028
Fax. (905) 669-7903
email: designstudio@vilkitchens.ca
www.vilkitchens.ca

CLIENT: ROYAL PINE HOMES

PROJECT: FORESTSIDE

ADDRESS: RP-FS(6)-07 BLK 02

MODEL: CHESTNUT 1803 ELEV. AA1/B

KITCHEN

Oct 31, 2019

lot 7 Block 2




EXTRAS:
1. LARGER OPENING FOR 36" FRIDGE

DRAWN BY: DIDI

DATE: OCTOBER 30/2019

REVISION:

PAGE: 3 OF 6

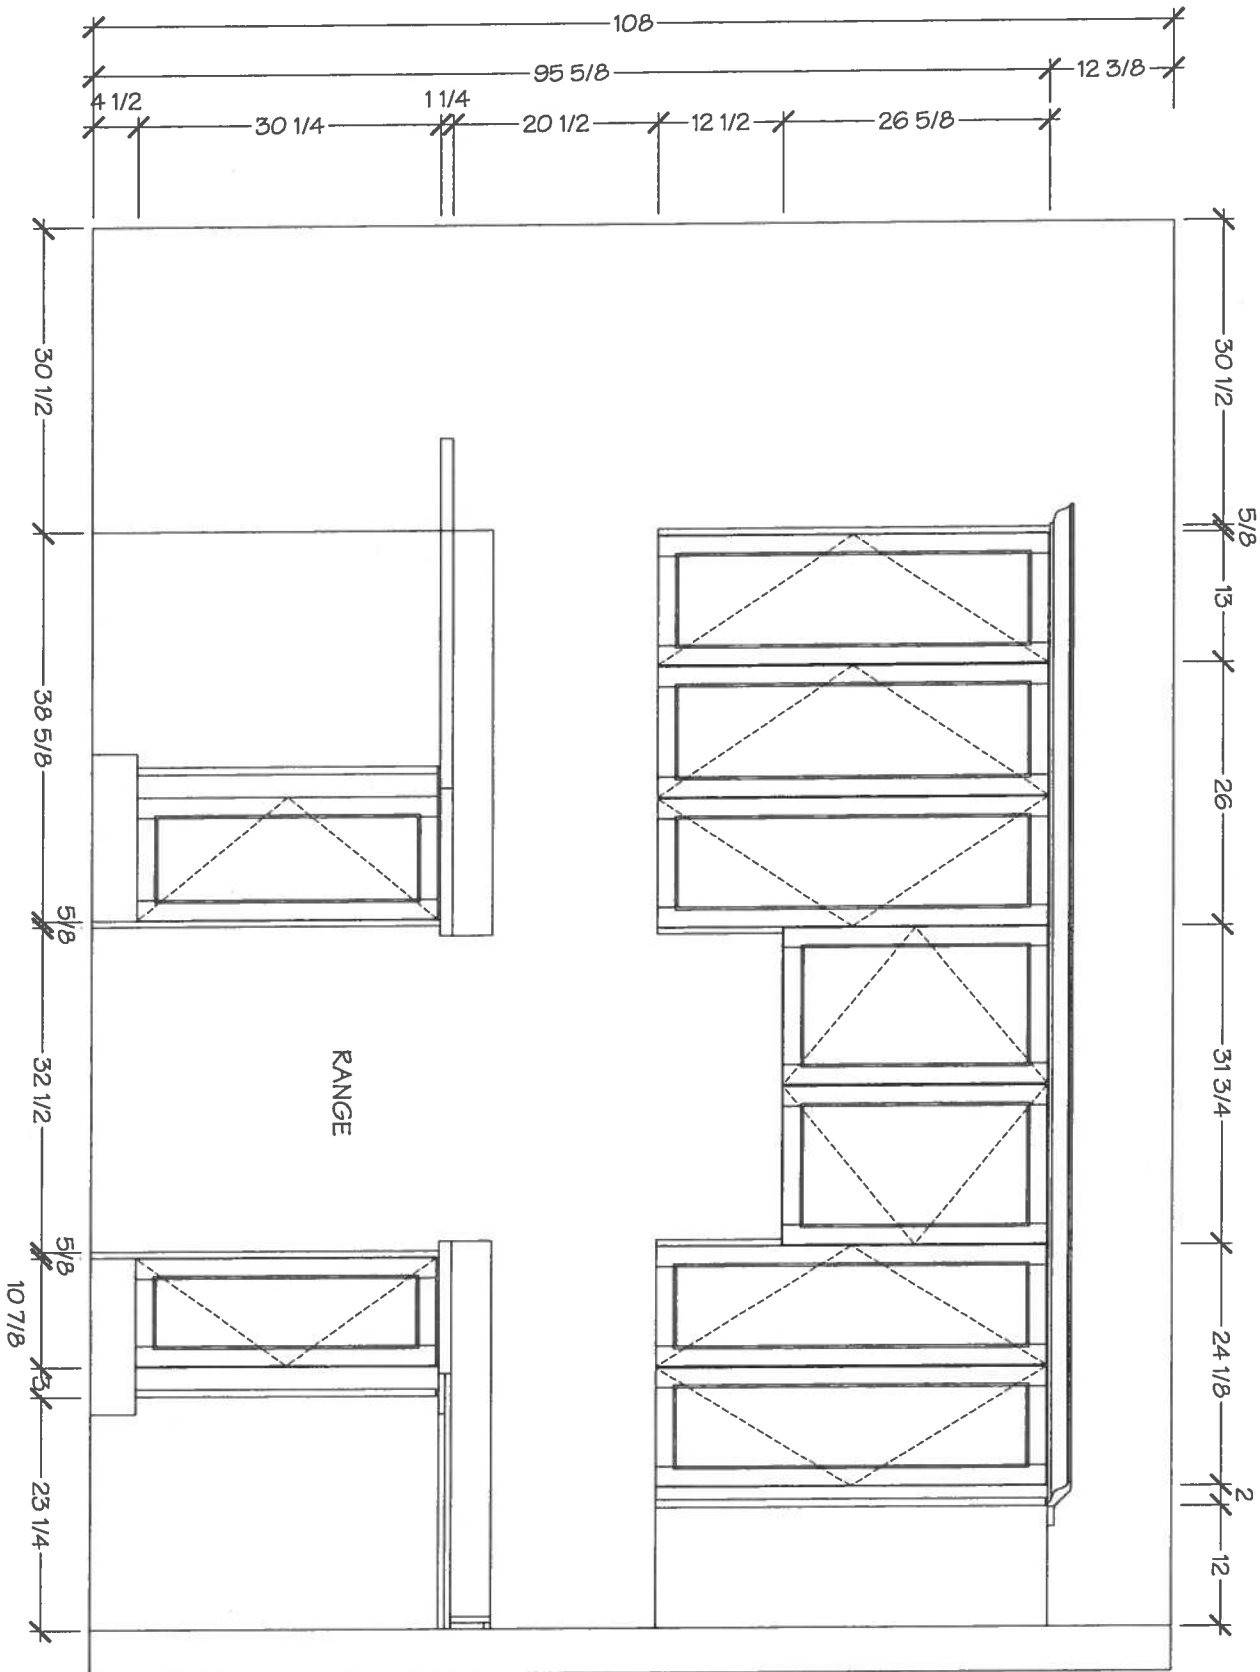

Villa
KITCHENS & FINE CABINETRY LTD

8111 Jane St. Unit 10
Concord, Ontario L4K 4L7
Tel. (905) 669-7028
Fax. (905) 669-7903
email: designstudio@villakitchens.ca
www.villakitchens.ca


CLIENT: ROYAL PINE HOMES
PROJECT: FORESTSIDE
ADDRESS: RP-FS(6)-07 BLK 02
MODEL: CHESTNUT 1803 ELEV. AA1/B

KITCHEN

Oct 31, 2019
Lot 7 Block 2
○○○

EXTRAS:
1. LARGER OPENING FOR 36" FRIDGE

DRAWN BY: DIDI
DATE: OCTOBER 30/2019
REVISION:

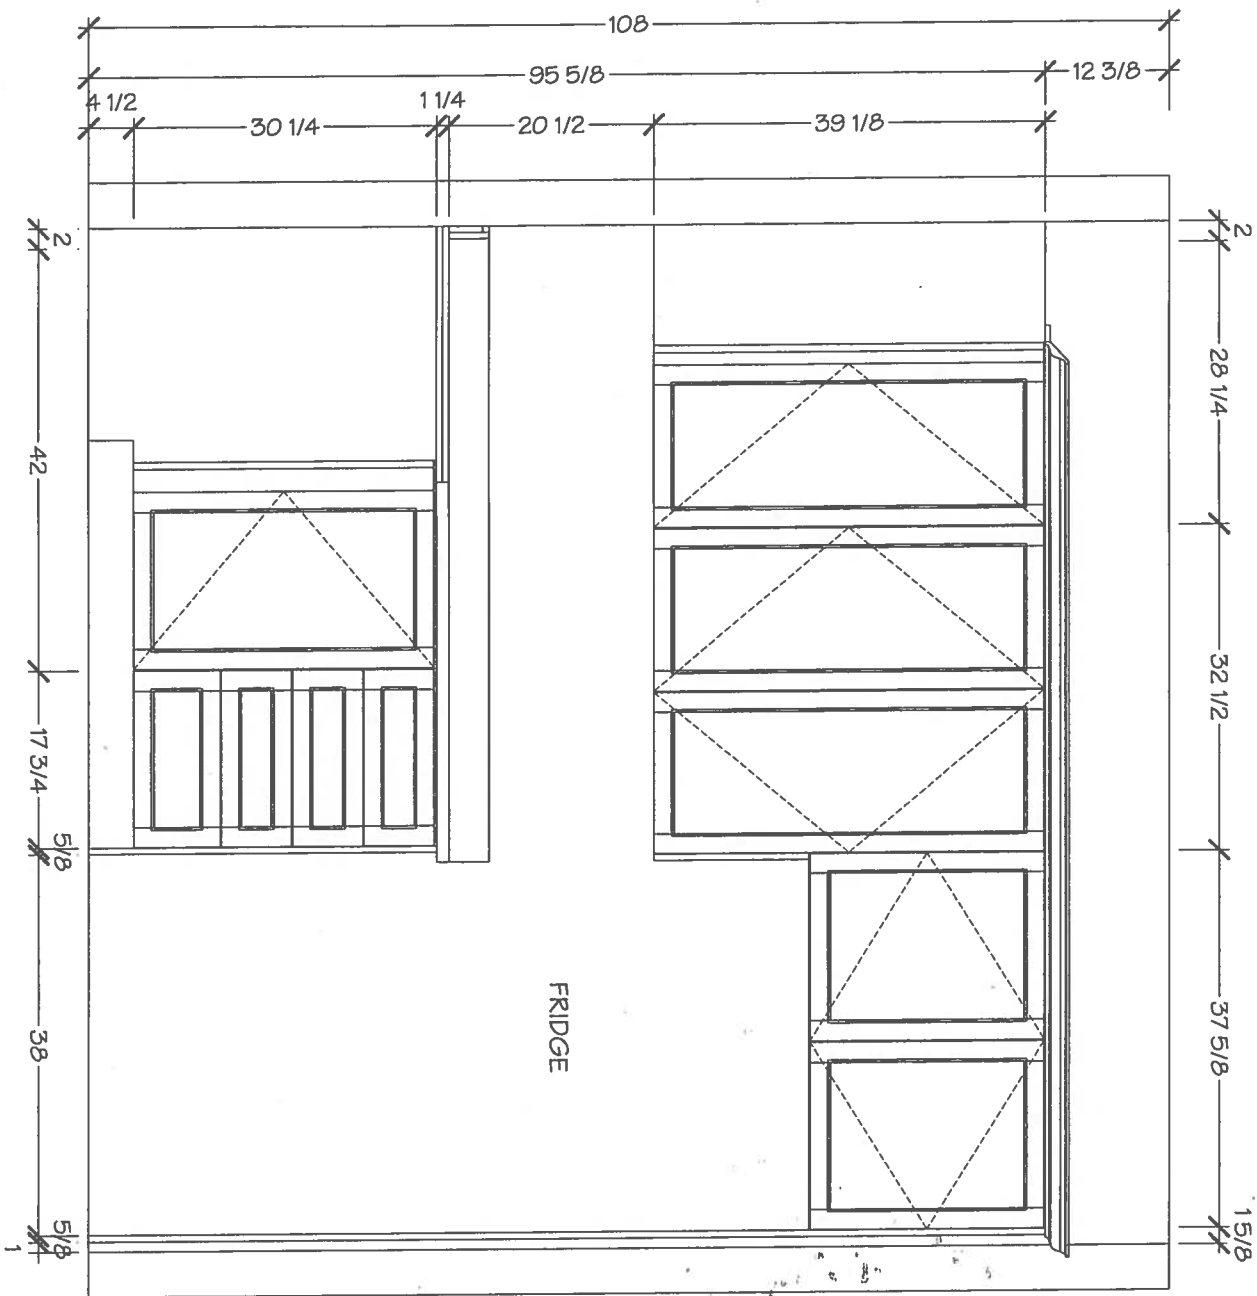





KITCHENS & FINE CABINETRY LTD
8111 Jane St. Unit 10
Concord, Ontario L4K 4L7
Tel. (905) 669-7028
Fax. (905) 669-7903
email: designstudio@vilakitchens.ca
www.vilakitchens.ca

CLIENT: ROYAL PINE HOMES
PROJECT: FORESTSIDE
ADDRESS: RP-FS(6)-07 BLK 02
MODEL: CHESTNUT 1803 ELEV. A/A1/B

MASTER ENSUITE

Oct 31, 2019
Lot 7 Block 2

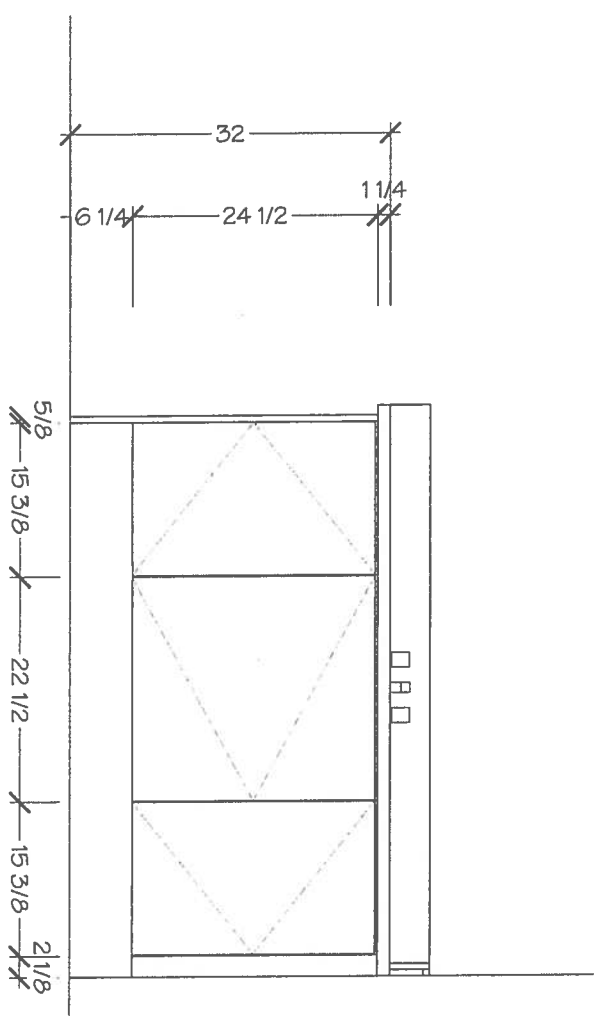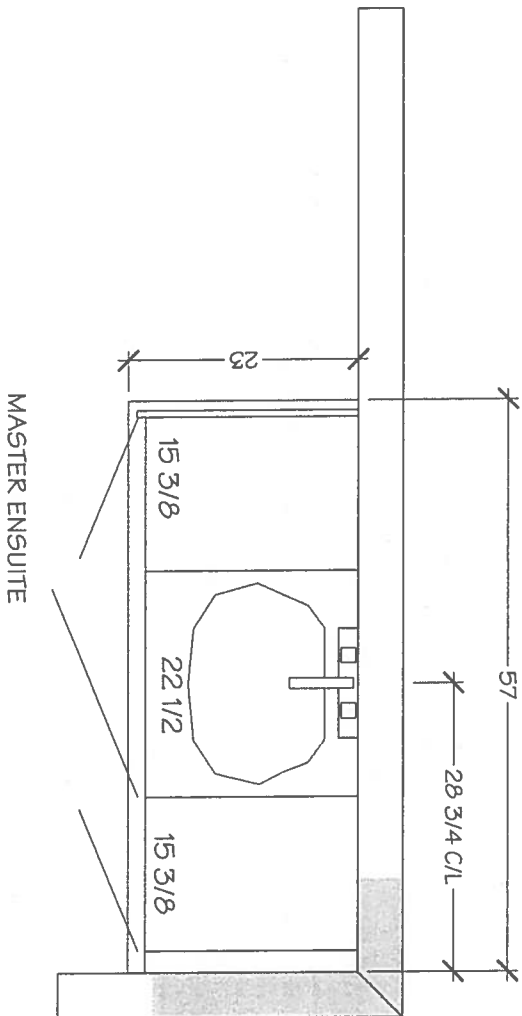

DRAWN BY: DIDI
DATE: OCTOBER 30/2019

REVISION:

PAGE: 5 OF 6




KITCHENS & FINE CABINETRY LTD


8111 Jane St. Unit 10
Concord, Ontario L4K 4L7
Tel. (905) 669-7028
Fax. (905) 669-7903
email: designstudio@villakitchens.ca
www.villakitchens.ca

CLIENT: ROYAL PINE HOMES
PROJECT: FORESTSIDE
ADDRESS: RP-FS(6)-07 BLK 02
MODEL: CHESTNUT 1803 ELEV. AA1/B

MAIN BATH

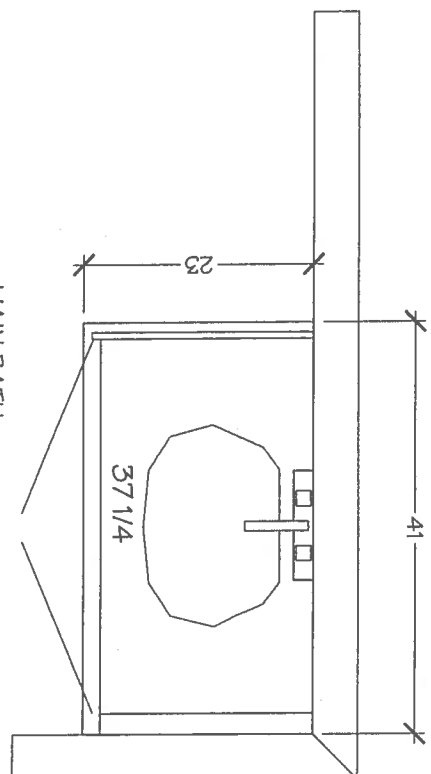

Oct 31, 2019
lot 7 Block 2

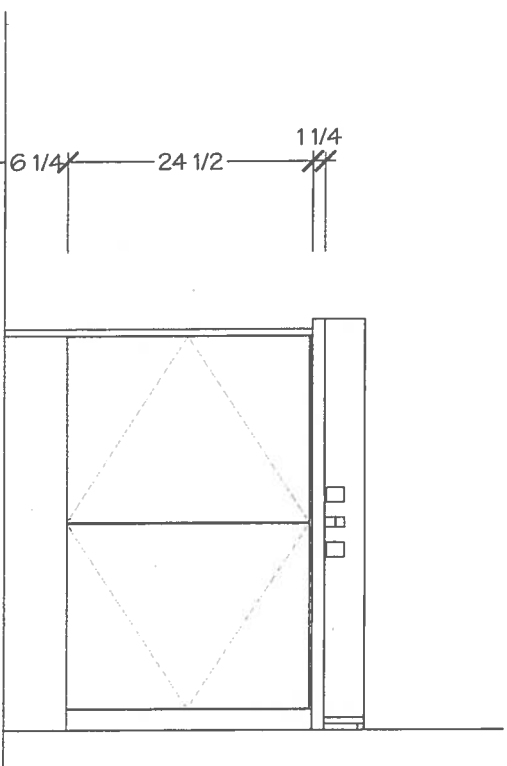

DRAWN BY: DIDI

DATE: OCTOBER 30/2019

REVISION:

PAGE: 6 OF 6