








Original

16 TOWNHOMES

AZALEA

(18-02)

2035 SQ. FT.

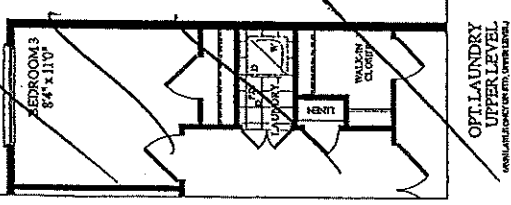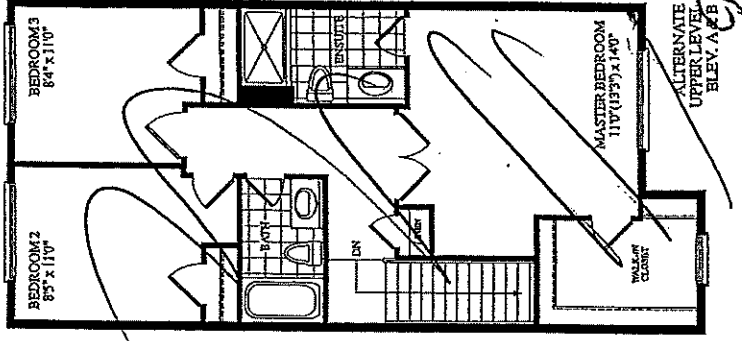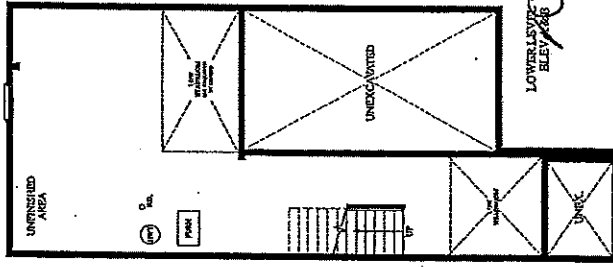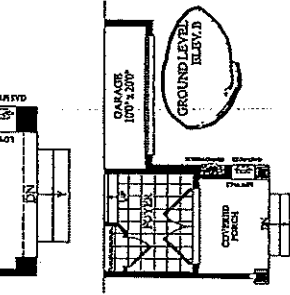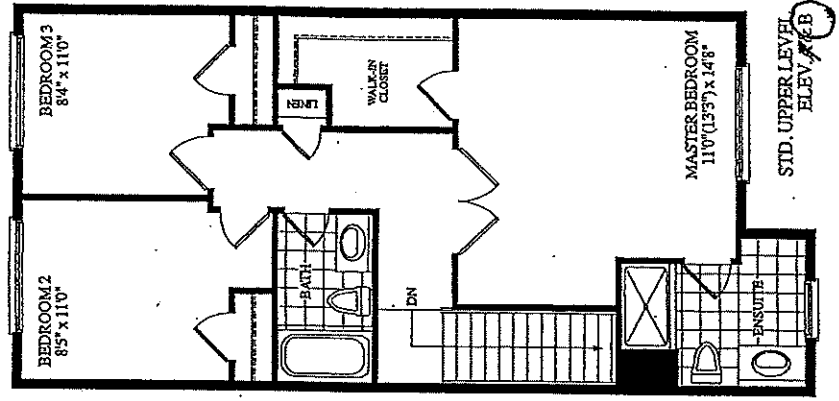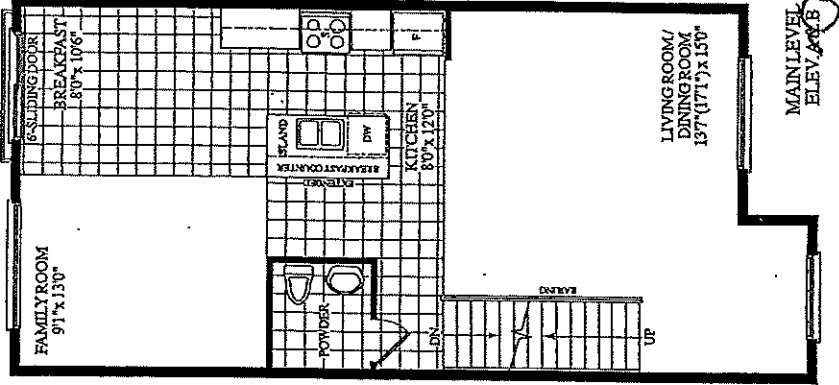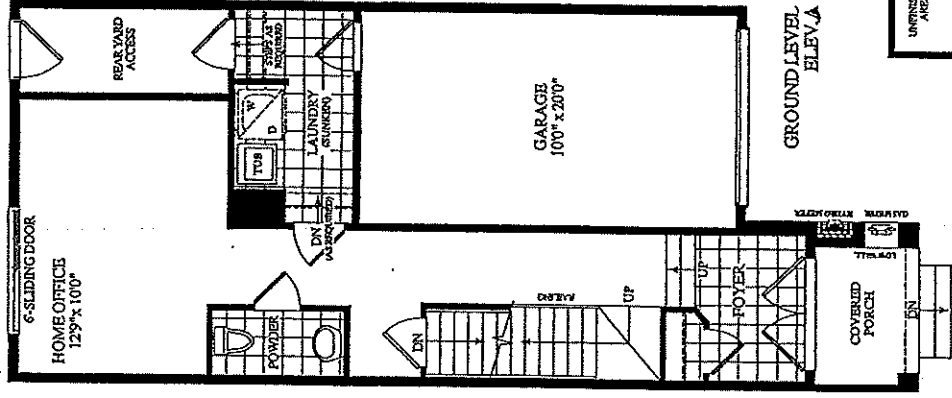

The name of
claireville

ROYAL PINE

ROYALPINEHOMES.COM

18' TOWNHOMES

BLK. 7 LOT43 EL.B





AZALEA

(18-02)

2035 SQ. FT.

STANDARD FLOOR LEVELS

CONSTRUCTION LAYOUT

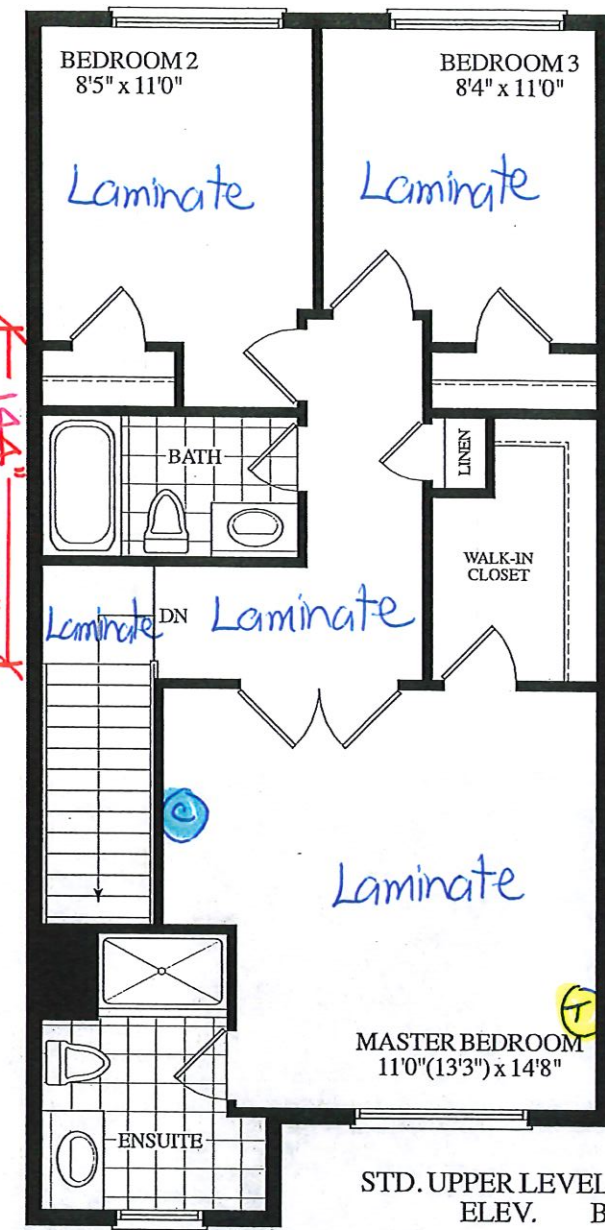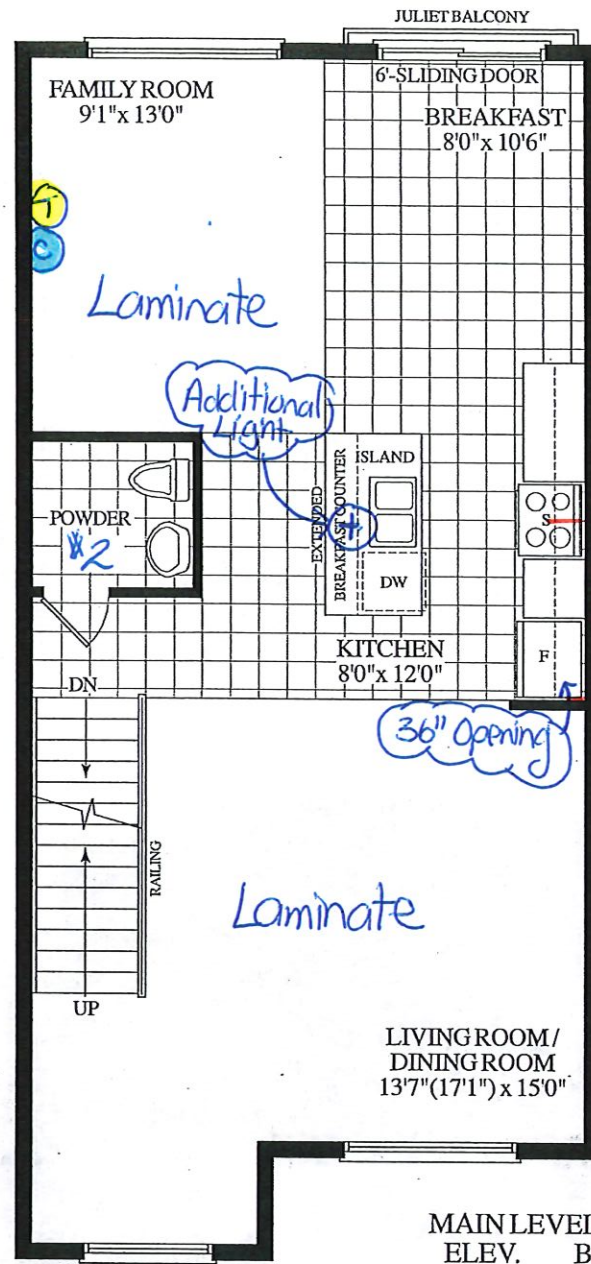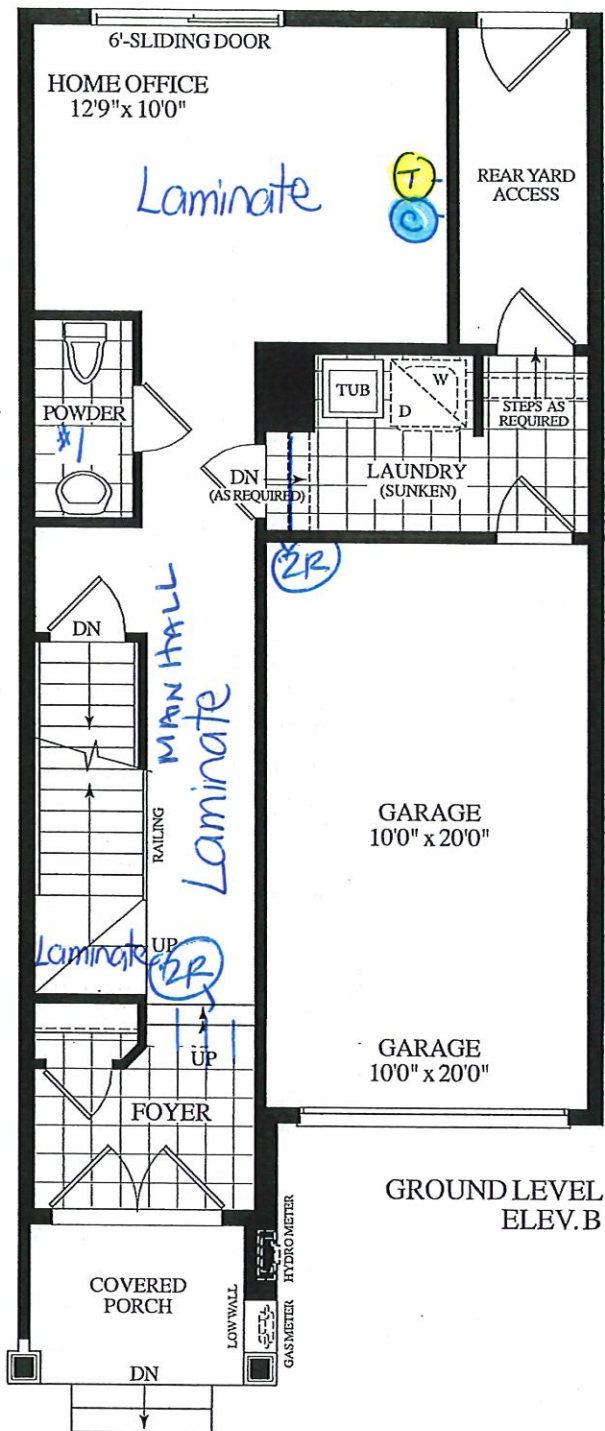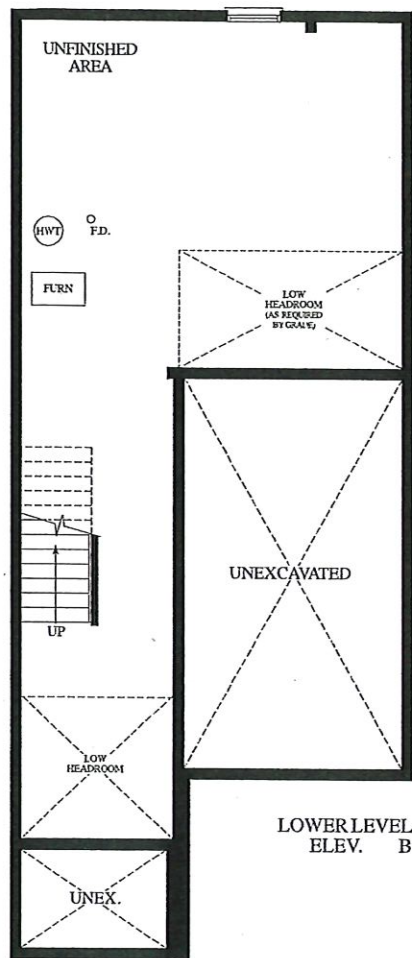

- Ⓢ - cable (x3)
- Ⓣ - Telephone (x3)

November 21, 2019



RECEIVED
SEPT 6 '19



CONSTRUCTION SUMMARY

Forestsides Estates Inc.

PURCHASER: FADORO CORPORATION

TEL:

LOT NUMBER	PHASE	HOUSE TYPE	CLOSING DATE
43 Block 7	6	AZALEA-ELEV B-std ground with std upper level	30-Oct-19

Offer	BONUS PACKAGE -PURCHASER TO RECEIVE \$10,000 (INCLUSIVE OF TAXES) WORTH OF UPGRADES AT DECOR CENTRE AT TIME OF COLOUR CHART		
Workshee	Note:		
Offer	BONUS PACKAGE OF 5 APPLIANCES TO INCLUDE FRIDGE, STOVE, DISHWASHER, WASHER AND DRYER AS PER VENDORS SAMPLES		
Workshee	Note:		
Offer	CHOICE OF COLOUR (FROM VENDORS SAMPLES) FOR 7 1/2 INCH LAMINATE ENGINEERED FLOORING IN ALL AREAS NOT COVERED WITH CERAMIC TILES ON MAIN/GROUND LEVEL, INCLUDING STAIR LANDINGS AS PER PLAN.		
Workshee	Note:		



CONSTRUCTION SUMMARY

Forestsides Estates Inc.

PURCHASER: FADORO CORPORATION

TEL:

LOT NUMBER	PHASE	HOUSE TYPE	CLOSING DATE
43 Block 7	6	AZALEA-ELEV B-std ground with std upper level	30-Oct-19

Date Added: 21-Nov-19 Invoice Number: 7356

1 - Standard Cable Rough-Ins (x3) and Standard Telephone Rough-Ins (x3) (See Sketch) Note:
1 - KITCHEN - In addition to builders standard ceiling light, Install ONE (1) ADDITIONAL CEILING LIGHT with Sepeate Switch - To be installed centred above kitchen island (See Sketch) Note:
1 - GROUND FLOOR / MAIN FLOOR / UPPER LEVEL - Install Upgrade Baseboard and Trim - UPGRADE PACKAGE #1 (3" Backbend and 5 1/4" Baseboard) To be installed throughout house, where applicable (See Sketch) Note:
2 - STAIRCASE - STAIN OAK STAIRCASE WITH IRON PICKETS - To be Stained in: VINTAGE RED OAK COBALT, throughout staircase where applicable (x2 Flights) To Include; Staircase from Ground Floor to Main Floor, and Main Floor to 2nd Floor Note: In Lieu of Builders Standard Natural Oak (See Sketch)
1 - STAIRCASE VS FLOORING - WOOD SPECIES DIFFERENCE: STAIRCASE - The purchaser was advised and therefore accepts and acknowledges that the wood species of the staircase and flooring chosen do not match. This difference may result in a stain colour variance Note: The purchaser agrees that the vendor is to be exempt from any and all claims by the purchaser regarding this colour variance.
1 - STAIRCASE VS FLOORING - STAINING DIFFERENCE: STAIRCASE - The purchaser was advised and therefore accepts and acknowledges that the stain of the staircase and flooring chosen do not match. This difference might result in an undesirable colour variance. Note: The purchaser agrees that the vendor is to be exempt from any and all claims by the purchaser regarding this colour variance.
1 - STAIRCASE - Install Upgrade Railing Package - UPGRADE PACKAGE #3 - To be installed throughout staircase, where applicable (x2 Flights) (See Sketch) To Include: HANDRAIL- Modern Rec. PICKETS-Steel-Modern Sq./Alt.Plain-Black POST- Modern Sq. 3 1/2" Note:
531 - UPPER LEVEL FLOORING - Install LAMINATE FLOORING - 7 1/2" TORLEYS FOREST OKANOGAN 9742-P - To be installed throughout Upper Level, where applicable. To Include; Upper Hall, Master Bedroom, Bedroom #2 and Bedroom #3 (See Sketch) Note: In Lieu of Builders Standard Broadloom
146 - GROUND FLOOR FLOORING - UPGRADE #2 - PORCELAIN TILES - 20x20 PULPIS GRIS - To be installed throughout ground floor areas, where applicable. To Include; Foyer, Powder Room #1, and Laundry Room (To be Installed Straight) (See Sketch) Note: Includes Larger Size
1 - MAIN FLOOR FLOORING - UPGRADE #2 - PORCELAIN TILES - 20x20 PULPIS GRIS - To be installed throughout main floor areas, where applicable. To Include; Powder Room #2 and Kitchen/Breakfast Area (To be Installed Straight) (See Sketch) Note: Includes Larger Size
1 - KITCHEN - KITCHEN COUNTERTOP - Install Upgrade Stone Countertop - UPGRADE #1 - QUORASTONE GRIS with 1 1/2" DOUBLE BEVEL - To be installed throughout kitchen, where applicable. (does not include stome backsplash) (See Sketch) Note:
1 - DISCLAIMER - STONE COUNTERTOP; KITCHEN - Stone slabs vary in size & all seams are visible & the fabricator reserves the right to position the seams as necessary. Note:
1 - KITCHEN - KITCHEN SINK - Install Upgrade Undermount Sink - BLANCO HORIZON Undermount Sink - Model # 401234 (See Sketch) Note:
1 - KITCHEN - KITCHEN FAUCET - Install the Builders Standard Faucet in the kitchen - DELTA Chrome Pull Down Kitchen Faucet (Single Hole) - Model # 976 LF Chrome Note:



WINDOW
SITE COPY

CONSTRUCTION SUMMARY

Forestsides Estates Inc.

PURCHASER: FADORO CORPORATION

TEL:

LOT NUMBER	PHASE	HOUSE TYPE	CLOSING DATE
43 Block 7	6	AZALEA-ELEV B-std ground with std upper level	30-Oct-19

Date Added: 21-Nov-19 Invoice Number: 7356

1 - KITCHEN - CABINETS - Accommodate the fridge opening for a future 36" wide fridge. (See Sketch) Note: Purchaser Accepts and Acknowledges that the Builders Standard Fridge will be 30" wide.
1 - KITCHEN - Install UPGRADE STAINLESS STEEL EXHAUST FAN in Lieu of Builders Standard White Exhaust Fan, above stove at kitchen (See Sketch) Note:
1 - KITCHEN - KITCHEN BACKSPLASH - Install Standard 3x6 Subway Bone Backsplash Tile in STRAIGHT/STACKED. To be installed throughout kitchen, where applicable. (does not include behind the fridge or stove) (See Sketch) Note:
1 - APPLIANCE PACKAGE - Install STANDARD APPLIANCE PACKAGE - To be installed throughout house, where applicable. (See Sketch) Note:
50 - MASTER ENSUITE - UPGRADE #2 - PORCELAIN TILES - 20x20 PULPIS GRIS - To be installed throughout master ensuite floor, where applicable. (To be Installed Straight) (See Sketch) Note: Includes Larger Size
105 - MASTER ENSUITE - UPGRADE #3 - PORCELAIN TILES - 12x24 DREAM WHITE - To be installed throughout master ensuite shower walls, where applicable. (To be Installed Horizontally / Stacked) (See Sketch) Note: Includes Rectified
34 - MAIN BATH - UPGRADE #2 - PORCELAIN TILES - 20x20 PULPIS GRIS - To be installed throughout main bath floor, where applicable. (To be Installed Straight) (See Sketch) Note: Includes Larger Size
1 - MASTER ENSUITE - Install Upgrade Stone Countertop - UPGRADE #1 - QUORASTONE SNOW WHITE with 1 1/2" DOUBLE BEVEL EDGE - To be installed throughout master ensuite vanity, where applicable (Includes 3" Splash) (See Sketch) Note:
1 - DISCLAIMER - STONE COUNTERTOP: MASTER ENSUITE - Stone slabs vary in size & all seams are visible & the fabricator reserves the right to position the seams as necessary. Note:
1 - MASTER ENSUITE - VANITY SINK - Install Upgrade Undermount Sink - CONTRAC CALVIN Undermount Sink - Model # 4220-CFY White (x1 Sink) (See Sketch) Note: **To be Installed with Builders Standard Vanity Faucet**
1 - CLARIFICATION: POWDER ROOM #1, POWDER ROOM #2, MASTER ENSUITE & MAIN BATH - Install the builders standard Plumbing Fixtures throughout all bathrooms, where applicable. To Include; Powder Room #1, Powder Room #2, Master Ensuite & Main Bath (See Sketch) Note:
1 - PURCHASER TO RECEIVE A FURTHER DISCOUNT OF \$1,000.00 (Before Taxes) - Approved As Per Steve C. Note:
1 - BONUS PACKAGE - PURCHASER HAS APPLIED \$10,000.00 (Includes Taxes) WORTH OF UPGRADE PROMOTIONAL PACKAGE TOWARDS THE PURCHASE OF UPGRADES COMPLETED AT THE DECOR CENTRE. Note:
1 - PURCHASER HAS ATTENDED A COLOR APPOINTMENT AT THE DECOR CENTRE AND HAS DECLINED ANY ADDITIONAL UPGRADES. Purchaser accepts and acknowledges that there will be no further changes/additions/deletions to be made upon signing on November 21, 2019 Note:
1 - PURCHASER AWARE AND ACCEPTS THAT ANY CHANGES MADE TO UPGRADES AFTER SIGNING THIS PURCHASERS EXTRA FORM ARE SUBJECT TO A MINIMUM ADMINISTRATION FEE OF \$500. PLUS A 10% HOLDBACK FEE. Note:



* INTERIOR COLOUR SCHEME *

Purchaser	Decor Consultant	Model and Elevation	Telephone Res. / Bus	Project	Closing Date	Property
FADORO CORPORATION	Melissa Di Marino	AZALEA-ELEV B-std ground with std upper level	/	Forestside Estates Inc.	30/10/2019	43 Block 7

Page 1 of 3

	Flooring	Wall Tile				Plumbing
	Description	Main	Accent/Insert	Border / Listello	Pattern	
Master Ensuite	✓ 20x20 PULPIS GRIS (STRAIGHT) (UPG)	✓ 12x24 DREAM WHITE (Horizontal)(UPG)	NONE	NONE	NONE	WHITE
Main Bathroom	✓ 20x20 PULPIS GRIS (STRAIGHT) (UPG)	✓ 8x10 CARRARA MATTE (STD)	NONE	NONE	NONE	WHITE
Powder Room #1	✓ 20x20 PULPIS GRIS (STRAIGHT) (UPG)	N/A	N/A	N/A	NONE	WHITE
Powder Room #2	✓ 20x20 PULPIS GRIS (STRAIGHT) (UPG)	N/A	N/A	N/A	NONE	WHITE
Kitchen/Breakfast	✓ 20x20 PULPIS GRIS (STRAIGHT) (UPG)	✓ 3x6 SUBWAY BONE (STACKED)(STD)	NONE	NONE	NONE	UPG
Laundry	✓ 20x20 PULPIS GRIS (STRAIGHT) (UPG)	N/A	N/A	N/A	NONE	STD
Foyer	✓ 20x20 PULPIS GRIS (STRAIGHT) (UPG)	Railings and Stairs				Cornice Moulding / Medalion
Main Hall	✓ 7 1/2" Torleys Forest - Okanogan 9742P (STD)					Foyer NO
Home Office	✓ 7 1/2" Torleys Forest - Okanogan 9742P (STD)	Railings ✓ UPG - Modern Rec. Vintage Red Oak Cobalt	Landing - Upper ✓ 7 1/2" Okanogan 9742P			
Family Room	✓ 7 1/2" Torleys Forest - Okanogan 9742P (STD)	Pickets ✓ UPG - Steel Modern Sq./Alt.Plain-Black	Landing - Lower ✓ 7 1/2" Okanogan 9742P			
Living Room	✓ 7 1/2" Torleys Forest - Okanogan 9742P (STD)	Posts ✓ UPG - Modern Sq. 3 1/2" Vint.Oak Cobalt	Ledge - Upper N/A			
Dining Room	✓ 7 1/2" Torleys Forest - Okanogan 9742P (STD)	Stringers ✓ UPG - VINTAGE RED OAK COBALT	Ledge - Lower N/A			
		Treads ✓ UPG - VINTAGE RED OAK COBALT				
		Risers ✓ UPG - VINTAGE RED OAK COBALT				
		Runner NO				
		Trim				
Upper Hall	✓ 7 1/2" Torleys Forest - Okanogan 9742P (UPG)	Baseboard & Casing ✓ UPG - 3" Backband / 5 1/4" Baseboard	Knobs STANDARD			
		Front Door Glass ✓ STANDARD	Hinges STANDARD			
		Interior Doors ✓ STANDARD - CARRARA	Grip Set STANDARD			
Master Bedroom	✓ 7 1/2" Torleys Forest - Okanogan 9742P (UPG)	Notes				
Bedroom 2	✓ 7 1/2" Torleys Forest - Okanogan 9742P (UPG)					
Bedroom 3	✓ 7 1/2" Torleys Forest - Okanogan 9742P (UPG)					
		✓ KITCHEN - KITCHEN Sink - install Upgrade Undermount Sink - BLANCO Horizon Undermount Sinks Model # 740120				
		✓ KITCHEN - KITCHEN Faucet - install the Builders Standard Faucet in the kitchen - DELTA Chrome 1/2" Bowl Kitchen Faucet (Single Hole) - Model # 976 LF Chrome				
Rear Yard Access	✓ STANDARD					

Page 1 of 3

Consultant:

Melissa Di Marino

Purchaser:

FADORO CORPORATION

Vendor:

Forestside Estates Inc.

Lot: 43 Block 7 Project: Forestside Estates Inc. Model: AZALEA-ELEV B-std ground with std upper level

Printed Nov 21, 2019 2:39 pm



* INTERIOR COLOUR SCHEME *

Purchaser	Decor Consultant	Model and Elevation	Telephone Res. / Bus	Project	Closing Date	Property
FADORO CORPORATION	Melissa Di Marino	AZALEA-ELEV B-std ground with std upper level	/	Forestside Estates Inc.	30/10/2019	43 Block 7

Page 2 of 3

Interior Paint		Cabinet			
	Description	Style	Countertop	Counter Edge	Handle / Knob
Master Ensuite	COOL WHITE	EURO - MELAMINE - LICORICE WF-392 (STD)	Quorastone Snow White (UPG)	1 1/2" DOUBLE BEVEL (STD)	541-140
Main Bathroom	COOL WHITE	EURO - MELAMINE - LICORICE WF-392 (STD)	7735-58 PORTICO MARBLE	STD	541-140
Powder Room #1	COOL WHITE	N/A	N/A	N/A	N/A
Powder Room #2	COOL WHITE	N/A	N/A	N/A	N/A
Kitchen/Breakfast	COOL WHITE	EURO - MELAMINE - ARCTIC WF-394 (STD)	QUORASTONE GRIS (UPG)	1 1/2" DOUBLE BEVEL (STD)	5017-195
Laundry	COOL WHITE	N/A	N/A	N/A	N/A
Foyer	COOL WHITE				
Main Hall	COOL WHITE				
Home Office	COOL WHITE				
Family Room	COOL WHITE				
Living Room	COOL WHITE				
Dining Room	COOL WHITE				
Upper Hall	COOL WHITE				
Master Bedroom	COOL WHITE				
Bedroom 2	COOL WHITE				
Bedroom 3	COOL WHITE				
Rear Yard Access	COOL WHITE				

Appliance Opening/Dimension

Fridge Size	SEE NOTES	Range	Std 31in Opening
Built-Ins	None	Microwave	None
Hood Fan	SEE NOTES	Exhaust Opening	6" 8"
Dishwasher Cabinet	Std 24in Opening		

Fireplace

Fireplace	N/A	Fireplace	N/A
Location Flooring	N/A	Location Flooring	N/A
Style	N/A	Style	N/A
Finish	N/A	Finish	N/A
Marble	N/A	Marble	N/A
Hearth	N/A	Hearth	N/A

Notes

- **KITCHEN - Install STANDARD APPLIANCE PACKAGE - To be installed throughout house, where applicable.
- **KITCHEN - Accommodate Fridge Opening for Future 36" Wide Fridge
- **KITCHEN - Install Upgrade STAINLESS STEEL EXHAUST FAN

Page 2 of 3

Decor Consultant: Melissa Di Marino

Purchaser: FADORO CORPORATION

Vendor: Forestside Estates Inc.
Printed Nov 21, 2019 2:39 pm

Lot: 43 Block 7 Project: Forestside Estates Inc. Model: AZALEA-ELEV B-std ground with std upper level

Villa
KITCHENS & FINE CABINETRY LTD

8111 Jane St. Unit 10
Concord, Ontario L4K 4L7
Tel. (905) 669-7028
Fax. (905) 669-7903
email: designstudio@villakitchens.ca
www.villakitchens.ca


CLIENT: ROYAL PINE HOMES
PROJECT: FORESTSIDE
ADDRESS: RP-FS(6)-43-BLK-7
MODEL: AZALEA 1802 ELEV A/B & ALT THIRD FLOOR

KITCHEN

November 28, 2019

EXTRAS:
1. 36" FRIDGE

DRAWN BY: ASHLEY
DATE: NOVEMBER 28, 2019
REVISION:
PAGE: 1 OF 5

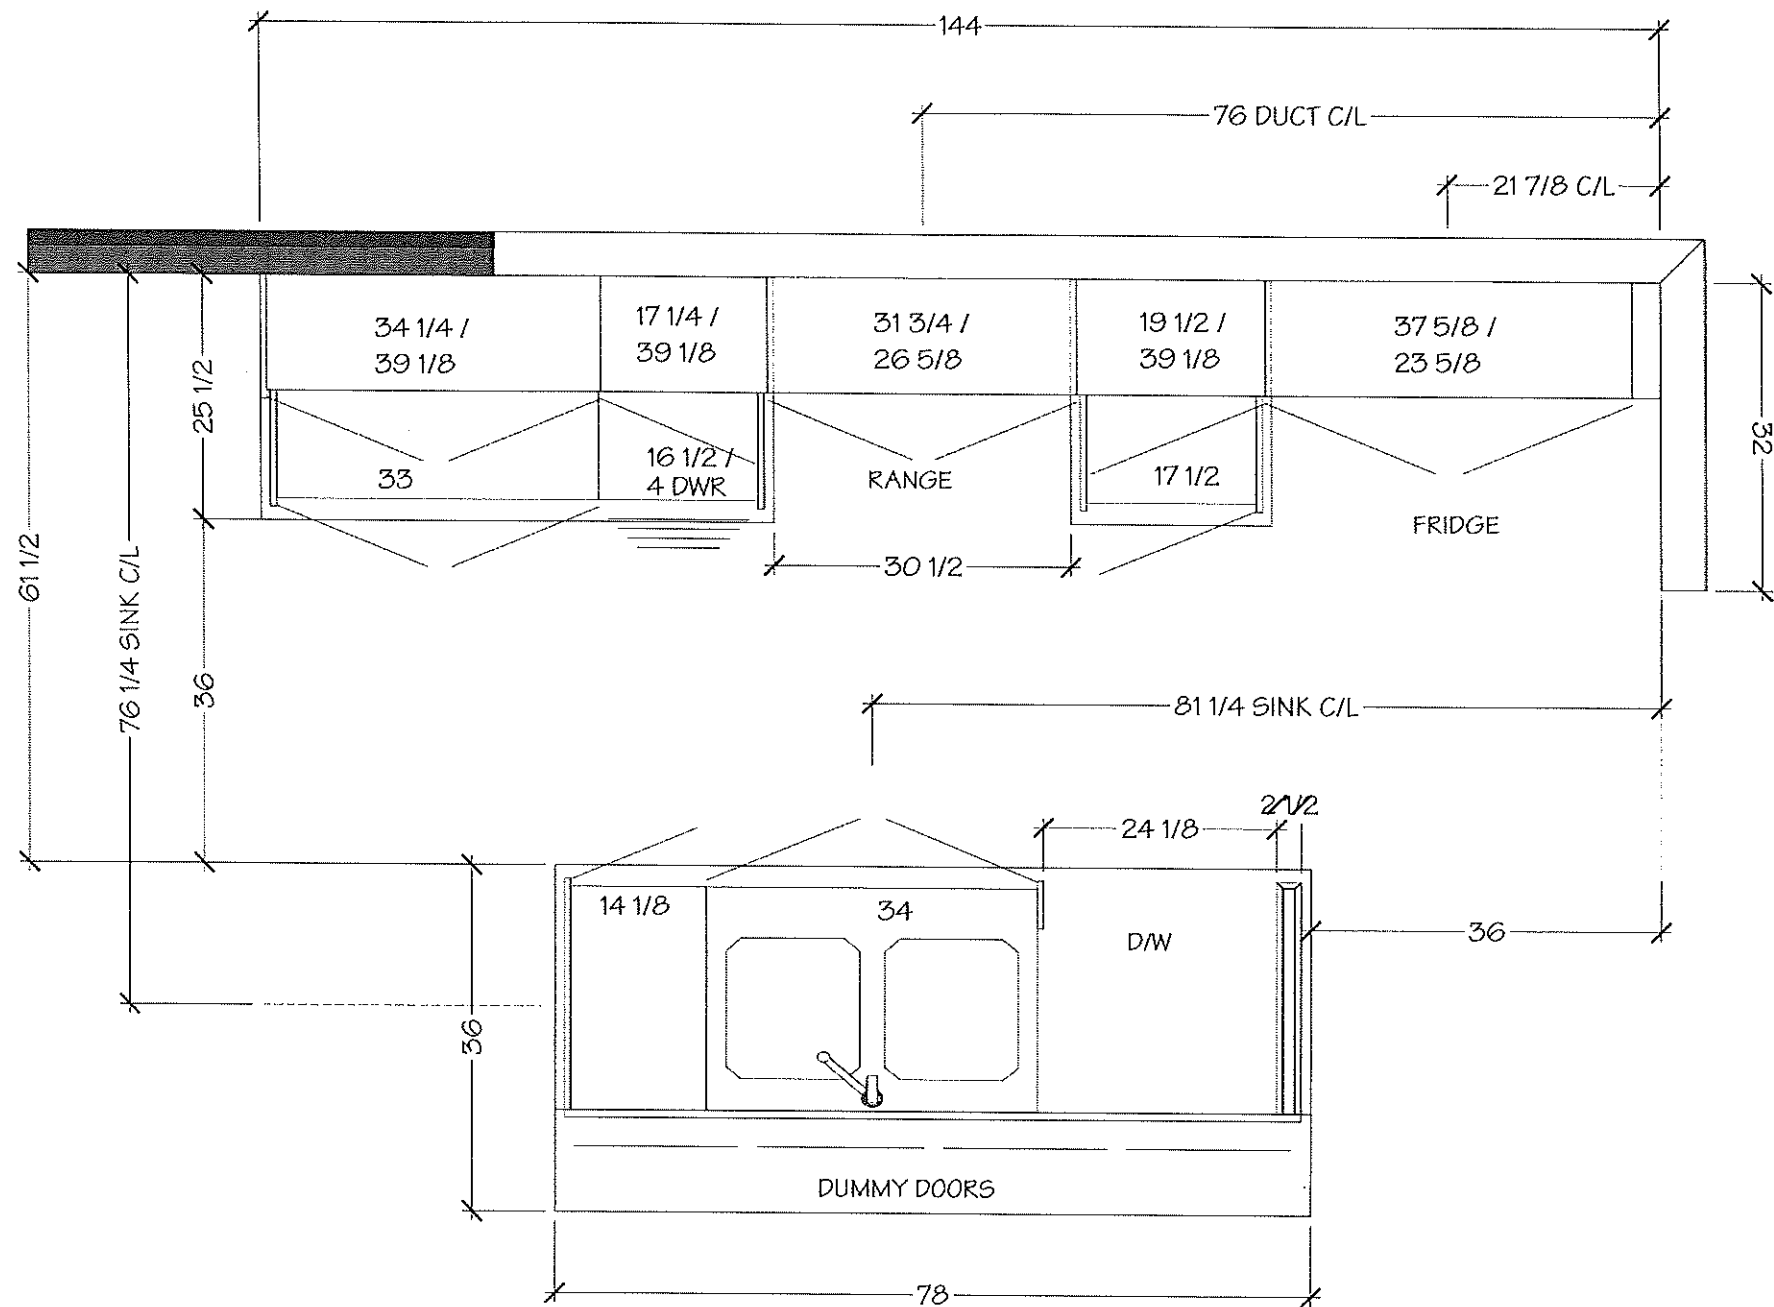

Lot 43 / BLK 7 Forestside

Villa

KITCHENS & FINE CABINETRY LTD

8111 Jane St. Unit 10
Concord, Ontario L4K 4L7
Tel. (905) 669-7028
Fax. (905) 669-7903
email: designstudio@villakitchens.ca
www.villakitchens.ca

CLIENT: ROYAL PINE HOMES

PROJECT: FORESTSIDE

ADDRESS: RP-FS(6)-43-BLK-7

MODEL: AZALEA 1802 ELEV A/B & ALT THIRD FLOOR

KITCHEN

November 28, 2019




EXTRAS:
1. 36" FRIDGE

DRAWN BY: ASHLEY

DATE: NOVEMBER 28, 2019

REVISION:

PAGE: 2 OF 5

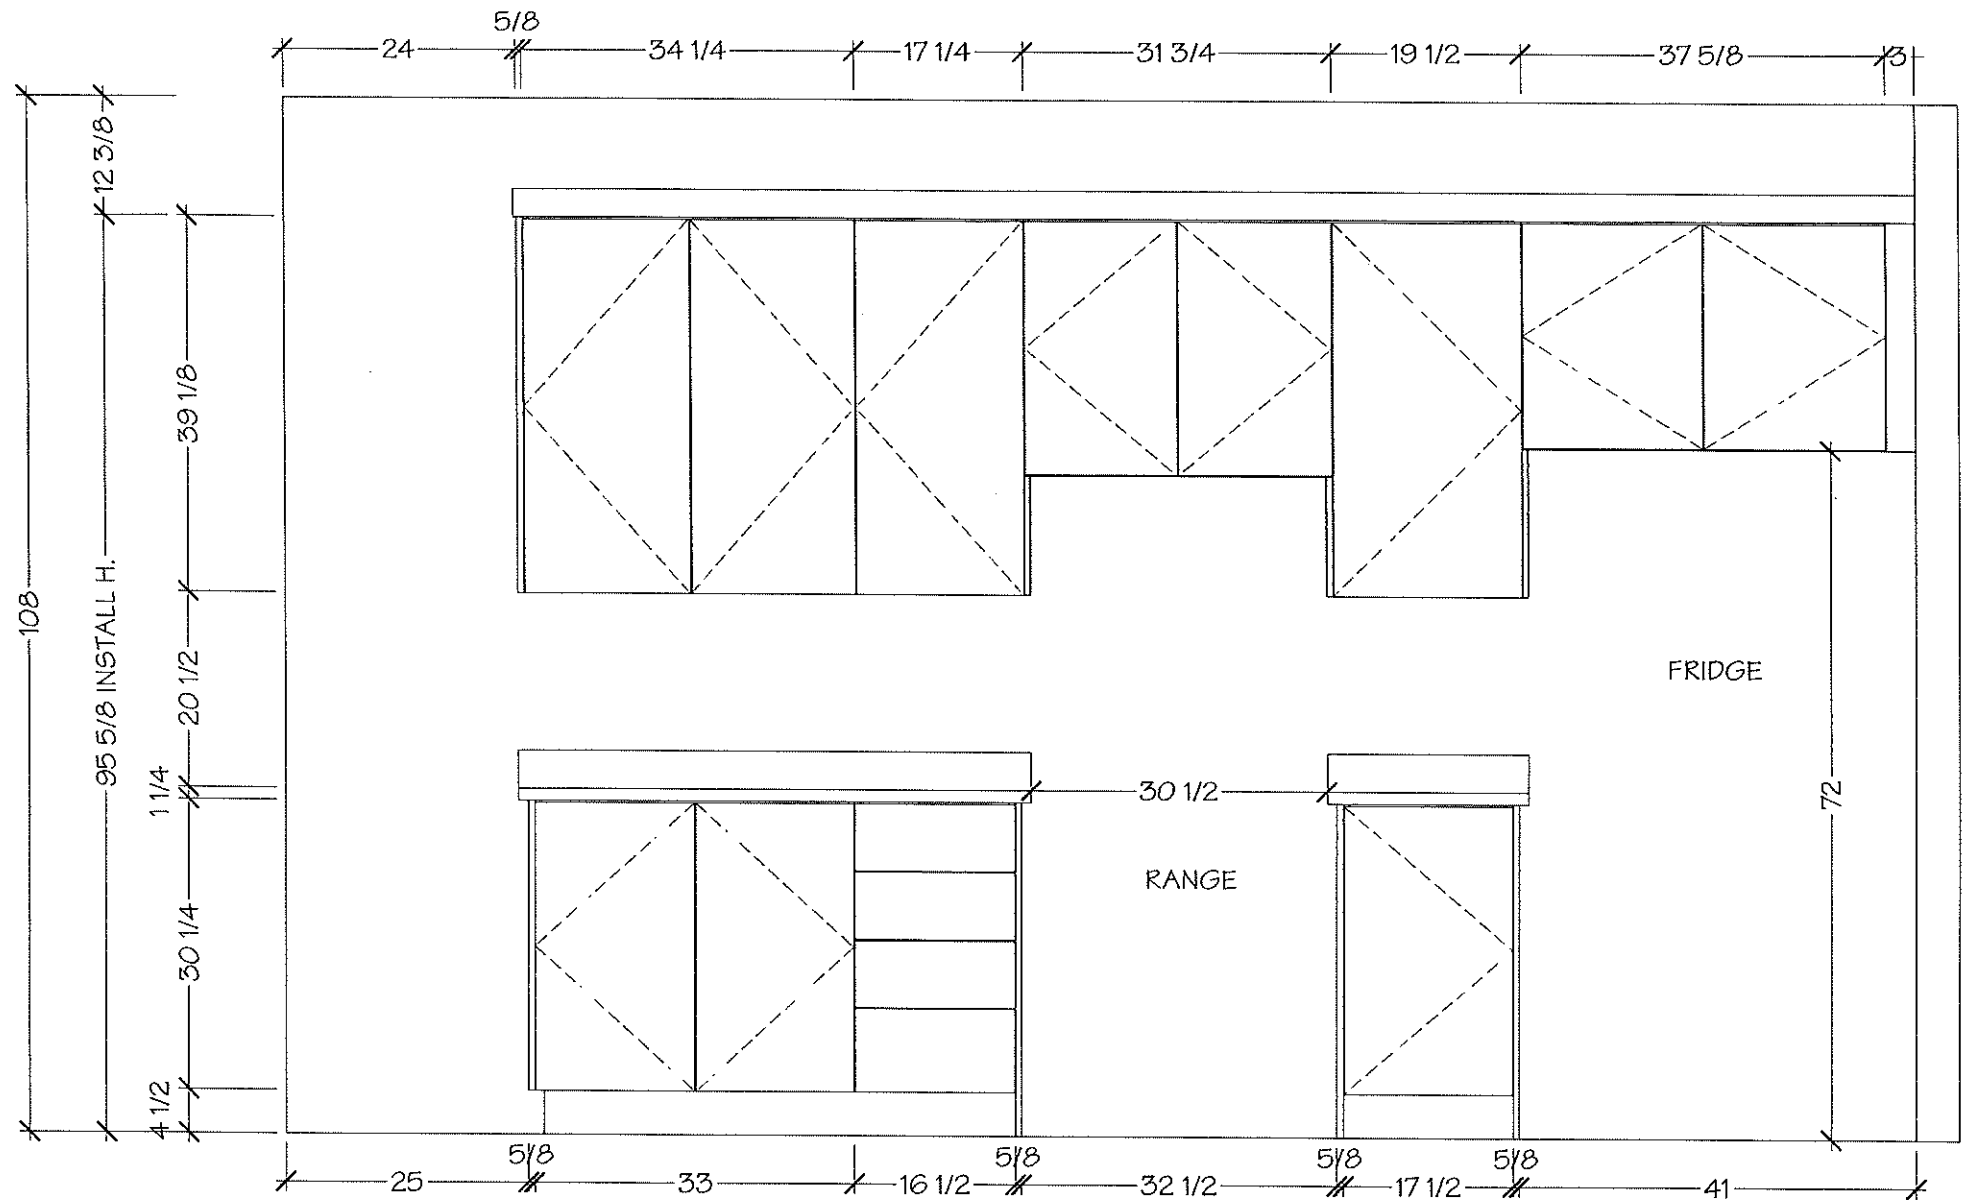

Lot 43/ Blk 7 Forestside

Villa

KITCHENS & FINE CABINETS LTD

8111 Jane St. Unit 10
Concord, Ontario L4K 4L7
Tel. (905) 669- 7028
Fax. (905) 669 - 7903
email: designstudio@villakitchens.ca
www.villakitchens.ca

CLIENT: ROYAL PINE HOMES
PROJECT: FORESTSIDE
ADDRESS: RP-FS(6)-43-BLK-7
MODEL: AZALEA 1802 ELEV A/B & ALT THIRD FLOOR



KITCHEN

November 28, 2019



EXTRAS:
1. 36" FRIDGE

DRAWN BY: ASHLEY
DATE: NOVEMBER 28, 2019
REVISION:
PAGE: 3 OF 5

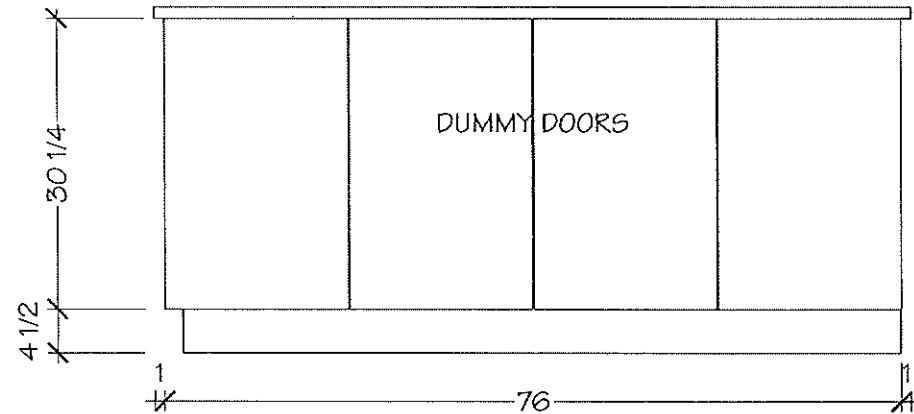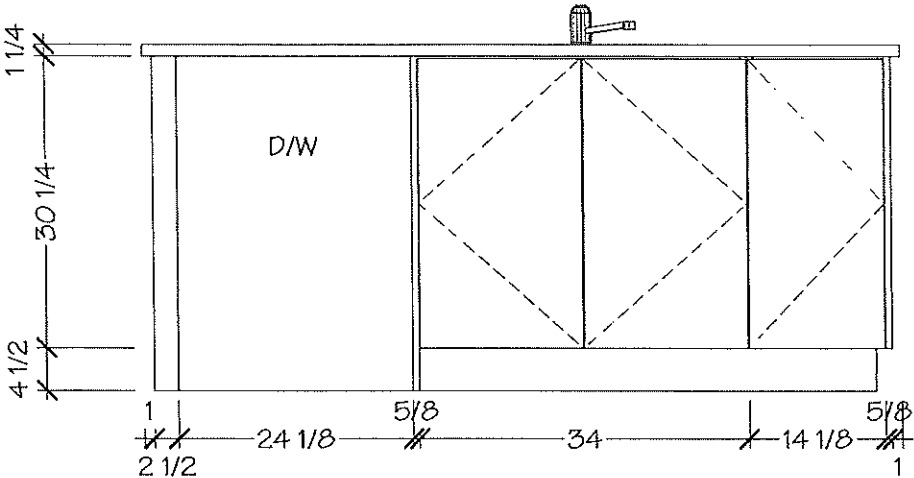

Villa



Technical drawing of a rectangular box with a lid. The drawing shows the box from a top-down perspective. The lid is hinged on the left side. The dimensions are: length 42, width 23, and an internal width of $38 \frac{1}{4}$. The lid has a central octagonal cutout with a handle.

Technical drawing of a rectangular structure, possibly a window or door frame, showing dimensions and a diamond pattern.

Dimensions:

- Vertical dimensions (left side):
 - Top section: $1\frac{1}{4}$
 - Middle section: $24\frac{1}{2}$
 - Bottom section: $6\frac{1}{4}$
- Horizontal dimensions (bottom):
 - Left section: $2\frac{1}{8}$
 - Middle section: $38\frac{1}{4}$
 - Right section: $5\frac{1}{8}$

Structure Details:

- The structure is a rectangle with a diamond pattern (X) inside.
- There are three small squares (X) on the top edge.
- The drawing includes various lines indicating dimensions and structural elements.

Lot 43/ Blk 7 Forestside

Villa
KITCHENS & FINE CABINETRY LTD

8111 Jane St. Unit 10
Concord, Ontario L4K 4L7
Tel. (905) 669- 7028
Fax. (905) 669 - 7903
email: designstudio@villakitchens.ca
www.villakitchens.ca


CLIENT: ROYAL PINE HOMES
PROJECT: FORESTSIDE
ADDRESS: RP-FS(6)-43-BLK-7
MODEL: AZALEA 1802 ELEV A/B & ALT THIRD FLOOR

MAIN


November 28, 2019



DRAWN BY: ASHLEY
DATE: NOVEMBER 28, 2019
REVISION:
PAGE: 5 OF 5

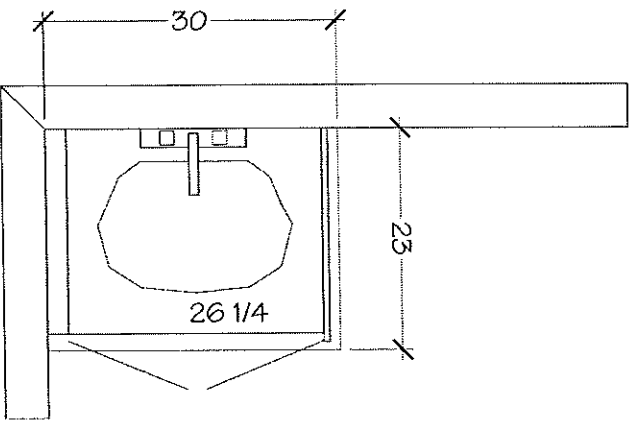

MAIN BATH

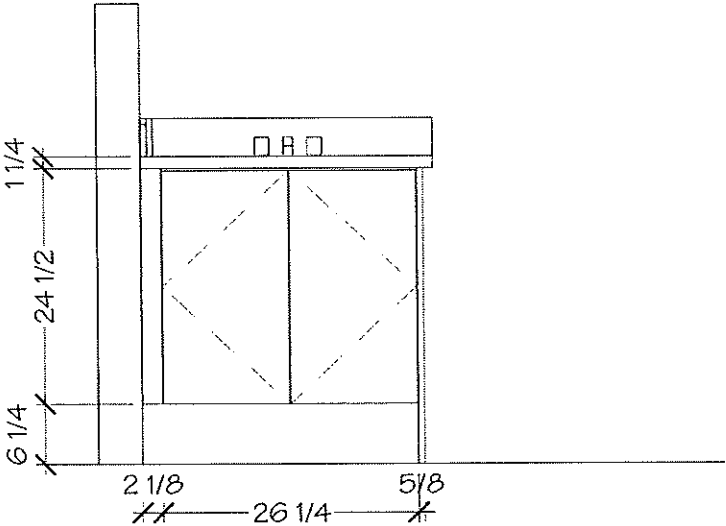


Lot 43 / BIK 7 Forestside

November 19, 2019




ARISTON
MARBLE & GRANITE LTD.
119 WINGES RD.
WOODBIDGE, ONTARIO L4L 6C2

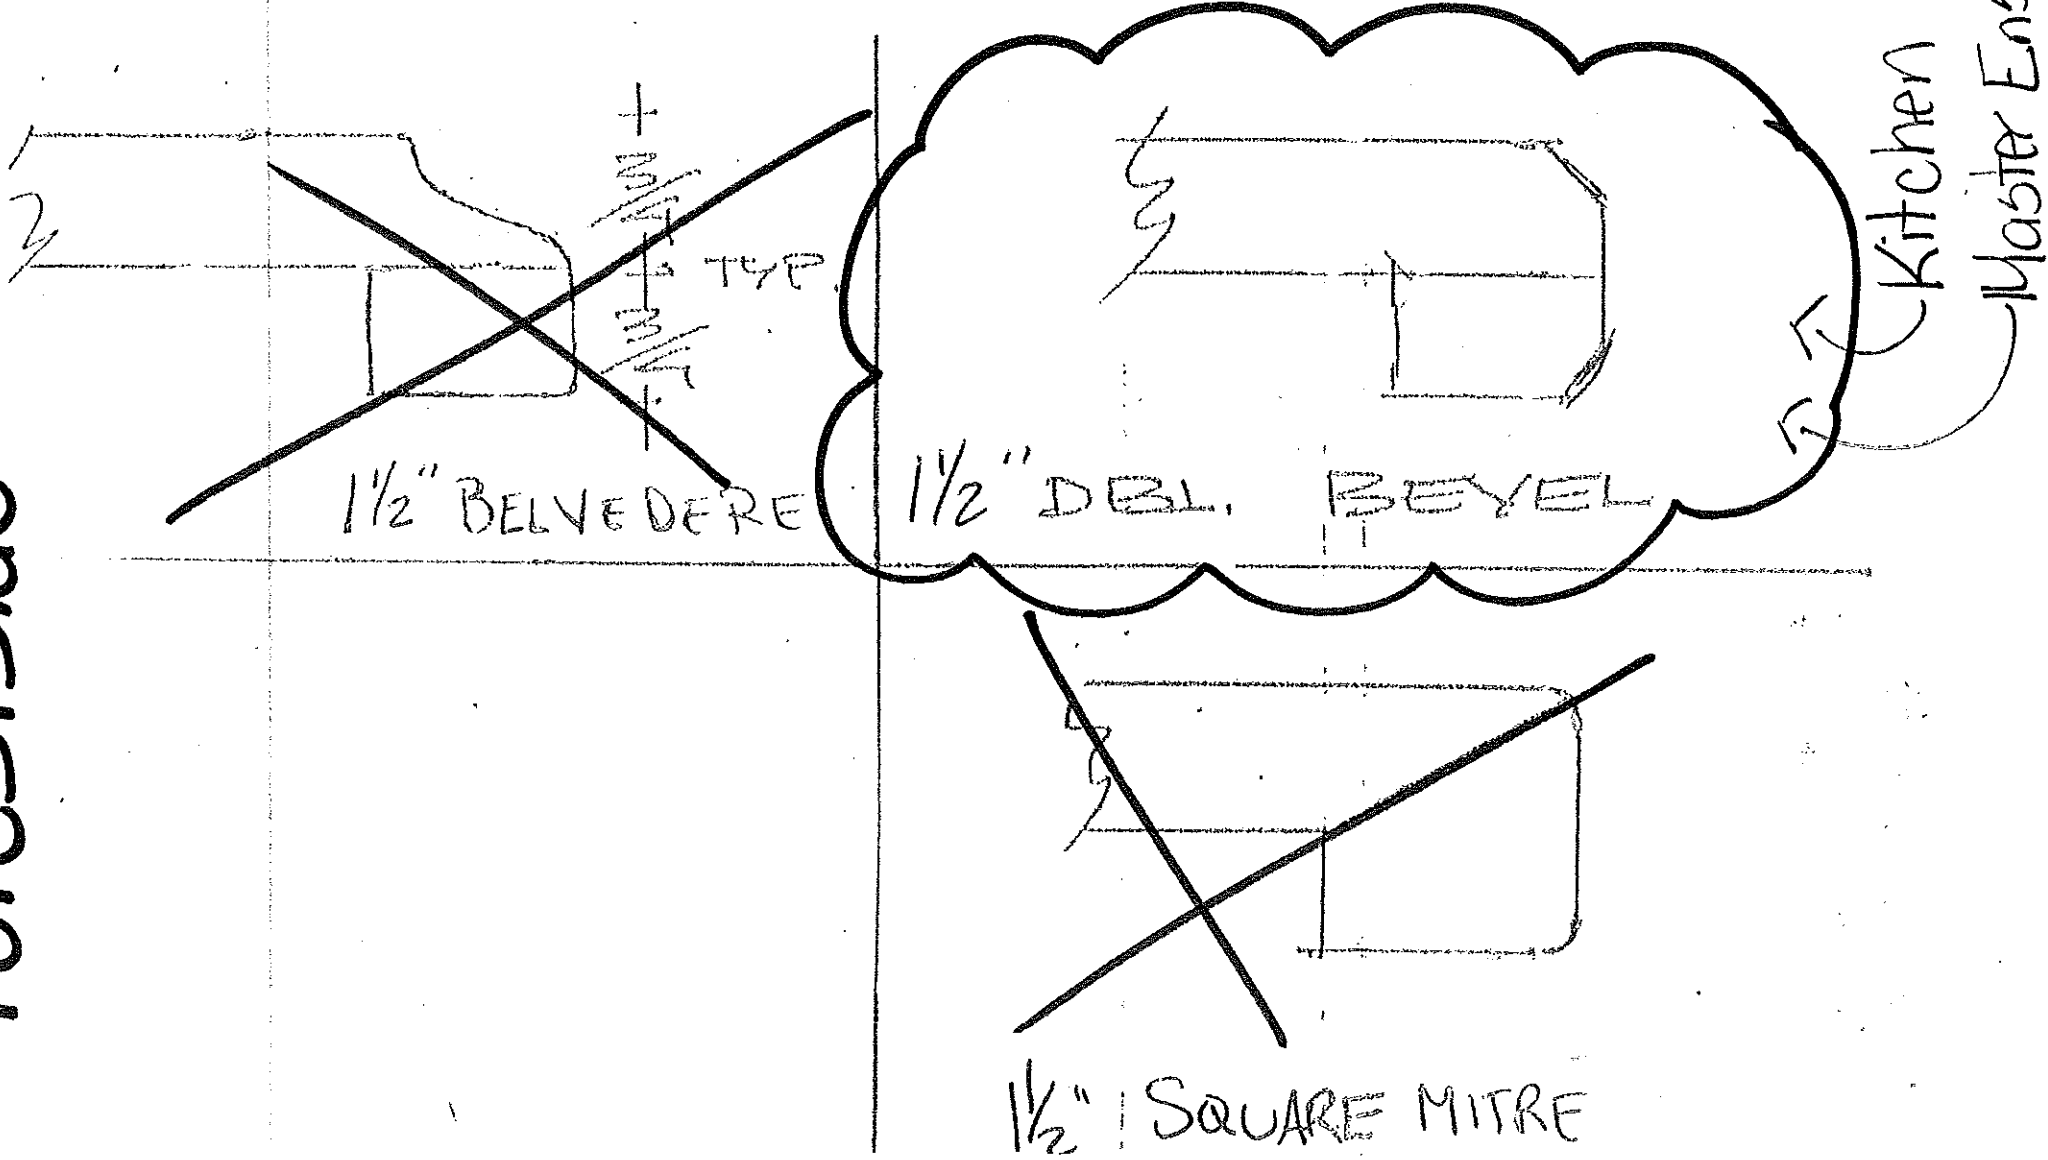

HORIZON™
Undermount

Lot 43/Blk 7 Forestside

HORIZON™ U 2

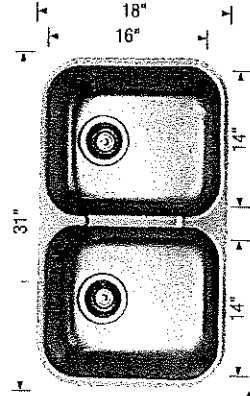

Sink Specification

Undermount
Minimum Cabinet Size*
33" (840 mm)
Bowl Depth
8" (205 mm)
Cubed Weight
49 lb. (22 kg)

Note: 18 gauge stainless steel

Optional accessories

406406 Grid
517666 CapFlow™


Installed Price**

Model N°

401234

Kitchen

HORIZON™ U 1.5

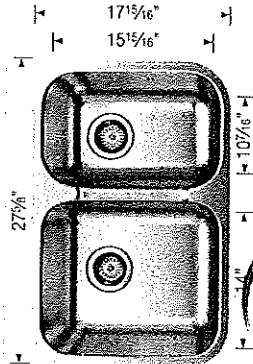

Sink Specification

Undermount
Minimum Cabinet Size*
30" (760 mm)
Bowl Depth
8" (205 mm)
Cubed Weight
61 lb. (28 kg)

Note: 18 gauge stainless steel

Installed Price**


Model N°

402148

Optional accessories

406409 Grid (LB)
406407 Grid (SB)
517666 CapFlow™

HORIZON™ U 1

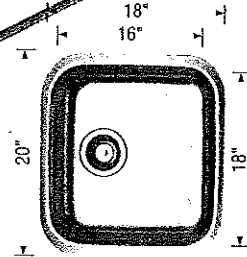

Sink Specification

Undermount
Minimum Cabinet Size*
24" (610 mm)
Bowl Depth
8" (205 mm)
Cubed Weight
20 lb. (9 kg)

Note: 20 gauge stainless steel

Installed Price**

Model N°

401251

Optional accessories

517666 CapFlow™

* Depending on cabinet construction, a different cabinet size may be required. Consult the cabinet manufacturer. | ** Installed price subject to change.



CALVIN

ITEM DETAILS

Lot 43/BIK7
Forestside

OUTER DIMENSIONS 19 1/4" W x 16 1/8" D x 7 5/8" H

INNER DIMENSIONS 17" W x 13 3/4" D x 5 3/4" H

MATERIAL Vitreous china

COLOUR Soft white

Oval undermount sink | Front overflow hole | Template and mounting hardware supplied | Faucet not included

CERTIFICATIONS

IAPMO cUPC

ASME A112.19.2 / CSA B45.1



Master Ensuite



19 1/4" SINK
4220CFY

4220
CFY.

ISSUED MA