

18' TOWNHOMES





BLK. 3 LOT 12 EL.A

CROCUS END *STD Floor Levels*
(18-04 END)

2195 SQ. FT. *W 3PC WAS HEDOM*

(INCLUDES 14 SQ. FT. OF OPEN AREA)

INVENTORY LOT

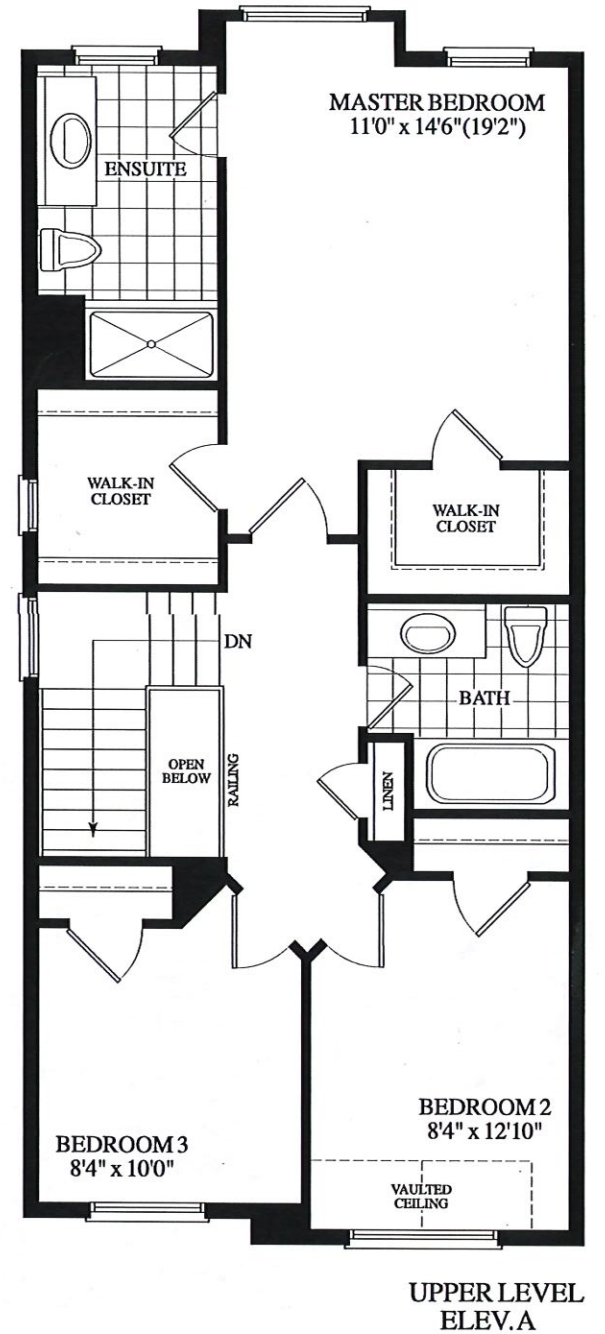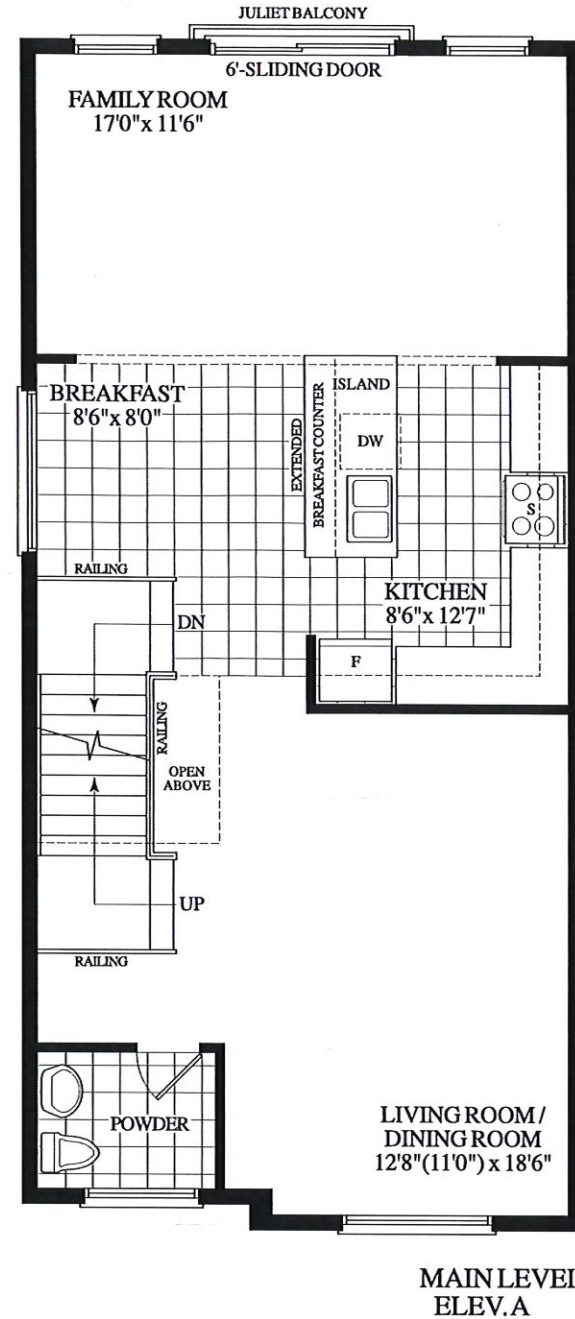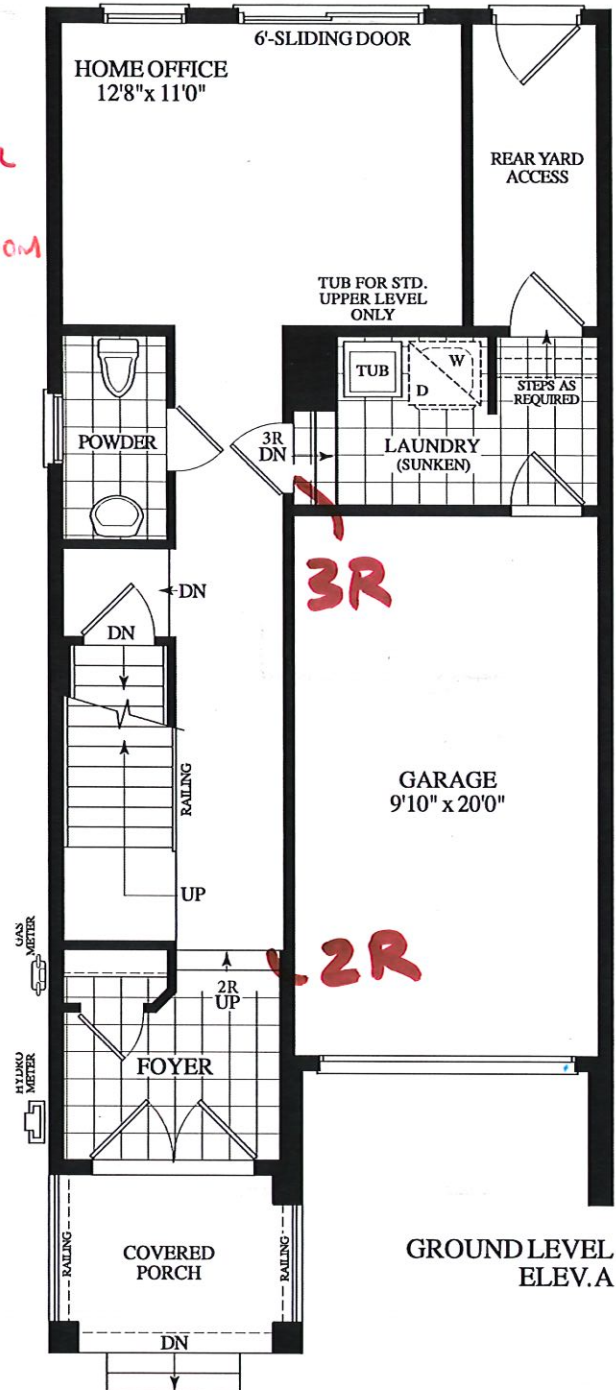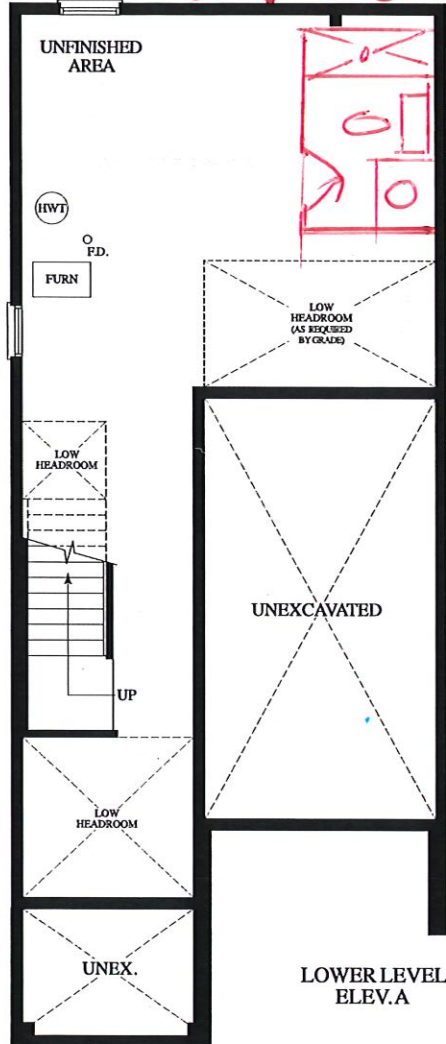

Dimensions, specifications, layouts, window sizes, and materials are approximate only, may vary, and are subject to change as provided in the Agreement of Purchase & Sale. Plans may be reversed. Illustrations are artist's concept. E.&O.E.

ROYALPINEHOMES.COM

Nov 4 2019 REV.