
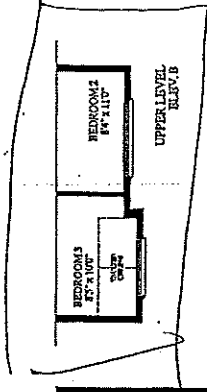
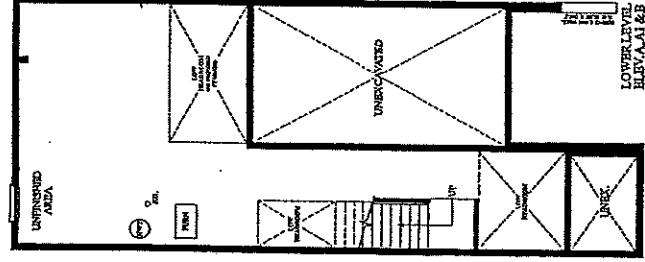
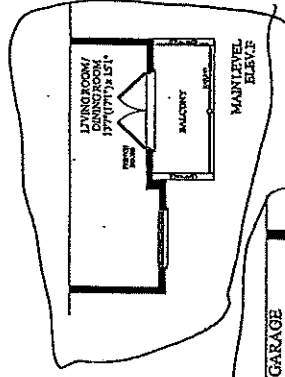


Original

# CHESTNUT (18-03)

2140 SQ. FT.  
(INCLUDES 10 SQ. FT. OF OPEN AREA)

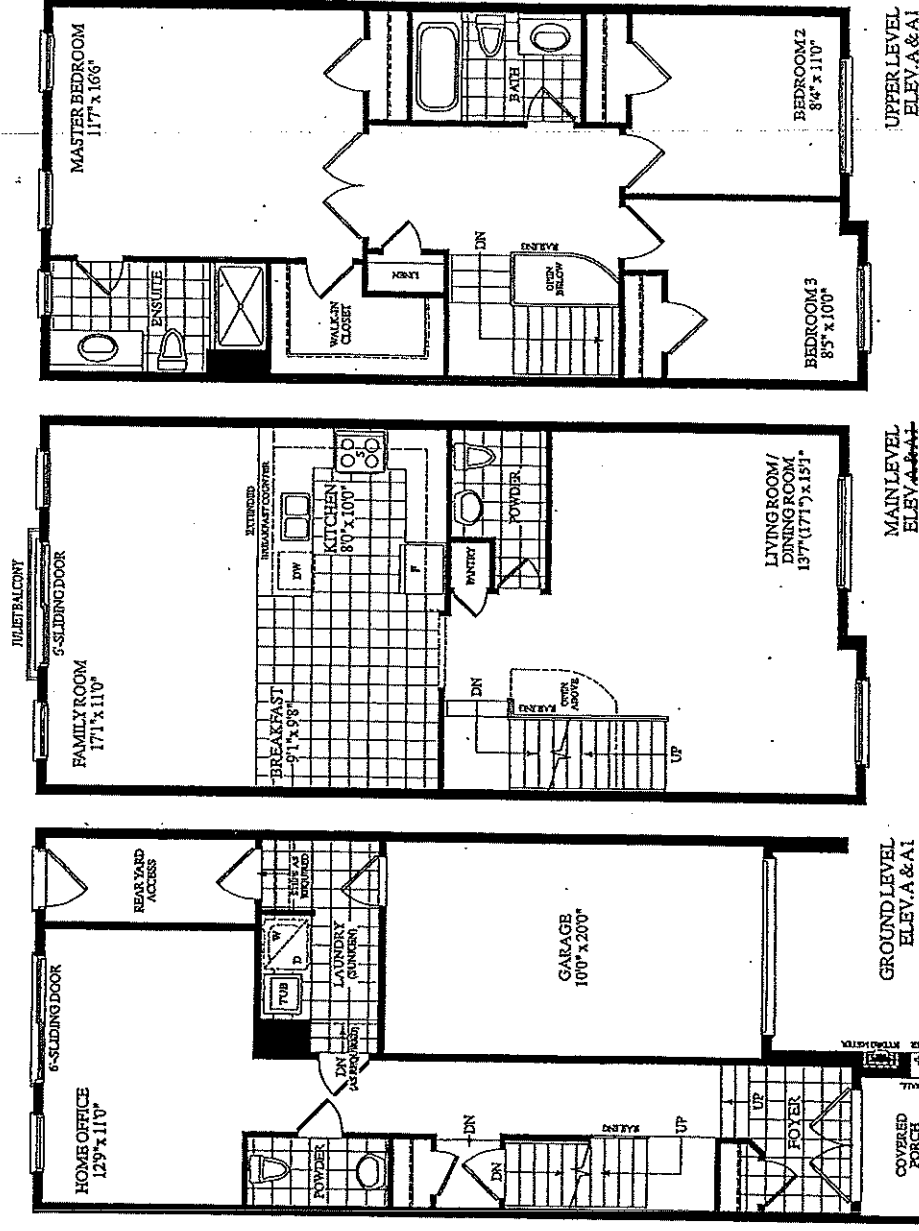

LOT #39  
BLK 7  
ELV. B

8



ROYALFINEHOMES.COM

Description - Vendor to Supply and Install the Following as Per Purchase Price





- BONUS PACKAGE -PURCHASER TO RECEIVE \$10,000 (INCLUSIVE OF TAXES) WORTH OF UPGRADES AT DECOR CENTRE AT TIME OF COLOUR CHART
- BONUS PACKAGE OF 5 APPLIANCES TO INCLUDE FRIDGE, STOVE, DISHWASHER, WASHER AND DRYER AS PER VENDORS SAMPLES
- CHOICE OF COLOUR (FROM VENDORS SAMPLES) FOR 7 1/2 INCH LAMINATE ENGINEERED FLOORING IN ALL AREAS NOT COVERED WITH CERAMIC TILES ON MAIN/GROUND LEVEL, INCLUDING STAIR LANDINGS AS PER PLAN.

18' TOWNHOMES

BLK. 7 LOT 39 EL. B

# CHESTNUT (18-03)

2140 SQ. FT.  
(INCLUDES 10 SQ. FT. OF OPEN AREA)  
STANDARD FLOOR LEVELS

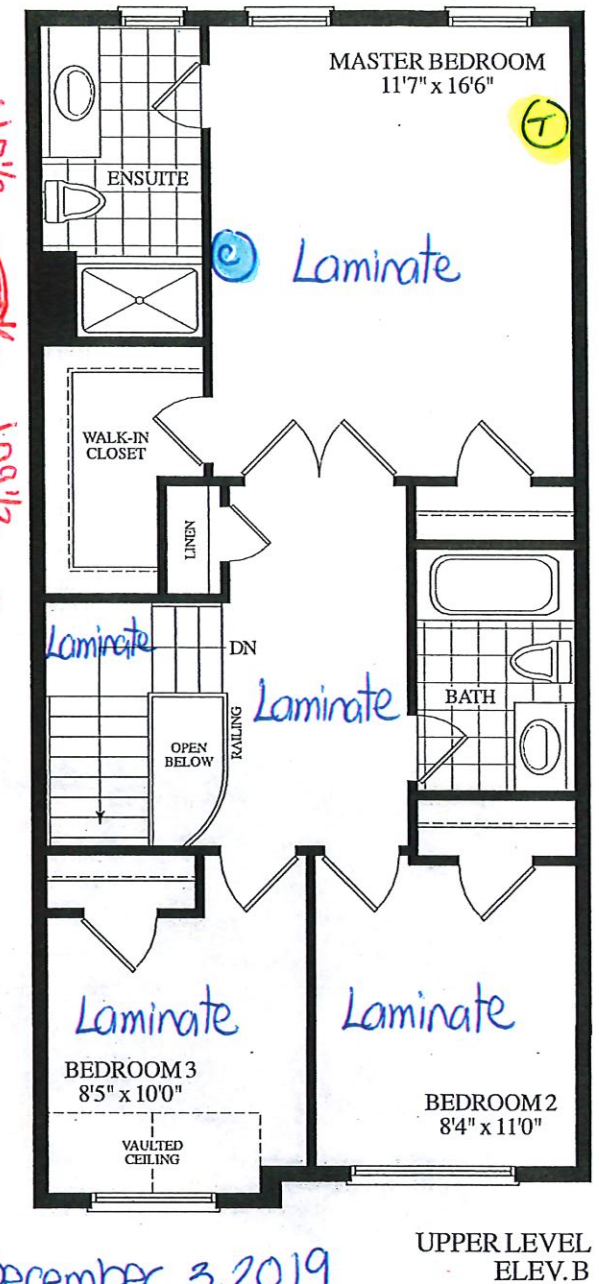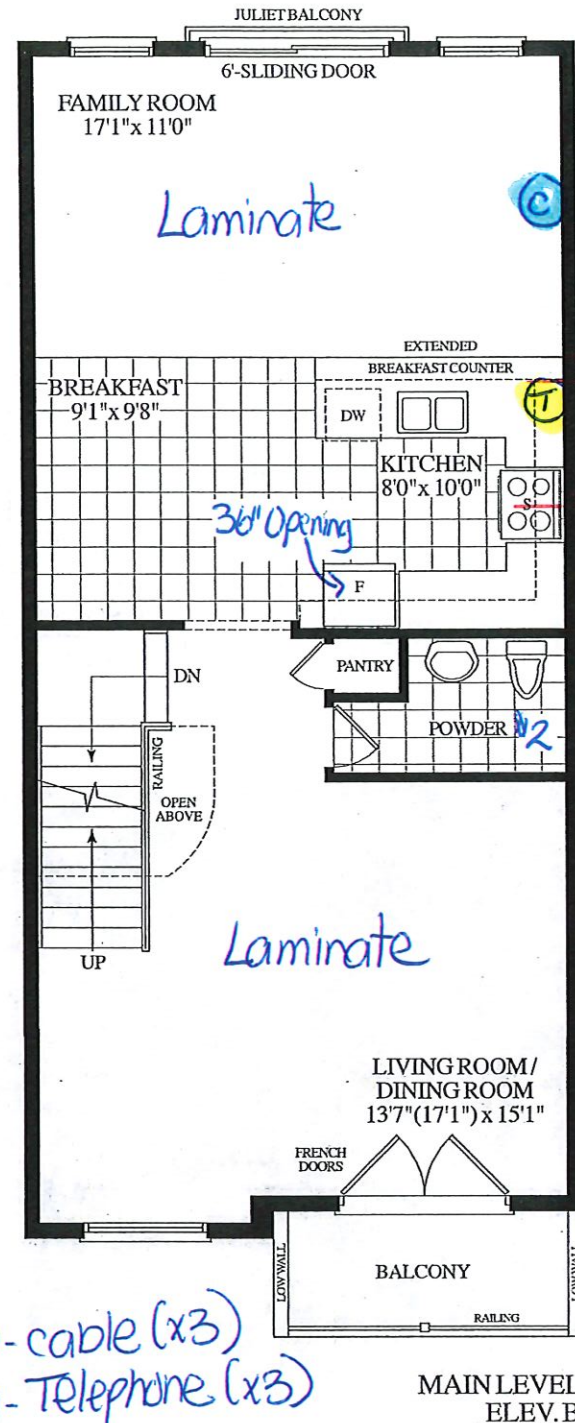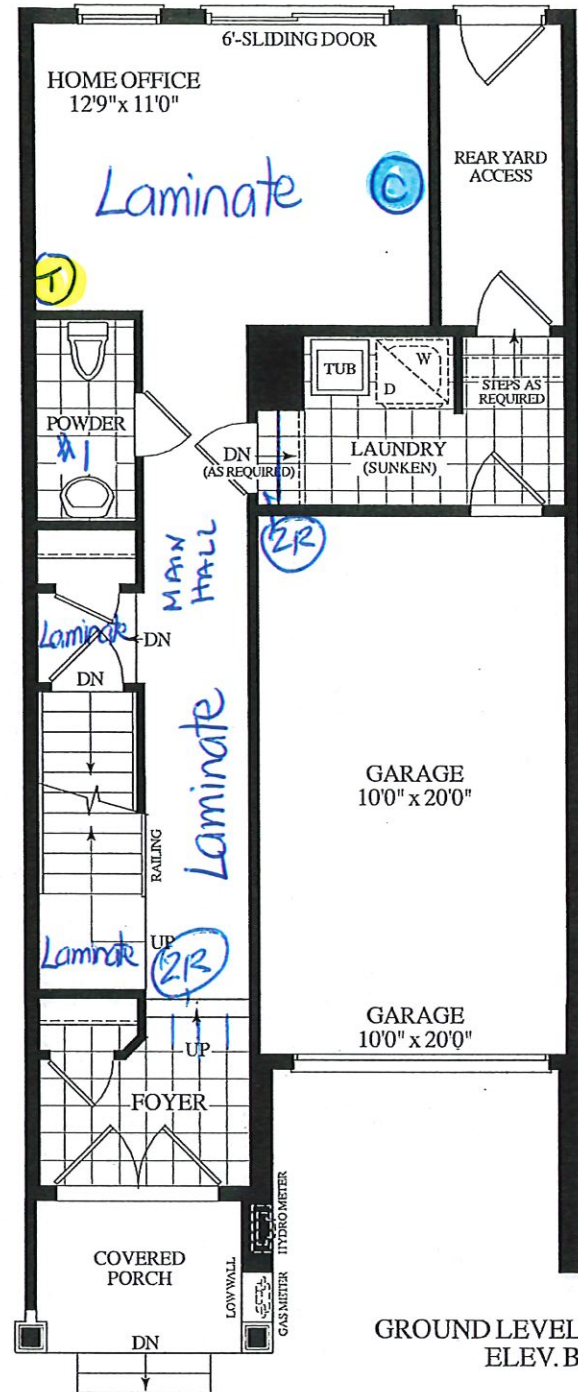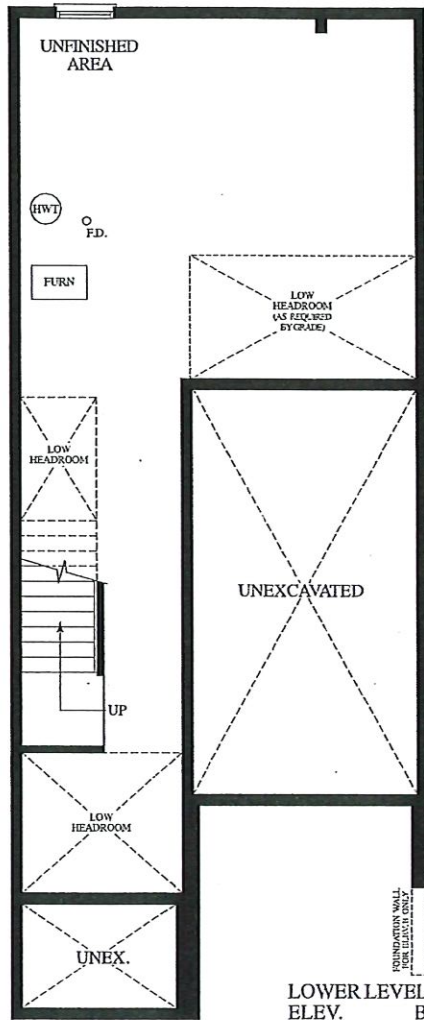

© - cable (x3)  
T - Telephone (x3)

December 3, 2019

RECEIVED  
SEPT 6 '19



Depicted as conceptual floor plans. Actual areas and materials are approximate only. They vary and are subject to change.

ROYALPINEHOMES.COM



PURCHASER: LINO GIULIANI

CONSTRUCTION SUMMARY

Forestside Estates Inc.

TEL:

| LOT NUMBER | PHASE | HOUSE TYPE      | CLOSING DATE |
|------------|-------|-----------------|--------------|
| 39 Block 7 | 6     | CHESTNUT-ELEV B | 30-Oct-19    |

|                   |                                                                                                                                                                                                      |
|-------------------|------------------------------------------------------------------------------------------------------------------------------------------------------------------------------------------------------|
| Offer<br>Workshee | BONUS PACKAGE -PURCHASER TO RECEIVE \$10,000 (INCLUSIVE OF TAXES) WORTH OF UPGRADES AT DECOR CENTRE AT TIME OF COLOUR CHART<br>Note:                                                                 |
| Offer<br>Workshee | BONUS PACKAGE OF 5 APPLIANCES TO INCLUDE FRIDGE, STOVE, DISHWASHER, WASHER AND DRYER AS PER VENDORS SAMPLES<br>Note:                                                                                 |
| Offer<br>Workshee | CHOICE OF COLOUR (FROM VENDORS SAMPLES) FOR 7 1/2 INCH LAMINATE ENGINEERED FLOORING IN ALL AREAS NOT COVERED WITH CERAMIC TILES ON MAIN/GROUND LEVEL, INCLUDING STAIR LANDINGS AS PER PLAN.<br>Note: |





WINDOW  
SITE COPY

CONSTRUCTION SUMMARY

Forestside Estates Inc.

PURCHASER: LINO GIULIANI

TEL:

| LOT NUMBER | PHASE | HOUSE TYPE      | CLOSING DATE |
|------------|-------|-----------------|--------------|
| 39 Block 7 | 6     | CHESTNUT-ELEV B | 30-Oct-19    |

Date Added: 03-Dec-19      Invoice Number: 7368

|                                                                                                                                                                                                                                                                                                                                                                                                            |
|------------------------------------------------------------------------------------------------------------------------------------------------------------------------------------------------------------------------------------------------------------------------------------------------------------------------------------------------------------------------------------------------------------|
| 1 - Standard Cable Rough-Ins (x3) and Standard Telephone Rough-Ins (x3) (See Sketch)<br>Note:                                                                                                                                                                                                                                                                                                              |
| 1 - GROUND FLOOR / MAIN FLOOR / UPPER LEVEL - Install Upgrade Baseboard and Trim - UPGRADE PACKAGE #1 (3" Backbend and 5 1/4" Baseboard) - To be installed throughout house, where applicable. (See Sketch)<br>Note:                                                                                                                                                                                       |
| 2 - STAIRCASE - STAIN OAK STAIRCASE WITH IRON PICKETS - To be Stained in: VINTAGE RED OAK COBALT, throughout staircase where applicable (x2 Flights) To Include; Staircase from Ground Floor to Main Floor, and Main Floor to 2nd Floor<br>Note: In Lieu of Builders Standard Natural Oak (See Sketch)                                                                                                     |
| 1 - STAIRCASE VS FLOORING - WOOD SPECIES DIFFERENCE:<br>STAIRCASE - The purchaser was advised and therefore accepts and acknowledges that the wood species of the staircase and flooring chosen do not match. This difference may result in a stain colour variance<br>Note: The purchaser agrees that the vendor is to be exempt from any and all claims by the purchaser regarding this colour variance. |
| 1 - STAIRCASE VS FLOORING - STAINING DIFFERENCE:<br>STAIRCASE - The purchaser was advised and therefore accepts and acknowledges that the stain of the staircase and flooring chosen do not match. This difference might result in an undesirable colour variance.<br>Note: The purchaser agrees that the vendor is to be exempt from any and all claims by the purchaser regarding this colour variance   |
| 1 - STAIRCASE - Install Upgrade Railing Package - UPGRADE PACKAGE #3 - To be installed throughout staircase, where applicable (x2 Flights) (See Sketch)<br>To Include;<br>HANDRAIL- Modern Rec.<br>PICKETS-Steel-ModernSq./Alt.Plain-Black<br>POST-Modern Rec. 3 1/2"<br>Note:                                                                                                                             |
| 573 - UPPER LEVEL FLOORING - Install Laminate Flooring - 7 1/2" TORLEYS FOREST OKANOGAN 9742P - To be installed throughout upper level, where applicable. To Include; Upper Hall, Master Bedroom, Bedroom #2, and Bedroom #3 (See Sketch)<br>Note: In Lieu of Builders Standard Broadloom                                                                                                                  |
| 150 - GROUND FLOOR FLOORING - UPGRADE #2 - PORCELAIN TILES - 20x20 PULPIS GRIS - To be installed throughout ground floor areas, where applicable. To Include; Foyer, Laundry Room and Powder Room #1 (To be Installed Straight) (See Sketch)<br>Note: Includes Larger Size                                                                                                                                 |
| 225 - MAIN FLOOR FLOORING - UPGRADE #2 - PORCELAIN TILES - 20x20 PULPIS GRIS - To be installed throughout main floor areas, where applicable. To Include; Kitchen/Breakfast Area and Powder Room #2 (To be Installed Straight) (See Sketch)<br>Note: Includes Larger Size                                                                                                                                  |
| 52 - MASTER ENSUITE FLOOR - UPGRADE #2 - PORCELAIN TILES - 20x20 PULPIS GRIS - To be installed throughout master ensuite floor, where applicable (To be Installed Straight) (See Sketch)<br>Note: Includes Larger Size                                                                                                                                                                                     |
| 42 - MAIN BATH FLOOR - UPGRADE #2 - PORCELAIN TILES - 20x20 PULPIS GRIS - To be installed throughout main bath floor, where applicable (To be Installed Straight) (See Sketch)<br>Note: Includes Larger Size                                                                                                                                                                                               |
| 1 - KITCHEN - COUNTERTOP - Install Upgrade Stone Countertop - UPGRADE #1 - QUORASTONE COTTON KNIT with 1 1/2" DOUBLE BEVEL EDGE - To be installed throughout kitchen, where applicable (does not include stone backsplash) (See Sketch)<br>Note:                                                                                                                                                           |
| 1 - DISCLAIMER - STONE COUNTERTOP;<br>KITCHEN - Stone slabs vary in size & all seams are visible & the fabricator reserves the right to position the seams as necessary.<br>Note:                                                                                                                                                                                                                          |
| 1 - KITCHEN - KITCHEN SINK - Install Upgrade Undermount Sink - BLANCO HORIZON U2 Undermount Sink - Model # 401234 (See Sketch)<br>Note:                                                                                                                                                                                                                                                                    |





WINDOW  
SITE COPY

## CONSTRUCTION SUMMARY

Forestside Estates Inc.

PURCHASER: LINO GIULIANI

TEL:

| LOT NUMBER | PHASE | HOUSE TYPE      | CLOSING DATE |
|------------|-------|-----------------|--------------|
| 39 Block 7 | 6     | CHESTNUT-ELEV B | 30-Oct-19    |

Date Added: 03-Dec-19 Invoice Number: 7368

1 - KITCHEN - KITCHEN FAUCET - Install the Builders Standard Faucet in the kitchen - DELTA Chrome Pull Down Kitchen Faucet (Single Hole) - Model # 976 LF Chrome  
Note:

1 - KITCHEN - KITCHEN BACKSPLASH - UPGRADE #1 - 12x12 TWILIGHT OYSTER GLASS MOSAICS - To be installed throughout kitchen, where applicable (does not include behind the fridge or stove) (See Sketch)  
Note:

1 - APPLIANCE PACKAGE - Install STANDARD APPLIANCE PACKAGE - To be installed throughout house, where applicable. (See Sketch)  
Note:

1 - KITCHEN - CABINETRY - Accommodate the fridge opening for a future 36" wide fridge. (See Sketch)  
Note: Purchaser Accepts and Acknowledges that the Builders Standard Fridge will be 30" wide.

1 - KITCHEN - Delete Builders Standard White Exhaust Fan above the stove. Install UPGRADE STAINLESS STEEL EXHAUST FAN above the stove at kitchen (See Sketch)  
Note:

1 - MASTER ENSUITE - COUNTERTOP - Install Upgrade Stone Countertop - UPGRADE #1 - QUORASTONE COTTON KNIT with 1 1/2" DOUBLE BEVEL EDGE - To be installed throughout master ensuite vanity, where applicable (Includes 3" Splash) (See Sketch)  
Note:

1 - MAIN BATH - COUNTERTOP - Install Upgrade Stone Countertop - UPGRADE #1 - QUORASTONE COTTON KNIT with 1 1/2" DOUBLE BEVEL EDGE - To be installed throughout main bath vanity, where applicable (Includes 3" Splash) (See Sketch)  
Note:

1 - DISCLAIMER - STONE COUNTERTOP;  
MASTER ENSUITE / MAIN BATH - Stone slabs vary in size & all seams are visible & the fabricator reserves the right to position the seams as necessary.  
Note:

1 - MASTER ENSUITE - VANITY - Install Upgrade Undermount Sink - CONTRAC CAMDEN Undermount Sink - Model # 4210-CHY - WHITE (x1 Sink) (See Sketch)  
Note: \*\*To be Installed with Builders Standard Vanity Faucet\*\*

1 - MAIN BATH - VANITY - Install Upgrade Undermount Sink - CONTRAC CAMDEN Undermount Sink - Model # 4210-CHY - WHITE (x1 Sink) (See Sketch)  
Note: \*\*To be Installed with Builders Standard Vanity Faucet\*\*

1 - CLARIFICATION;  
POWDER ROOM #1 and POWDER ROOM #2 - Install the builders standard Plumbing Fixtures throughout all bathrooms, where applicable. To Include; Powder Room #1 and Powder Room #2 (See Sketch)  
Note:

1 - PURCHASER TO RECEIVE A FURTHER DISCOUNT OF; \$1,000.00 (Before Taxes) - Approved as per Steve C.  
Note:

1 - BONUS PACKAGE - PURCHASER HAS APPLIED \$10,000.00 (Includes Taxes) WORTH OF UPGRADE PROMOTIONAL PACKAGE TOWARDS THE PURCHASE OF UPGRADES COMPLETED AT THE DECOR CENTRE  
Note:

1 - PURCHASER HAS ATTENDED A COLOR APPOINTMENT AT THE DECOR CENTRE AND HAS DECLINED ANY ADDITIONAL UPGRADES. Purchaser accepts and acknowledges that there will be no further changes/additions/deletions to be made upon signing on December 3, 2019  
Note:



\* INTERIOR COLOUR SCHEME \*

| Purchaser     | Decor Consultant  | Model and Elevation | Telephone Res. / Bus | Project                 | Closing Date | Property   |
|---------------|-------------------|---------------------|----------------------|-------------------------|--------------|------------|
| LINO GIULIANI | Melissa Di Marino | CHESTNUT-ELEV B     | /                    | Forestside Estates Inc. | 30/10/2019   | 39 Block 7 |

|                   | Flooring                                       | Wall Tile                                  | Plumbing      |                   |         |
|-------------------|------------------------------------------------|--------------------------------------------|---------------|-------------------|---------|
|                   | Description                                    | Main                                       | Accent/Insert | Border / Listello | Pattern |
| Master Ensuite    | ✓ 20x20 PULPIS GRIS (STRAIGHT) (UPG)           | ✓ 8x10 CARRARA MATTE (STD)                 | NONE          | NONE              | WHITE   |
| Main Bathroom     | ✓ 20x20 PULPIS GRIS (STRAIGHT) (UPG)           | ✓ 8x10 CARRARA MATTE (STD)                 | NONE          | NONE              | WHITE   |
| Powder Room #1    | ✓ 20x20 PULPIS GRIS (STRAIGHT) (UPG)           | N/A                                        | N/A           | N/A               | WHITE   |
| Powder Room #2    | ✓ 20x20 PULPIS GRIS (STRAIGHT) (UPG)           | N/A                                        | N/A           | N/A               | WHITE   |
|                   |                                                |                                            |               |                   |         |
| Kitchen/Breakfast | ✓ 20x20 PULPIS GRIS (STRAIGHT) (UPG)           | ✓ 12x12 Twilight Oyster Glass Mosaics(Upg) | NONE          | NONE              | UPG     |
| Laundry           | ✓ 20x20 PULPIS GRIS (STRAIGHT) (UPG)           | N/A                                        | N/A           | N/A               | STD     |
|                   |                                                |                                            |               |                   |         |
|                   |                                                |                                            |               |                   |         |
| Foyer             | ✓ 20x20 PULPIS GRIS (STRAIGHT) (UPG)           |                                            |               |                   |         |
| Main Hall         | ✓ 7 1/2" Torleys Forest - Okanogan 9742P (STD) |                                            |               |                   |         |
| Home Office       | ✓ 7 1/2" Torleys Forest - Okanogan 9742P (STD) |                                            |               |                   |         |
| Family Room       | ✓ 7 1/2" Torleys Forest - Okanogan 9742P (STD) |                                            |               |                   |         |
| Living Room       | ✓ 7 1/2" Torleys Forest - Okanogan 9742P (STD) |                                            |               |                   |         |
| Dining Room       | ✓ 7 1/2" Torleys Forest - Okanogan 9742P (STD) |                                            |               |                   |         |
|                   |                                                |                                            |               |                   |         |
|                   |                                                |                                            |               |                   |         |
| Upper Hall        | ✓ 7 1/2" Torleys Forest - Okanogan 9742P (UPG) |                                            |               |                   |         |
|                   |                                                |                                            |               |                   |         |
| Master Bedroom    | ✓ 7 1/2" Torleys Forest - Okanogan 9742P (UPG) |                                            |               |                   |         |
| Bedroom 2         | ✓ 7 1/2" Torleys Forest - Okanogan 9742P (UPG) |                                            |               |                   |         |
| Bedroom 3         | ✓ 7 1/2" Torleys Forest - Okanogan 9742P (UPG) |                                            |               |                   |         |
|                   |                                                |                                            |               |                   |         |
| Rear Yard Access  | ✓ STANDARD                                     |                                            |               |                   |         |


| Railings and Stairs |                                             | Cornice Moulding / Medallion |                                    |
|---------------------|---------------------------------------------|------------------------------|------------------------------------|
| Railings            | ✓ UPG - Modern Rec. Vintage RedOak Cobalt   | Landing - Upper              | ✓ 7 1/2" Okanogan 9742P (STD) (X2) |
| Pickets             | ✓ UPG - Steel - ModernSq./Alt.Plain - Black | Landing - Lower              | ✓ 7 1/2" Okanogan 9742P (STD)      |
| Posts               | ✓ UPG - ModernSq. 3 1/2" Vint.RedOak Cobalt | Ledge - Upper                | N/A                                |
| Stringers           | ✓ UPG - VINTAGE RED OAK COBALT              | Ledge - Lower                | N/A                                |
| Treads              | ✓ UPG - VINTAGE RED OAK COBALT              |                              |                                    |
| Risers              | ✓ UPG - VINTAGE RED OAK COBALT              |                              |                                    |
| Runner              | NO                                          |                              |                                    |
| Trim                |                                             |                              |                                    |
| Baseboard & Casing  | ✓ UPG - 3" Backbend / 5 1/4" Baseboard      | Knobs                        | ✓ STANDARD                         |
| Front Door Glass    | ✓ STANDARD                                  | Hinges                       | ✓ STANDARD                         |
| Interior Doors      | ✓ STANDARD - CARRARA                        | Grip Set                     | ✓ STANDARD                         |


  

| Notes                                                                                                                                                          |
|----------------------------------------------------------------------------------------------------------------------------------------------------------------|
| ✓ KITCHEN - KITCHEN SINK - Install Upgrade Undermount Sink - BLANCO HORIZON U2 Undermount Sink - Model # 401234                                                |
| ✓ KITCHEN - KITCHEN FAUCET - Install the Builders Standard Faucet in the kitchen - DELTA Chrome Pull Down Kitchen Faucet (Single Hole) - Model # 976 LF Chrome |

Page 1 of 3

Consultant:   
Melissa Di Marino

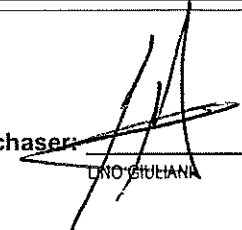Purchaser:   
LINO GIULIANI

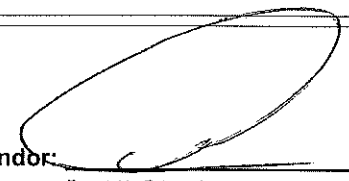Vendor:   
Forestside Estates Inc.



\* INTERIOR COLOUR SCHEME \*

| Purchaser     | Decor Consultant  | Model and Elevation | Telephone Res. / Bus | Project                 | Closing Date | Property   |
|---------------|-------------------|---------------------|----------------------|-------------------------|--------------|------------|
| LINO GIULIANI | Melissa Di Marino | CHESTNUT-ELEV B     | /                    | Forestside Estates Inc. | 30/10/2019   | 39 Block 7 |

Page 2 of 3

Master Ensuite

Main Bathroom

Powder Room #1

Powder Room #2

Kitchen/Breakfast

Laundry

Foyer

Main Hall

Home Office

Family Room

Living Room

Dining Room

Upper Hall

Master Bedroom

Bedroom 2

Bedroom 3

Rear Yard Access

Interior Paint

Description

COOL WHITE

COOL WHITE

Cabinet

Style

EURO - MELAMINE - LICORICE - WF-392 (STD)

EURO - MELAMINE - LICORICE - WF-392 (STD)

N/A

N/A

EURO - MELAMINE - ARCTIC - WF-394 (STD)

N/A

N/A

Appliance Opening/Dimension

Fridge Size SEE NOTES

Range Std 31in Opening

Built-Ins None

Microwave None

Hood Fan SEE NOTES

Exhaust Opening 6" 8"

Dishwasher Cabinet Std 24in Opening

Fireplace

Fireplace

N/A

Location Flooring

N/A

Style

N/A

Finish

N/A

Marble

N/A

Hearth

N/A

Fireplace

N/A

Location Flooring

N/A

Style

N/A

Finish

N/A

Marble

N/A

Hearth

N/A

Page 2 of 3

Decor Consultant:

Melissa Di Marino

Purchaser:

LINO GIULIANI

Notes

\*\*KITCHEN - INSTALL STANDARD APPLIANCE PACKAGE, TO BE INSTALLED THROUGHOUT HOUSE WHERE APPLICABLE

\*\*KITCHEN - ACCOMMODATE FRIDGE OPENING FOR FUTRE 36" WIDE FRIDGE

\*\*KITCHEN - INSTALL UPGRADE STAINLESS STEEL EXHAUST FAN

Vendor:

Forestside Estates Inc.

Printed Dec 03, 2019 10:04 am

Lot 39 / Blk 7 Forestside

*Villa*  
KITCHENS & FINE CABINETRY LTD

8111 Jane St. Unit 10  
Concord, Ontario L4K 4L7  
Tel. (905) 669- 7028  
Fax. (905) 669 - 7903  
email: designstudio@villakitchens.ca  
www.villakitchens.ca

CLIENT: ROYAL PINE HOMES  
PROJECT: FORESTSIDE  
ADDRESS: RP-FS(6)-39  
MODEL: CHESTNUT 1803 ELEV. B


KITCHEN  
DOOR STYLE: EURO  
DOOR PROFILE: N/A  
FINISH COLOUR: ARCTIC WF-394  
DOOR MATERIAL: MELAMINE

EXTRAS:  
ENLARGED FRIDGE OPENING TO  
ACCOMMODATE 36" FRIDGE.

December 9, 2019



DRAWN BY: NEERAJ  
DATE: 4 DEC,19  
REVISION:  
PAGE: 1 OF 6

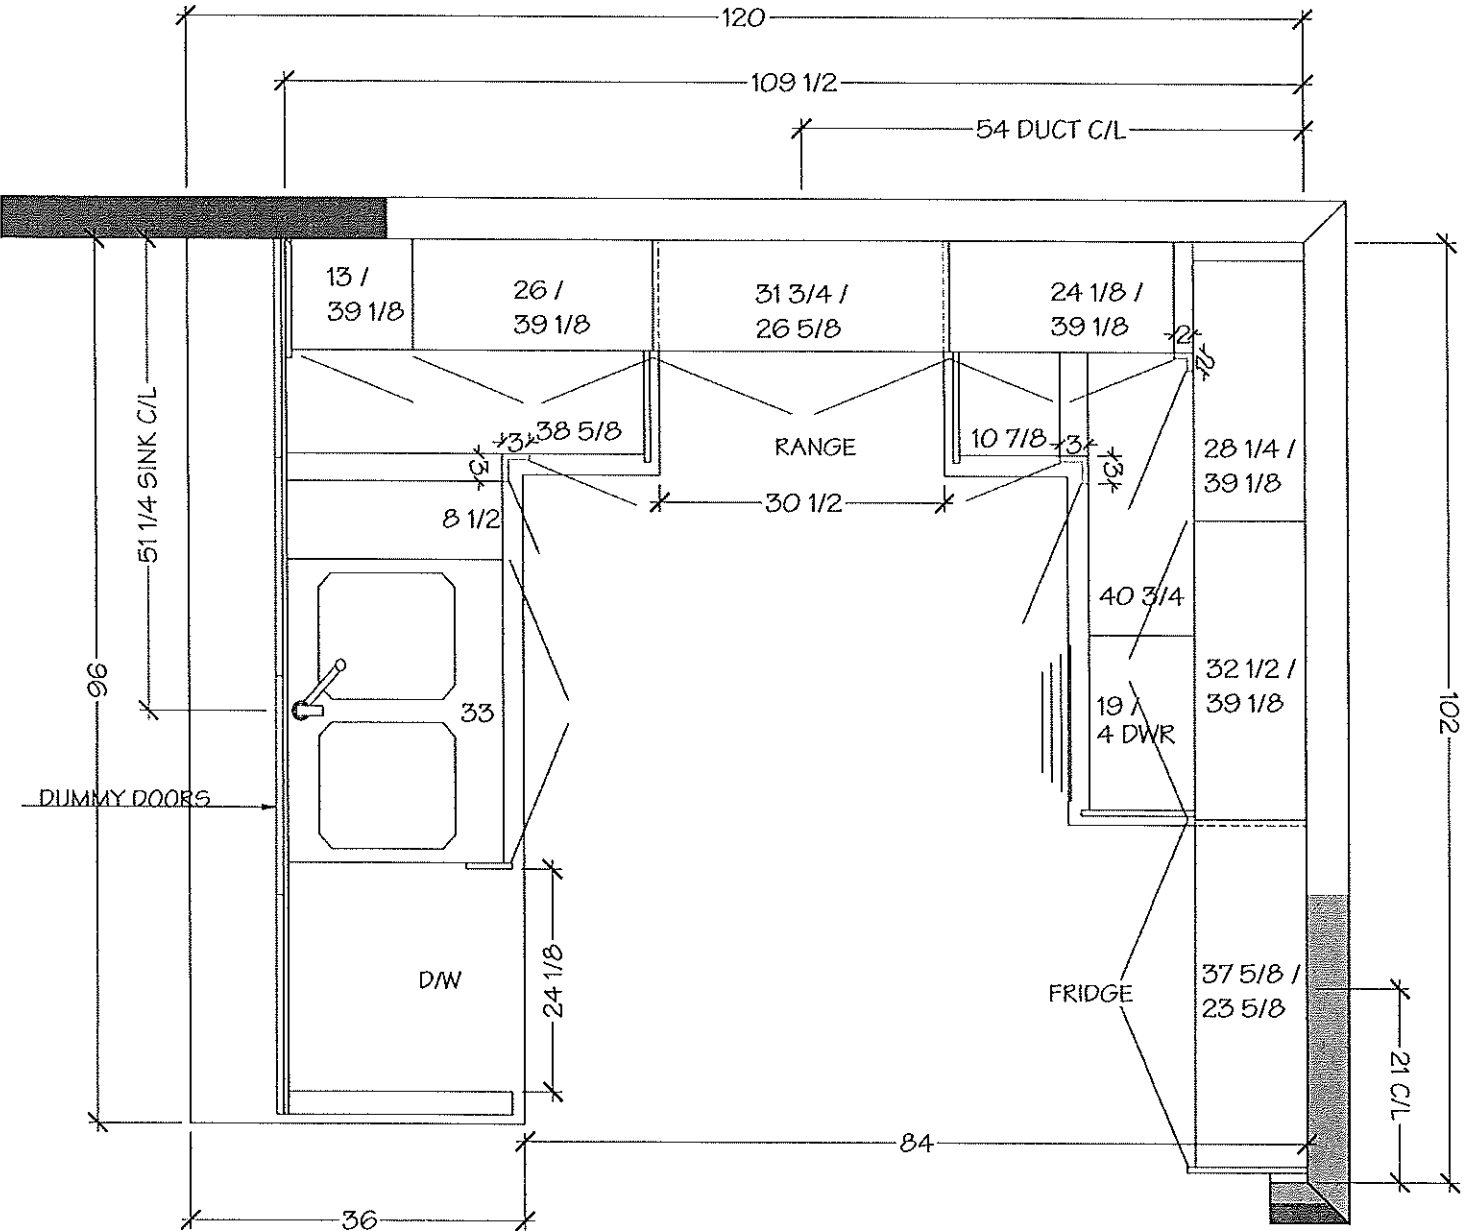



Lot 39 / Blk 7 Forestside

*Villa*

KITCHENS & FINE CABINETS LTD

8111 Jane St. Unit 10  
Concord, Ontario L4K 4L7  
Tel. (905) 669-7028  
Fax. (905) 669-7903  
email: designstudio@villakitchens.ca  
www.villakitchens.ca

CLIENT: ROYAL PINE HOMES  
PROJECT: FORESTSIDE  
ADDRESS: RP-FS(6)-39  
MODEL: CHESTNUT 1803 ELEV. B

KITCHEN


DOOR STYLE: EURO  
DOOR PROFILE: N/A  
FINISH COLOUR: ARCTIC WF-394  
DOOR MATERIAL: MELAMINE

EXTRAS:  
ENLARGED FRIDGE OPENING TO  
ACCOMMODATE 36" FRIDGE.

December 9, 2019



DRAWN BY: NEERAJ  
DATE: 4 DEC, 19  
REVISION:  
PAGE: 3 OF 6

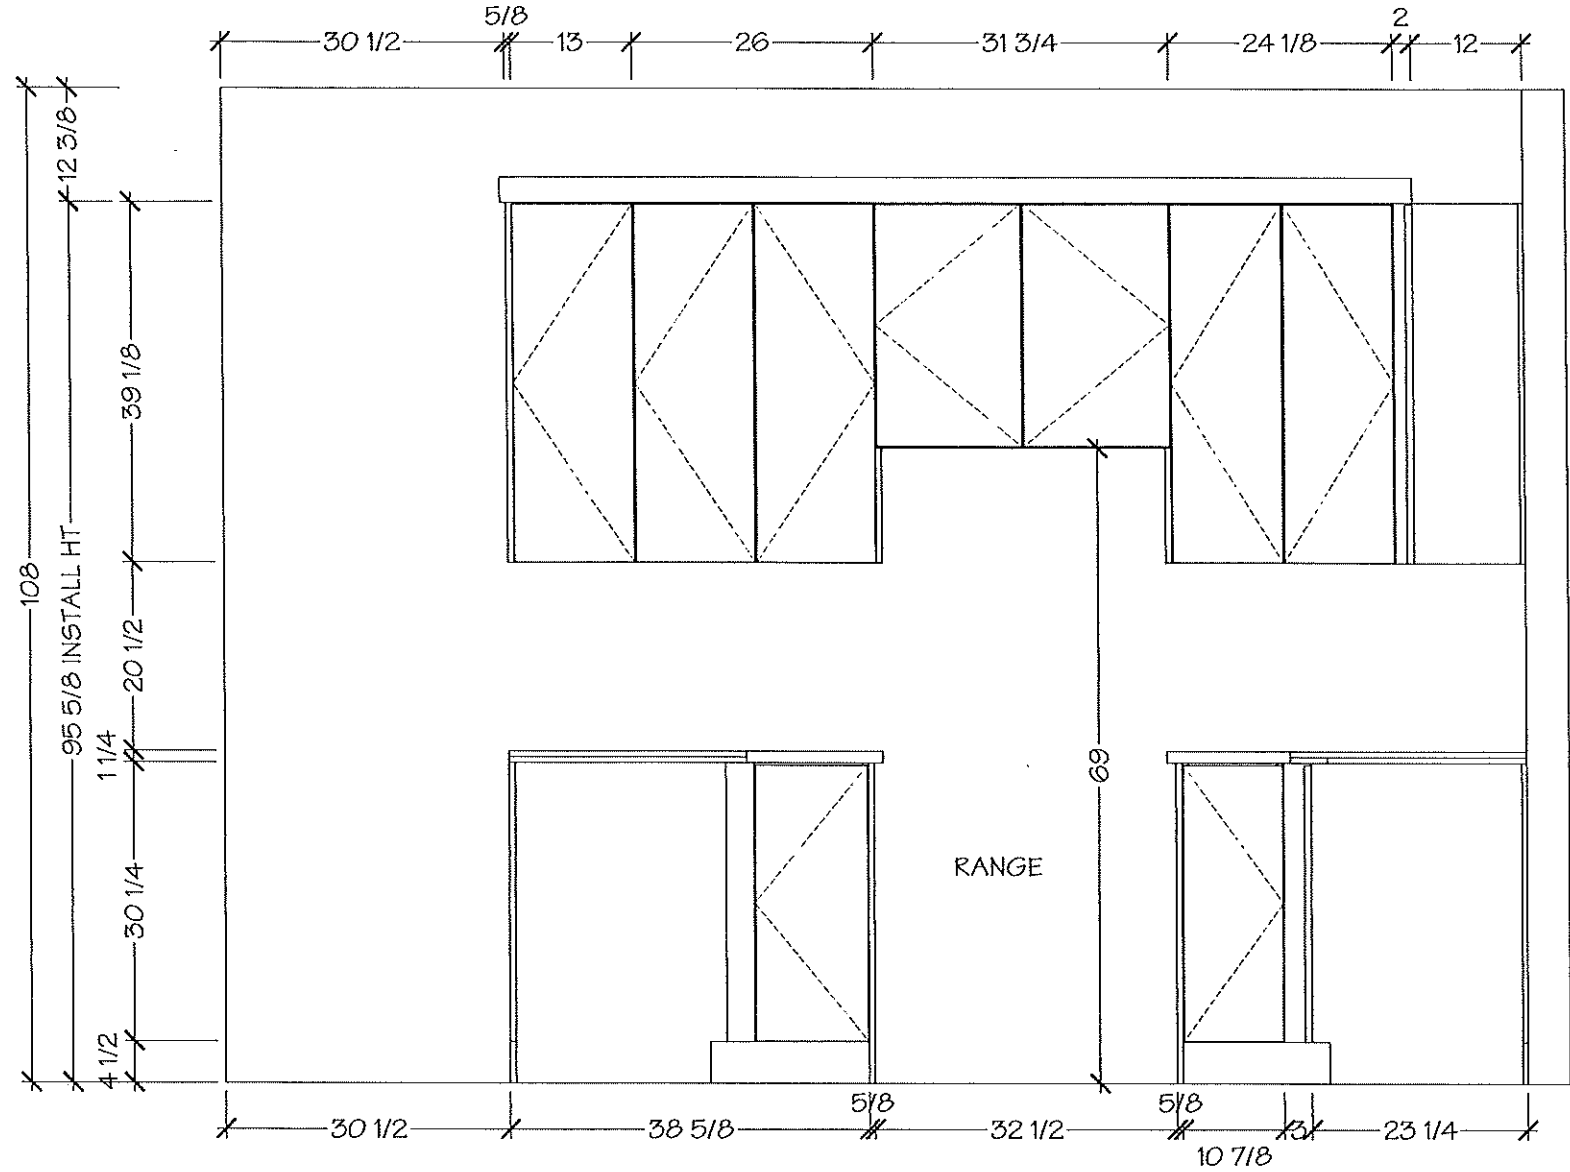

Lot 39 / BIK7 Forestside

*Villa*  
KITCHENS & FINE CABINETRY LTD

8111 Jane St. Unit 10  
Concord, Ontario L4K 4L7  
Tel. (905) 669- 7028  
Fax. (905) 669 - 7903  
email: designstudio@villakitchens.ca  
www.villakitchens.ca

CLIENT: ROYAL PINE HOMES  
PROJECT: FORESTSIDE  
ADDRESS: RP-FS(6)-39  
MODEL: CHESTNUT 1803 ELEV. B

KITCHEN


DOOR STYLE: EURO  
DOOR PROFILE: N/A  
FINISH COLOUR: ARCTIC WF-394  
DOOR MATERIAL: MELAMINE

EXTRAS:  
ENLARGED FRIDGE OPENING TO  
ACCOMMODATE 36" FRIDGE.

December 9, 2019



DRAWN BY: NEERAJ  
DATE: 4 DEC, 19  
REVISION:  
PAGE: 4 OF 6

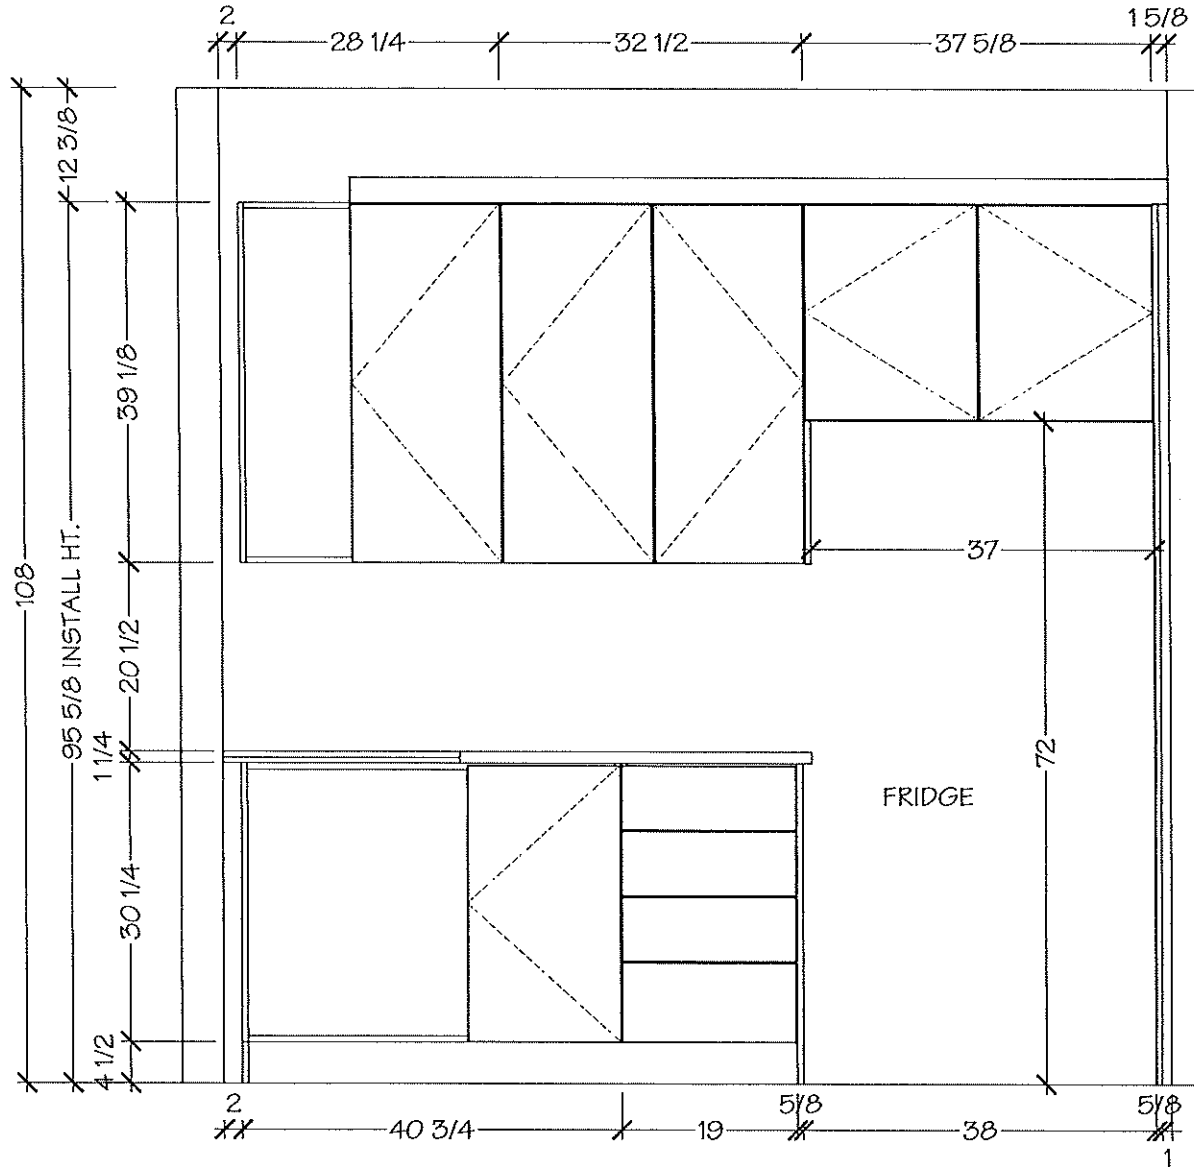

Lot 39 / B1K7 Forestside



8111 Jane St. Unit 10  
Concord, Ontario L4K 4L7  
Tel. (905) 669-7028  
Fax. (905) 669-7903  
email: designstudio@villakitchens.ca  
www.villakitchens.ca

CLIENT: ROYAL PINE HOMES  
PROJECT: FORESTSIDE  
ADDRESS: RP-FS(6)-39  
MODEL: CHESTNUT 1803 ELEV. B

KITCHEN


DOOR STYLE: EURO  
DOOR PROFILE: N/A  
FINISH COLOUR: ARCTIC WF-394  
DOOR MATERIAL: MELAMINE

EXTRAS:  
ENLARGED FRIDGE OPENING TO  
ACCOMMODATE 36" FRIDGE.


December 9, 2019



DRAWN BY: NEERAJ  
DATE: 4 DEC,19  
REVISION:  
PAGE: 2 OF 6

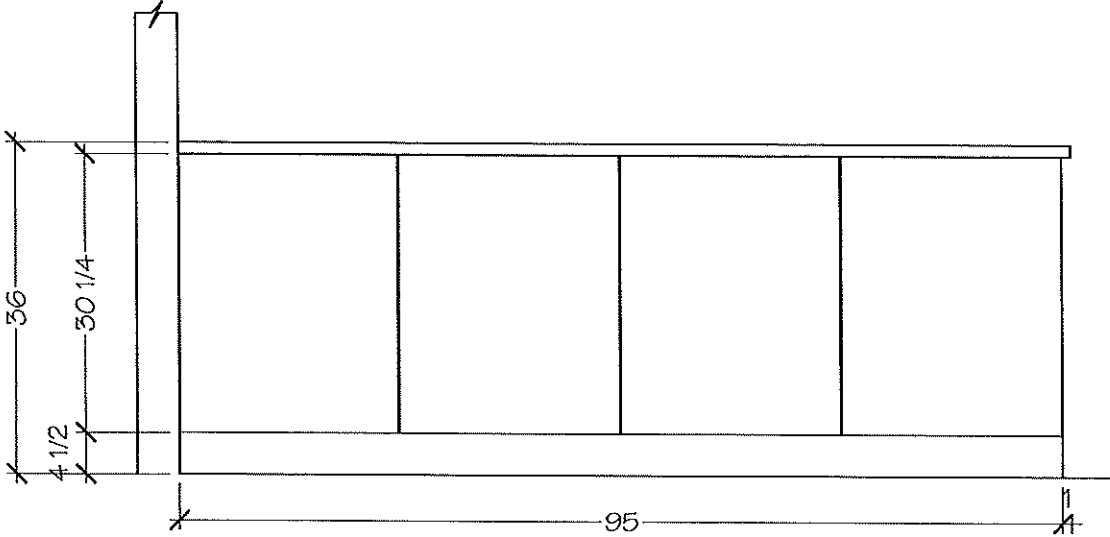

BACK ELEVATION

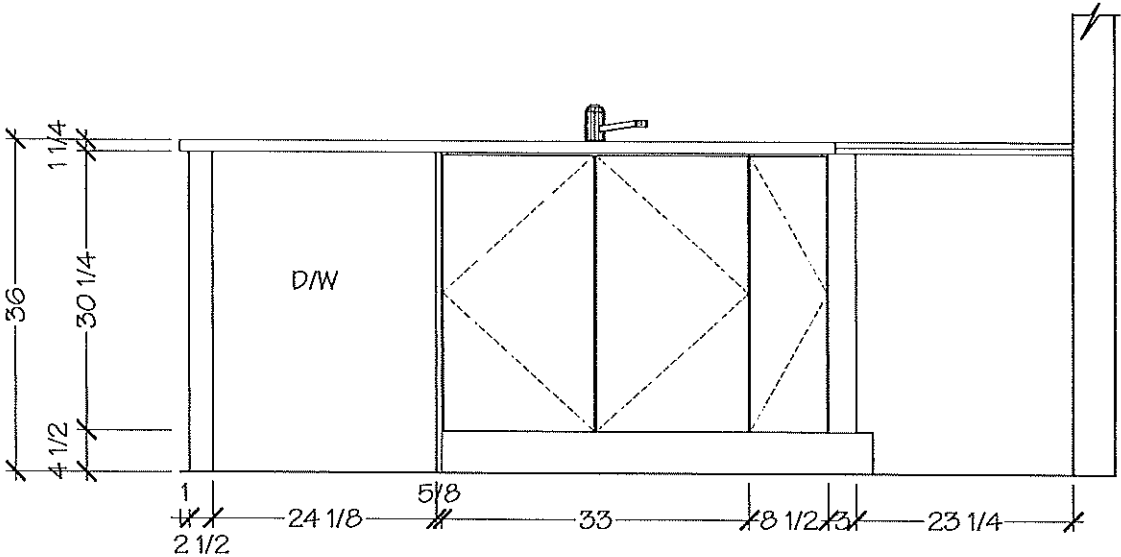

FRONT ELEVATION



Lot 39 / BIK 7 Forestside

Villa

KITCHENS & FINE CABINETS LTD

8111 Jane St. Unit 10  
Concord, Ontario L4K 4L7  
Tel. (905) 669- 7028  
Fax. (905) 669 - 7903  
email: designstudio@villakitchens.ca  
www.villakitchens.ca

CLIENT: ROYAL PINE HOMES  
PROJECT: FORESTSIDE  
ADDRESS: RP-FS(6)-39  
MODEL: CHESTNUT 1803 ELEV. B


MASTER ENSUITE

DOOR STYLE: EURO  
DOOR PROFILE: N/A  
FINISH COLOUR: LICORICE WF-392  
DOOR MATERIAL: MELAMINE


December 9, 2019



DRAWN BY: NEERAJ  
DATE: 4 DEC,19  
REVISION:  
PAGE: 5 OF 6

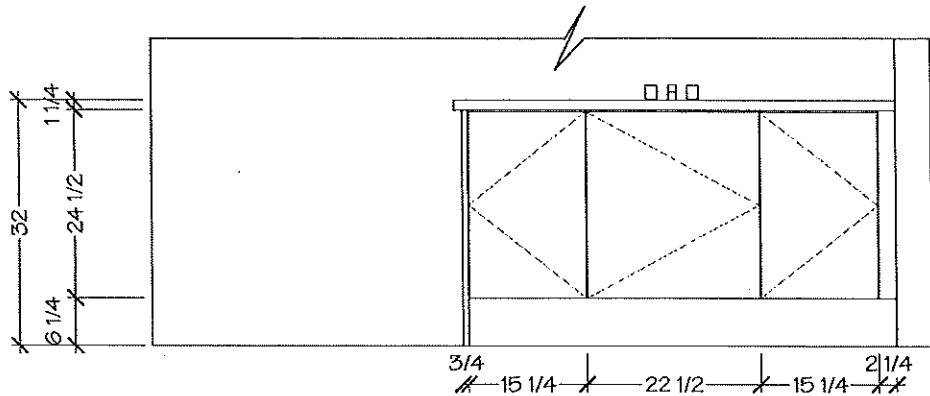

FRONT ELEVATION

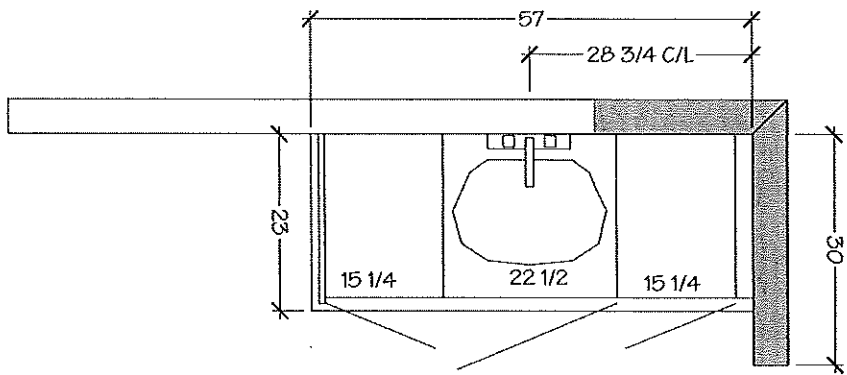

MASTER ENSUITE-PLAN

Lot 39 / B1K7 Forestside

*Villa*

KITCHENS & FINE CABINETRY LTD

8111 Jane St. Unit 10  
Concord, Ontario L4K 4L7  
Tel. (905) 669-7028  
Fax. (905) 669-7903  
email: designstudio@villakitchens.ca  
www.villakitchens.ca

CLIENT: ROYAL PINE HOMES  
PROJECT: FORESTSIDE  
ADDRESS: RP-FS(6)-39  
MODEL: CHESTNUT 1803 ELEV. B

### MAIN BATH

DOOR STYLE: EURO  
DOOR PROFILE: N/A  
FINISH COLOUR: LICORICE WF-392  
DOOR MATERIAL: MELAMINE

December 9, 2019




DRAWN BY: NEERAJ


DATE: 4 DEC, 19

REVISION:

PAGE: 6 OF 6

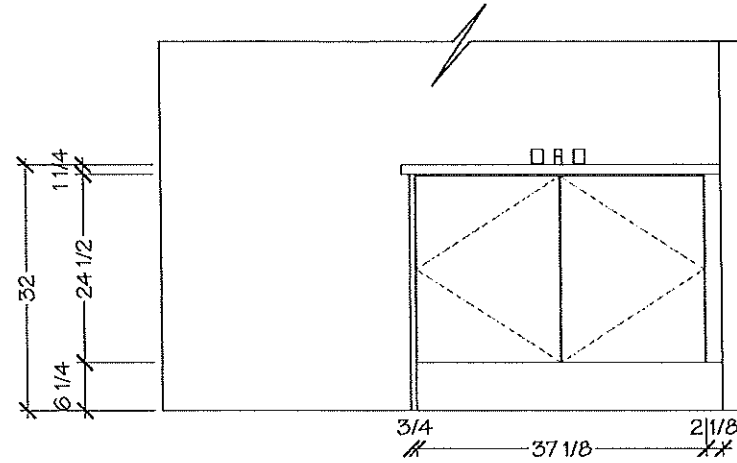

FRONT ELEVATION

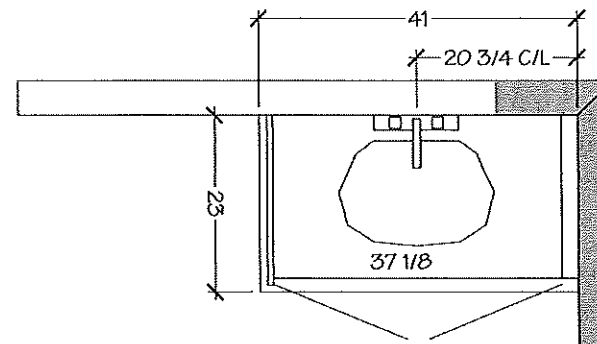

MAIN BATH-PLAN

SINK | UNDERMOUNT

\*Buildas Standard Faucet\*



Lot 39/BIK 7 Forestside

CAMDEN

#### ITEM DETAILS

OUTER DIMENSIONS 16" W x 16" D x 7½" H

INNER DIMENSIONS 14" W x 14" D x 5½" H

MATERIAL: Vitreous china


COLOR: Soft white

Square undermount sink | Front overflow hole | Template and mounting hardware supplied | Faucet not included

#### CERTIFICATIONS

| IAPMO cUPC

| ASME A112.19.2 / CSA B45.1

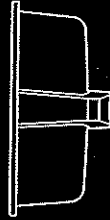

Master Ensuite (x1)  
Main Bath (x1)

December 3, 2019



16" SINK  
4210CHY

ISSUED MAY 2019

contrac. | CONTRAC.CA  
| CONTRAC.US


2019 CONTRAC CATALOGUE

85

# HORIZON™ Undermount

## Lot 39 / BIK7 Forestside

HORIZON™ U 2

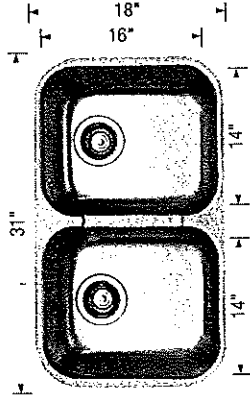

Undermount

Minimum Cabinet Size\*

33" (840 mm)

Bowl Depth

8" (205 mm)

Cubed Weight

49 lb. (22 kg)

Note: 18 gauge stainless steel

Model

401234

Installed


CapFlow™

406406 Grid

517666 CapFlow™

*Kitchen  
Builders Standard Faucets*

HORIZON™ U 1.5

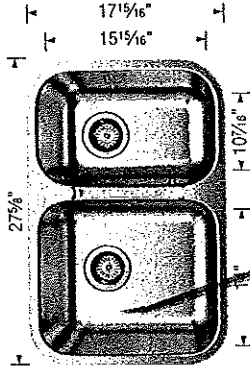

Undermount

Minimum Cabinet Size\*

30" (760 mm)

Bowl Depth

8" (205 mm)

Cubed Weight

61 lb. (28 kg)

Note: 18 gauge stainless steel

Model

402148

Installed


CapFlow™

406409 Grid (LB)

406407 Grid (SB)

517666 CapFlow™

HORIZON™ U 1

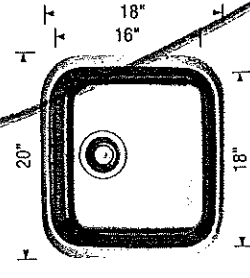

Undermount

Minimum Cabinet Size\*

27" (610 mm)

Bowl Depth

8" (205 mm)

Cubed Weight

20 lb. (9 kg)

Note: 20 gauge stainless steel

Model

401251

Installed

CapFlow™

517666 CapFlow™

December 3, 2019

\* Depending on cabinet construction, a different cabinet size may be required. Consult the cabinet manufacturer. | \*\* installed price subject to change.



Lot 39 / BIK 7  
Forestside

December 3, 2019




ARISTON  
MARBLE & GRANITE LTD.  
119 WINGES RD.  
WOODBRIIDGE, ONTARIO L4L 6S2



1 1/2" MITRE


TYPE

1 1/2" BELVEDERE

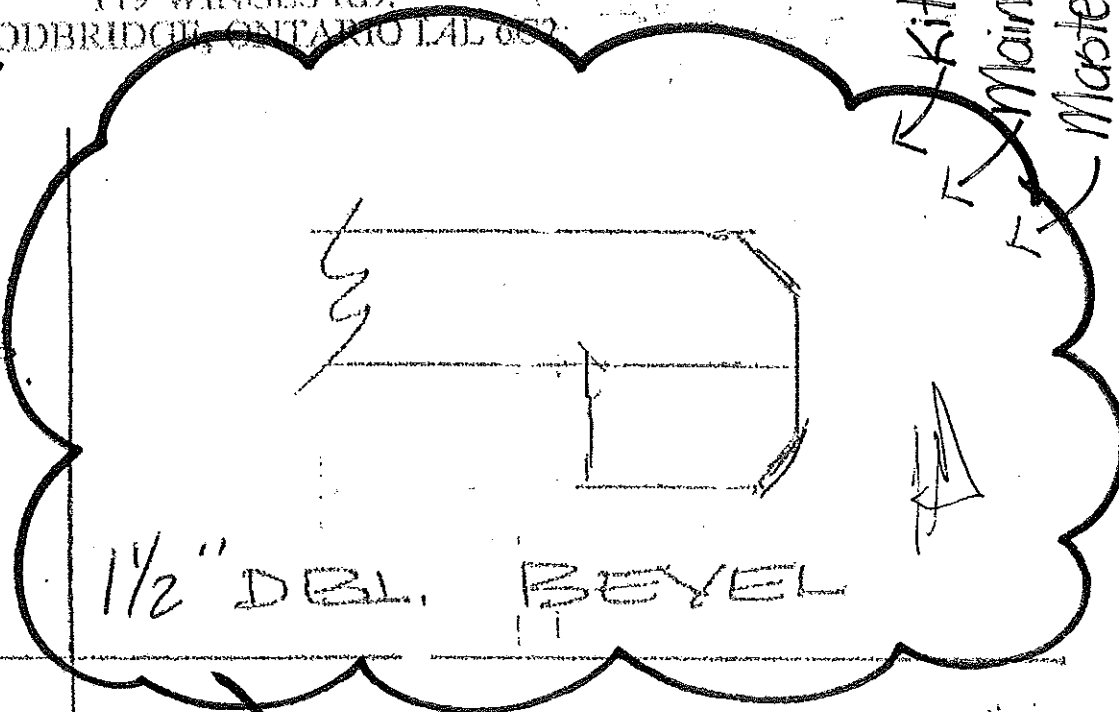

1 1/2" DBL. BEVEL

Kitchen  
Main Bath  
Master Ensuite

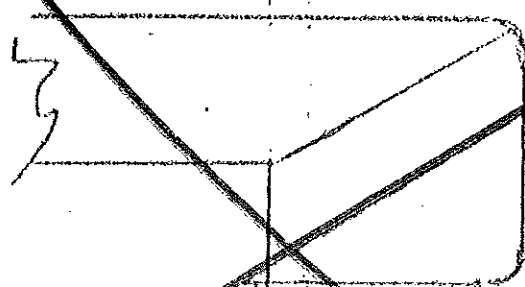

1 1/2" SQUARE MITRE