


- 1ST UPG. APPLIANCE PACKAGE WITH: 36" FRIDGE, CHIMNEY HOOD FAN, MICROWAVE SHELF
- 2 CAPPED PENDANT LIGHTS
- x 5 PUCK LIGHTS
- 64" STOVE CENTER
- 129" SINK PIPE CENTER
- x1 PLUG IN PENINSULA
- MAIN AND ENSUITE RAISED VANITYS 36 1/4" WITH ~~DELETE 3" SPLASH~~
- KITCHEN UPGRADES:
MAGIC BASE CORNER'
UPPER CORNER 'L' SHAPED CABINET
PANTRY w/ MICRO SHELF

***REVISED LAUNDRY DOOR SWING &
ENSUITE WALL AS PER THIS BROCHURE**

**ADD 1 CONDUIT IN LIVING/
DINING ROOM + PLUG +BLOCKING
FOR FUTURE MOUNTED TV**

* SEE
KITCHEN LAYOUT
WITH UPGRADES.

February 5, 2020

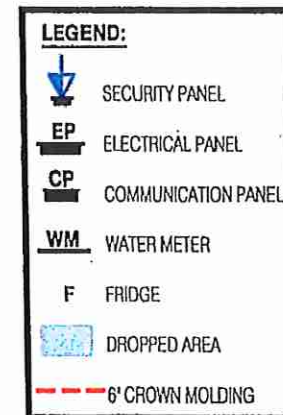



vincent's
SITE COPY

CONSTRUCTION SUMMARY

Braylea Investments Inc.

PURCHASERS: LESLEE R. WELLS and RICHARD W. WELLS

TEL: RES.: 416-795-5441

LOT NUMBER	PHASE	HOUSE TYPE	CLOSING DATE
606	1	NOYAC BAY	28-May-20

Offer Workshee	CONDUIT AND BLOCKING FOR WALL MOUNTED TV (60 INCHES ABOVE FF) IN LIVING ROOM, AS PER PLAN Note:		
Offer Workshee	PURCHASER TO SELECT COLOURS AT DECOR CENTER FROM BUILDERS SAMPLES , EXCEPT FOR FLOORING IN MAIL FOYER AND COLOURS IN BOTH BATHROOMS Note:		
Offer Workshee	TWO (2) CAPPED CEILING LIGHTS ABOVE THE KITCHEN SINK ON SAME SWITCH, AS PER PLAN Note:		
Offer Workshee	TALLER 36? VANITIES IN ALL BATHROOMS AS PER VENDORS STANDARD SAMPLES AND SPECIFICATIONS, AS PER PLAN Note:		
Offer Workshee	1ST UPGRADE APPLIANCE PACKAGE WITH 36 INCH FRIDGE, AS PER VENDORS SAMPLES Note:		
Offer Workshee	WATER LINE FOR FRIDGE Note:		
Offer Workshee	STAINLESS STEEL CHIMNEY HOOD FAN AND MICROWAVE SHELF WITH TRIM KIT IN LIEU OF STANDARD COMBINATION MICROWAVE/HOOD FAN, (INCLUDES ELECTRICAL), AS PER VENDORS SPECIFICATIONS AND SAMPLES Note:		
Offer Workshee	RAINHEAD INSTALLED FROM CEILING IN MASTER ENSUITE AND COMPLETED WITH VENDORS STANDARD PLUMBING SAMPLES. Note:		
Offer Workshee	UPGRADE KITCHEN LAYOUT AS PER VENDORS SAMPLES AND SPECIFICATIONS AND ANTI SLAM HINGES AND DRAWER SLIDERS AS APPLICABLE IN THE BATHROOM VANITIES. Note:		



VINYL
SITE COPY

CONSTRUCTION SUMMARY

Braylea Investments Inc.

PURCHASERS: LESLEE R. WELLS and RICHARD W. WELLS

TEL: RES.: 416-795-5441

LOT NUMBER	PHASE	HOUSE TYPE	CLOSING DATE
606	1	NOYAC BAY	28-May-20

Date Added: 06-Feb-20 Invoice Number: 7407

1 - KITCHEN - Install LAMINATE FLOORING - 7 1/2" TORLYS FOREST OKANOGAN 9742P - To be Installed Throughout kitchen flooring, where applicable in lieu of builders standard tiles (See Sketch)
Note:

1 - KITCHEN - Install Standard Stone Countertop - ASPEN TRIBECA - To be installed throughout kitchen, where applicable. (Does not include stone backsplash) (See Sketch)
Note:

1 - DISCLAIMER - STONE COUNTERTOP:
KITCHEN - Stone slabs vary in size & all seams are visible & the fabricator reserves the right to position the seams as necessary.
Note:

1 - KITCHEN - KITCHEN SINK - Install Upgrade Undermount Sink - BLANCO QUATRUS U SUPER SINGLE Undermount Sink - Model # 401248 (See Attached)
Note:

1 - KITCHEN - KITCHEN FAUCET - Install Builders Standard Kitchen Faucet - Delta Chrome Pull Out Kitchen Faucet (Single Hole) - Model # 469LF - Chrome
Note:

1 - KITCHEN - CABINETRY - Install UPGRADE #1 CABINETRY PACKAGE - CATEGORY 3 FIBERBOARD - CLOUD WHITE QT 4801 - To be installed throughout kitchen, where applicable. (See Sketch)
Note:

1 - KITCHEN - KITCHEN BACKSPLASH - DELETE Do Not Install / Supply / Credit Purchaser for Builders Standard Kitchen Backsplash (See Sketch)
Note:

1 - MAIN BATH - Install Standard Stone Countertop - ASPEN TERRA WHITE- To be installed throughout main bath vanity, where applicable. (Does not include 3" Splash) (See Sketch)
Note:

1 - MASTER ENSUITE - Install Standard Stone Countertop - ASPEN CYRUS GREY To be installed throughout master ensuite vanity, where applicable. (Does not include 3" Splash) (See Sketch)
Note:

1 - MASTER ENSUITE- Install the Delta Contemporary Round 14 Series Pressure Balance Kit Intergrated Diverter Valve Ceiling mount & wall mount shower arm Model # DF-KIT18
Note: No Charge

1 - CLARIFICATION:
MAIN BATH & MASTER ENSUITE - DELETE Standard 3" Stone Splash above all vanity countertops. To include: Main Bath and Master Ensuite.
Note:

1 - DISCLAIMER - STONE COUNTERTOP:
MAIN BATH & MASTER ENSUITE - Stone slabs vary in size & all seams are visible & the fabricator reserves the right to position the seams as necessary.
Note:

1 - CLARIFICATION:
MAIN BATH & MASTER ENSUITE - DELETE Do Not Install / Supply / Credit Purchaser for builders standard ceramic bathroom accessories (toilet paper, towel bar & soap dish) throughout all bathrooms where applicable
Note: To Include; Main Bath & Master Ensuite (See Sketch)

1 - PURCHASER HAS ATTENDED A COLOR APPOINTMENT AT THE DECOR CENTRE AND HAS DECLINED ANY ADDITIONAL UPGRADES. Purchaser accepts and acknowledges that there will be no further changes/additions/deletions to be made upon signing on February 5,2020
Note:



* INTERIOR COLOUR SCHEME *

Purchasers	Decor Consultant	Model Type	Telephone Res. / Bus	Project	Closing Date	Unit
LESLEE R. WELLS & RICHARD W. WELLS	Melissa Di Marino	NOYAC BAY	(416) 795-5441 /	Braylea Investments Inc.	28/05/2020	606

Page 1 of 3

Flooring		Wall Tile		
	Description	Main	Accent/Insert	Pattern
MASTER ENSUITE	✓ 24X24 CALACATTA POLISHED (UPGD)	24X24 CALACATTA POLISHED (UPGD)	NONE	NONE
MAIN BATHROOM	✓ 24X24 LONDON GREY (UPGD)	24X24 LONDON GREY (UPGD)	NONE	NONE
POWDER ROOM	N/A	N/A	N/A	N/A
KITCHEN / DINETTE	✓ 7 1/2" Torlys Forest - Okanogan 9742P (UPG)	Delete - Do Not Install / Supply / Credit	NONE	NONE
FOYER	✓ 24X24 LANCASTER (UPGD)	N/A	N/A	N/A
LAUNDRY	✓ 24X24 LANCASTER (UPGD)	N/A	N/A	N/A
LIVING ROOM	✓ 7 1/2" Torlys Forest - Okanogan 9742P (STD)	Notes		
DINING ROOM	✓ 7 1/2" Torlys Forest - Okanogan 9742P (STD)			
DEN	N/A			
MASTER BEDROOM	✓ 7 1/2" Torlys Forest - Okanogan 9742P (STD)			
BEDROOM 2	✓ 7 1/2" Torlys Forest - Okanogan 9742P (STD)			
BEDROOM 3	N/A			

Page 1 of 3

Consultant:

Melissa Di Marino

Purchaser:

LESLEE R. WELLS

Purchaser:

RICHARD W. WELLS

Vendor:

Braylea Investments Inc.

Printed Feb 05, 2020 12:20 pm



* INTERIOR COLOUR SCHEME *

Purchasers	Decor Consultant	Model Type	Telephone Res. / Bus	Project	Closing Date	Unit
LESLEE R. WELLS & RICHARD W. WELLS	Melissa Di Marino	NOYAC BAY	(416) 795-5441 /	Braylea Investments Inc.	28/05/2020	606

Page 2 of 3

CABINETRY, VANITIES AND COUNTERTOPS

	Style	Countertop	Counter Edge	Handle / Knob
MAIN BATHROOM	CATEGORY 2 - MAPLE - PISTACHIO QT 2503 (STD)	☒ ASPEN TERRA WHITE (STD)	☒ A * EDGE (STD)	39660-195
MASTER ENSUITE	CATEGORY 1 - FIBERBOARD - WHITE QT 1203 (STD)	☒ ASPEN CYRUS GREY (STD)	☒ A * EDGE (STD)	3487-128
POWDER ROOM	N/A	N/A	N/A	N/A
KITCHEN / DINETTE	CATEGORY 3 - FIBERBOARD - CLOUD WHITE QT 4201 (UPG)	☒ ASPEN TRIBECA (STD)	☒ A * EDGE (STD)	3487-128
LAUNDRY ROOM	N/A	N/A	N/A	N/A

APPLIANCE PACKAGE

Upgrade #1
Package w/
36" Fridge
* See Attached Specs *

Std 31in Opening

PLUMBING FIXTURES

KITCHEN

Sink Model ☒ Blanco Super Single #401248 (UPG)
Sink Faucet ☒ STANDARD

TOILETS

Master Ensuite ☒ CALI #4710BOVU (UPGD)
Main Bathroom ☒ CALI #4710BOVU (UPGD)
Powder Room N/A

VANITY FAUCETS

Master Ensuite ☒ STANDARD
Main Bathroom ☒ STANDARD
Powder Room N/A

VANITY SINKS

Master Ensuite ☒ STANDARD
Main Bathroom ☒ STANDARD
Powder Room N/A

SHOWER STALL / TUBS

Master Ensuite Shower Stall ☒ Delta Contemporary Kit #DF-KIT18
Master Ensuite Tub ☒ N/A
Main Bathroom Tub ☒ STANDARD

Trim

Baseboard & Casing ☒ STANDARD
Interior Doors ☒ STANDARD

Levers ☒ STANDARD
Door Height ☒ STANDARD

Cornice Moulding / Medallion

Foyer ☒ STANDARD - #CTR-611
Living Room ☒ STANDARD - #CTR-611
Dining Room ☒ STANDARD - #CTR-611
Den N/A
Master Bedroom N/A
Bedroom 2 N/A
Bedroom 3 N/A

Fireplace

Fireplace N/A
Location Flooring N/A
Style N/A
Finish N/A
Marble N/A
Hearth N/A

MISC. INSTALLATIONS

Ceramic Accessories
(installed by Vendor)
☒ Yes ☐ No

Bathroom Mirrors
(installed by Vendor)
☐ Yes ☐ No

Wire Shelving - Closet
(installed by Vendor)
☐ Yes ☐ No

Paint Throughout

Walls DLX- 1001-2 ARIA
Trim STANDARD WHITE

Page 2 of 3

Decor Consultant:
Melissa Di Marino

Purchaser:
LESLEE R. WELLS

Purchaser:
RICHARD W. WELLS

Vendor:
Braylea Investments Inc.
Printed Feb 05, 2020 12:20 pm



Quality Tops & Kitchens Ltd.
80 Sante Drive, Vaughan, ON L4K 3C4
T 416.746.1811 F 905.761.5901
www.QTK.ca info@qtk.ca

your kitchen, your taste.

PURCHASE AGREEMENT FORM

PURCHASER:		CONTRACTOR:	
ADDRESS:		BRAYLEA INVESTMENTS INC.	
EMAIL:		SITE: HAMPTON PLACE	
PHONE #:		MODEL TYPE: NOYAC BAY (2G+D)	
PHONE #:		LOT #: 606 HMP UPGRADE PKG 1	
PHONE #:		DATE: May 28, 2019 Q5186	

The purchaser agrees to buy and Quality Tops & Kitchens Ltd. (QTK) agrees to sell and provide for the purchaser the following articles listed herein and with attached drawing in accordance to the terms and conditions described on the reverse of this agreement form.

ROOM	DESCRIPTION	CATEGORY
KITCHEN	DOOR STYLE: QT 4801 FINISH: CLOUD WHITE SPECIES: Fibreboard DOOR HARDWARE: 3487-128 DRW HARDWARE: COUNTER TOP: Counter Top by Others	CATEGORY 3

ITEM #	QTY	DESCRIPTION	PRICE
VB	1	VALANCE BOX UPPEERS & PUCK LIGHT CUTOUTS (ELEC. & LIGHTS NOT INCL.) - (OPTION PAID FOR BY BUILDER)	
FG2696	1	FRIDGE GABLE - 26" DEEP x 95-1/2"H. - (OPTION PAID FOR BY BUILDER)	
FC2623	1	FRIDGE CABINET - 26" DEEP x 23"H. - (OPTION PAID FOR BY BUILDER)	
BCR-MC1	1	MAGIC CORNER: 1 PULL-OUT UNIT w/ 4 S.S. ANTI-SLIP BASKETS	
BLOC	1	BASE L-SHAPE CORNER CABINET w/ 1 ADJ. SHELF	
ULCC-12	1	UPPER L-SHAPE CORNER CABINET 28" x 26" - 12" DEEP	
UC-14WK	1	INCREASE DEPTH OF UPPER CABINET TO 13-3/4" DEEP (WHOLE KITCHEN) - 113 WHITE LP INTERIOR	
CUST-1	1	BLUM MOTION ANTI SLAM HINGES & 1 SET OF BLUM WHITE ANTARO DRAWER SLIDES	
CUST-2	1	PULL-OUT SPICE UNIT w/ 2 FIXED BASKETS INCL. BLUM WHITE ANTARO ANTI SLAM SLIDES- 15"	
CUST-3	1	TALL CABINET w/ 1 OPENING FOR MICROWAVE & 2 DRAWERS BELOW (SPECS REQUIRED)	
ROOM SUMMARY:			

ROOM	DESCRIPTION	CATEGORY
Main Bath VANITY	DOOR STYLE: QT 2503 FINISH: PISTACHIO SPECIES: MAPLE DOOR HARDWARE: 39660-195 DRW HARDWARE: COUNTER TOP: BY OTHERS	CATEGORY 2

ITEM #	QTY	DESCRIPTION	PRICE
VB-RAISE8	1	RAISE VANITY HEIGHT TO 34-1/2" - PER VANITY (>61" LONG)	
CUST-1	1	BLUM MOTION ANTI SLAM HINGES	
ROOM SUMMARY:			

ROOM	DESCRIPTION	CATEGORY
ENSUITE VANITY	DOOR STYLE: QT 1203 FINISH: WHITE SPECIES: Fibreboard DOOR HARDWARE: 3487-128 DRW HARDWARE: COUNTER TOP: BY OTHERS	CATEGORY 1

ITEM #	QTY	DESCRIPTION	PRICE
VB-RAISE8	1	RAISE VANITY HEIGHT TO 34-1/2" - PER VANITY (>61" LONG)	
CUST-1	1	BLUM MOTION ANTI SLAM HINGES & 1 SET OF BLUM MOTION WHITE ANTARO DRAWER SLIDES	
ROOM SUMMARY:			



Quality Tops & Kitchens Ltd.
80 Sante Drive, Vaughan, ON L4K 3C4
T 416:746.1811 F 905.761.5901
www.QTK.ca info@qtk.ca

your kitchen. your taste.

PURCHASE AGREEMENT FORM

PURCHASER:		CONTRACTOR:	Braylea Investments Inc.
ADDRESS:	Suite 606	SITE:	HAMPTON PLACE
EMAIL:	Hampton	MODEL TYPE:	NOYAC BAY (2G+D)
PHONE #:		LOT #:	606 HMP UPGRADE PKG 1
PHONE #:		DATE:	MAY 28, 2019 Q5186

EXPECTED DELIVERY DATE	TBD	SUB-TOTAL:	
Customers please note all garbage bins, spice baskets, magic corner baskets and other accessories will only be delivered AFTER you move in the house. Please call us to request delivery of these items after you move in. Thank you. ALL CHANGES FINAL UPON SIGNING.		TOTAL:	
PLEASE READ ALL THE TERMS AND CONDITIONS ON THE ACCOMPANYING QTK TERMS & CONDITIONS DOCUMENT. BY SIGNING BELOW YOU AGREE TO RECEIVE THE ITEMS LISTED HEREIN AND PAY (ACCORDING TO QTK'S PAYMENT POLICY), AND HAVE READ AND UNDERSTOOD THE TERMS & CONDITIONS AS OUTLINED IN THE QTK TERMS & CONDITIONS DOCUMENT.		HST	
		GRAND TOTAL:	
		DEPOSIT 1:	
		DEPOSIT 2:	
BALANCE TO BE PAID IN FULL BY DUE DATE: _____ CUSTOMER INITIAL(S): _____			



CUSTOMER SIGNATURE: Sheliza Khan DATE: February 5, 2020

CUSTOMER SIGNATURE: Sheliza Khan QTK AUTHORIZED SIGNATURE: Sheliza Khan

606
Rev. April 4/19.


UPG KITCHEN LAYOUT

- 1ST UPGRADE APPLIANCE PKG
w/ 36" FRIDGE, CHIMNEY HOOD FAN,
MICRO IN PANTRY ON SHELF
- (x5) PUCK LIGHTS
- (x1) PLUG PENINSULA
- (x2) CAPPED PENDANT LIGHTS
- POWDER ROOM & ENSUITE
RAISED VANITIES 36 1/4"

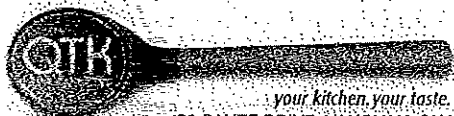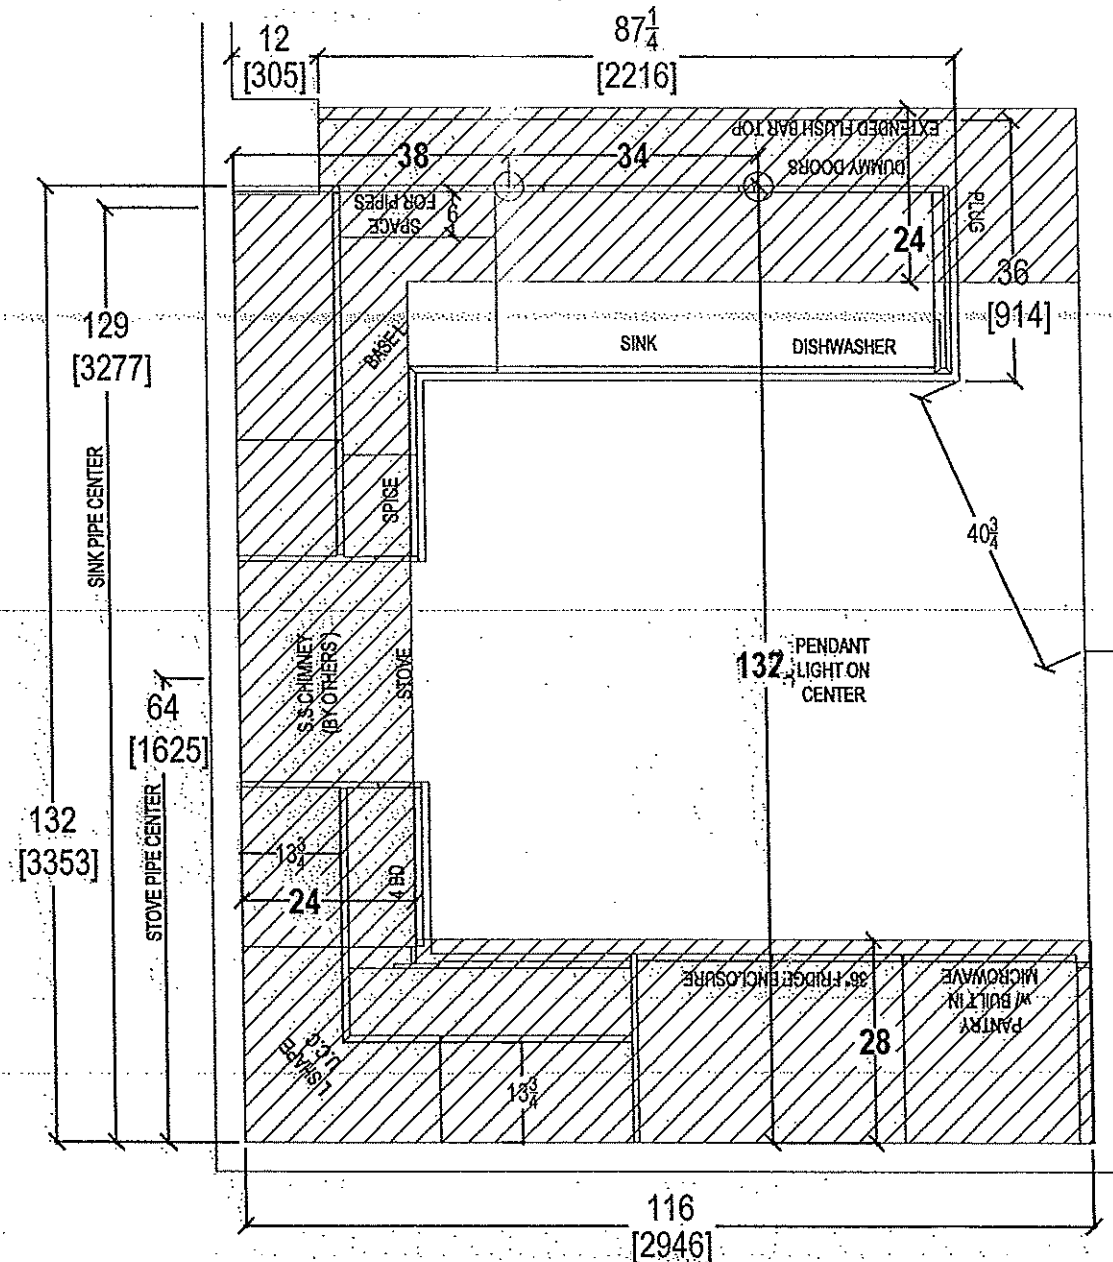

80 SANTE DRIVE, VAUGHAN, ON L4K 3C4,
T: 416.746.1811 F: 905.761.5901

CLIENT: ROYAL PINE HOMES	JOB NAME: UNIT 606 HMP	ROOM: KITCHEN	DRAWN BY: SK	COMMENTS: PLEASE NOTE ALL DIMENSIONS ARE NOT FINAL AND ARE SUBJECT TO CHANGE UPON FINAL SITE MEASURE
SITE: HAMPTON PLACE	DOOR STYLE: —	DOOR HANDLE: —	SCALE: 1/2" = 1'-0"	
PHONE: —	FINISH: —	DRW HANDLE: —	DATE: REVISED APRIL 4, 2019	
EMAIL: —	SPECIES: —	TOP: —	PAGE:	

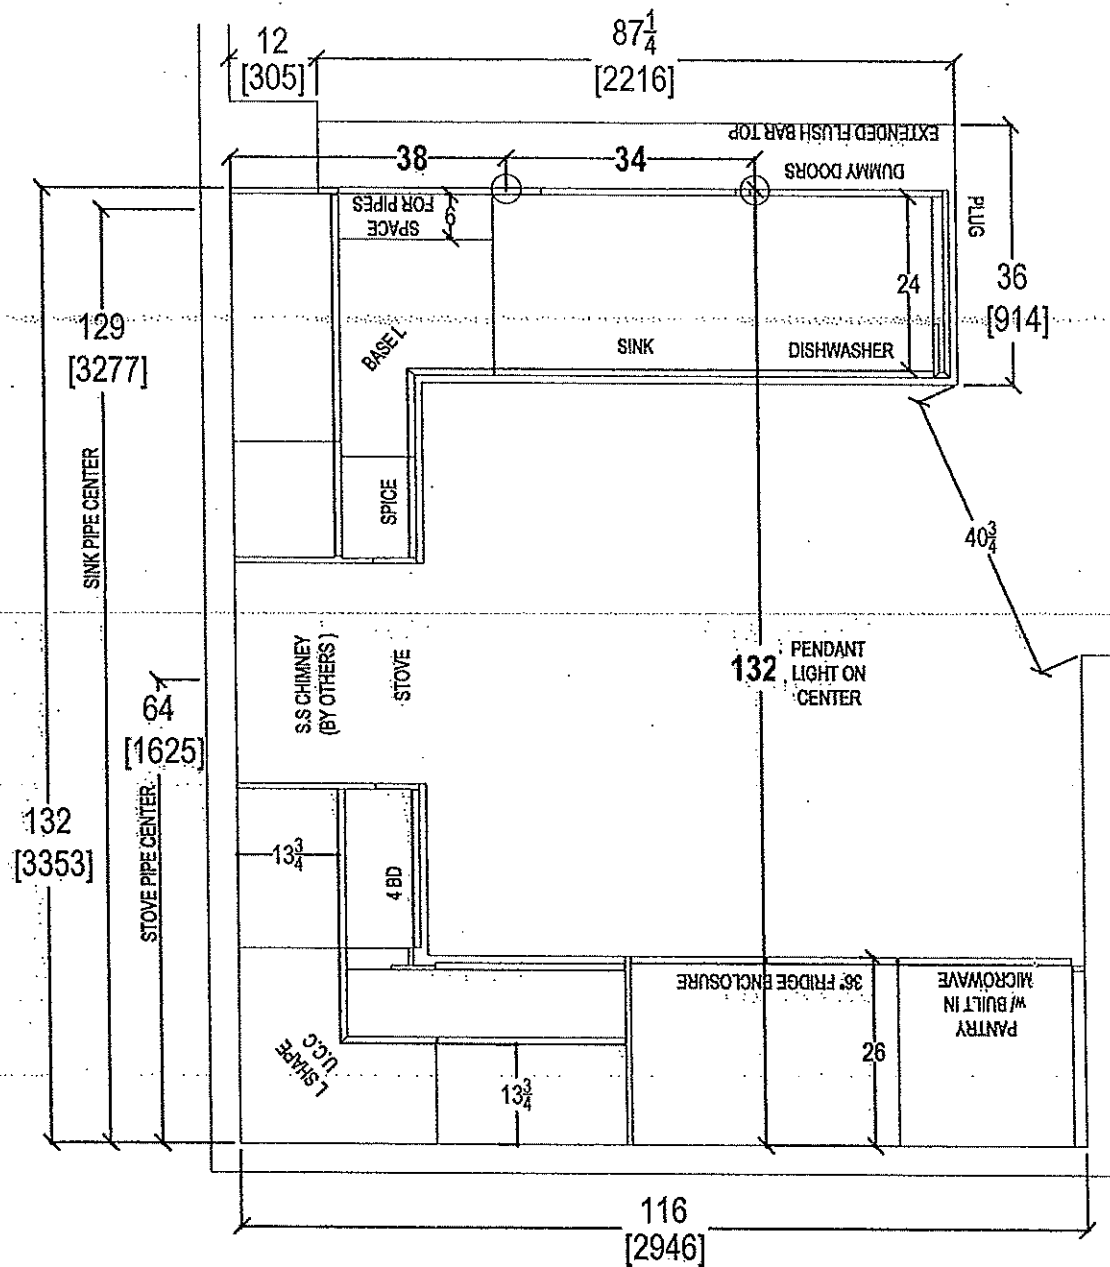

80 SANTE DRIVE, VAUGHAN, ON L4K 3C4,
T: 416.746.1811 F: 905.761.5901

CLIENT: ROYAL PINE HOMES

SITE: HAMPTON PLACE

PHONE: —

EMAIL: —

JOB NAME: UNIT 606 HMP

DOOR STYLE: —

FINISH: —

SPECIES: —

ROOM: KITCHEN

DOOR HANDLE: —

DRW HANDLE: —

TOP: —

DRAWN BY: SK




SCALE: 1/2" = 1' - 0"

DATE: REVISED APRIL 4, 2019.

PAGE:

COMMENTS:

PLEASE NOTE ALL DIMENSIONS
ARE NOT FINAL AND ARE
SUBJECT TO CHANGE UPON
FINAL SITE MEASURE

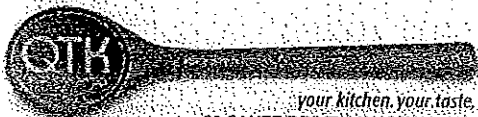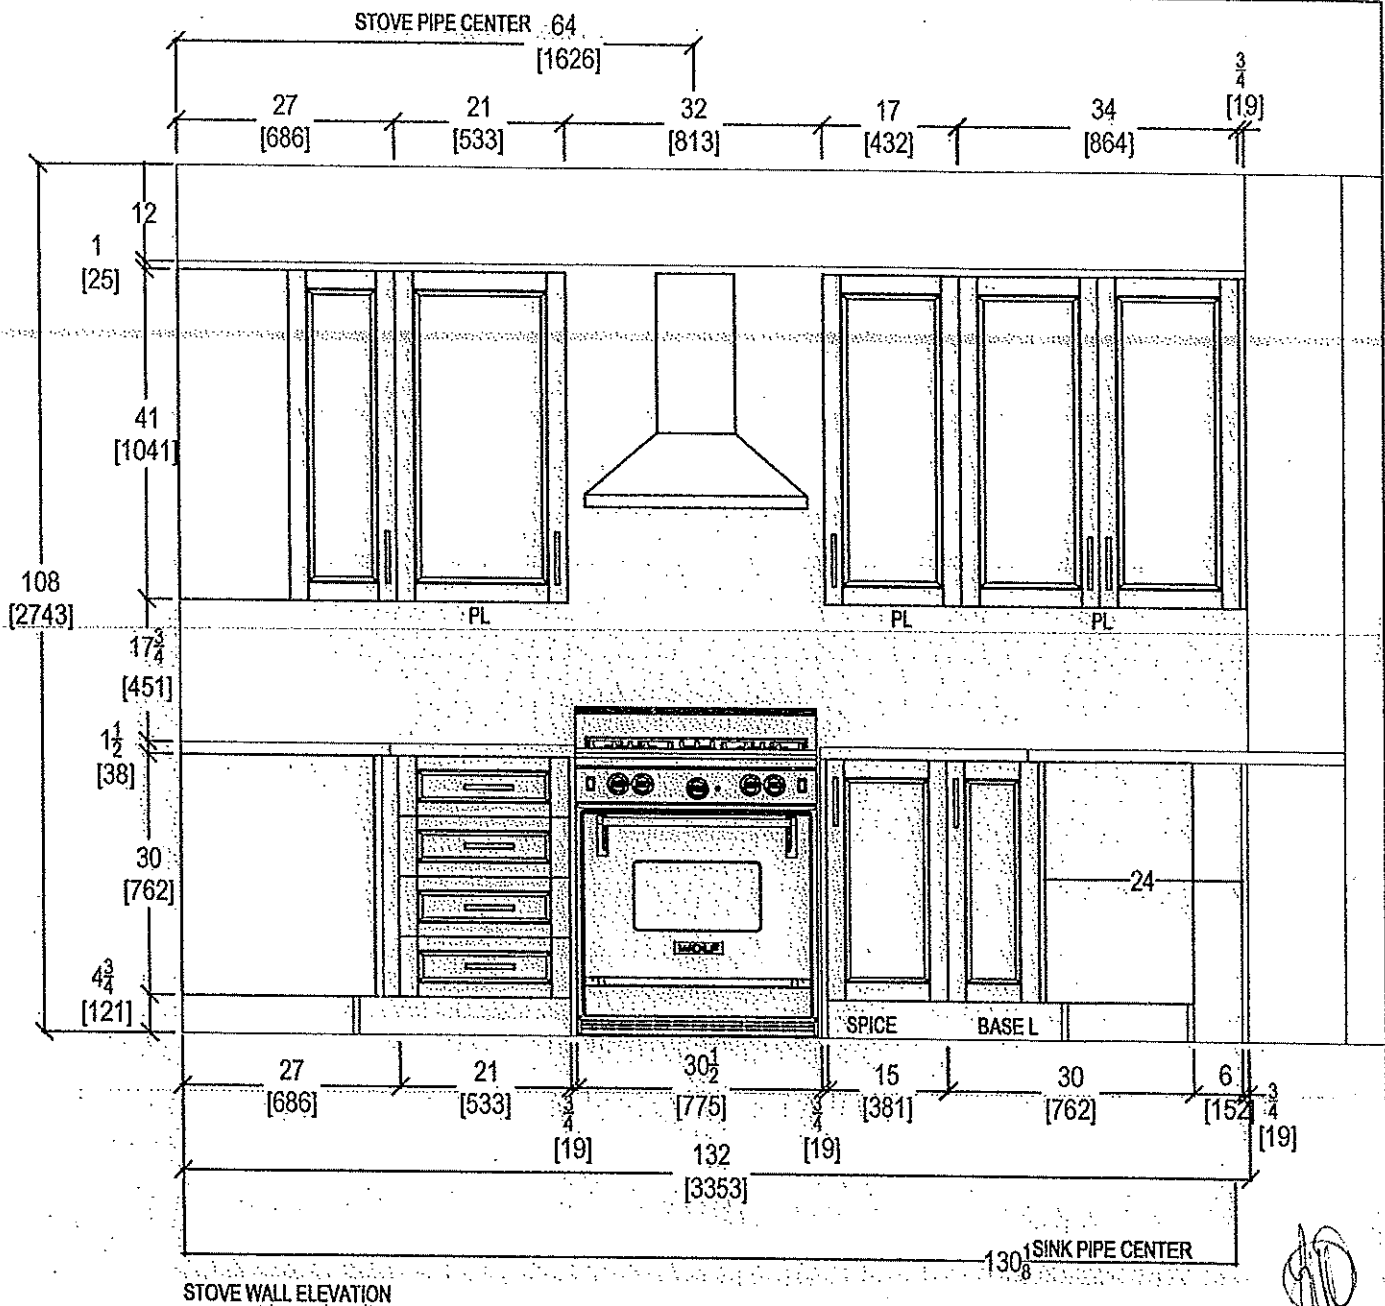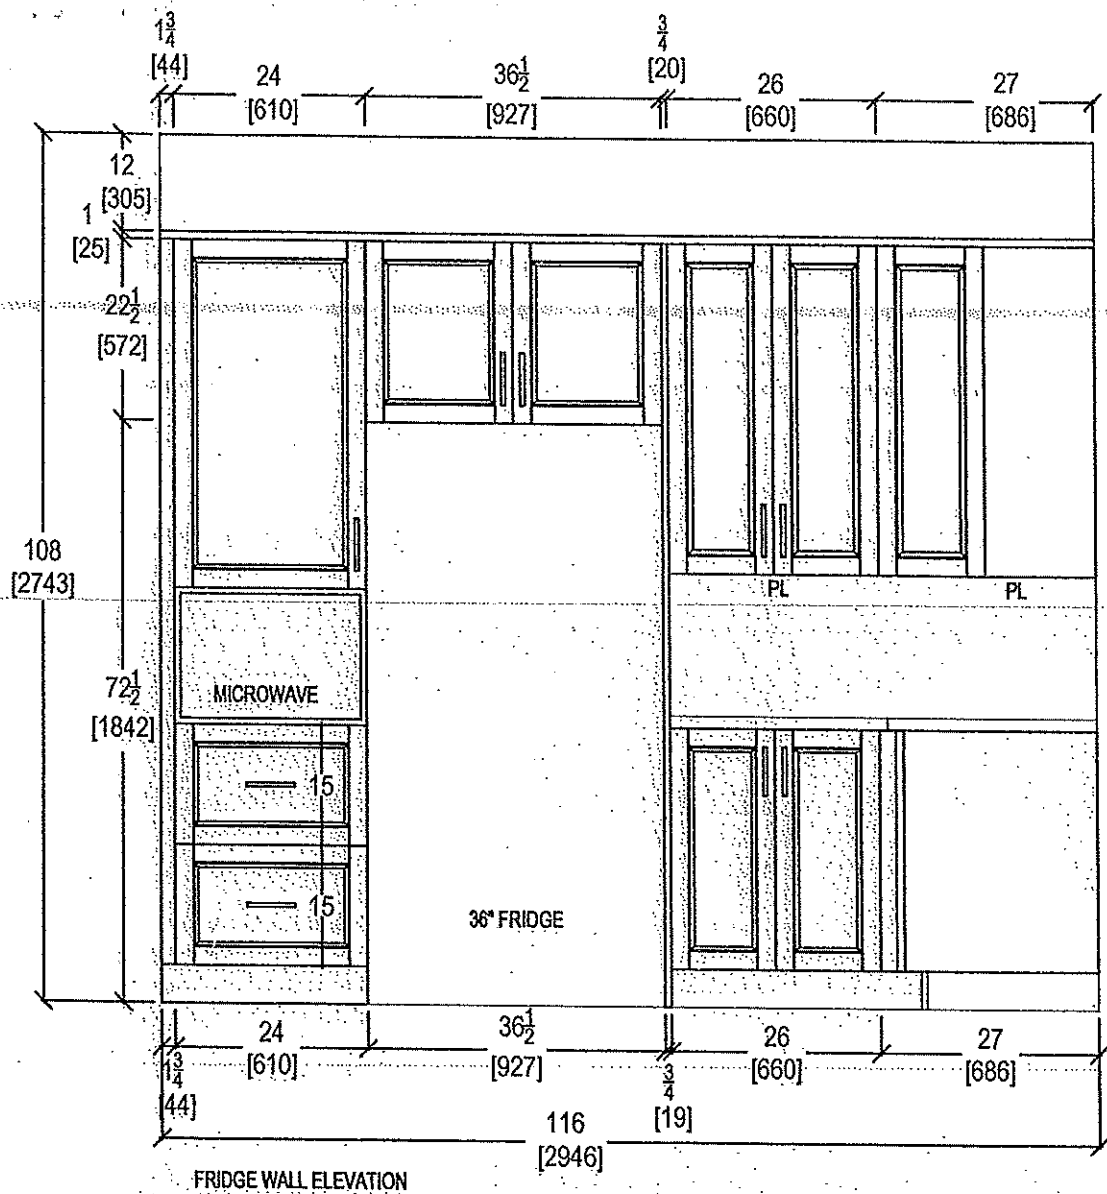

80 SANTE DRIVE, VAUGHAN, ON L4K 3C4,
T: 416.746.1811 F: 905.761.5901

CLIENT: ROYAL PINE HOMES

SITE: HAMPTON PLACE

PHONE: —

EMAIL: —

JOB NAME: UNIT 606 HMP

DOOR STYLE: —

FINISH: —

SPECIES: —

ROOM: KITCHEN

DOOR HANDLE: —

DRW HANDLE: —

TOP: —

DRAWN BY: SK


SCALE: 1/2" = 1' - 0"

DATE: REVISED APRIL 4, 2019


PAGE:

COMMENTS:


PLEASE NOTE ALL DIMENSIONS
ARE NOT FINAL AND ARE
SUBJECT TO CHANGE UPON
FINAL SITE MEASURE

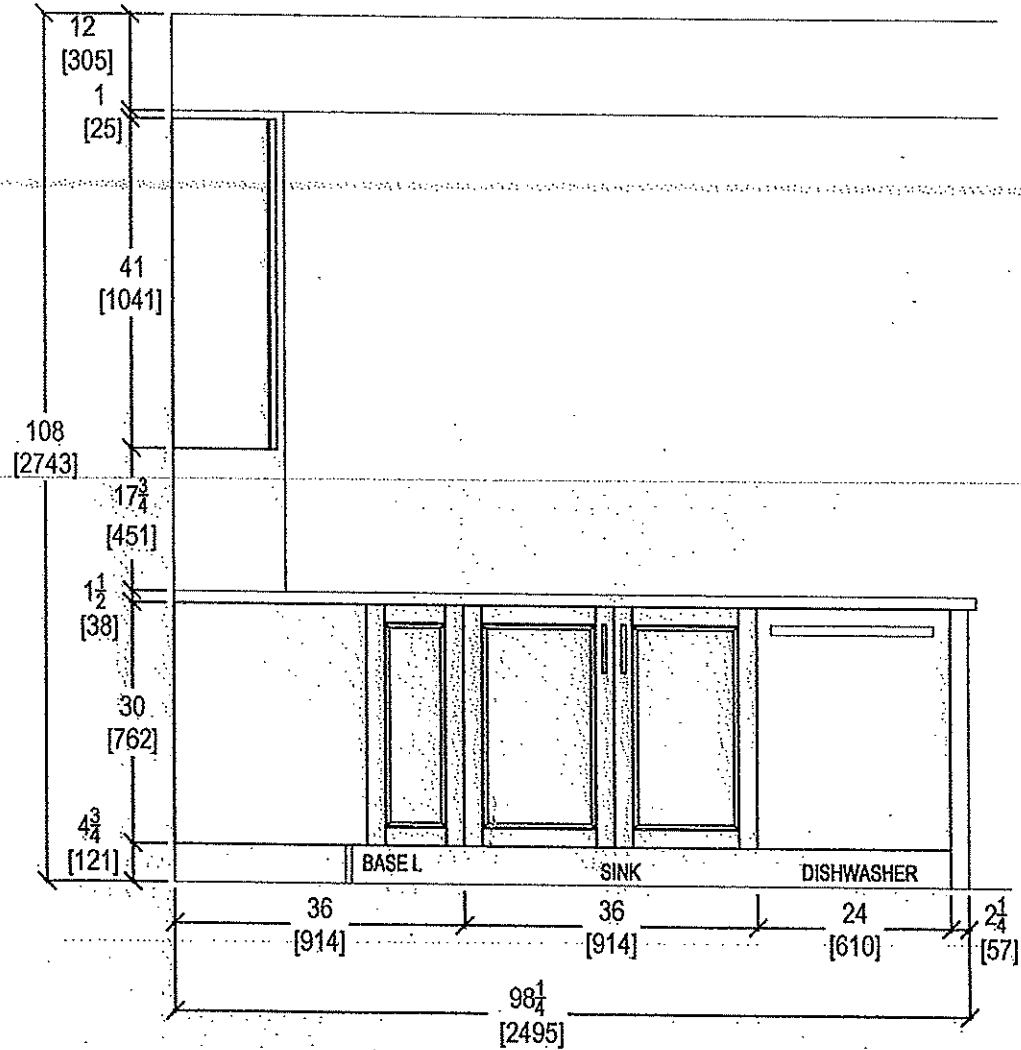

KITCHEN PENINSULA ELEVATION
FRONT VIEW

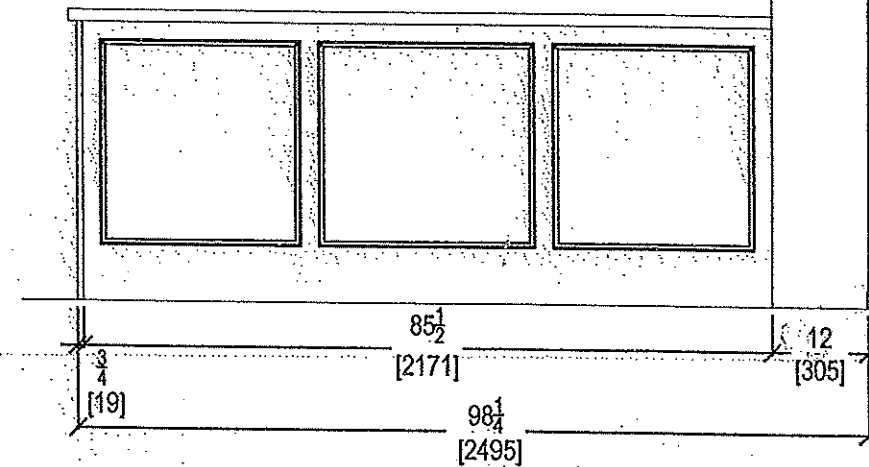

KITCHEN PENINSULA ELEVATION
REAR VIEW

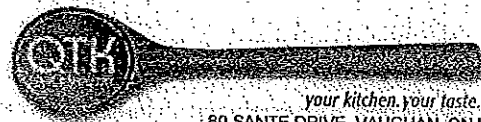

CLIENT: ROYAL PINE HOMES

SITE: HAMPTON PLACE

PHONE: —

EMAIL: —

JOB NAME: UNIT 606 HMP

DOOR STYLE: —

FINISH: —

SPECIES: —

ROOM: KITCHEN

DOOR HANDLE: —

DRW HANDLE: —

TOP: —

DRAWN BY: SK





SCALE: 1/2" = 1' - 0"

DATE: REVISED APRIL 4, 2019

PAGE: —


COMMENTS:

PLEASE NOTE ALL DIMENSIONS
ARE NOT FINAL AND ARE
SUBJECT TO CHANGE UPON
FINAL SITE MEASURE

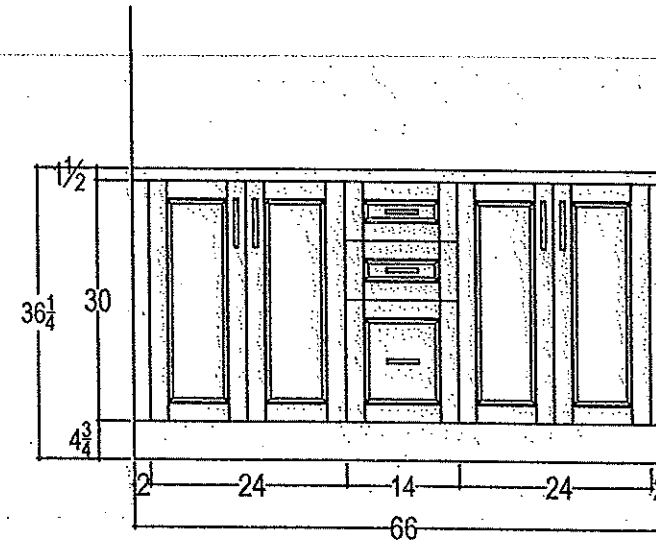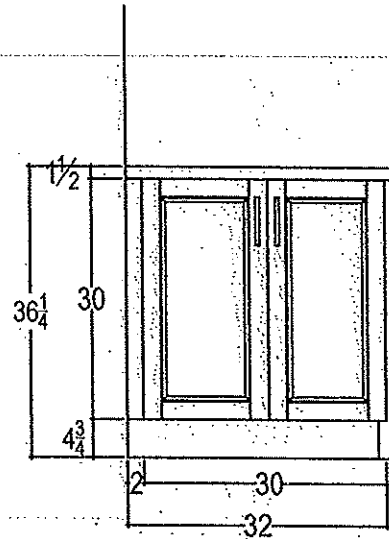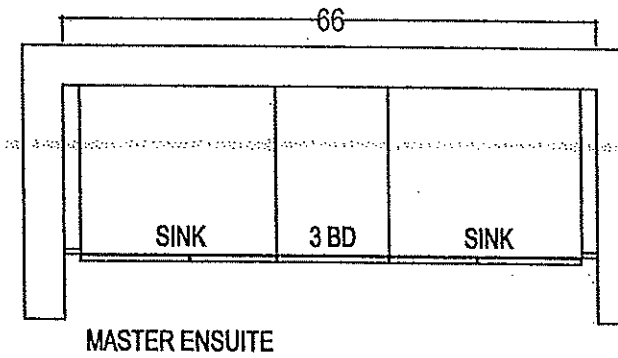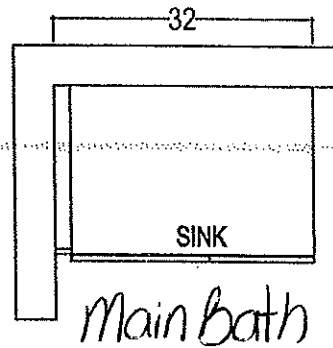

36 1/4" RAISED VANITIES * (Delete 3" splash)

[Handwritten signature]

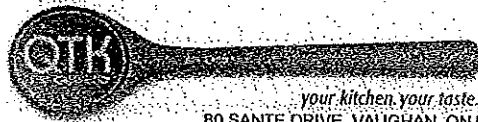


your kitchen. your taste.
80 SANTE DRIVE, VAUGHAN, ON L4K 3C4,
T: 416.746.1811 F: 905.761.5901

CLIENT: ROYAL PINE HOMES	JOB NAME: UNIT 606 HMP	ROOM: VANITIES	DRAWN BY: SK	COMMENTS: PLEASE NOTE ALL DIMENSIONS ARE NOT FINAL AND ARE SUBJECT TO CHANGE UPON FINAL SITE MEASURE
SITE: HAMPTON PLACE	DOOR STYLE: —	DOOR HANDLE: —	SCALE: 1/2" = 1' - 0"	
PHONE: —	FINISH: —	DRW HANDLE: —	DATE: REVISED APRIL 4, 2019	
EMAIL: —	SPECIES: —	TOP: —	PAGE:	

KRFC302ESS

22 cu.ft. 36-Inch Width Counter Depth French Door Refrigerator with Interior Dispense

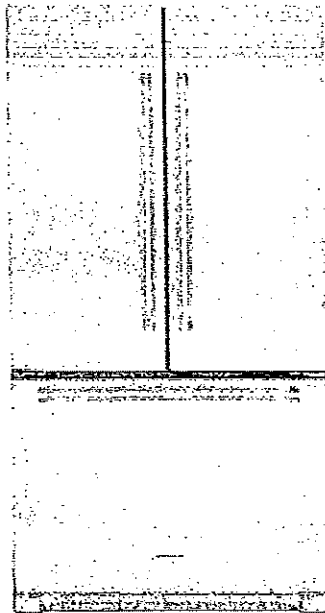

KRFC302ESS

Key Features:

- ExtendFresh™ Temperature Management System
- Interior Water Dispenser
- Professionally-Inspired Design
- Produce Preserver
- Humidity-Controlled Crispers
- FreshChill™ Temperature-Controlled Full-Width Pantry
- Pull-Out Tri-Level Freezer Drawer
- SatinGlide® System
- LED Lighting
- Star-K Certified
- Automatic Ice Maker
- Max Cool

KitchenAid®

<http://www.kitchenaid.com>

Product Dimensions:

Height: 72

Width: 35 3/4

Depth: 30 1/4

Electrical Requirements:

15 Amps.

Available In:

- ☐ Stainless Steel
- ☒ Black
- ☐ White

Upgrade
Package 2
Suite 606

MADE
IN
AMERICA

Because Whirlpool Corporation policy includes a continuous commitment to improve our products, we reserve the right to change materials and specifications without notice. We also reserve the right to discontinue or transition products without notice.

Reg. Registered trademark/TM Trademark of Whirlpool USA © 2013 Whirlpool Corporation All Rights Reserved. All other trademarks are owned by their respective companies.

Created On: Wednesday, April 22, 2015 15:51:04




Our website uses cookies and similar tools to improve its performance and enhance your user experience. By continuing to use this website without changing your settings you consent to their use. To find out more about the cookies we use or how to change your settings, please see our cookies policy. [OK](#) [Learn more.](#)

NN-ST765S

Evolved Genius®
Microwave with
Cyclonic Inverter
Technology

- 1,200 W High Cooking Power
- Genius Sensor Cooking with 14 Categories
- 10-level Power Settings
- 3-multi-stage Cooking
- Sensor Reheat
- Cyclonic Inverter Technology
- Full LED Lighting System

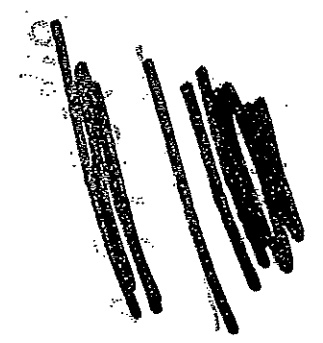

OverviewFeaturesSpecsAccessoriesWhere to BuySupport

New Cyclonic Inverter Technology

CONVENTIONAL

CYCLONIC INVERTER

Meat	Fish	Chicken	Milk

Suite 606

2



Microwave Ovens Countertop

Countertop NN-ST765S

MODEL & SIZE	Model Number	NN-ST765S
	Type	Family-size
	Installation	Countertop or built-in
	Oven Capacity	1.6 cu. ft.
PANASONIC TECHNOLOGY	Cooking Power	1200W
	Turntable Diameter	380mm
	Panasonic Inverter	Cyclonic Inverter
	Genius Sensor	Genius®
DESIGN	Color	Stainless Steel
	Control Panel	Touch pad
	Display Panel	New 4 Digit + Icon LCD / Green
	Door Window	Clear Black
STYLE	Door Release	Push Open
	Oven Interior	Paint White
	Multi-stage Cooking	3 stage
	Sensor Cook	Yes
PROGRAMMABLE FEATURES	Sensor Reheat	Yes
	Auto Cook/Reheat	Yes
	More / Less Control	Yes
	Inverter Turbo Defrost	Yes
	Keep Warm Button	Yes



Sute 606

NN-ST765S Countertop - Panasonic Canada

1.6 cu. ft.
Oven capacity

1200 Watt
Cooking power

304 x 555 x 493 mm
Exterior dimensions (H x W x D)

SEE ALL SPECS

NN-TK722S
27" Trim kit for NN-ST765S

NN-TK732S
30" Trim kit for NN-ST765S

NN-TK714SS
24" Trim kit for NN-ST765S

Suite 606

2

SPECIFICATIONS	Popcorn Button	Yes
	Quick Minute	Yes
	Cavity Dimensions (W x D x H)	Approx. 418 x 470 x 228 mm 15.7 x 18.5 x 8.3 inch
	Unit Dimensions (W x D x H)	555 x 493 x 304 mm 21.9 x 19.4 x 12 inch
	Carton Dimensions (W x D x H)	627 x 540 x 360 mm
ACCESSORIES	TRIM KITS	27" Model Number NN-TK72S
		30" Model Number NN-TK732S
	Accessory	Glass Tray

Copyright ©Panasonic Canada Inc.

Suite 606p




Trim Kit
NNTK714SS



NNTK714SS-



2. Installation Diagram
2. Schéma d'installation
2. Diagrama de instalación

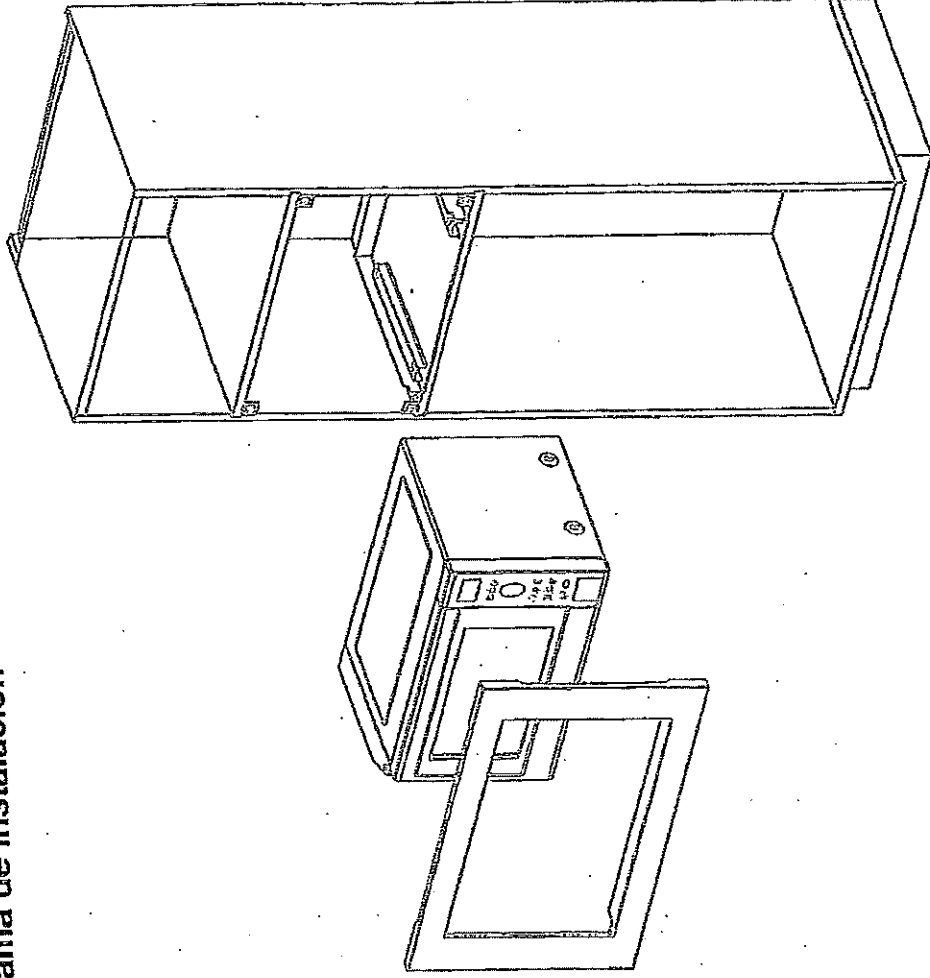



Trim Kit Dimensions	
Width	596 mm (23 1/2")
Height	410 mm (16 1/8")
Depth (Thickness)	20 mm (3/4")

Dimensions du nécessaire d'encastrement	
Largeur	596 mm (23 1/2 po)
Hauteur	410 mm (16 1/8 po)
Profondeur (épaisseur)	20 mm (3/4 po)

Dimensiones del juego de acabados	
Ancho	23 1/2" (596 mm)
Altura	16 1/8" (410 mm)
Profundidad (grosor)	3/4" (20 mm)

Suite bdd

- 3. Cabinet Diagram and Dimensions
- 3. Schéma de l'armoire et dimensions
- 3. Dimensiones y diagrama del gabinete

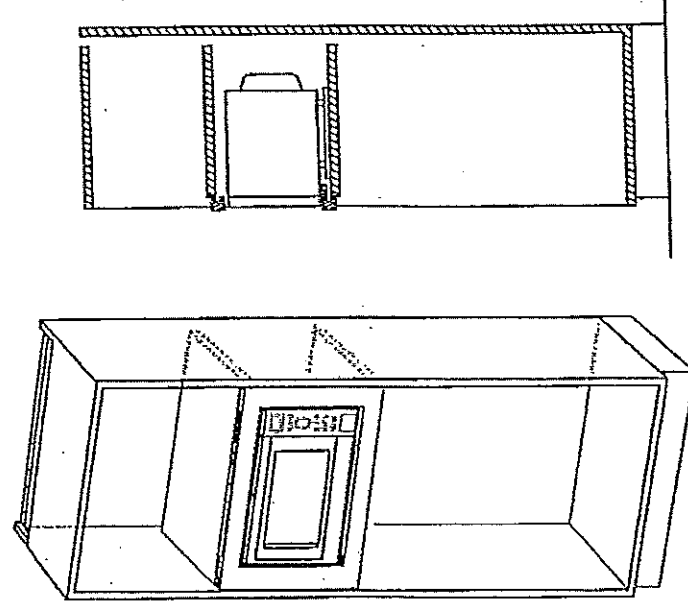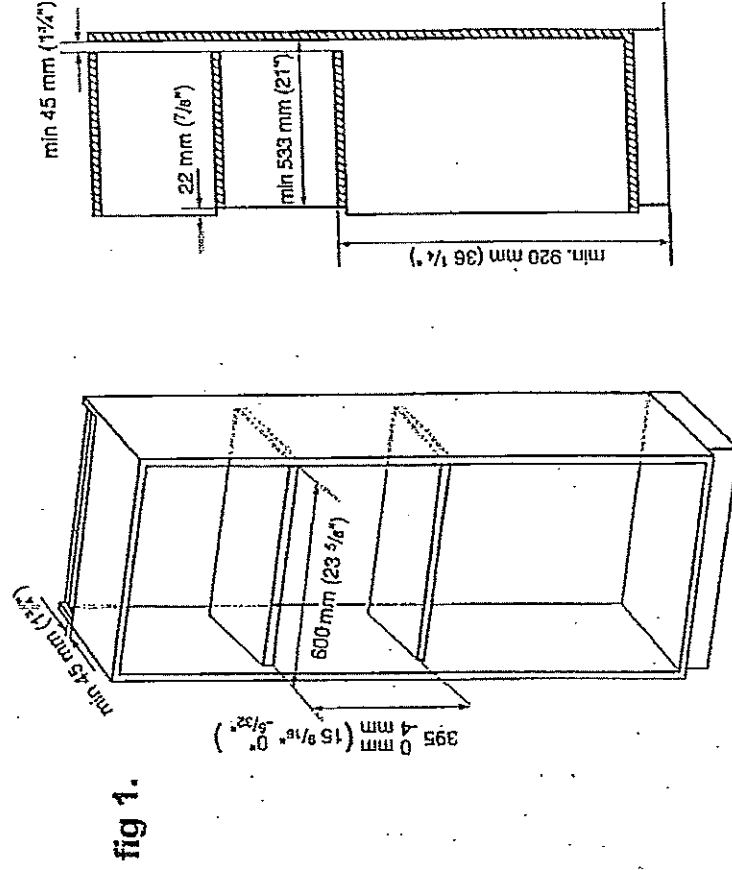

10

Upgrade Package!


Suite 606

WEE745H0FS

6.4 Cu. Ft. Slide-In Electric Range with True
Convection

Whirlpool®

<http://www.whirlpool.com>

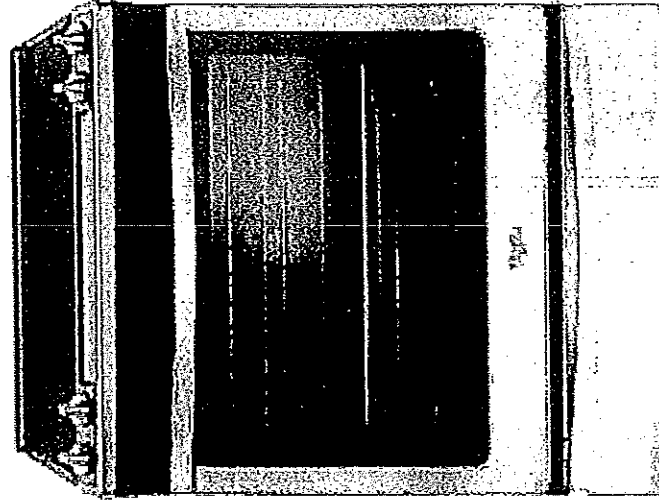

Key Features:

- Frozen Bake™ Technology
- True Convection Cooking
- FlexHeat™ Triple Radiant Element
- Convection Conversion
- AquaLift® Self-Cleaning Technology
- Temperature Sensor
- Rapid Preheat
- 6.4 Cu. Ft. Capacity
- Easy-Wipe Ceramic Glass Cooktop
- Large Oven Window
- Max Capacity Rack
- Hidden Bake Element

Product Dimensions:

Height: 36

Width: 29 7/8

Additional Information:

[Use And Care Guide](#)

[Dimension Guide](#)

[Installation Guide](#)

[Warranty Certificate](#)

INVESTED
IN
AMERICA



®Registered trademark/™ Trademark of Whirlpool, U.S.A. © 2016 Whirlpool Corporation. All Rights Reserved.

All other trademarks are owned by their respective companies.

Because Whirlpool Corporation policy includes a continuous commitment to improve our products, we reserve the right to change materials and specifications without notice. We also reserve the right to discontinue or transition products without notice.

Manufacturer's Suggested Retail Price (MSRP) and Minimum Advertised Price (MAP) provided for reference purposes only. Dealer alone determines advertised and retail prices.

Created On: Friday, January 27, 2017 10:46:47

100

Upgrade
Package!


Suite 604

WDTA50SAHZ

Whirlpool®

<http://www.whirlpool.com>

Contemporary Design. Stainless Steel Tub
Dishwasher with TotalCoverage Spray Arm

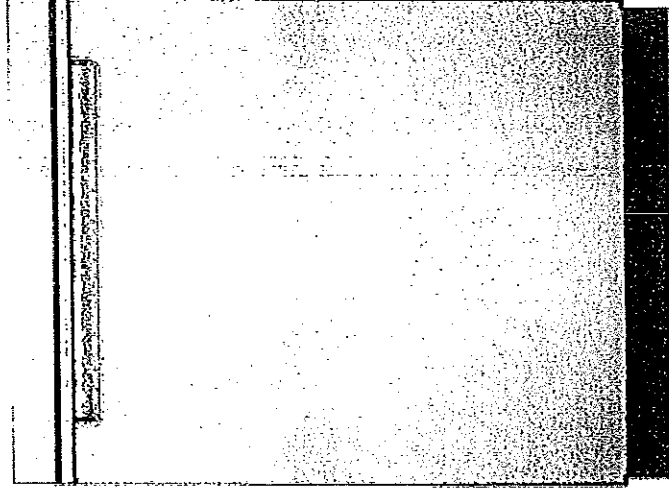

Key Features:

- Sensor Cycle
- TotalCoverage Spray Arm
- 1-Hour Wash Cycle
- Tap Touch Controls

Product Dimensions:

Height: 34 1/2
Width: 23 7/8
Depth: 24 1/2

Additional Information:

Use And Care
Dimension Guide
Installation Guide
Energy Guide
Warranty

Available in:



Black

Fingerprint Resistant Sunset Bronze

Fingerprint Resistant Black Stainless



White

Fingerprint Resistant Stainless Steel

INVESTED
IN
AMERICA



®Registered trademark/™ Trademark of Whirlpool, U.S.A. © 2016 Whirlpool Corporation. All Rights Reserved. All other trademarks are owned by their respective companies.

Because Whirlpool Corporation policy includes a continuous commitment to improve our products, we reserve the right to change materials and specifications without notice. We also reserve the right to discontinue or transition products without notice.

Manufacturer's Suggested Retail Price (MSRP) and Minimum Advertised Price (MAP) provided for reference purposes only. Dealer alone determines advertised and retail prices.

Upgrade
Package!




Suite 604

WFW75HEFW

4.5 cu. ft. Front Load Washer with Precision
Dispense



<http://www.whirlpool.com>

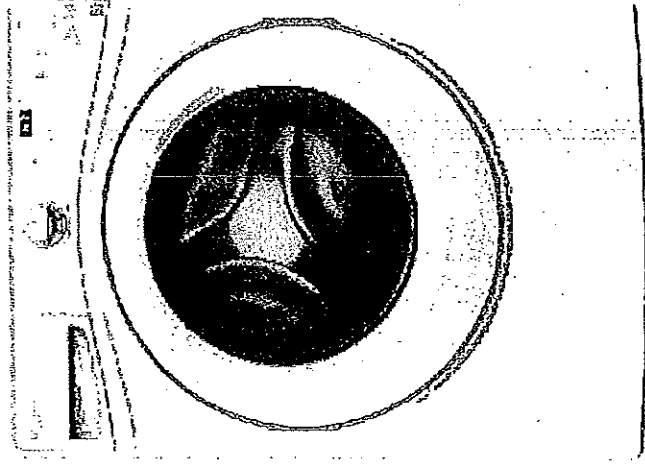

Key Features:

- Precision Dispense
- Adaptive Wash Technology
- Smooth Wave Stainless Steel Wash Basket
- 4.5 cu. ft. Capacity
- ENERGY STAR® Qualified

Product Dimensions:

Height: 39 3/4"

Width: 27"

Depth: 33 5/16"

Electrical Requirements:

15 or 20, 120 V.

Additional Information:

[Use And Care Guide](#)

[Dimension Guide](#)

[Installation Guide](#)

[Energy Guide](#)

[Warranty Certificate](#)

INVESTED
IN
AMERICA



®Registered trademark/™Trademark of Whirlpool, U.S.A. ©2013 Whirlpool Corporation. All Rights Reserved.
All other trademarks are owned by their respective companies.
Because Whirlpool Corporation policy includes a continuous commitment to improve our products, we reserve
the right to change materials and specifications without notice. We also reserve the right to discontinue or
replace products without notice.
Manufacturer's Suggested Retail Price (MSRP) and Minimum Advertised Price (MAP) provided for reference
purposes only. Dealer alone determines advertised and retail prices.
Created On: Wednesday, March 23, 2016 11:51:03

Upgrade
Package!

Suite 606

YWED75HEFW

8.5 cu. ft. Duet® High Efficiency Front Load Electric
Dryer with ENERGY STAR®

MSRP: \$0.00

Whirlpool®

<http://www.whirlpool.com>

Key Features:

- Advanced Moisture Sensing System
- Quad Baffles
- Tap Touch Controls with Memory
- EcoBoost™ Option
- Wrinkle Shield™ Plus Option
- Undercounter Installation
- 7.4 Cu. Ft. Capacity
- ENERGY STAR® Qualified

Product Dimensions:

Height: 39

Width: 27


Depth: 31

Additional Information:

Use And Care

Installation Guide

Warranty

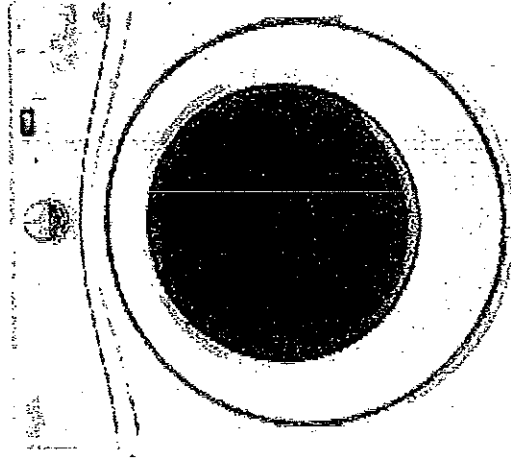

Available in:

☐ White

INVESTED
IN
AMERICA



®Registered trademark/™ Trademark of Whirlpool, U.S.A. © 2016 Whirlpool Corporation. All Rights Reserved. All other trademarks are owned by their respective companies.

Because Whirlpool Corporation policy includes a continuous commitment to improve our products, we reserve the right to change materials and specifications without notice. We also reserve the right to discontinue or transition products without notice.

Manufacturer's Suggested Retail Price (MSRP) and Minimum Advertised Price (MAP) provided for reference purposes only. Dealer alone determines advertised and retail prices.



Suite 604

4/3/2018

Hoods From Collection Potenza Vulcano | Falmec

U.S.A. (EN (/en_us/)) - Select Country (/en_us/country/)

Catalogues (/en_us/catalog/) Downloads (/en_us/downloads/) Reserved area (http://portal.falmec.com/) Contacts (/en_us/contacts/)

Search Q


falmec (/en_us/)

PRODUCTS COMPANY (/EN_US/COMPANY/) FALMEC WORLD (/EN_US/FALMEC_WORLD/)

NEWS & PRESS (/EN_US/NEWS/)

SHARE THIS PRODUCT

HOME (/EN_US/) > HOODS (/EN_US/TYPOLGY/HOODS-4/) > POTENZA (/EN_US/TYPOLGY/HOODS-4/COLLECTION/POTENZA-15/) > VULCANO

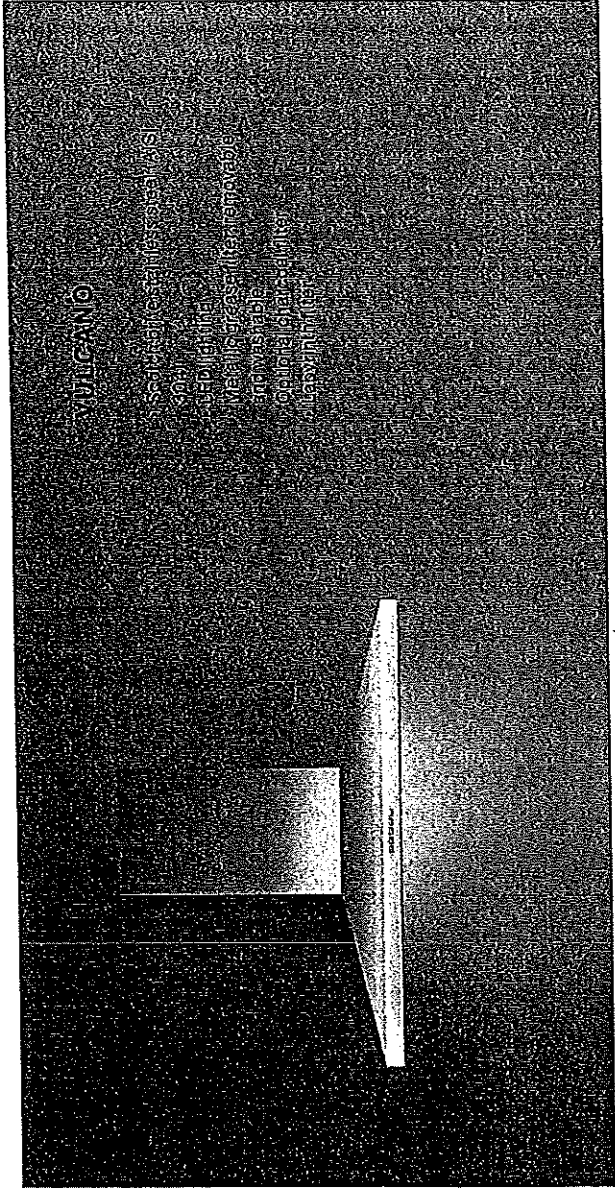

VARIANTS

FPVUL30W3SS / Vulcano Wall 30" (76 cm) 280 CFM
FPVUX36W6SS / VulcanoXL Wall 36" (90 cm) 600 CFM
FPVUL24W3SS / Vulcano Wall 24" (60 cm) 280 CFM
FPVUX30W6SS / VulcanoXL Wall 30" (76 cm) 600 CFM

TECHNICAL FEATURES

Installation type
Wall

Dimensions
76 cm / 30 in

Features
Scotch brite stainless steel
(AISI 304)
Electronic control
Metallic grease filter,
removable and washable
Optional charcoal filter
Labyrinth filter

Finish
Scotch brite stainless steel
(AISI 304)

Motor
450 m³/h / 280 cfm

Type of control
Electronic control

Speed settings

ACCESSOIRES

KACL.510#I
Extension H700 - Wall

KACL.512#I
Extension H960 - Wall

KACL.815
Protective cleaning cloths for
stainless steel (box 10 pcs)

103050107
Square charcoal filter - Type
3

CONSUMPTION

Maximum consumption
150 W

Current
120V 60Hz

Frequency

PACKAGING

Gross weight
20 Kg

Net weight
15 Kg

Volumes
0.30 m³

Packaging size
Length: 995 mm
Height: 595 mm
Depth: 510 mm

COOKIE POLICY

We use cookies on "www.falmecnorthamerica.com". If you continue to use "www.falmecnorthamerica.com" we will assume that you are happy with the use of cookies. For more information about our cookies and how to change your preferences please see our Cookie Policy

http://www.falmecnorthamerica.com/en_us/product_details/vulcano-160.html

Countertop Edges

Suite 606


Hampton

February 5, 2020


EDGE
DETAILS

004


CONNOLLY Marble & Granite Ltd.

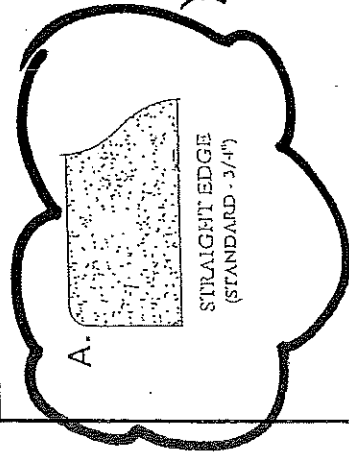

- * Kitchen
- * Main Bath
- * Master Ensuite

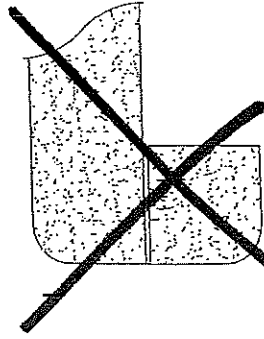

DOUBLE TOP "D" EDGE
(STANDARD - 1 1/2")

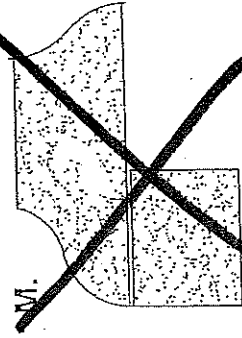


CBE - SQUARE EDGE
(MED./HIGH - 1 1/2")

EDGING UP-GRADE OPTIONS




*

Suite 604 *

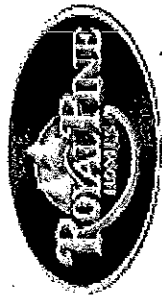


Master Ensuite
Shower Stall

UPGRADE OPTION 2
PACKAGE

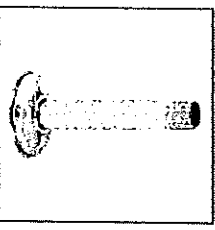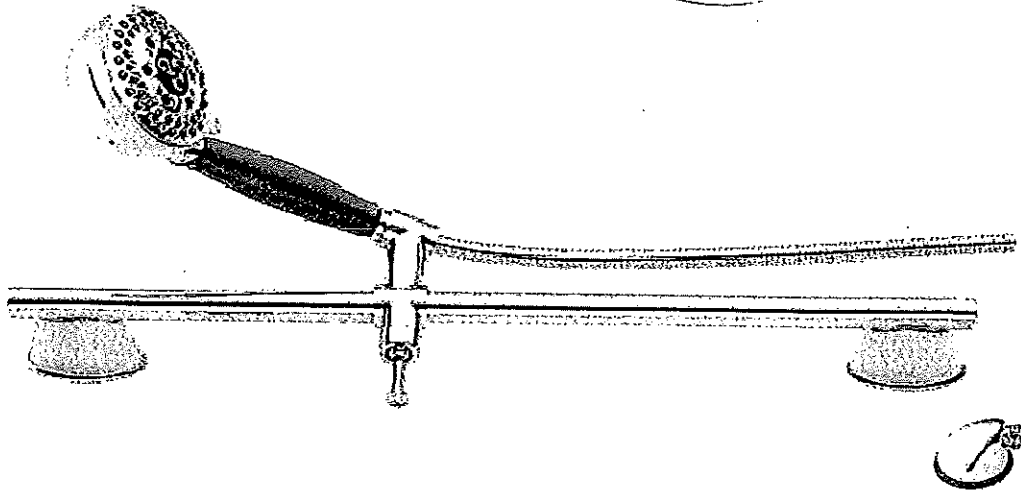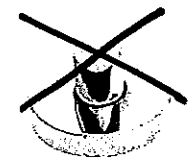

* From Ceiling *

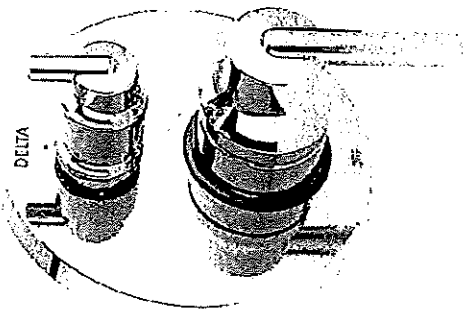

Delta Contemporary Round 14 Series Pressure Balance Kit
Integrated Diverter Valve
Includes both ceiling mount & wall mount shower arm
Model DF-KIT18

Canton Sales Corp. 4300 Matthews Blvd. Unit # 30, Mississauga, Ont L4Z 1N8 Tel: 905-629-7072 Fax: 905-629-2131

Upgrade kitchen Sinks




Suite 606
Hampton




BLANCO

February 5, 2020

A handwritten signature in black ink, appearing to be "J. D. Smith".

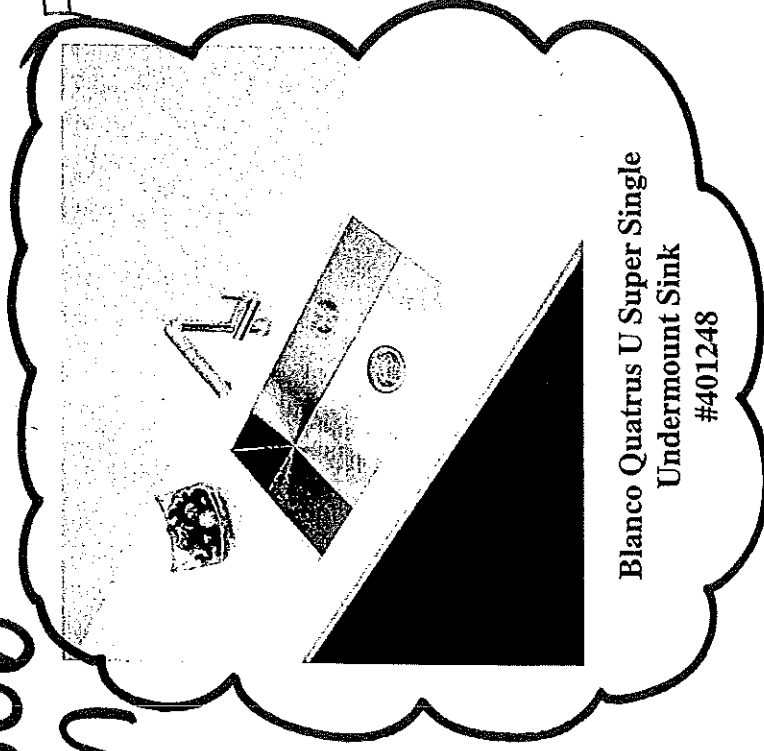

Blanco Quatrus U Super Single
Undermount Sink
#401248

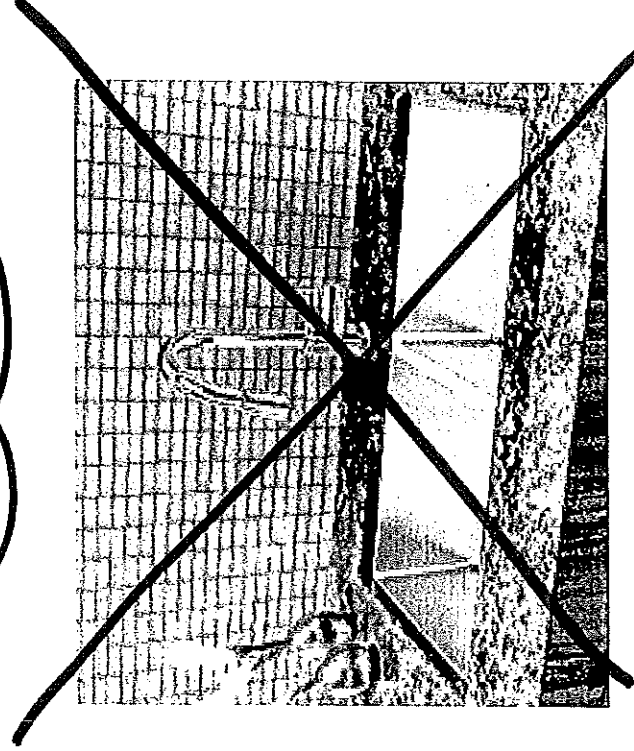

Blanco Quatrus R15 Two Bowl
Undermount Sink
#401519