

BLOCK 3 LOT 4 EL. B




MORNING GLORY
(22'01)

2020 SQ. FT.
INCLUDES 12 SQ. FT. OF OPEN AREA

*Upgrade *1 Appliance Pkg.

- Ⓢ - cable (x3)
- Ⓣ - Telephone (x3)

February 24, 2020

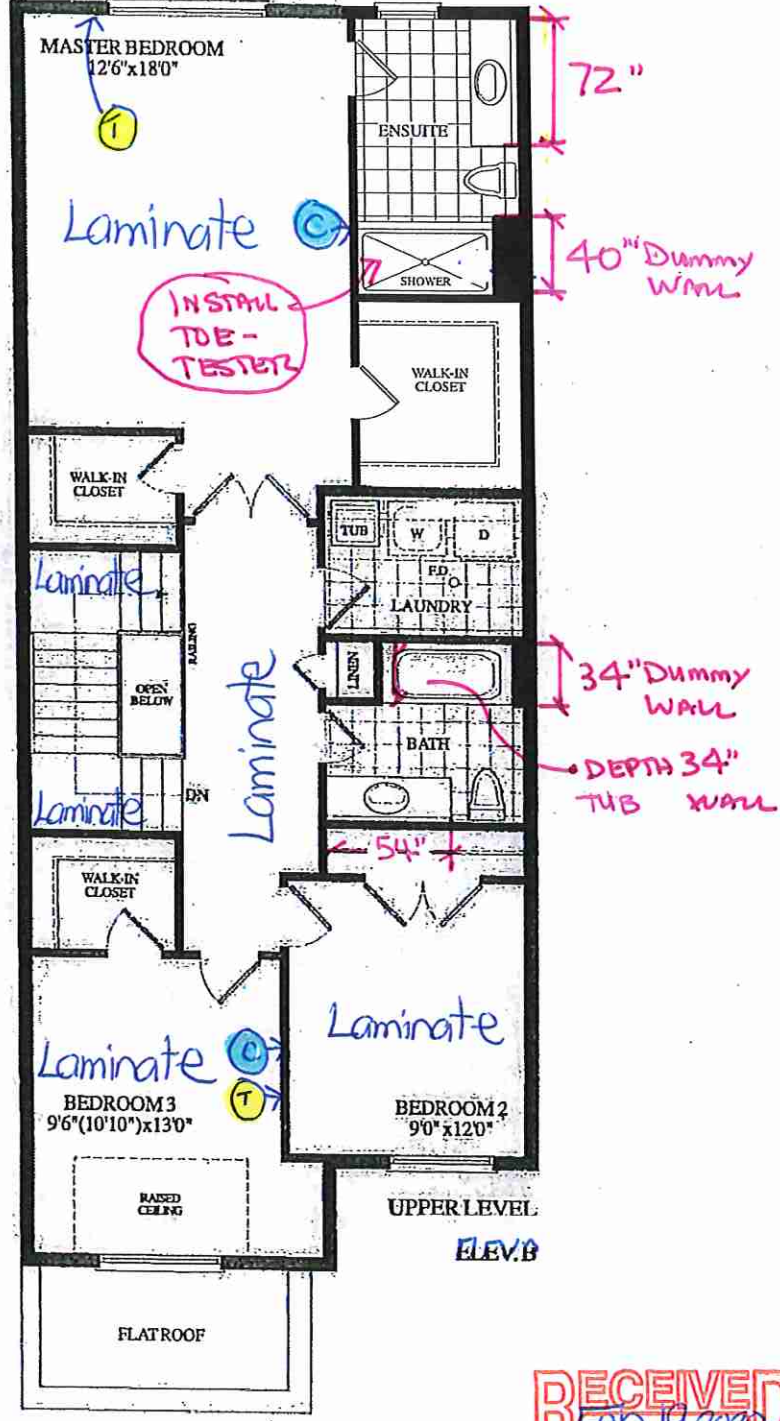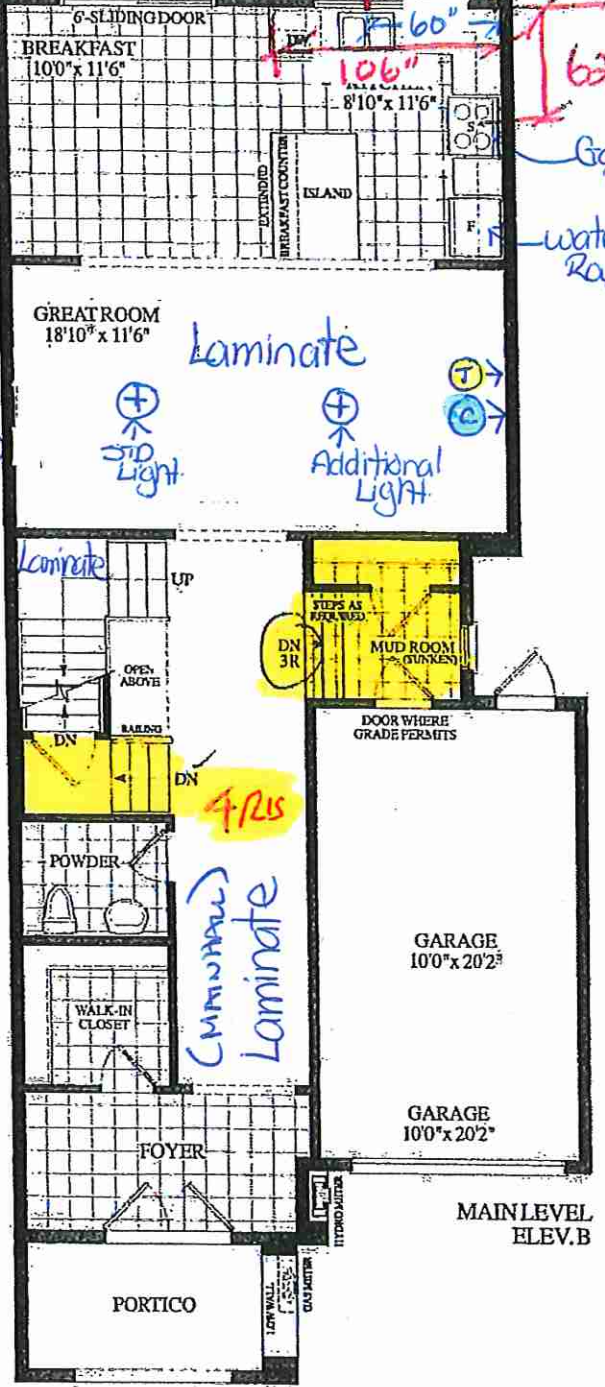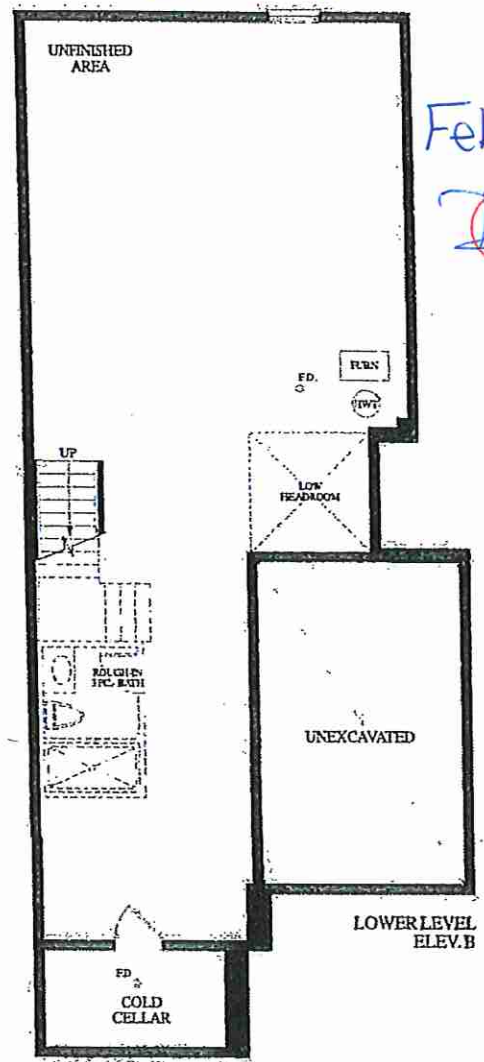

RECEIVED
Feb 19, 2020



Options and features shown on this plan are not guaranteed and may vary at the discretion of the builder. This plan is for informational purposes only and does not constitute an offer. All dimensions are in feet and inches.

ROYALPINEHOMES.COM



(Site Window)

SITE COPY

CONSTRUCTION SUMMARY

Forestside Estates Inc.

PURCHASERS: TRUPTI DHAVALKUMAR PATEL and DHAVALKUMAR ASHOKKUMAR PATEL

TEL: RES.: 647-879-5381

LOT NUMBER	PHASE	HOUSE TYPE	CLOSING DATE
4 Block 3	6	MORNING GLORY-ELEV B	31-Aug-20

Date Added: 24-Feb-20 Invoice Number: 7414

1 - Standard Cable Rough-Ins (x3) and Standard Telephone Rough-Ins (x3) (See Sketch) Note:
1 - GREAT ROOM - In addition to builders standard ceiling light, Install ONE (1) ADDITIONAL CEILING LIGHT with Seperate Switch. To be installed in line with builders standard ceiling light (See Sketch) Note:
1 - STAIRCASE - STAIN OAK STAIRCASE WITH IRON PICKETS - To be Stained in: VINTAGE RED OAK GRAPHITE throughout staircase where applicable (x1 Flight) To Include; Staircase from Main Floor to 2nd Floor (See Sketch) Note: In Lieu of Builders Standard Natural Oak (See Sketch)
1 - STAIRCASE VS FLOORING - WOOD SPECIES DIFFERENCE: STAIRCASE - The purchaser was advised and therefore accepts and acknowledges that the wood species of the staircase and flooring chosen do not match. This difference may result in a stain colour variance Note: The purchaser agrees that the vendor is to be exempt from any and all claims by the purchaser regarding this colour variance.
1 - STAIRCASE VS FLOORING - STAINING DIFFERENCE: STAIRCASE - The purchaser was advised and therefore accepts and acknowledges that the stain of the staircase and flooring chosen do not match. This difference might result in an undesirable colour variance. Note: The purchaser agrees that the vendor is to be exempt from any and all claims by the purchaser regarding this colour variance.
1 - STAIRCASE - Install Upgrade Railing Package - UPGRADE PACKAGE #3 - To be installed throughout staircase, where applicable (x2 Flights) (See Sketch) To Include; HANDRAIL- Modern Rec. PICKETS-Steel-Modern Rec./Alt.Plain - Black POST-Modern Rec.3 1/2" Note:
1 - UPPER LEVEL FLOORING - Install LAMINATE FLOORING - 7 1/2" TORLYS FOREST ACADIAN 9743P - To be installed throughout upper level, where applicable. To Include; Upper Hall, Master Bedroom, Bedroom #2 and Bedroom #3 (See Sketch) Note: In Lieu of Builders Standard Broadloom
1 - DISCLAIMER - THERMOFOIL CABINETRY; KITCHEN - The purchaser was advised and therefore accepts and acknowledges that by installing thermofoil cabinets in the kitchen, Note: they may result in the cabinet peeling due to the vapor and moisture of the stove and dishwasher.
1 - KITCHEN - KITCHEN SINK - Install the Builders Standard Top Mount Sink in the kitchen - BLANCO HORIZON 2.0 (8") Top mount Sink- Model # 401124 Note:
1 - KITCHEN - KITCHEN FAUCET - Install the Builders Standard Faucet in the kitchen - DELTA Chrome Pull Down Kitchen Faucet (Single Hole) - Model # 976 LF Chrome Note:
1 - KITCHEN - KITCHEN BACKSPLASH - DELETE Do Not Install / Supply / Credit purchaser for builders standard kitchen backsplash (See Sketch) Note:
1 - APPLIANCE PACKAGE - Install Upgrade Appliance Package - UPGRADE PACKAGE #1 - To be installed throughout house, where applicable. (See Attached Specifications) Note: Includes Applicable Electrical for Microwave / Hood Fan Combination Unit
1 - KITCHEN - Install GAS LINE ROUGH-IN at Kitchen, stove area (See Sketch) Note: Purchaser Accepts and Acknowledges that the Builders Upgrade Stove will be Electric
1 - KITCHEN - Install WATER LINE ROUGH-IN ONLY at Kitchen Fridge Area (See Sketch) Note:



SITE COPY

CONSTRUCTION SUMMARY

Forestside Estates Inc.

PURCHASERS: TRUPTI DHAVALKUMAR PATEL and DHAVALKUMAR ASHOKKUMAR PATEL

TEL: RES.: 647-879-5381

LOT NUMBER	PHASE	HOUSE TYPE	CLOSING DATE
4 Block 3	6	MORNING GLORY-ELEV B	31-Aug-20

Date Added: 24-Feb-20 Invoice Number: 7414

1 - MASTER ENSUITE - Install TOE TESTER to the Standard Shower Stall in the Master Ensuite. Model #T14434-LC/R10000 (See Sketch) Note:
1 - CLARIFICATION; POWDER ROOM, MASTER ENSUITE & MAIN BATH - Install the builders standard Plumbing Fixtures throughout all bathrooms, where applicable. To Include; Powder Room, Master Ensuite & Main Bath (See Sketch) Note:
1 - BONUS PACKAGE - PURCHASER HAS APPLIED \$12,000.00 (Includes Taxes) WORTH OF UPGRADE PROMOTIONAL PACKAGE TOWARDS THE PURCHASE OF UPGRADES COMPLETED AT THE DECOR CENTRE. Note:
1 - PURCHASER HAS ATTENDED A COLOR APPOINTMENT AT THE DECOR CENTRE AND HAS DECLINED ANY ADDITIONAL UPGRADES. Purchaser accepts and acknowledges that there will be no further changes/additions/deletions to be made upon signing on February 24, 2020 Note:
1 - PURCHASER AWARE AND ACCEPTS THAT ANY CHANGES MADE TO UPGRADES AFTER SIGNING THIS PURCHASERS EXTRA FORM ARE SUBJECT TO A MINIMUM ADMINISTRATION FEE OF \$1,000 PLUS A 10% HOLDBACK FEE. Note:

This Document is Extremely Time Sensitive - Printed 27 Feb 20 at 9:04

Page 1 of 3Page 1 of 3

Vendor: Forestside Estates Inc.

Page 2 of 3

Foyer

Great Room

Upper Hall

Bedroom 2

--	--

[illegible]

Appliance Opening/Dimension

☐ **Fireplace**

Page 2 of 3

Purchaser: Tripti Dhaval Kumar Pate
TRIPTI DHAVAI KUMAR PATE

Vendor: Forrestida Estates Inc

Notes

****KITCHEN - INSTALL UPGRADE APPLIANCE PACKAGE - UPGRADE PACKAGE #1,
TO BE INSTALLED THROUGHOUT HOUSE. WHERE APPLICABLE.**

****KITCHEN - INSTALL UPGRADE MICROWAVE / HOOD FAN COMBINATION UNIT (AS PER UPGRADE #1 APPLIANCE PACKAGE)**



* INTERIOR COLOUR SCHEME *

Purchasers	Decor Consultant	Model and Elevation	Telephone Res. / Bus	Project	Closing Date	Property
DHAVALKUMAR PATEL & DHAVALKUMAR ASHOKKUMAR P.	Melissa Di Marino	MORNING GLORY-ELEV B	(647) 879-5381 /	Forestside Estates Inc.	31/08/2020	4 Block 3

Purchaser(s) acknowledge the following

Arborite Counter Top Waiver:

Purchaser acknowledges that countertops are susceptible to damage/swelling from standing water. Care must be taken to ensure that countertops are kept free of standing water at joints and openings at sinks and faucets. Delamination can also occur caused by excessive heat from appliances and cooking equipment. Therefore, the Vendor assumes no responsibility for these conditions if caused by the Purchaser's negligence.

Hardwood Floor/Stair Waiver

Purchaser acknowledges and accepts that the hardwood flooring is pre-finished in a factory in a controlled environment and that the stairs are finished on site. The vendor will do their best to match the color between the stairs and the floor, but it is not possible to have an identical match and that there will be shade differences.

Standard Appliance Specifications Waiver:

In lieu of supplying appliance specifications and/or special requirements, the purchaser acknowledges that cabinetry will be made to allow for standard openings only. Standard opening sizes are as follows:

- Fridge: 36" wide x 72 1/2" high
- Stove: 31" wide
- Dishwasher: 24" wide
- OPTIONAL Microwave box: 24" wide x 15" high x 19" deep

and only those appliances that fit the standard openings should be selected and purchased.

Hardwood Floor Waiver:

Hardwood floors installed by the Vendor will be fully warranted for one full year against any defects in workmanship, due to improper installation. The Purchaser acknowledges and understands that the vendor will not be responsible to repair the natural drying out of wood that may cause shrinkage.

Changes:

This Colour Sheet is FINAL. ANY changes requested are subject to Builder approval and a minimum administration fee of \$1,000.00 will be charged.

Page 3 of 3

Decor Consultant:

Melissa Di Marino

Purchaser:

TRUPTI DHAVALKUMAR PATEL

Purchaser:


DHAVALKUMAR ASHOKKUMAR PATEL

Vendor:

Forestside Estates Inc.

Lot 4 / BIK 3

Forestside
STANDARD SHOWER

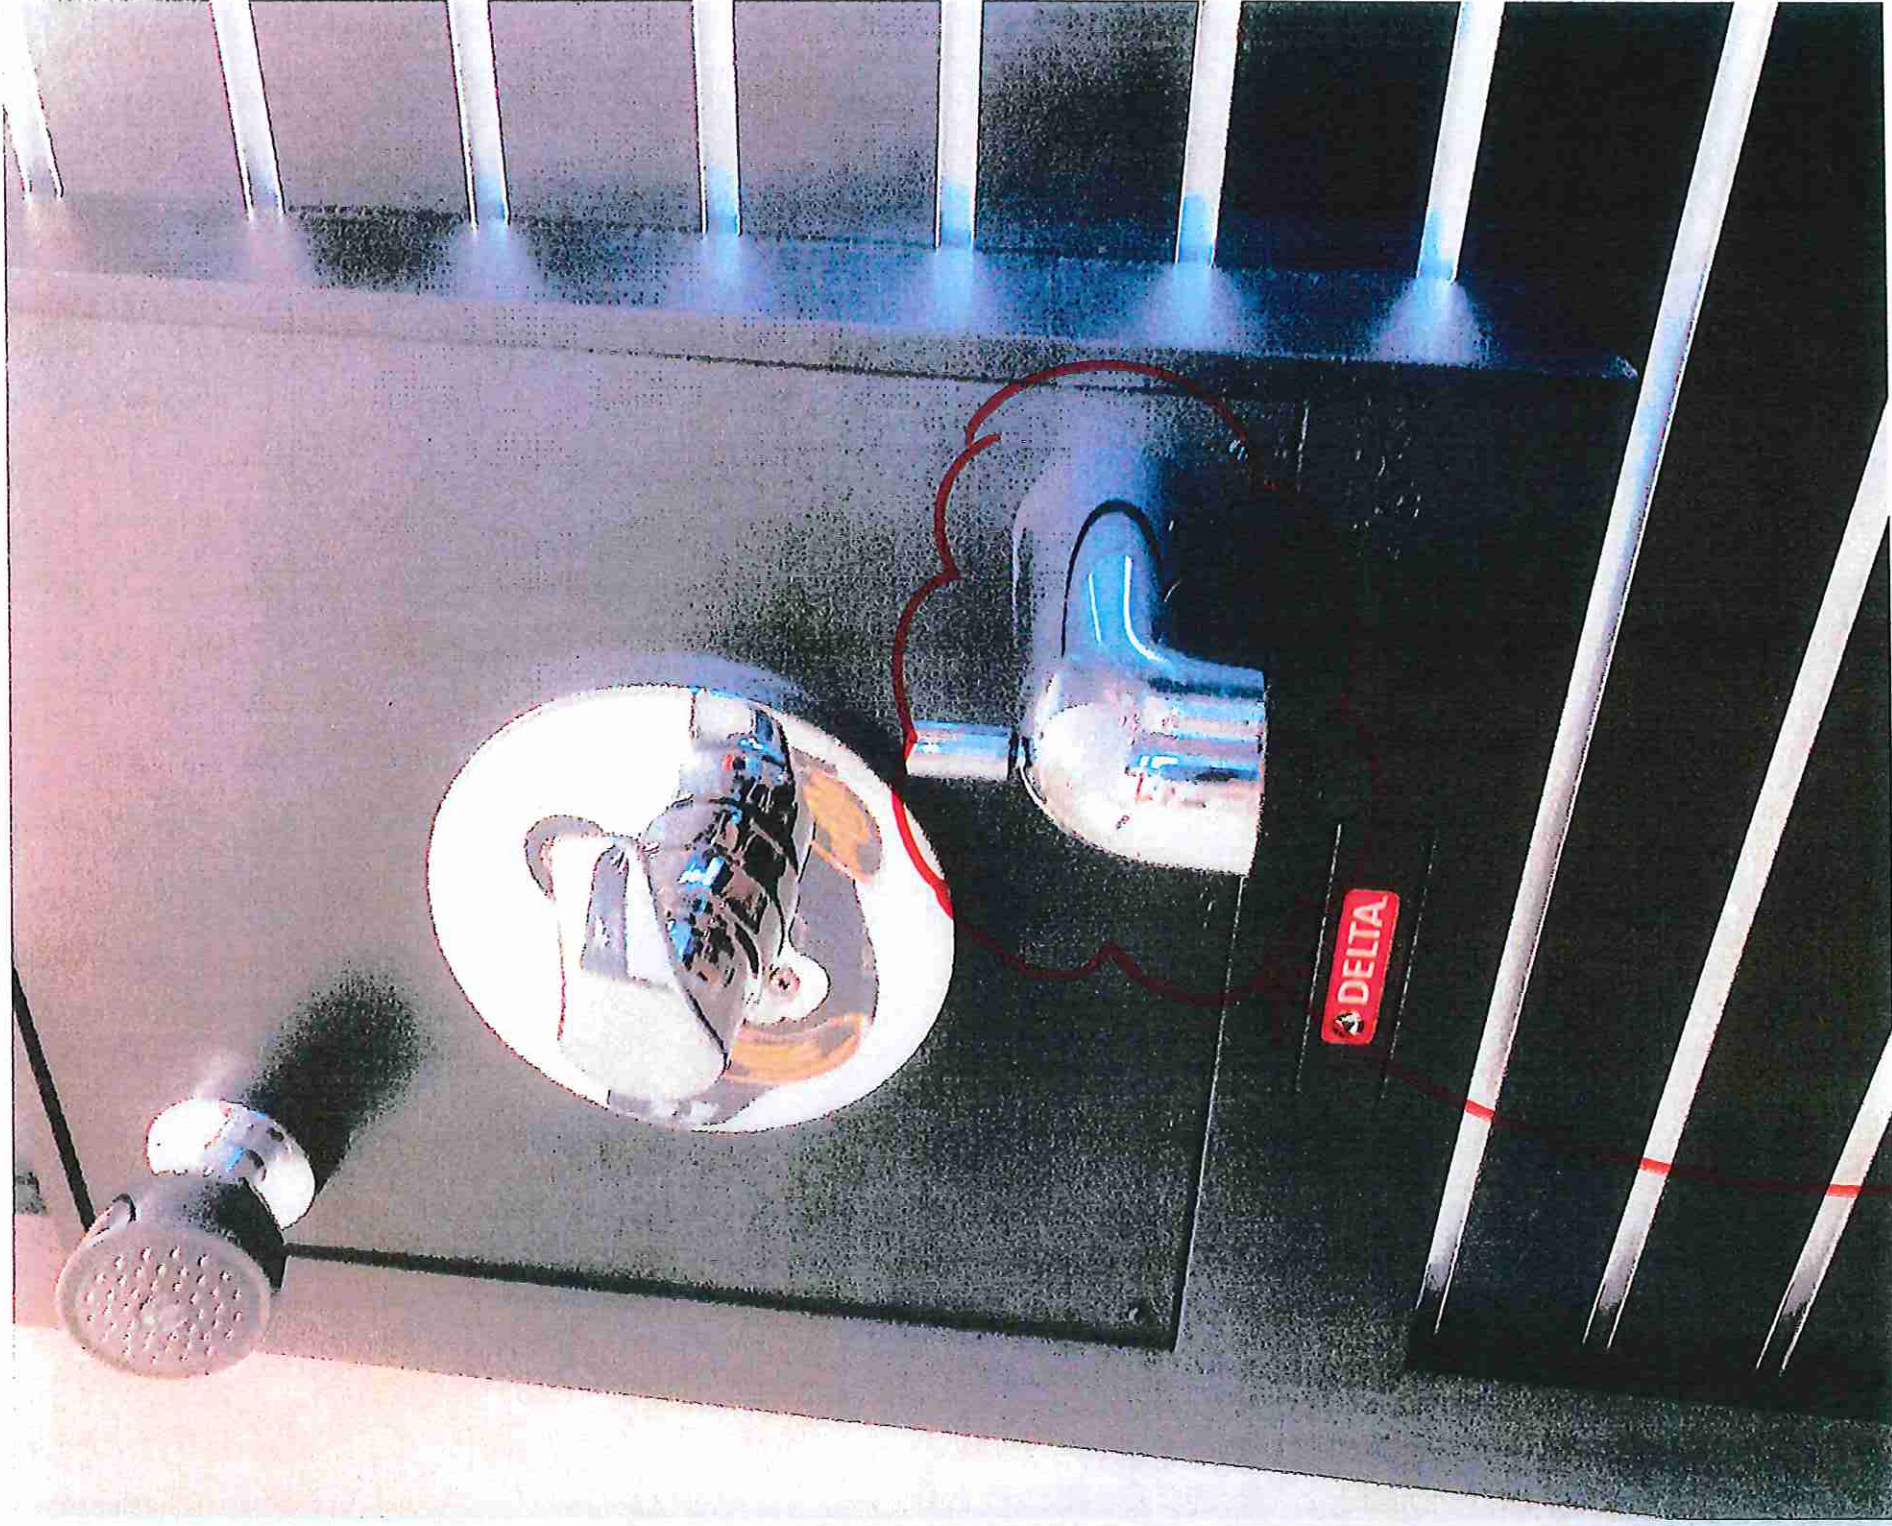

Install Toe Tester
Master Ensuite Shower
Stall

Lot 4 / BIK 3 Forestside

Villa

KITCHENS & FINE CABINETRY LTD

8111 Jane St. Unit 10
Concord, Ontario L4K 4L7
Tel. (905) 669-7028
Fax. (905) 669-7903
email: designstudio@villakitchens.ca
www.villakitchens.ca

CLIENT: ROYAL PINE HOMES

PROJECT: FORESTSIDE


ADDRESS: RP-FS(6)-BLOCK 3 LOT 04

MODEL: MORNING GLORY 2201 ELEV B + OPT SECOND FLOOR

KITCHEN

UPGRADE #1 APPLIANCE PACKAGE

February 26, 2020

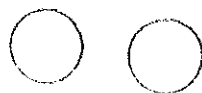


DRAWN BY: DIDI

DATE: FEBRUARY 26/2020

REVISION:

PAGE: 1 OF 6

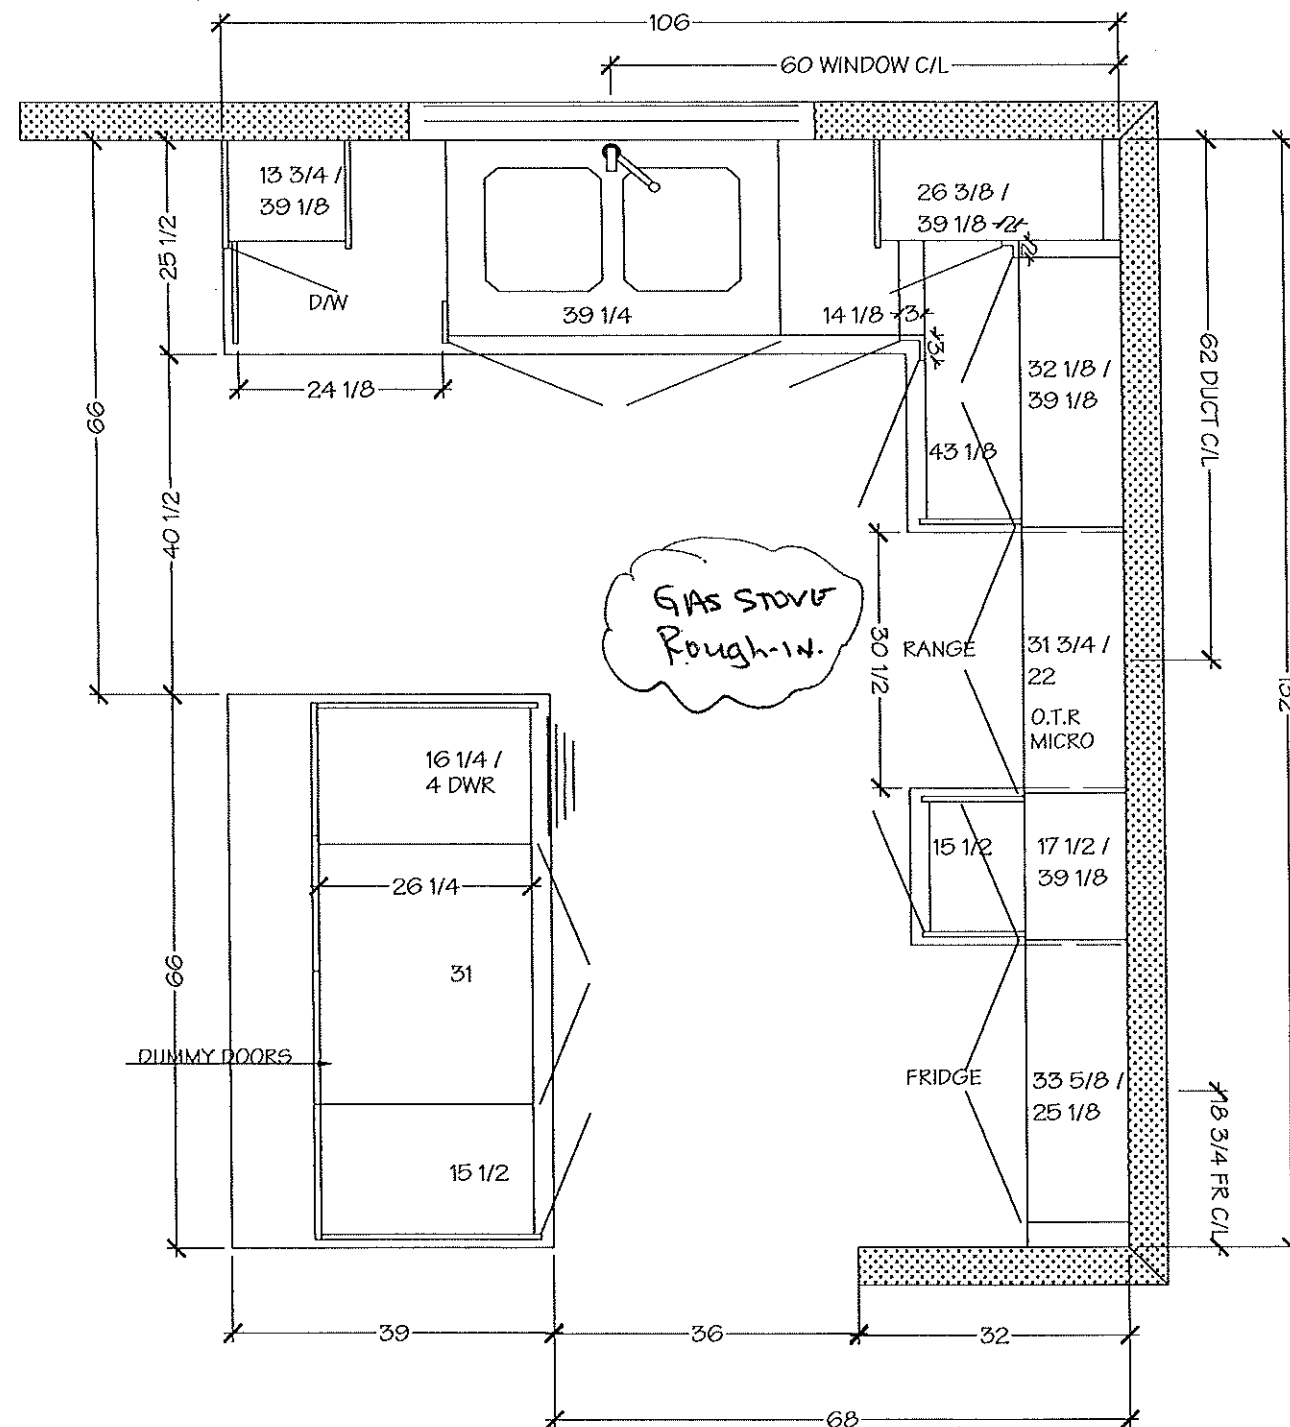

Lot 4 / BIK3 Forestside

Villa

KITCHENS & FINE CABINETRY LTD

8111 Jane St. Unit 10
Concord, Ontario L4K 4L7
Tel. (905) 669- 7028
Fax. (905) 669 - 7903
email: designstudio@villakitchens.ca
www.villakitchens.ca

CLIENT: ROYAL PINE HOMES
PROJECT: FORESTSIDE
ADDRESS: RP-FS(6)-BLOCK 3 LOT 04
MODEL: MORNING GLORY 2201 ELEV B + OPT SECOND FLOOR


KITCHEN

UPGRADE #1 APPLIANCE PACKAGE

February 26, 2020



DRAWN BY: DIDI
DATE: FEBRUARY 26/2020
REVISION:
PAGE: 2 OF 6

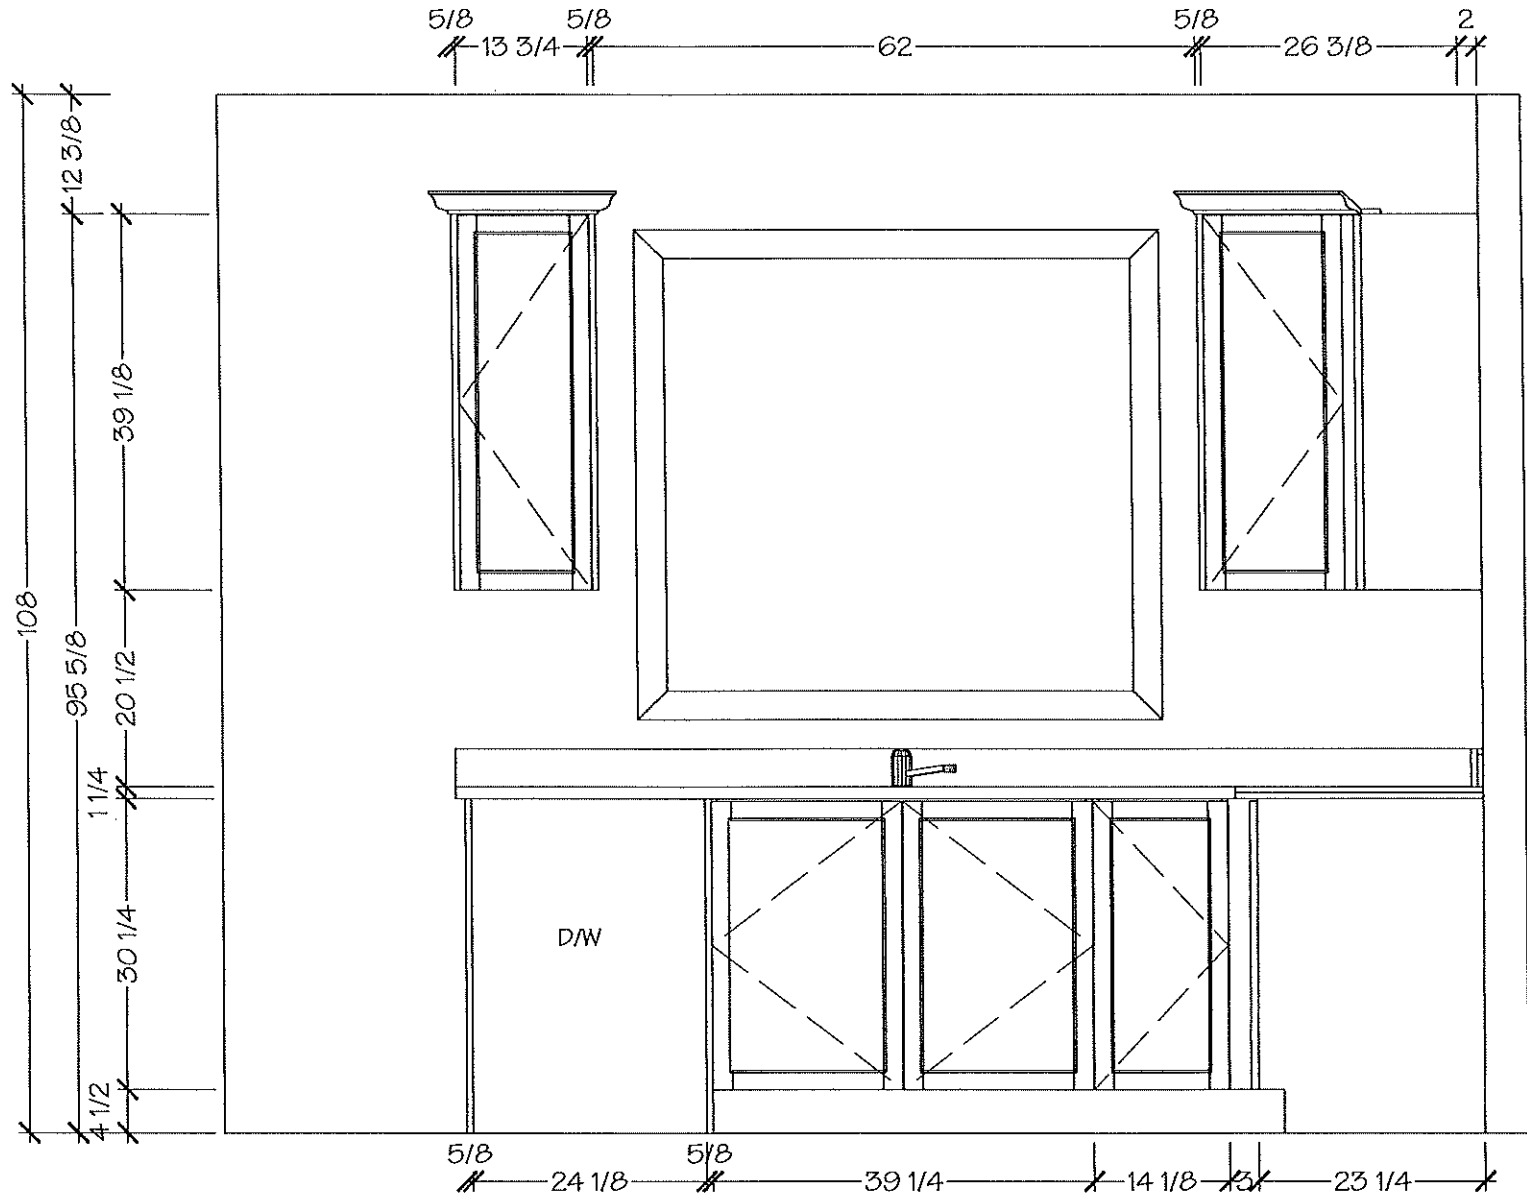

Lot 4 / BIK3 Forestside

Villa

KITCHENS & FINE CABINETS LTD

8111 Jane St. Unit 10
Concord, Ontario L4K 4L7
Tel. (905) 669-7028
Fax. (905) 669-7903
email: designstudio@villakitchens.ca
www.villakitchens.ca

CLIENT: ROYAL PINE HOMES

PROJECT: FORESTSIDE


ADDRESS: RP-FS(6)-BLOCK 3 LOT 04

MODEL: MORNING GLORY 2201 ELEV B + OPT SECOND FLOOR

KITCHEN

UPGRADE #1 APPLIANCE PACKAGE

February 26, 2020

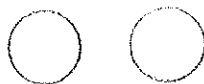


DRAWN BY: DIDI

DATE: FEBRUARY 26/2020

REVISION:

PAGE: 3 OF 6

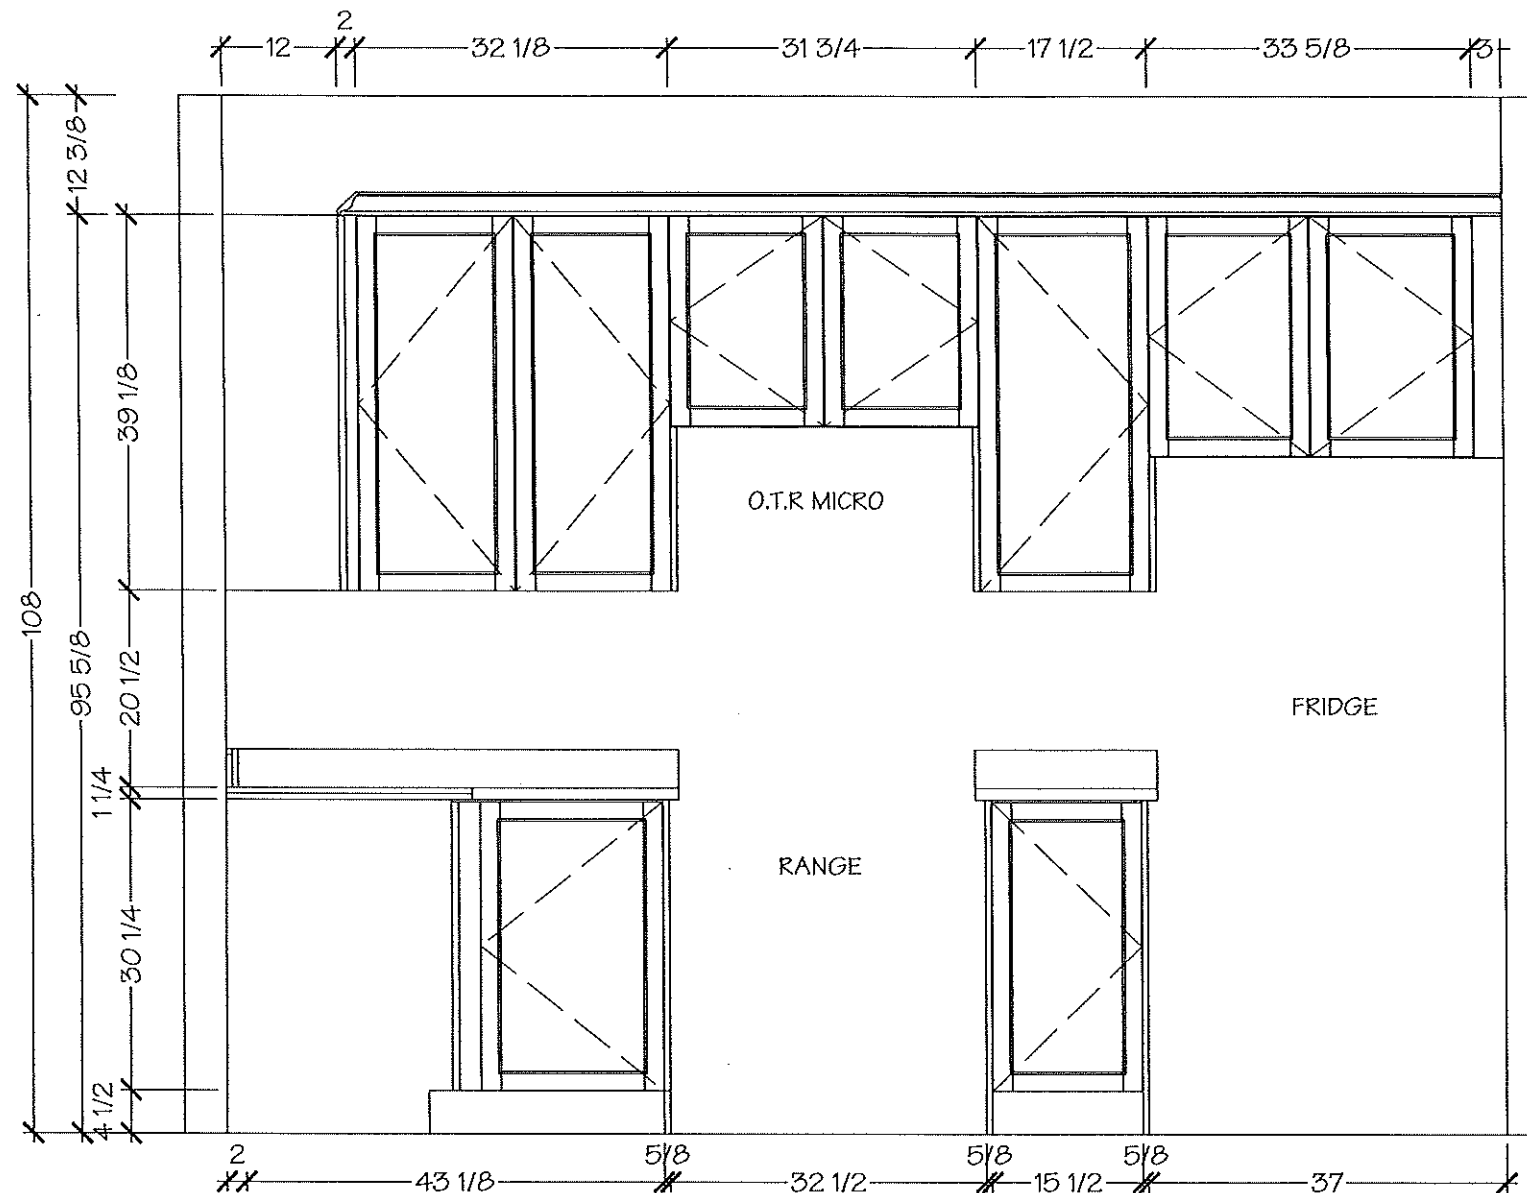

Lot 4 / B1K3 Forestside

Villa

KITCHENS & FINE CABINETRY LTD

8111 Jane St. Unit 10
Concord, Ontario L4K 4L7
Tel. (905) 669- 7028
Fax. (905) 669 - 7903
email: designstudio@villakitchens.ca
www.villakitchens.ca

CLIENT: ROYAL PINE HOMES
PROJECT: FORESTSIDE
ADDRESS: RP-FS(6)-BLOCK 3 LOT 04
MODEL: MORNING GLORY 2201 ELEV B + OPT SECOND FLOOR



KITCHEN

UPGRADE #1 APPLIANCE PACKAGE

February 26, 2020



DRAWN BY: DIDI
DATE: FEBRUARY 26/2020
REVISION:
PAGE: 4 OF 6

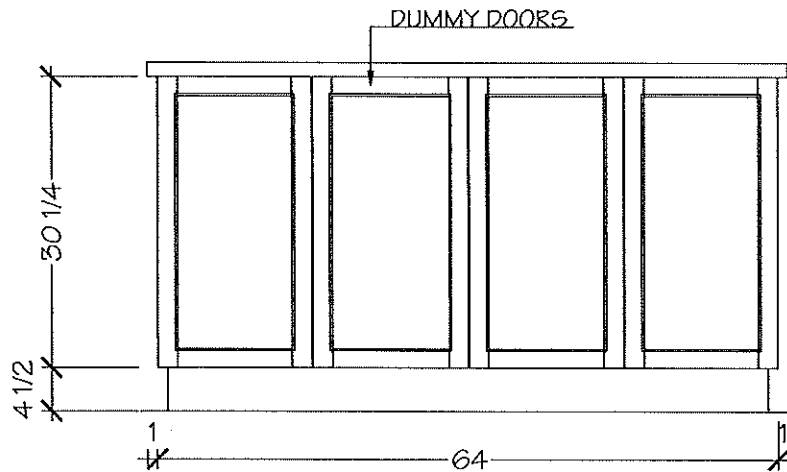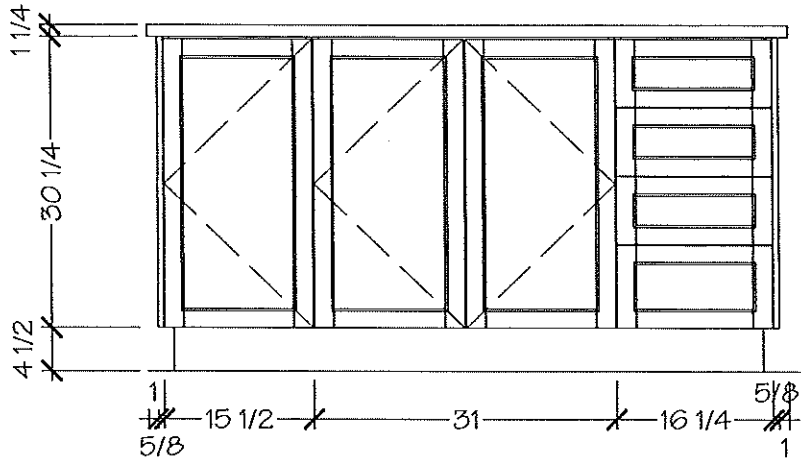

Lot 4 / BLK3 Forestside

Villa
KITCHENS & FINE CABINETS LTD

8111 Jane St. Unit 10
Concord, Ontario L4K 4L7
Tel. (905) 669- 7028
Fax. (905) 669 - 7903
email: designstudio@villakitchens.ca
www.villakitchens.ca


CLIENT: ROYAL PINE HOMES
PROJECT: FORESTSIDE
ADDRESS: RP-FS(6)-04 BLK 03
MODEL: MORNING GLORY 2201 ELEV B + OPT SECOND FLOOR

MAIN BATH


February 20, 2020



DRAWN BY: DIDI
DATE: FEBURARY 20/2020
REVISION:
PAGE: 2 OF 3

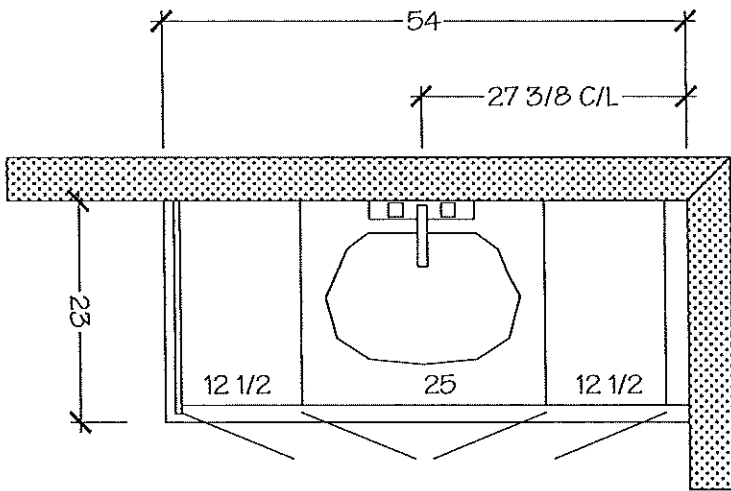

MAIN BATH

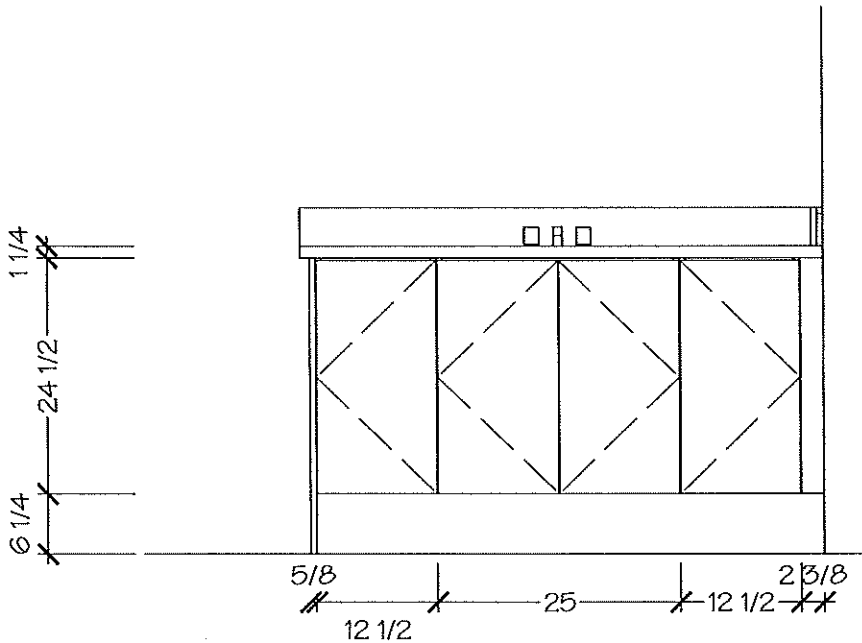

Lot 4 / BLK3 Forestside

Villa

KITCHENS & FINE CABINETRY LTD

8111 Jane St. Unit 10
Concord, Ontario L4K 4L7
Tel. (905) 669- 7028
Fax. (905) 669 - 7903
email: designstudio@villakitchens.ca
www.villakitchens.ca


CLIENT: ROYAL PINE HOMES
PROJECT: FORESTSIDE
ADDRESS: RP-FS(6)-04 BLK 03
MODEL: MORNING GLORY 2201 ELEV B + OPT SECOND FLOOR

MASTER ENSUITE


February 26, 2020



DRAWN BY: DIDI
DATE: FEBURARY 20/2020
REVISION:
PAGE: 3 OF 3

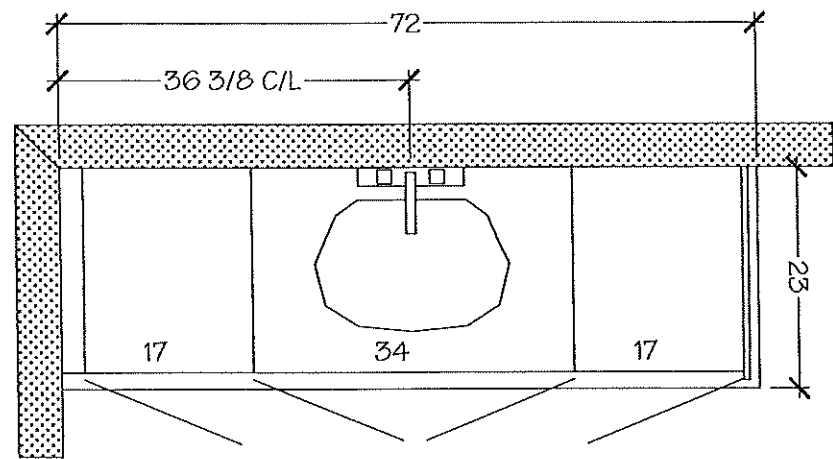


MASTER ENSUITE

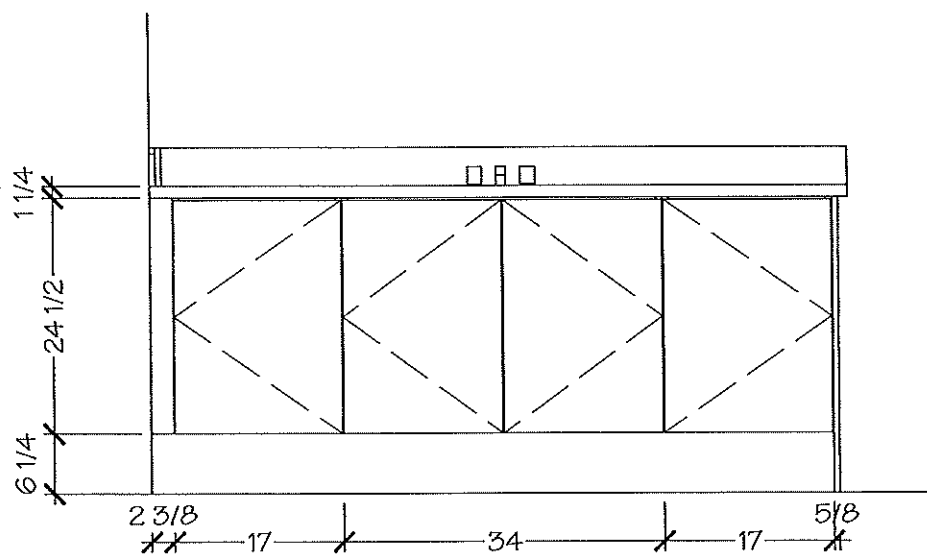

pg 1

Lot 4 / BIK3
Forestside

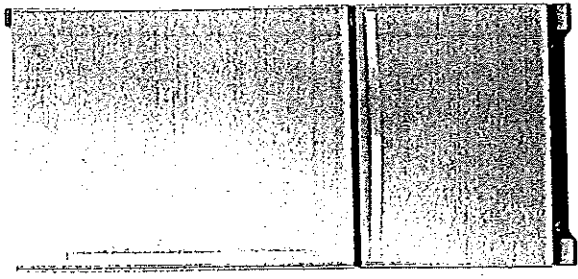

Whirlpool® 22 cu. ft. Bottom-Freezer Refrigerator with Freezer Drawer

WRB322DMBM

Storing all of your favorite fresh and frozen foods is easy with this 22 cu. ft. capacity bottom-freezer refrigerator featuring a convenient freezer drawer that places frozen items in close reach, making it easy to organize and find exactly what you need. You'll be able to keep food at the right temperature without wasting energy thanks to the Accu-Chill™ temperature management system, which uses built-in sensors to measure internal temperature and activates the compressor only when necessary. That food will look just as it should with energy-efficient LED lights, which cast a more natural light, while the FreshFlow™ produce preserver extends the freshness of produce for up to 4 days longer* to keep fruits and vegetables tasting great.

Top Features

Spillproof Glass Shelves
Simplify cleanup with shelves that help contain spills and prevent liquids from leaking below.

FreshFlow™ Produce Preserver
Keep fruits and veggies in the ideal environment to help produce stay fresher longer.*

Deli Drawer
Store plenty of meat and cheese with a deli drawer.

Humidity-Controlled Crispers
Store fruits and vegetables in their ideal environment.

Accu-Chill™ Temperature Management System
Cool food quickly with technology that senses and adapts to create the ideal environment for food.

Available Finishes/Colours

- WRB322DM8B Black
- WRB322DMBW White
- WRB322DMBM Stainless Steel
- WRB322DMHV Black Stainless

Manuals & Literature:

- Use and Care
- Energy Guide
- Dimension Guide
- Warranty

Dimensions

Depth	33 3/8
Height	70
Width	32 5/8
Cutout Height	69
Cutout Width	33
Height To Top Of Cabinet	68 1/2
Depth With Door Open 90 Degree	62
Depth Excluding Handles	30 7/8
Depth Closed Including Handles	33 3/8
Width of Cabinet Only	32 5/8

Dimensions

Width with Doors Closed	32 3/4
-------------------------	--------

Performance

Freezer Capacity	6.45
Refrigerator Capacity	15.62
Energy Star® Qualified	ENERGY STAR® Qualified

Refrigerator Features

Humidity-Controlled Drawers	2 Half-Width
Lighting	LED
Number of Interior Shelf(s)	5

Spill-Proof Glass Shelf(s)



- 1 Fixed Full-Width, 4 Adjustable Half-Width

grade 1 Lot 4 / BIKS POWERSTAR



Whirlpool® 6.4 Cu. Ft. Front Control Electric Range with True Convection

YWEE745H0FS

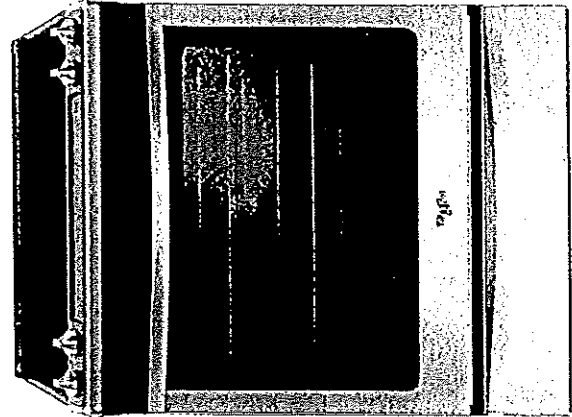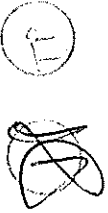

Take on family favorites with this front control electric range designed to fit your kitchen and your cooking. Frozen Bake™ technology lets you skip preheating for frozen dishes like pizza, lasagna, chicken nuggets, fries or pies. Cook food faster** with the kitchen range's true convection cooking. Convection Conversion will do the math for you to adjust cooking times and temperatures. The FlexHeat™ triple radiant element is like having three elements in one to fit small pots and pans and make room for larger cookware on the range stove. Plus, when it's time to clean up, AquaLift® self-cleaning technology provides odor-free cleaning without harsh chemicals in only 50 minutes.**

Top Features

Frozen Bake™ Technology
Frozen Bake™ technology cooks frozen foods faster¹ by eliminating the need to preheat the oven. Just select the food type, temperature and cook time listed on the frozen item's package and the oven will start customizing. Now you can cook frozen pizza 31% faster², and even lasagna, chicken nuggets, fries and pies can get from the oven to the table in less time.

True Convection Cooking
True convection cooking helps you cook foods faster² by using a third element plus a fan to distribute hot air evenly over, under and around food.

FlexHeat™ Triple Radiant Element
The FlexHeat™ triple radiant element is like having three elements in one. A 6" inner ring is great for smaller pots and pans, while 9" and 12" outer rings make room to heat larger cookware.

Convection Conversion
Your oven will do the math for you when you need to convert traditional recipes for convection cooking, automatically adjusting cooking times and temperatures.

Available Finishes/Colours

- YWEE745H0FH
- Other YWEE745H0FS Stainless Steel

Manuals & Literature:

- Use and Care Energy Guide
- Installation Instructions Warranty

Dimensions

Height 36
Width 29 7/8

Center Rear Element-Burner Size 6"

Center Rear Element-Burner Type Warming

Configuration and Overview

Fuel Type Electric
Range Type Slide-in

Left Front Element-Burner Power 3000W

Left Front Element-Burner Size 12"9"9/8"

Cooktop Features

Cooktop Element Style Radiant
Cooktop Surface Color Black
Cooktop Surface Material Ceramic Glass

Number of Cooking Element-Burners 5

Center Rear Element-Burner Power 100W

Left Front Element-Burner Type Triple

Left Rear Element-Burner 300W1300W Power

APPLIANCE CANADA LTD

Nadia Lalomia
nlalomia@appliancescanada.com

91 Caldari Road
Concord, ON L4K 3Z9
(905) 660-2424 x 2325



Page 3 of 8



Because Whirlpool Corporation policy includes a continuous commitment to improve our products, we reserve the right to change materials and specifications without notice. Dimensions are for planning purposes only. For complete details, see Installation Instructions packed with product. Specifications subject to change without notice.

Upgrade 1

Lot 4 / BLK3
Forestside

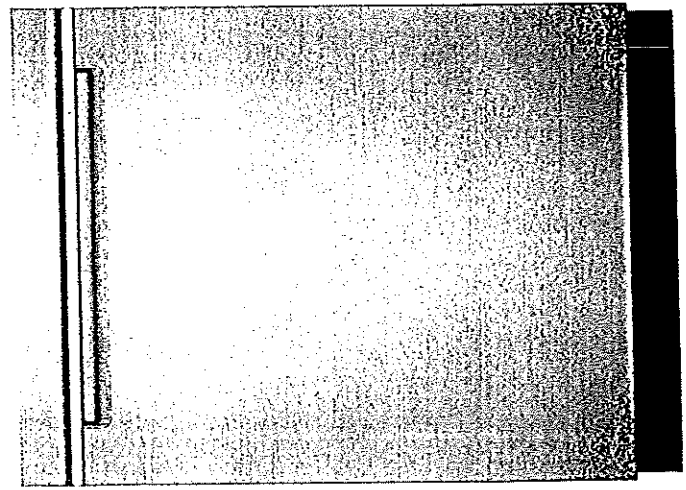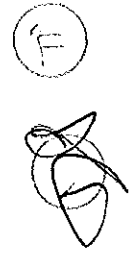

Whirlpool® Stainless Steel Tub Pocket Handle Dishwasher with TotalCoverage Spray Arm

WDTA50SAHZ

Get the right clean for your dishes with this stainless steel dishwasher. Choose the Sensor cycle and let your dishwasher pick the right cycle for you, then get more water pressure with the TotalCoverage spray arm that cleans with twice the jets²11. Finish up with dry dishes thanks to the stainless steel tub.

Top Features

TotalCoverage spray arm
Cleans with twice the jets²11 for more coverage while a smarter sequence of spray patterns from multiple nozzles hits your dishes with increased water pressure.

Sensor cycle
Automatically get the right wash and dry settings for each load with two sensors that measure temperature, soil level and load size during prewash and the wash cycle.

1-Hour Wash Cycle
Clean dishes in half the time³ so your plates, pans and glasses are thoroughly cleaned up and taken care of in just an hour.

Tap Touch controls
Clean these controls as easily as you use them.

Soil sensor
Determines how dirty dishes are and adjusts the Normal cycle as needed to make sure dishes come out clean.

Dimensions		Configuration and Overview	
Depth	24 1/2	Sensor	Yes
Height	34 1/2	Decibel Level (dBA)	47
Width	23 7/8	Dispensers	Detergent and Rinse Aid
Depth With Door Open 90 Degree	49 1/2	Number of Wash Levels	3
Carton Depth	26 1/2	Rinse Aid Dispenser Level Indicator	Yes
Carton Height	35 5/8	Sound Package	Yes
Carton Width	24 1/2		

Configuration and Overview		Controls	
Dishwasher Type	Built-In	Dishwasher Cycle Selections	1-Hour Wash, Heavy, Normal, Sensor Wash, Soak & Clean
Number of Place Settings	15		
Control Type	Electronic Touch	Number of Wash Cycles	5

Manuals & Literature:

- [Use and Care](#)
- [Dimension Guide](#)
- [Energy Guide](#)
- [Installation Instructions](#)
- [Warranty](#)

Available Finishes/Colours

- WDTA50SAHB Black
- WDTA50SAHN FingerPrint Resistant Sunset Bronze
- WDTA50SAHW White
- WDTA50SAHV FingerPrint Resistant Black Stainless Steel
- WDTA50SAHZ FingerPrint Resistant Stainless Steel

APPLIANCE CANADA LTD
Nadia Lalomia
nlalomia@appliancecanada.com

91 Caldari Road
Concord, ON L4K 3Z9
(905) 660-2424 x 2325




Because Whirlpool Corporation policy includes a continuous commitment to improve our products, we reserve the right to change materials and specifications without notice. Dimensions are for planning purposes only. For complete details, see Installation Instructions packed with product. Specifications subject to change without notice.

Upgrade! Lot 4 / BILK5 Forestside



Whirlpool® Smart 1.9 cu. ft. Over the Range Microwave with Multi-step cooking¹¹

YWMHA9019HZ

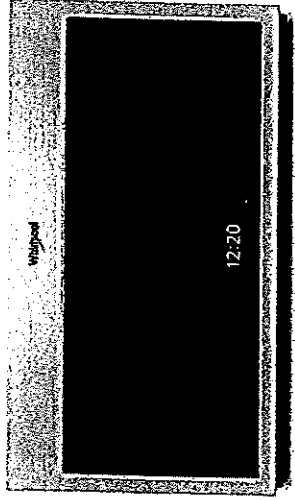

Available Finishes/Colours

- YWMHA9019HN
FingerPrint
Resistant Sunset
Bronze
- YWMHA9019HV
Black Stainless
- YWMHA9019HZ
FingerPrint
Resistant Stainless
Steel

Manuals & Literature:

[Installation Instructions](#)

Make multi-step meals more simple by using your smartphone or tablet to send multiple cooking instructions to the oven all at once. Your smart microwave remembers family favorites when you use the touchscreen, and bakes food right in the microwave with our convection microwave's True convection cooking setting. Plus, this over therange microwave is fingerprint-resistant so smudges don't happen.

Top Features

- Touchscreen**
Get instant access to the settings you use most with an intuitive touchscreen that learns, adapts and suggests customized presets based on your family's routines.
- Smart Appliance**
Care for your family from your smartphone or tablet.²
- Multi-Step Cooking¹¹**
Make multi-step meals more simple. Use your smartphone or tablet to send multiple cooking instructions to the oven all at once. The temperature automatically adjusts based on the recipe you enter for great results without having to monitor your meal.
- Proximity Sensor**
Easily read your display while you cook no matter where you are in the kitchen with a sensor that knows when you're close and adjusts the display text size based on your distance.
- Guided Service**
Keep track of scheduled appointments and make sure issues are known using the Whirlpool® app to send data from the appliance directly to Whirlpool brand customer service.⁴³

Dimensions

Depth	16
Height	17 1/8
Width	29 15/16

Configuration and Overview

Fan CFM	400
Venting Type	Exterior or Recirculating

Ventilation Features

Odor Removal Filter (charcoal)	Charcoal Odor Removing Filter
-----------------------------------	----------------------------------

Controls

Number of Speeds	4
------------------	---

APPLIANCE CANADA LTD
Nadia Lalomia
nlalomia@appliancacanada.com




Because Whirlpool Corporation policy includes a continuous commitment to improve our products, we reserve the right to change materials and specifications without notice. Dimensions are for planning purposes only. For complete details, see Installation Instructions packed with product. Specifications subject to change without notice.


Upgrade!

Lot 4 / BLK3

Forestside

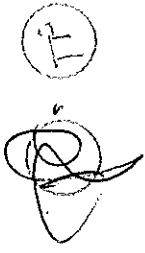

Whirlpool®

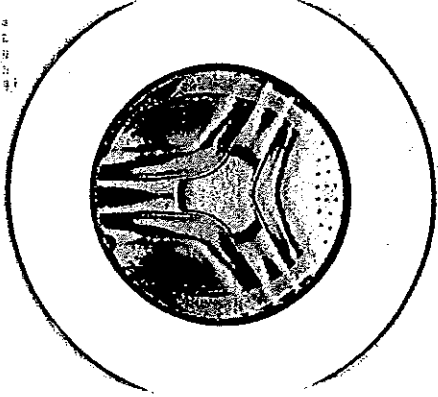

Available Finishes/Colours

- WFW560CHW
- White

Manuals & Literature:

- Use and Care
- Installation Instructions
- Energy Guide
- Warranty

Whirlpool® 5.0 cu.ft I.E.C. Closet-Depth Front Load Washer with Intuitive Controls

WFW560CHW

Match your family's routines and your space with a closet-depth front load washing machine that still offers plenty of room for bulky items at 5.0 cu. ft. I.E.C. capacity. Let the ENERGY STAR® certified washer guide you to the right cycle combinations, like the Sanitize cycle with Oxi, or customize up to 35 of your own with Intuitive Controls.

Top Features

5.0 cu. ft. I.E.C. Capacity
Get plenty of room for bulky items with 5.0 cu. ft. I.E.C. capacity.

ENERGY STAR® Certified
ENERGY STAR® certified models exceed government standards to help conserve natural resources and save money on your utility bills.

Intuitive Controls
Let the washer guide you to the right cycle combinations or customize up to 35 of your own to get the right type of fabric care for whatever you're washing.

Sanitize Cycle with Oxi
The Sanitize cycle with Oxi eliminates 99.9% of common household bacteria^{2,1} by mixing detergent with an oxi additive.

Quick Wash Cycle
Your small, lightly soiled loads will be clean in as little as 15 minutes with the Quick Wash cycle.³

Dimensions

Width	27
Depth	31 9/16
Minimum Height	38 5/8

Controls

Pedestal Options	WFP2715HW, XHP1000XW
Stackable	Yes
Maytag Commercial Technology Components	No
LED Color	Blue
Display Type	Cycle Indicator Lights with Digital Time Remaining

Configuration and Overview

CEE Tier Rating	Tier 1
Energy Star® Qualified	ENERGY STAR® Qualified

UL

UL

Controls

Out of Balance Sensing	Yes
Hoses Included	4ft 4in Drain Hose Included
Basket Material	Stainless Steel
Motor Drive Type	Direct Drive

Cycle and Options

Number of Spin Speeds	4
Number of Soil Levels	3
Temperature Combinations	Hot, Cold, Cool, Warm

APPLIANCE CANADA LTD
Nadia Lalomia
nlalomia@appliancescanada.com

91 Caldwell Road
Concord, ON L4K 3Z9
(905) 660-2424 x 2325

ENERGY STAR





Because Whirlpool Corporation policy includes a continuous commitment to improve our products, we reserve the right to change materials and specifications without notice. Dimensions are for planning purposes only. For complete details, see Installation Instructions packed with product. Specifications subject to change without notice.

upfront!

Whirlpool®

Lot 4 / Blks Forestside
Whirlpool® 7.4 cu. ft. Front Load Electric Dryer
with Intuitive Touch Controls

YWED5620HW

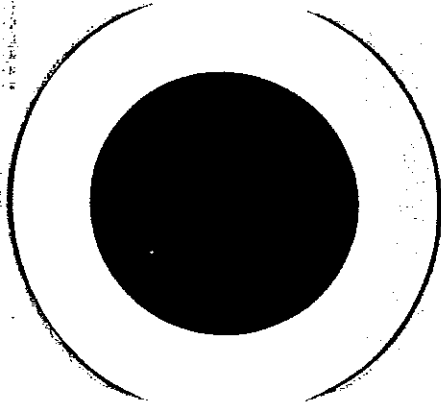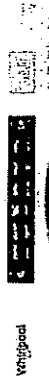

Let the front load electric dryer guide you to the right cycle combinations for whatever you're drying with Intuitive Controls. Advanced Moisture Sensing uses three moisture sensors to help prevent overdrying. The ENERGY STAR® certified electric dryer helps keep wrinkles from setting after the cycle with the Wrinkle Shield™ option.

Top Features

Advanced Moisture Sensing
Help prevent overdrying. Three sensors track moisture and temperature, adapting drying times to end the cycle at just the right time.

Wrinkle Shield™ Option

7.4 cu. ft. Capacity
Get plenty of room to dry the large loads you washed in the matching front load washer. This 7.4 cu. ft. dryer easily handles bulky items like comforters and sleeping bags.

Intuitive Controls

Let the dryer guide you to the right cycle combinations or customize up to 36 of your own to get the right type of fabric care for whatever you're drying.

Quad Baffles

Four baffles tumble clothes in a randomized pattern, allowing items to open up freely. This helps increase the effectiveness of the dryer for small loads.

Available Finishes/Colours

- YWED5620HW
- White

Manuals & Literature:

- Use and Care
- Installation Instructions
- Warranty

Dimensions

Height	38 3/4
Width	27
Depth	31

Cycle and Options

Cycle Time Remaining	Yes
EcoBoost™/Energy Saver	Yes
Lint Filter Indicator	No
Maytag Commercial Technology Components	No

Configuration and Overview

Venting Direction	Left, Right, Bottom, Rear
Maximum Vent Length	64
Fuel Type	Electric
Capacity	7.40
Energy Star® Qualified	ENERGY STAR® Qualified

Dryer Option Selections	Control Lock, Cycle Signal, Eco Boost™, Damp Dry Signal
-------------------------	---

Temperature Selections

High, Low, Medium, Air Only

Cycle and Options

Number of Dryer Cycles	36
Advanced Moisture Sensor	Yes

Style and Extras

Drum Material	Powder Coat
---------------	-------------

APPLIANCE CANADA LTD
Nadia Lalomia
nlalomia@appliancecanada.com

91 Caldari Road
Concord, ON L4K 3Z9
(905) 660-2424 x 2325

Page 7 of 8

Appliance Canada
For more information

Because Whirlpool Corporation policy includes a continuous commitment to improve our products, we reserve the right to change materials and specifications without notice. Dimensions are for planning purposes only. For complete details, see Installation Instructions packed with product. Specifications subject to change without notice.