



**UNITED ENGINEERING INC**  
Mechanical and Electrical Consulting Engineers

3645 Keele St. #105  
Toronto, ON, M3J 1M6  
Email: info@u-eng.ca  
T: (416) 398-1999  
F: (416) 398-1933

## **SITE SUPPLEMENTAL INSTRUCTION**

**PROJECT:** Forestside Estates  
Attmar & Palleschi Drive  
Brampton, Ontario

**PROJECT NO.:** 18-017

**CONTRACT:** Electrical

**DATE:** May 04, 2021

**SITE SI NO.** E-4

---

THIS SITE SUPPLEMENTAL INSTRUCTION IS NOT TO BE CONSTRUED AS A CHANGE IN THE CONTRACT PRICE, BUT IS ISSUED FOR CLARIFICATION ONLY. IF A CHANGE IN CONTRACT PRICE IS PERCEIVED, PROVIDE AN ITEMIZED BREAKDOWN OF ANY EXTRAS OR CREDITS WITHIN SEVEN (7) WORKING DAYS.

**PURPOSE:** Revised as per updated architecture drawings.


**1.0 Reference Drawings E-2B (Parking Level Part B - Electrical) Issued  
E-2C (Parking Level - Electrical Room Layout)**

1.1 **Revise:** Electrical layout for sub electrical room A area as shown.

**PREPARED BY:** \_\_\_\_\_

*Susan Pan*  
Susan Pan  
Electrical Department

ISSUED TO ROYAL PINE HOMES,  
Cinzia Caruso, Cinzia@royalpinehomes.com;  
Vince Staffieri, vince@royalpinehomes.com;  
FOR DISTRIBUTION TO ALL AFFECTED PARTIES.

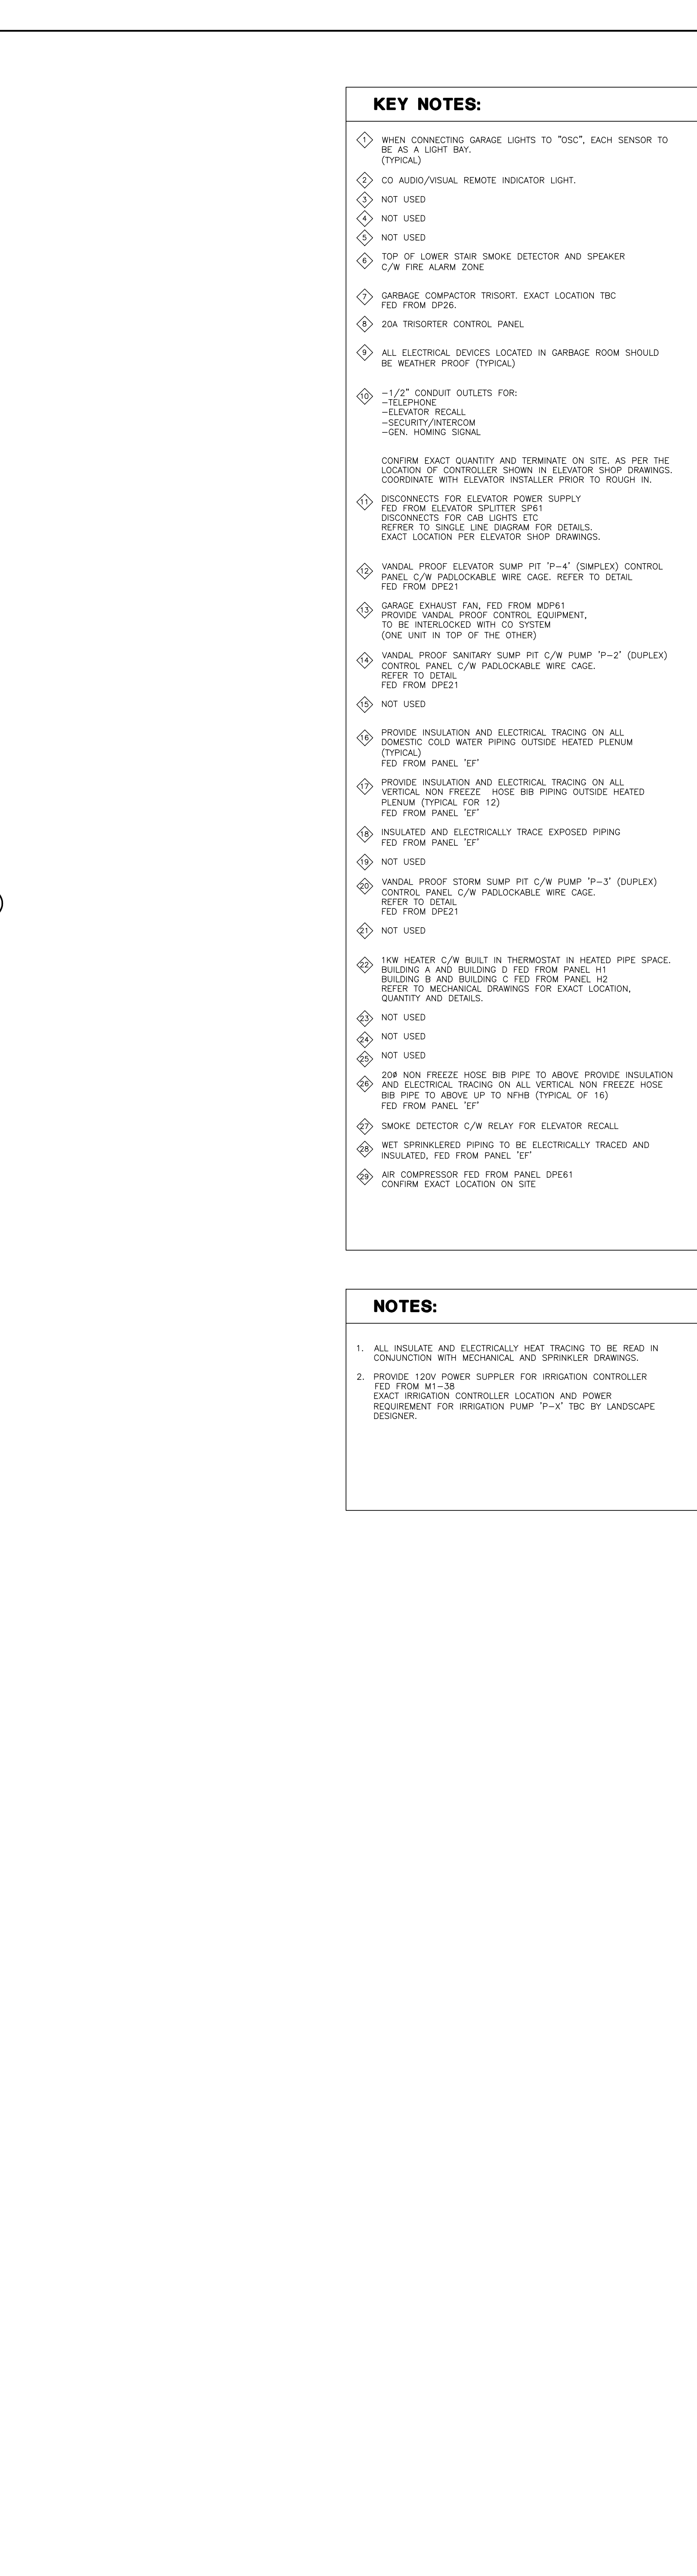

GENERAL NOTES:

1. A COMPLETE NETWORKED GAS DETECTION AND CONTROL SYSTEM TO BE PROVIDED AND INSTALLED WHERE THE VENTILATION SYSTEM WILL BE HOODED UP DIRECTLY TO THE GAS DETECTION SYSTEM (REFER TO CO HOBSON SYSTEM TYPICAL INSTALLATION DETAIL FOR MORE INFORMATION).

2. FINAL DRIFT DRP+ AND TEST POINTS LOCATIONS MUST BE CO-ORDINATED WITH THE FIRE PROTECTION CONTRACTOR ON SITE. ALL DRIFT DRP+3 AND TEST POINTS TO BE ELECTRICALLY TRACED AND INSULATED (TYPICAL).  
(REFER TO FIRE PROTECTION DRAWINGS FOR EXACT LOCATION FOR DRIFT DRP+3. TEST CONNECTIONS, PHC AND OTHER FIRE TRACING REQUIREMENT IN THE PROTECTION SYSTEM AS NOT AVAILABLE AT THE TIME OF TENDER)

3. FINAL EXPOSED P+ TRAPS MUST BE CO-ORDINATED WITH MECHANICAL CONTRACTOR ON SITE. ALL EXPOSED P+ TRAPS TO BE ELECTRICALLY TRACED AND INSULATED (TYPICAL).

4. PROVIDE LIGHT SWITCHES/OCCUPANCY SENSORS WHICH IS (ARE) INTRODUCED WITH THE OPERATION OF THE EXHAUST FAN SERVING THE ROOM FOR MECHANICAL ROOMS AND STORAGE ROOMS. ELSE PROVIDE SHOPS OPERATION FOR THOSE FANS. REFER TO MECHANICAL FAN SCHEDULE FOR FANS TO BE SHOPS OPERATION (TYPICAL).

5. ALL OCCUPANCY SENSOR INSTALLATION TO BE AS PER MANUFACTURER RECOMMENDATION

6. EXT SIGNS TO BE 5V OR LESS PER FACE.

10	SP	ISSUED FOR SITE INSTRUCTION E-4	MAY. 04, 2021
09	SP	ISSUED FOR SITE INSTRUCTION E-1	APR. 13, 2021
08	SP	ISSUED FOR PROGRESSIVE CONSTRUCTION	MAR. 26, 2021
07	SP	ISSUED FOR PERMIT BUILDINGS A, B, C, D	MAR. 03, 2021
06	SP	ISSUED FOR ADD E-4	FEB. 08, 2021
05	SP	ISSUED FOR ADD E-3	JAN. 18, 2021
04	SP	ISSUED FOR PERMIT	SEP. 28, 2020
03	SP	ISSUED FOR ADD E-2	JUN. 15, 2020
02	SP	ISSUED FOR ADD E-1	SEP. 16, 2019
01	SP	ISSUED FOR TENDER	AUG. 02, 2019
NO.	BY	DESCRIPTION	DATE

REVISIONS

This drawing, is an instrument of service, is provided by and is the property of United Engineering Inc.. The contractor must verify and accept responsibility for all dimensions and conditions on site and must notify United Engineering Inc. of any discrepancy before proceeding.


United Engineering Inc. is not responsible for the accuracy of Architectural, structural, interior design, etc., on this drawing.

Refer to the appropriate trade drawings before proceeding with any work. Installation must conform to all applicable codes and requirements of the authorities having jurisdiction.

This drawing is not to be scaled, all symbols are graphic representations only.

<



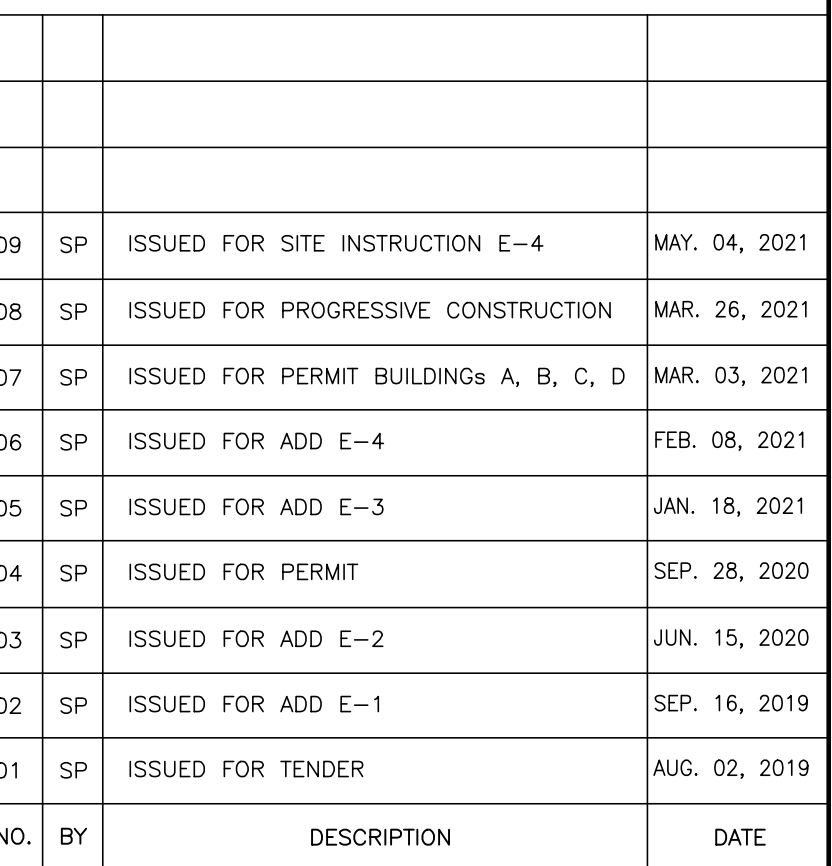


This drawing, is an instrument of service, is provided by and is the property of United Engineering Inc. The contractor must verify and accept responsibility for all dimensions and conditions on site and must notify United Engineering Inc. of any discrepancy before proceeding.

United Engineering Inc. is not responsible for the accuracy of Architectural, structural, interior design, etc. on this drawing.

Refer to the appropriate trade drawings before proceeding. Any work, or installation must conform to all applicable codes and requirements of the authorities having jurisdiction.

This drawing is not to be scaled, all symbols are graphic representations only.

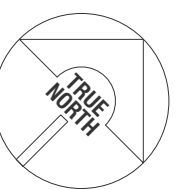

**UNITED ENGINEERING INC.**  
 Mechanical Electrical Consulting Engineers  
 3645 Keele Street, Suite 105,  
 Toronto, Ontario, M3J 1M6  
 Tel: (416) 398 1999, Fax: (416) 398 1933

TITLE	PARKING LEVEL ELECTRICAL ROOM LAYOUT
-------	---

**BRAMPTON STACKED  
FORESTSIDE ESTATES**

ATTMAR + PALLESCHI DRIVE  
BRAMPTON, ONTARIO

DRAWN SP	CHECKED MG	SCALE <b>1:150</b>
DATE  MAY, 2019	PROJECT  <b>18-017</b>	DRAWING <b>E-2C</b>
		OF <b>16</b>