

3645 Keele St. #105 Toronto, ON, M3J 1M6 Email:info@u-eng.ca T:(416)398-1999

F:(416)398-1933

## SITE SUPPLEMENTAL INSTRUCTION

PROJECT: Forestside Estates PROJECT NO.: 18-017

Attmar & Palleschi Drive

Brampton, Ontario

**CONTRACT:** Electrical

DATE: May 12, 2021 SITE SI NO. E-5

THIS SITE SUPPLEMENTAL INSTRUCTION IS NOT TO BE CONSTRUED AS A

CHANGE IN THE CONTRACT PRICE, BUT IS ISSUED FOR CLARIFICATION ONLY. IF A CHANGE IN CONTRACT PRICE IS PERCEIVED, PROVIDE AN ITEMIZED BREAKDOWN OF ANY EXTRAS OR CREDITS WITHIN SEVEN (7) WORKING DAYS.

**PURPOSE:** Revised as per elevator shop drawings.

1.0 Reference Drawings E-12 (Single Line Diagram - Electrical) Issued

1.1 Revise: Single line diagram as shown.

Power supply for elevators to be 600V, 3PH.

Susan Pan PREPARED BY:

Susan Pan


Electrical Department


ISSUED TO ROYAL PINE HOMES.

Cinzia Caruso, Cinzia@royalpinehomes.com;

Vince Staffieri, vince@royalpinehomes.com;

FOR DISTRIBUTION TO ALL AFFECTED PARTIES.

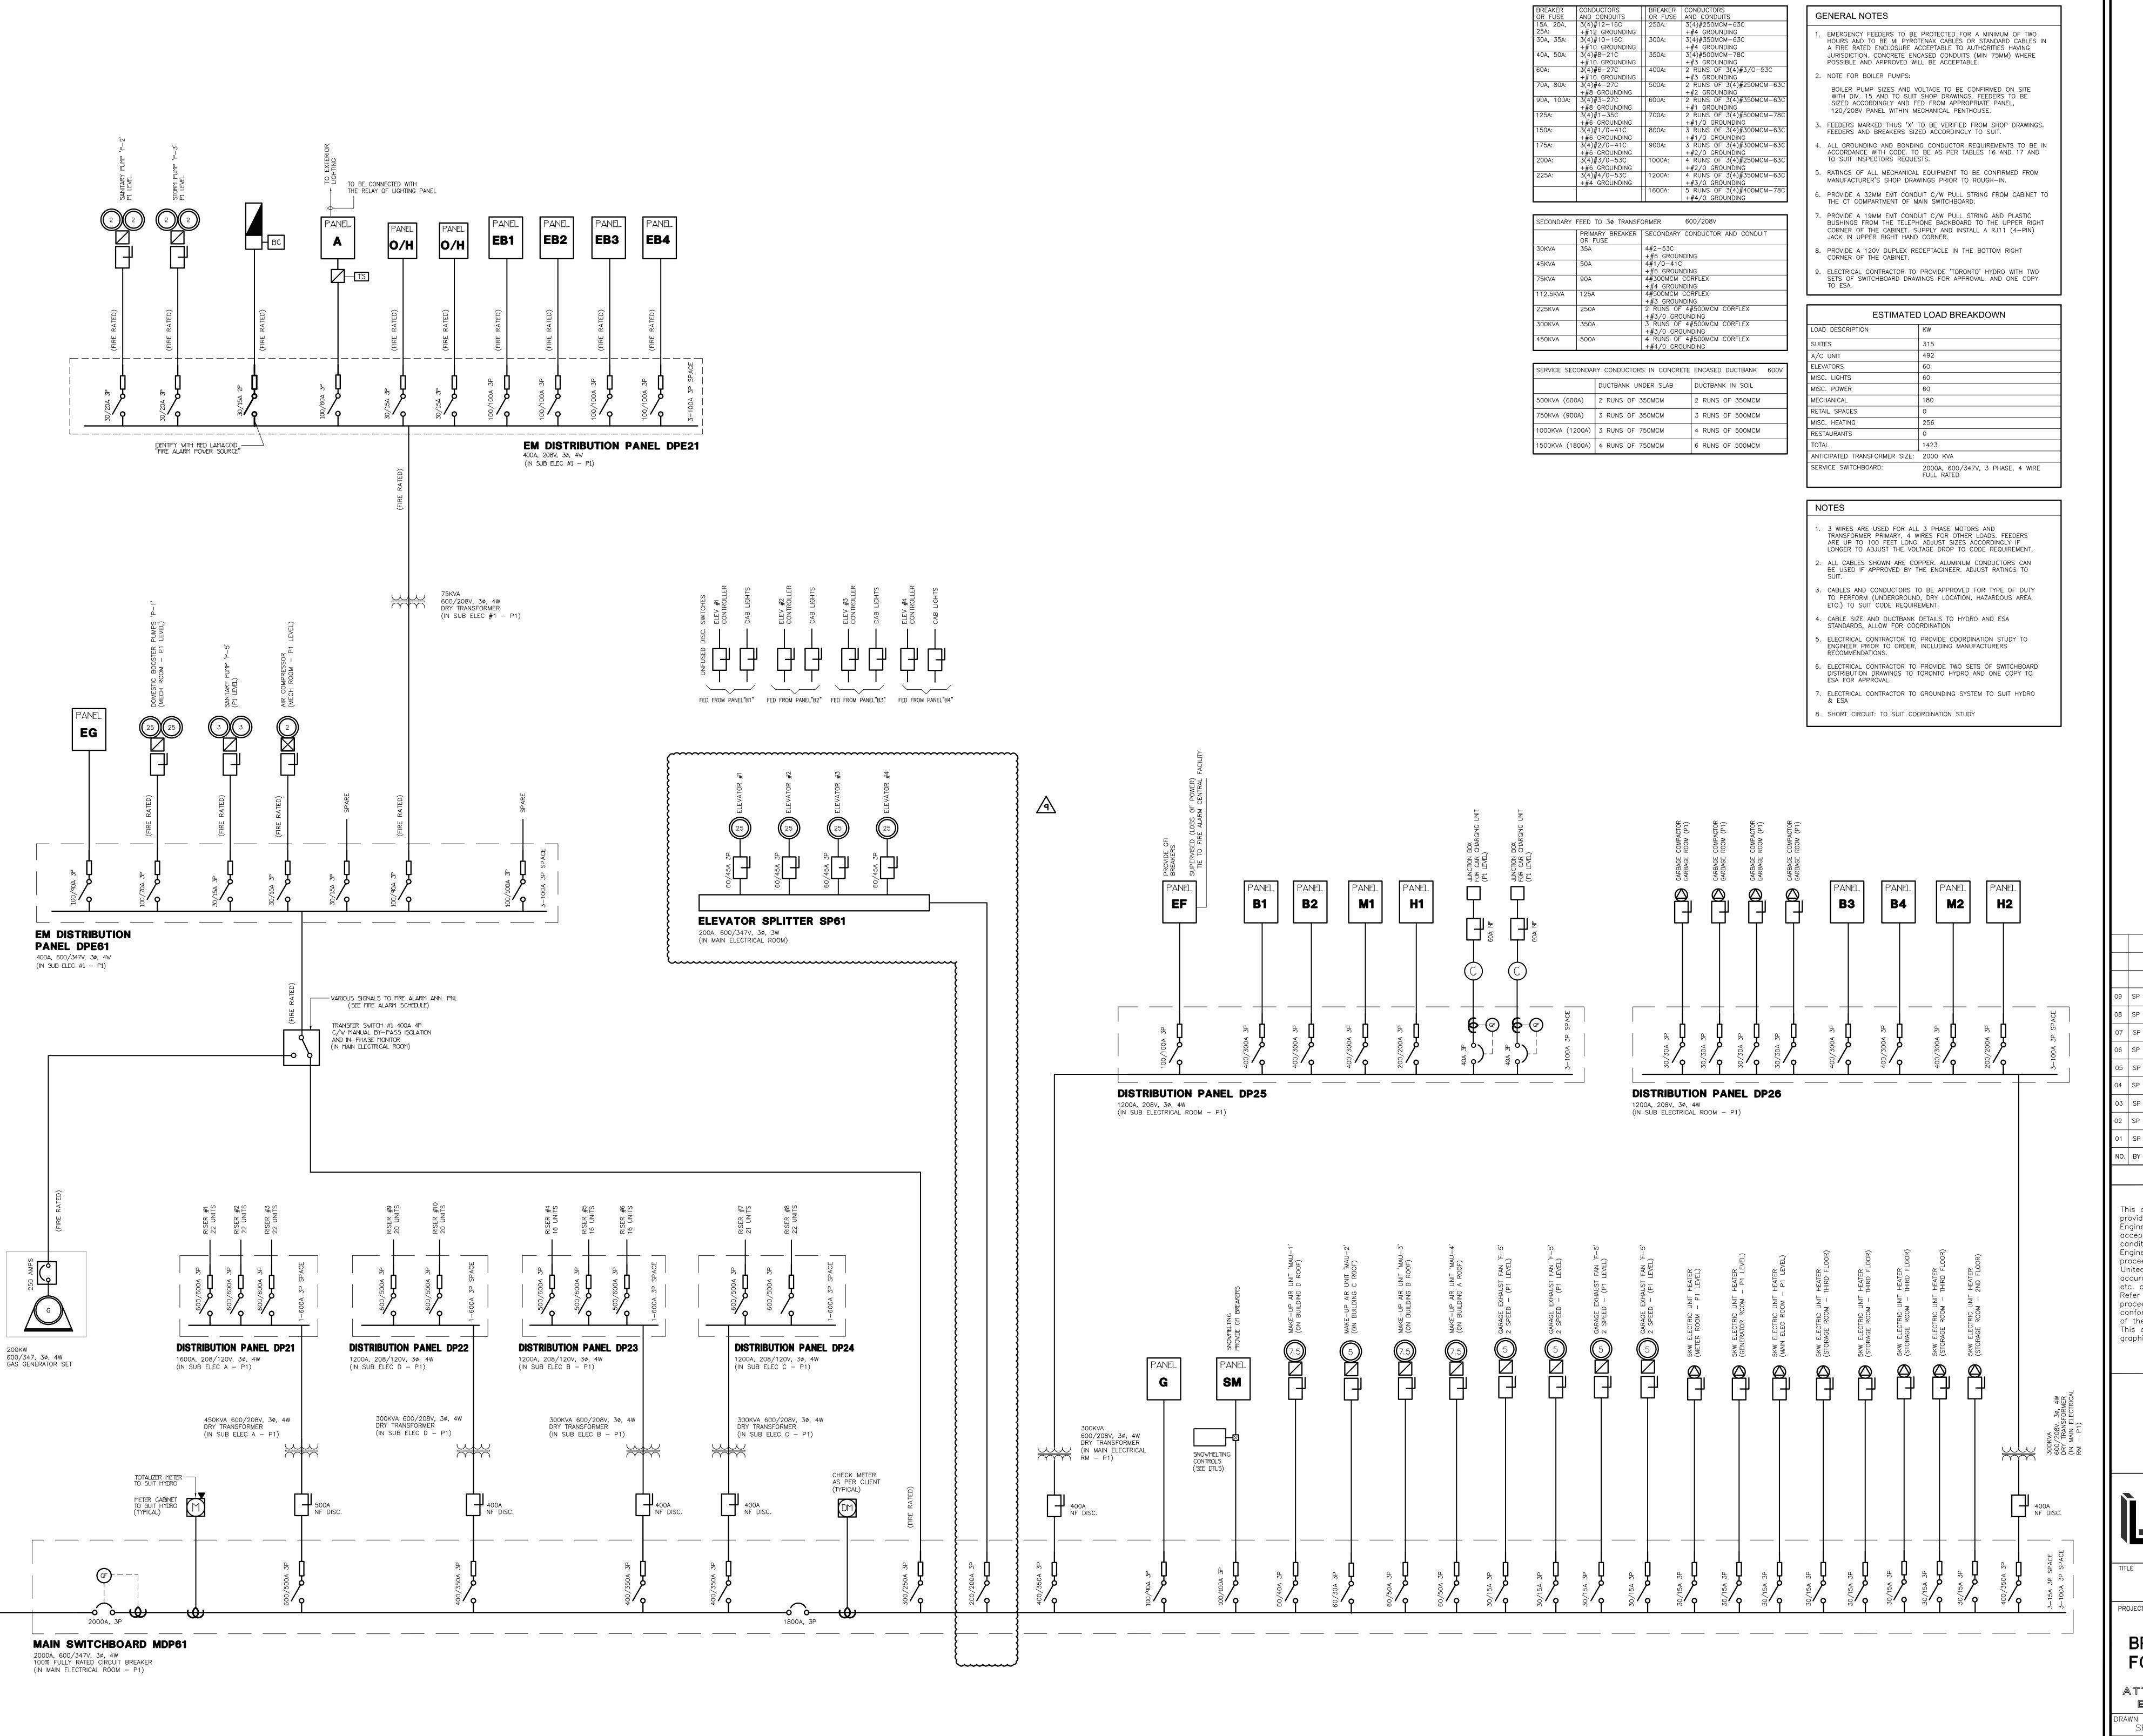

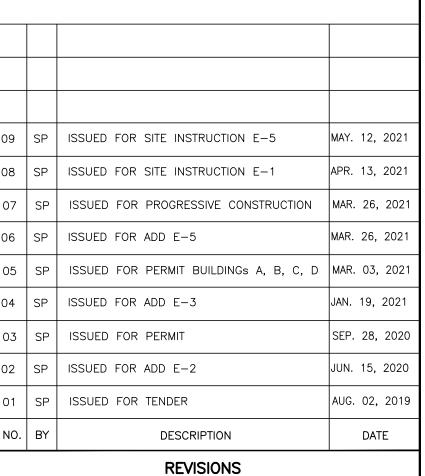


This drawing, is an instrument of service, is provided by and is the property of United Engineering Inc. The contractor must verify and accept responsibility for all dimensions and

conditions on site and must notify United
Engineering Inc. of any discrepancy before
proceeding.
United Engineering Inc. is not responsible for the
accuracy of Architectural, structural, interior design,
etc. on this drawing.
Refer to the appropriate trade drawings before

Refer to the appropriate trade drawings before proceeding with any work. Installation must conform to all applicable codes and requirements of the authorities having jurisdiction.

This drawing is not to be scaled, all symbols are graphic representations only.

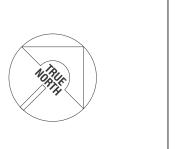



Tel: (416) 398 1999, Fax: (416) 398 1933

SINGLE LINE DIAGRAM
ELECTRICAL

PROJECT

BRAMPTON STACKED FORESTSIDE ESTATES

ATTMAR + PALLESCHI DRIVE
BRAMPTON, ONTARIO

DRAWN
SP
MG
DRAWN
SP
MG
DRAWING

DRAWING

PROJECT

MAY, 2019

18-017

