

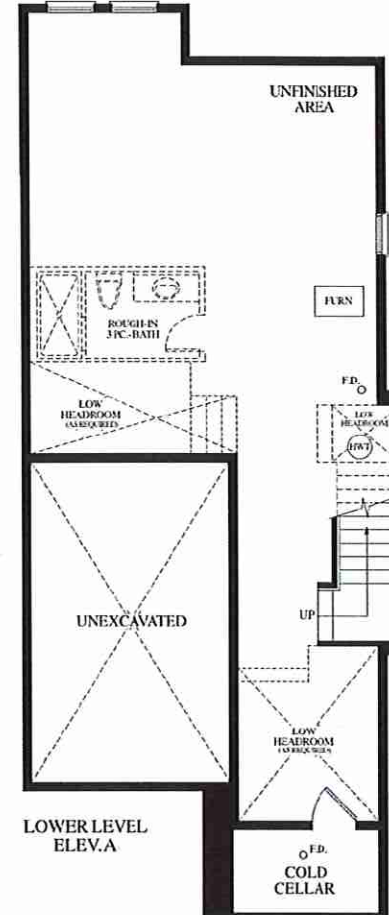


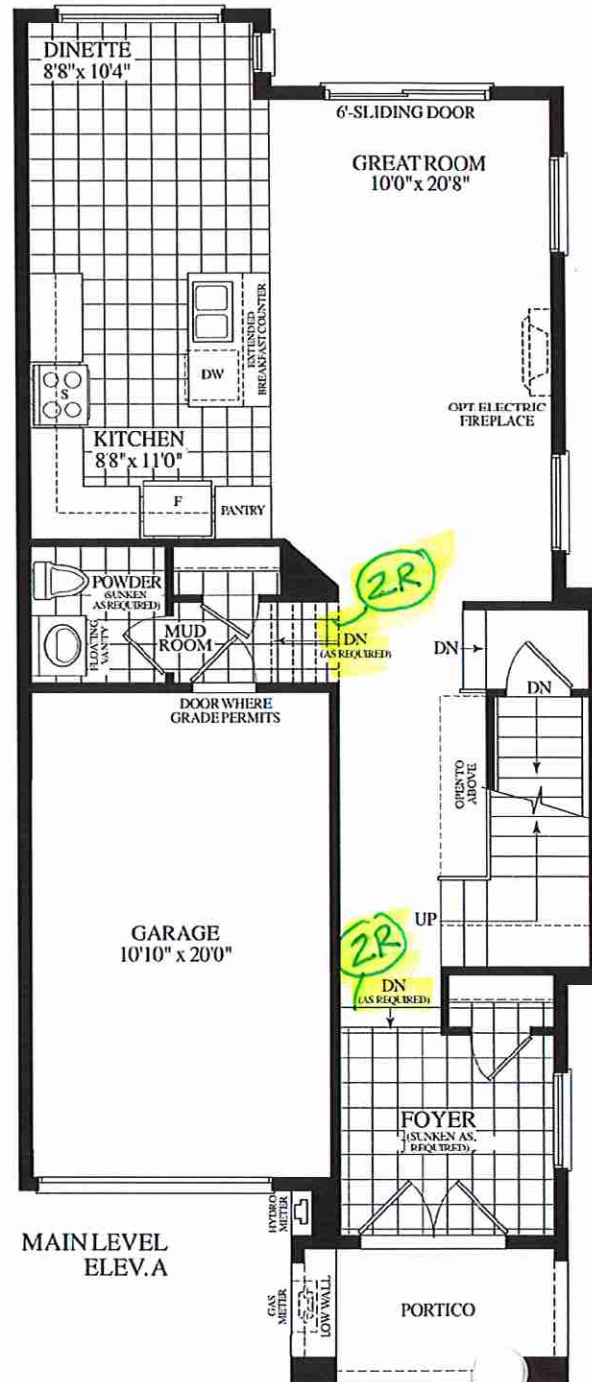

# TOWN | THE MILL POND

(20-10) SIDE UPGRADE

BLOCK 66 - LOT 8

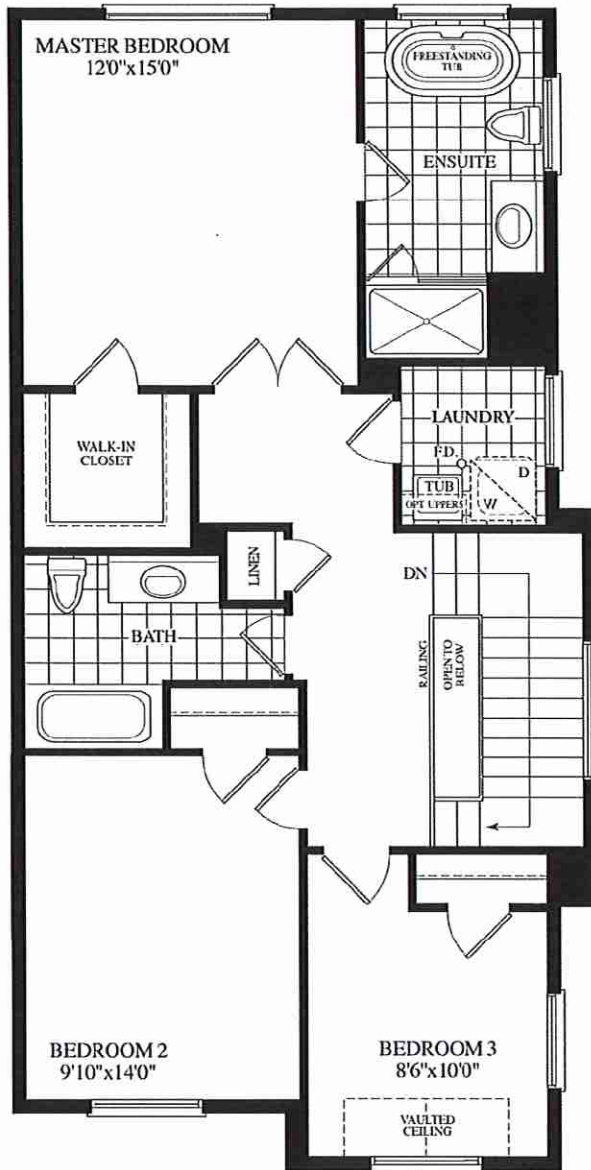

## SCHEDULE "B"

Purchaser	MEI YING HO
And Vendor	Grovetrail Developments Inc.
Lot Number	8 Block 66, Phase 1, Plan AS PER SCHEDULE C in the City of Richmond Hill
Date of Offer	March 28, 2021
Dated Required:	January 12, 2022
	Model: MILL POND (20-10AS-SIDE) ELEV A SIDE UPGRADE (I)
Description - Vendor to Supply and Install the Following as Per Purchase Price	
<ul style="list-style-type: none"> <li>BONUS PACKAGE FOR TOWNHOUSE: 5 APPLIANCES TO INCLUDE FRIDGE, STOVE, DISHWASHER WITH STAINLESS STEEL FINISH AND WHITE WASHER AND DRYER AS PER VENDORS SAMPLES. DELIVERED ONLY - NOT INSTALLED.</li> <li>BONUS PACKAGE FOR TOWNHOUSE: PURCHASER TO RECEIVE \$7,503.00 (INCLUSIVE OF TAXES) WORTH OF UPGRADES AT DECOR CENTRE AT TIME OF COLOUR CHART</li> </ul>	

