




INVENTORY
38-14 COVENTRY EL.A
Opt. Main with
Laundry - 4 Baths
Walk up
LOT 38

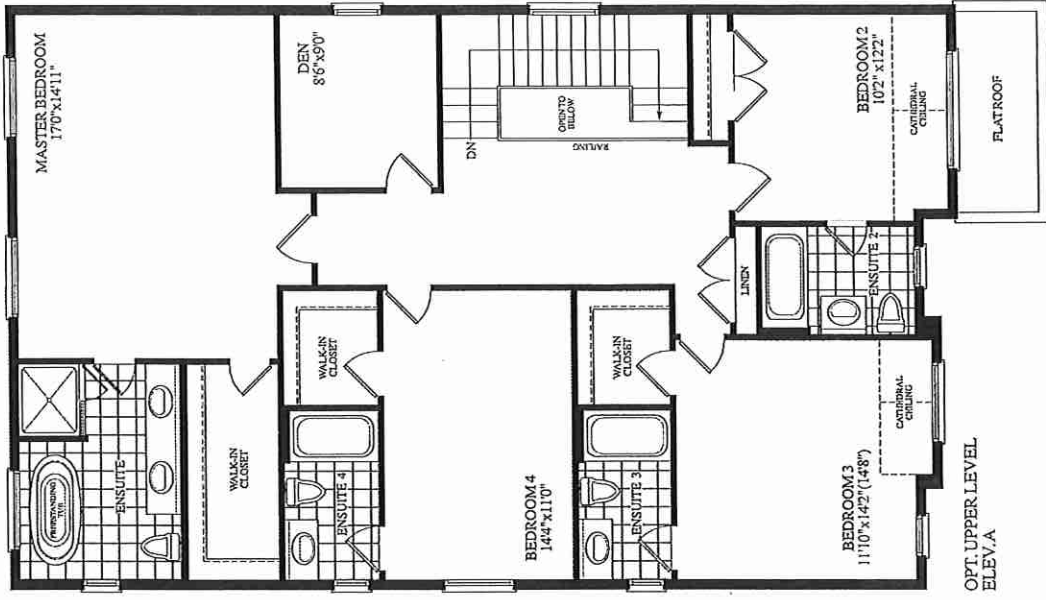

walk up Bsmt (NO Deck over walk-up)

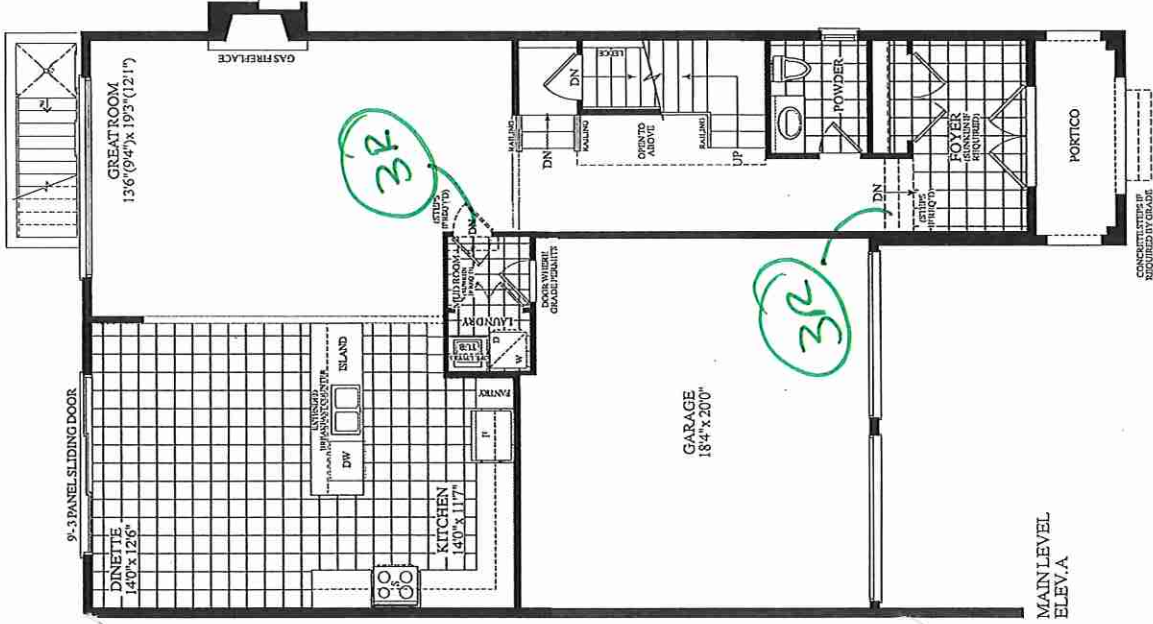

ELEVATION A
2720
SQUARE FEET

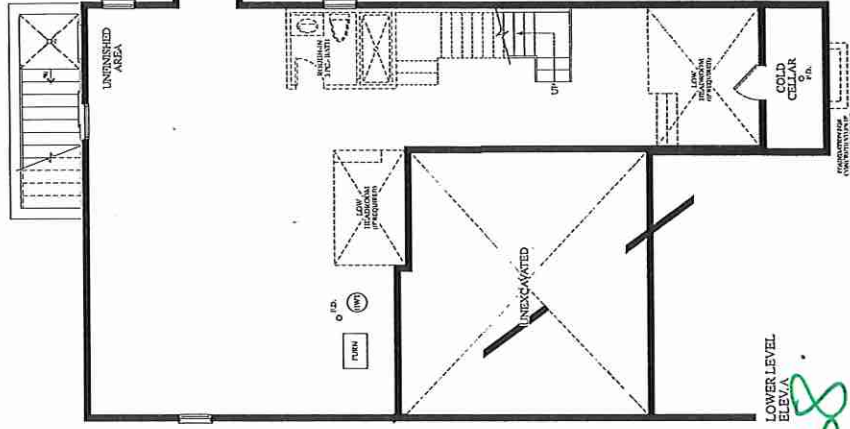

LOT # 38



Inventory