

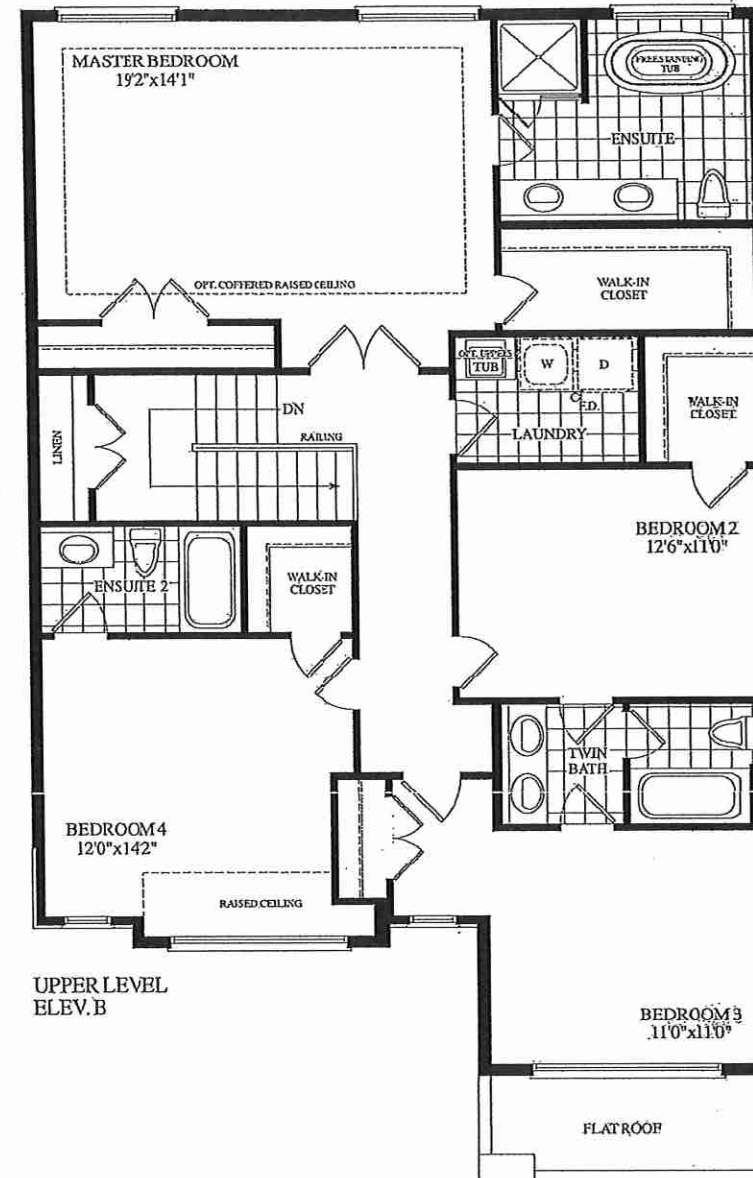


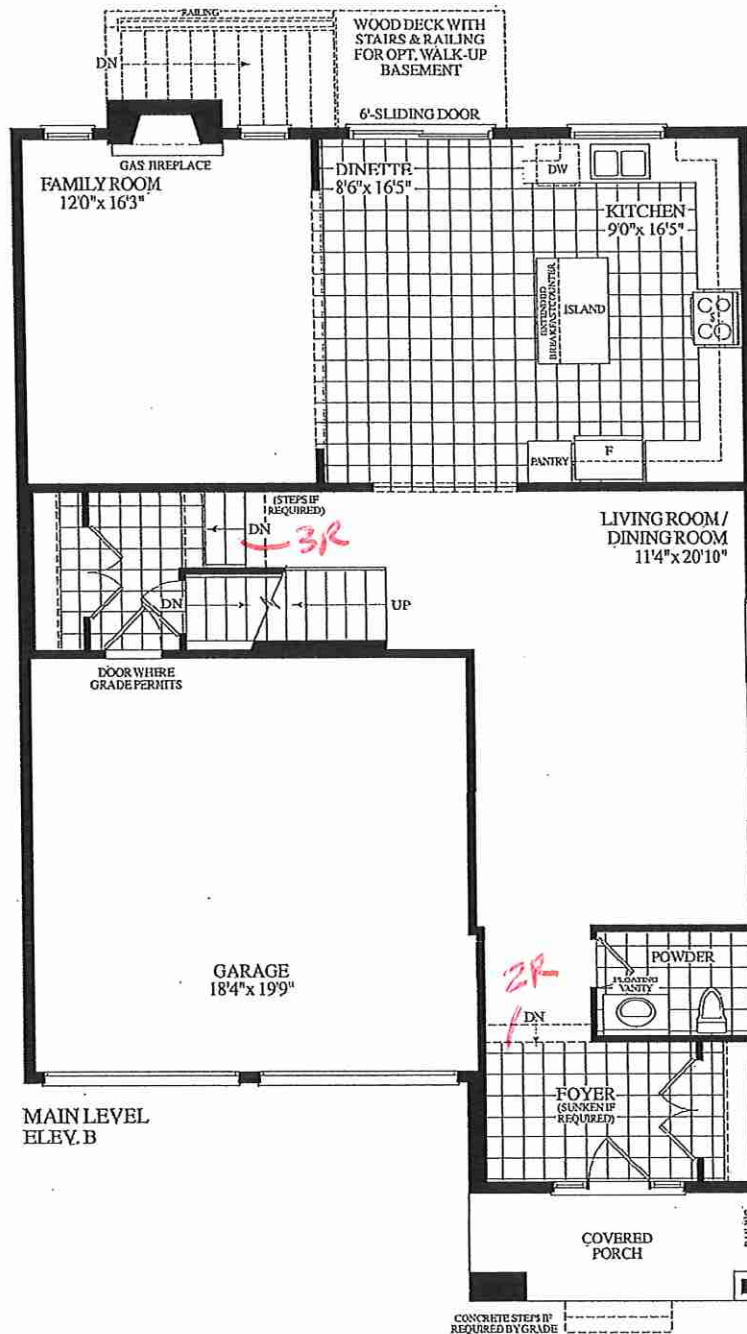

Dimensions, specifications, layouts, window sizes, and materials are approximate only, may vary, and are subject to change as provided in the Agreement of Purchase & Sale. This plan may be reversed. Illustrations are artist's concept. E.&O.E.

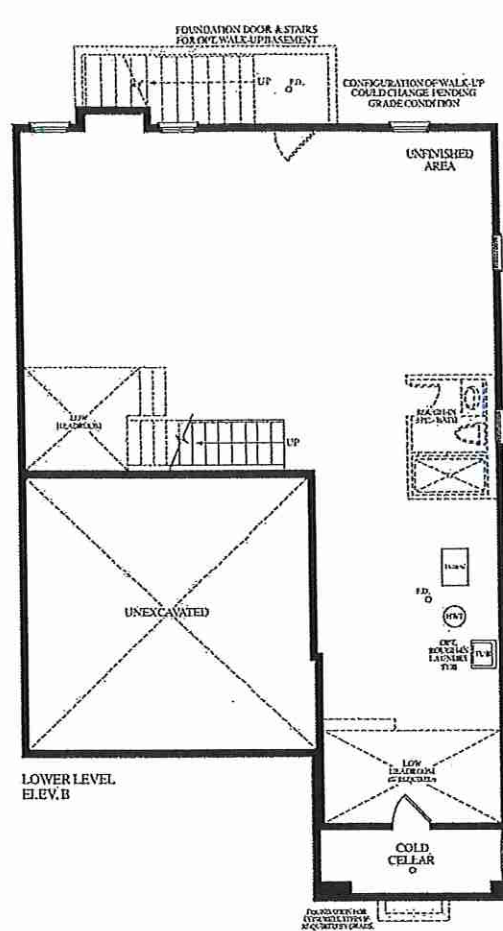

SCHEDULE "B"

Purchaser KENNETH YAM,
Purchaser ANITA HUEN,
And
Vendor Grovetrail Developments Inc.
Lot Number 41 Tipp Drive, Phase 1, Plan AS PER SCHEDULE C in the City of Richmond Hill
Date of Offer April 04, 2021
Dated Required: March 08, 2022 Model: BELVEDERE (38-11B) ELEV B ()

Description - Vendor to Supply and Install the Following as Per Purchase Price

- BONUS PACKAGE FOR 38' DETACHED: PURCHASER TO RECEIVE \$15,000.00 (INCLUSIVE OF TAXES) WORTH OF UPGRADES AT DECOR CENTRE AT TIME OF COLOUR CHART

