


INVENTORY

38-09 BLOOMINGTON OPT. MAIN with
OPT. LAUNDRY-3BATHS Walk-up
El. B LOT 39


No Permit
No Excavation

**WALK UP
INVENTORY
LOT 39**

approximate
deck size 7'x6'

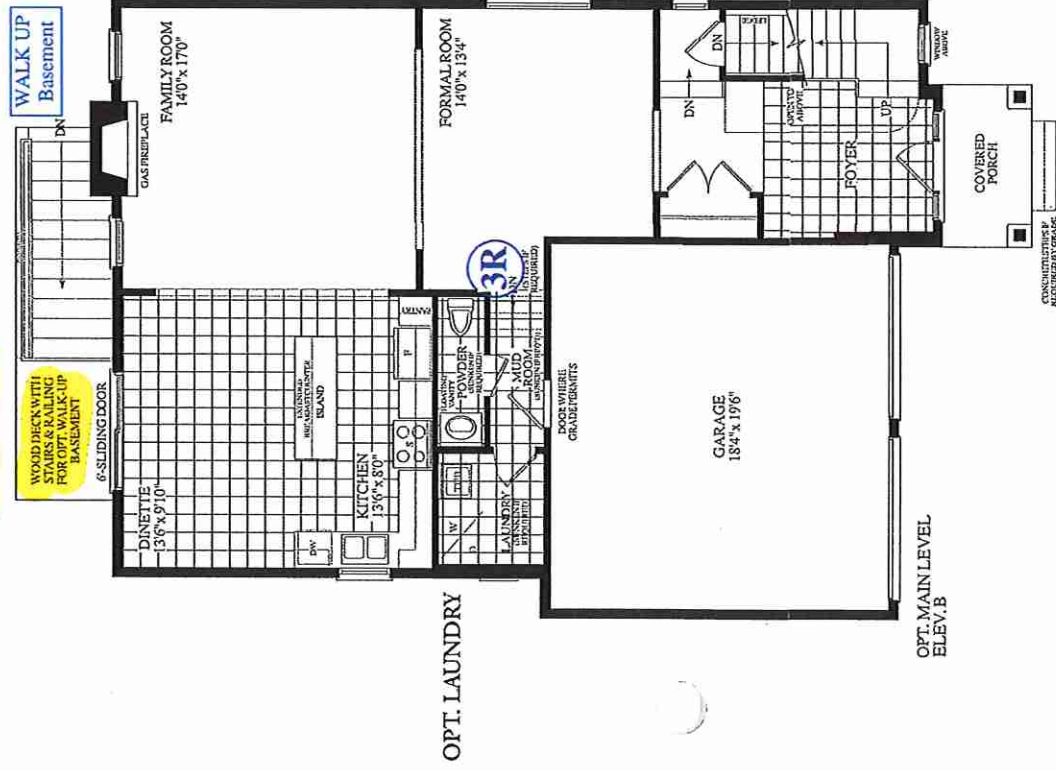


OPT. MAIN LEVEL
ELEV. B

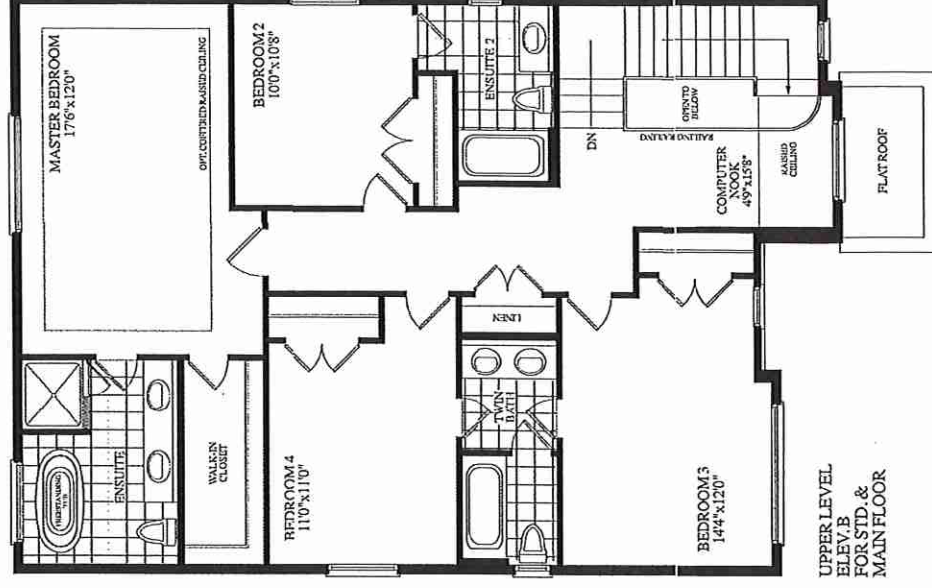

UPPER LEVEL
ELEV. B
FOR STD. &
MAIN FLOOR

WALK UP Basement

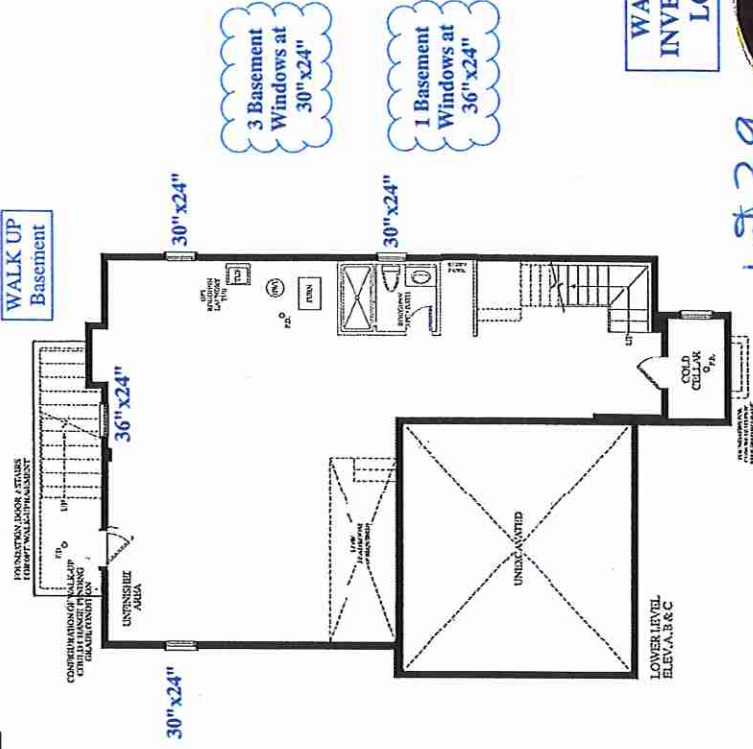WALK UP
INVENTORY
LOT 30

1039



ELEVATION B

2455
SQUARE FEET