



SITE COPY

CONSTRUCTION SUMMARY
Grovetrail Developments Inc.

PURCHASER: KAI LUN TONY HO

TEL:

LOT NUMBER	PHASE	HOUSE TYPE	CLOSING DATE
34 Block 55	1a	PALMER (20-11BMOD) ELEV BMOD	02-Feb-22

Offer Worksheet	BONUS PACKAGE FOR TOWNHOUSE: PURCHASER TO RECEIVE \$7,500.00 (INCLUSIVE OF TAXES) WORTH OF UPGRADES AT DECOR CENTRE AT TIME OF COLOUR CHART Note:
--------------------	--





Offer Worksheet	BONUS PACKAGE FOR TOWNHOUSE: 5 APPLIANCES TO INCLUDE FRIDGE, STOVE, DISHWASHER WITH STAINLESS STEEL FINISH AND WHITE WASHER AND DRYER AS PER VENDORS SAMPLES. DELIVERED ONLY - NOT INSTALLED. Note:
--------------------	--

Date Added: 12-Aug-21 Invoice Number: 7475

1 - PURCHASER HAS ATTENDED A STRUCTURAL APPOINTMENT WITH THE DECOR CENTRE VIA PHONE AND HAS DECLINED ANY ADDITIONAL STRUCTURAL UPGRADES. Note:

1 - PURCHASER AWARE AND ACCEPTS THAT ANY CHANGES MADE TO UPGRADES AFTER SIGNING THIS PURCHASERS EXTRA FORM ARE SUBJECT TO A MINIMUM ADMINISTRATION FEE OF \$1,000. PLUS A 10% HOLDBACK FEE. Note:
--

This Document is Extremely Time Sensitive - Printed 17 Aug 21 at 14:54

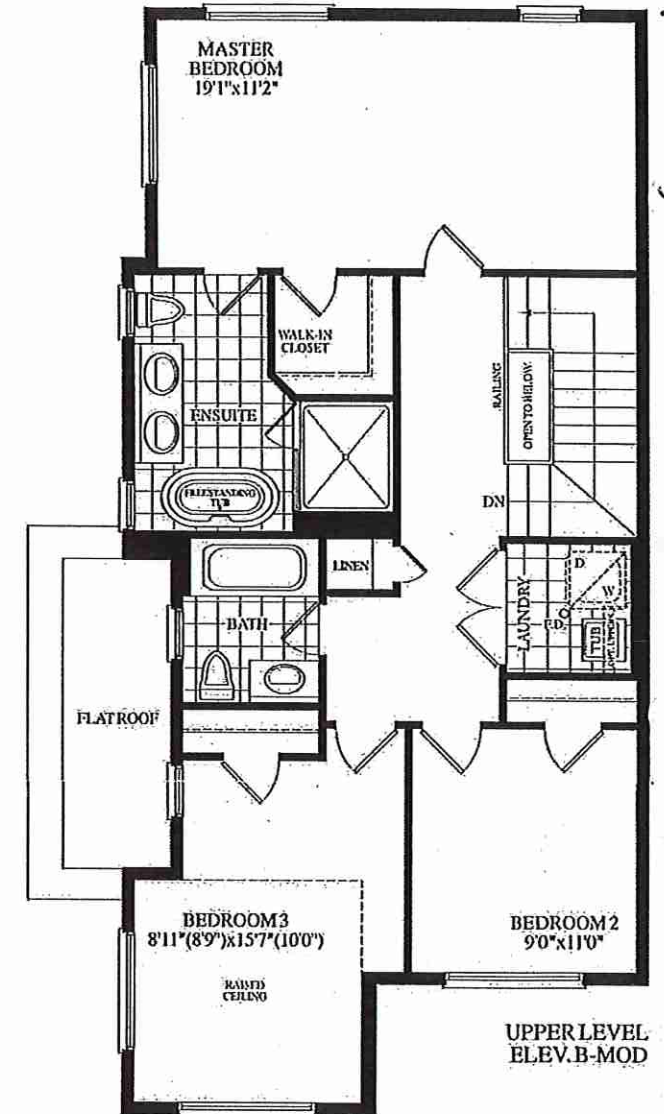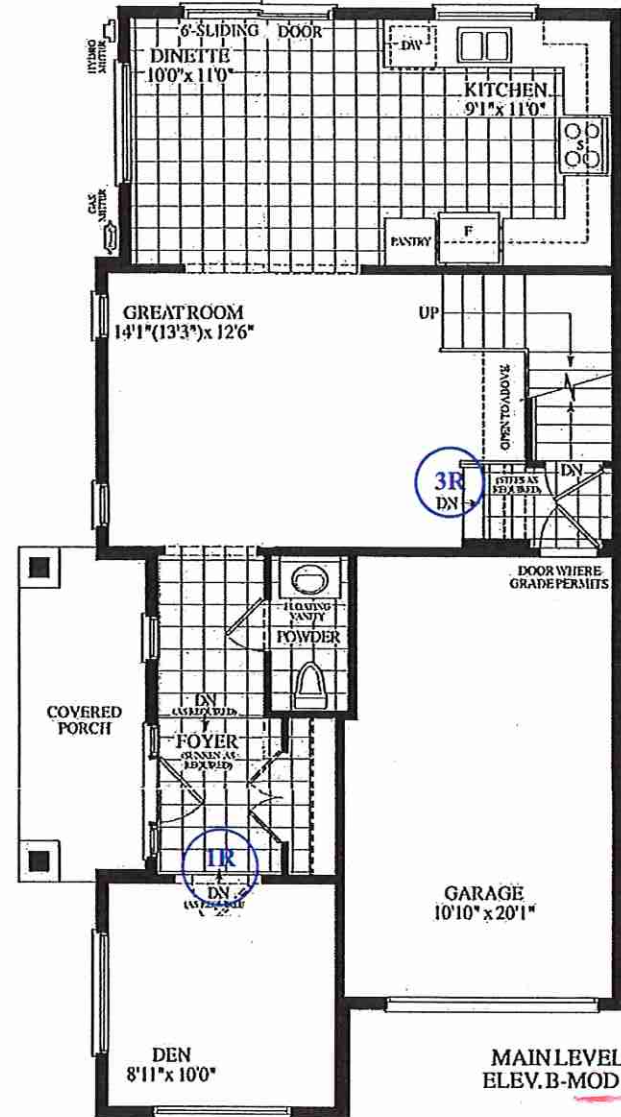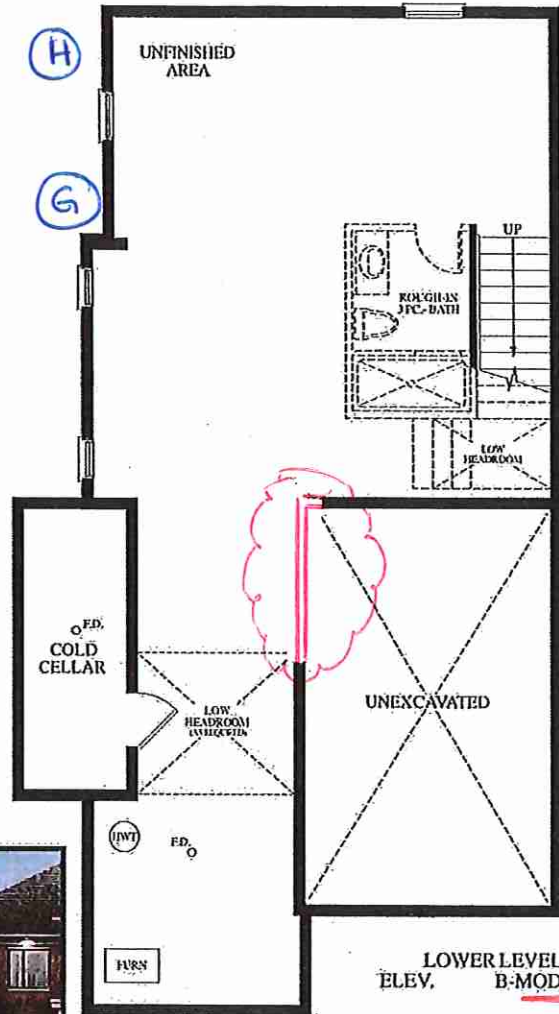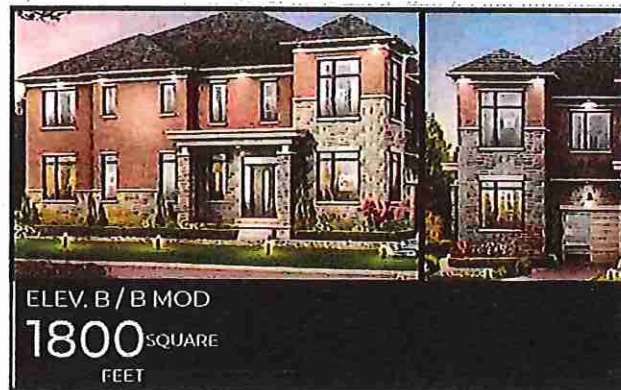

(20-11 "B"
 END UNIT
 LOT # 34 BLK 55

RECEIVED
46321

Purchaser		KAI LUN TONY HO		SCHEDULE "B"	
And Vendor		Grovetrail Developments Inc.			
Lot Number		34 Block 55, Phase 1a, Plan AS PER SCHEDULE C in the City of Richmond Hill			
Date of Offer		March 27, 2021			
Dated Required:		February 02, 2022		Model: PALMER (20-11BMOD) ELEV BMOD ()	
Description - Vendor to Supply and install the Following as Per Purchase Price					

- BONUS PACKAGE FOR TOWNHOUSE: PURCHASER TO RECEIVE \$7,500.00 (INCLUSIVE OF TAXES); WORTH OF UPGRADES AT DECOR CENTRE AT TIME OF COLOUR CHART
- BONUS PACKAGE FOR TOWNHOUSE: 5 APPLIANCES TO INCLUDE FRIDGE, STOVE, DISHWASHER WITH STAINLESS STEEL FINISH AND WHITE WASHER AND DRYER AS PER VENDORS SAMPLES. DELIVERED ONLY - NOT INSTALLED.

