

ROOF FLOOR SLAB BILL

SCALE: 1:100

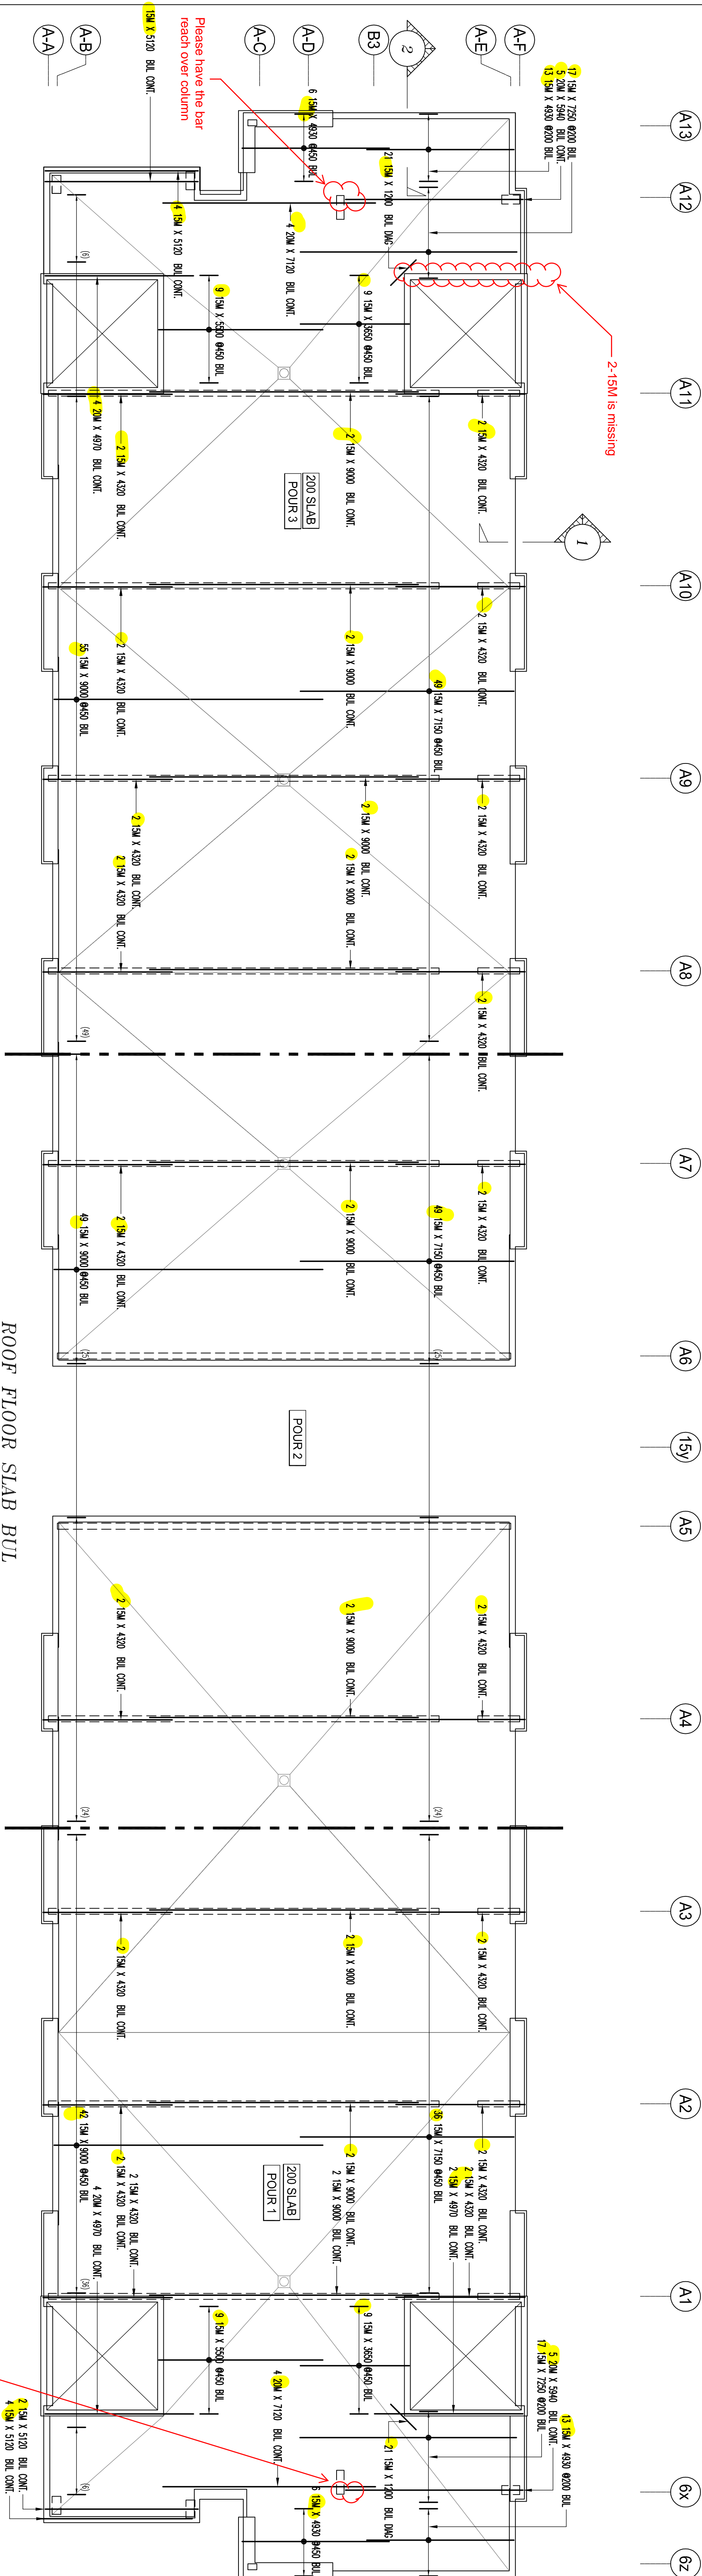
Rebar Number: R18.0A BL 2, BL 1, BL 1, BL 1											
Bar Mark	Qty	Size	Unit	Type	X	Y	Z	T	W	V	U
1	1	19M	7260								
2	1	19M	7260								
Rebar Number: R18.0A BL 2, BL 1, BL 1, BL 1											
Bar Mark	Qty	Size	Total Length	Type	X	Y	Z	T	W	V	U
1	1	19M	7260								
2	1	19M	7260								
3	1	19M	7260								
4	1	19M	7260								
5	1	19M	5650				5650				
6	1	19M	6950				6950				
7	1	19M	7550				7550				

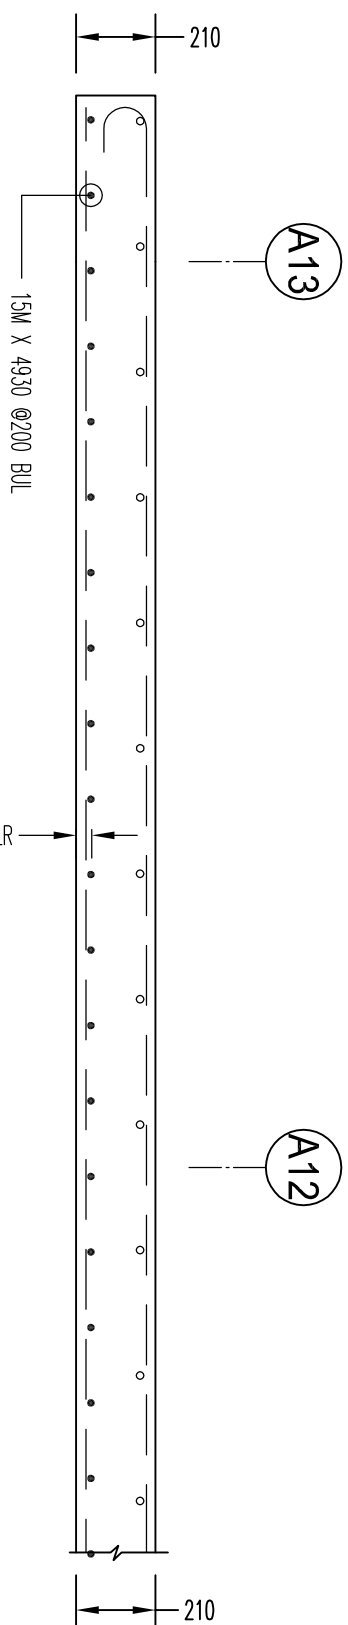
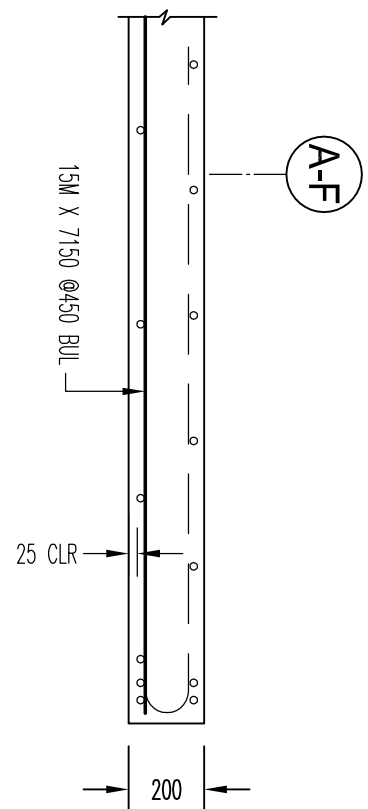
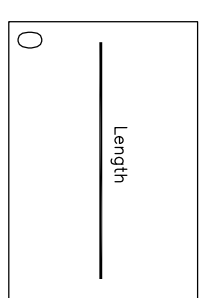
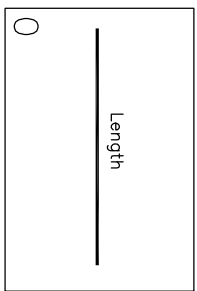
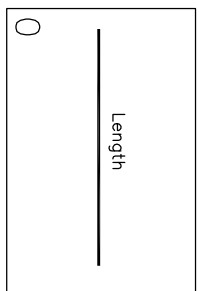
Length

0




[illegible]

Phone Number 718.638.97.5, 301.472.														
SR LIST														
Dr Rank	Qty	Size	Unit (each)	Type	Y1	Y2	Y3	Y4	Y5	Y6	Y7	Y8	Y9	Y0
	51	194		3003		3003								
	46	126				7153								
	8	134		4200		4200								

[illegible]

DRAWING REVIEW			
<p>This review of this drawing does not in any way relieve the contractor of responsibility for its accuracy or for compliance with the contract documents.</p>			
No comment	<input checked="" type="checkbox"/>	See comment	
Amend & Resubmit	<input type="checkbox"/>	Rejected	See Remarks
Submission No. <b>19066</b> Project No. <b>MB</b> By <b>15 Oct 2021</b> Date		JABLONSKY, AST AND PARTNERS Consulting Engineers 1429 Leslie Street Oak Mills, Ont. M3C 2K5	

MANSTEEL, REBAR		100 Imperial Road, Monrovia, NJ 07066 Phone: 908-273-9974 Email: info@mansteelrebar.com	<b>STANDARD DATA LABEL COMMENT</b> <b>7" B15M X 3600</b> LENGTH: _____ DIAMETER: _____ WEIGHT: _____ DATE: _____ BY: _____		<b>7" B15M B1501</b> LENGTH: _____ DIAMETER: _____ WEIGHT: _____ DATE: _____ BY: _____		<b>GRADING OF STEEL</b> 100 Imperial Road, Monrovia, NJ 07066 Phone: 908-273-9974 Email: info@mansteelrebar.com	
			<b>STANDARD DATA LABEL COMMENT</b> <b>7" B15M X 3600</b> LENGTH: _____ DIAMETER: _____ WEIGHT: _____ DATE: _____ BY: _____		<b>7" B15M B1501</b> LENGTH: _____ DIAMETER: _____ WEIGHT: _____ DATE: _____ BY: _____		<b>GRADING OF STEEL</b> 100 Imperial Road, Monrovia, NJ 07066 Phone: 908-273-9974 Email: info@mansteelrebar.com	
<b>FOR APPROVAL</b> DATE: _____ BY: _____			<b>REMARKS</b> DATE: _____ BY: _____			<b>REMARKS</b> DATE: _____ BY: _____		

BAR SIZE	STANDARD LAP (mm)
10M	300
15M	440
20M	590
25M	730
30M	880
35M	1030

TENSION-SPUN SPLICE (L.S. & DEVELOPMENT LENGTH (Ld)) (FOR WALL OR COL. OR L.S. OR FTG.)									
BAR SIZE	t <sub>c</sub> =25		t <sub>c</sub> =30		t <sub>c</sub> =35				
	L.S.	L.d	L.S.	L.d	L.S.	L.d	L.S.	L.d	
10M	490	380	490	350	420	320			
15M	740	570	670	520	620	480			
20M	980	750	890	690	830	640			
25M	1530	1170	1390	1070	1290	990			
30M	1830	1410	1670	1280	1550	1190			
35M	2130	1640	1950	1500	1800	1390			











