

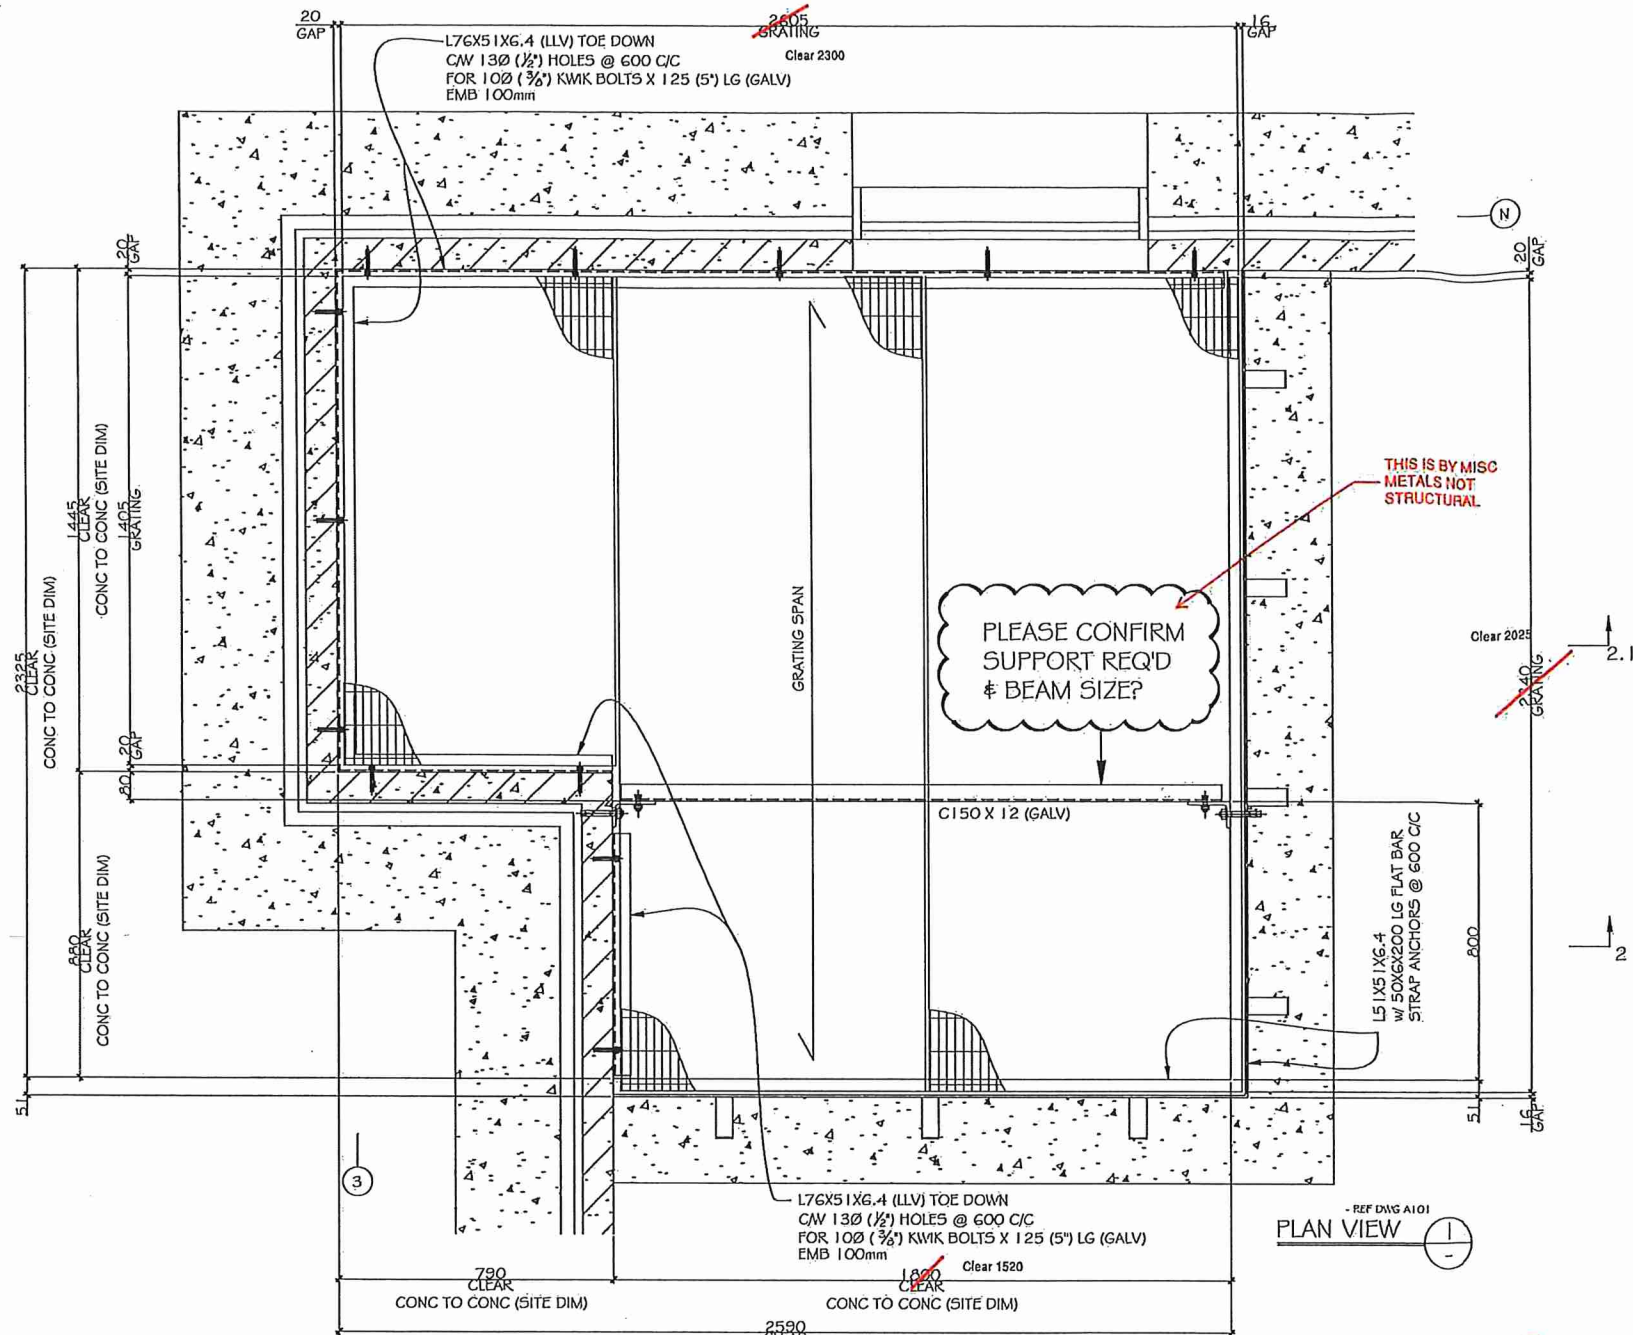


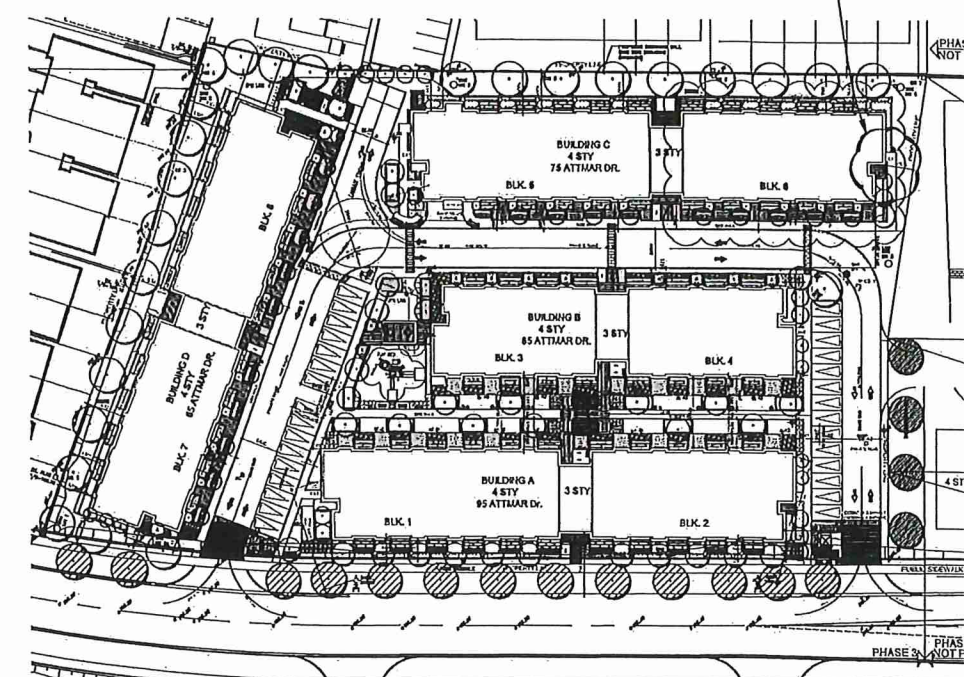

DRAWING REVIEW	
This review of this drawing does not in any way relieve the contractor of responsibility for its accuracy or for compliance with the contract documents.	
No comment	See comment
Amend & Resubmit	Reflected See Remarks
Submission No. 10000	
Project No. 10000	
By: J.S.	
Date: 15 Nov 2021	
JABLONSKY, AST AND PARTNERS	
Consulting Engineers	
129 Levee Street Don Mills, Ont. M3C 2K5	

PROVIDE PENG STAMP

GRATING AND SUPPORT NEEDS TO BE DESIGNED FOR HEAVY TRUCK LOADING

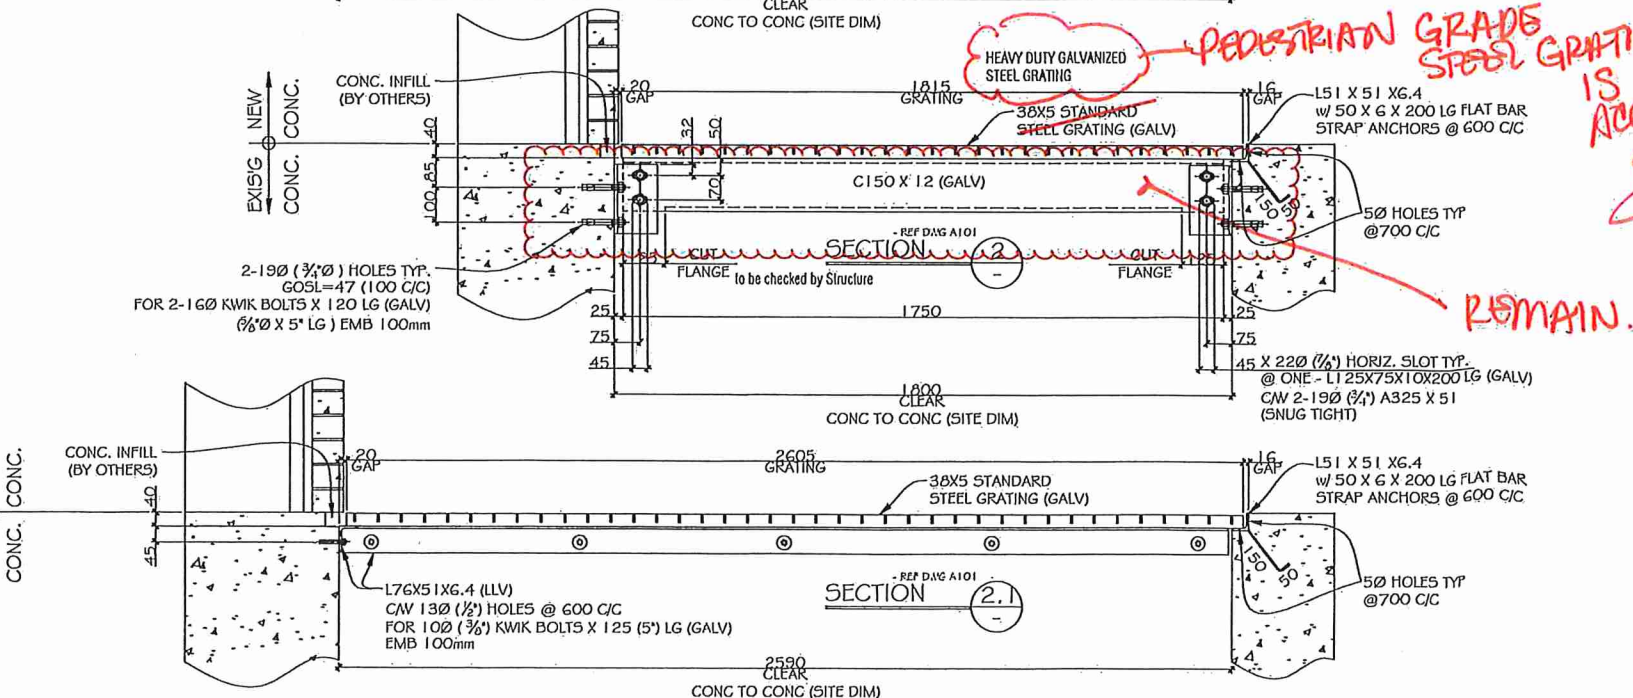

KEY PLAN @ GROUND LEVEL

REVIEWED AS NOTED

REVISOR AND RESUBMIT

This review by GRAZIMA + CORAZZA Architects Inc. is for the sole purpose of assuring conformance with the general design concept. This review shall not mean that GRAZIMA + CORAZZA Architects Inc. approves the detail design shown in the shop drawings, responsibility for which shall remain with the Contractor submitting them, and such review shall not relieve the Contractor of his responsibility for errors or omissions in the shop drawings or of his responsibility for meeting all requirements of the contract documents. The Contractor is responsible for dimensions to be confirmed and correlated at job site, for information that pertains solely to fabrication processes or to techniques of construction and installation and for co-ordination of the work of all trades.

GRAZIMA + CORAZZA Architects Inc.

By: MA Date: 15 NOV 2021

THIS IS BY MISC METALS NOT STRUCTURAL

G+C: all beams dimensions must be checked by Structure, in terms of size and load.

NOTE: IF BEAM REQ'D EXTRA TO CONTRACT

CONTRACTOR, ARCHITECT OR ENGINEER PLEASE NOTE!! THESE DRAWINGS ARE OUR INTERPRETATION OF THE CONTRACT DOCUMENTS TO BE USED FOR FABRICATION ON THIS PROJECT, THEREFORE IT IS IMPERATIVE THAT YOU CHECK THAT YOUR REQUIREMENTS ARE BEING PROVIDED FOR BY THESE DRAWINGS. YOUR REVIEW OR APPROVAL CONSTITUTES YOUR ACCEPTANCE OF OUR INTERPRETATION, EXCEPT FOR YOUR NOTES ON THE RETURNED DRAWINGS. ANY ADDITIONS, CHANGES, ADDENDA, ETC. REQUIRED BY THIS OFFICE AFTER OUR RECEIPT OF APPROVED DRAWINGS WILL BE AN EXTRA TO THE CONTRACT AT THE APPLICABLE RATES.

NOTE:





- ALL WELDS 6mm FILLET U/N

- VERIFY ALL DIMENSIONS ON SITE BEFORE FABRICATION

NOV 05, 21 1 REVD AS PER SITE DIM

FINISH	HOT DIP GALVANIZED
CUSTOMER	FORESTSIDE ESTATES INC
PROJECT	66-95 ATTAMAR DRIVE (BLDG. C)
LOCATION	BRAMPTON, ONTARIO
DETAIL	EXTERIOR GALVANIZED EXHAUST SHAFT GRATING
DRAWN BY	BL
CHECKED BY	SCALE AS NOTED
DATE	MAY 19/2021
DRAWING NO.	21-000C-MS1

MASTER STEEL FABRICATION LTD.

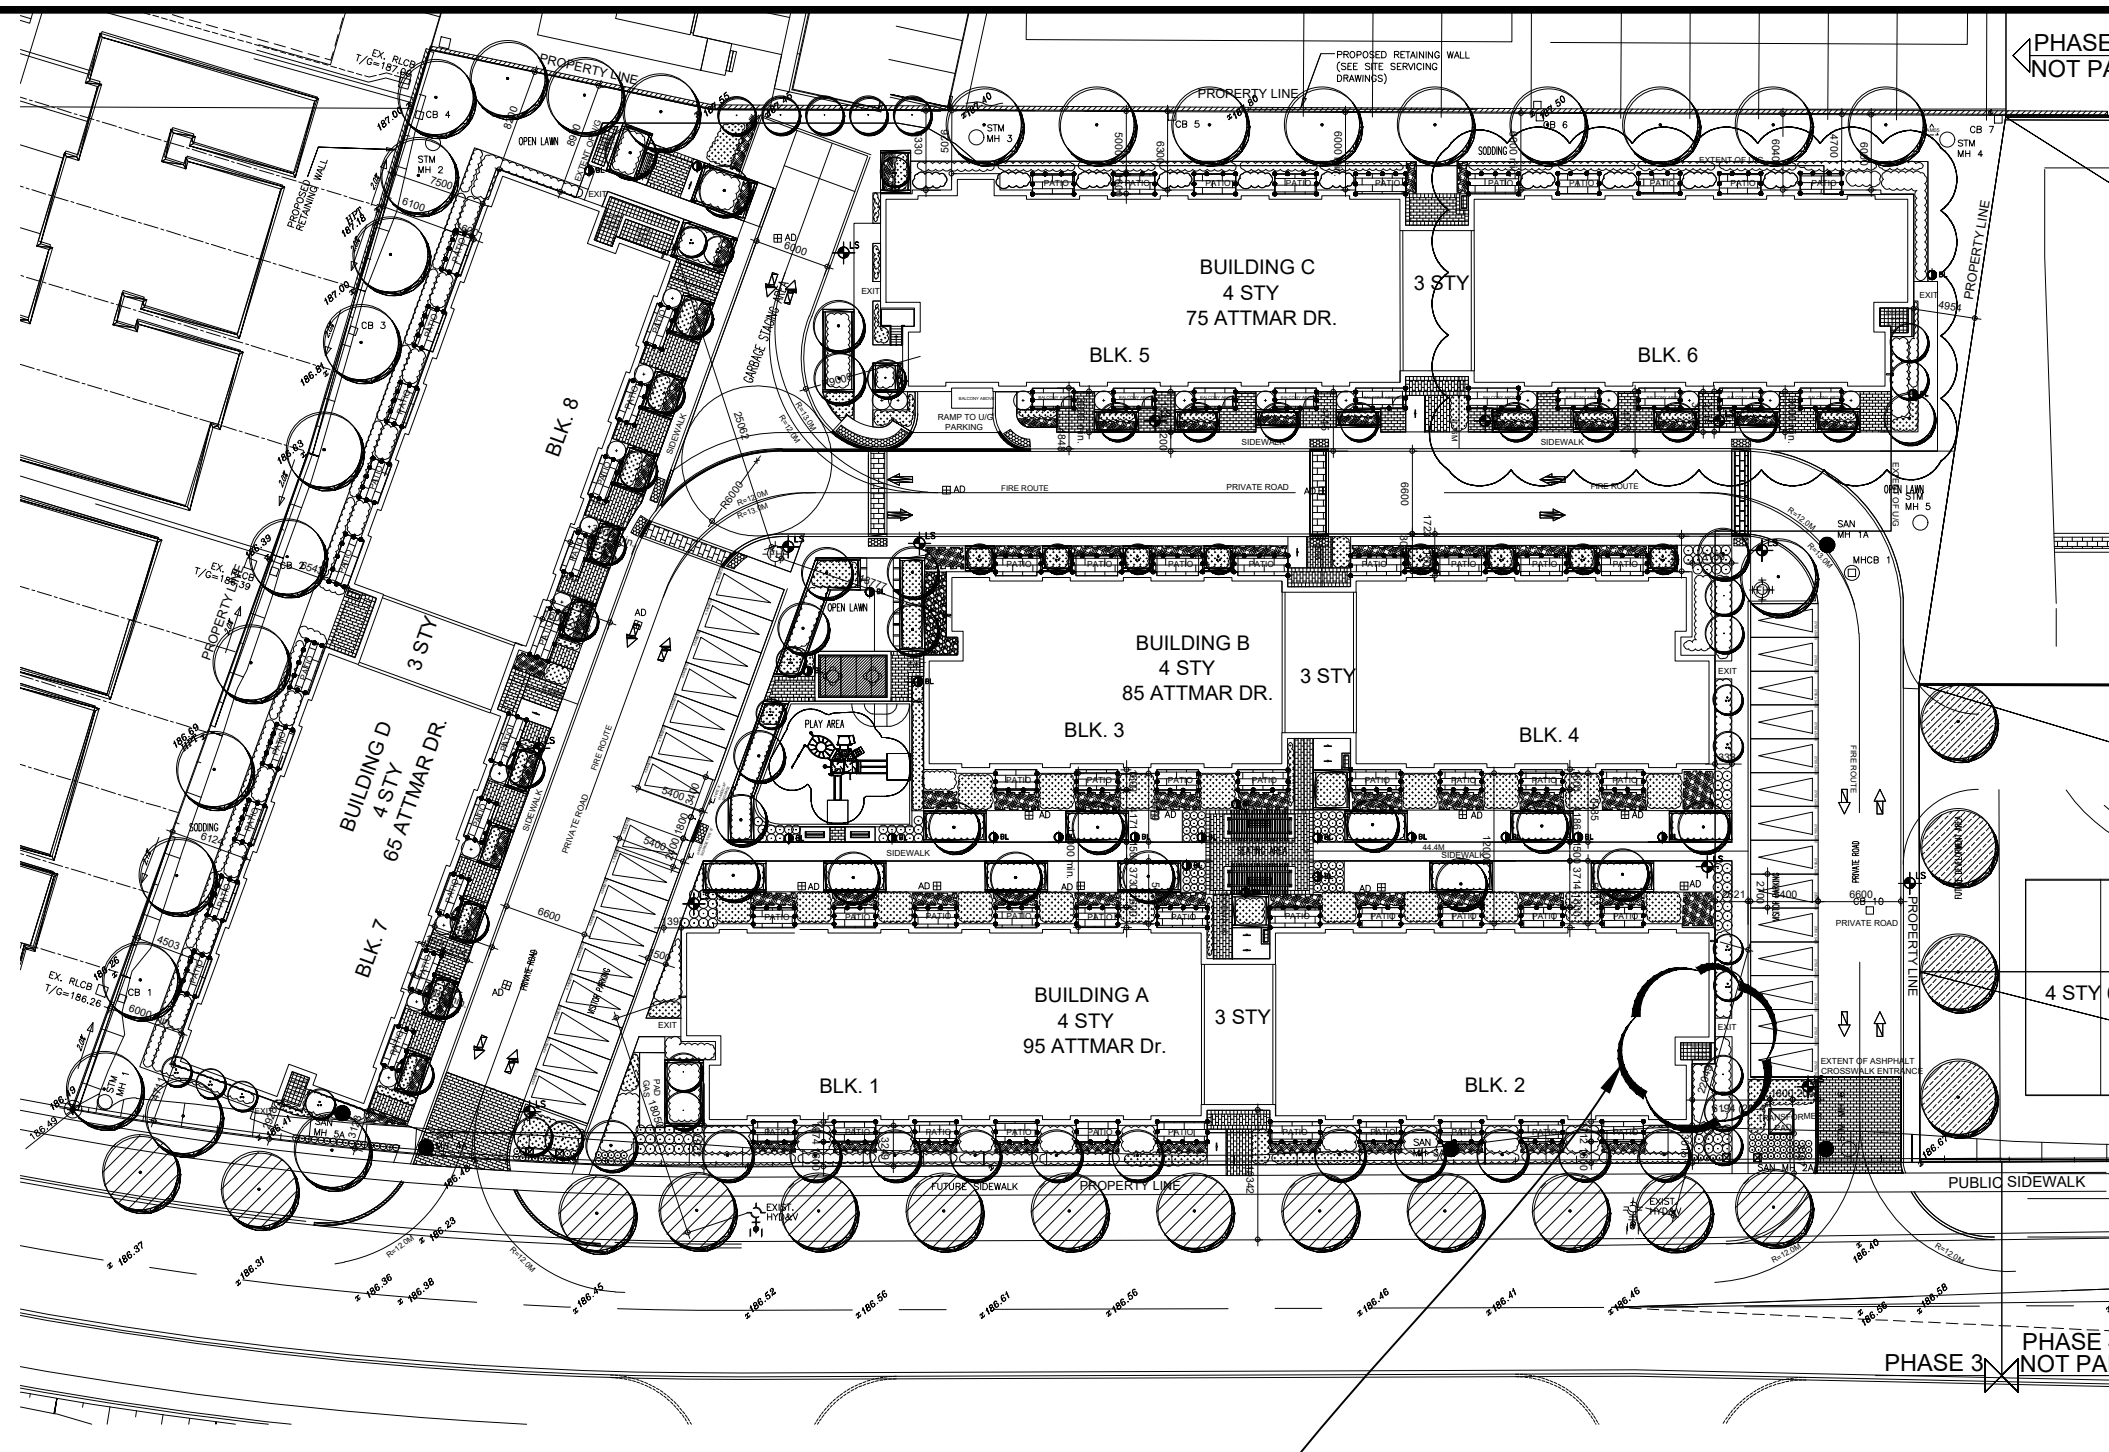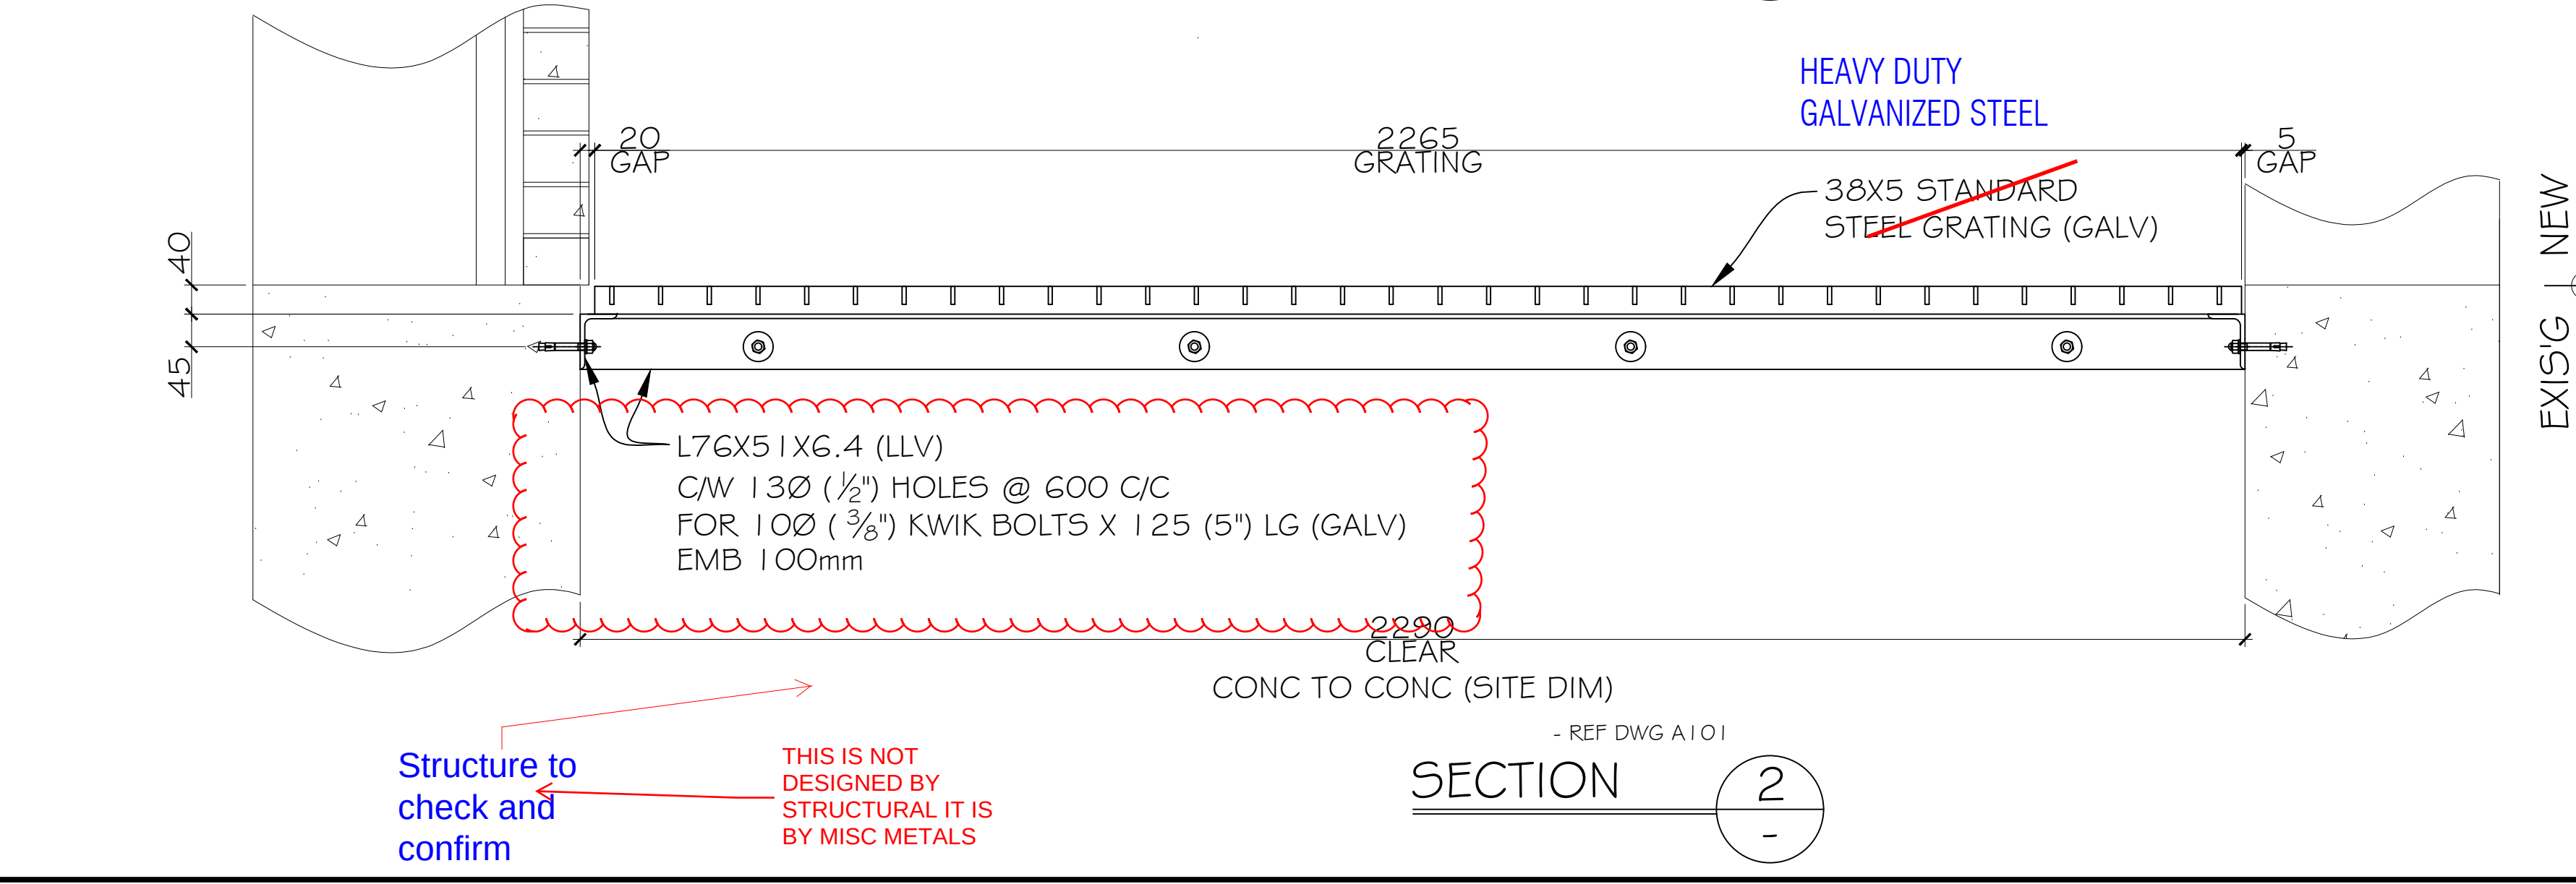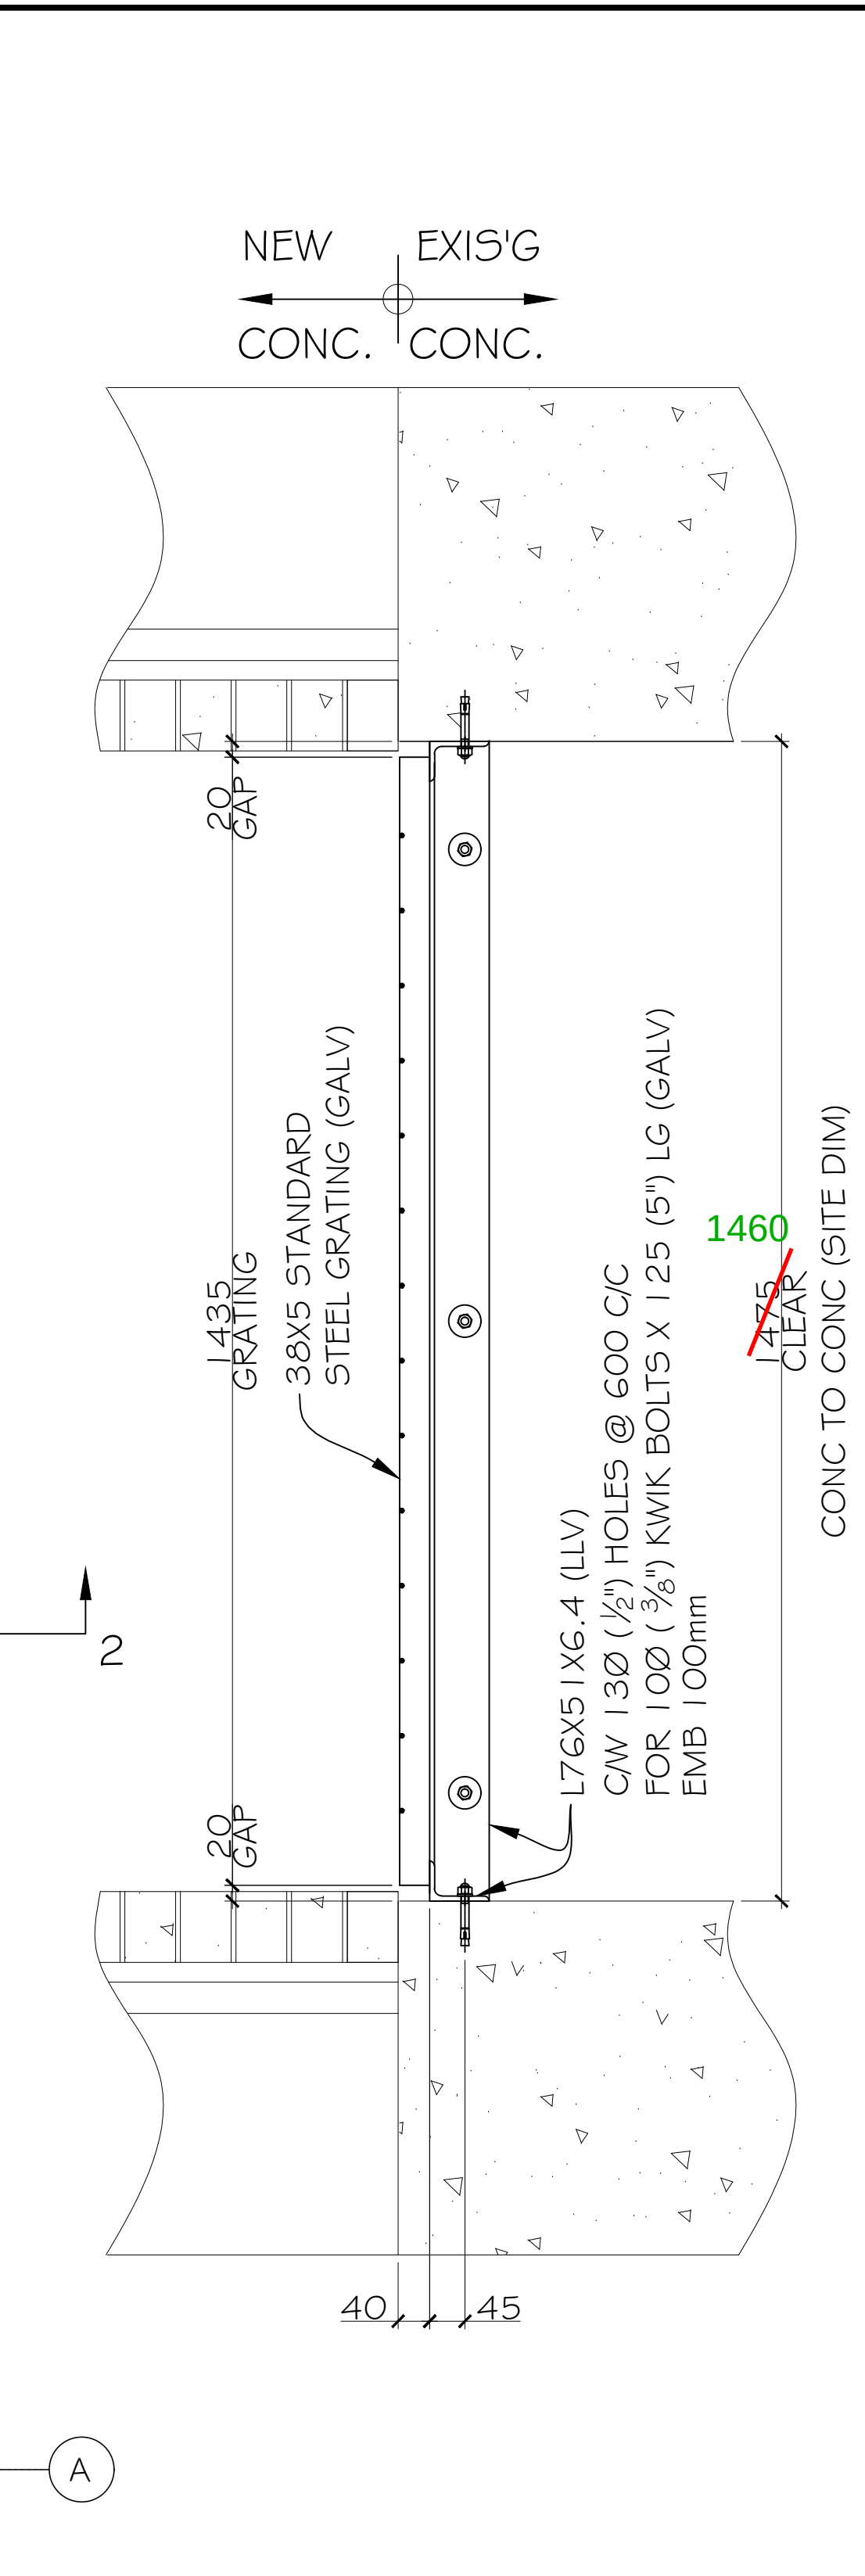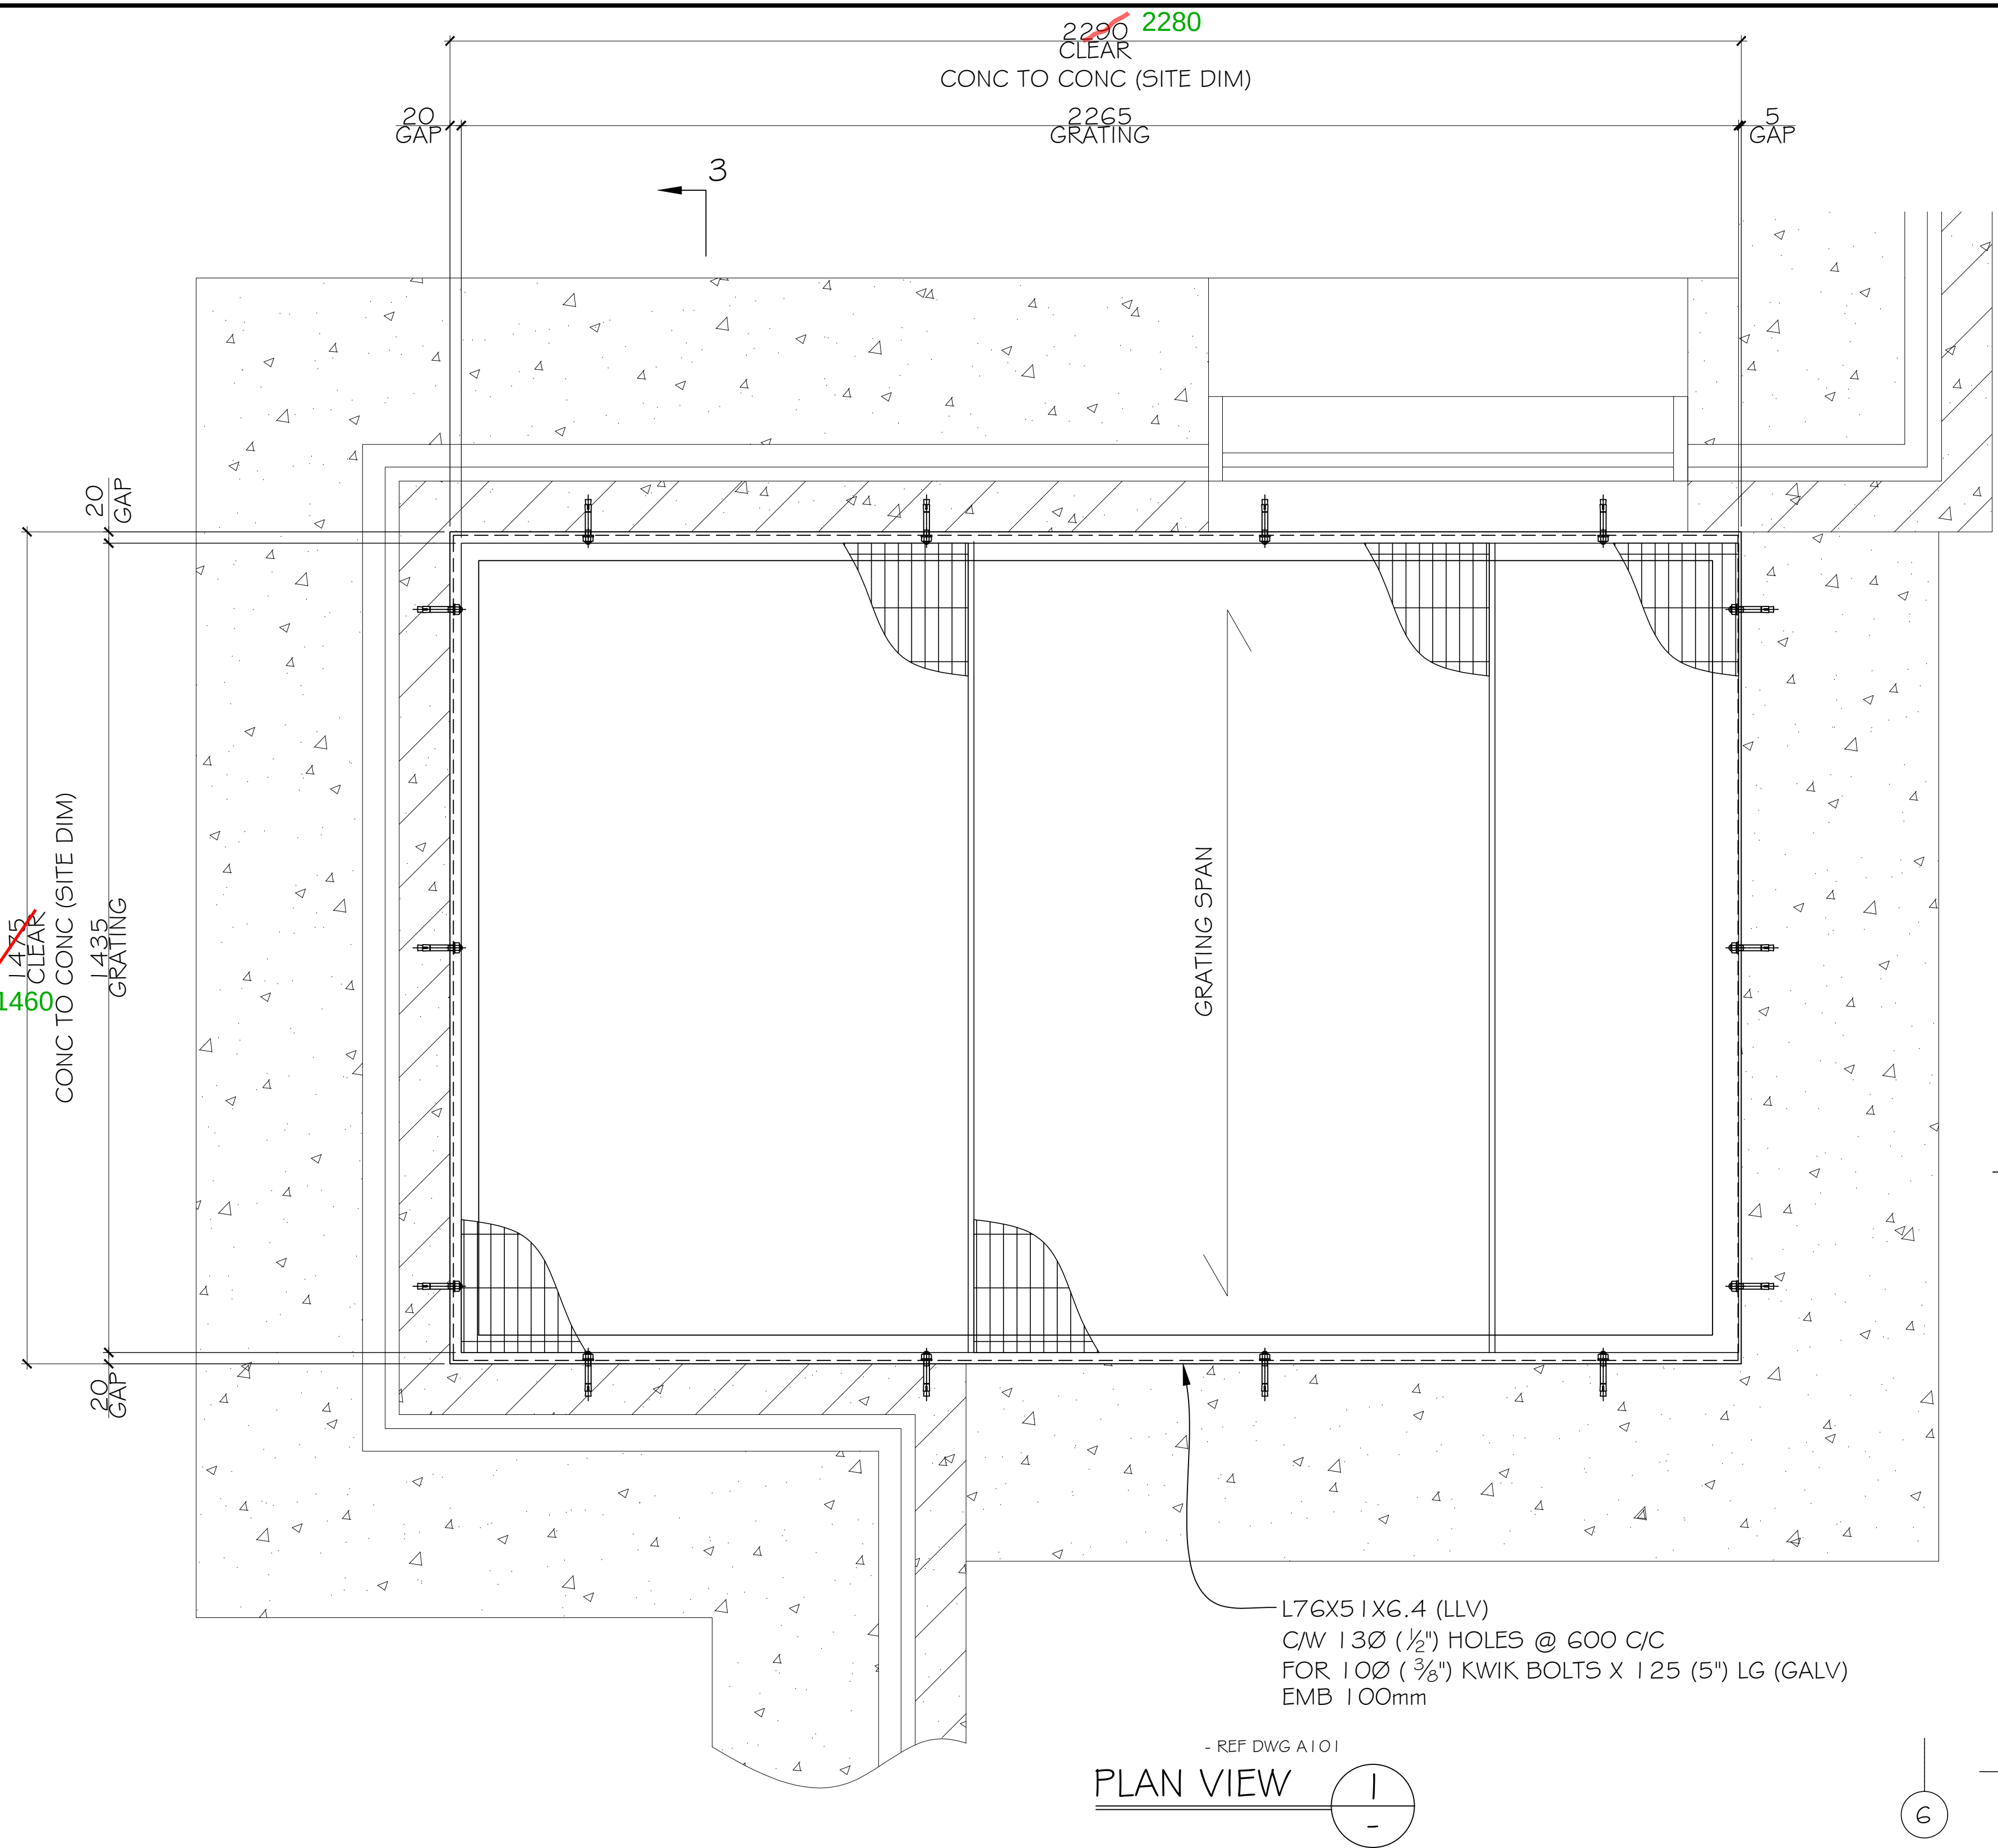

KEY PLAN @ GROUND LEVEL

EXTERIOR GALVANIZED AIRSHAFT GRATING FOR BUILDING 'A'

DRAWING REVIEW	
This review of this drawing does not in any way relieve the contractor of responsibility for its accuracy or for compliance with the contract documents.	
No comment	See comment
Amend & Resubmit	Rejected See Remarks
Submission No. 14006	
Project No. 14006	
By: KO	
Date: 15 Nov 2021	
JABLONSKY, AST AND PARTNERS Consulting Engineers 1129 Leslie Street Don Mills, Ont. M3C 2K5	

PROVIDE PENG STAMP

CONFIRM IF IT NEEDS TO BE DESIGNED FOR HEAVY TRUCK LOADING

G+C:
all beams dimensions must be checked by Structure, in terms of size and load.

REVIEWED	REVIEWED AS NOTED	REVISIT AND RESUBMIT
This review by GRAZIANI + CORAZZA Architects Inc. is for the sole purpose of ascertaining conformance with the general design concept. This review shall not mean that GRAZIANI + CORAZZA Architects Inc. approves the detail design inherent in the shop drawings, responsibility for which shall remain with the Contractor submitting same, and such review shall not relieve the Contractor of his responsibility for errors or omissions in the shop drawings or of his responsibility for meeting all requirements of the contract documents. The Contractor is responsible for dimensions to be confirmed and correlated at job site, for information that pertains solely to fabrication processes or to techniques of construction and installation and for co-ordination of the work of all subtrades. GRAZIANI + CORAZZA Architects Inc.		
By: MA	Date: 15.NOV.2021	

CONTRACTOR, ARCHITECT OR ENGINEER PLEASE NOTE!! THESE DRAWINGS ARE OUR INTERPRETATION OF THE CONTRACT DOCUMENTS TO BE USED FOR FABRICATION ON THIS PROJECT, THEREFORE IT IS IMPERATIVE THAT YOU CHECK THAT YOUR REQUIREMENTS ARE BEING PROVIDED FOR BY THESE DRAWINGS. YOUR REVIEW OR APPROVAL CONSTITUTES YOUR ACCEPTANCE OF OUR INTERPRETATION. EXCEPT FOR YOUR NOTES ON THE RETURNED DRAWINGS. ANY ADDITIONS, CHANGES ADDENDA, ETC. REQUIRED BY THIS OFFICE AFTER OUR RECEIPT OF APPROVED DRAWINGS WILL BE AN EXTRA TO THE CONTRACT AT THE RELEVANT RATES.

NOTE :
- ALL WELDS 6mm FILLET U/N
- VERIFY ALL DIMENSIONS ON SITE BEFORE FABRICATION

NOV 05, 21	I	REV'D AS PER SITE DIM # SITE CONDITION
DATE	NO.	REVISION

FINISH	HOT DIP GALVANIZED		
CUSTOMER	FORESTSIDE ESTATES INC		
PROJECT	GG-95 ATTMAR DRIVE (BLDG. A)		
LOCATION	BRAMPTON, ONTARIO		
DETAIL	EXTERIOR GALVANIZED AIR SHAFT GRATING		
DRAWN BY	BL	CHECKED BY	DRAWING NO.
DATE	MAY 19/2021	SCALE	A5 NOTED
			21-000A-M51
			
615 GARYRAY DRIVE., TORONTO ONT. TEL: (416)746-1255 FAX: (416)746-1256			