



CONSTRUCTION SUMMARY

Grovetrail Developments Inc.

PURCHASER: NA YOUNG KIM

TEL:

LOT NUMBER	PHASE	HOUSE TYPE	CLOSING DATE
32 Block 60	1	LAWSON Elev B	08-Sep-22

Offer	BONUS PACKAGE FOR TOWNHOUSE: PURCHASER TO RECEIVE \$7,500.00 (INCLUSIVE OF TAXES) WORTH OF UPGRADES AT DECOR CENTRE AT TIME OF COLOUR CHART
Workshee	Note:

Offer	BONUS PACKAGE FOR TOWNHOUSE: 5 APPLIANCES TO INCLUDE FRIDGE, STOVE, DISHWASHER WITH STAINLESS STEEL FINISH AND WHITE WASHER AND DRYER AS PER VENDORS SAMPLES. DELIVERED ONLY - NOT INSTALLED.
Workshee	Note:

Offer	TWO (2) LARGER BASEMENT WINDOWS 30 X 30 INCHES, AS PER SKETCH
Workshee	Note:



SITE MASTER

CONSTRUCTION SUMMARY

Grovetrail Developments Inc.

PURCHASER: NA YOUNG KIM

TEL:

LOT NUMBER	PHASE	HOUSE TYPE	CLOSING DATE
32 Block 60	1	LAWSON Elev B	08-Sep-22

Date Added: 13-Jan-22 Invoice Number: 7686

1 - Standard Cable, Telephone and Conduit Rough In (See Sketch) Note:
1 - GARAGE DOOR- Install the builders standard garage door handle with lock Note:
1 - APPLIANCE PACKAGE- Install the Standard Appliance Package throughout the home, where applicable. Note:
1 - KITCHEN- Install a 1st upgrade kitchen cabinet, throughout the kitchen, where applicable, in lieu of teh builders standard. Install the EURO DECO TEC ARCTIC GREY SOFT TOUCH 313 Note:
1 - KITCHEN & BATHROOMS - Purchaser has DECLINED All Upgrades offered during decor appointment at the decor centre for kitchen & bathroom cabinetry. Standard Kitchen Layout & Standard Bathroom Vanities to be installed as per standard plan. (See Sketch) Note:
1 - KITCHEN- Install an upgraded undermount sink in the kitchen. Install the Blanco FORMERA U SUPER SINGLE Model # 402241 Note: **Install the Builders standard single hole kitchen faucet**
1 - MAIN FLOOR- Install an Upgrade #1 Viynl floor throughout the Main floor in lieu of the builders standard Laminate. Install the Everwood Viynl OYSTER BAY EW23005, to be installed on the Main Hall, Great Room, and applicable landings Note:
1 - KITCHEN/DINETTE & MUD ROOM- Install an Upgrade #1 Viynl floor throughout the Kitchen/Dinette & Mud Room in lieu of the builders standard floor tile. Install the Everwood Viynl OYSTER BAY EW23005 Note:
1 - SECOND FLOOR- Install an Upgrade #1 Viynl floor throughout the 2nd Floor in lieu of the builders standard carpet. Install the Everwood Viynl OYSTER BAY EW23005 throughout the Upper Hall, Master Bedroom, Bedroom #2 and #3 Note:
1 - STAIRCASE VS FLOORING WOOD SPECIES DIFFERENCE: STAIRCASE - The purchaser was advised and therefore accepts and acknowledges that the wood species of the staircase and flooring chosen do not match. This difference may result in a stain colour variance. Note: The purchaser agrees that the vendor is to be exempt from any and all claims by the purchaser regarding this colour variance
1 - STAIRCASE VS FLOORING STAINING DIFFERENCE: STAIRCASE - The purchaser was advised and therefore accepts and acknowledges that the stain of the staircase and flooring chosen do not match. This difference might result in an undesirable colour variance Note: The purchaser agrees that the vendor is to be exempt from any and all claims by the purchaser regarding this colour variance.
55 - FOYER- Install an Upgrade 1 floor tile in lieu of the builders standard floor tile. Install the 20X20 PARK GRIS on the Foyer Note:
28 - POWDER ROOM- Install an Upgrade 1 floor tile in lieu of the builders standard floor tile. Install the 20X20 PARK GRIS on the Powder Room. Note:
1 - POWDER ROOM- Install an upgraded undermount sink in the Powder Room, in lieu of the builders standard. Install the Contrac CATENA Model # 4210CIY Note: **Install the builders standard single hole faucet**



SITE MASTER

CONSTRUCTION SUMMARY
Grovetrail Developments Inc.

PURCHASER: NA YOUNG KIM

TEL:

LOT NUMBER	PHASE	HOUSE TYPE	CLOSING DATE
32 Block 60	1	LAWSON Elev B	08-Sep-22

Date Added: 13-Jan-22 Invoice Number: 7686

48 - MASTER ENSUITE- Install a 1st Upgrade floor tile in the Master Ensuite floor, in lieu of the builders standard floor tile. Install the 20X20 PARK GRIS Note:
95 - MASTER ENSUITE SHOWER STALL - Install a 1st Upgrade wall tile in the Master Ensuite shower stall walls in lieu of the builders standard wall tile. Install the 8X16 New Serenity White Glossy- Installed Stacked and Horizontal Note:
1 - CLARIFICATION-POWDER ROOM/ MASTER ENSUITE / MAIN BATH- Install the Standard 3" Splash throughout all bathroom vanity counter tops, where applicable. Note:
1 - LAUNDRY ROOM- Install upgraded Stackable Washer and Dryer in the Laundry Room, in lieu of the builders standard W/D. Install the Whirlpool 27" Front Load Washer # WFW560CHW & 27" Wide Dryer Front Load #YWED5620HW Note:
1 - COUNTER TOPS Purchaser accepts & acknowledges that the Stone slabs vary in size & all seams are visible & the fabricator reserves the right to position the seams as necessary. Note:
1 - Purchaser to receive TEN (X10) Potlights on Main floor as per their Standard Features and Finishes List **SEE BELOW** Note:
1 - GREAT ROOM- In addition to the builders standard ceiling light and switch, Install EIGHT(X8) potlights in the Great Room. All EIGHT (X8) pot lights to be on one separate switch (See Sketch) Note:
1 - DINETTE- In addition to the builders standard ceiling light and switch, Install TWO (X2) potlights in the Dinette Area ONLY. TWO (X2) pot lights to be on the same switch as the builders standard Dinette ceiling light (See Sketch) Note:
1 - PURCHASER HAS ATTENDED A COLOR APPOINTMENT AT THE DECOR CENTRE AND HAS DECLINED ANY ADDITIONAL UPGRADES. Note:
1 - PURCHASER AWARE AND ACCEPTS THAT ANY CHANGES MADE TO UPGRADES AFTER SIGNING THIS PURCHASERS EXTRA FORM ARE SUBJECT TO A MINIMUM ADMINISTRATION FEE OF \$1,000 PLUS A 10% HOLDBACK FEE. Note:

Date Added: 03-Dec-21 Invoice Number: 7624

1 - SECOND FLOOR- Install smooth ceilings throughout the second floor, in lieu of the builders standard. Install smooth ceilings throughout teh Upper Hall, Master Bedroom, Bedroom #2 and #3 Note:
1 - MASTER ENSUITE- Install a frameless glass shower enclosure for the Master Ensuite shower stall, in lieu of the builders standard. (See Sketch) Note:
1 - PURCHASER HAS ATTENDED A STRUCTURAL APPOINTMENT AT THE DECOR CENTRE AND HAS DECLINED ANY ADDITIONAL UPGRADES. Note:
1 - PURCHASER AWARE AND ACCEPTS THAT ANY CHANGES MADE TO UPGRADES AFTER SIGNING THIS PURCHASERS EXTRA FORM ARE SUBJECT TO A MINIMUM ADMINISTRATION FEE OF \$1,000 PLUS A 10% HOLDBACK FEE. Note:



* INTERIOR COLOUR SCHEME *

Purchaser NA YOUNG KIM	Decor Consultant Laura Di Pede	Model and Elevation LAWSON Elev B	Telephone Res. / Bus /	Project Grovetrail Developments Inc.	Closing Date 08/09/2022	Property 32 Block 60
----------------------------------	--	---	----------------------------------	--	-----------------------------------	--------------------------------

Page 1 of 3

Flooring

Description

Master Ensuite

Main Bathroom

Powder Room

Kitchen/Dinette

Laundry 2nd Floor

Foyer

Main Hall

Great Room

Mud Room

Upper Hall

Master Bedroom

Bedroom 2

Bedroom 3

Wall Tile

Main

Accent/Insert

Border / Listello

Pattern

20X20 PARK GRIS (UPGD)

13X13 COSTA WHITE (STD)

20X20 PARK GRIS (UPGD)

Everwood Vinyl Oyster Bay EW23005 (Upgd)

13X13 COSTA WHITE (STD)

20X20 PARK GRIS (UPGD)

Everwood Vinyl Oyster Bay EW23005 (Upgd)

Everwood Vinyl Oyster Bay EW23005 (Upgd)

Railings and Stairs

Railings

Pickets

Posts

Stringers

Treads

Risers

Runner

(STD) MIRAGE Red Oak ASPEN

(STD) PLAIN FLAT BLACK

(STD) MIRAGE Red Oak ASPEN

(STD) MIRAGE Red Oak ASPEN

(STD) MIRAGE Red Oak ASPEN

(STD) MIRAGE Red Oak ASPEN

N/A

Trim

Baseboard & Casing

Front Door Glass

Interior Doors

STD- Modern Step Bevel

STANDARD

STANDARD-Carrara Smooth

Knobs

Hinges

Grip Set

Oyster Bay EW23005 (Upgd)

Oyster Bay EW23005 (Upgd)

N/A

N/A

STANDARD LEVER

STANDARD

STANDARD

Cornice Moulding / Medalion

Foyer

Living Room

Dining Room

Family Room

Main Hall

Kitchen

2nd Floor Hall

NO

NO

Plumbing

WHITE

WHITE

WHITE

UPGRADE

N/A

Notes

**MASTER ENSUITE- 2X2 WHITE MOSAIC SHOWER STALL FLOOR WHITE QUARTZ CURB TOP

**MUD ROOM- Everwood Vinyl Oyster Bay EW23005 (Upgd)

Lot: 32 Block 60 Project: Grovetrail Developments Inc. Model: LAWSON Elev B

Consultant: Laura Di Pede Purchaser: NA YOUNG KIM Vendor: Grovetrail Developments Inc. Printed Jan 12, 2022 3:07 pm



* INTERIOR COLOUR SCHEME *

Purchaser	Decor Consultant	Model and Elevation	Telephone Res. / Bus	Project	Closing Date	Property
NA YOUNG KIM	Laura Di Pede	LAWSON Elev B	/	Grovetrail Developments Inc.	08/09/2022	32 Block 60

Page 2 of 3

Master Ensuite

Main Bathroom

Powder Room

Kitchen/Dinette

Laundry 2nd Floor

Foyer

Main Hall

Great Room

Uper Hall

Master Bedroom

Bedroom 2

Bedroom 3

Interior Paint

Description

(STD) SILVER BIRCH

(STD) SILVER BIRCH

Cabinet

Style

(STD) EURO MAPLE SOAPSTONE

(STD) EURO MAPLE SOAPSTONE

(STD) EURO MAPLE SOAPSTONE

(UPGD) EURO- DECOTEC ARCTIC GREY SOFT TOUCH 313

N/A

Countertop

Emmerstone Maple White (STD)

Emmerstone Maple White (STD)

Emmerstone Maple White (STD)

Emmerstone Maple White (STD)

N/A

Counter Edge

"A" EDGE (STD)

"A" EDGE (STD)

"A" EDGE (STD)

"A" EDGE (STD)

N/A

Handle / Knob

930396 BSN-Std

930396 BSN-Std

930396 BSN-Std

930396 DBK Std

N/A

Appliance Opening/Dimension

Fridge Size STANDARD

Range Std 31in Opening

Built-Ins None

Microwave None

Hood Fan Std 30in

Exhaust Opening ☒ 6" ☐ 8"

Dishwasher Cabinet Std 24in Opening

Notes

BUILDERS STANDARD APPLIANCES

UPGRADE ONLY THE WASHER/DRYER

STANDARD STAINLESS STEEL EXHAUST FAN

Fireplace

Fireplace N/A

Location Flooring N/A

Style N/A

Finish N/A

Marble N/A

Hearth N/A

Fireplace N/A

Location Flooring N/A

Style N/A

Finish N/A

Marble N/A

Hearth N/A

Page 2 of 3

Decor Consultant:

Laura Di Pede




Purchaser:

NA YOUNG KIM

Vendor:

Grovetrail Developments Inc.

Printed Jan 12, 2022 3:07 pm

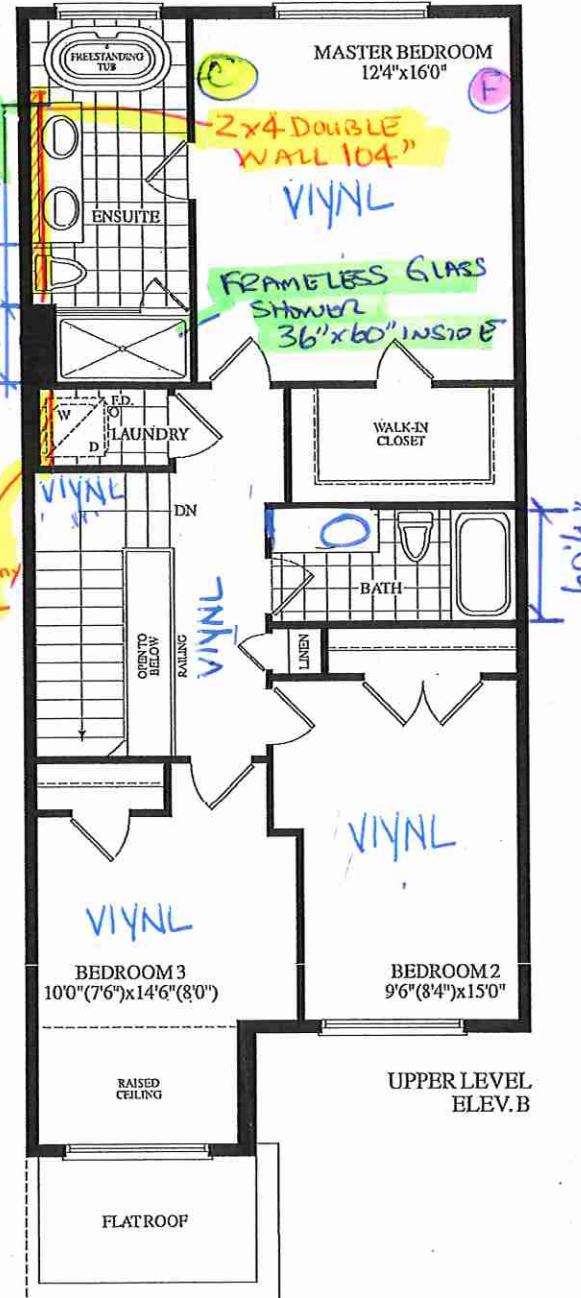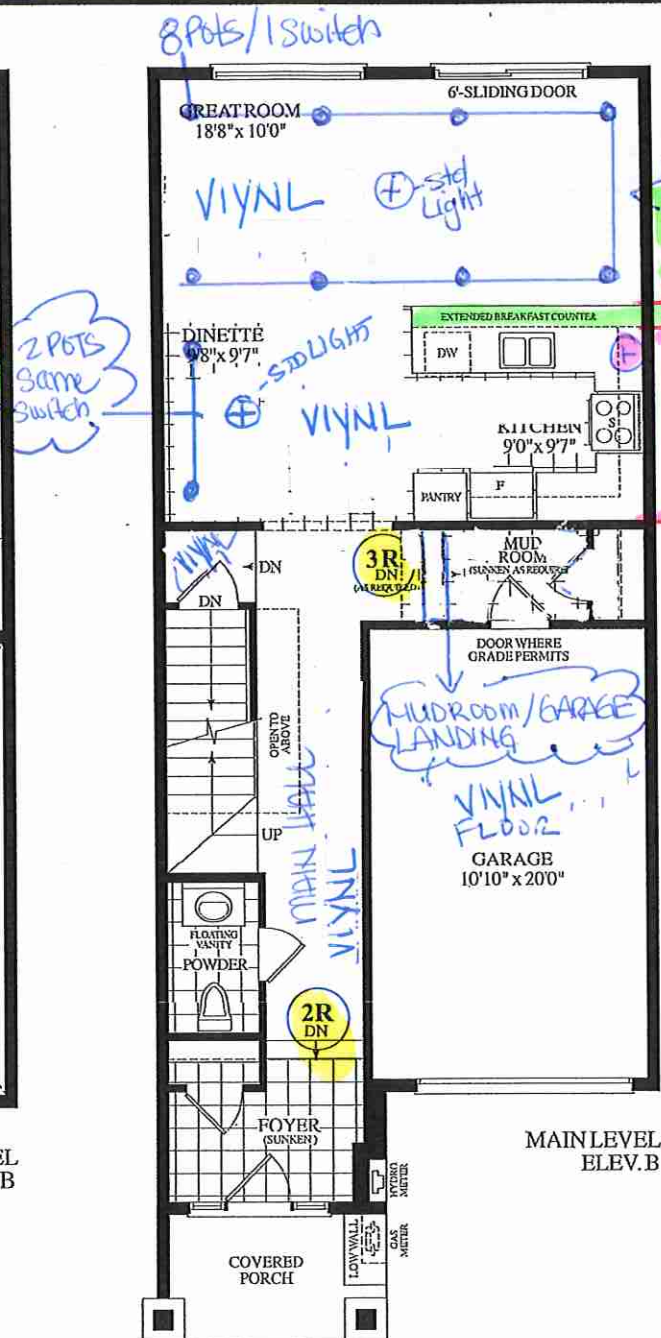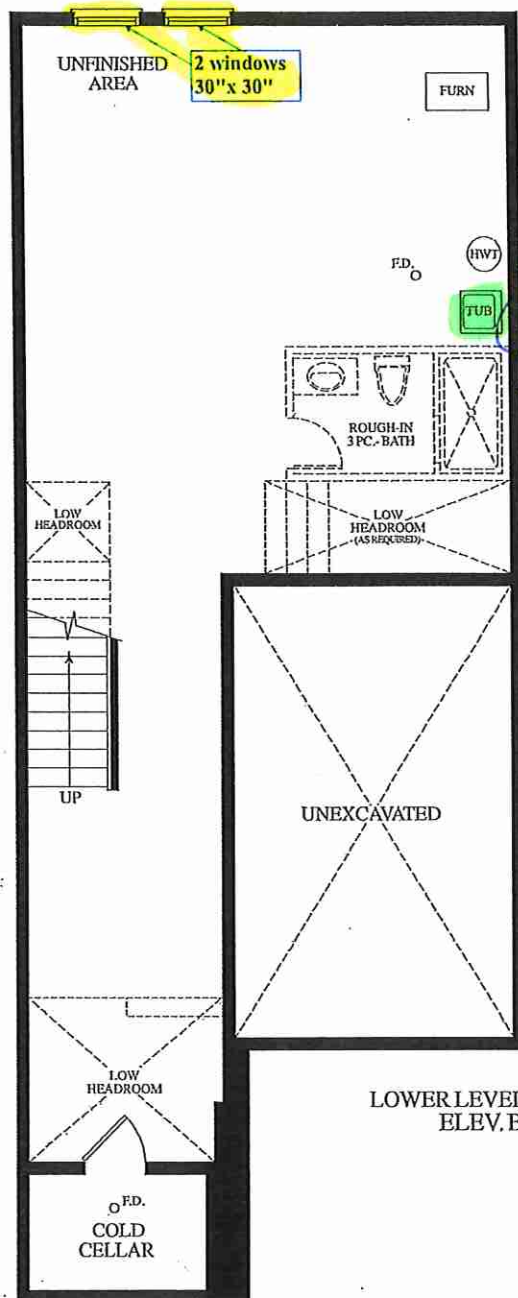


* SMOOTH CEILING 2ND FLOOR *

Ⓢ Cable (x2)
Ⓣ Telephone (x2)
CONDUIT

NYIC

BLK 60 TH 32
20-08 ELEV. B

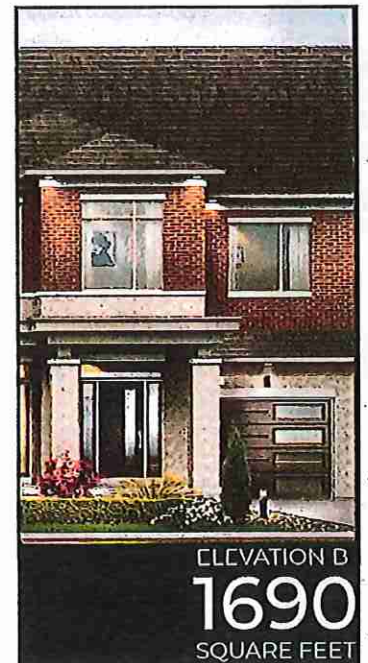

Villa

KITCHENS & FINE CABINETRY LTD

8111 Jane St. Unit 10
Concord, Ontario L4K 4L7
Tel. (905) 669- 7028
Fax. (905) 669 - 7903
email: designstudio@villakitchens.ca
www.villakitchens.ca

CLIENT: ROYAL PINE HOMES

PROJECT: CENTERFIELD

ADDRESS: RP-CE-MASTER

MODEL: LAWSON 2008

KITCHEN


NOTE: BULKHEAD IS
BASED ON A FLAT EURO
CROWN

DRAWN BY: DIDI

DATE: SEPT 10/2021

REVISION:

PAGE: 1 OF 1

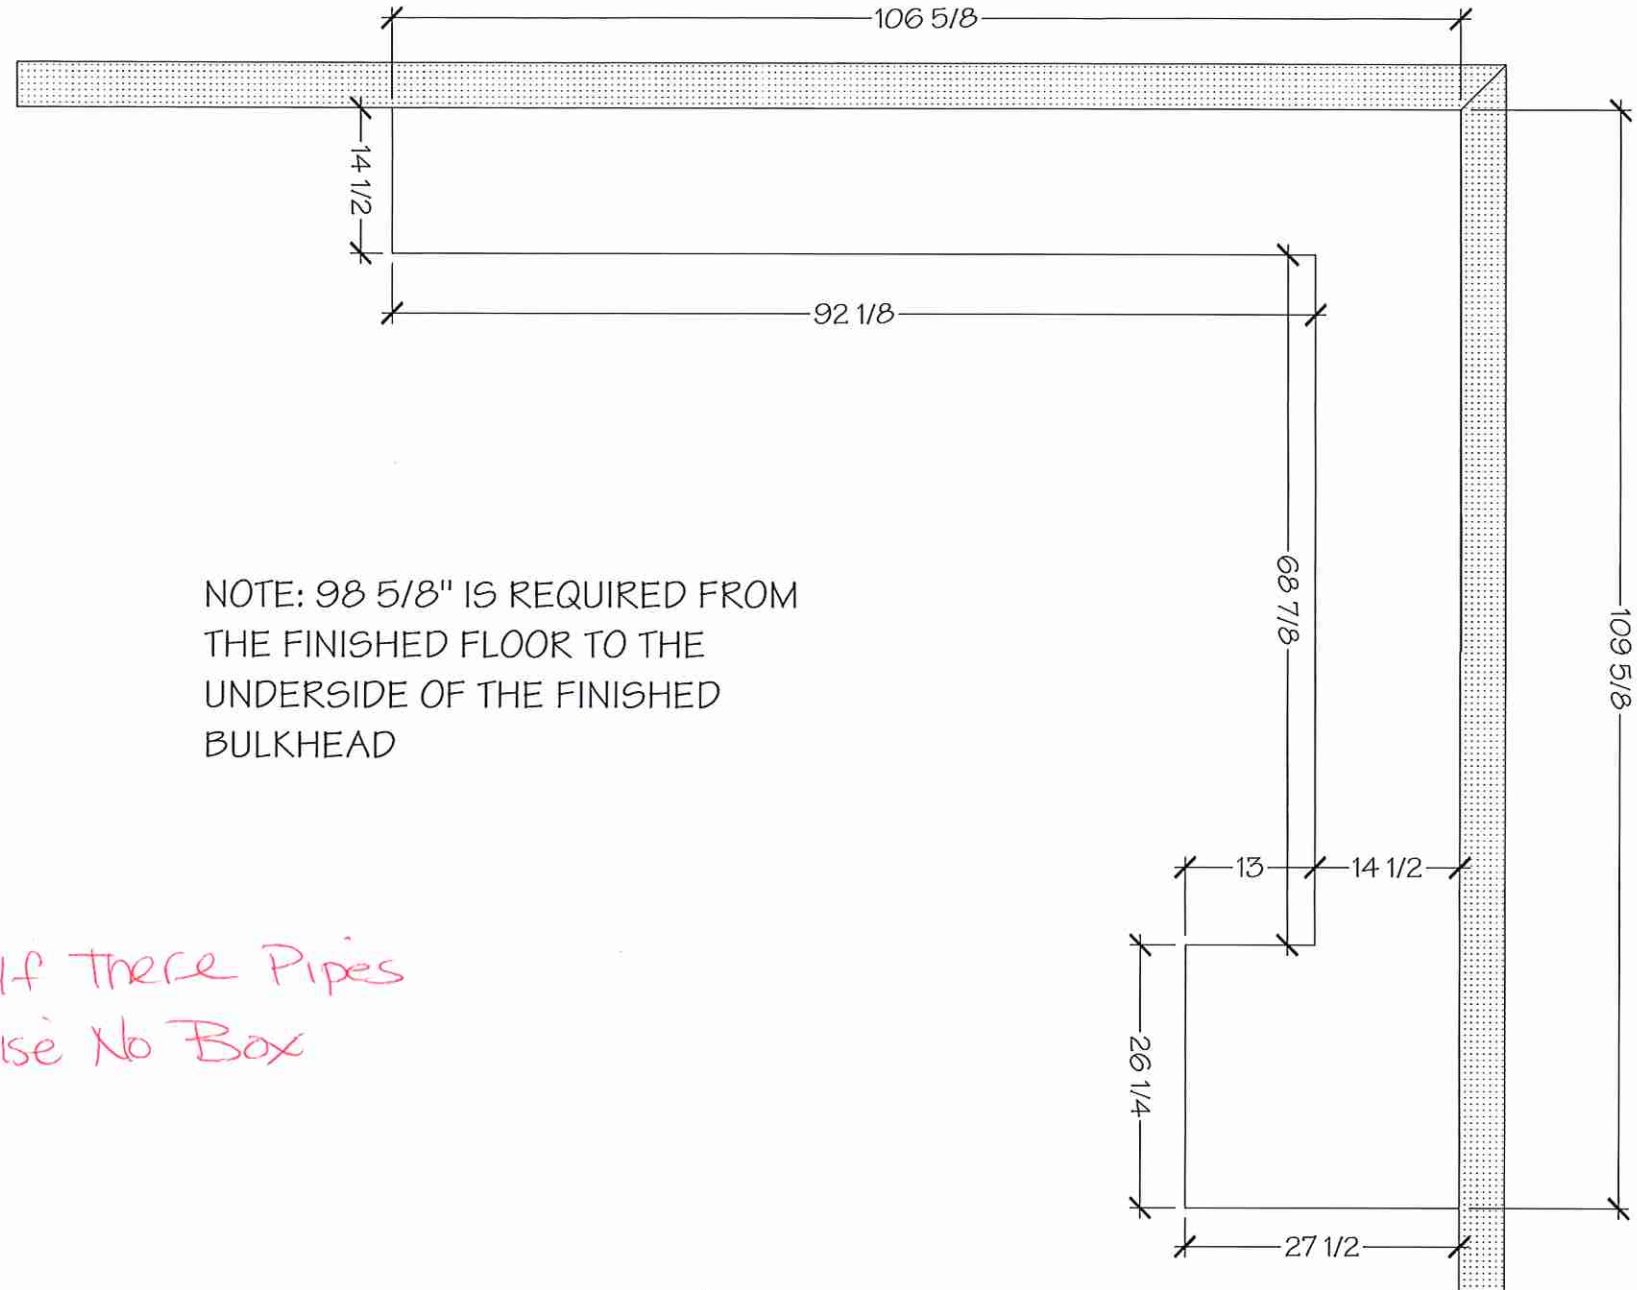

NOTE: $98 \frac{5}{8}$ " IS REQUIRED FROM
THE FINISHED FLOOR TO THE
UNDERSIDE OF THE FINISHED
BULKHEAD

**Only if there Pipes
otherwise No Box*

8111 Jane St. Unit 10
Concord, Ontario L4K 4L7
Tel. (905) 669-7028
Fax. (905) 669-7903
email: designstudio@villakitchens.ca
www.villakitchens.ca

CLIENT: ROYAL PINE HOMES
PROJECT: CENTERFIELD
ADDRESS: RP-CE-MASTER
MODEL: LAWSON 2008

KITCHEN

NOTE: THIS SITE GETS STD-CROWN

LOT 32 BLK 60


AMC

DRAWN BY: DIDI

DATE: JUNE 19/2021

REVISION: NOVEMBER 05/2021

PAGE: 1 OF 8

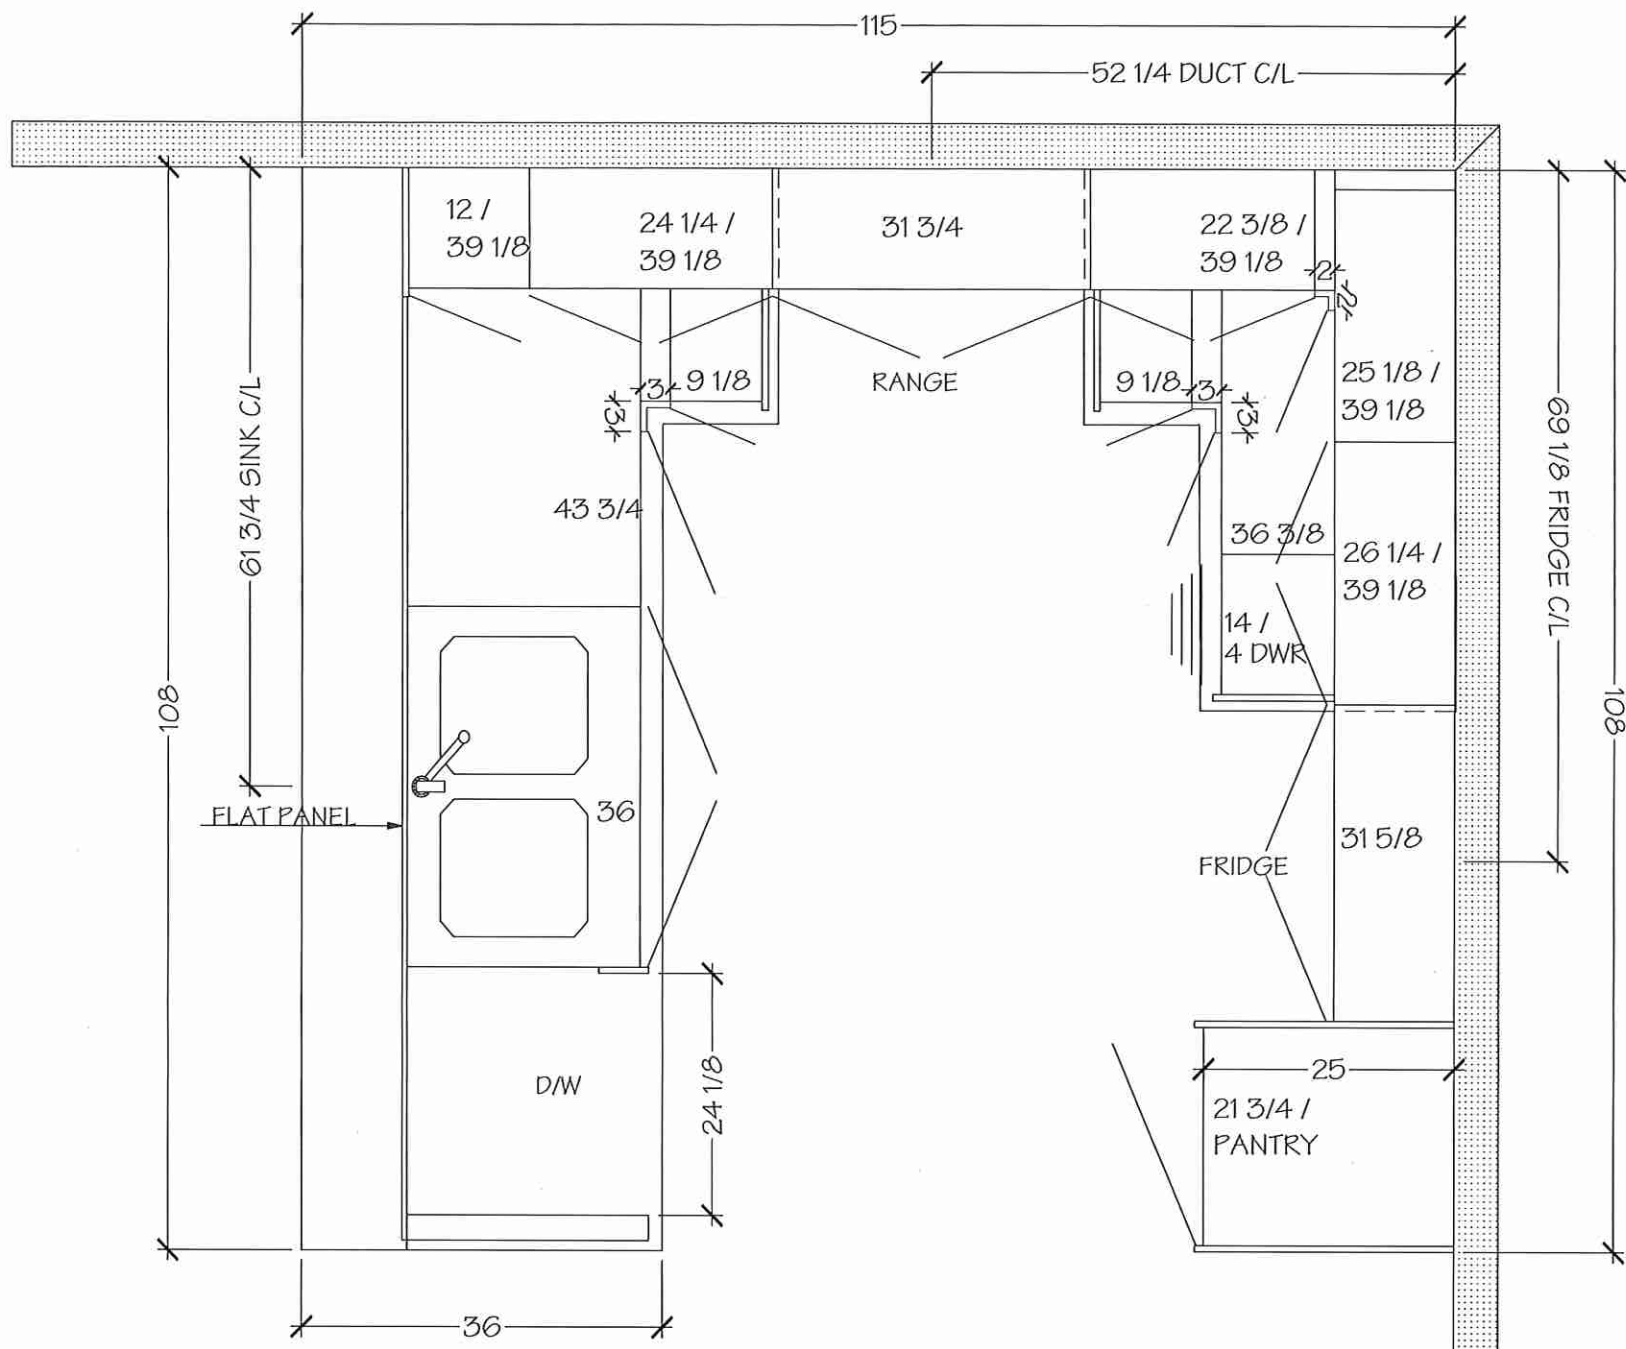

NOTE MEASURES ARE BASED ON FINISHED DRYWALL

Villa

KITCHENS & FINE CABINETRY LTD

8111 Jane St. Unit 10
Concord, Ontario L4K 4L7
Tel. (905) 669- 7028
Fax. (905) 669 - 7903
email: designstudio@villakitchens.ca
www.villakitchens.ca

CLIENT: ROYAL PINE HOMES

PROJECT: CENTERFIELD

ADDRESS: RP-CE-MASTER

MODEL: LAWSON 2008

KITCHEN

NOTE: THIS SITE GETS STD-CROWN

LOT 32 BLK 60




DRAWN BY: DIDI

DATE: JUNE 19/2021

REVISION: NOVEMBER 05/2021

PAGE: 3 OF 8

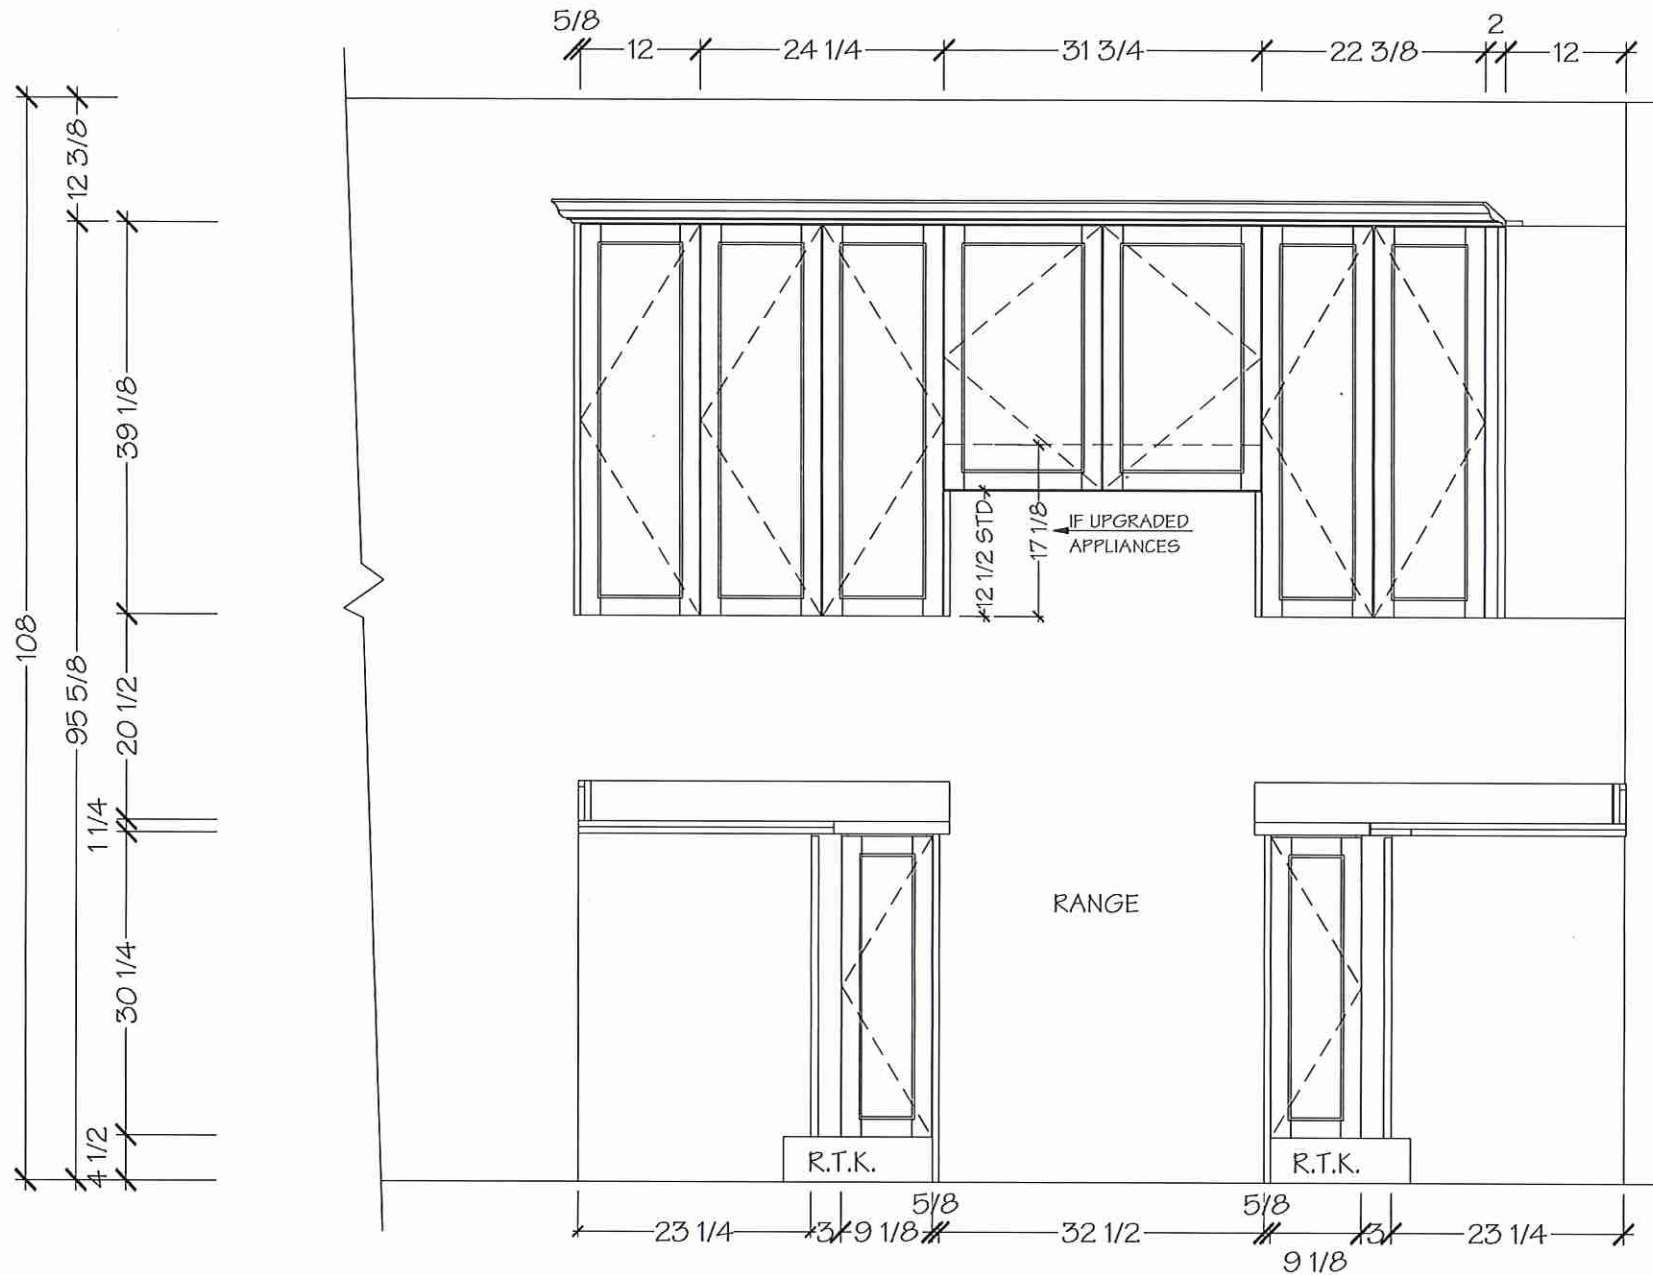

Villa

KITCHENS & FINE CABINETRY LTD

8111 Jane St. Unit 10
Concord, Ontario L4K 4L7
Tel. (905) 669- 7028
Fax. (905) 669 - 7903
email: designstudio@villakitchens.ca
www.villakitchens.ca

CLIENT: ROYAL PINE HOMES

PROJECT: CENTERFIELD

ADDRESS: RP-CE-MASTER

MODEL: LAWSON 2008

KITCHEN

NOTE: THIS SITE GETS STD-CROWN

LOT 32 BLK 60


AKIC

DRAWN BY: DIDI

DATE: JUNE 19/2021

REVISION: NOVEMBER 05/2021

PAGE: 4 OF 8

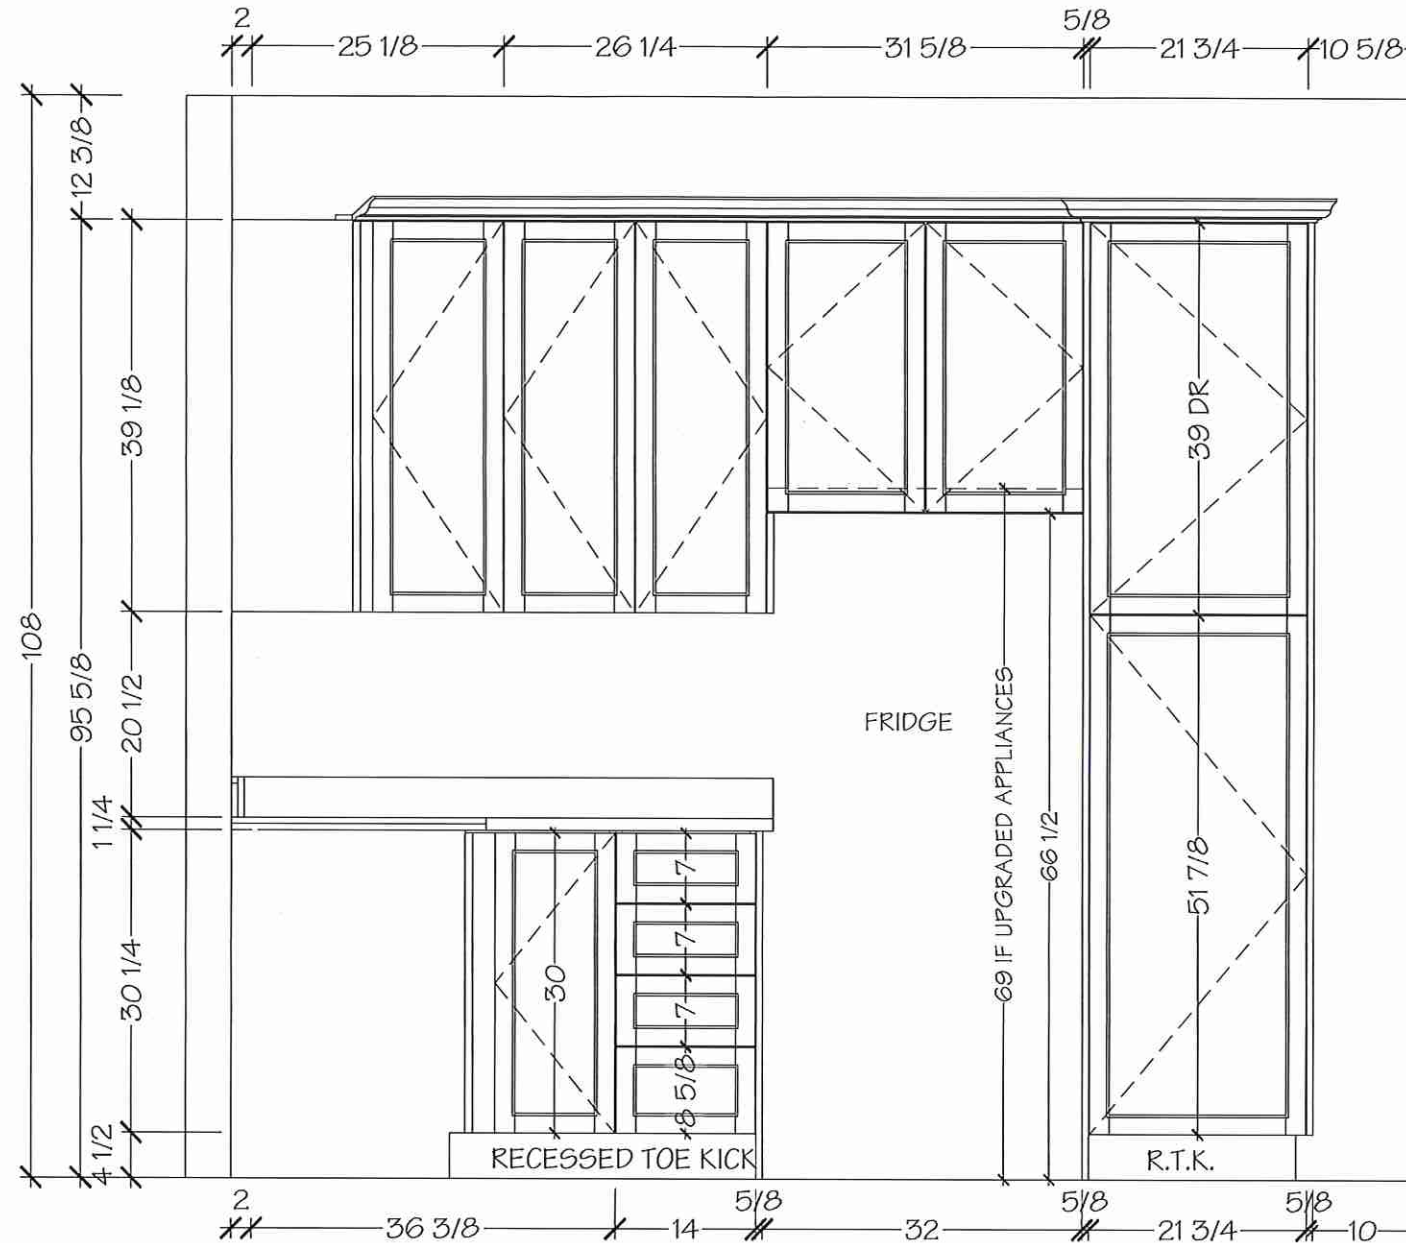

NOTE MEASURES ARE BASED ON FINISHED DRYWALL

Villa

KITCHENS & FINE CABINETRY LTD

8111 Jane St. Unit 10
Concord, Ontario L4K 4L7
Tel. (905) 669-7028
Fax. (905) 669-7903
email: designstudio@villakitchens.ca
www.villakitchens.ca

CLIENT: ROYAL PINE HOMES

PROJECT: CENTERFIELD

ADDRESS: RP-CE-MASTER

MODEL: LAWSON 2008

KITCHEN

NOTE: THIS SITE GETS STD-CROWN

LOT 32 BLK 60



NVIC

DRAWN BY: DIDI

DATE: JUNE 19/2021

REVISION: NOVEMBER 05/2021

PAGE: 2 OF 8

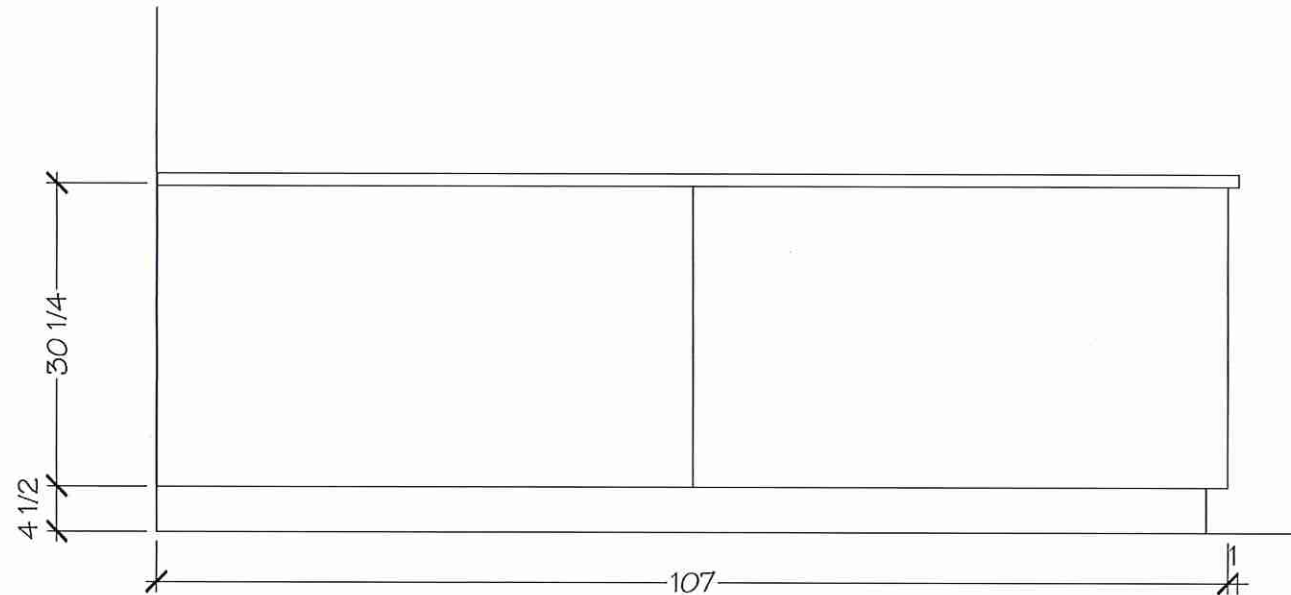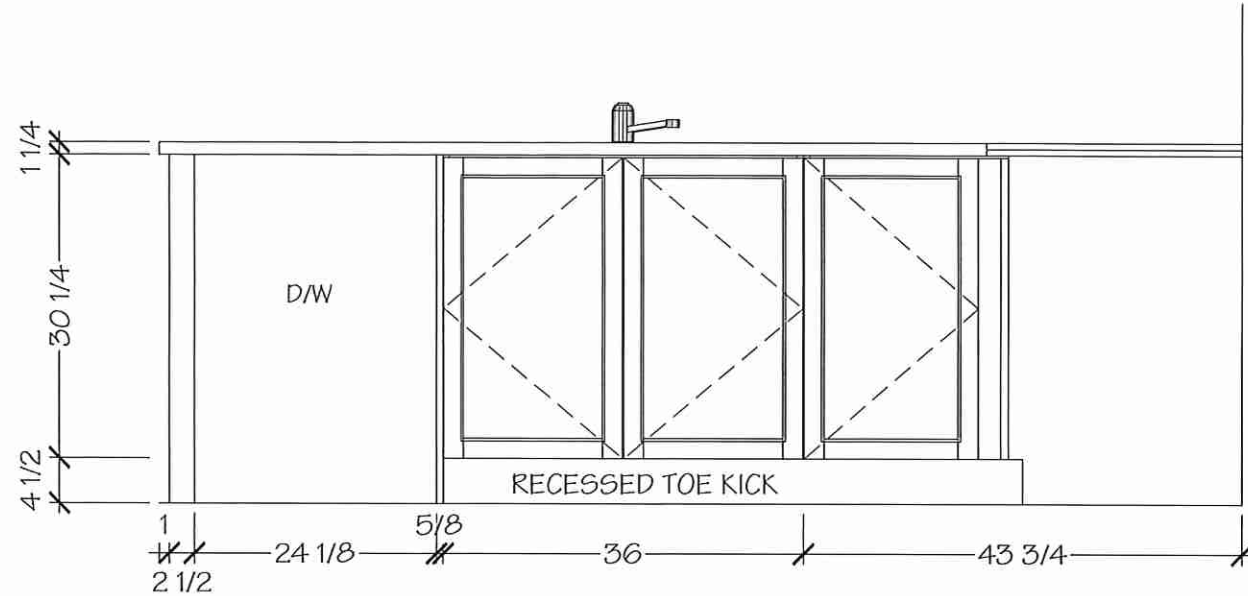

NOTE MEASURES ARE BASED ON FINISHED DRYWALL

Villa

KITCHENS & FINE CABINETS LTD

8111 Jane St. Unit 10
Concord, Ontario L4K 4L7
Tel. (905) 669- 7028
Fax. (905) 669 - 7903
email: designstudio@villakitchens.ca
www.villakitchens.ca

CLIENT: ROYAL PINE HOMES
PROJECT: CENTERFIELD
ADDRESS: RP-CE-MASTER
MODEL: LAWSON 2008

POWDER ROOM

LOT 32 BLK60




DRAWN BY: DIDI


DATE: JUNE 19/2021

REVISION: NOVEMBER 05/2021

PAGE: 5 OF 8

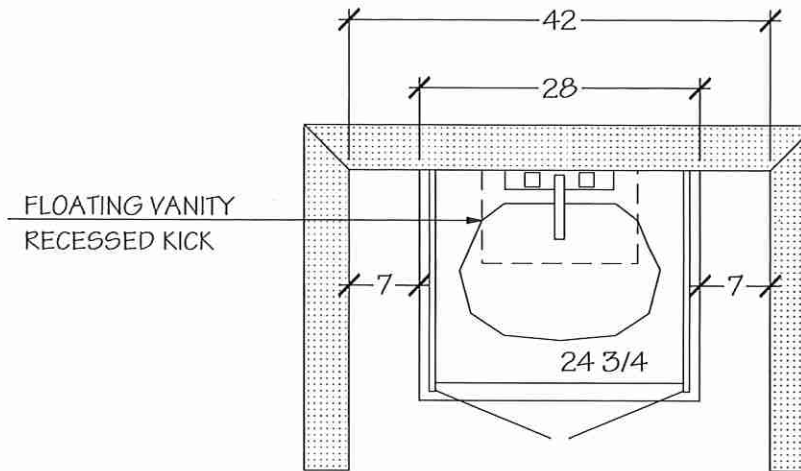

POWDER ROOM

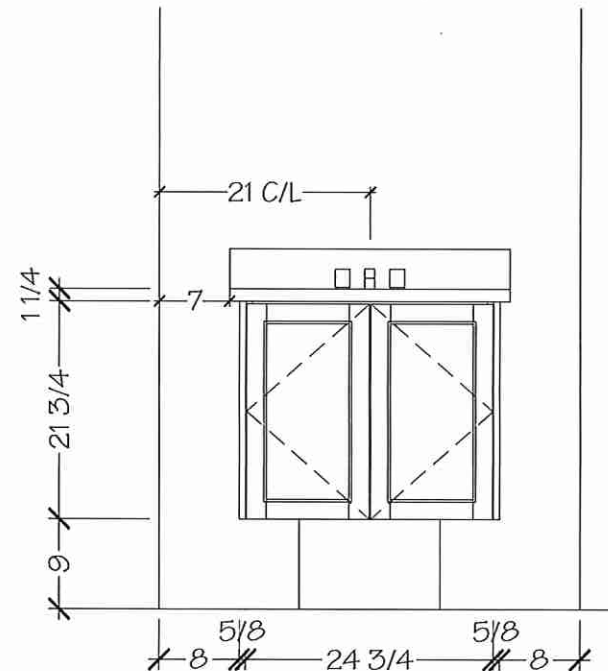

NOTE MEASURES ARE BASED ON FINISHED DRYWALL

Villa

KITCHENS & FINE CABINETRY LTD

8111 Jane St. Unit 10
Concord, Ontario L4K 4L7
Tel. (905) 669- 7028
Fax. (905) 669 - 7903
email: designstudio@villakitchens.ca
www.villakitchens.ca

CLIENT: ROYAL PINE HOMES

PROJECT: CENTERFIELD

ADDRESS: RP-CE-MASTER

MODEL: LAWSON 2008

MASTER ENSUITE

LOT 32 BLK 60





DRAWN BY: DIDI

DATE: JUNE 19/2021

REVISION: NOVEMBER 05/2021

PAGE: 6 OF 8

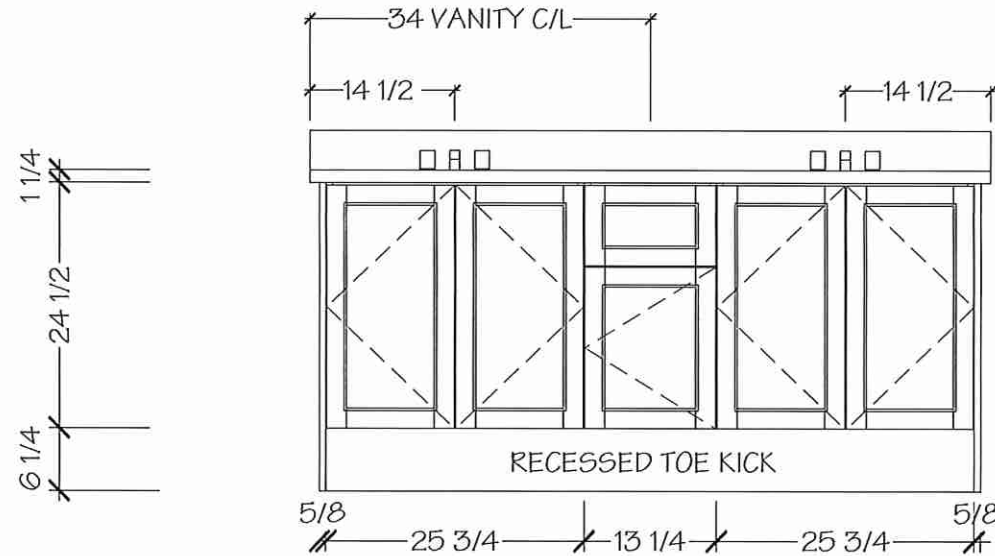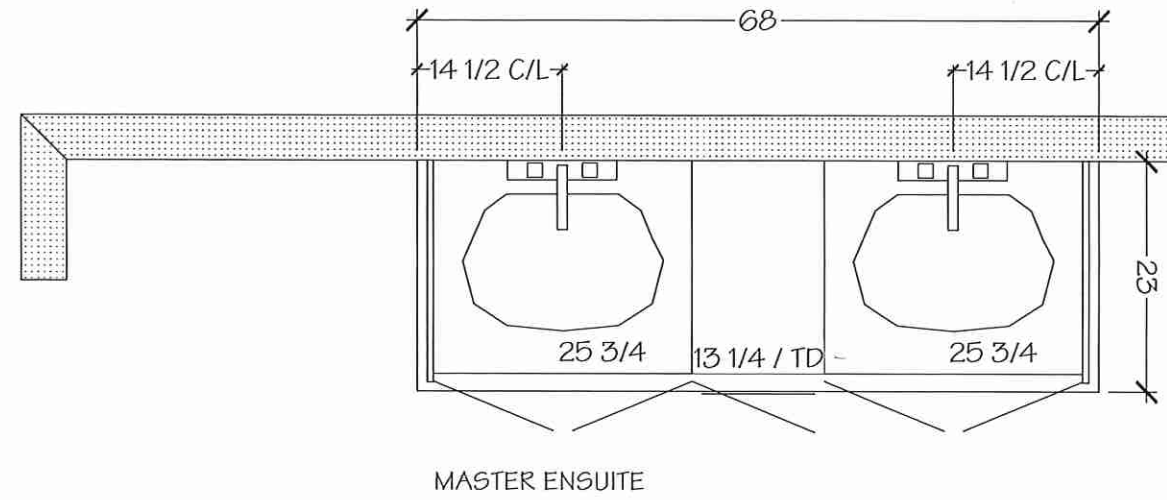

NOTE MEASURES ARE BASED ON FINISHED DRYWALL

Villa

KITCHENS & FINE CABINETRY LTD

8111 Jane St. Unit 10
Concord, Ontario L4K 4L7
Tel. (905) 669-7028
Fax. (905) 669-7903
email: designstudio@villakitchens.ca
www.villakitchens.ca

CLIENT: ROYAL PINE HOMES

PROJECT: CENTERFIELD

ADDRESS: RP-CE-MASTER

MODEL: LAWSON 2008

MAIN BATH

LOT 32 BLK60


NY14

DRAWN BY: DIDI


DATE: JUNE 19/2021

REVISION: NOVEMBER 05/2021

PAGE: 7 OF 8

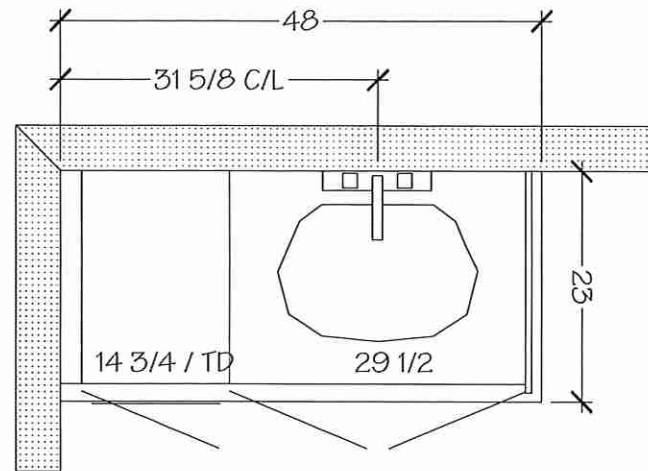

MAIN BATH

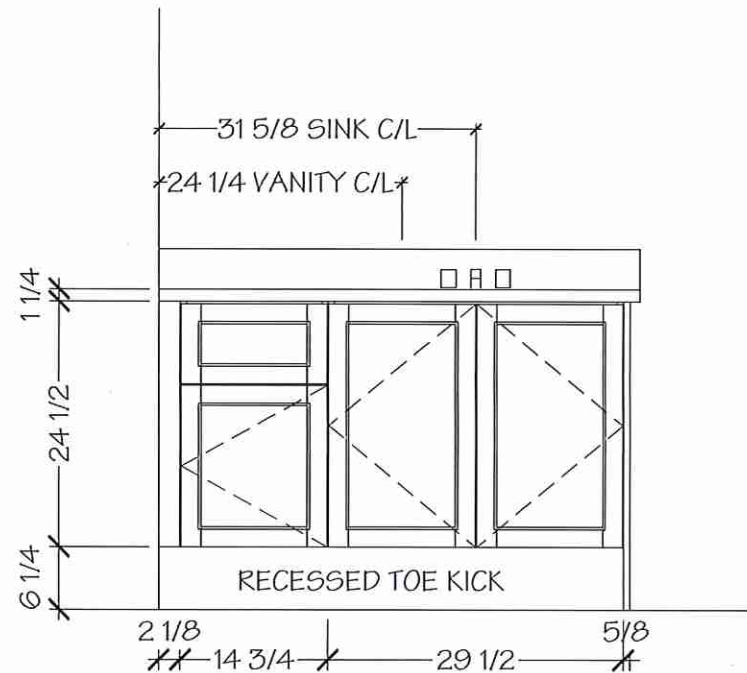

NOTE MEASURES ARE BASED ON FINISHED DRYWALL

LOT 32 BLK60




UPGRADE



5.0 cu.ft I.E.C. Closet-Depth Front Load Washer
with Intuitive Controls

WFW560CHW

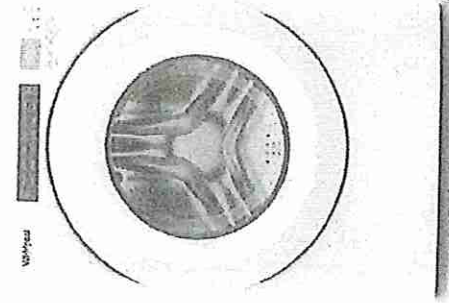

Match your family's routines and your space with a closet-depth front load washing machine that still offers plenty of room for bulky items at 5.0 cu. ft. I.E.C. capacity. Let the ENERGY STAR® certified washer guide you to the right cycle combinations, like the Sanitize cycle with Oxi, or customize up to 35 of your own with Intuitive Controls.

Top Features

5.0 cu. ft. I.E.C. Capacity
Get plenty of room for bulky items with 5.0 cu. ft. I.E.C. capacity.

ENERGY STAR® Certified
ENERGY STAR® certified models exceed government standards to help conserve natural resources and save money on your utility bills.

Intuitive Controls

Let the washer guide you to the right cycle combinations or customize up to 35 of your own to get the right type of fabric care for whatever you're washing.

Sanitize Cycle with Oxi

The Sanitize cycle with Oxi eliminates 99.9% of common household bacteria by mixing detergent with an oxi additive.

Available Finishes/Colours


☐

WFW560CHW
White

Manuals & Literature:



Energy Guide

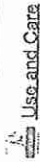

Use and Care



Installation Instructions



Warranty

Dimensions		Controls	
Depth	31 9/16	End of Cycle Signal	Yes
Width	27	LCD Touch Screen	No
		LED Color	Blue

Exterior		Compatibility	
Lid/Door Lock	Yes	Connectivity	No
Lid/Door Swing	Left	Works With	No
Window	Yes		

Controls		Appearance	
Automatic Temperature Controls	Yes	Window	Yes
Control Type	Tap Touch	LCD Touch Screen	No
Control Location			
Electronic Display Type		Details	
		Cycle Indicator Lights with Digital Time Remaining	No
		Automated Dispenser	N/A

LASTMAN'S BAD BOY
Josh Robins
josh@noobody.com

500 Fenmar Drive
North York, ON M9L 2V5

Page 6 of 7




Because Whirlpool Corporation policy includes a continuous commitment to improve our products, we reserve the right to change materials and specifications without notice. Dimensions are for planning purposes only. For complete details, see Installation Instructions packed with product. Specifications subject to change without notice.

LOT 32 BLK 60



UPGRADE

Whirlpool®

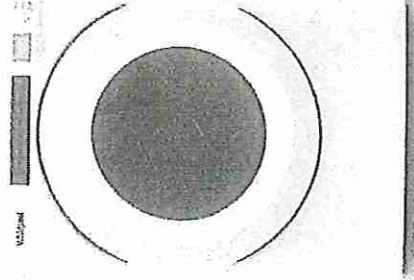

7.4 cu. ft. Front Load Electric Dryer with Intuitive Touch Controls

YWED5620HW

Let the front load electric dryer guide you to the right cycle combinations for whatever you're drying with Intuitive Controls. Advanced Moisture Sensing uses three moisture sensors to help prevent overdrying. The ENERGY STAR® certified electric dryer helps keep wrinkles from setting after the cycle with the Wrinkle Shield™ option.

Top Features

Wrinkle Shield™ Option

Help keep wrinkles from setting into clean, dry fabrics with the Wrinkle Shield™ option. It keeps clothes tumbling for up to 150 minutes after the cycle ends or until you open the door.

7.4 cu. ft. Capacity

Get plenty of room to dry the large loads you washed in the matching front load washer. This 7.4 cu. ft. dryer easily handles bulky items like comforters and sleeping bags.

Intuitive Controls

Let the dryer guide you to the right cycle combinations or customize up to 36 of your own to get the right type of fabric care for whatever you're drying.

Advanced Moisture Sensing

Help prevent overdrying. Three sensors track moisture and temperature, adapting drying times to end the cycle at just the right time.

Available Finishes/Colours

☐ YWED5620HW
White

Manuals & Literature:

- Dimension Guide
- Energy Guide
- Installation Instructions
- Use and Care
- Warranty

Dimensions		Controls	
Depth	31	End of Cycle Signal	Yes
Height	38 3/4		
Width	27		
Configuration and Overview			
Fuel Type	Electric		
Appearance			
Door Style	Side Swing		
Window	Yes		
Reversible Door	Yes		
Controls			
Control Type	Electronic		
Feedback-Status Indicators	Check Vent, Cool Down, Damp, Sensing, Wet		
Control Location	Front Panel		
Details			
Door Style	Side Swing		
Eco Monitor/Efficiency Monitor	No		
Maytag Commercial Components	No		
Automatic Dry Control	Yes		

LASTMAN'S BAD BOY
Josh Robins
josh@noobody.com

500 Fenmar Drive
North York, ON M9L 2V5

Page 7 of 7



Because Whirlpool Corporation policy includes a continuous commitment to improve our products, we reserve the right to change materials and specifications without notice. Dimensions are for planning purposes only. For complete details, see installation instructions packed with product. Specifications subject to change without notice.

LOT 32 BLK60

BLANCO

Sink Specifications

FORMERA U SUPER SINGLE
Stainless steel

Colour

SKU

402241



Design and planning tips


- Min cabinet size: 36 in (915 mm)
- Bowl Depth: 9 in (230.0 mm)

Specifications:

Sink template, Installation instructions, Clips,
3½" (90 mm) stainless steel strainer(s), Limited
Lifetime Warranty

Depending on cabinet construction, a different
cabinet size may be required. Consult the cabinet
manufacturer.

Codes/Standards: ASME A112.19.3-2017/ CSA
B45.4-17

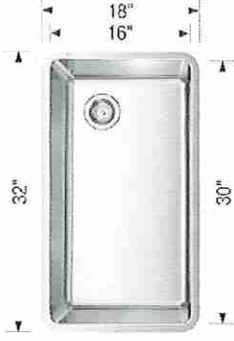

**Standard Single
Hole Faucet **

Optional Accessories

~~CapFlow Strainer Cover 517666~~

~~Sink Grid 402248~~

Warranty

Limited lifetime warranty on all sinks and faucets. One-year warranty on all accessories and soap dispensers.

Code/Standards Compliance

BLANCO sinks and faucets are third-party tested and certified to CSA, cUPC, ANSI/ASME, IAPMO and NSF standards and listed by applicable certification bodies. For more information on individual product listings, contact our office or listing organization.



Need support? Learn more by watching our sink & faucet How-to videos:
<https://www.blanco.com/ca-en/support/how-to-videos/how-to-videos-for-sinks/>



BLANCO Canada Inc
100 Corporation Drive
Brampton ON L6S 6B5

Tel & Fax

Tel: 905-494-2400 Toll free: 1-877-425-2626

Fax: 905-494-2425 Toll free: 1-877-825-2626

While BLANCO strives to provide accurate information, all images and dimensions in this document are intended for reference only and are subject to change at any time without notice. This document is not intended for use as an installation guide. For technical installation details, refer to installation instructions provided with the product. BLANCO assumes no responsibility for the use of superseded or voided specifications.

LOT 32 BUKO

POWDER ROOM



SINK | UNDERMOUNT



CATENA

20" SINK
4210CIY

ITEM DETAILS

OUTER DIMENSIONS 20" W x 15³/₈" D x 7¹/₂" H

INNER DIMENSIONS 18" W x 13³/₈" D x 5¹/₂" H

MATERIAL Vitreous china COLOUR Soft white


Rectangular undermount sink | Front overflow hole | Template and mounting hardware supplied | Faucet not included.

~~*Standard Faucet*~~

CERTIFICATIONS

| IAPMO cUPC

| ASME A112.19.2 / CSA B45.1-2013

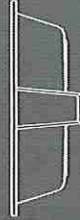

ISSUED JUNE 2018


LOT 32 BLK 60

EDGE
DETAILS


004

- * Powder Room
- * KITCHEN
- * MASTER ENSUITE
- * ~~MAIN BATH~~

NMC

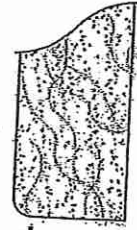

STRAIGHT EDGE
(STANDARD - 3/4")

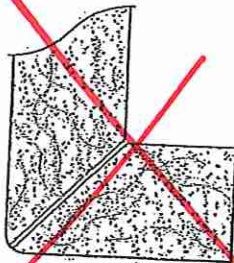

MITER WITH SKIRT EDGE
(MEDIUM - 1 1/2")



OGEES - SQUARE EDGE
(MED/HIGH - 1 1/2")

EDGING UP-GRADE OPTIONS

RECEIVED
HCS