

Dimensions, specifications, layouts, window sizes, and materials are approximate only, may vary, and are subject to change as provided in the Agreement of Purchase & Sale. Plans may be reversed. Illustrations are artist's concept. E&OE



SITE COPY

CONSTRUCTION SUMMARY

Forestside Estates Inc.

PURCHASER: NICOLA FACCIUOLO

TEL:

LOT NUMBER	PHASE	HOUSE TYPE	CLOSING DATE
318 BLOCK 2	6-III	Magnolia 2C1*	13-Apr-23

Date Added: 25-Feb-22

Invoice Number: 7731

1 - APPLIANCE PACKAGE- Install the Standard Appliance Package. To be installed throughout the suite, where applicable (See Sketch)

Note:

75 - FOYER - FLOORING- Install UPGRADE 1 FLOOR TILE (13X13 New Reeds Silver) throughout the foyer where applicable in lieu of the builder's standard floor tile. To be installed straight/stacked (See sketch)

Note:

1 - KITCHEN & BATHROOMS - Purchaser has DECLINED All Upgrades offered during decor appointment at the decor centre for kitchen & bathroom cabinetry. Standard Kitchen Layout & Standard Bathroom Vanities to be installed as per standard plan. (See Sketch)

Note:

1 - KITCHEN - CABINETRY - Install UPGRADE 2 CABINET DOORS (3101 Chantilly Lace) throughout the kitchen where applicable in lieu of the builder's standard. (See Sketch)

Note:

1 - KITCHEN- CABINETRY - Install OPTIONAL ISLAND inside the Kitchen. (3101 Chantilly Lace)  
(ISLAND WITH ONE SET OF POT DRAWER (1SMALL, 2 DEEP) w/ PREMIUM SOFT CLOSE MOTION SLIDES AS PER DRAWINGS

Note:

1 - KITCHEN - COUNTER - Install STONE COUNTERTOP on top of the OPTIONAL KITCHEN ISLAND. To install Emmerstone Maple White with the standard "A" Edge ( See sketch)

Note:

1 - KITCHEN - PLUMBING - Install the UPGRADED UNDERMOUNT sink in the kitchen- Install the BLANCO QUATRUS U1 SUPER SINGLE-Model # 401248. To include cut and polish

Note:

1 - KITCHEN- PLUMBING - Kitchen Faucet STANDARD- DELTA Chrome Osler Pull Down Kitchen Faucet (Single Hole) - Model # 976 LF

Note:

28 - POWDER ROOM- FLOORING- Install UPGRADE 1 FLOOR TILE (13X13 New Reeds Silver) throughout the Powder room where applicable in lieu of the builder's standard floor tile. To be installed straight/stacked (See sketch)

Note:

1 - POWDER ROOM- CABINETRY - Install UPGRADE 2 CABINET DOORS (3101 Chantilly Lace) throughout the Powder Room where applicable in lieu of the builder's standard. (See Sketch)

Note:

35 - MECHANICAL ROOM- FLOORING- Install UPGRADE 1 FLOOR TILE (13X13 New Reeds Silver) throughout the Mechanical Room where applicable in lieu of the builder's standard floor tile. To be installed straight/stacked (See sketch)

Note:

28 - LAUNDRY- FLOORING- Install UPGRADE 1 FLOOR TILE (13X13 New Reeds Silver) throughout the Laundry Room where applicable in lieu of the builder's standard floor tile. To be installed straight/stacked (See sketch)

Note:

1 - STAIRCASE VS FLOORING  
WOOD SPECIES DIFFERENCE:

STAIRCASE - The purchaser was advised and therefore accepts and acknowledges that the wood species of the staircase and flooring chosen do not match. This difference may result in a stain colour varianc

Note: The purchaser agrees that the vendor is to be exempt from any and all claims by the purchaser regarding this colour variance.

1 - STAIRCASE - STAIN - Stain Staircase Complete from main to second floor throughout where applicable. To be stained Vintage Red Oak Pewter. To include handrail, posts, treads. ( See sketch)

Note: Risers and Stringers to remain painted white





SITE COPY

CONSTRUCTION SUMMARY			
Forestside Estates Inc.			
PURCHASER: NICOLA FACCIUOLO			TEL:

LOT NUMBER	PHASE	HOUSE TYPE	CLOSING DATE
318 BLOCK 2	6-III	Magnolia 2C1*	13-Apr-23

Date Added: 25-Feb-22      Invoice Number: 7731

<p>1 - STAIRCASE VS FLOORING</p> <p>STAINING DIFFERENCE:</p> <p>STAIRCASE - The purchaser was advised and therefore accepts and acknowledges that the stain of the staircase and flooring chosen do not match. This difference might result in an undesirable colour variance.</p> <p>Note: The purchaser agrees that the vendor is to be exempt from any and all claims by the purchaser regarding this colour variance.</p>
<p>1 - MAIN BATH- FLOORING - Purchaser accepts &amp; acknowledges that the floor tiles on the Main Bath will be installed stacked NOT brick pattern.</p> <p>Note:</p>
<p>1 - POWDER ROOM /MASTER ENSUITE / MAIN BATH- Install the Standard 3" Splash throughout all bathroom vanity counter tops, where applicable. To include the Powder Room, Main Bath and the Master Ensuite</p> <p>Note:</p>
<p>1 - POWDER ROOM/ MASTER ENSUITE / MAIN BATH- Install the builders standard Plumbing Fixtures throughout all bathrooms, where applicable. To Include the Master Ensuite &amp; Main Bath &amp; Powder Room</p> <p>Note:</p>
<p>1 - KITCHEN / MAIN BATH/ MASTER ENSUITE / POWDER ROOM - Stone slabs vary in size &amp; all seams are visible &amp; the fabricator reserves the right to position the seams as necessary.</p> <p>Note:</p>
<p>50 - MASTER ENSUITE - FLOORING- Install UPGRADE 1 FLOOR TILE (13X13 New Reeds Silver) throughout the Master ensuite where applicable in lieu of the builder's standard floor tile. To be installed straight/stacked (See sketch)</p> <p>Note:</p>
<p>1 - MASTER ENSUITE- CABINETRY - Install UPGRADE 2 CABINET DOORS (3101 Chantilly Lace) throughout the Master ensuite where applicable in lieu of the builder's standard. (See Sketch)</p> <p>Note:</p>
<p>40 - MAIN BATH - FLOORING- Install UPGRADE 1 FLOOR TILE (13X13 New Reeds Silver) throughout the Main Bath where applicable in lieu of the builder's standard floor tile. To be installed straight/stacked (See sketch)</p> <p>Note:</p>
<p>35 - KITCHEN - WALL TILE - Install UPGRADE 1 BACKSPLASH (Glass tile, Twilight Coffee/Mocha Mosaic Sheets) throughout the Kitchen where applicable in lieu of the builder's standard backsplash. Does not include behind stove / behind fridge (see sketch)</p> <p>Note:</p>
<p>1 - MAIN BATH- CABINETRY - Install UPGRADE 2 CABINET DOORS (3101 Chantilly Lace) throughout the main bath where applicable in lieu of the builder's standard. (See Sketch)</p> <p>Note:</p>
<p>1 - MASTER BEDROOM - FLOORING - Install UPGRADED LAMINATE throughout the master bedroom where applicable in lieu of the builder's standard broadloom. Install 8" HIGHLAND ALDERSON OAK (EE-H-285) (See sketch)</p> <p>Note:</p>
<p>1 - BEDROOM #2 - FLOORING - Install UPGRADED LAMINATE throughout bedroom #2 where applicable in lieu of the builder's standard broadloom. Install 8" HIGHLAND ALDERSON OAK (EE-H-285) (See sketch)</p> <p>Note:</p>
<p>1 -       PURCHASER AWARE AND ACCEPTS THAT ANY CHANGES MADE TO UPGRADES AFTER SIGNING THIS PURCHASERS EXTRA FORM ARE SUBJECT TO A MINIMUM ADMINISTRATION FEE OF \$1000 PLUS A 10% HOLDBACK FEE.</p> <p>Note:</p>
<p>1 - PURCHASER HAS ATTENDED A STRUCTURAL AND COLOR APPOINTMENT AT THE DECOR CENTRE AND HAS DECLINED ANY ADDITIONAL UPGRADES.</p> <p>Note:</p>

\* INTERIOR COLOUR SCHEME \* ~~REVISED~~ ~~INTENT~~ ~~NOT~~

<b>Purchaser</b> NICOLA FACCIUOLO	<b>Decor Consultant</b> Denise Sue	<b>Model and Elevation</b> Magnolia 2C1*	<b>Telephone Res. / Bus</b> /	<b>Project</b> Forestsides Estates Inc.	<b>Closing Date</b> 13/04/2023	<b>Property</b> 318 BLOCK 2
--------------------------------------	---------------------------------------	---	----------------------------------	--	-----------------------------------	--------------------------------

Master Ensuite

Main Bathroom

Powder Room

Kitchen

Laundry

Mechanical Room

Foyer

Storage Room

Living Room

Dining Room

2nd Floor Hall

Den

Master Bedroom

Bedroom 2


Flooring		Wall Tile	Accent/Insert	Border / Listello	Pattern	Plumbing
Master Ensuite	13x13 New Reeds Silver (UPGRADE)	8x10 Calacatta Malte (STANDARD)	N/A	N/A	N/A	WHITE
	13x13 New Reeds Silver (UPGRADE)	8x10 Calacatta Malte (STANDARD)	N/A	N/A	N/A	WHITE
Powder Room	13x13 New Reeds Silver (UPGRADE)	N/A				WHITE
	8" Highland Alderson Oak EE-H-285 (STANDARD)	Twilight Mocha/Coffee Mosaic (UPG)	N/A	N/A	N/A	See Notes
Kitchen	13x13 New Reeds Silver (UPGRADE)	N/A	N/A	N/A	N/A	N/A
	13x13 New Reeds Silver (UPGRADE)	N/A	N/A	N/A	N/A	N/A
Mechanical Room						
Foyer	8" Highland Alderson Oak EE-H-285 (STANDARD)					
Storage Room	8" Highland Alderson Oak EE-H-285 (STANDARD)					
	8" Highland Alderson Oak EE-H-285 (STANDARD)					
Living Room	8" Highland Alderson Oak EE-H-285 (STANDARD)					
	8" Highland Alderson Oak EE-H-285 (STANDARD)					
Dining Room						
2nd Floor Hall	8" Highland Alderson Oak EE-H-285 (STANDARD)					
	8" Highland Alderson Oak EE-H-285 (STANDARD)					
Den	8" Highland Alderson Oak EE-H-285 (STANDARD)					
	8" Highland Alderson Oak EE-H-285 (STANDARD)					
Master Bedroom	8" Highland Alderson Oak EE-H-285 (STANDARD)					
	8" Highland Alderson Oak EE-H-285 (STANDARD)					
Bedroom 2						

Railings and Stairs		Landing - Upper	Landing - Lower	Ledge - Upper	Ledge - Lower	Cornice Moulding / Medallion
Railings	(STD) OVAL RED OAK Pewter (UPG)	Highland Alderson Oak EE-H-285	N/A	N/A	N/A	Foyer
Pickets	N/A	N/A	N/A	N/A	N/A	Living Room
Posts	(STD) 3 1/2" Oak Sq. w/ Cap - Pewter (Upg)	N/A	N/A	N/A	N/A	Dining Room
Stringers	PAINTED WHITE (STD)	N/A	N/A	N/A	N/A	Family Room
Treads	RED OAK Vintage Pewter (UPGRADE)					Main Hall
Risers	PAINTED WHITE (STD)					Kitchen
Runner	N/A					2nd Floor Hall
Trim						
Baseboard & Casing	STANDARD	Knobs	STANDARD			
Front Door Glass	N/A	Hinges	STANDARD			
Interior Doors	STANDARD	Grip Set	STANDARD			

Notes

KITCHEN - PLUMBING - Install the UPGRADED UNDERMOUNT sink in the kitchen- Install the BLANCO QUATRUS U1 SUPER SINGLE- Model # 401248.

KITCHEN- PLUMBING - Kitchen Faucet STANDARD- DELTA Chrome Oster Pull Down Kitchen Faucet (Single Hole) - Model # 976 LF

<b>Consultant:</b> Denise Sue	<b>Purchaser:</b> NICOLA FACCIUOLO	<b>Vendor:</b> Forestside Estates Inc.
<b>DocuSigned by:</b> 		<b>Printed Feb 18, 2022 1:23 pm</b>



\* INTERIOR COLOUR SCHEME \*

BUILDING A

<b>Purchaser</b> NICOLA FACCIUOLO	<b>Decor Consultant</b> Denise Sue	<b>Model and Elevation</b> Magnolia 2C1*	<b>Telephone Res. / Bus</b> /	<b>Project</b> Forestside Estates Inc.	<b>Closing Date</b> 13/04/2023	<b>Property</b> 318 BLOCK 2
--------------------------------------	---------------------------------------	---	----------------------------------	---	-----------------------------------	--------------------------------

Interior Paint						
Description						
Master Ensuite	DISTANT GREY (STANDARD)	✓	CAT.2 - 3101 Chantilly Lace FIBER BOARD (UPGRADE)	✓	Emmerstone Maple White (STD)	✓
	DISTANT GREY (STANDARD)		CAT.2 - 3101 Chantilly Lace FIBER BOARD (UPGRADE)		Emmerstone Maple White (STD)	
Main Bathroom						
Powder Room	DISTANT GREY (STANDARD)	✓	CAT.2 - 3101 Chantilly Lace FIBER BOARD (UPGRADE)	✓	Emmerstone Maple White (STD)	✓
	DISTANT GREY (STANDARD)		CAT.2 - 3101 Chantilly Lace FIBER BOARD (UPGRADE)		Emmerstone Maple White (STD)	
Kitchen	DISTANT GREY (STANDARD)					
	DISTANT GREY (STANDARD)					
Laundry	DISTANT GREY (STANDARD)					
	DISTANT GREY (STANDARD)					
Mechanical Room	DISTANT GREY (STANDARD)					
	DISTANT GREY (STANDARD)					
Foyer	DISTANT GREY (STANDARD)					

Storage Room	DISTANT GREY (STANDARD)					
Living Room	DISTANT GREY (STANDARD)					
Dining Room	DISTANT GREY (STANDARD)					
2nd Floor Hall	DISTANT GREY (STANDARD)					
Den	DISTANT GREY (STANDARD)					
Master Bedroom	DISTANT GREY (STANDARD)					
Bedroom 2	DISTANT GREY (STANDARD)					

Appliance Opening/Dimension

Fridge Size

STANDARD

Range

STANDARD

Built-Ins

None

Microwave

O.T.R MICRO (STD)

Hood Fan

O.T.R MICRO (STD)

Exhaust Opening

6" 8"

Dishwasher Cabinet

Std 24in Opening

Fireplace

Fireplace

N/A

Location Flooring

N/A

Style

N/A

Finish

N/A

Marble

N/A

Hearth

N/A

Fireplace

Fireplace

N/A

Location Flooring

N/A

Style

N/A

Finish

N/A

Marble

N/A

Hearth

N/A

Notes

\*STANDARD KITCHEN APPLIANCE

<b>Decor Consultant:</b> Denise Sue	<b>Purchaser:</b> NICOLA FACCIUOLO
<b>DocuSigned by:</b> 	<b>Vendor:</b> 



# BUILDING A SUITE 318 BLK 2

## BLANCO



### QUATRUS U 1 SUPER SINGLE

Stainless steel brushed finish

#### Sink Specifications

Colour                      SKU  
brushed finish            401248

#### Design and planning tips


- Min cabinet size: 36 in ( 915 mm )
- Bowl Depth: 9 in ( 230.0 mm )

#### Specifications:

Installation clips, Sink template, Installation instructions, 3 ½" (90 mm) stainless steel strainer

Depending on cabinet construction, a different cabinet size may be required. Consult the cabinet manufacturer.

Codes/Standards: ASME A112.19.3-2017/ CSA B45.4-17

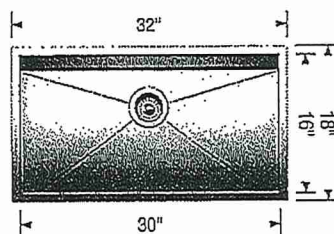

*Install Builders Standard  
Faucet*

#### Warranty

Limited lifetime warranty on all sinks and faucets. One-year warranty on all accessories and soap dispensers.

#### Code/Standards Compliance

BLANCO sinks and faucets are third-party tested and certified to CSA, cUPC, ANSI/ASME, IAPMO and NSF standards and listed by applicable certification bodies. For more information on individual product listings, contact our office or listing organization.



Need support? Learn more by watching our sink & faucet How-to videos:

<https://www.blanco.com/ca-en/support/how-to-videos/how-to-videos-for-sinks/>



BLANCO Canada Inc  
100 Corporation Drive  
Brampton ON L6S 6B5

Tel & Fax:

Tel: 905-494-2400 Toll free: 1-877-425-2626

Fax: 905-494-2425 Toll free: 1-877-825-2626

While BLANCO strives to provide accurate information, all images and dimensions in this document are intended for reference only and are subject to change at any time without notice. This document is not intended for use as an installation guide. For technical installation details, refer to installation instructions provided with the product. BLANCO assumes no responsibility for the use of superseded or voided specifications.



80 Sante Drive, Vaughan, ON L4K 3C4  
T 416.746.1811 F 905.761.5901  
www.QTK.ca info@qtk.ca

CLIENT: ROYAL PINE HOMES	JOB NAME: 2C1 MAGNOLIA <del>20 REDDINE</del>	ROOM: KITCHEN	DRAWN BY: GS
SITE: FORESTSIDE ESTATES	DOOR STYLE: QTS 1022	DOOR HANDLE: __	SCALE: 1/2" = 1'-0"
PHONE: __	FINISH: __	DRW HANDLE: __	DATE: JUNE 12, 2020
EMAIL: __	SPECIES: LAMINATE	TOP: __	PAGE:

COMMENTS:  
**BUILDING A SUITE 318 BLK 2**


Customer Agrees and Accepts the following conditions: 1. The Drawing is a representation only and the installed cabinetry may vary slightly in product size, measurements, handle appearance and location and other details. Although Quality Tops & Kitchens Ltd. (QTK) does it's best to manufacture exactly what is shown here outside factors may prevent that and some variance is to be expected and accepted by the customer. 2. These drawings represent the intellectual property of QTK and as such the customer understands and accepts that all deposits given by the customer to QTK are non-refundable after QTK has supplied drawings (either physically or electronically) to the customer. If the customer decides to cancel the order after QTK has submitted drawings to the customer, the deposit will then be considered a design fee and no money will be returned to the customer.

KITCHEN PLAN 2C1

2C1 : 8 nos.



**\* Reflect Island Location in Brochure \***

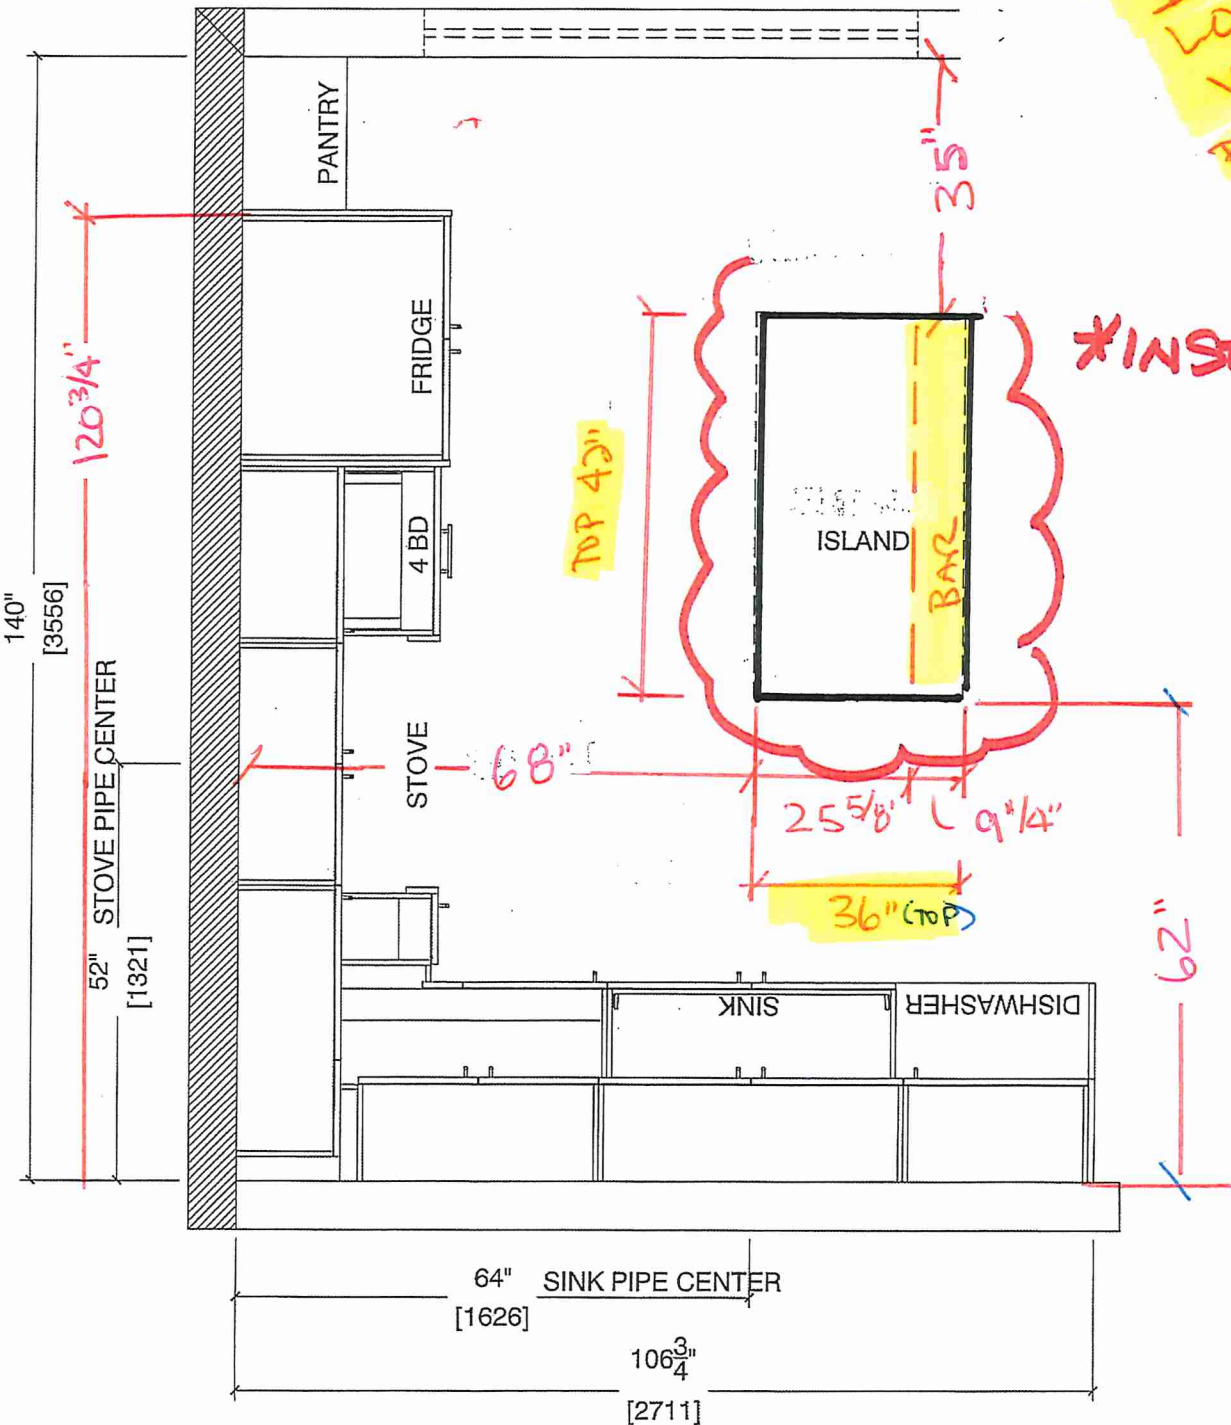



80-Sante Drive, Vaughan, ON L4K 3C4  
T 416.746.1811 F 905.761.5901  
www.QTK.ca info@qtk.ca


CLIENT: ROYAL PINE HOMES	JOB NAME: 2C, 2Ca-UPG2 2C1	ROOM: KITCHEN	DRAWN BY: VGP
SITE: FOREST SIDE	DOOR STYLE: —	DOOR HANDLE: —	SCALE: 1/2" = 1'-0"
PHONE: —	FINISH: —	DRW HANDLE: —	DATE: 05 <sup>th</sup> Oct 2021
EMAIL: —	SPECIES: —	TOP: —	PAGE:

COMMENTS: BUILDING A SUITE 318 BLK 2.


Customer Agrees and Accepts the following conditions: 1. The Drawing is a representation only and the installed cabinetry may vary slightly in product size, measurements, handle appearance and location and other details. Although Quality Tops & Kitchens Ltd. (QTK) does it's best to manufacture exactly what is shown here outside factors may prevent that and some variance is to be expected and accepted by the customer. 2. These drawings represent the intellectual property of QTK and as such the customer understands and accepts that all deposits given by the customer to QTK are non-refundable after QTK has supplied drawings (either physically or electronically) to the customer. If the customer decides to cancel the order after QTK has submitted drawings to the customer, the deposit will then be considered a design fee and no money will be returned to the customer.

OPTION 1


ISLAND FRONT ELEV

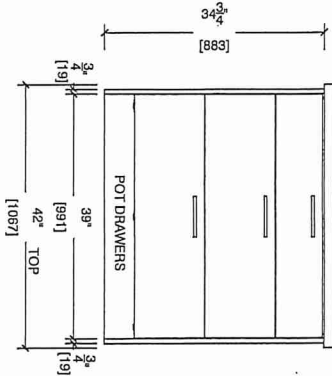


ISLAND BACK ELEV

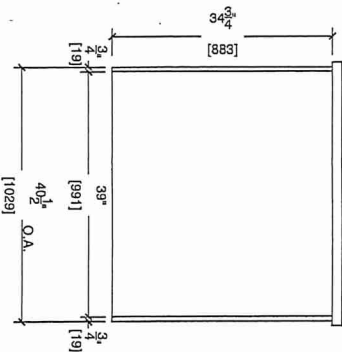

ISLAND LEFT ELEV

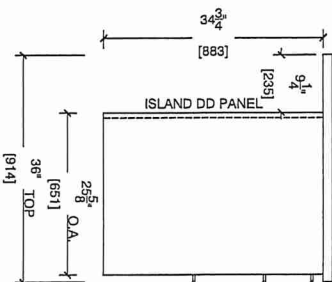

ISLAND RIGHT ELEV

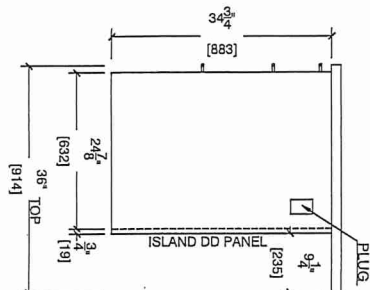







80 Sante Drive, Vaughan, ON L4K 3C4  
T 416.746.1811 F 905.761.5901  
www.QTK.ca info@qtk.ca

CLIENT: ROYAL PINE HOMES	JOB NAME: 2C1	ROOM: KITCHEN + VANITY	DRAWN BY: VGP
SITE: FOREST SIDE	DOOR STYLE: __	DOOR HANDLE: __	SCALE: 1/2" = 1'-0"
PHONE: __	FINISH: __	DRW HANDLE: __	DATE: 05 <sup>th</sup> Oct 2021
EMAIL: __	SPECIES: __	TOP: __	PAGE:

COMMENTS: *Building A Suite 318 Blk 2.*

Customer Agrees and Accepts the following conditions: 1. The Drawing is a representation only and the installed cabinetry may vary slightly in product size, measurements, handle appearance and location and other details. Although Quality Tops & Kitchens Ltd. (QTK) does it's best to manufacture exactly what is shown here outside factors may prevent that and some variance is to be expected and accepted by the customer. 2. These drawings represent the intellectual property of QTK and as such the customer understands and accepts that all deposits given by the customer to QTK are non-refundable after QTK has supplied drawings (either physically or electronically) to the customer. If the customer decides to cancel the order after QTK has submitted drawings to the customer, the deposit will then be considered a design fee and no money will be returned to the customer.

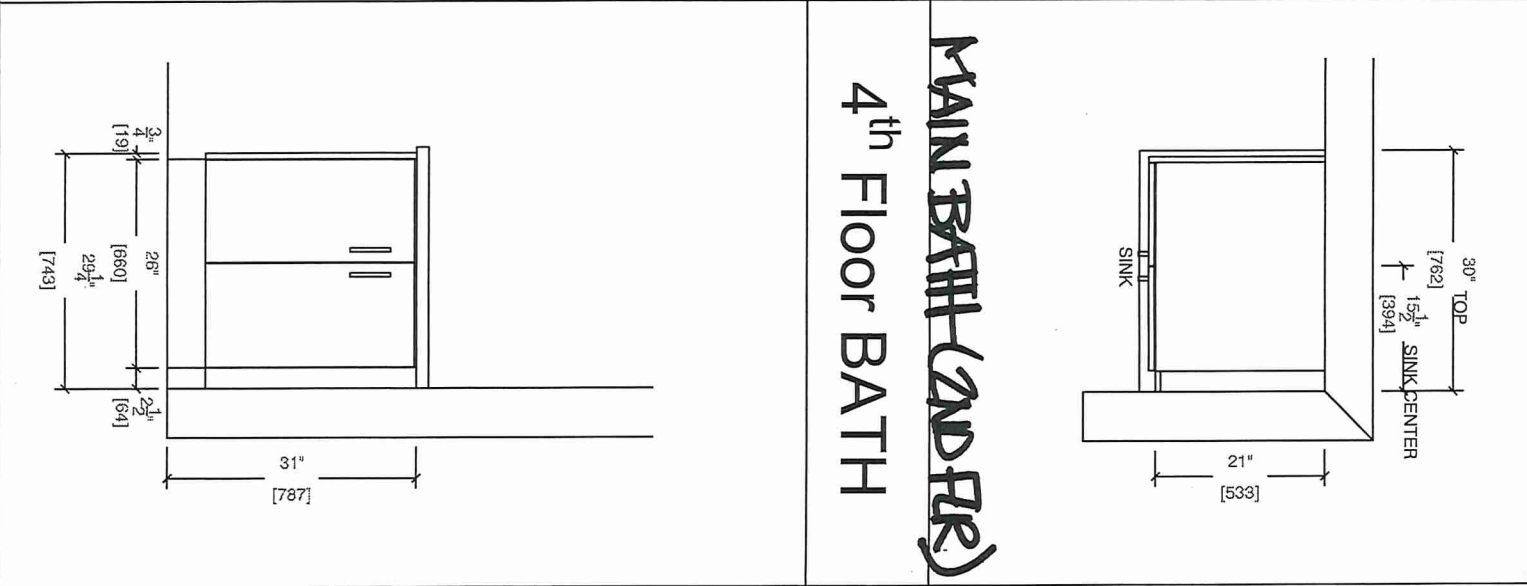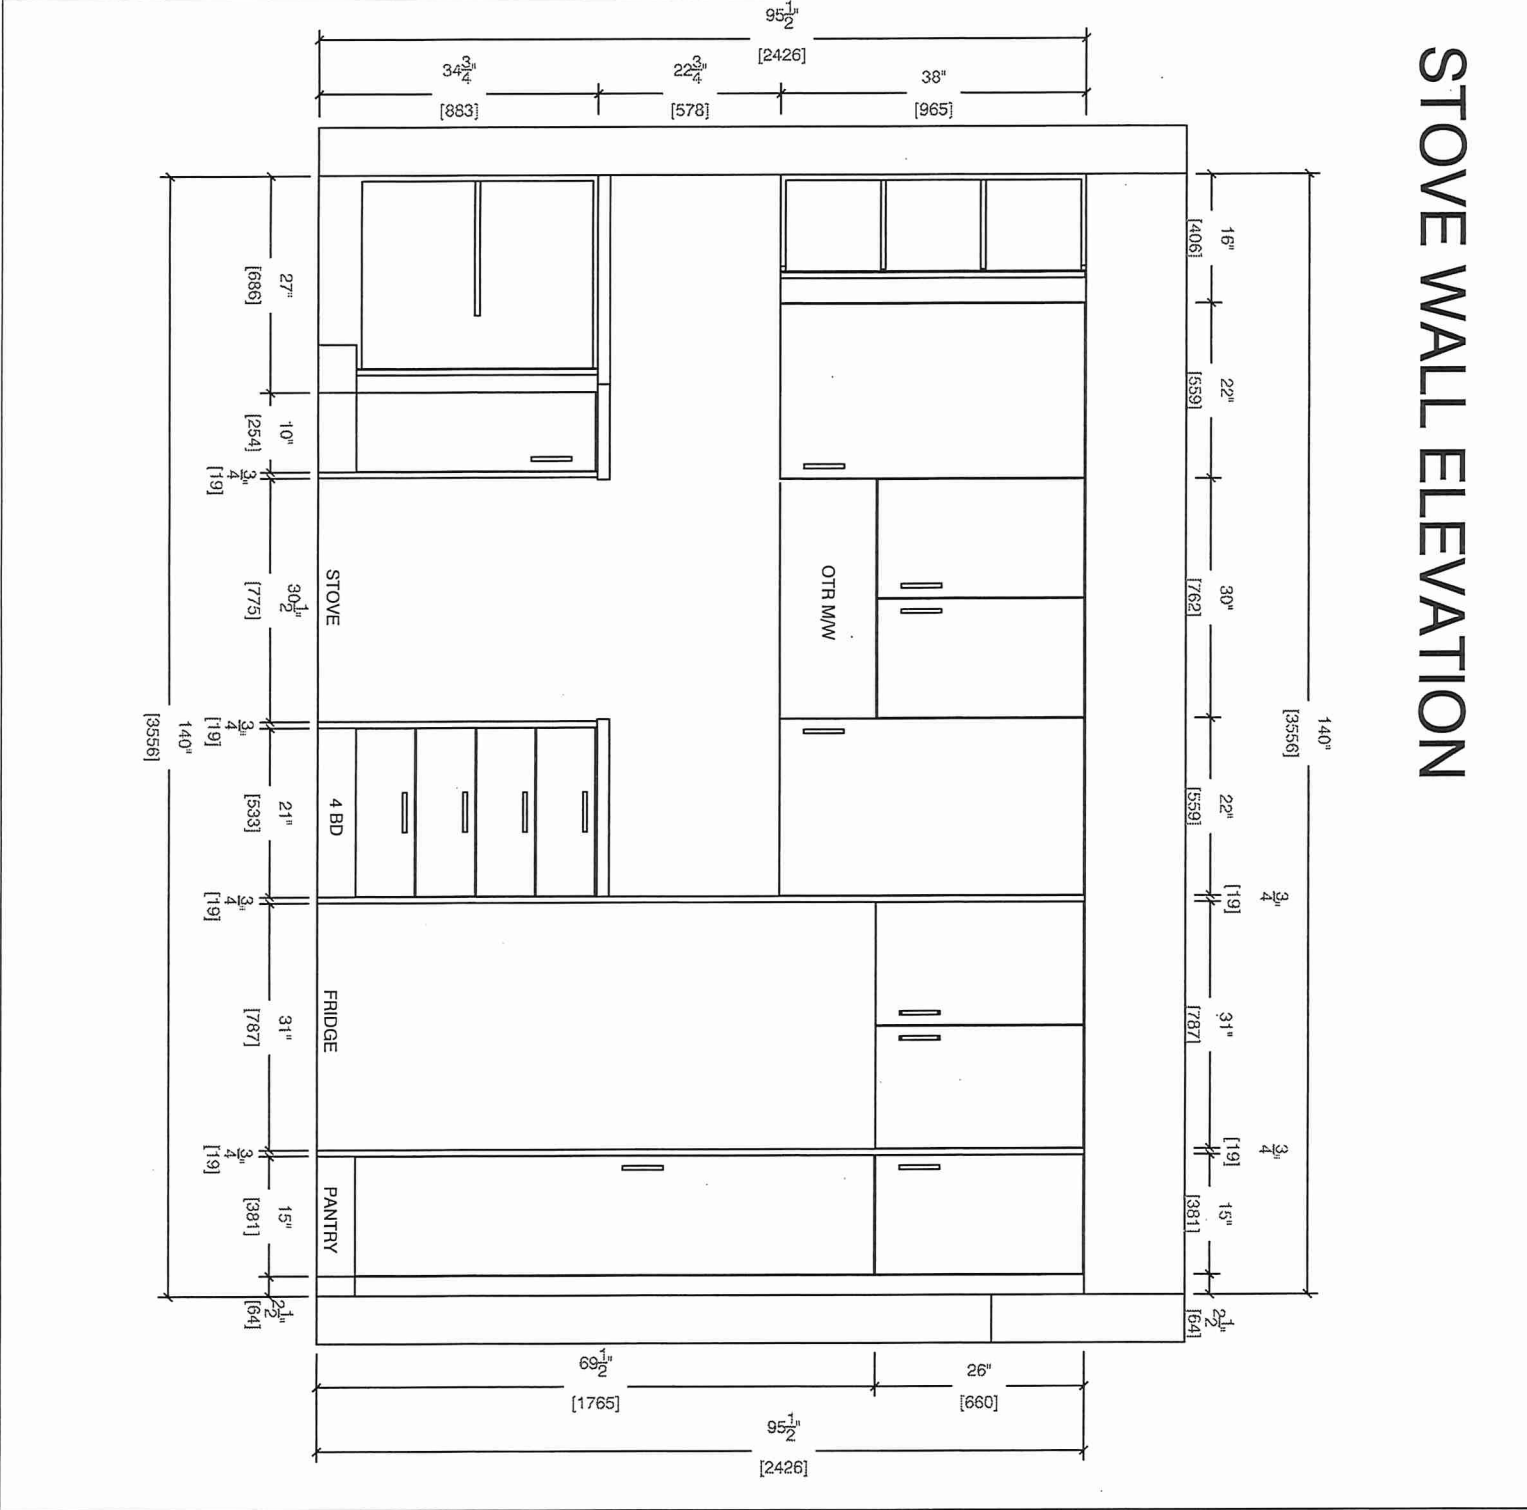




80 Sante Drive, Vaughan, ON L4K 3C4  
T 416.746.1811 F 905.761.5901  
www.QTK.ca info@qtk.ca

CLIENT: ROYAL PINE HOMES	JOB NAME: 2C1	ROOM: KITCHEN + VANITY	DRAWN BY: VGP
SITE: FOREST SIDE	DOOR STYLE: __	DOOR HANDLE: __	SCALE: 1/2" = 1'-0"
PHONE: __	FINISH: __	DRW HANDLE: __	DATE: 05 <sup>th</sup> Oct 2021
EMAIL: __	SPECIES: __	TOP: __	PAGE:


COMMENTS: *Building A Suite 318 BLK 2*

Customer Agrees and Accepts the following conditions: 1. The Drawing is a representation only and the installed cabinetry may vary slightly in product size, measurements, handle appearance and location and other details. Although Quality Tops & Kitchens Ltd. (QTK) does it's best to manufacture exactly what is shown here outside factors may prevent that and some variance is to be expected and accepted by the customer. 2. These drawings represent the intellectual property of QTK and as such the customer understands and accepts that all deposits given by the customer to QTK are non-refundable after QTK has supplied drawings (either physically or electronically) to the customer. If the customer decides to cancel the order after QTK has submitted drawings to the customer, the deposit will then be considered a design fee and no money will be returned to the customer.

SINK WALL ELEVATION

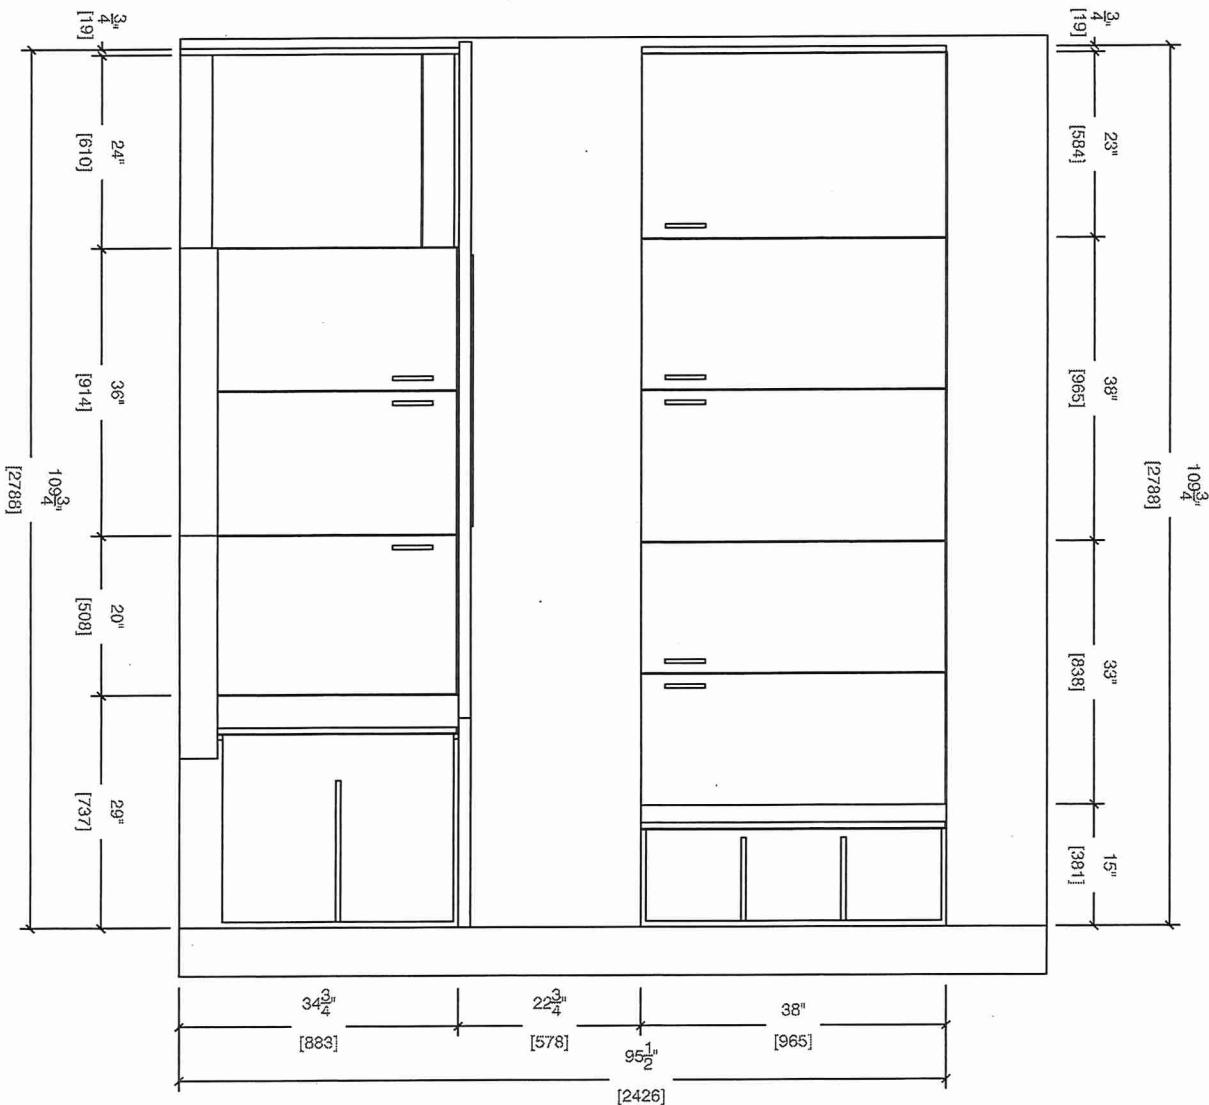

MASTER ENSUITE  
4<sup>th</sup> Floor ENSUITE

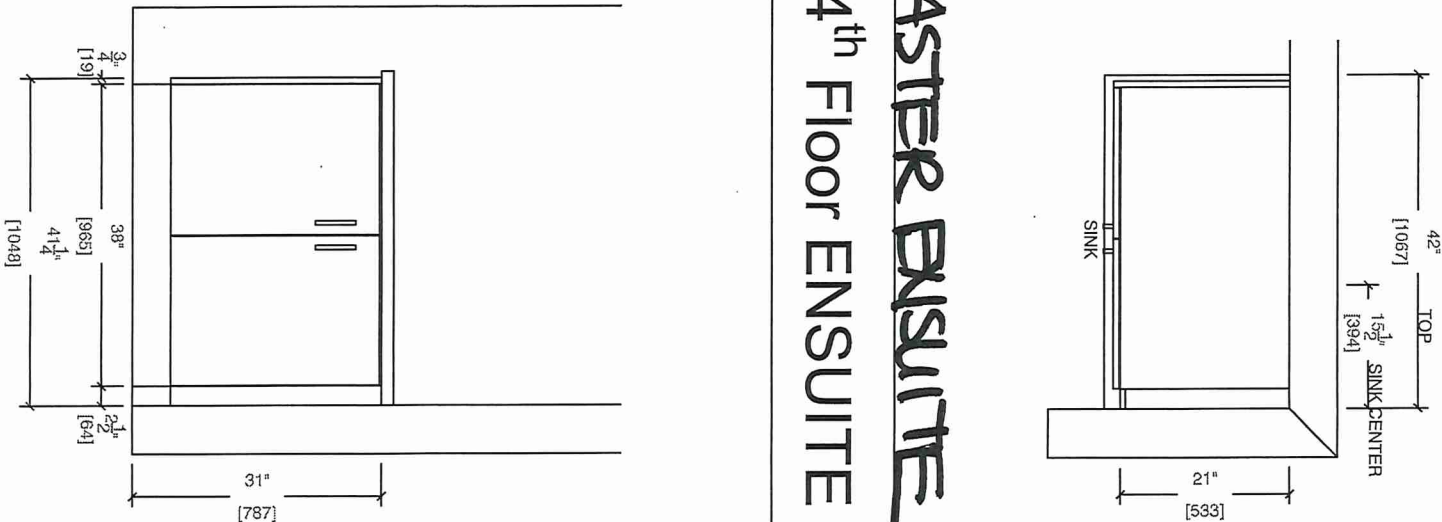






80 Sante Drive, Vaughan, ON L4K 3C4  
T 416.746.1811 F 905.761.5901  
www.QTK.ca info@qtk.ca

CLIENT: ROYAL PINE HOMES	JOB NAME: 2C1	ROOM: KITCHEN	DRAWN BY: VGP
SITE: FOREST SIDE	DOOR STYLE: __	DOOR HANDLE: __	SCALE: 1/2" = 1'-0"
PHONE: __	FINISH: __	DRW HANDLE: __	DATE: 05 <sup>th</sup> Oct 2021
EMAIL: __	SPECIES: __	TOP: __	PAGE:

COMMENTS: *Building A Suite 318 BLK 2.*

Customer Agrees and Accepts the following conditions: 1. The Drawing is a representation only and the installed cabinetry may vary slightly in product size, measurements, handle appearance and location and other details. Although Quality Tops & Kitchens Ltd. (QTK) does it's best to manufacture exactly what is shown here outside factors may prevent that and some variance is to be expected and accepted by the customer. 2. These drawings represent the intellectual property of QTK and as such the customer understands and accepts that all deposits given by the customer to QTK are non-refundable after QTK has supplied drawings (either physically or electronically) to the customer. If the customer decides to cancel the order after QTK has submitted drawings to the customer, the deposit will then be considered a design fee and no money will be returned to the customer.

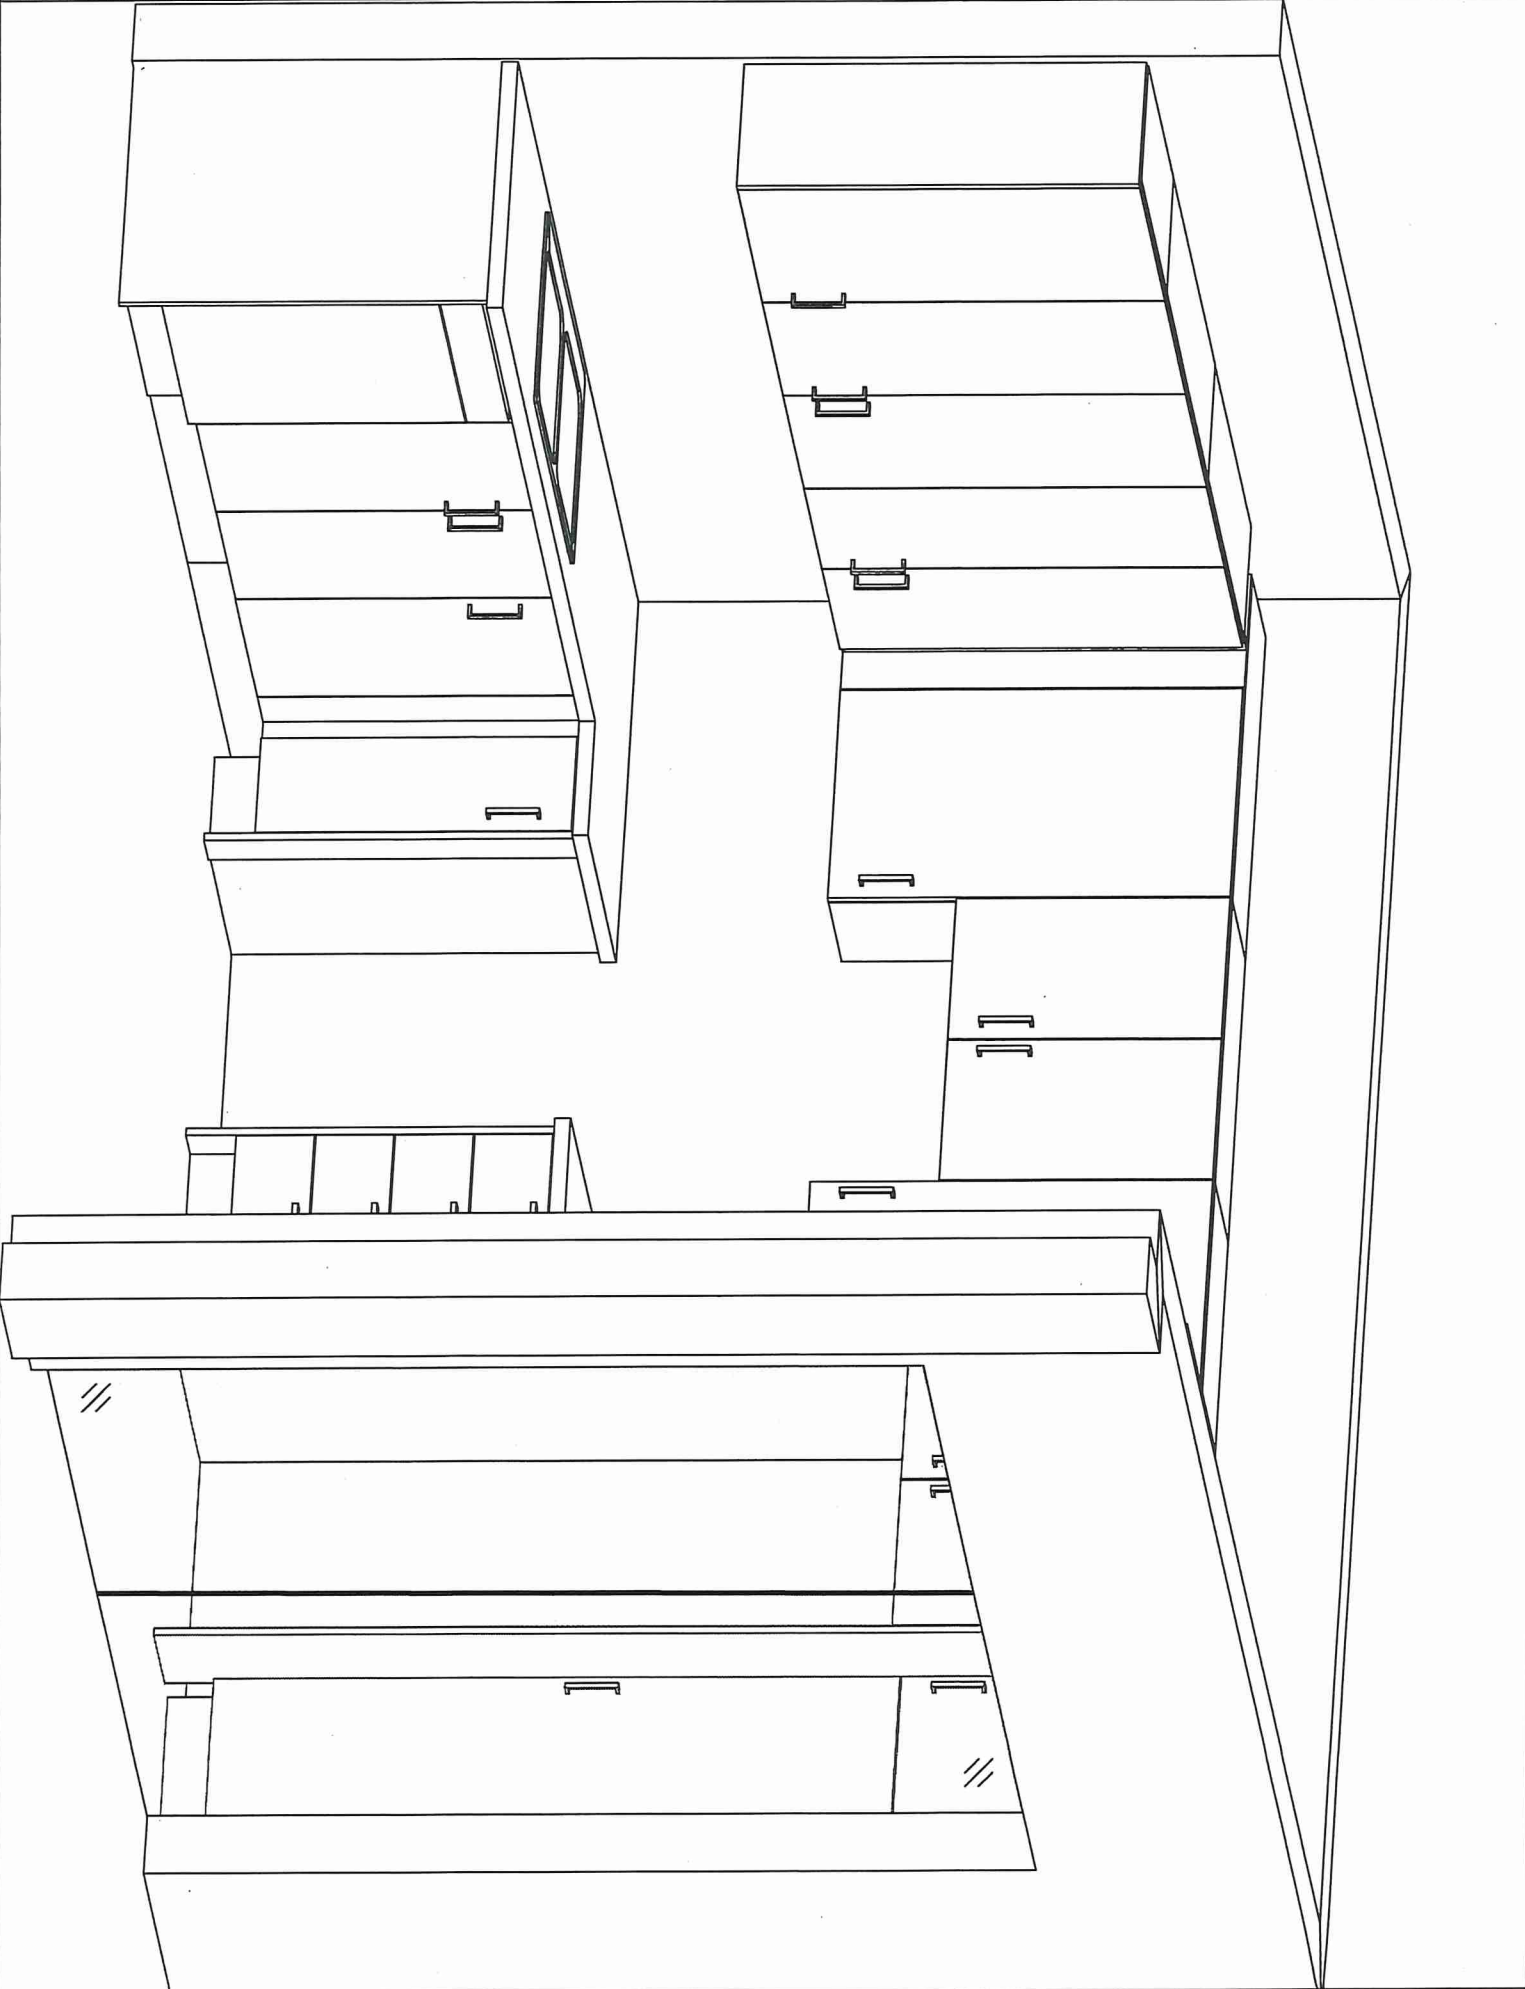



80 Sante Drive, Vaughan, ON L4K 3C4  
T 416.746.1811 F 905.761.5901  
www.QTK.ca info@qtk.ca

CLIENT: ROYAL PINE HOMES	MODEL : <del>2C, 2Ca</del> HOLLY, 2C1 MAGNOLIA 2D RED PINE, 2C1 WINTERGREEN	ROOM: VANITY	DRAWN BY: GS
SITE: FORESTSIDE ESTATES	DOOR STYLE: QTS 1022	DOOR HANDLE: __	SCALE: 1/2" = 1'-0"
PHONE: __	FINISH: __	DRW HANDLE: __	DATE: JUNE 12, 2020
EMAIL: __	SPECIES: LAMINATE	TOP: __	PAGE:

COMMENTS:

BUILDING A SUITE 318 BLK 2

Customer Agrees and Accepts the following conditions: 1. The Drawing is a representation only and the installed cabinetry may vary slightly in product size, measurements, handle appearance and location and other details. Although Quality Tops & Kitchens Ltd. (QTK) does it's best to manufacture exactly what is shown here outside factors may prevent that and some variance is to be expected and accepted by the customer. 2. These drawings represent the intellectual property of QTK and as such the customer understands and accepts that all deposits given by the customer to QTK are non-refundable after QTK has supplied drawings (either physically or electronically) to the customer. If the customer decides to cancel the order after QTK has submitted drawings to the customer, the deposit will then be considered a design fee and no money will be returned to the customer.

POWDER ROOM PLAN (~~2C~~, ~~2Ca~~, 2C1, ~~2D~~, ~~2D2~~)



- 2C

:

24 nos.

2Ca

:

4 nos.

2C1

:

8 nos.

2D


:

24 nos.

2D2

:

6 nos.

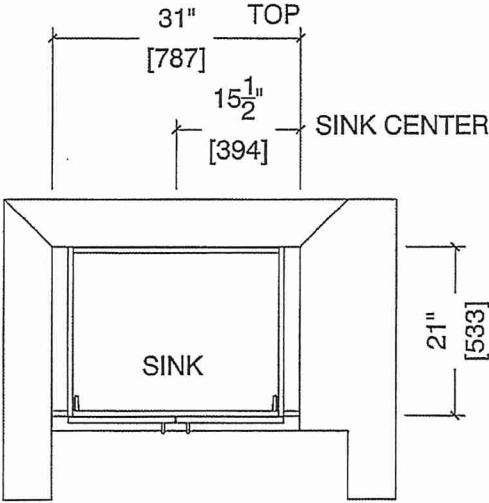

POWDER ROOM ELEVATION (~~2C~~, ~~2Ca~~, 2C1, ~~2D~~, ~~2D2~~)

