

SITE STATISTICS				
ITEM		PROPOSED		
LOT FRONTAGE	11.6 m	38'-1"		
LOT AREA	313.20 sq,m	3371.28 sq, ft.		
MAX. ALLOWABLE COVERAGE (%)		55		
BUILDING COVERAGE CALCULATION	COVERAGE W/O PORCH		151.60 sq,m	
	LOT COVERAGE		48.40 %	
BUILDING HEIGHT CALCULATION	FIN. FLOOR ELEV.	AVG. (EST.) GRADE	FF TO AVG. GRADE	FF TO MEAN OF ROOF
	295.22	294.39	0.83	7.54 m
	PROP. BUILDING HEIGHT	5.37 m	27'-6"	
MAX BUILDING HEIGHT		12m FROM AVG. GRADE TO MEAN		

FRONT YARD LANDSCAPE AREA	
FRONT YARD AREA :	53.20 m2
DRIVEWAY AREA:	31.50 m2
COVERED PORCH AREA:	5.20 m2
SOFT LANDSCAPE AREA :	26.90 m2
LANDSCAPE / OPEN SPACE:	50.56 %


City File D19-20001	
MODEL NO.	3814
HOUSE STYLE (I.E. BUNGALOW, WALKOUT ETC.)	2 STOREY
BUILDING CLASSIFICATION	GROUP C
	-



No unprotected openings permitted within 1.2 metres of the lot line as per 9.10.14 of the Ontario Building Code

**ZONING REVIEWED**

Initials: **BH**

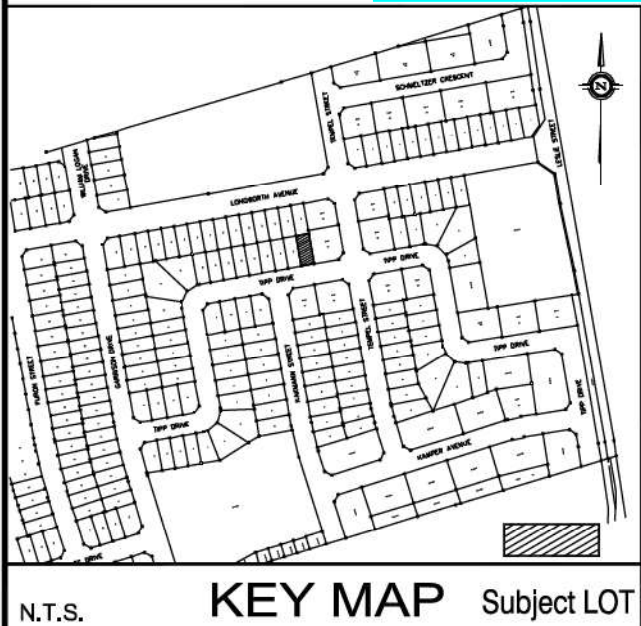

REVIEWED ONLY AS TO GENERAL COMPLIANCE WITH THE INTENT OF THE GRADING AND SERVICING DRAWINGS. THE ENGINEER DOES NOT WARRANT THAT THE INFORMATION CONTAINED ON THIS PLAN IS EITHER ACCURATE OR CORRECT. SOLE RESPONSIBILITY FOR CORRECT DESIGN, DETAILS AND DIMENSIONS WILL REMAIN WITH THE PARTY SUBMITTING THE DRAWING


☒ REVIEWED

☐ REVIEWED AS NOTED

☐ REVISE AND RESUBMIT

**The MUNICIPAL INFRASTRUCTURE Group Ltd.**

Date: **Feb 03, 2023** By: **Abdul Ahmadzai**

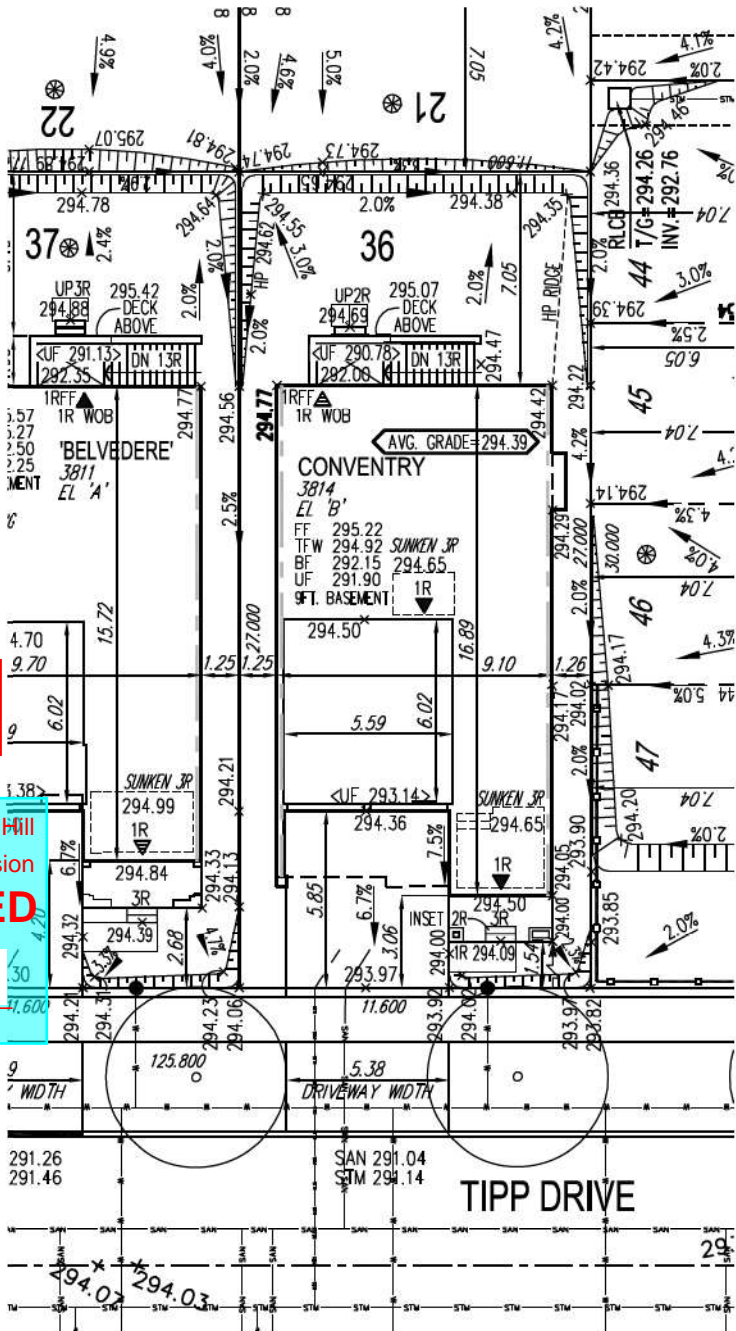

**W Architect Inc.**

**DESIGN CONTROL REVIEW**

**FEBRUARY 07, 2022**

**FINAL RESITE** BY: **GGE**

This stamp is only for the purposes of design control and carries no other professional obligations.

**CITY OF RICHMOND HILL**

**BUILDING DIVISION**

**02/23/2022**

**REVISED**

Per: **KER**

**GENERAL NOTES:**

- BUILDER TO VERIFY LOCATION OF UTILITIES AND OTHER SERVICES. IF MIN. DIMENSIONS ARE NOT MAINTAINED, BUILDER IS TO RELOCATE AT BUILDER'S EXPENSE.
- BUILDER TO VERIFY ELEV. OF STM, AND SAN, LATERALS IN RELATION TO BASEMENT U/S OF FOOTING ELEVATIONS FOR COMPLIANCE WITH MUNICIPAL STANDARDS PRIOR TO EXCAVATION.
- APPROVED PERMIT DRAWINGS & CONSTRUCTION NOTES MUST BE REVIEWED AND FOLLOWED IN CONJUNCTION WITH THE SITING AND GRADING PLAN. BUILDER TO VERIFY BUILDING ENVELOPE ON SITE PLAN MATCHES APPROVED PERMIT DRAWINGS & CONSTRUCTION NOTES PRIOR TO POURING CONCRETE. IF THERE ARE ANY DISCREPANCIES, THEY ARE TO BE BROUGHT TO THE ATTENTION OF HUNT DESIGN ASSOCIATES INC.
- UNLESS NOTED ON BUILDING ENVELOPE OR APPROVED PERMIT DRAWINGS & CONSTRUCTION NOTES, ALL TOP OF FOUNDATION WALLS INCLUDING GARAGE WALLS TO BE CONSISTENT WITH THE ELEVATION PROVIDED FOR TFW ON SITING AND GRADING PLAN. THE EXTERIOR OF THE FOUNDATION WALL TO BE PROVIDED WITH A REDUCTION OF THICKNESS FOR MASONRY VENEER AS REQUIRED.

RE-ISSUED FOR FINAL APPROVAL	MM	2022.02.02
LOT RE-SITED W/ NEW UNIT	MM	2022.01.10
ISSUED FOR FINAL APPROVAL	DS	2021.07.28
ISSUED FOR PRELIMINARY APPROVAL	DS	2021.07.13




**SITING AND GRADING PLAN**

THE UNDERSIGNED HAS REVIEWED AND TAKES RESPONSIBILITY FOR THIS DESIGN AND HAS THE QUALIFICATIONS AND MEETS THE REQUIREMENTS SET OUT IN THE ONTARIO BUILDING CODE TO BE A DESIGNER.

DEREK R. SANTOS 37308

 SIGNATURE

BOIN

**HUNT DESIGN ASSOCIATES INC.**

19695

[www.huntdesign.ca](http://www.huntdesign.ca)

Plan No. **36**

Lot **36**

Street Name **TIPP DRIVE**

Royal Pine Homes / Centerfield Properties Inc - 216102 'OAKRIDGE MEADOWS', RICHMOND HILL, ON

Drawn By	Checked By	Scale	File Number	Lot / Page Number
DS	DS	1:250	216102-SP01.DWG	<b>36</b>

8966 Woodbine Ave, Markham, ON L3R 0J7 T 905.737.5133 F 905.737.7326