



CONSTRUCTION SUMMARY  
2185715 Ontario Inc.

PURCHASERS: KEYUR, RAMANIKLAL PATEL and KASHYAP, A. PATEL TEL:

LOT NUMBER	PHASE	HOUSE TYPE	CLOSING DATE
032	1	ISABELLA-OPT MAIN-4 BEDROOM-ELEVATION A	15-Nov-22


Offer	BONUS PACKAGE - PURCHASER TO RECEIVE \$20,000 (INCLUSIVE OF TAXES) WORTH OF UPGRADES AT THE DECOR CENTER AT TIME OF COLOUR CHART.
Workshee	Note:

Date Added: 04-May-22 Invoice Number: 7870


1 - SECOND FLOOR - BEDROOMS - Install SMOOTH CEILINGS Throughout second floor bedrooms, where applicable. To Include; Primary Bedroom, Bedroom #2, Bedroom #3 and Bedroom #4 (See Sketch) Note:
1 - BONUS PACKAGE - PURCHASER HAS APPLIED \$20,000.00 (Incudes Taxes) WORTH OF UPGRADE PROMOTIONAL PACKAGE TOWARDS THE PURCHASE OF STRUCTURAL UPGRADES COMPLETED AT THE DECOR CENTRE Note: **Remaining Bonus Package of \$13,220.00 (Includes Taxes) will be applied to upgrades completed during decor appointment**
1 - PURCHASER HAS ATTENDED A STRUCTURAL APPOINTMENT AT THE DESIGN STUDIO AND HAS DECLINED ANY ADDITIONAL UPGRADES.Purchaser accepts and acknowledges that there will be no further structural changes/additions/deletions to be made upon signing on APRIL 25,2022 Note:
1 - PURCHASER AWARE AND ACCEPTS THAT ANY CHANGES MADE TO UPGRADES AFTER SIGNING THIS PURCHASERS EXTRA FORM ARE SUBJECT TO A MINIMUM ADMINISTRATION FEE OF \$1,000 Note:

This Document is Extremely Time Sensitive - Printed 4 May 22 at 13:53


\* ALL BSMT WINDOWS  
STD 30" x 16"

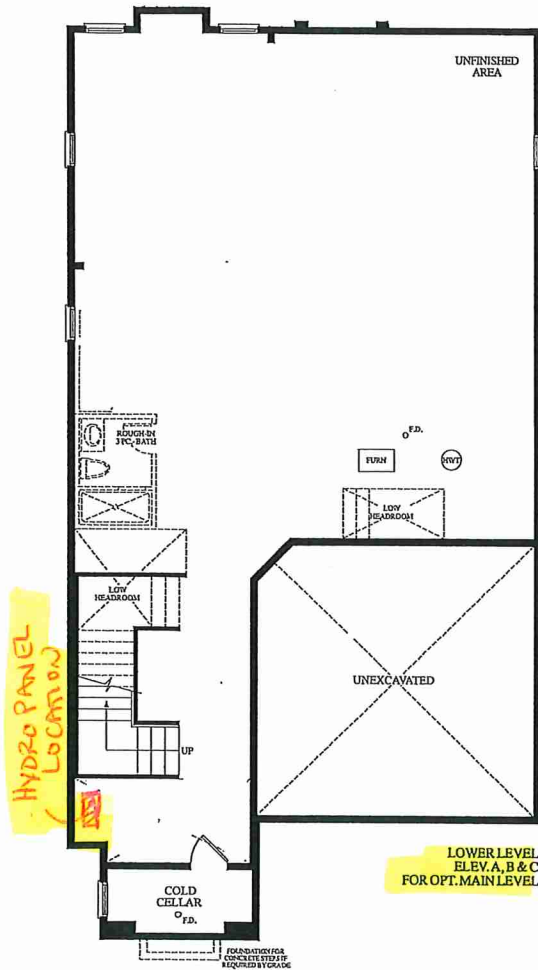

LOWER LEVEL  
ELEV. A, B & C  
FOR OPT. MAIN LEVEL

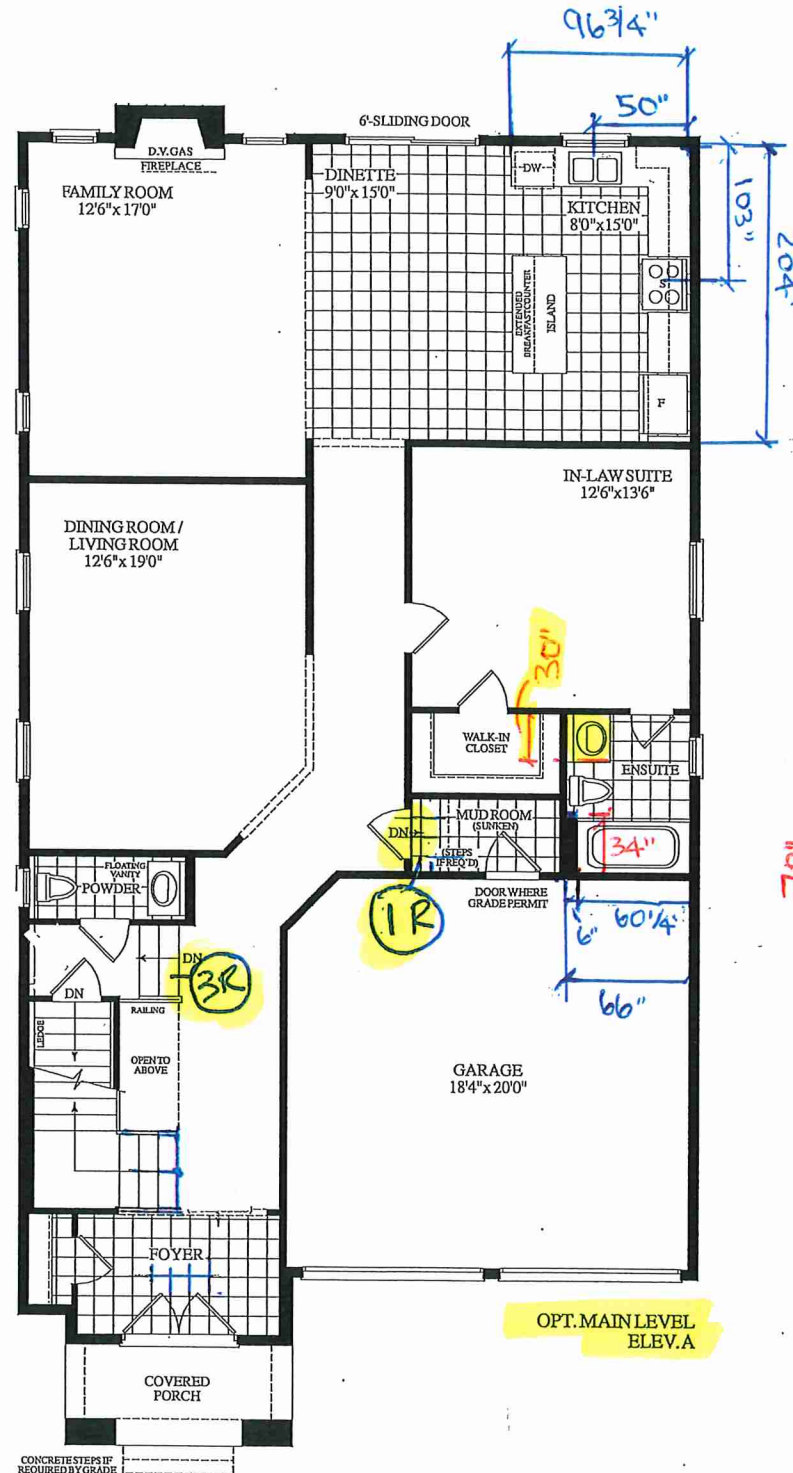

\* Smooth Ceilings Throughout Bedrooms

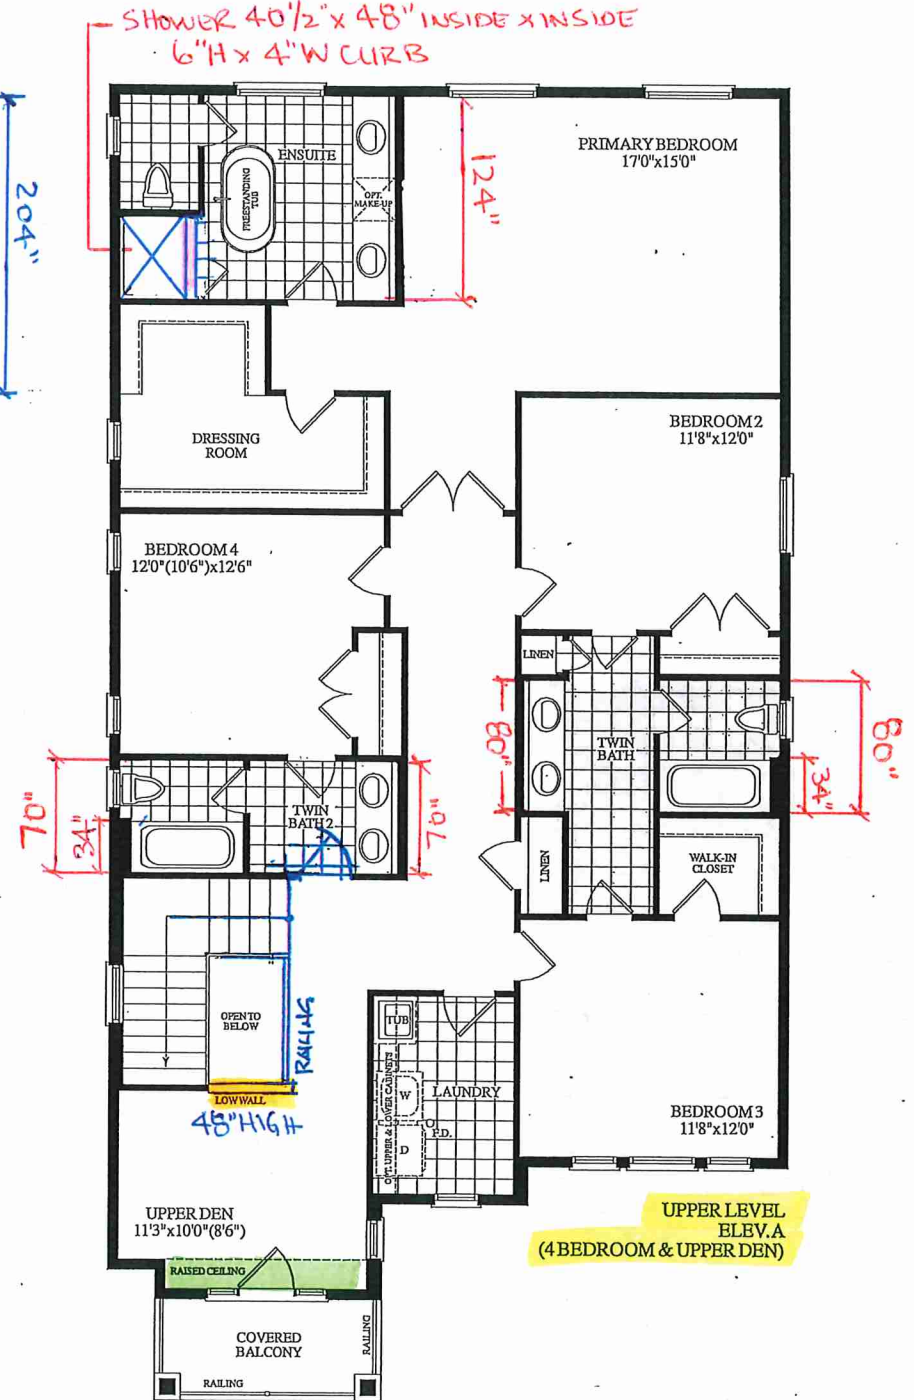

LOT 32 - Isabella - 40-06 - OPTIONAL MAIN 4 BEDROOMS

3460 SQ. FT.  
ELEV. A

