


LOT NUMBER

039

PHASE

1



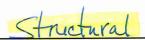

CONSTRUCTION SUMMARY

2185715 Ontario Inc.

HOUSE TYPE

ISABELLA-OPT MAIN-4 BEDROOM-ELEVATION C

PURCHASERS: HITESH M. LIMBACHIYA and JYOTI HITESH LIMBACHIYA

TEL: RES.: 416-837-1311

CLOSING DATE

Offer	BONUS PACKAGE - PURCHASER TO RECEIVE \$20,000 (INCLUSIVE OF TAXES) WORTH OF UPGRADES AT THE DECOR CENTER AT TIME OF COLOUR CHART.
Worksheet	
Offer	OPTIONAL MAIN WITH INLAW SUITE -4 BEDROOMS
Upgrade	Note:
Date Added: 19-May-22 Invoice Number: 7873	
5 - BASEN	MENT- Install FIVE (x5) 30"x24" larger basement windows in lieu of the builders standard. (With possible window wells)
Note:	
1 - BASEN	MENT- Install ONE (X1) Additional 30"x24" basement window (with possible window well) (See Sketch)
Note:	
1 - SIDE F	EXTERIOR- Install the optional side door with applicable coach light (See Sketch)
Note:	
1 - FRON' Sketch) Note:	T EXTERIOR- In addition to the builders standard Coach Light at front door, Install an additional Coach light to be on the same switch (See
1 - BACK switch (Se	EXTERIOR- In addition to the builders standard Coach Light at next to patio sliders, Install an additional Coach light to be on the same e Sketch)

1 - UPPER DEN- Delete the low wall at the Upper Den, and Install a full wall. Install a builders standard interior door. Accommodate with return wall for interior door (See Sketch)

Note:

Note:

1 - IN LAW SUITE- Delete the builders standard interior door, and Install Extended Height Double French doors with regular glass 1 Lite (full glass) (Inleudes additional applicable trim and paint as required) French doors to be centred(See Sketch)

Note:

1 - PURCHASER HAS ATTENDED A STRUCTURAL APPOINTMENT AT THE DESIGN STUDIO AND HAS DECLINED ANY ADDITIONAL UPGRADES


Note:

1 - BONUS PACKAGE-PURCHASER TO RECEIVE \$20,000 (INCLUSIVE OF TAXES) WORTH OF UPGRADES AT THE DESIGN STUDIO AT TIME OF COLOUR CHART

Note:

1 - PURCHASER AWARE AND ACCEPTS THAT ANY CHANGES MADE TO UPGRADES AFTER SIGNING THIS PURCHASERS EXTRA FORM ARE SUBJECT TO A MINIMUM ADMINISTRATION FEE OF \$1,000 Note:

This Document is Extremely Time Sensitive - Printed 19 May 22 at 11:14

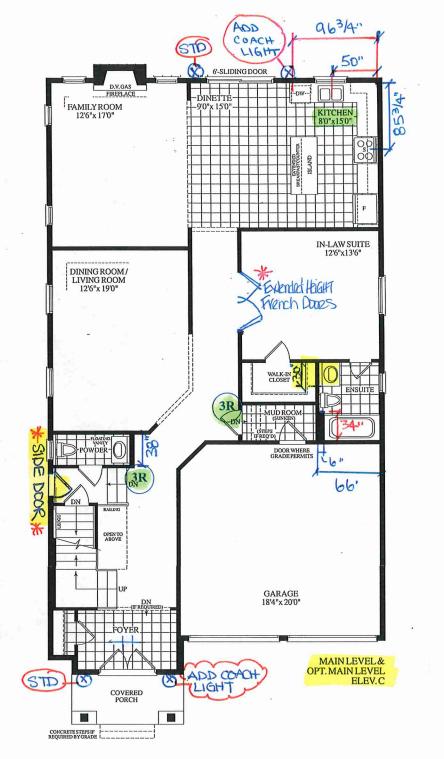

30X2L

36X24

30X24

1 HORO
PAHEL

COLD

O_{F.D.}

UNFINISHED AREA

30 x24

ADD 30X24\

(TVT)

LOWER LEVEL ELEV.A,B&C FOR OPT. MAIN LEVEL

UNEXCAVATED

