



Docusign Envelope ID: 3E	:FABZ3A-4231-4313-B313-B13UF018E1A9		* INTE	ERIOR COLO	OUR SCHEME *				
	Purchaser	Decor Consultant	Model and El		Telephone Res. / Bus	Projec	:t	Closing Date	Property
	TONYA L LUBY	Mellssa Di Marino	Holly 2C	:	(416) 889-9123 /	Forestside Esta	1	13/04/2023	320 BLOCK 2
Page 1 of 3	Flooring Description		all Tile————			1			Plumbing—
Master Ensuite	13x13 London Bron	Maii 8x10	<u>n</u> O Cararra Malle (STD)	Acce N/A	nt/Insert	Border / Listell	<u>'0</u>	<u>Pattern</u>	
Main Bathroom	13x13 London Bro		Cararra Malle (STD)	N/A		, N/A		NONE	WHITE
			odiana malie (OTD)	N/A		N/A		NONE	WHITE
Powder Room	13x13 London Bra	N/A	CDS 1	N/A					
Mech.Room	13x13 London Bro	N/A	US	IV/A	POCTION	N/A	13 13	NONE	WHITE
, Laundry Room	13x13 London Bran				- KCIOI			NONE	N/A
		INA.		N/A		N/A		NONE	STD
Kitchen	8" Highland Watson Natural Oak EE	-H-292 (STD)	Black Glossy (STD)						
	- I I I I I I I I I I I I I I I I I I I	3/01	DIACK GIOSSY (STD)	N/A					
Foyer	13x13 London Bron		ailings and Stairs——						
	DICI.	Rai	ilings Mod Rectangle R.	O Drift Wood (UPG)	Landing - Upper	lighland Watson Natural Oak		Moulding / Medalion	
Storage	8" Highland Watson Natural Oak EE-	Pio	kets / NA	**	Landing - Lower		Foyer Living Ro	N/A N/A	
	5 Taginana Traison (Valural Oak EL-	Pos	sts 3 1/2" SQ TRP-13 I	No Cap		N/A	Dining Ro	L	
Living Room	8" Highland Watson Natural Oak EE-	Stri	ingers STANDARD-PAIN	NTED WHITE	Ledge - Lower	N/A	Family Ro		
Dining Room	8" Highland Watson Natural Oak EE-	ITE	ads Mirage Red Oak D				Main Hall	N/A	
	7 9 Frigitiand Watsolf Watural Oak EE-		ers STANDARD - PAIN	NTED WHITE			Kitchen	N/A	
							2nd Floor	Hall N/A	
Upper Hall	8* Highland Watson Natural Oak EE-	I Pan	seboard & Casing STA	NDARD	Knobs UPC	GRADE - Morgan Modern Lever			
	5 Thighland Walson Natural Oak EE-		nt Door Glass			NDARD			
Master Bedroom	8" Highland Walson Natural Oak EE-			NDARD	Grip Set STA	NDARD		L	
Bedroom 2	1		tes					77.1	
	8" Highland Walson Natural Oak EE-I	H-292 (UPG)	э.·					-	
									4
		Page	1 of 3	00					
			ODN (n////	DocuSigned by:	,	·		
	i	Cons	ultant:	/	Lley				
Lot: 320 BLOCK 2 F	Project: Forestside Estates Inc. Mode		Mellssa Di Marino	Furci	naser:F92B8C47DADC40D TONYA L LUBY		'	Vendor: Foresiside Estates	lan.
		ar nony 20			TO MODEL DE PARTICIPATION OF THE PARTICIPATION OF T			Printed Ja	an 27, 2022 3:44 pm

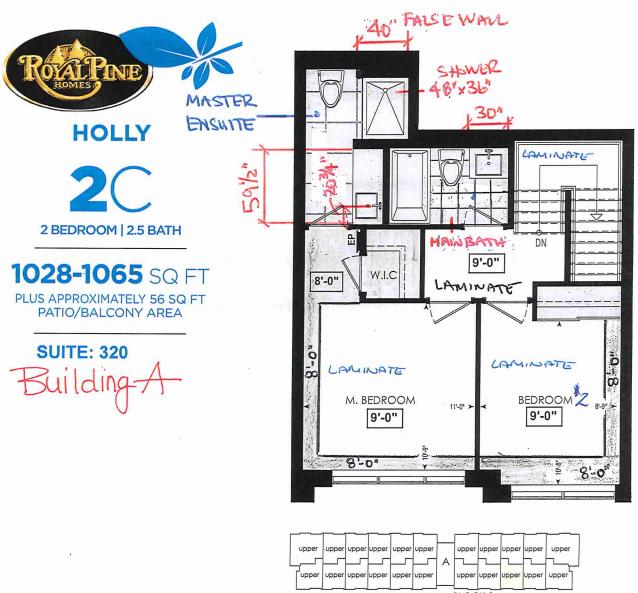

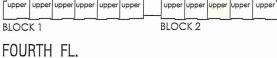

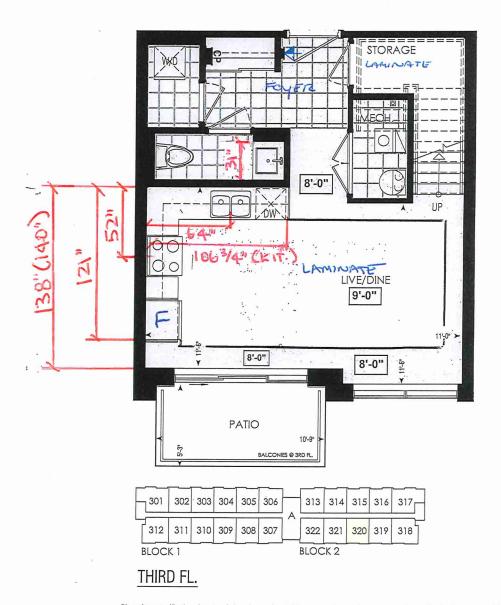

LOCATION OF KITCHEN LIGHTS REFER TO KITCHEN DWG.

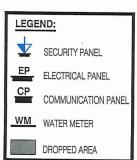

RECEIVED

Dimensions, specifications, layouts, window sizes, and materials are approximate only, may vary, and are subject to change as provided in the Agreement of Purchase & Sale, Plans may be reversed. Illustrations are artist's concept, E.&O.E.



SITE COPY

CONSTRUCTION SUMMARY

Forestside Estates Inc.

PURCHASER: TONYA L LUBY

TEL: RES.: 416-889-9123

LOT NUMBER PHASE HOUSE TYPE CLOSING DATE 320 BLOCK 2 6-III Holly 2C 13-Apr-23

Date Added: 11-Feb-22

Invoice Number: 7708

1 - APPLIANCE PACKAGE- Install the Standard Appliance Package To be supplied ONLY for the home, where applicable.

Note:

- 1 KITCHEN & BATHROOMS Purchaser has DECLINED All Upgrades offered during decor appointment at the decor centre for kitchen & bathroom cabinetry. Standard Kitchen Layout & Standard Bathroom Vanities to be installed as per standard plan. (See Sketch) Note:
- 1 KITCHEN- PLUMBING -Kitchen Faucet STANDARD- DELTA Chrome Osler Pull Down Kitchen Faucet (Single Hole) Model # 976 LF
- 1 KITCHEN- PLUMBING Install the UPGRADED UNDEROUNT SINK in the kitchen- Install the BLANCO QUATRUS R15 U2 Model # 401519 in lieu of the builder's standard kitchen sink. To include cut and polish (see sketch)

 Note:
- 1 KITCHEN / MAIN BATH/ MASTER ENSUITE Stone slabs vary in size & all seams are visible & the fabricator reserves the right to position the seams as necessary.

Note:

1 - STAIRCASE - RAILING - Install UPGRADE RAILING PACKAGE #4 from main to second floor throughout where applicable in lieu of the builder's standard.

Install:

Handrail: Mod Rectangle

Pickets: Steel 1/2" Square, Plain/PTM-1S/Plain, with Modern Shoes

Note: Posts: 3 1/2" Square IRP-13 No Cap

1 - STAIRCASE - STAIN - STAIN STAIRCASE COMPLETE throughout where applicable from main to second floor. To be stained Red Oak Mirage Drift Wood. To include handrail, treads, and posts.

Note: Stringers and risers to remain painted white

1 - STAIRCASE VS FLOORING

WOOD SPECIES DIFFERENCE:

STAIRCASE - The purchaser was advised and therefore accepts and acknowledges that the wood species of the staircase and flooring chosen do not match. This difference may result in a stain colour variance.

Note: The purchaser agrees that the vendor is to be exempt from any and all claims by the purchaser regarding this colour variance.

1 - STAIRCASE VS FLOORING

STAINING DIFFERENCE:

STAIRCASE - The purchaser was advised and therefore accepts and acknowledges that the stain of the staircase and flooring chosen do not match. This difference might result in an undesirable colour variance.

Note: The purchaser agrees that the vendor is to be exempt from any and all claims by the purchaser regarding this colour variance.

- 1 MASTER ENSUITE / MAIN BATH / POWDER ROOM- Install the Standard 3" Splash throughout all bathroom vanity counter tops, where applicable. To include the Powder Room, Main Bath and the Master Ensuite Note:
- 1 MASTER ENSUITE / MAIN BATH / POWDER ROOM- PLUMBING Install the builders standard Plumbing Fixtures throughout all bathrooms, where applicable. To Include the Powder

Room, Master Ensuite & Main Bath

Note

1 - MAIN BATH- Purchaser accepts & acknowledges that the floor tiles on the Main Bath will be installed stacked NOT brick pattern.

Note:

1 - MASTER BEDROOM - FLOORING - Install LAMINATE throughout the master bedroom where applicable in lieu of the builder's standard broadloom. Install 8" Highland Watson Natural Oak EE-H-292 (see sketch)
Note:



SITE COPY

CONSTRUCTION SUMMARY

Forestside Estates Inc.

PURCHASER: TONYA L LUBY

TEL: RES.: 416-889-9123

LOT NUMBER	PHASE	HOUSE TYPE	CLOSING DATE	
320 BLOCK 2	6-III	Holly 2C	13-Apr-23	

Date Added: 11-Feb-22

Invoice Number: 7708

1 - BEDROOM #2 - FLOORING - Install LAMINATE throughout bedroom #2 where applicable in lieu of the builder's standard broadloom. Install 8" Highland Watson Natural Oak EE-H-292 (see sketch)

Note:

1 - INTERIOR - HARDWARE - Install UPGRADED INTERIOR DOOR HANDLES throughout where applicable in lieu of the builder's standard. To install 1ST UPGRADE MODERN LEVER (See sketch)

Note: Install MORGAN Modern Lever in Satin Nickel

1 - Purchaser has recieved a futhre discount of \$497 (before taxes).

Discount has been applied to the decor upgrades completed at the decor center - Approved as per Steve C.

Note:

1 - PURCHASER AWARE AND ACCEPTS THAT ANY CHANGES MADE TO UPGRADES AFTER SIGNING THIS PURCHASERS EXTRA FORM ARE SUBJECT TO A MINIMUM ADMINISTRATION FEE OF \$1000 PLUS A 10% HOLDBACK FEE.

Note:

1 - PURCHASER HAS ATTENDED A STRUCTURAL AND COLOR APPOINTMENT AT THE DECOR CENTRE AND HAS DECLINED ANY ADDITIONAL UPGRADES.

Note:

Date Added: 25-Oct-21

Invoice Number: 7536

1 - PURCHASER HAS DECLINED ANY STRUCTURAL CHANGES THAT WERE OFFERED THROUGH EMAIL WITH THE DECOR CENTRE. Purchaser accepts & acknowledges that there will be no further structural changes/additions/deletions to be made OCTOBER 12,2021 Note:

1 - PURCHASER AWARE AND ACCEPTS THAT ANY CHANGES MADE TO UPGRADES AFTER SIGNING THIS PURCHASERS EXTRA FORM ARE SUBJECT TO A MINIMUM ADMINISTRATION FEE OF \$1,000 PLUS A 10% HOLDBACK FEE.

Note:

This Document is Extremely Time Sensitive - Printed 25 Feb 22 at 16:24

Carlo -			* INTERIOR (COLOUR SCHEME *		BUILDING	A
	Purchaser	Decor Consultant	Model and Elevation	Telephone Res. / Bus	Project	Closing Date	Property
	TONYA L LUBY	Melissa Di Marino	Holly 2C	(416) 889-9123 /	Forestside Estates Inc.	13/04/2023	320 BLOCK 2
Page 2 of 3	Interior Paint	Cabinet—			-	, , , , , , , , , , , , , , , , , , , ,	
Master Ensuite	Description Distant Grey (Standard)	Style CAT 1 OT ED.	OSTING (SM) LP LAMINATE (STANDAF	201	Countertop	Counter Edge	Handle / Knob
Main Bathroom					Silver Shadow QS7907 (STD)	['A" (STANDARD)	White
wain Bainroom	Distant Grey (Standard)	CAT.1 QT FR	OSTING (SM) LP LAMINATE (STANDAR	RD)	Silver Shadow QS7907 (STD)	"A" (STANDARD)	White
Powder Room	Distant Grey (Standard)	CAT.1 QT FR	OSTING (SM) LP LAMINATE (STANDAF	RD)	Silver Shadow QS7907 (STD)	("A" (STANDARD)	White
Mech.Room	Distant Grey (Standard)	N/A			N/A	N/A	N/A
Laundry Room	Distant Grey (Standard)	N/A			N/A	; N/A	N/A
Kitchen	Distant Grey (Standard)	CAT.1 QT FR	OSTING (SM) LP LAMINATE (STANDAI	RD)	Snow WhiteOSi7947 (STD)	"A" (STANDARD)	STD
					3 (010)		
Foyer	Distant Grey (Standard)				1		
Main Hall				7 - 1 - 1 - 1 - 1 - 1 - 1 - 1 - 1 - 1 -		1	
	Distant Grey (Standard)		Opening/Dimension-		Notes *STANDARD APPLIAN	CE PACKAGE	
Storage	Distant Grey (Standard)	Fridge Size	STANDARD Re	ange STANDARD		-4.7,4(4,6)	
		Built-Ins		crowave O.T.R.MICRO - STANDARD			
Living Room	Distant Grey (Standard)	J		thaust Opening 🌑 6" 🔘 8'			
Dining Room	Distant Grey (Standard)	Dishwashe	r Cabinet Std 24in Opening				
Upper Hall	Distant Grey (Standard)	Fireplace Fireplace) 1/A				
Master Bedroom	Distant Grey (Standard)	: 1 · · ·	N/A Flooring N/A	Fireplace N/A Location Flooring N/A			
Bedroom 2	Distant Grey (Standard)	Style	N/A	Style N/A			· · · · · · · · · · · · · · · · · · ·
	Ostant Orey (Clandard)	Finish	N/A	Finish N/A			
	, <u></u>	Marble Hearth	N/A N/A	Marble N/A			
		[IVIA	Hearth N/A			
		Page 2 of 3		——DocuSigned by:			
				- Duky		· · · · · · · · · · · · · · · · · · ·	
		Decor Cons	ultant:	Purchaser:		Vendor	
Lot: 320 BLOCK 2	Project: Forestside Estates Inc. N	lodel: Holly 2C	אוכווספם דו ואומווות	TONYA I HIRY		Forestside Esta Printed	les inc Jan 27, 2022-3:44 nm

SUITE 320

Sink Specifications

Colour

SKU

·brushed finish

401519

Design and planning tips

- Min cabinet size: 36 in (915 mm)
- Bow! Depth: 9 in (230.0 mm)

Specifications:

Sink template, Mounting clips, Installation instructions, 3 1/2" (90 mm) stainless steel

strainers


Depending on cabinet construction, a different cabinet size may be required. Consult the cabinet INStall Standard Talles

Codes/Standards: ASME A112,19.3-2017/ CSA

B45.4-17

QUATRUS R15 U 2

Stainless steel brushed finish

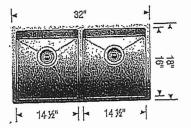

Warranty

Limited lifetime warranty on all sinks and faucets. One-year warranty on all accessories and soap dispensers.

Code/Standards Compliance

BLANCO sinks and faucets are third-party tested and certified to CSA, cUPC, ANSI/ASME, IAPMO and NSF standards and listed by applicable certification bodies. For more information on individual product listings, contact our office or listing organization.

Need support? Learn more by watching our sink & faucet How-to videos: https://www.blanco.com/ca-en/support/how-to-videos/how-to-videos-for-sinks/



BLANCO Canada Inc 100 Corporation Drive Brampton ON L65 6B5 Tel & Fax

Tel: 905-494-2400 Toll free: 1-877-425-2626 Fax: 905-494-2425 Toll free: 1-877-825-2626

While BLANCO strives to provide accurate information, all images and dimensions in this document are intended for reference only and are subject to change at any time without notice. This document is not intended for use as an installation guide. For technical installation details, refer to installation instructions provided with the product, BLANCO assumes no responsibility for the use of superseded or voided specifications.

casigii Liivelope ID. UĻI DOU 80 Sante Drive, Vaughan, ON L4K 3C4 T 416.746.1811 F 905.761.5901 info@qtk.ca www.QTK.ca your kitchen, your taste. CLIENT: ROYAL PINE HOMES JOB NAME: 2C, 2Ca HOLLY, 2D-REDPINE ROOM: KITCHEN DRAWN BY: GS FORESTSIDE ESTATES DOOR STYLE: QTS 1022 DOOR HANDLE: __ SCALE: 1/2" = 1'-0" DRW HANDLE: __ PHONE: __ DATE: JUNE 12, 2020 LAMINATE EMAIL: SPECIES: COMMENTS: Customer Agrees and Accepts the following conditions: 1. The Drawing is a representation only and the installed cabinetry may vary slightly in product size, measurements, nandle appearance and location and other details. Although Quality Tops & Kitchens Ltd. (QTK) does it's best to manufacture exactly what is shown here outside factors may prevent that and some variance is to be expected and accepted by the customer. 2. These drawings represent the intellectual property of QTK and as such the customer understands and accepts that all deposits given by the customer to QTK are non-refundable after QTK has supplied drawings (either physically or electronically) to the customer. If the customer decides to cancel the order after QTK has submitted drawings to the customer, the deposit will then be considered a design fee and no money will be KITCHEN PLAN 2C, 20a, 2D Note: Model-type 2D cannot have an optional pantry due to window configuration : 24 nos. 2C 2Ca : 4 nos. 2D : 24-nos. 4 BD 140" STOVE PIPE 52" 1321 DISHWASHER 64" SINK PIPE CENTER [1626]

Note: Model-type 2D cannot have an optional pantry due to window configuration




80 Sante Dríve, Vaughan, ON L4K 3C4 T 416.746.1811 F 905.761.5901 www.QTK.ca info@qtk.ca

CLIENT: ROYAL PINE HOMES	JOB NAME: 2C, 2Ca HOLLY, 2C1-MAGNOLIA, 2D REDPINE	ROOM: KITCHEN	DRAWN BY: GS
SITE: FORESTSIDE ESTATES	DOOR STYLE: QTS 1022	DOOR HANDLE:	SCALE: 1/2" = 1'-0"
PHONE:	FINISH:	DRW HANDLE:	DATE: JUNE 5, 2020
EMAIL:	SPECIES: LAMINATE	TOP:	PAGE:

COMMENTS:

BUILDING A SUITE 320 BLK Z

Customer Agrees and Accepts the following conditions: 1. The Drawing is a representation only and the installed cabinetry may vary slightly in product size, measurements, handle appearance and location and other details. Although Quality Tops & Kitchens Ltd. (QTK) does it's best to manufacture exactly what is shown here outside factors may prevent that and some variance is to be expected and accepted by the customer. 2. These drawings represent the intellectual property of QTK and as such the customer understands and accepts that all deposits given by the customer to QTK are non-refundable after QTK has supplied drawings (either physically or electronically) to the customer. If the customer decides to cancel the order after QTK has submitted drawings to the customer, the deposit will then be considered a design fee and no money will be returned to the customer.

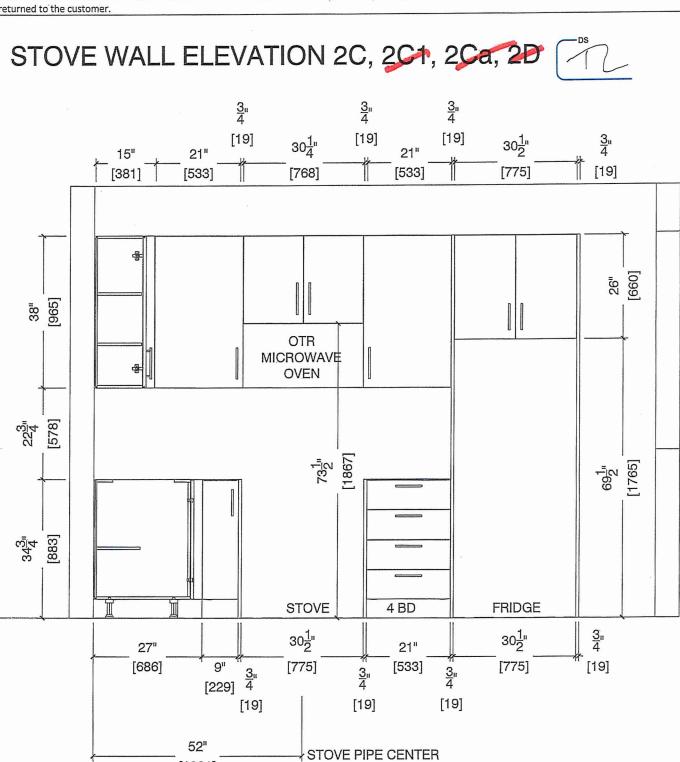

[1321]



80 Sante Drive, Vaughan, ON L4K 3C4 F 905.761.5901 T 416.746.1811 www.QTK.ca info@qtk.ca


\			
CLIENT: ROYAL PINE HOMES	JOB NAME: 2C, 2Ca HOLLY, 2C1 MAGNOLIA, 2D REDPINE	ROOM: KITCHEN	DRAWN BY: GS
SITE: FORESTSIDE ESTATES	DOOR STYLE: QTS 1022	DOOR HANDLE:	SCALE: 1/2" = 1'-0"
PHONE: _	FINISH:	DRW HANDLE:	DATE: JUNE 5, 2020
EMAIL:	SPECIES: LAMINATE	TOP:	PAGE:

COMMENTS:

Customer Agrees and Accepts the following conditions: 1. The Drawing is a representation only and the installed cabinetry may vary slightly in product size, measurement of the details Although Quality Tons & Kitchens Ltd. (QTK) does it's best to manufacture exactly what is shown here outside factors may be compared to the custom of the handle appearance and location and other details. Although Quality Tops & Kitchens Ltd. (QTK) does it's best to manufacture exactly what is shown here outside factors may prevent that and some variance is to be expected and accepted by the customer. 2. These drawings represent the intellectual property of QTK and as such the customer understands and accepts that all deposits given by the customer to QTK are non-refundable after QTK has supplied drawings (either physically or electronically) to the customer. If the customer decides to cancel the order after QTK has submitted drawings to the customer, the deposit will then be considered a design fee and no money will be eturned to the customer.

SINK WALL ELEVATION 2C, 20a, 2D



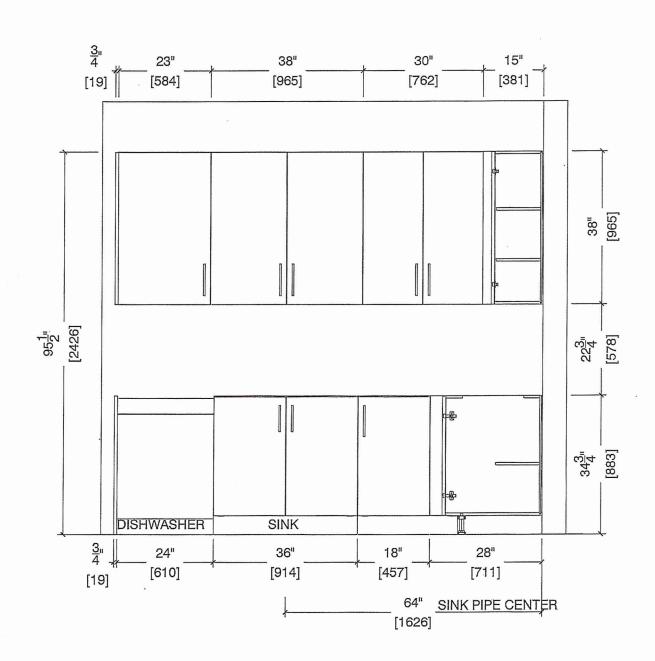




80 Sante Drive, Vaughan, ON L4K 3C4 T 416.746.1811 F 905.761.5901 www.QTK.ca info@qtk.ca

	20.20-110117		T
CLIENT: ROYAL PINE HOMES	JOB NAME: 2C, 2Ca HOLLY, 2C1 MAGNOLIA, 2D-REDPINE	ROOM: KITCHEN	DRAWN BY: GS
SITE: FORESTSIDE ESTATES	DOOR STYLE: QTS 1022	DOOR HANDLE:	SCALE: 1/2" = 1'-0"
PHONE:	FINISH:	DRW HANDLE:	DATE: JUNE 12, 2020
EMÁIL:	SPECIES: LAMINATE	TOP:	PAGE:

COMMENTS:

Customer Agrees and Accepts the following conditions: 1. The Drawing is a representation only and the installed cabinetry may vary slightly in product size, measurements, handle appearance and location and other details. Although Quality Tops & Kitchens Ltd. (QTK) does it's best to manufacture exactly what is shown here outside factors may prevent that and some variance is to be expected and accepted by the customer. 2. These drawings represent the intellectual property of QTK and as such the customer understands and accepts that all deposits given by the customer to QTK are non-refundable after QTK has supplied drawings (either physically or electronically) to the customer. If the customer decides to cancel the order after QTK has submitted drawings to the customer, the deposit will then be considered a design fee and no money will be

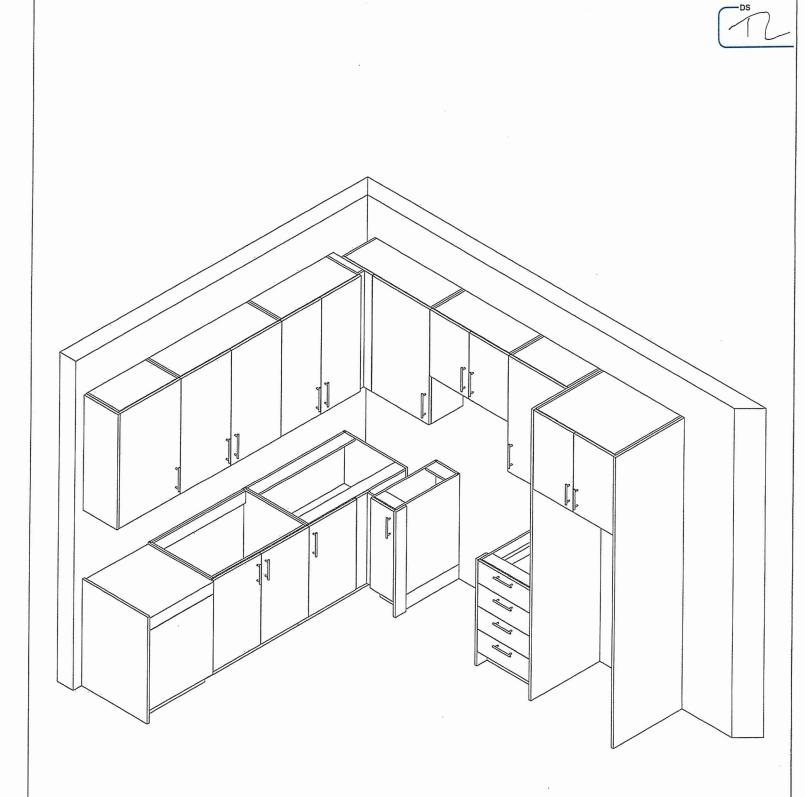



80 Sante Drive, Vaughan, ON L4K 3C4 T 416.746.1811 F 905.761.5901 www.QTK.ca info@qtk.ca

CLIENT: ROYAL PINE HOMES	MODEL: 2C, 2Ca-HOLLY, 2C1 MAGNOLIA 2D RED PINE, 2C1 WINTERGREEN	ROOM: VANITY	DRAWN BY: GS
SITE: FORESTSIDE ESTATES	DOOR STYLE: QTS 1022	DOOR HANDLE:	SCALE: 1/2" = 1'-0."
PHONE:	FINISH:	DRW HANDLE:	DATE: JUNE 12, 2020
EMAIL:	SPECIES: LAMINATE	TOP:	PAGE:

COMMENTS:

BUILDING A SUITE 320 BUY 2

Customer Agrees and Accepts the following conditions: 1. The Drawing is a representation only and the installed cabinetry may vary slightly in product size, measurements, nandle appearance and location and other details. Although Quality Tops & Kitchens Ltd. (QTK) does it's best to manufacture exactly what is shown here outside factors may prevent that and some variance is to be expected and accepted by the customer. 2. These drawings represent the intellectual property of QTK and as such the customer understands and accepts that all deposits given by the customer to QTK are non-refundable after QTK has supplied drawings (either physically or electronically) to the customer. If the customer decides to cancel the order after QTK has submitted drawings to the customer, the deposit will then be considered a design fee and no money will be returned to the customer.


POWDER ROOM PLAN (2C, 2Ca, 2C1, 2D, 2D2)

2C : 24 nos. 2Ca : 4 nos. 2C1 : 8 nos. 2D : 24 nos.


: 6 nos.

2D2



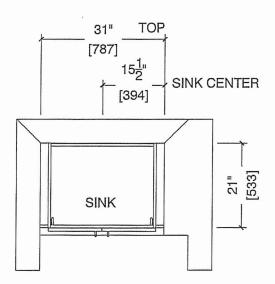

POWDER ROOM ELEVATION (2C, 2Ca, 2C1, 2D, 2D2)

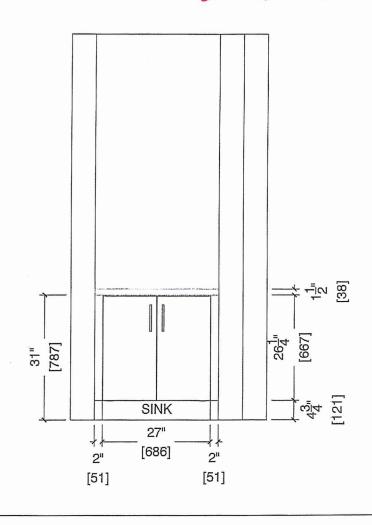



80 Sante Drive, Vaughan, ON L4K 3C4 T 416.746.1811 F 905.761.5901 www.QTK.ca info@qtk.ca

CLIENT: ROYAL PINE HOMES	MODEL: 2C, 2G(a), 2G(b)-HOLLY-	ROOM: VANITY	DRAWN BY: GS
SITE: FORESTSIDE ESTATES	DOOR STYLE: QTS 1022	DOOR HANDLE:	SCALE: 1/2" = 1'-0"
PHONE:	FINISH:	DRW HANDLE:	DATE: JUNE 12, 2020
EMAIL:	SPECIES: LAMINATE	TOP:	PAGE:


COMMENTS:

BUILDING A SUITE 320 BUX 2


Customer Agrees and Accepts the following conditions: 1. The Drawing is a representation only and the installed cabinetry may vary slightly in product size, measurements, handle appearance and location and other details. Although Quality Tops & Kitchens Ltd. (QTK) does it's best to manufacture exactly what is shown here outside factors may prevent that and some variance is to be expected and accepted by the customer. 2. These drawings represent the intellectual property of QTK and as such the customer understands and accepts that all deposits given by the customer to QTK are non-refundable after QTK has supplied drawings (either physically or electronically) to the customer. If the customer decides to cancel the order after QTK has submitted drawings to the customer, the deposit will then be considered a design fee and no money will be returned to the customer.

BATH PLAN (206, 20a, 20)

2Cb : 4 nos. 2Ca : 4 nos. 2C : 24 nos.

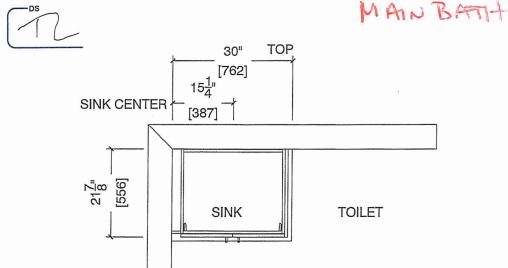

BATH ELEVATION (2Cb, 2Ca, 2C)

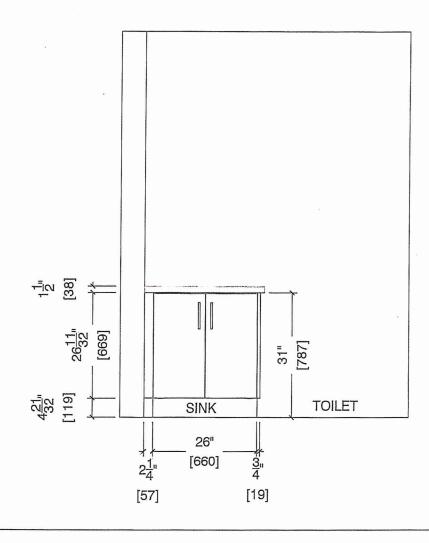

OTH your kitchen. your taste

80 Sante Drive, Vaughan, ON L4K 3C4 T 416.746.1811 F 905.761.5901 www.QTK.ca info@qtk.ca


CLIENT: ROYAL PINE HOMES	MODEL: 2C,2G(a) 2C(b) HOLLY	ROOM: VANITY	DRAWN BY: GS	
SITE: FORESTSIDE ESTATES	DOOR STYLE: QTS 1022	DOOR HANDLE:	SCALE: 1/2" = 1'-0"	
PHONE:	FINISH:	DRW HANDLE;	DATE: JUNE 12, 2020	
EMAIL:	SPECIES: LAMINATE	TOP:	PAGE:	

COMMENTS

BUILDING A SUITE 320 BLK Z

Customer Agrees and Accepts the following conditions: 1. The Drawing is a representation only and the installed cabinetry may vary slightly in product size, measurements handle appearance and location and other details. Although Quality Tops & Kitchens Ltd. (QTK) does it's best to manufacture exactly what is shown here outside factors may prevent that and some variance is to be expected and accepted by the customer. 2. These drawings represent the intellectual property of QTK and as such the customer understands and accepts that all deposits given by the customer to QTK are non-refundable after QTK has supplied drawings (either physically or electronically) to the customer. If the customer decides to cancel the order after QTK has submitted drawings to the customer, the deposit will then be considered a design fee and no money will be returned to the customer.

MASTER ENSUITE PLAN (2Cb, 2Ca, 2C)

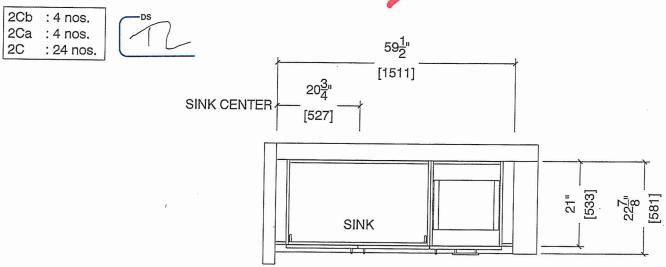

MASTER ENSUITE ELEVATION (206, 20a, 20)

