



SITE COPY

CONSTRUCTION SUMMARY

Grovetrail Developments Inc.

PURCHASER: CHRISTIAN ROBERT ZANETTI

TEL:

LOT NUMBER	PHASE	HOUSE TYPE	CLOSING DATE
50 Block 50	1	MAJOR MACKENZIE-END Elev B	28-Feb-23

Offer	BONUS PACKAGE FOR TOWNHOUSE: PURCHASER TO RECEIVE \$7,500.00 (INCLUSIVE OF TAXES) WORTH OF UPGRADES AT DECOR CENTRE AT TIME OF COLOUR CHART
Worksheet	Note:

Offer	BONUS PACKAGE FOR TOWNHOUSE: 5 APPLIANCES TO INCLUDE FRIDGE, STOVE, DISHWASHER WITH STAINLESS STEEL FINISH AND WHITE WASHER AND DRYER AS PER VENDORS SAMPLES.
Worksheet	Note:



SITE COPY

CONSTRUCTION SUMMARY
Grovetrail Developments Inc.

PURCHASER: CHRISTIAN ROBERT ZANETTI TEL:

LOT NUMBER	PHASE	HOUSE TYPE	CLOSING DATE	
50 Block 50	1	MAJOR MACKENZIE-END Elev B	28-Feb-23	

Date Added: 23-Dec-22 Invoice Number: 8422

1 - Standard Cable and Telehpne rough in (See Sketch) Note: **PLEASE NOTE** Purchaser's request to have Fonzie C locate the standard cable and telephone outlets
1 - BASEMENT- Install ONE (X1) larger basement window, 36"x24", in lieu of the standard (See Sketch) Note: As Per Fonzie
1 - Purchaser to receive TEN (X10) Potlights on Main floor as per their Standard Features and Finishes List **SEE BELOW** Note: **PLEASE NOTE**- Purchaser's request to have Fonzie locate all builders standard pot lightson behalf of the purchaser
1 - EXTERIOR- Install exterior pot lights and outlet, as per Fonzie Note:
1 - FRONT EXTERIOR- Install Extended height Single front and applicable side lights (See Sketch) Note: As per Fonzie
1 - MASTER ENSUITE- Increase the size of the Master Ensuite shower stall (See Sketch) Note: As per Fonzie
1 - MASTER ENSUITE- install a shower niche for the Master Ensuite shower stall, Install a 24"x14" niche (See Sketch) Note: As per Fonzie
1 - MASTER BEDROOM- Increase the width of the master bedroom walk in closet, and convert teh double door entry to a single door entry (See Sketch) Note: As per Fonzie
1 - MAIN BATH- Delete the tub shower and install a shower stall (36"x66"), to include 2x2 mosaic, shower pot lights, and curb with stone top (See Sketch) Note: As per Fonzie
1 - MAIN BATH- install a shower niche for the Main Bath shower stall, Install a 24"x14" niche (See Sketch) Note: As per Fonzie
1 - KITCHEN & BATHROOMS - Purchaser has DECLINED All Upgrades offered during decor appointment at the decor centre for kitchen & bathroom cabinetry. Standard Kitchen Layout & Standard Bathroom Vanities to be installed as per standard plan. (See Sketch) Note:
1 - APPLIANCE PACKAGE- Install the Standard Appliance Package throughout the home, where applicable. Note:
1 - KITCHEN- Install builders standard counter top, Emmerstone MAPLE WHITE Note:
1 - KITCHEN- Install an upgraded undermount kitchen sink for the kitchen, in lieu of the builders standard. Install the Blanco Quatrus R15 U2 Model #401519 Note: Install standard single hole faucet
1 - KITCHEN-Install an upgraded "L" Edge throughout the kitchen ONLY, in lieu of the builders standard edge. Note:
1 - POWDER ROOM-Install builders standard counter top, Emmerstone MAPLE WHITE with standard "A" Edge Note:



SITE COPY

CONSTRUCTION SUMMARY
Grovetrail Developments Inc.

PURCHASER: CHRISTIAN ROBERT ZANETTI TEL:

LOT NUMBER	PHASE	HOUSE TYPE	CLOSING DATE	
50 Block 50	1	MAJOR MACKENZIE-END Elev B	28-Feb-23	

Date Added: 23-Dec-22 Invoice Number: 8422

1 - POWDER ROOM- Install an upgarde faucet for the powder room- Install the Moen CIA Single Handle Lav Faucet with Lift Rod Drain in Matte Black Model # 6221 BL
Note:

1 - MASTER ENSUITE- Install builders standard counter top, Emmerstone MAPLE WHITE with standard "A" Edge
Note:

1 - MAIN BATH- Install builders standard counter top, Emmerstone MAPLE WHITE with standard "A" Edge
Note:

1 - CLARIFICATION- Install the builders standard Plumbing Fixtures throughout all bathrooms, where applicable.
Note:

1 - COUNTER TOPS

Purchaser accepts & acknowledges that the Stone slabs vary in size & all seams are visible & the fabricator reserves the right to position the seams as necessary.
Note:

1 - CLARIFICATION- Install the Standard 3" Splash throughout all bathroom vanity counter tops, where applicable.
Note:

1 - STAIRCASE VS FLOORING
WOOD SPECIES DIFFERENCE:
STAIRCASE - The purchaser was advised and therefore accepts and acknowledges that the wood species of the staircase and flooring chosen do not match. This difference may result in a stain colour variance.
Note: The purchaser agrees that the vendor is to be exempt from any and all claims by the purchaser regarding this colour variance.

1 - STAIRCASE VS FLOORING
STAINING DIFFERENCE:
STAIRCASE - The purchaser was advised and therefore accepts and acknowledges that the stain of the staircase and flooring chosen do not match. This difference might result in an undesirable colour variance.
Note: The purchaser agrees that the vendor is to be exempt from any and all claims by the purchaser regarding this colour variance.

1 - SECOND FLOOR- Install Laminate upgrade flooring throughout the 2nd floor, in lieu of the builders standard carpet. Install the Highland Watson Natural Oak EE-H-292, throughout the Upper Hall, Master Bedroom, Bedroom #2, and #3
Note:

1 - MASTER ENSUITE- Install Frameless glass enclosure for the Master Ensuite shower stall, in lieu of the builders standard framed glass panels.
Note:

1 - MAIN BATH- Install 6mm clear tempered glass with chrome U channel & a maax swing door for the Main Bathroom shower stall
Note:

1 - Purchaser to receive a further discount of -\$7,231.72 (50%) on the Sub-Total, as per Steve C
Note:

1 - PURCHASER AWARE AND ACCEPTS THAT ANY CHANGES MADE TO UPGRADES AFTER SIGNING THIS PURCHASERS EXTRA FORM ARE SUBJECT TO A MINIMUM ADMINISTRATION FEE OF \$1,000
Note:

1 - PURCHASER HAS ATTENDED A COLOUR CHART APPOINTMENT AT THE DESIGN STUDIO AND HAS DECLINED ANY ADDITIONAL UPGRADES
Note:

	Purchaser CHRISTIAN ROBERT ZANETTI	Decor Consultant Laura Di Pede	Model and Elevation MAJOR MACKENZIE-END Elev B	Telephone Res. / Bus /	Project Grovetrail Developments Inc.	Closing Date 28/02/2023	Property 50 Block 50
--	--	--	--	----------------------------------	--	-----------------------------------	--------------------------------

Master Ensuite
Main Bathroom

Powder Room
Kitchen/Dinette
Laundry-2nd Flr

Foyer
Main Hall
Great Room

Upper Hall

Master Bedroom
Bedroom 2
Bedroom 3

Wall Tile				Plumbing
<u>Main</u>	<u>Accent/Insert</u>	<u>Border / Listello</u>	<u>Pattern</u>	
8X10 KEATON ICE (STD)	N/A	N/A	N/A	WHITE
8X10 KEATON ICE (STD)	N/A	N/A	N/A	WHITE
N/A	N/A	N/A	N/A	WHITE
3X6 C&D Glossy White(Std) (Stacked)	N/A	N/A	N/A	See Notes
N/A	N/A	N/A	N/A	STD

Railings and Stairs

Railings	Mirage Red Oak DRIFTWOOD (STD)	Landing - Upper	Wilson Natural Oak EE-H-292
Pickets	Single Plain Black Steel (STD)	Landing - Lower	Wilson Nat Wilson Nat EE-H-292
Posts	Mirage Red Oak DRIFTWOOD (STD)	Ledge - Upper	N/A
Stringers	Mirage Red Oak DRIFTWOOD (STD)	Ledge - Lower	N/A
Treads	Mirage Red Oak DRIFTWOOD (STD)		
Risers	Mirage Red Oak DRIFTWOOD (STD)		
Runner	N/A		

Trim

Baseboard & Casing	STD- Step Bevel MODERN	Knobs	STD- LEVER
Front Door Glass	STANDARD	Hinges	STANDARD
Interior Doors	STANDARD	Grip Set	STANDARD

Cornice Moulding / Medallion

Foyer	NO
Living Room	NO
Dining Room	NO
Family Room	NO
Main Hall	NO
Kitchen	NO
2nd Floor Hall	NO

Notes

MASTER ENSUITE- 2X2 WHITE MOSAIC & WHITE QUARTZ CURB TOP ** MAIN BATH- 2X2 WHITE MOSAIC & WHITE QUARTZ CURB TOP ** KITCHEN- INSTALL AN
UPGRADE SINK Blanco Qualrus R15 U2 Model #401519

Page 1 of 3

Consultant:

Laura Di Pede

Purchaser

DocuSigned by:

Christian Robert Zanetti

Vendor:

Grovebait Developments Inc.

Printed Dec 20, 2022 10:33 am



* INTERIOR COLOUR SCHEME *

Purchaser	Decor Consultant	Model and Elevation	Telephone Res. / Bus	Project	Closing Date	Property
CHRISTIAN ROBERT ZANETTI	Laura Di Pedo	MAJOR MACKENZIE-END Elev B	/	Grovetrail Developments Inc.	28/02/2023	50 Block 50

Page 2 of 3

	Interior Paint	Cabinet
	Description	Style
Master Ensuite	(STD) SILVER BIRCH	EURO RUSTICA ROVERE CHIOSTRO RU-03(STD)
Main Bathroom	(STD) SILVER BIRCH	EURO RUSTICA ROVERE CHIOSTRO RU-03 (STD)
Powder Room	(STD) SILVER BIRCH	EURO RUSTICA ROVERE CHIOSTRO RU-03(STD)
Kitchen/Dinette	(STD) SILVER BIRCH	EURO RUSTICA LARICE BIANCO RU-05 (STD)
Laundry-2nd Flr	(STD) SILVER BIRCH	
Foyer	(STD) SILVER BIRCH	
Main Hall	(STD) SILVER BIRCH	
Great Room	(STD) SILVER BIRCH	
Upper Hall	(STD) SILVER BIRCH	
Master Bedroom	(STD) SILVER BIRCH	
Bedroom 2	(STD) SILVER BIRCH	
Bedroom 3	(STD) SILVER BIRCH	

Countertop	Counter Edge	Handle / Knob
Emmerstone- MAPLE WHITE (STD)	A" STD- EGDE	930396BSN
Emmerstone- MAPLE WHITE (STD)	A" STD- EGDE	930396BSN
Emmerstone- MAPLE WHITE (STD)	A" STD- EGDE	930396DBK
Emmerstone- MAPLE WHITE (STD)	L" EDGE- UPGD	930396BSN

Appliance Opening/Dimension

Fridge Size STANDARD Range STANDARD

Built-Ins None Microwave None

Hood Fan STANDARD Exhaust Opening 6" 8"

Dishwasher Cabinet Std 24in Opening

Fireplace

Fireplace	N/A	Fireplace	N/A
Location Flooring	N/A	Location Flooring	N/A
Style	N/A	Style	N/A
Finish	N/A	Finish	N/A
Marble	N/A	Marble	N/A
Hearth	N/A	Hearth	N/A

Notes



BUILDERS STANDARD APPLIANCES

Page 2 of 3

Decor Consultant: Laura Di Pedo

Purchaser: Christian Robert Zanetti

Vendor: Grovetrail Developments Inc.
Printed Dec 20, 2022 10:33 am

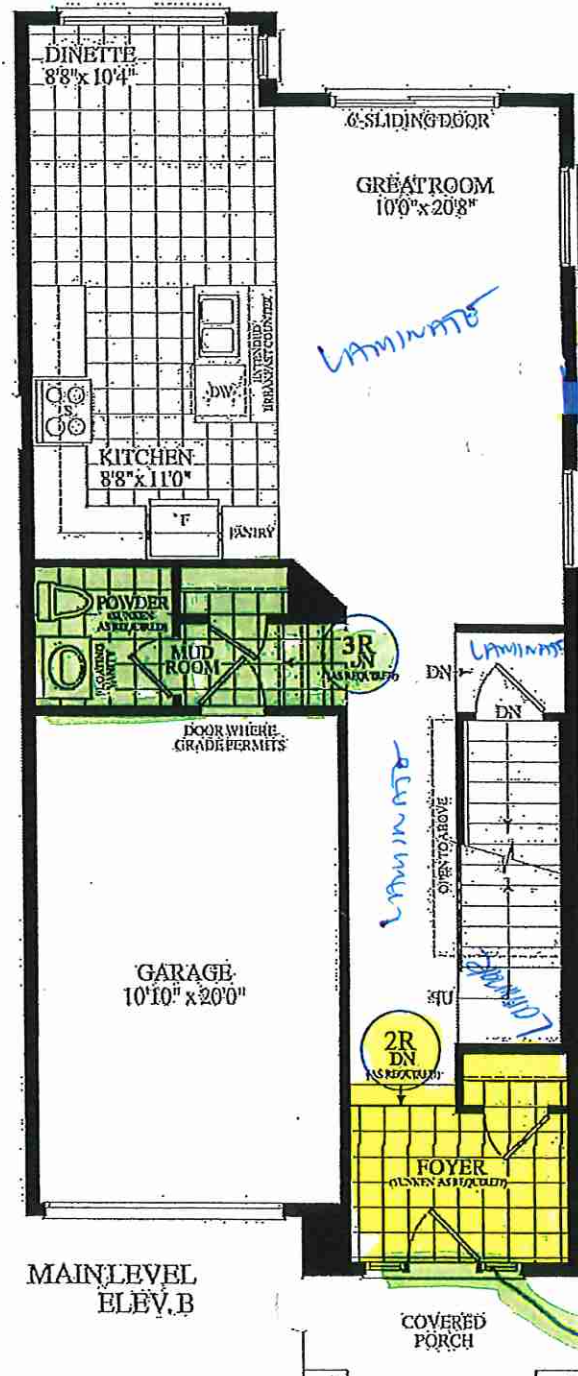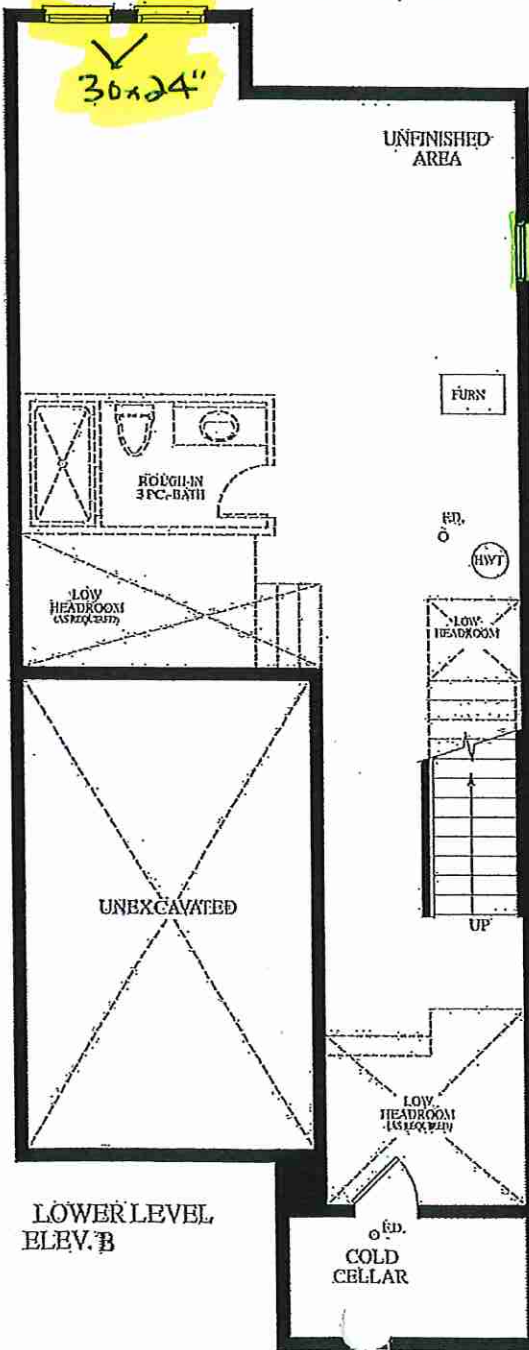

BLK. 50 TH. 50 - 20-09 END - MACKENZIE EL. B

PROJECT: RP-CE-BLK 50- TH50


MODEL: THE MACKENZIE -2009 END
ELEV. B

KITCHEN

DOOR STYLE: EURO MELAMINE
TRIM: NO
COLOUR: RU-05 LARICE BIANCO
INTERIOR COLOUR: WHITE MELAMINE
DRAWER BOX: STANDARD - NO SOFT CLOSE
HINGES: STANDARD - NO SOFT CLOSE
LIGHT VALANCE: NO
CROWN MOULDING: SQUARE CROWN
PAN MOULDING: NO
COUNTERTOP: BY OTHERS
INSTALL HEIGHT: 95 5/8"
HEIGHT TO UNDERSIDE OF BULKHEAD: 98 5/8" AFF
DECORATIVE HARDWARE:
MARATHON - BRUSHED NICKEL FIN.
#9603 -96-BSN - 6 1/4" L OVERALL



DRAWN BY: Lai-Yee
DATE: JANUARY 26, 2023
REVISED:
PAGE: 1 OF 7

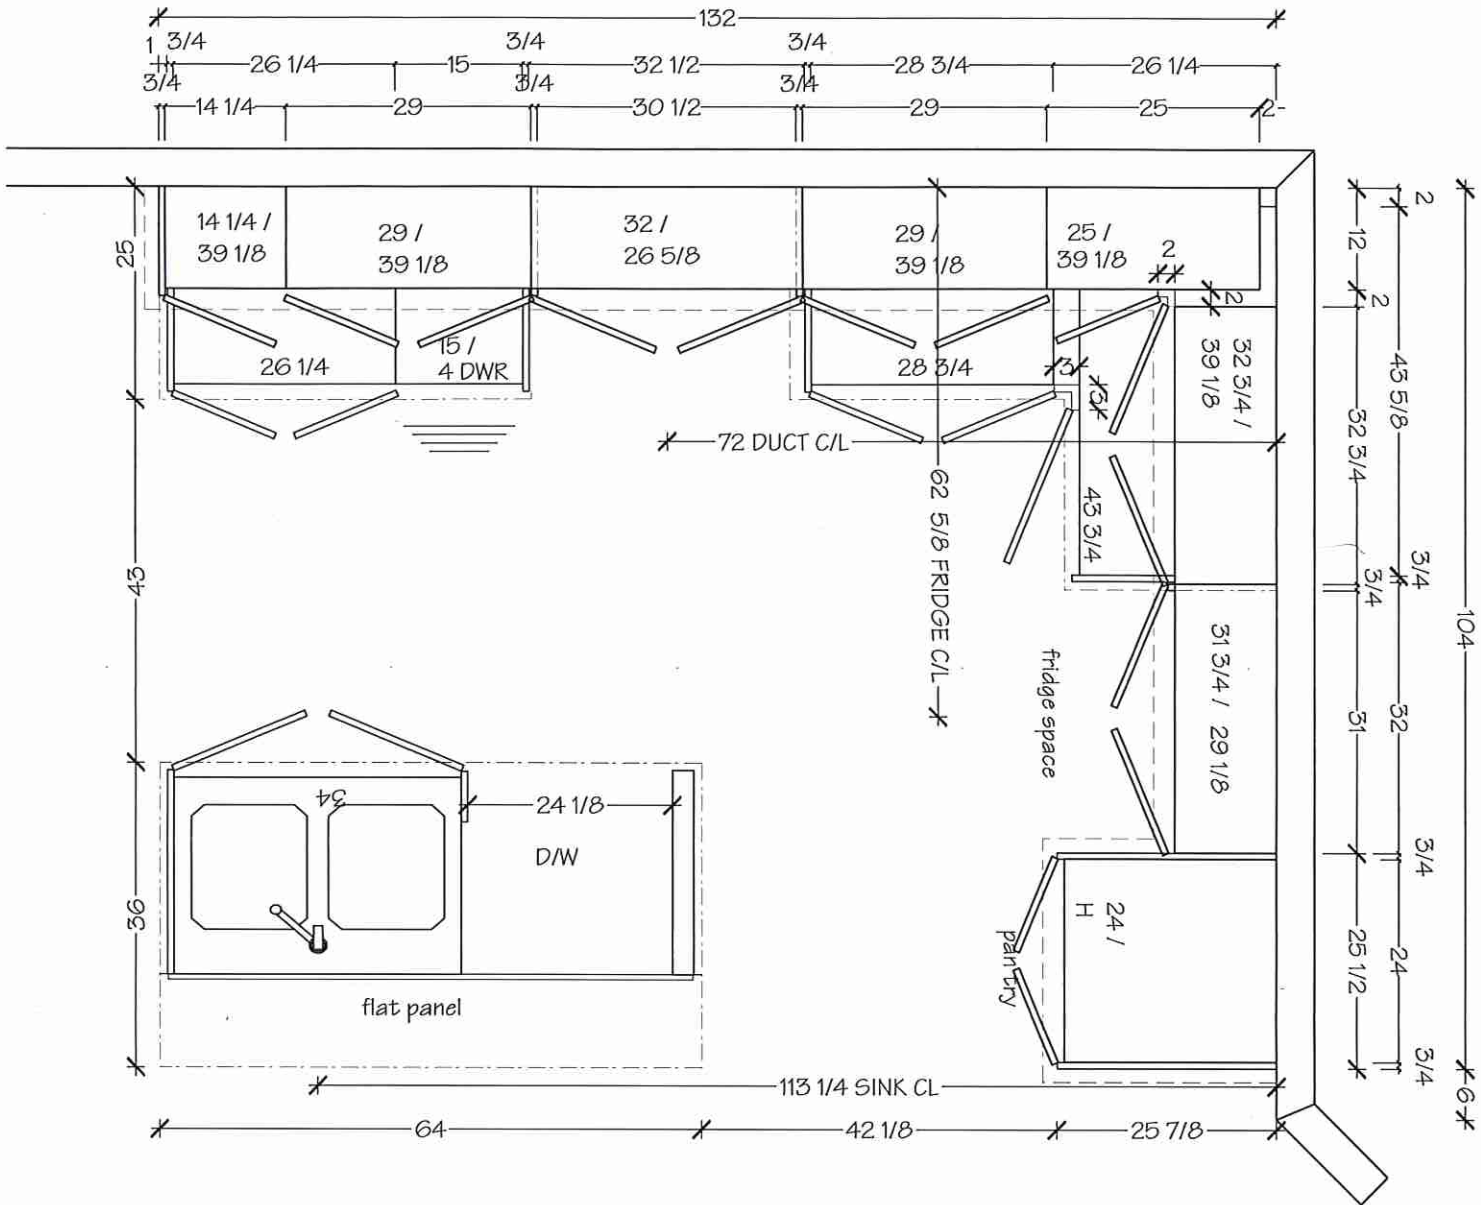



8111 Jane St. Unit 10
Concord, Ontario L4K 4L7
Tel. (905) 669- 7028
Fax. (905) 669 - 7903
email: designstudio@villakitchens.ca
www.villakitchens.ca


CLIENT: ROYAL PINE HOMES
PROJECT: RP-CE-BLK 50- TH50
MODEL: THE MACKENZIE -2009 END
ELEV. B


KITCHEN

DOOR STYLE: EURO MELAMINE
TRIM: NO
COLOUR: RU-05 LARICE BIANCO
INTERIOR COLOUR: WHITE MELAMINE
DRAWER BOX:STANDRAD - NO SOFT CLOSE
HINGES: STANDARD - NO SOFT CLOSE
LIGHT VALANCE: NO
CROWN MOULDING: SQUARE CROWN
PAN MOULDING: NO
COUNTERTOP: BY OTHERS
INSTALL HEIGHT: 95 5/8"
HEIGHT TO UNDERSIDE OF BULKHEAD: 98 5/8" AFF
DECORATIVE HARDWARE:
MARATHON - BRUSHED NICKEL FIN.
#9603 -96-BSN - 6 1/4" L OVERALL



DRAWN BY: Lai-Yee
DATE: JANUARY 26, 2023
REVISED:
PAGE: 2 OF 7

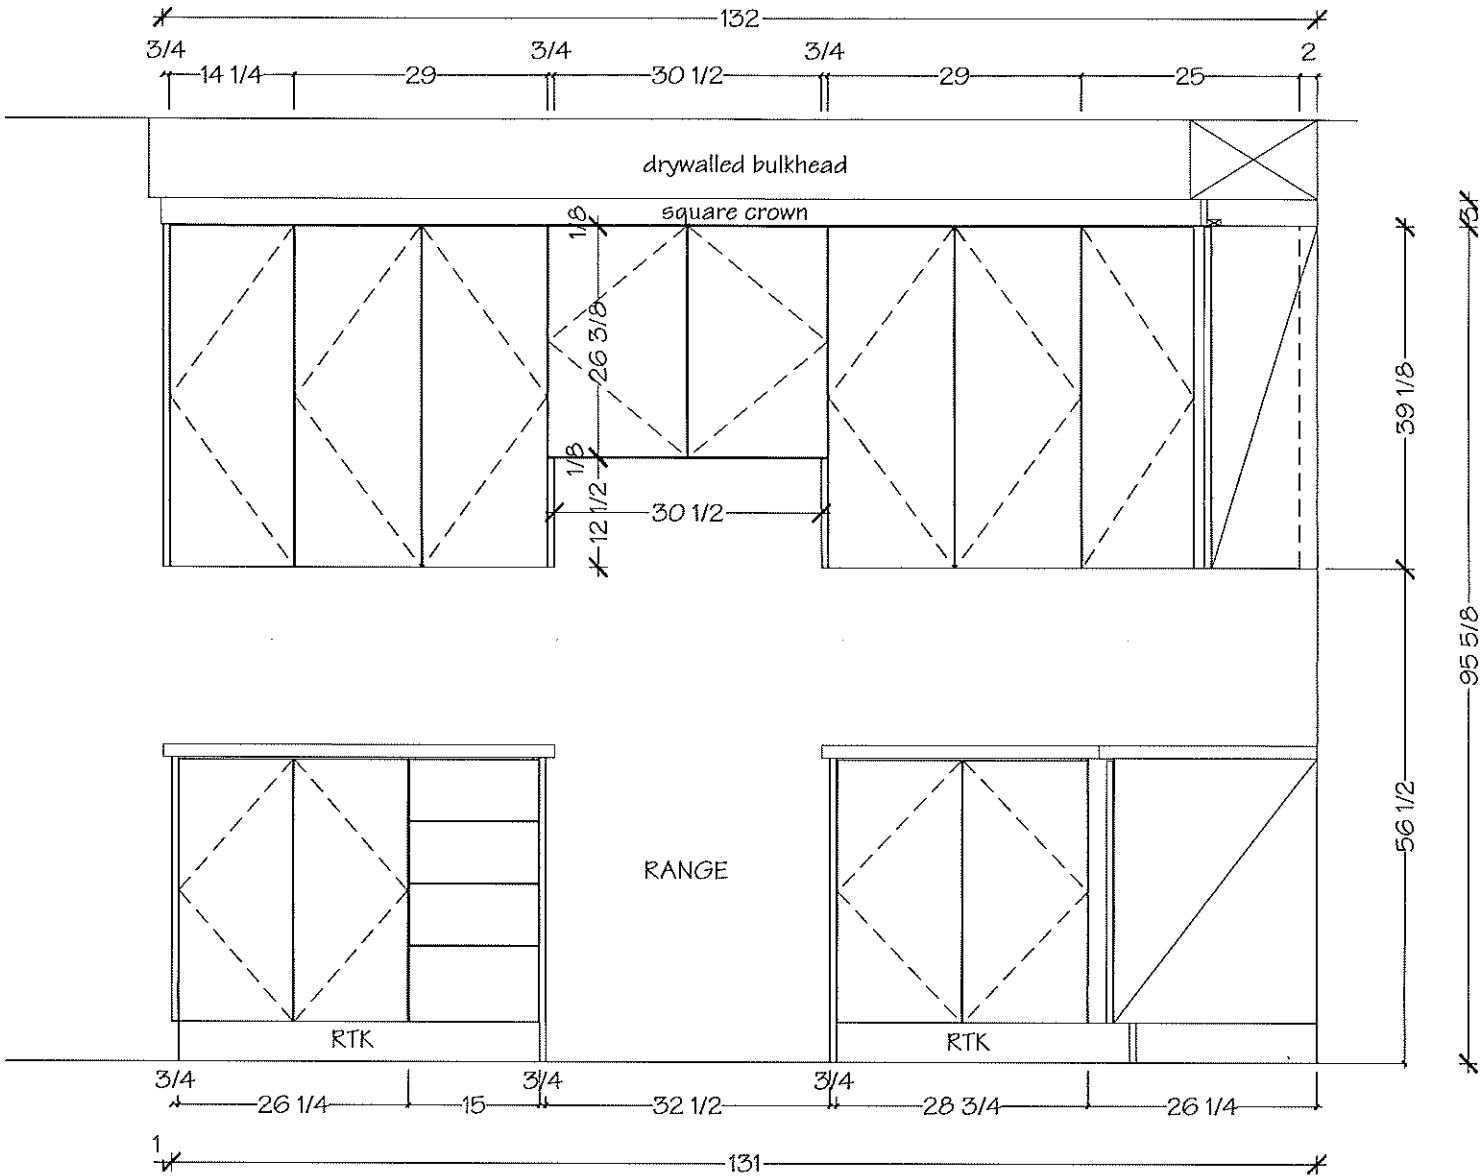

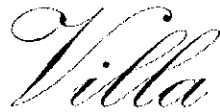

KITCHENS & FINE CABINETRY LTD

8111 Jane St. Unit 10
Concord, Ontario L4K 4L7
Tel. (905) 669-7028
Fax. (905) 669-7903
email: designstudio@villakitchens.ca
www.villakitchens.ca




CLIENT: ROYAL PINE HOMES
PROJECT: RP-CE-BLK 50- TH50
MODEL: THE MACKENZIE -2009 END
ELEV. B


KITCHEN

DOOR STYLE: EURO MELAMINE
TRIM: NO
COLOUR: RU-05 LARICE BIANCO
INTERIOR COLOUR: WHITE MELAMINE
DRAWER BOX:STANDRAD - NO SOFT CLOSE
HINGES: STANDARD - NO SOFT CLOSE
LIGHT VALANCE: NO
CROWN MOULDING: SQUARE CROWN
PAN MOULDING: NO
COUNTERTOP: BY OTHERS
INSTALL HEIGHT: 95 5/8"
HEIGHT TO UNDERSIDE OF BULKHEAD: 98 5/8" AFF
DECORATIVE HARDWARE:
MARATHON - BRUSHED NICKEL FIN.
#9603 -96-BSN - 6 1/4" L OVERALL



DRAWN BY: Lai-Yee
DATE: JANUARY 26, 2023
REVISED:
PAGE: 3 OF 7

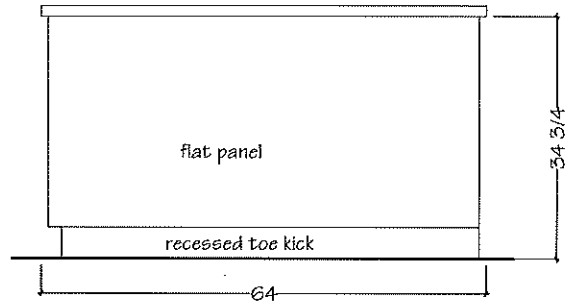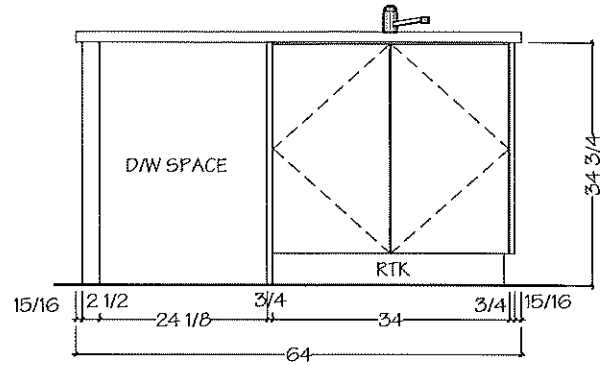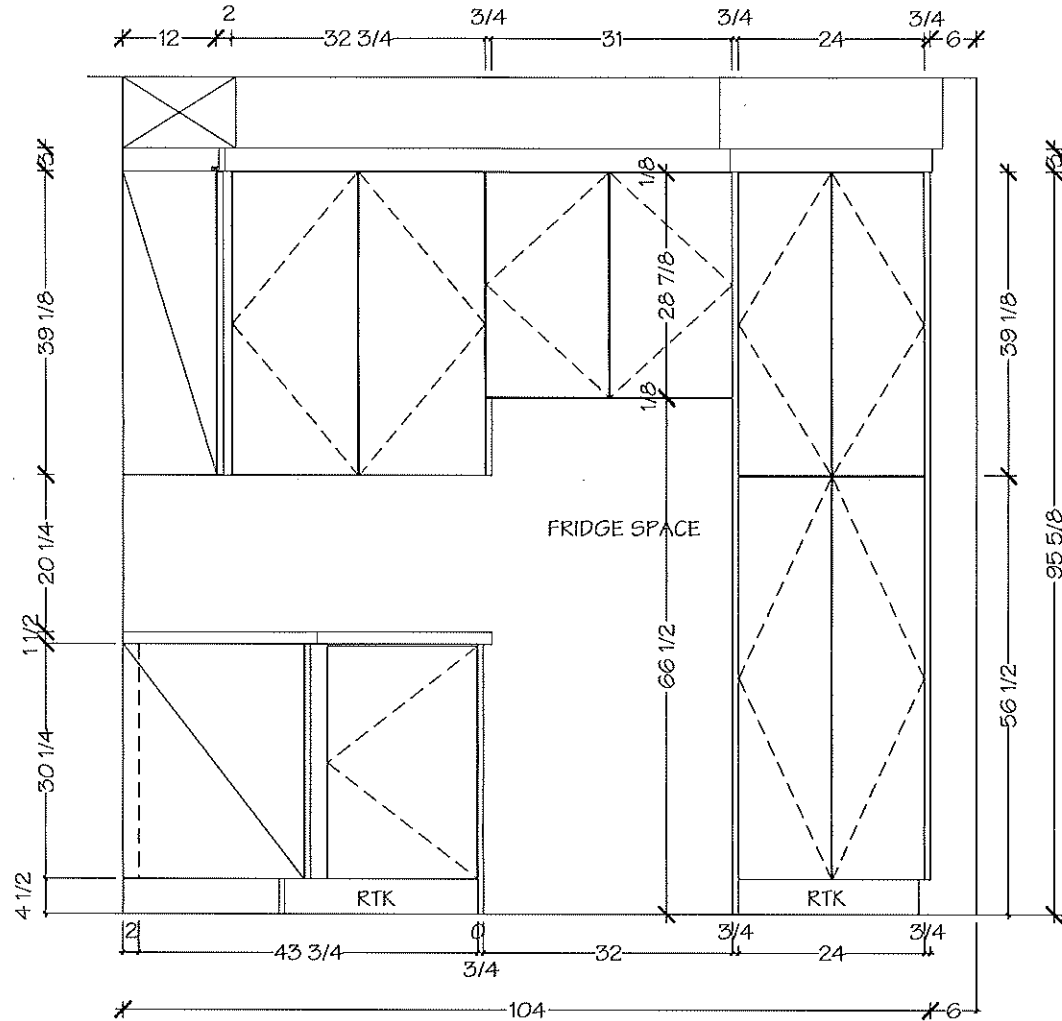

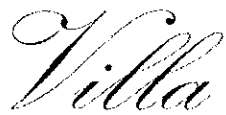


8111 Jane St. Unit 10
Concord, Ontario L4K 4L7
Tel. (905) 669- 7028
Fax. (905) 669 - 7903
email: designstudio@villakitchens.ca
www.villakitchens.ca

CLIENT: ROYAL PINE HOMES
PROJECT: RP-CE-BLK 50- TH50
MODEL: THE MACKENZIE -2009 END
ELEV. B

KITCHEN BULKHEAD

DRAWN BY: Lai-Yee
DATE: JAN 12, 2023
REVISED:
PAGE: 4 OF 7

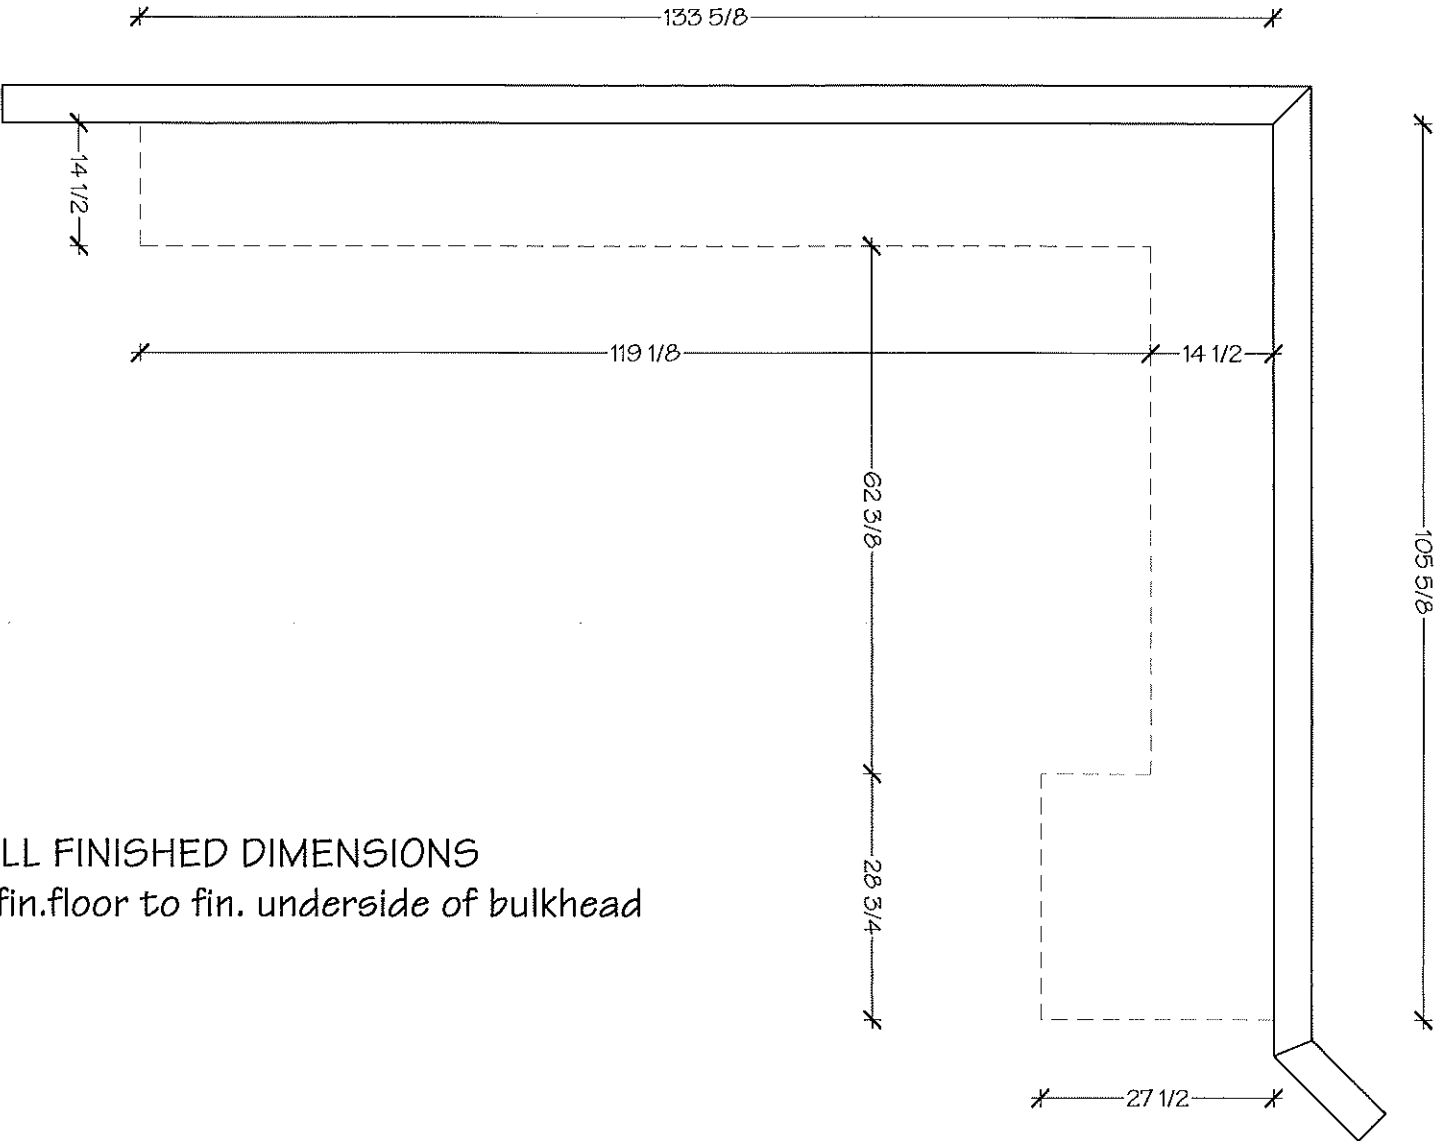



ALL FINISHED DIMENSIONS
98 5/8" from fin.floor to fin. underside of bulkhead

CLIENT: ROYAL PINE HOMES
PROJECT: RP-CE-BLK 50- TH50
MODEL: THE MACKENZIE -2009 END
ELEV. B

POWDER ROOM

DOOR STYLE: EURO MELAMINE
TRIM: NO
COLOUR: RUSTICA ROVERE CHIOSTRO RU-03
INTERIOR COLOUR: WHITE MELAMINE
DRAWER BOX: N/A
HINGES: STANDARD- NO SOFT CLOSE
COUNTERTOP: BY OTHERS
INSTALL HEIGHT: 33 1/4 + C/T
DECORATIVE HARDWARE: 9303-96 DBK

TH50 BLK50

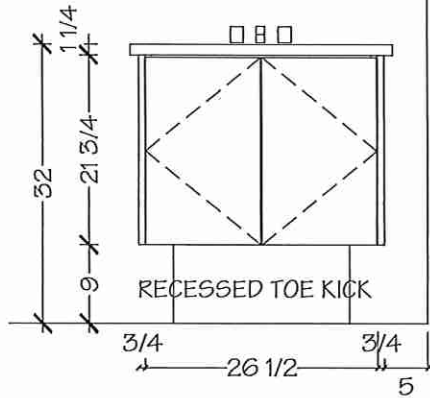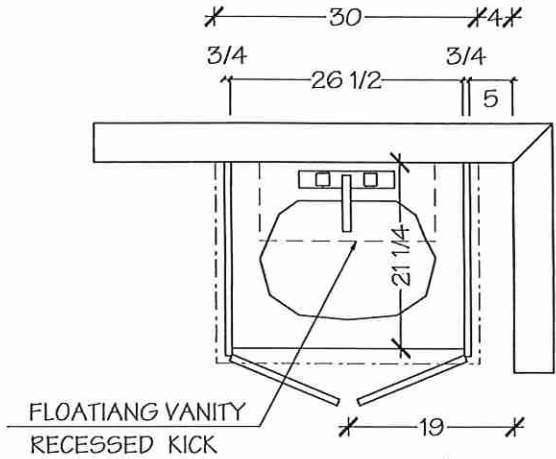

Villa

KITCHENS & FINE CABINETRY LTD

8111 Jane St. Unit 10
Concord, Ontario L4K 4L7
Tel. (905) 669-7028
Fax. (905) 669-7903
email: designstudio@villakitchens.ca
www.villakitchens.ca

CLIENT: ROYAL PINE HOMES

PROJECT: **RP-CE-BLK 50- TH50**

MODEL: THE MACKENZIE -2009 END
ELEV. B

MASTER ENSUITE

DOOR STYLE: EURO MELAMINE

TRIM: NO

COLOUR: ROVERE CHIOSTRO RU-03

INTERIOR COLOUR: WHITE MELAMINE

DRAWER BOX: STANDARD- NO SOFT CLOSE

HINGES: STANDARD- NO SOFT CLOSE

COUNTERTOP: BY OTHERS

INSTALL HEIGHT: 30 3/4" + C/T

DECORATIVE HARDWARE: 9303-96 BSN



TH50 BLK 50

DRAWN BY: Lai-Yee

DATE: JANUARY 13, 2023

REVISED:

PAGE: 6 OF 7

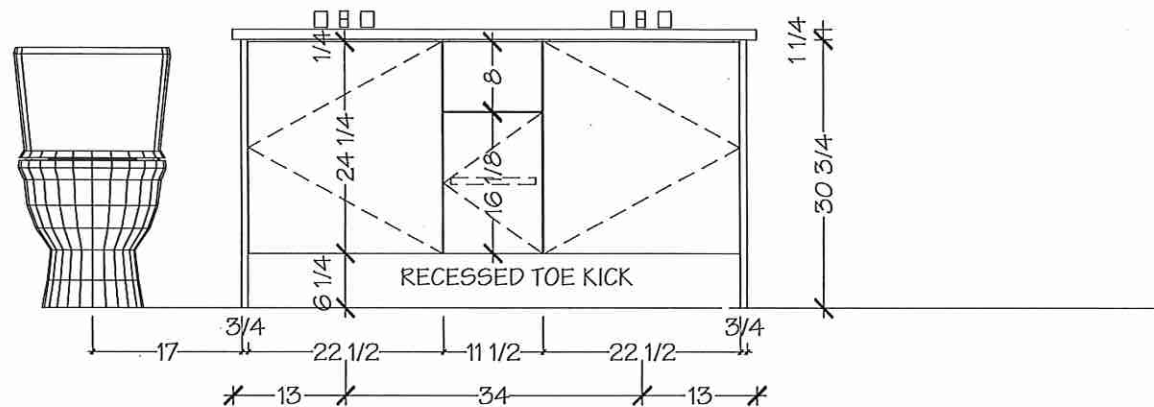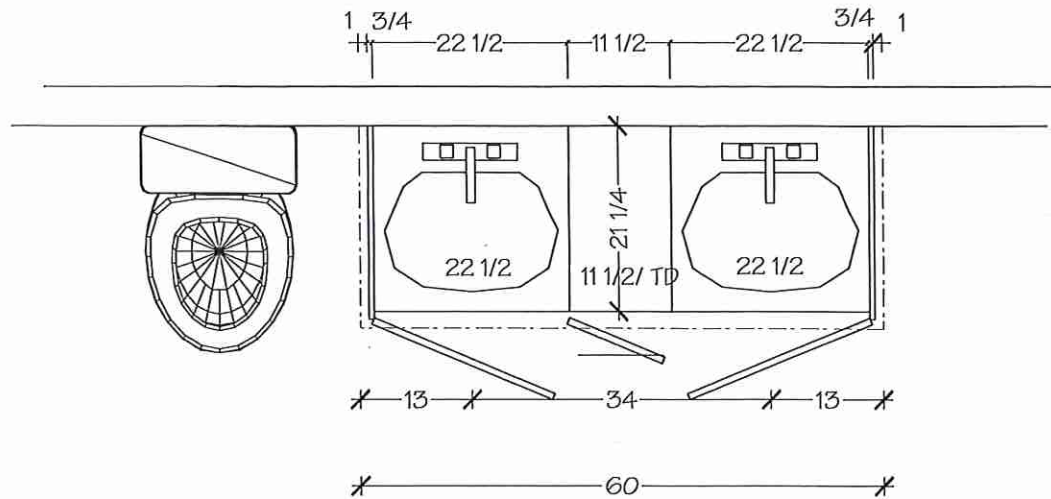

Villa
KITCHENS & FINE CABINETS LTD

8111 Jane St. Unit 10
Concord, Ontario L4K 4L7
Tel. (905) 669-7028
Fax. (905) 669-7903
email: designstudio@villakitchens.ca
www.villakitchens.ca

CLIENT: ROYAL PINE HOMES
PROJECT: CENTERFIELD
ADDRESS: RP-CE-MASTER
MODEL: **MACKENZIE 2009 END**


VANITIES

TH50 BLK50




DS
CRZ

DRAWN BY: DIDI
DATE: JUNE 18/2021
REVISION:
PAGE: 3 OF 4

FLOATING VANITY
RECESSED KICK

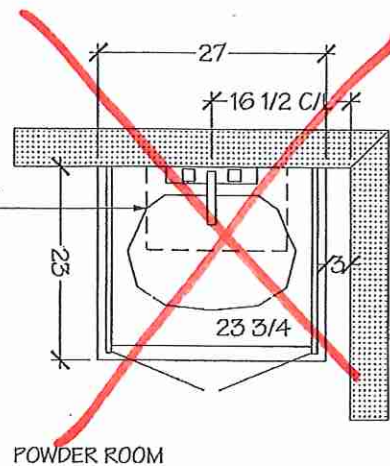

MASTER ENSUITE

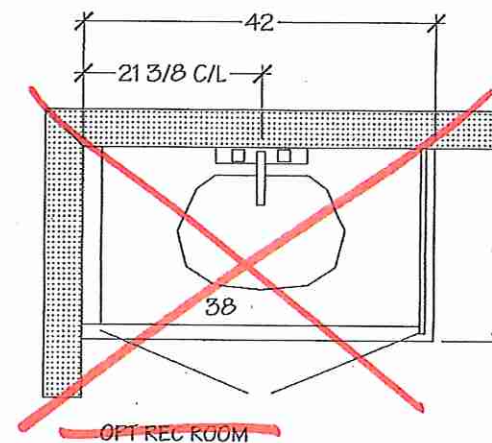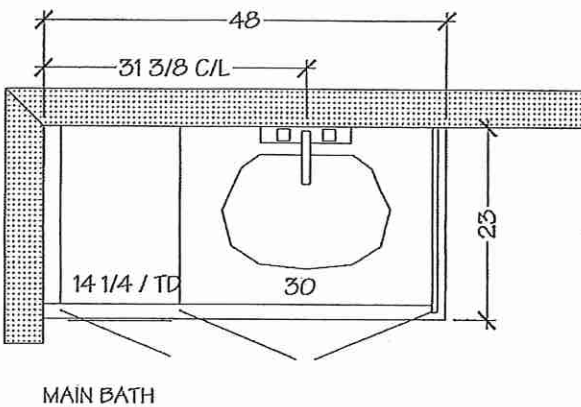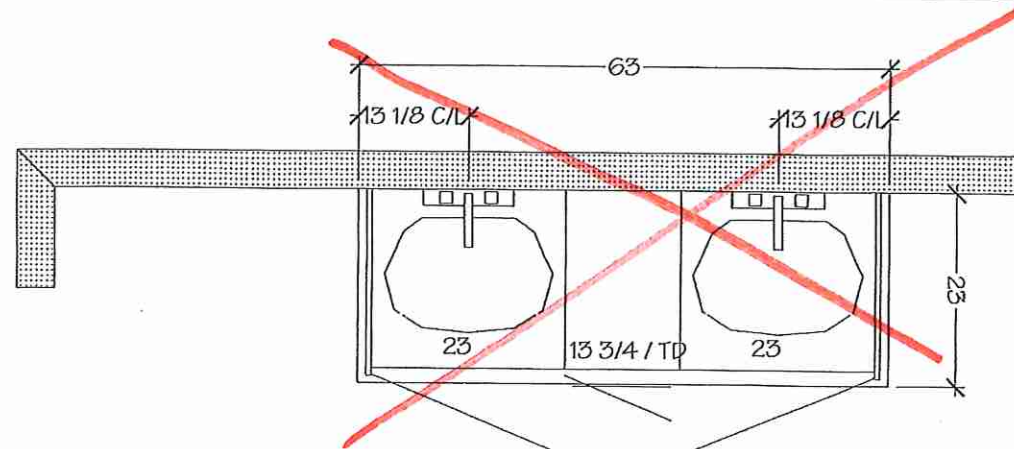


#50 BLK50


Cia™

Powder Room

DS
CRB

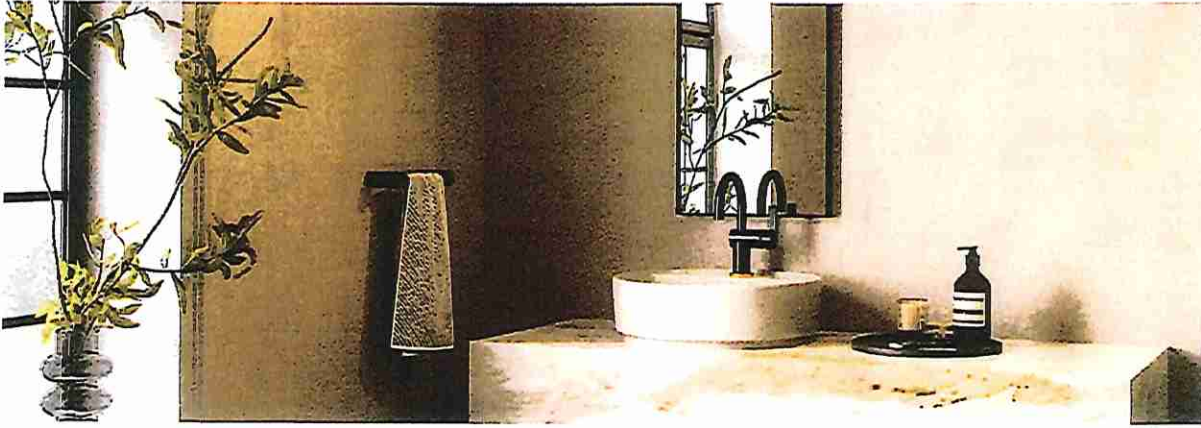

LAVATORY FAUCETS

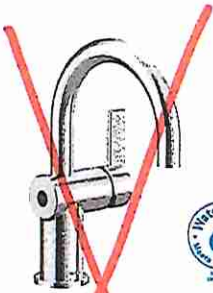


MotionSense Wave™ Single
Handle Lav Faucet

6221EW

Chrome \$1,102.89

Other \$1,651.38

Single hole installation only

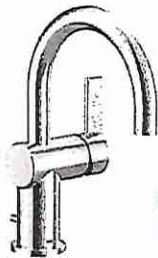


Single Handle Lav Faucet
with Lift Rod Drain

6221

~~Chrome \$449.14~~

Other \$666.95

Single hole installation only

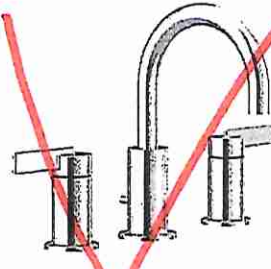

Two Handle Adjustable
Widespread (8\" - 16\") Lav
Faucet with Lift Rod Drain

T6222 / 69000

Chrome \$698.32

Other \$907.46

CIA FINISH OPTIONS



Chrome, LifeShine® Brushed Nickel (BN),
LifeShine® Brushed Gold (BG), Matte Black (BL)

To order, combine the
model number with one
of these finish letter(s):
LifeShine® Brushed
Nickel (BN), LifeShine®
Brushed Gold (BG)
& Matte Black (BL).
To order Chrome (C)
model, use model
number only.

Sink Specifications

Colour SKU
brushed finish 401519

QUATRUS R15 U 2
Stainless steel brushed finish



Design and planning tips

- Min cabinet size: 36 in (915 mm)
- Bowl Depth: 9 in (230.0 mm)

Specifications:

3 ½" (90 mm) stainless steel strainer(s)

Installation instructions


Cut-out template

Mounting clips

Limited lifetime warranty

Depending on cabinet construction, a different cabinet size may be required. Consult the cabinet manufacturer.

Cubed weight: 80 lbs.

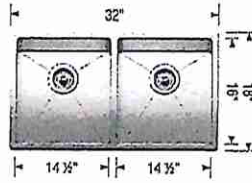

Optional Accessories

~~Ash Cutting Board 406345~~

~~CapFlow Strainer Cover 517666~~

~~Sink Grid 406454~~

* Install Standard Faucet *

Warranty

Limited lifetime warranty on all sinks and faucets. One-year warranty on all accessories and soap dispensers.

Code/Standards Compliance

BLANCO sinks and faucets are third-party tested and certified to CSA, cUPC, ANSI/ASME, IAPMO and NSF standards and listed by applicable certification bodies. For more information on individual product listings, contact our office or listing organization.



Need support? Learn more by watching our sink & faucet How-to videos:

<https://www.blanco.com/ca-en/support/how-to-videos/how-to-videos-for-sinks/>



BLANCO Canada Inc
100 Corporation Drive
Brampton ON L6S 6B5

Tel & Fax

Tel: 905-494-2400 Toll free: 1-877-425-2626

Fax: 905-494-2425 Toll free: 1-877-825-2626

While BLANCO strives to provide accurate information, all images and dimensions in this document are intended for reference only and are subject to change at any time without notice. This document is not intended for use as an installation guide. For technical installation details, refer to installation instructions provided with the product. BLANCO assumes no responsibility for the use of superseded or voided specifications.