



FILE COPY

CONSTRUCTION SUMMARY

Forestside Estates Inc.

PURCHASERS: KOMMINENI RAMANJANEYULU and PRABHAVATHI NADENDLA

TEL: RES.: 647-998-7268


| LOT NUMBER | PHASE | HOUSE TYPE                               | CLOSING DATE |
|------------|-------|------------------------------------------|--------------|
| 47         | 8     | WHITE FIR (45-02C4) - ELEV C - 4 BEDROOM | 27-Jun-24    |

|           |                                                                                                                             |
|-----------|-----------------------------------------------------------------------------------------------------------------------------|
| Offer     | BONUS PACKAGE -PURCHASER TO RECEIVE \$20,000 (INCLUSIVE OF TAXES) WORTH OF UPGRADES AT DECOR CENTRE AT TIME OF COLOUR CHART |
| Worksheet | Note:                                                                                                                       |



Date Added: 27-Jun-23 Invoice Number: 8498

|                                                                                                                                                                                                          |
|----------------------------------------------------------------------------------------------------------------------------------------------------------------------------------------------------------|
| 1 - MAIN FLOOR- Install extended height 10'-0" ceilings in Main Floor, To include extended height archways, 8 foot standard interior doors, as per vendors specifications and standard samples.<br>Note: |
| 1 - PURCHASER AWARE AND ACCEPTS THAT ANY CHANGES MADE TO UPGRADES AFTER SIGNING THIS PURCHASERS EXTRA FORM ARE SUBJECT TO A MINIMUM ADMINISTRATION FEE OF \$1,000<br>Note:                               |

This Document is Extremely Time Sensitive - Printed 6 Jul 23 at 11:24

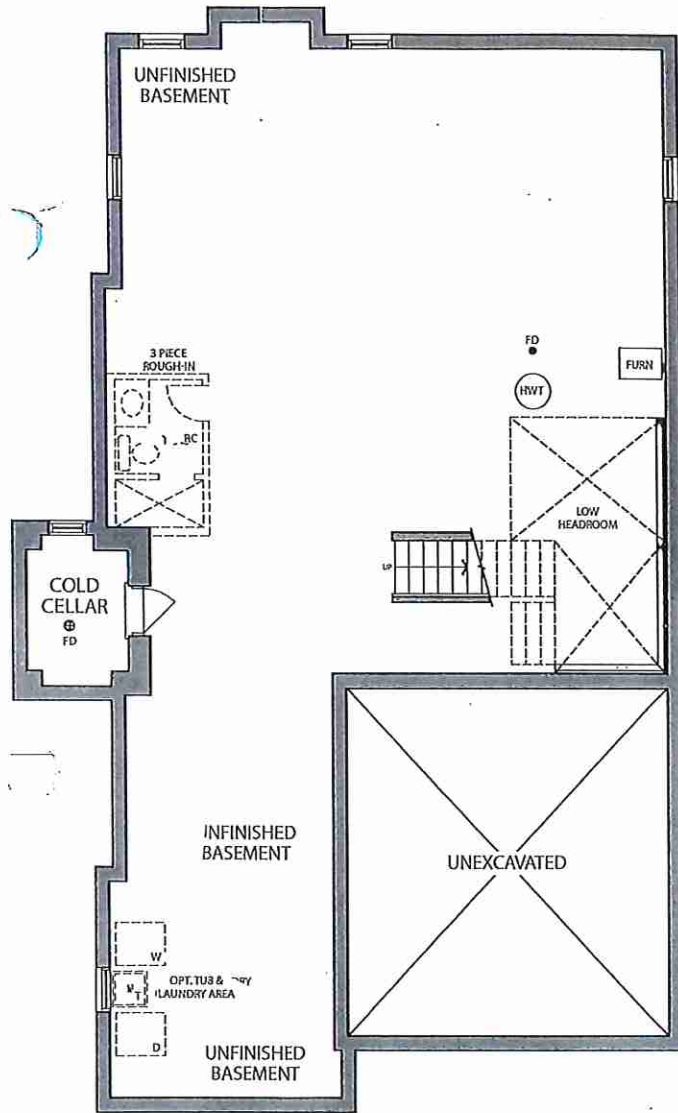

BASEMENT  
ELEV. C

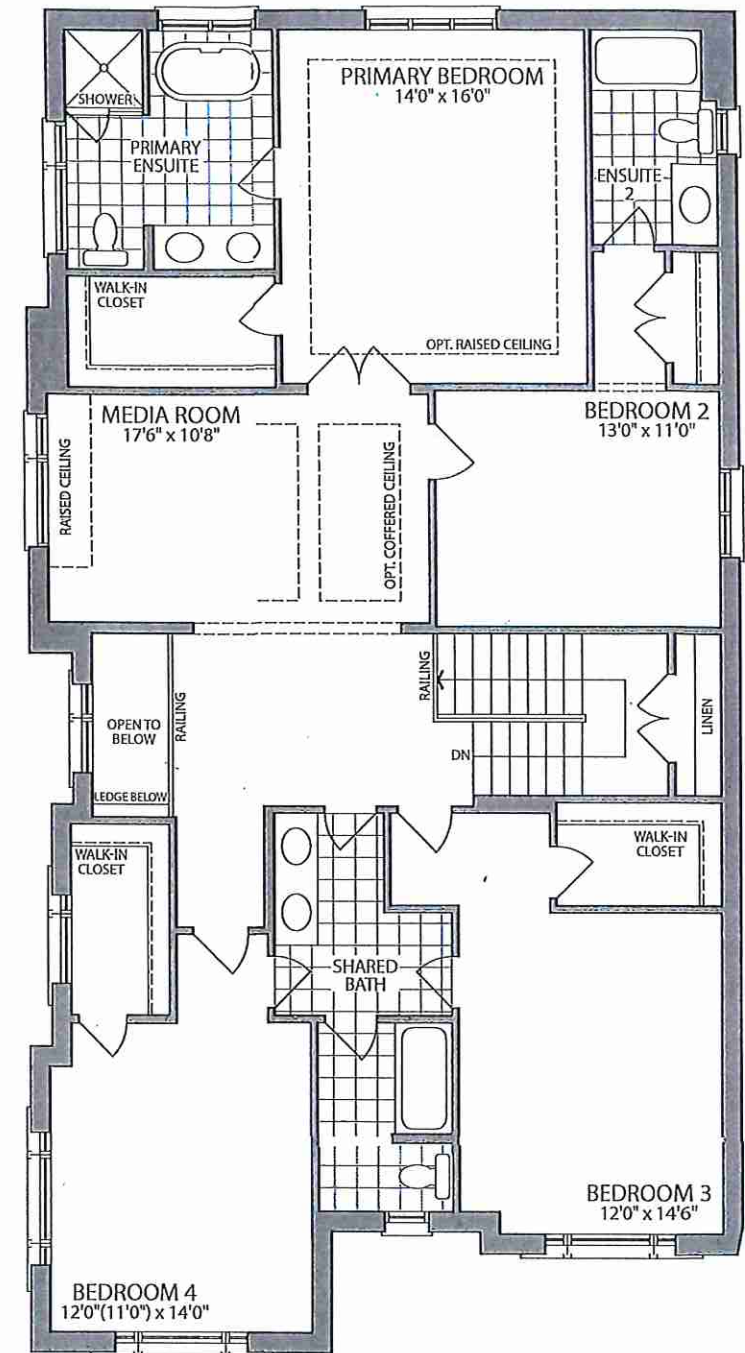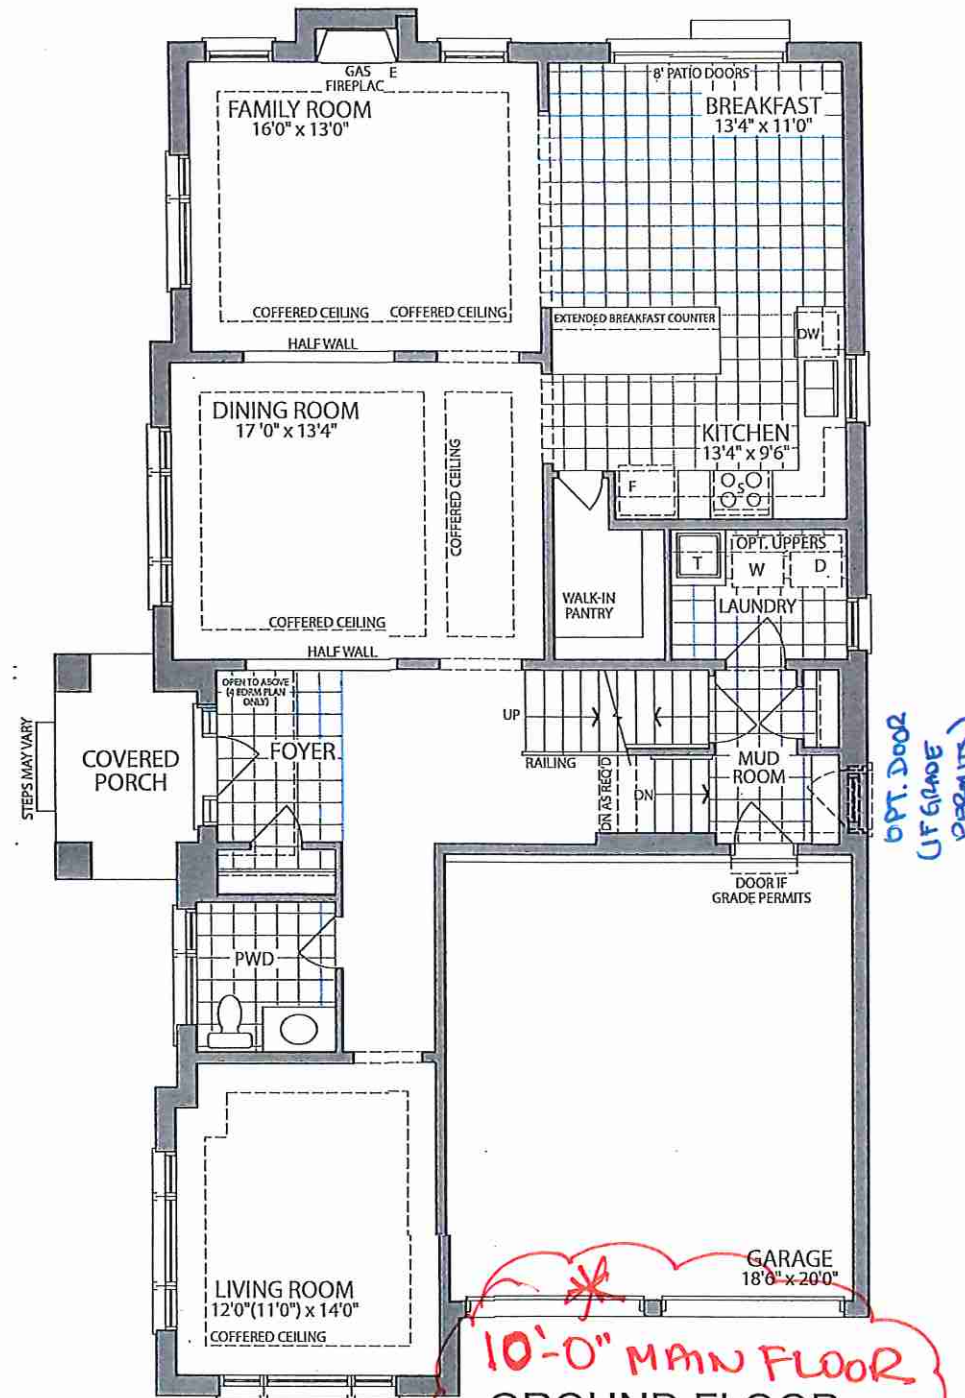

SECOND FLOOR  
ELEV. C

Materials, specifications and floor plans are subject to change without notice. All renderings are artist's concept. All floor plans are approximate dimensions. Actual usable floor space may vary from the stated floor area. E.&O.E.

LOT 47. 45-02 . The White Fir . EL. C. 4 BEDROOMS . 3350 SQ. FT.