



FILE COPY

Structural

CONSTRUCTION SUMMARY

Forestside Estates Inc.

PURCHASERS: MANDEEP SINGH MANGAT and HARKIRAN KAUR MANGAT

TEL:

LOT NUMBER	PHASE	HOUSE TYPE	CLOSING DATE
48	8	WHITE ORCHID (45-05S4C)-ELEV C-STD MAIN-4 BED	27-Jun-24

Offer	BONUS PACKAGE -PURCHASER TO RECEIVE \$20,000 (INCLUSIVE OF TAXES) WORTH OF UPGRADES AT DECOR CENTRE AT TIME OF COLOUR CHART
Worksheet	Note:



Offer	ELEVATION C HAS BEEN REQUESTED BY THE PURCHASER AS PER SCHEDULE G PAGE 1 AND WILL BE SUBJECT TO ARCHITECTURAL CONTROL AND APPROVAL.
Worksheet	Note:

Date Added: 29-Jun-23


Invoice Number: 8479

1 - BASEMENT-	Purcaser has declined extended height basement ceilings.
Note:	
1 - MAIN FLOOR-	Increase Main floor ceiling height to 10'-0". Includes Taller windows and 8'-0" interior taller doors ONLY
Note:	
1 - PURCHASER AWARE AND ACCEPTS THAT ANY CHANGES MADE TO UPGRADES AFTER SIGNING THIS PURCHASERS EXTRA FORM ARE SUBJECT TO A MINIMUM ADMINISTRATION FEE OF \$1,000	
Note:	
1 - BONUS PACKAGE-PURCHASER TO RECEIVE \$20,000 (INCLUSIVE OF TAXES) WORTH OF UPGRADES AT THE DESIGN STUDIO AT TIME OF COLOUR CHART	
Note:	


This Document is Extremely Time Sensitive - Printed 10 Jul 23 at 10:01

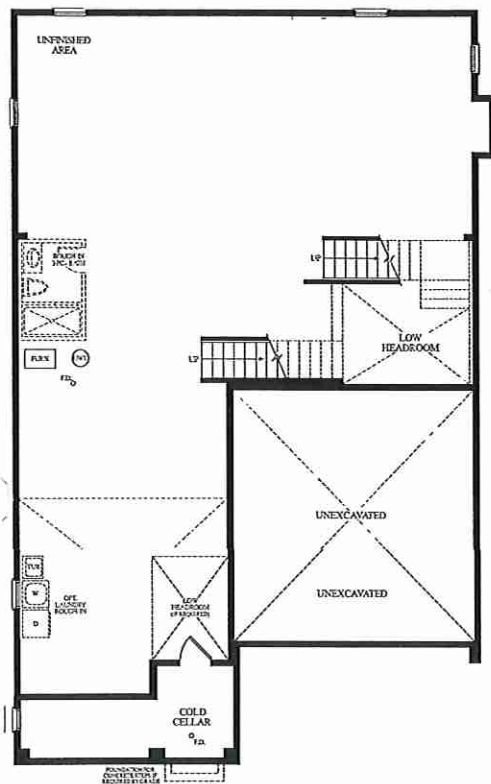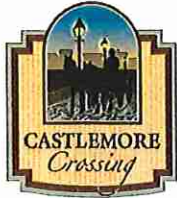

LOWER LEVEL  
ELEV. C

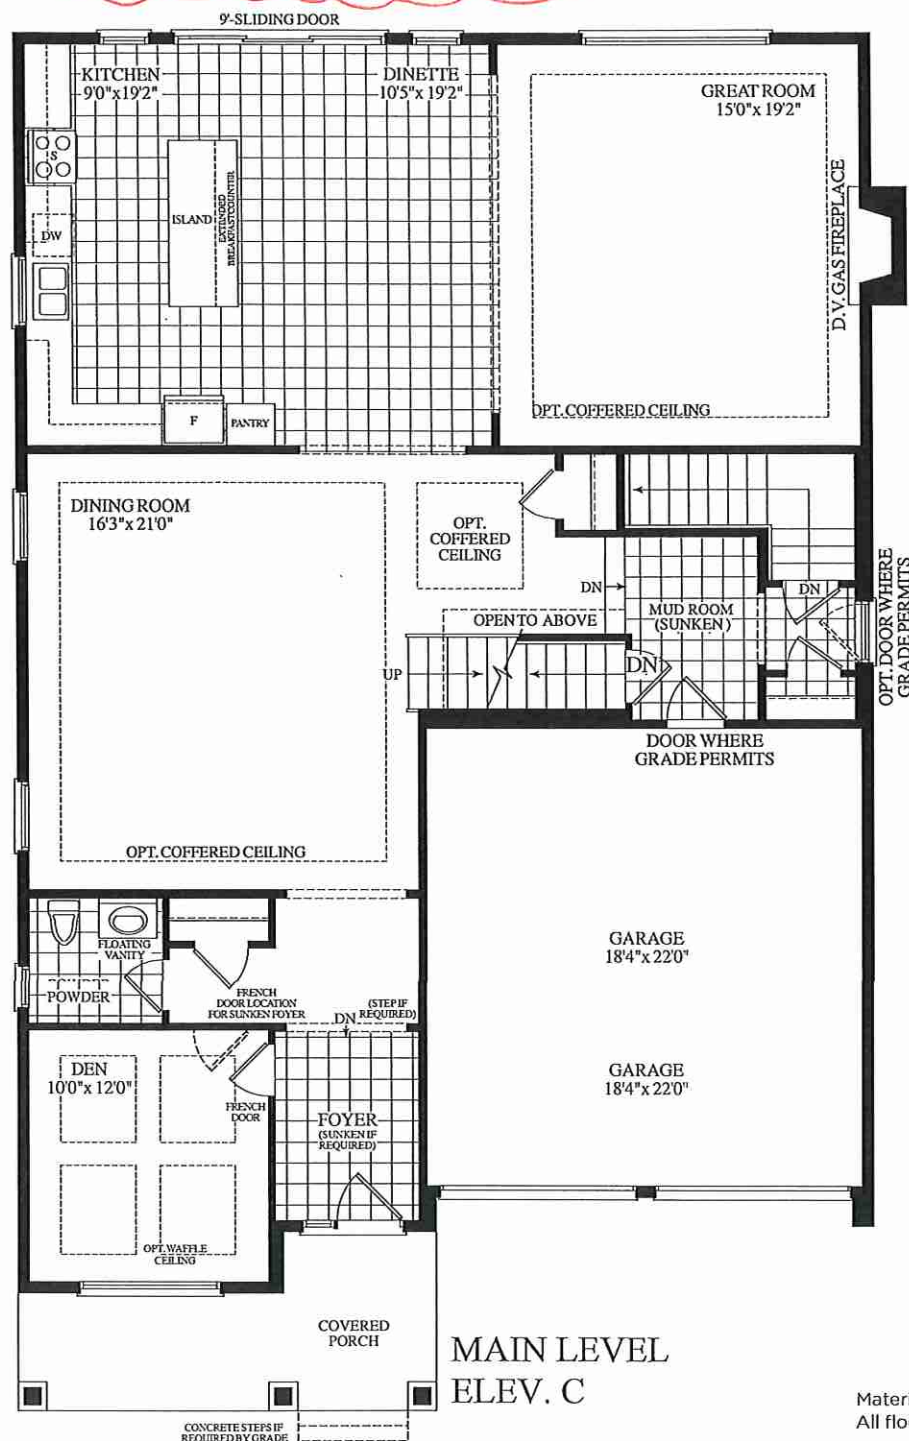

MAIN LEVEL  
ELEV. C

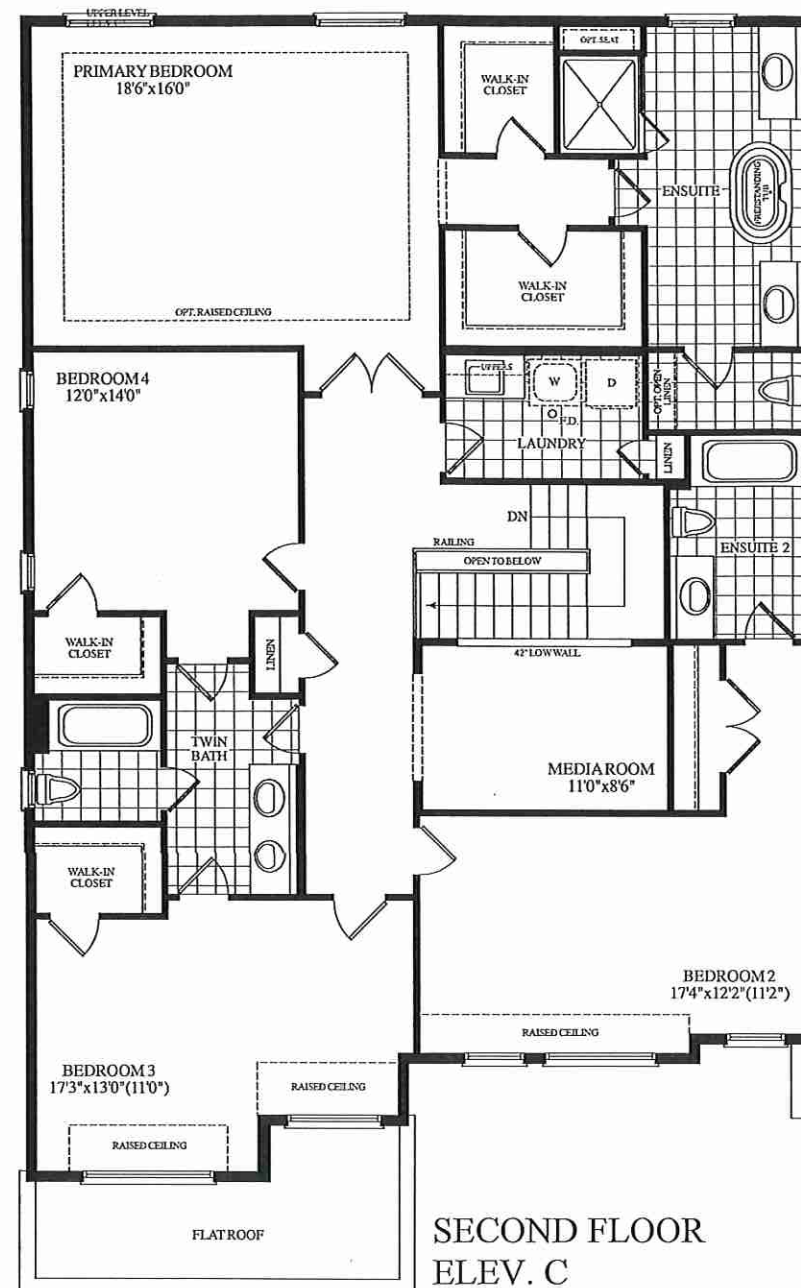

SECOND FLOOR  
ELEV. C

Materials, specifications and floor plans are subject to change without notice. All renderings are artist's concept. All floor plans are approximate dimensions. Actual usable floor space may vary from the stated floor area. E.&O.E.