



* INTERIOR COLOUR SCHEME * *RE SELECTION*

BUILDING

Purchaser SARBJIT KAUR KAMBOJ	Decor Consultant Denise Sue	Model and Elevation Red Pine 2D	Telephone Res. / Bus /	Project Forestside Estates Inc.	Closing Date 06/07/2023	Property 373 BLOCK 8
---	---------------------------------------	---	----------------------------------	---	-----------------------------------	--------------------------------

Page 1 of 3

Master Ensuite

Main Bathroom

Powder Room

Kitchen

Laundry

Mech. Room

Storage Room

Foyer

Main Hall

Living Room

Dining Room

2nd Floor Hall

Master Bedroom

Bedroom 2

Flooring

Description
12x24 H-Stone Light Beige - Horizontal/Stacked(STD)
12x24 H-Stone Light Beige - Horizontal/Stacked(STD)
12x24 H-Stone Light Beige - Horizontal/Stacked(STD)
8" Highland Watson Natural Oak EE-H-292(STD)
12x24 H-Stone Light Beige - Horizontal/Stacked(STD)
12x24 H-Stone Light Beige - Horizontal/Stacked(STD)
8" Highland Watson Natural Oak EE-H-292(STD)
12x24 H-Stone Light Beige - Horizontal/Stacked(STD)
8" Highland Watson Natural Oak EE-H-292(STD)
8" Highland Watson Natural Oak EE-H-292(STD)
8" Highland Watson Natural Oak EE-H-292(STD)
8" Highland Watson Natural Oak EE-H-292(STD)
8" Highland Watson Natural Oak EE-H-292(UPG)
8" Highland Watson Natural Oak EE-H-292(UPG)

Wall Tile

Main	Accent/Insert	Border / Listello	Pattern
8X10 Tuscany Gray (STANDARD)	N/A	N/A	N/A
8X10 Tuscany Gray (STANDARD)	N/A	N/A	N/A
N/A	N/A	N/A	N/A
3x6 Black Glossy-Stacked (STD)	N/A	N/A	N/A
N/A	N/A	N/A	N/A
N/A	N/A	N/A	N/A
N/A	N/A	N/A	N/A
N/A	N/A	N/A	N/A

Railings and Stairs

Railings	(Std)Oval Red Oak -Driftwood (Upg)	Landing - Upper	Watson Natural Oak EE-H-292
Pickets	N/A	Landing - Lower	N/A
Posts	(Std) 3 1/2" Sq. W/ Cap- Driftwood (Upg)	Ledge - Upper	N/A
Stringers	PAINTED WHITE(STANDARD)	Ledge - Lower	N/A
Treads	Mirage Red Oak Driftwood (UPG)		
Risers	PAINTED WHITE(STANDARD)		
Runner	N/A		

Trim

Baseboard & Casing	STANDARD	Knobs	STANDARD
Front Door Glass	N/A	Hinges	STANDARD
Interior Doors	STANDARD	Grip Set	STANDARD

Notes

Plumbing

WHITE
WHITE
WHITE
STD
N/A
N/A
N/A

Cornice Moulding / Medalion

Foyer	N/A
Living Room	N/A
Dining Room	N/A
Family Room	N/A
Main Hall	N/A
Kitchen	N/A
2nd Floor Hall	N/A

Page 1 of 3

Consultant: *DS*
Denise Sue

Purchaser: *Sarbjit K Kamboj*
SARBJIT KAUR KAMBOJ

Vendor: *[Signature]*
Forestside Estates Inc.



RED PINE

2D

2 BEDROOM | 2.5 BATH

1060 SQ FT

PLUS APPROXIMATELY
56 SQ FT
PATIO/BALCONY AREA

Suite: 373

BUILDING D

sb


* STANDARD KITCHEN
PACKAGE

* STANDARD APPLIANCE
PACKAGE



LOCATION OF
KITCHEN LIGHTS
REFER TO
KITCHEN DWG.

LEGEND:

-  SECURITY PANEL
-  ELECTRICAL PANEL
-  COMMUNICATION PANEL
-  WATER METER
-  DROPPED AREA

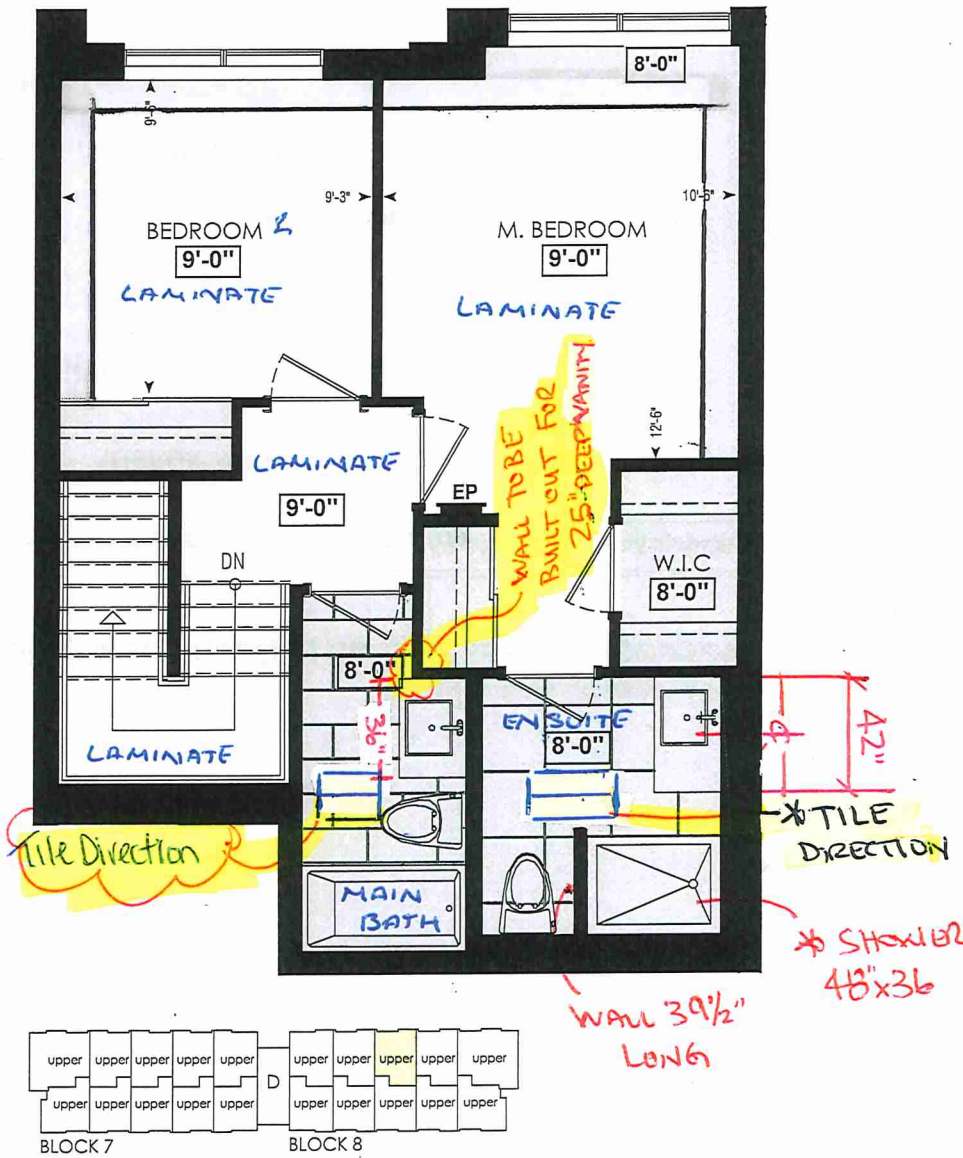

FOURTH FL.

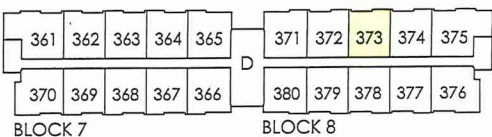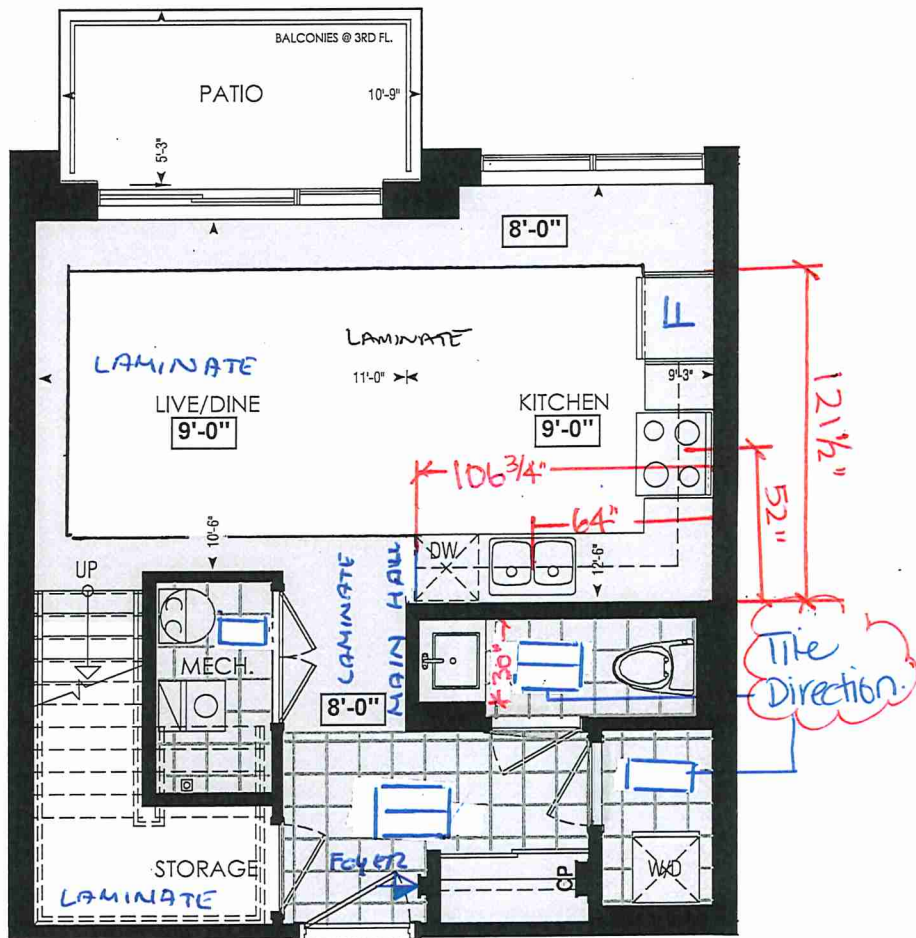

THIRD FL.



SITE COPY

Bldg "D"

CONSTRUCTION SUMMARY

Forestside Estates Inc.

PURCHASER: SARBJIT KAUR KAMBOJ TEL:

LOT NUMBER	PHASE	HOUSE TYPE	CLOSING DATE
373 BLOCK 8	6-III	Red Pine 2D	06-Jul-23

Date Added: 15-Jun-22 Invoice Number: 8306

1 - APPLIANCE PACKAGE- Install the Standard Appliance Package. To be installed throughout the suite, where applicable (See Sketch)

Note:

1 - KITCHEN & BATHROOMS - Purchaser has DECLINED All Upgrades offered during decor appointment at the decor centre for kitchen & bathroom cabinetry. Standard Kitchen Layout & Standard Bathroom Vanities to be installed as per standard plan. (See Sketch)

Note:

1 - KITCHEN- PLUMBING - Kitchen Faucet STANDARD- DELTA Chrome Osler Pull Down Kitchen Faucet (Single Hole) - Model # 976 LF

Note:

1 - KITCHEN-PLUMBING - Install the builders standard Top mount sink in the kitchen- Install the BLANCO HORIZON 2.0 (7") Top mount Sink- Model # 401124 (see sketch)

Note:

1 - KITCHEN - COUNTERTOP - Install Builders Standard Stone Countertop – Emmerstone Vanilla White with - To be installed throughout kitchen, where applicable (does not include stone backsplash) (See Sketch)

Note:

1 - KITCHEN - COUNTER - Install UPGRADED "L" EDGE throughout the kitchen where applicable. (see sketch)

Note:

1 - POWDER ROOM - COUNTERTOP - Install Builders Standard Stone Countertop - Emmerstone Vanilla White with STANDARD " A " EDGE PROFILE - To be installed throughout the Powder Room where applicable. To include 3" Splash(See Sketch)

Note:

1 - STAIRCASE – STAIN – STAIN STAIRCASE COMPLETE throughout where applicable from main to second floor. To be stained Mirage Red Oak Driftwood. To include handrail, treads, and posts.
Stringers and risers to remain painted white

Note: The purchaser agrees that the vendor is to be exempt from any and all claims by the purchaser regarding this colour variance.

1 - STAIRCASE VS FLOORING
WOOD SPECIES DIFFERENCE:
STAIRCASE - The purchaser was advised and therefore accepts and acknowledges that the wood species of the staircase and flooring chosen do not match. This difference may result in a stain colour variance.
Note: The purchaser agrees that the vendor is to be exempt from any and all claims by the purchaser regarding this colour variance.

1 - STAIRCASE VS FLOORING
STAINING DIFFERENCE:
STAIRCASE - The purchaser was advised and therefore accepts and acknowledges that the stain of the staircase and flooring chosen do not match. This difference might result in an undesirable colour variance.
Note: The purchaser agrees that the vendor is to be exempt from any and all claims by the purchaser regarding this colour variance.

1 - MAIN BATH- FLOORING - Purchaser accepts & acknowledges that the floor tiles on the Main Bath will be installed stacked NOT brick pattern.

Note:

1 - MASTER ENSUITE / MAIN BATH/ POWDER ROOM- Install the builders standard Plumbing Fixtures throughout all bathrooms, where applicable. To Include the Master Ensuite , Main Bath, & Powder Room

Note:

1 - MASTER ENSUITE / MAIN BATH/ POWDER ROOM- Install the Standard 3" Splash throughout all bathroom vanity counter tops, where applicable. To include the Powder Room, Main Bath and the Master Ensuite

Note:

1 - MAIN BATH - COUNTERTOP - Install Builders Standard Stone Countertop - Emmerstone Maple White with STANDARD " A " EDGE PROFILE - To be installed throughout the main bath where applicable. To include 3" Splash(See Sketch)

Note:



SITE COPY

CONSTRUCTION SUMMARY
Forestside Estates Inc.

PURCHASER: SARBJIT KAUR KAMBOJ TEL:

LOT NUMBER	PHASE	HOUSE TYPE	CLOSING DATE	
373 BLOCK 8	6-III	Red Pine 2D	06-Jul-23	

Date Added: 15-Jun-22 Invoice Number: 8306

1 - MASTER ENSUITE - COUNTERTOP - Install Builders Standard Stone Countertop - Emmerstone Maple White with STANDARD " A " EDGE PROFILE - To be installed throughout the Master Ensuite where applicable. To include 3" Splash(See Sketch) Note:
1 - KITCHEN/MAIN BATH/ POWER ROOM/ MASTER ENSUITE – COUNTER-Stone slabs vary in size & all seams are visible & the fabricator reserves the right to position the seams as necessary. Note:
1 - MASTER BEDROOM - FLOORING - Install UPGRADED LAMINATE throughout the master bedroom where applicable in lieu of the builder's standard broadloom. Install 8" HIGHLAND WATSON NATURAL OAK EE-H-292. To include shoe moulding (See sketch) Note:
1 - BEDROOM 2 - FLOORING - Install UPGRADED LAMINATE throughout bedroom 2 where applicable in lieu of the builder's standard broadloom. Install 8" HIGHLAND WATSON NATURAL OAK EE-H-292. To include shoe moulding (See sketch) Note:
1 - PURCHASER AWARE AND ACCEPTS THAT ANY CHANGES MADE TO UPGRADES AFTER SIGNING THIS PURCHASERS EXTRA FORM ARE SUBJECT TO A MINIMUM ADMINISTRATION FEE OF \$1000 PLUS A 10% HOLDBACK FEE. Note:
1 - PURCHASER HAS ATTENDED A STRUCTURAL AND COLOR APPOINTMENT AT THE DECOR CENTRE AND HAS DECLINED ANY ADDITIONAL UPGRADES. Note:

This Document is Extremely Time Sensitive - Printed 27 Oct 22 at 11:28



* INTERIOR COLOUR SCHEME *

BUILDING D

Purchaser	Decor Consultant	Model and Elevation	Telephone Res. / Bus	Project	Closing Date	Property
SARBJIT KAUR KAMBOJ	Denise Sue	Red Pine 2D	/	Forestside Estates Inc.	06/07/2023	373 BLOCK 8

Page 2 of 3

	Interior Paint	Cabinet	Countertop	Counter Edge	Handle / Knob
Master Ensuite	<u>Description</u> DISTANT GRAY (STANDARD)	<u>Style</u> CAT.1 QT1022 Frosting LP LAMINATE (STANDARD)	☒ Emmerstone Maple White (STD)	☒ "A" (STANDARD)	DH01010(Std)
Main Bathroom	DISTANT GRAY (STANDARD)	CAT.1 QT1022 Frosting LP LAMINATE (STANDARD)	☒ Emmerstone Maple White (STD)	☒ "A" (STANDARD)	DH01010(Std)
Powder Room	DISTANT GRAY (STANDARD)	CAT.1 QT1022 Chiostro LP LAMINATE (STANDARD)	☒ Emmerstone Vanilla White (STD)	☒ "A" (STANDARD)	DH01010(Std)
Kitchen	DISTANT GRAY (STANDARD)	CAT.1 QT1022 Chiostro LP LAMINATE (STANDARD)	☒ Emmerstone Vanilla White (STD)	☒ "L" (UPGRADE)	DH00010(Std)
Laundry	DISTANT GRAY (STANDARD)	N/A	N/A	N/A	N/A
Mech. Room	DISTANT GRAY (STANDARD)	N/A	N/A	N/A	N/A
Storage Room	DISTANT GRAY (STANDARD)	N/A	N/A	N/A	N/A
Foyer	DISTANT GRAY (STANDARD)	N/A	N/A	N/A	N/A
Main Hall	DISTANT GRAY (STANDARD)	N/A	N/A	N/A	N/A
Living Room	DISTANT GRAY (STANDARD)				
Dining Room	DISTANT GRAY (STANDARD)				
2nd Floor Hall	DISTANT GRAY (STANDARD)				
Master Bedroom	DISTANT GRAY (STANDARD)				
Bedroom 2	DISTANT GRAY (STANDARD)				

Appliance Opening/Dimension

Fridge Size Range

Built-Ins Microwave

Hood Fan Exhaust Opening ☒ 6" ☐ 8"

Dishwasher Cabinet


Fireplace

Fireplace	N/A	Fireplace	N/A
Location Flooring	N/A	Location Flooring	N/A
Style	N/A	Style	N/A
Finish	N/A	Finish	N/A
Marble	N/A	Marble	N/A
Hearth	N/A	Hearth	N/A


Notes

*STANDARD KITCHEN APPLINACES

Page 2 of 3

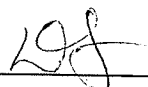Decor Consultant: 
Denise Sue

Purchaser: 
SARBJIT KAUR KAMBOJ

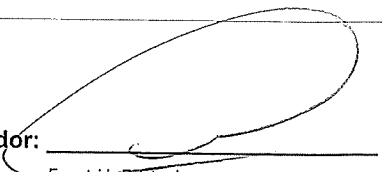Vendor: 
Forestside Estates Inc.



80 Sante Drive, Vaughan, ON L4K 3C4
T 416.746.1811 F 905.761.5901
www.QTK.ca info@qtk.ca

CLIENT: ROYAL PINE HOMES	JOB NAME: 2D	ROOM: KITCHEN + VANITY	DRAWN BY: VGP
SITE: FOREST SIDE	DOOR STYLE: —	DOOR HANDLE: —	SCALE: 1/2" = 1'-0"
PHONE: —	FINISH: —	DRW HANDLE: —	DATE: 05 th Oct 2021
EMAIL: —	SPECIES: —	TOP: —	PAGE:



COMMENTS: **BUILDING D SUITE 373 BUK 8**

Customer Agrees and Accepts the following conditions: 1. The Drawing is a representation only and the installed cabinetry may vary slightly in product size, measurements, handle appearance and location and other details. Although Quality Tops & Kitchens Ltd. (QTK) does it's best to manufacture exactly what is shown here outside factors may prevent that and some variance is to be expected and accepted by the customer. 2. These drawings represent the intellectual property of QTK and as such the customer understands and accepts that all deposits given by the customer to QTK are non-refundable after QTK has supplied drawings (either physically or electronically) to the customer. If the customer decides to cancel the order after QTK has submitted drawings to the customer, the deposit will then be considered a design fee and no money will be returned to the customer.

KITCHEN PLAN


2D : 24 nos.


Sb

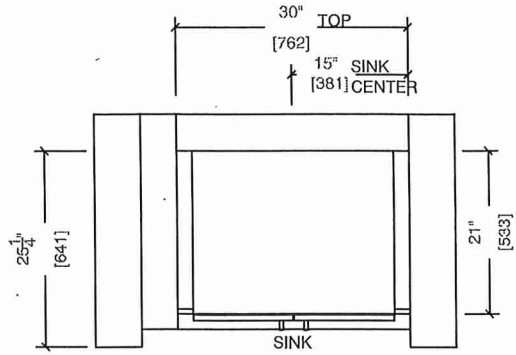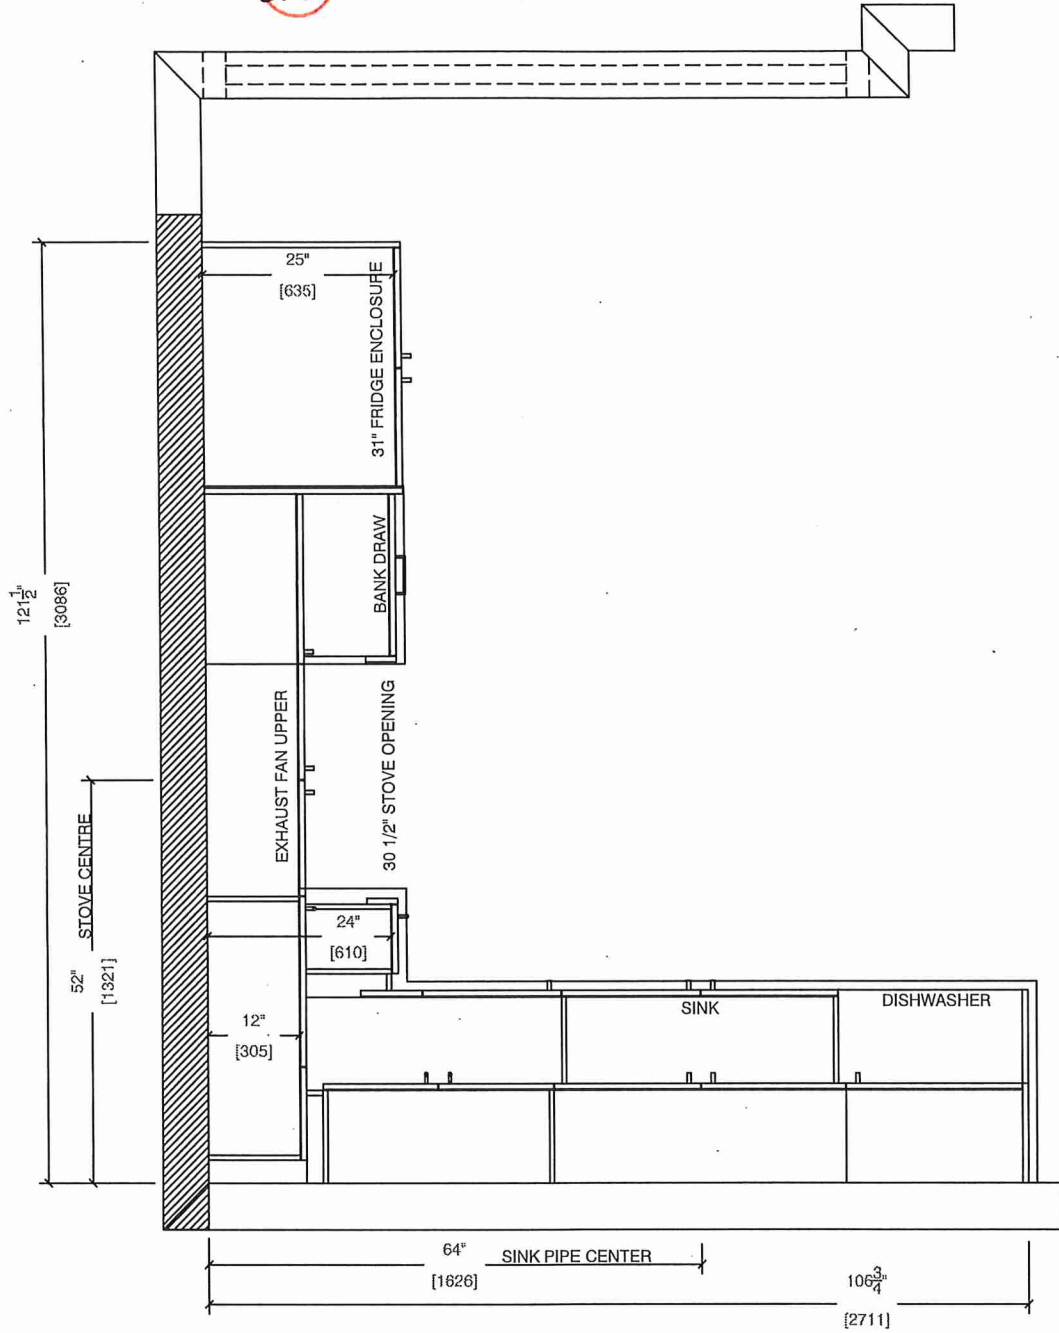

Powder Room 3rd Floor BATH

2D : 24 nos.

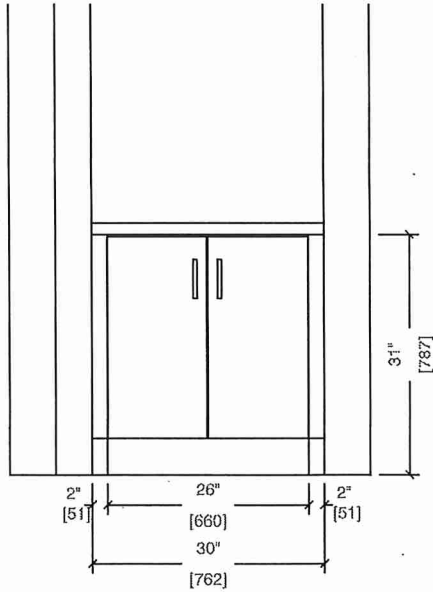

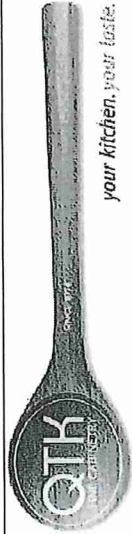



80 Sante Drive, Vaughan, ON L4K 3C4
T 416.746.1811 F 905.761.5901
www.QTK.ca info@qtk.ca

CLIENT: ROYAL PINE HOMES	JOB NAME: 2D	ROOM: KITCHEN + VANITY	DRAWN BY: VGP
SITE: FOREST SIDE	DOOR STYLE: —	DOOR HANDLE: —	SCALE: 1/2" = 1'-0"
PHONE: —	FINISH: —	DRW HANDLE: —	DATE: 05 th Oct 2021
EMAIL: —	SPECIES: —	TOP: —	PAGE:


COMMENTS: **BUILDING D SUITE 373 Bk 8**


Customer Agrees and Accepts the following conditions: 1. The Drawing is a representation only and the installed cabinetry may vary slightly in product size, measurements, handle appearance and location and other details. Although Quality Tops & Kitchens Ltd. (QTK) does it's best to manufacture exactly what is shown here outside factors may prevent that and some variance is to be expected and accepted by the customer. 2. These drawings represent the intellectual property of QTK and as such the customer understands and accepts that all deposits given by the customer to QTK are non-refundable after QTK has supplied drawings (either physically or electronically) to the customer. If the customer decides to cancel the order after QTK has submitted drawings to the customer, the deposit will then be considered a design fee and no money will be returned to the customer.

STOVE WALL ELEVATION

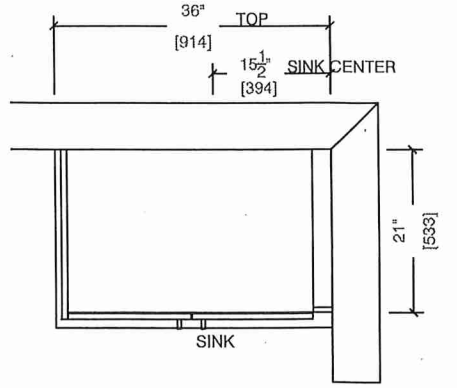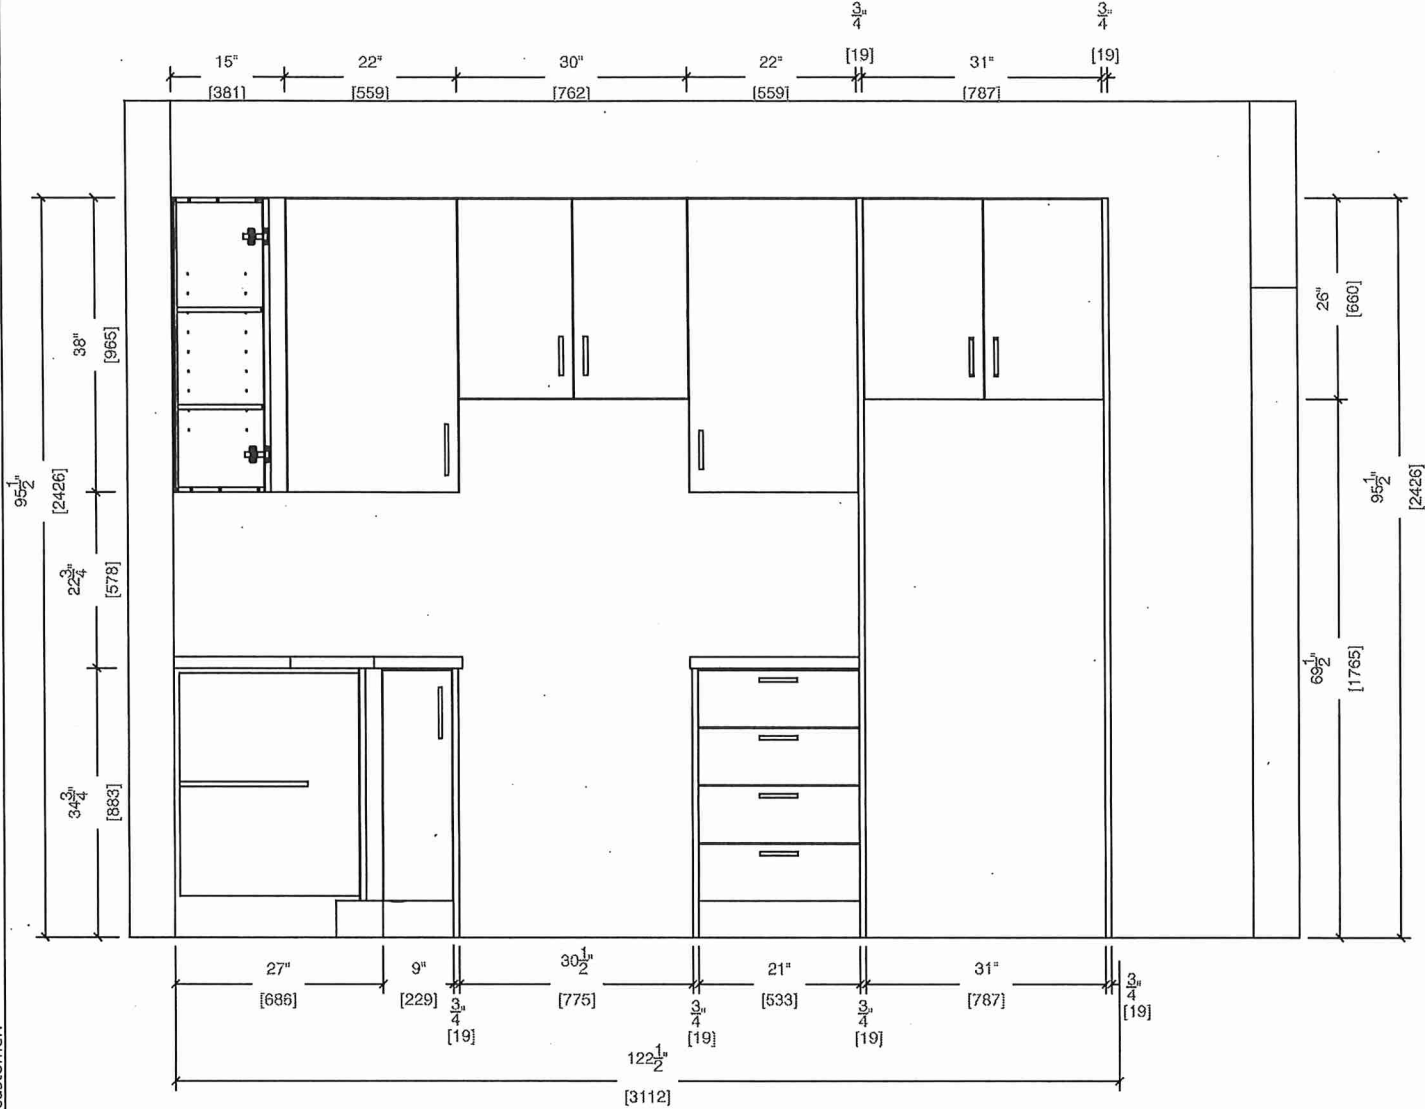

MAIN BATH
4th Floor BATH

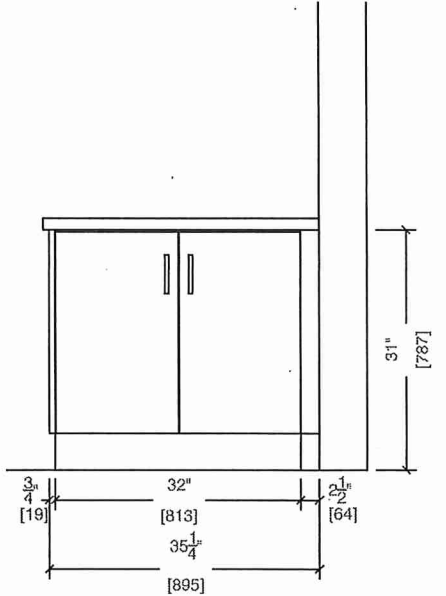

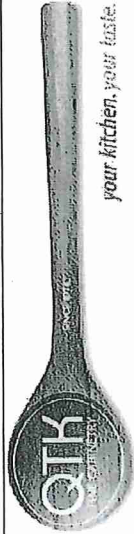

80 Sante Drive, Vaughan, ON L4K 3C4
T 416.746.1811 F 905.761.5901
www.QTK.ca info@qtk.ca


CLIENT: ROYAL PINE HOMES	JOB NAME: 2D	ROOM: KITCHEN + VANITY	DRAWN BY: VGP
SITE: FOREST SIDE	DOOR STYLE: —	DOOR HANDLE: —	SCALE: 1/2" = 1'-0"
PHONE: —	FINISH: —	DRW HANDLE: —	DATE: 05 th Oct 2021
EMAIL: —	SPECIES: —	TOP: —	PAGE:

COMMENTS: BUILDING D SUITE 373 BUK 8


Customer Agrees and Accepts the following conditions: 1. The Drawing is a representation only and the installed cabinetry may vary slightly in product size, measurements, handle appearance and location and other details. Although Quality Tops & Kitchens Ltd. (QTK) does it's best to manufacture exactly what is shown here outside factors may prevent that and some variance is to be expected and accepted by the customer. 2. These drawings represent the intellectual property of QTK and as such the customer understands and accepts that all deposits given by the customer to QTK are non-refundable after QTK has supplied drawings (either physically or electronically) to the customer. If the customer decides to cancel the order after QTK has submitted drawings to the customer, the deposit will then be considered a design fee and no money will be returned to the customer.

SINK WALL ELEVATION

36

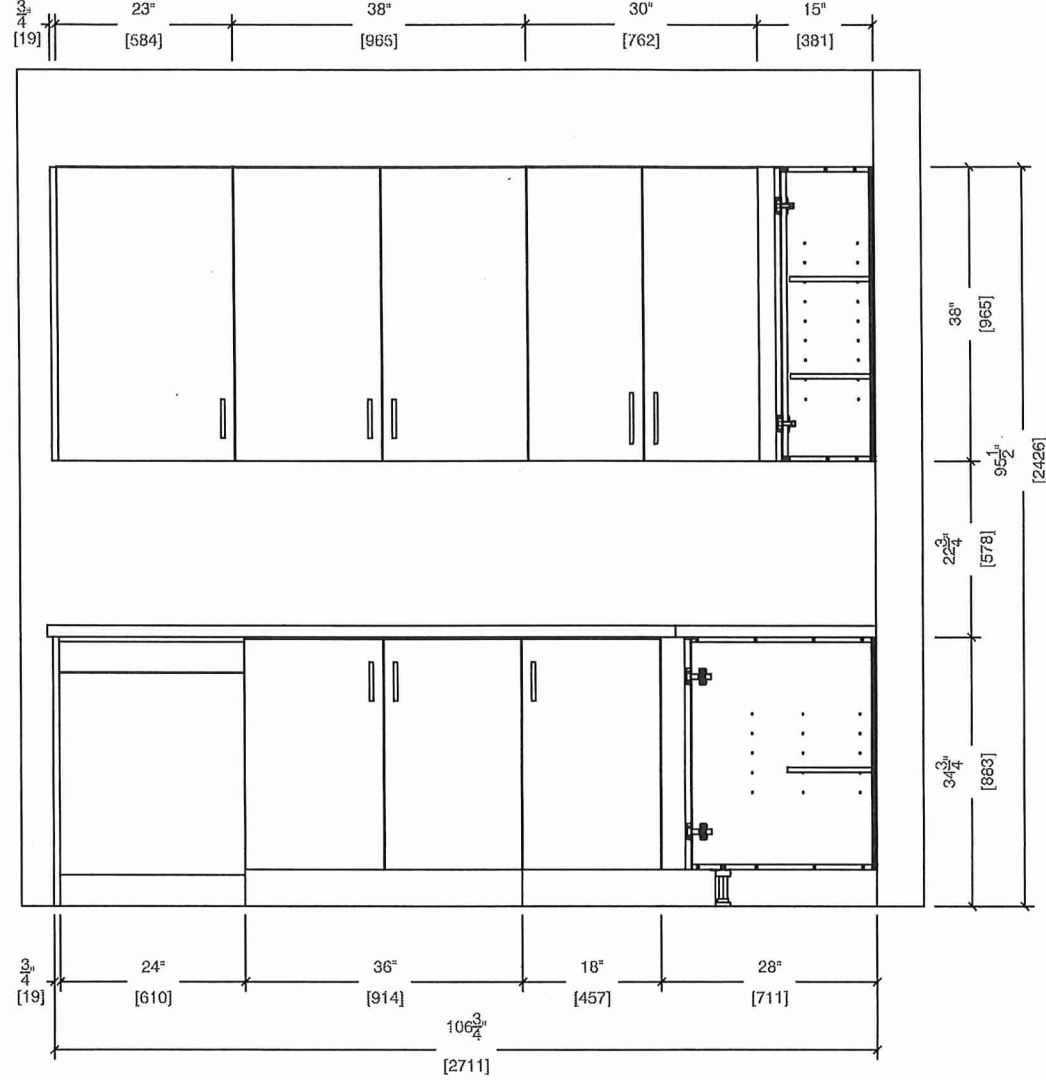

4th Floor ENSUITE

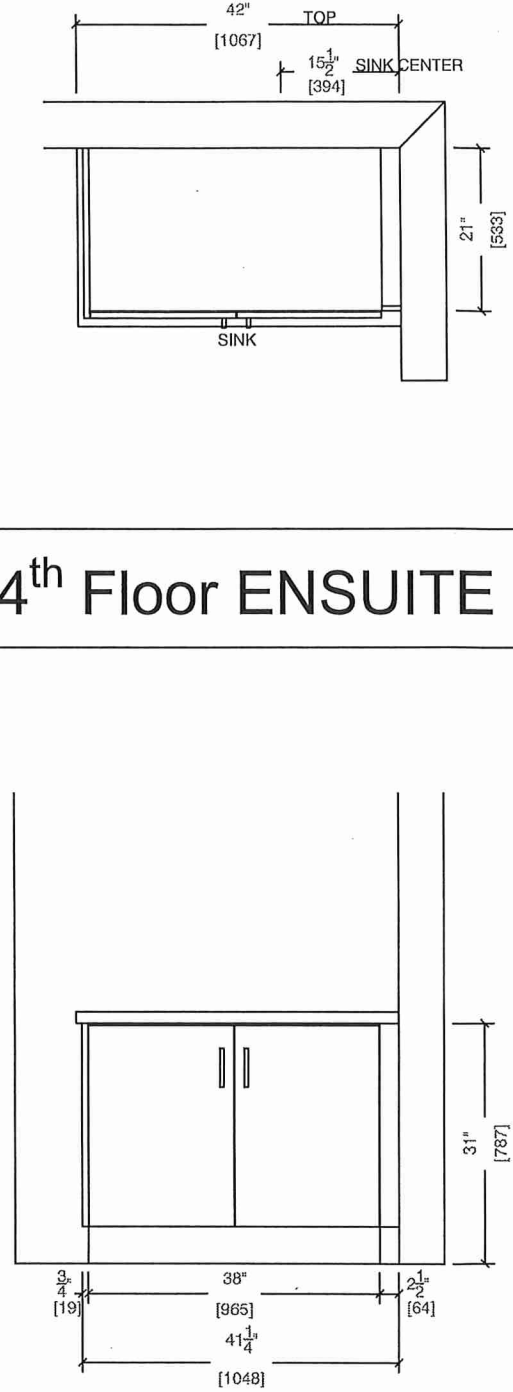




80 Sante Drive, Vaughan, ON L4K 3C4
T 416.746.1811 F 905.761.5901
WWW.QTK.ca info@qtk.ca

CLIENT: ROYAL PINE HOMES	JOB NAME: 2D	ROOM: KITCHEN	DRAWN BY: VGP
SITE: FOREST SIDE	DOOR STYLE: —	DOOR HANDLE: —	SCALE: 1/2" = 1'-0"
PHONE: —	FINISH: —	DRW HANDLE: —	DATE: 08 th Oct 2021
EMAIL: —	SPECIES: —	TOP: —	PAGE:

COMMENTS:

BUILDING D SURE 373 BUK8

Customer Agrees and Accepts the following conditions: 1. The Drawing is a representation only and the installed cabinetry may vary slightly in product size, measurements, handle appearance and location and other details. Although Quality Tops & Kitchens Ltd. (QTK) does it's best to manufacture exactly what is shown here outside factors may prevent that and some variance is to be expected and accepted by the customer. 2. These drawings represent the intellectual property of QTK and as such the customer understands and accepts that all deposits given by the customer to QTK are non-refundable after QTK has supplied drawings (either physically or electronically) to the customer. If the customer decides to cancel the order after QTK has submitted drawings to the customer, the deposit will then be considered a design fee and no money will be returned to the customer.

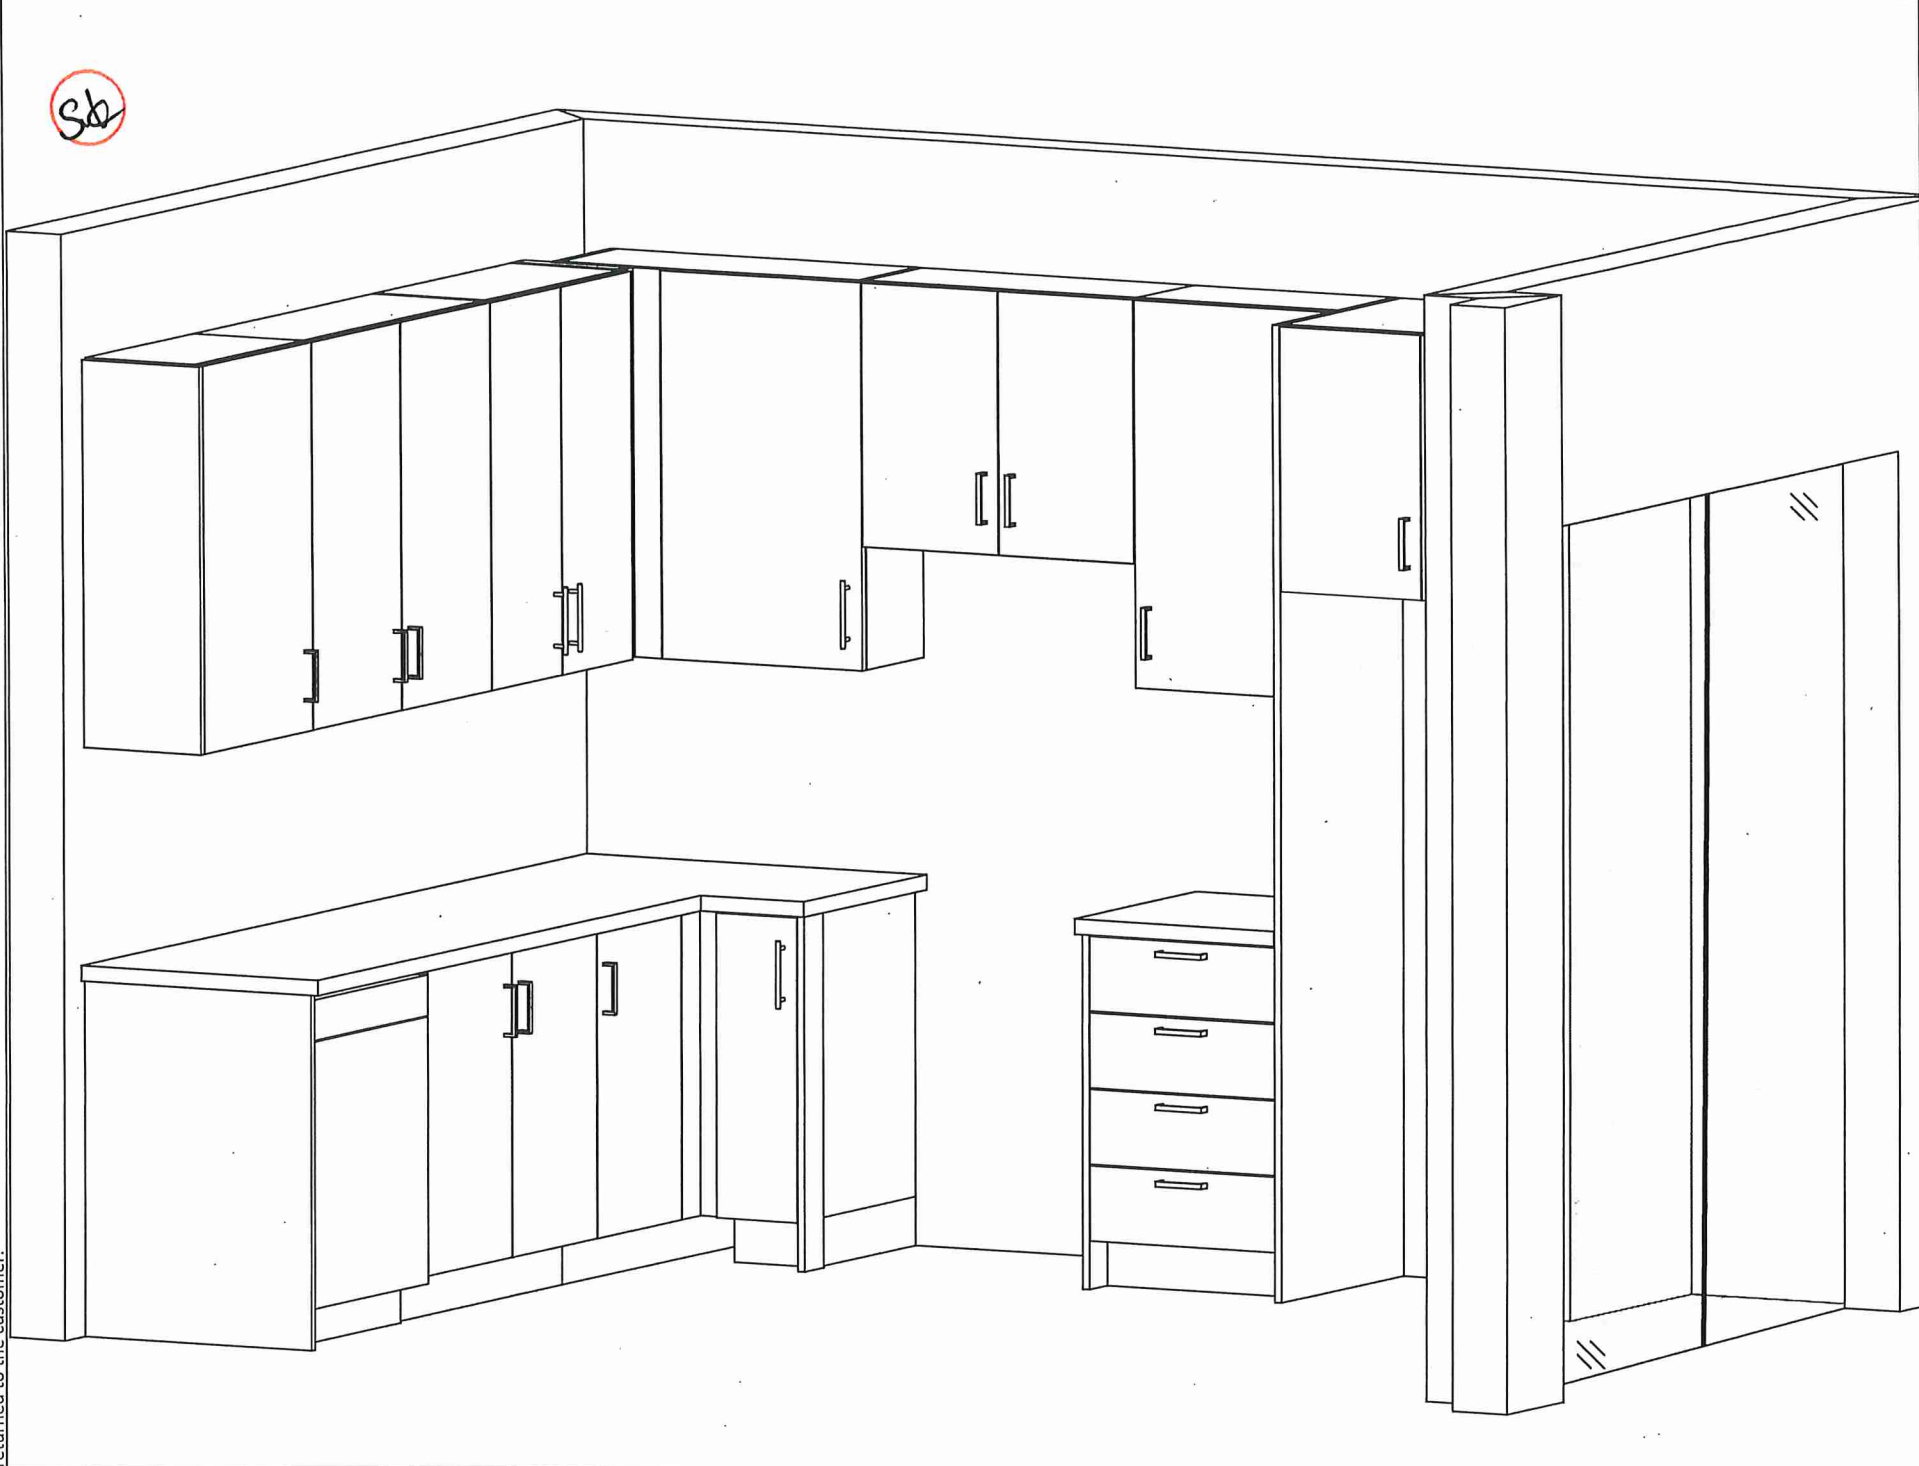


BUILDING D SUITE 373 BUK 8

CONNOLLY Marble & Granite Ltd.

EDGE
DETAILS

004

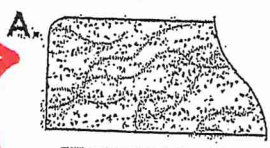

STRAIGHT EDGE
(STANDARD - 3/4")

* POWDER ROOM
* MASTER ENSUITE
* MAIN BATH




** L



MITER WITH SKIRT EDGE
(MEDIUM - 1 1/2")

* KITCHEN * UPGRADE *

M

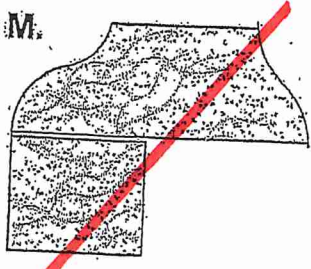

OGEE - SQUARE EDGE
(MED./HIGH - 1 1/2")

EDGING UP-GRADE OPTIONS

RECEIVED
OCT 5 1977