

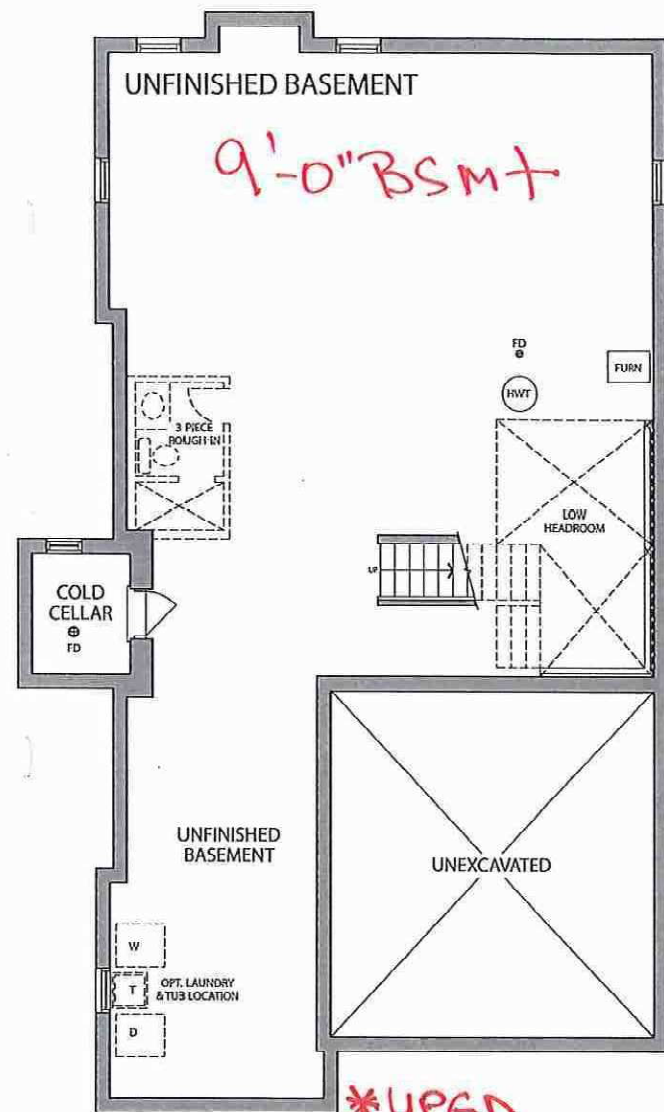


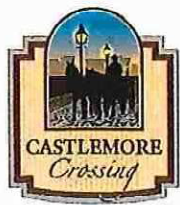


BASEMENT
ELEV. A

9'-0"
BSM+

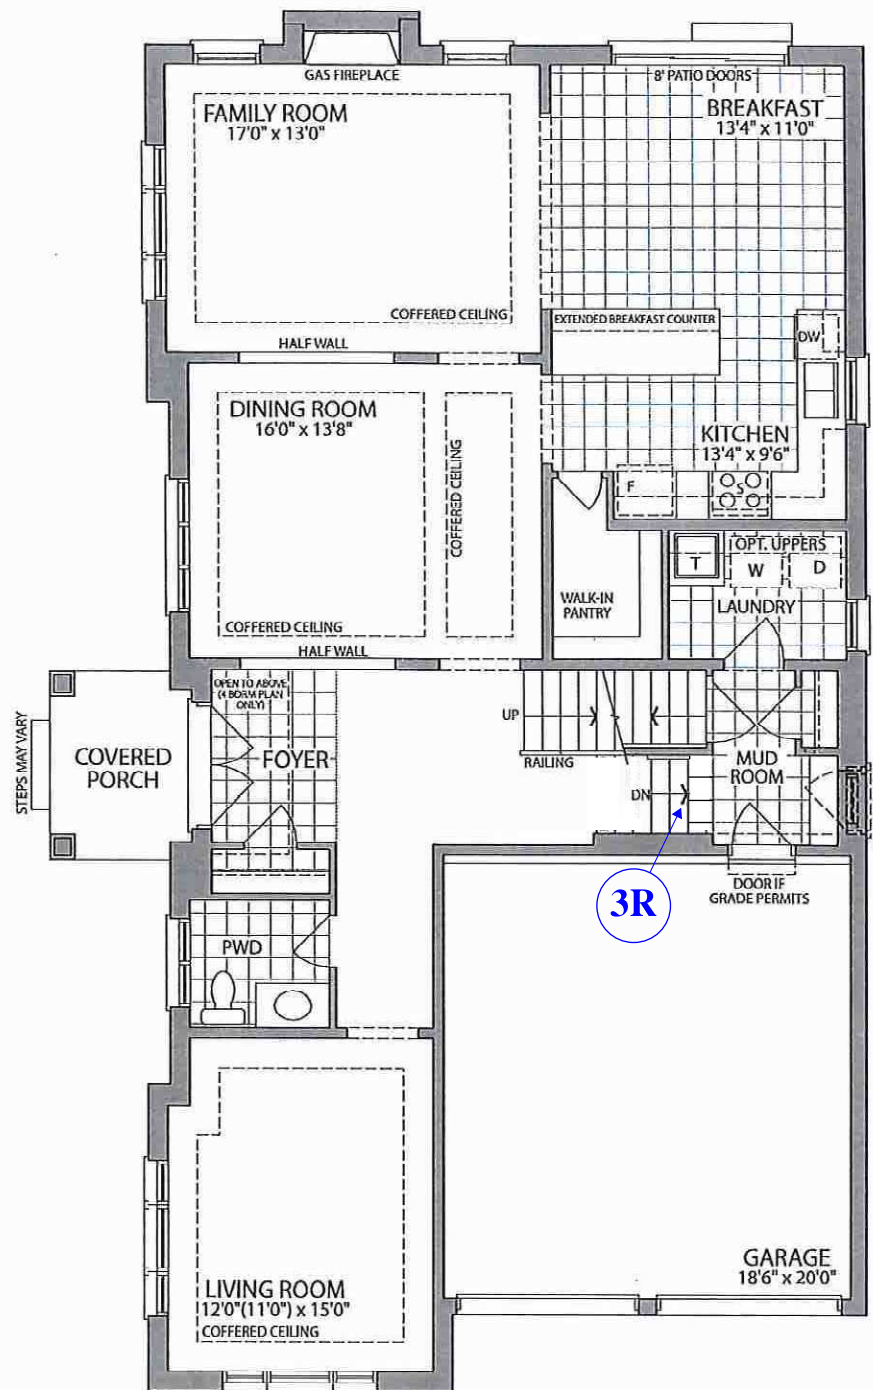


GROUND FLOOR
ELEV. A

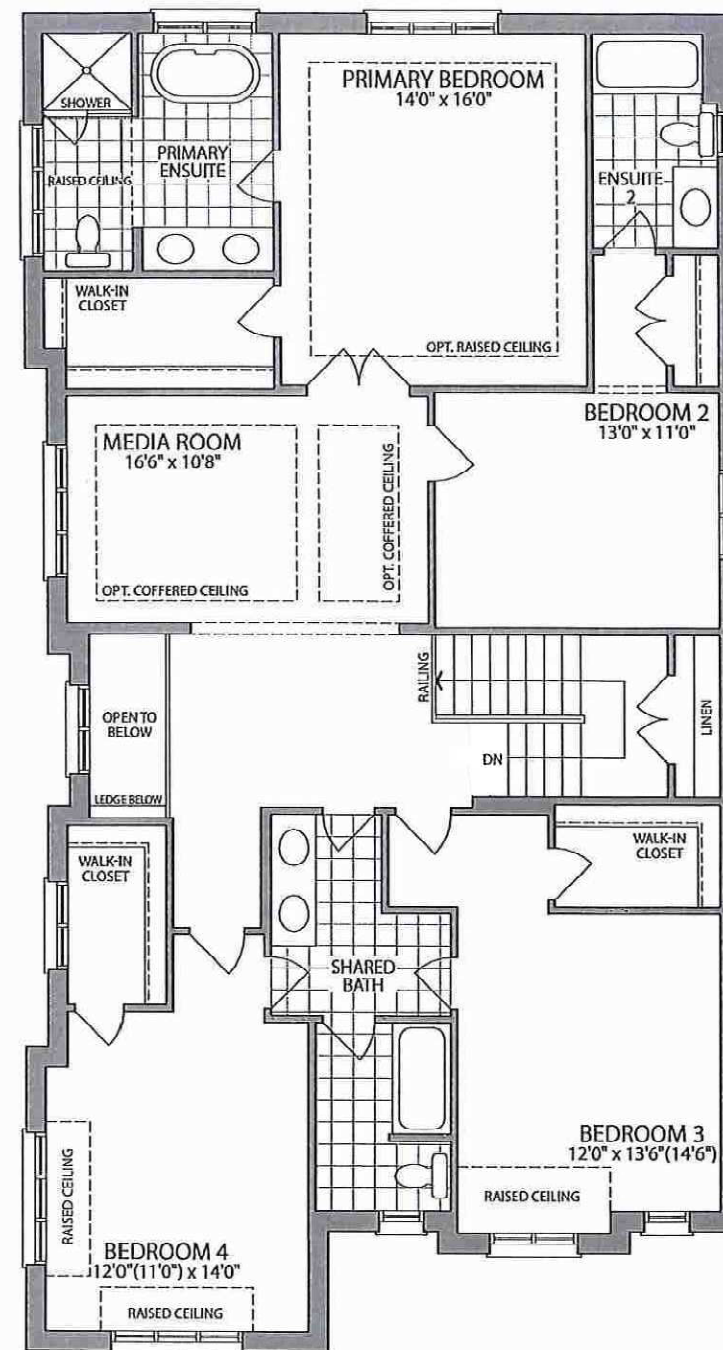

SECOND FLOOR
ELEV. A

Materials, specifications and floor plans are subject to change without notice. All renderings are artist's concept. All floor plans are approximate dimensions. Actual usable floor space may vary from the stated floor area. E.&O.E.

LOT 1. 45-02 . The White Fir . EL.A . 4 BEDROOMS . 3350 SQ.FT.

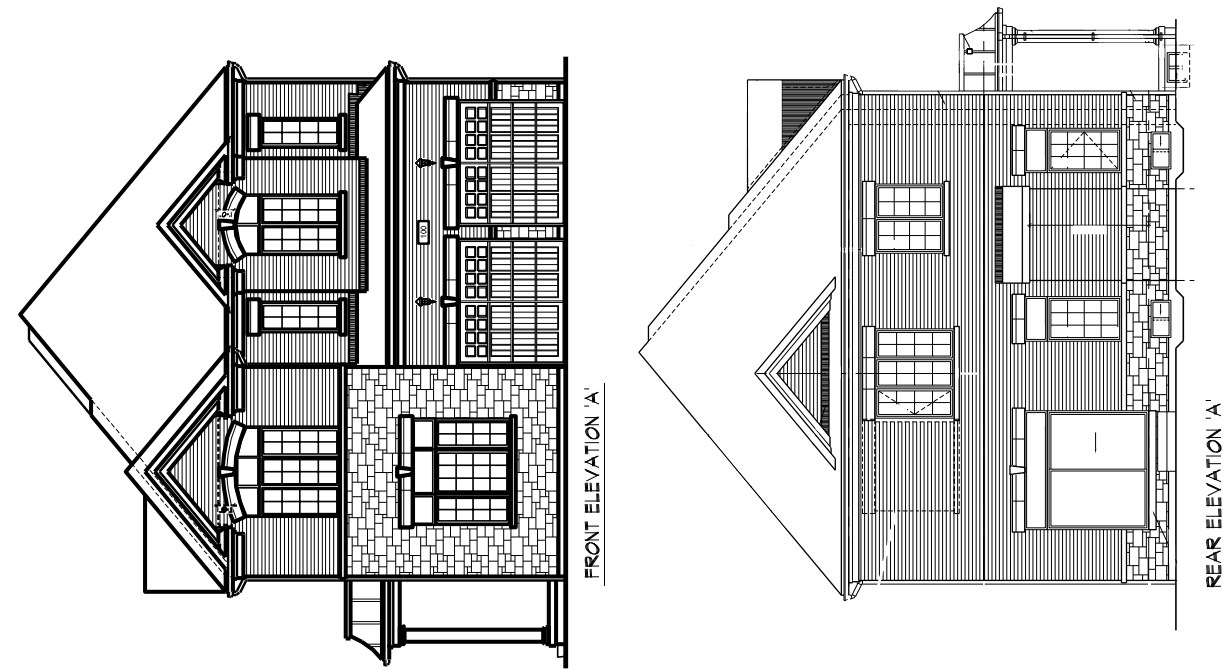

SCHEDULE "B"

Purchaser	PAWANDEEP KAUR GREWAL
And	
Vendor	Forestside Estates Inc.
Lot Number	1 DOLOMITE DR, Phase 8, Plan as per schedule C in the CITY of BRAMPTON
Date of Offer	April 23, 2023
Dated Required:	July 16, 2024
Model:	WHITE FIR (45-02A4) - ELEV A - 4 BEDROOM ()
Description - Vendor to Supply and Install the Following as Per Purchase Price	
■ BONUS PACKAGE -PURCHASER TO RECEIVE \$20,000 (INCLUSIVE OF TAXES) WORTH OF UPGRADES AT DECOR CENTRE AT TIME OF COLOUR CHART	