



CONSTRUCTION SUMMARY

Forestside Estates Inc.

PURCHASER: ABDOL GAMAL HAMID

TEL: RES.: 416-450-3424



LOT NUMBER	PHASE	HOUSE TYPE	CLOSING DATE
7	8	WHITE CYPRESS (45-01CS5)-ELEV C-STD MAIN-OPT 2ND	15-Aug-24

Offer	BONUS PACKAGE -PURCHASER TO RECEIVE \$20,000 (INCLUSIVE OF TAXES) WORTH OF UPGRADES AT DECOR CENTRE AT TIME OF COLOUR CHART
Worksheet	Note:


Date Added: 24-May-23      Invoice Number: 8470

1 - BASEMENT-	Increase basement height to APPROXIMATELY 9'-0" as per vendors specifications and architectural drawings.
	Note:
1 - PURCHASER AWARE AND ACCEPTS THAT ANY CHANGES MADE TO UPGRADES AFTER SIGNING THIS PURCHASERS EXTRA FORM ARE SUBJECT TO A MINIMUM ADMINISTRATION FEE OF \$1,000	
	Note:
1 - BONUS PACKAGE-PURCHASER TO RECEIVE \$20,000 (INCLUSIVE OF TAXES) WORTH OF UPGRADES AT THE DESIGN STUDIO AT TIME OF COLOUR CHART	
	Note:


This Document is Extremely Time Sensitive - Printed 27 Jun 23 at 14:01

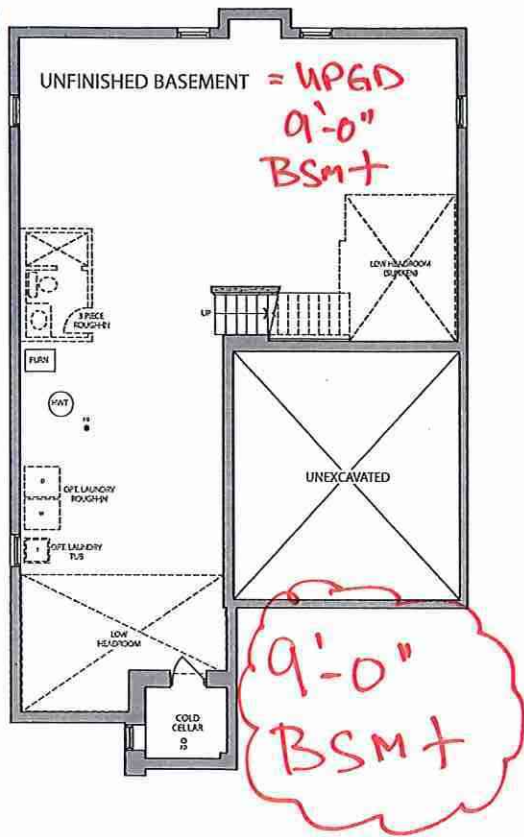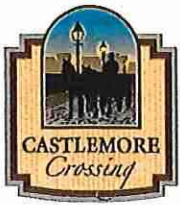

BASEMENT ELEV. C

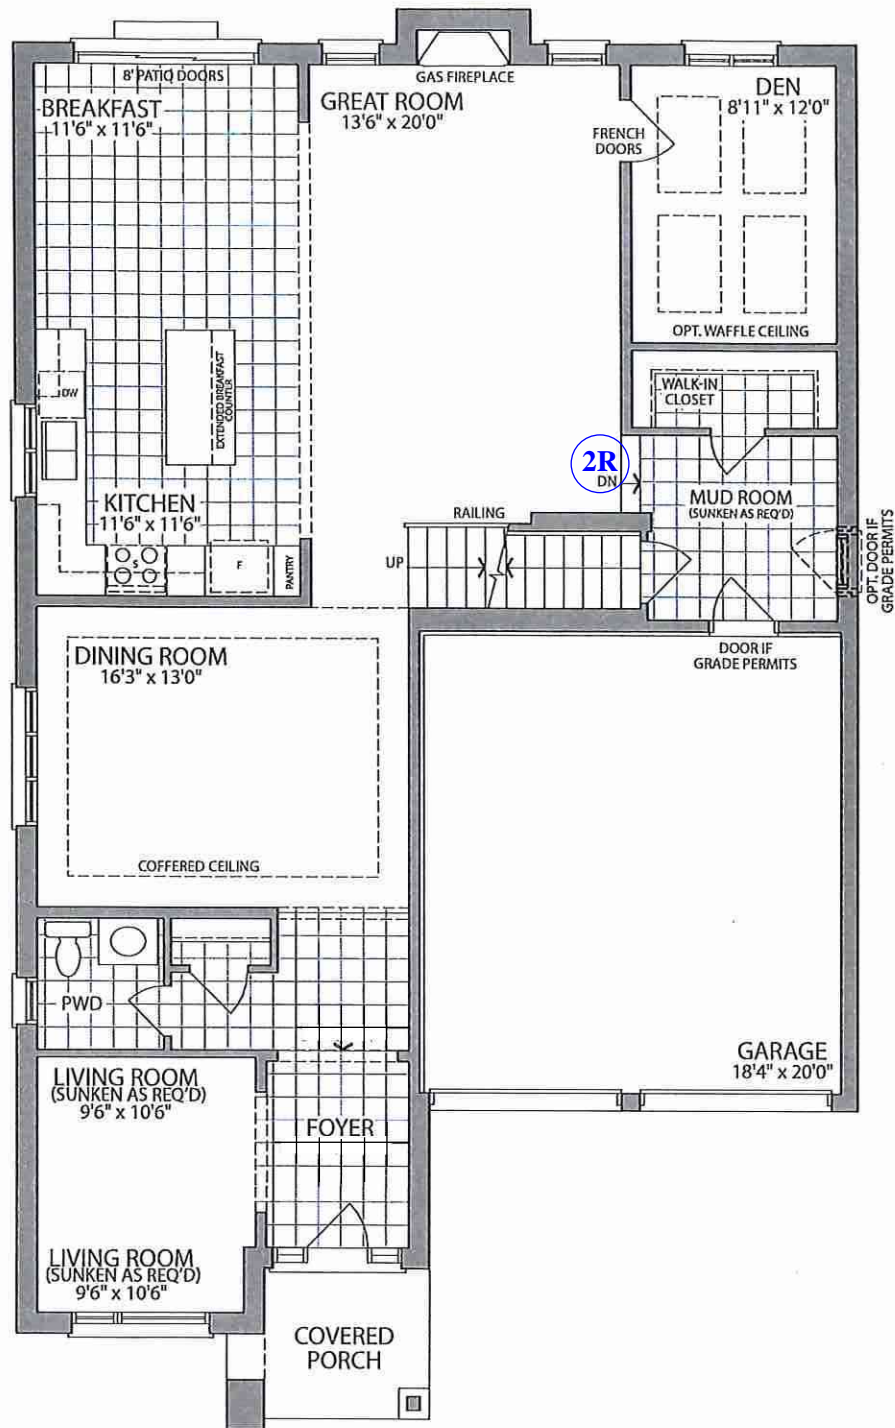

GROUND FLOOR  
ELEV. C

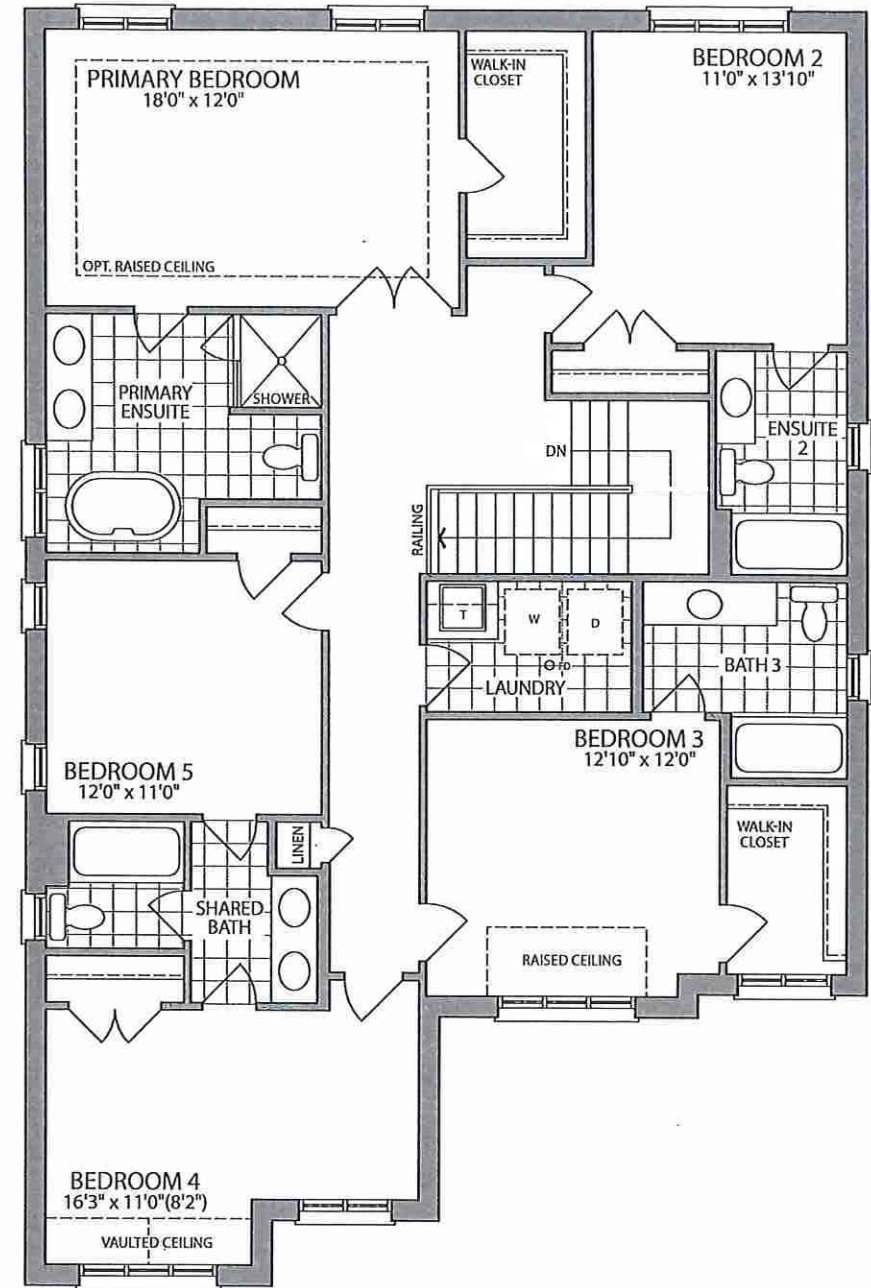

OPT. SECOND FLOOR  
W/5 BEDROOMS & 4 BATH  
ELEV. C