



CONSTRUCTION SUMMARY

Forestside Estates Inc.

PURCHASERS: AARUSH DUA and GURPREET KAUR

TEL: RES.: 647-618-7184


LOT NUMBER	PHASE	HOUSE TYPE	CLOSING DATE
38	8	SILVER POPLAR (40-02CO) - ELEV C - OPT 2ND	25-Jul-24

Offer	BONUS PACKAGE -PURCHASER TO RECEIVE \$20,000 (INCLUSIVE OF TAXES) WORTH OF UPGRADES AT DECOR CENTRE AT TIME OF COLOUR CHART
Worksheet	Note:


Date Added: 25-May-23 Invoice Number: 8472

1 - BASEMENT- Increase basement height to APPROXIMATELY 9'-0" as per vendors specifications and architentural drawings. Note:
1 - PURCHASER AWARE AND ACCEPTS THAT ANY CHANGES MADE TO UPGRADES AFTER SIGNING THIS PURCHASERS EXTRA FORM ARE SUBJECT TO A MINIMUM ADMINISTRATION FEE OF \$1,000 Note:
1 - BONUS PACKAGE-PURCHASER TO RECEIVE \$20,000 (INCLUSIVE OF TAXES) WORTH OF UPGRADES AT THE DESIGN STUDIO AT TIME OF COLOUR CHART Note:


This Document is Extremely Time Sensitive - Printed 27 Jun 23 at 14:07

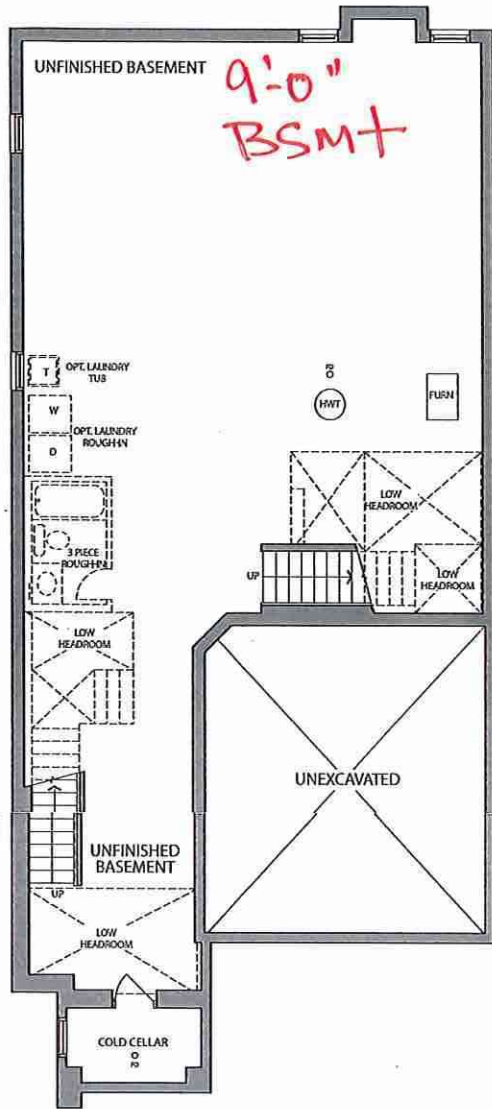

BASEMENT ELEV. C

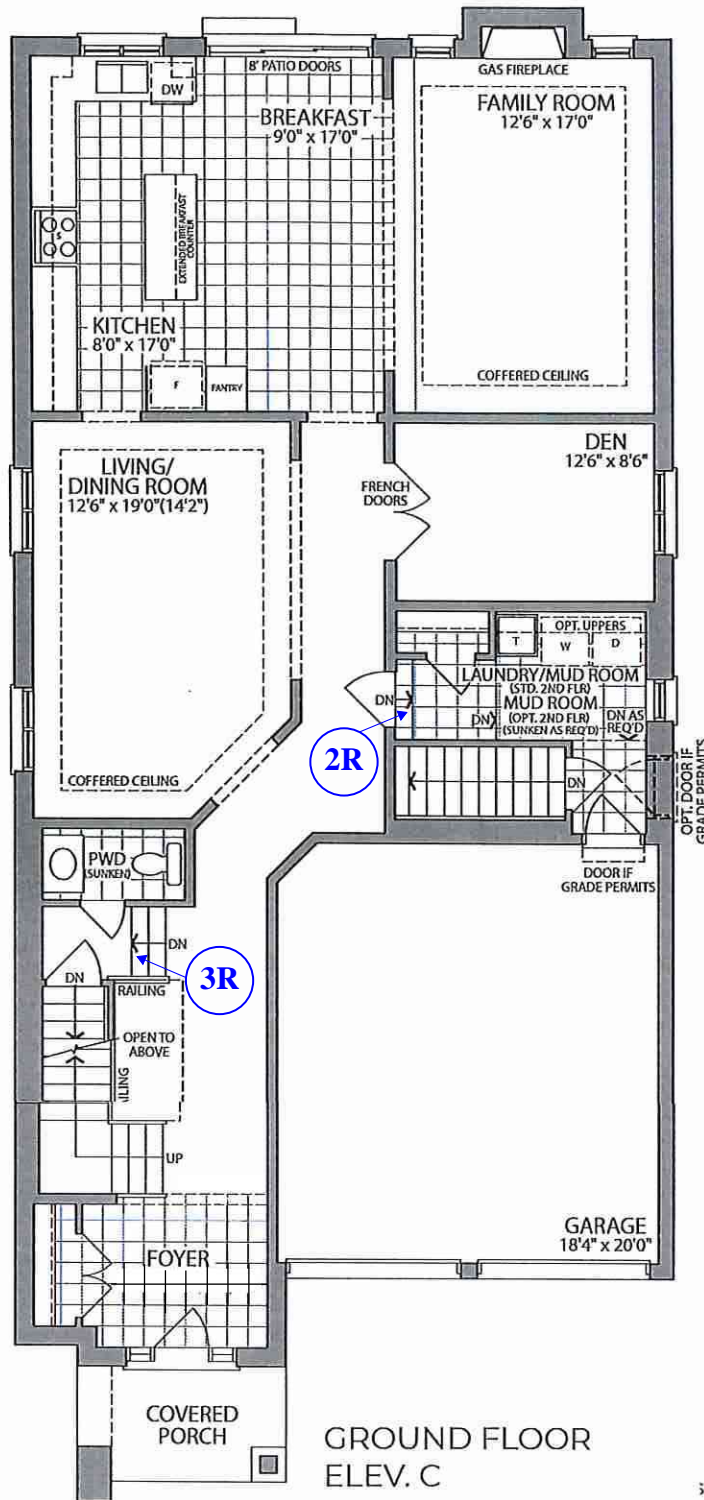

GROUND FLOOR
ELEV. C

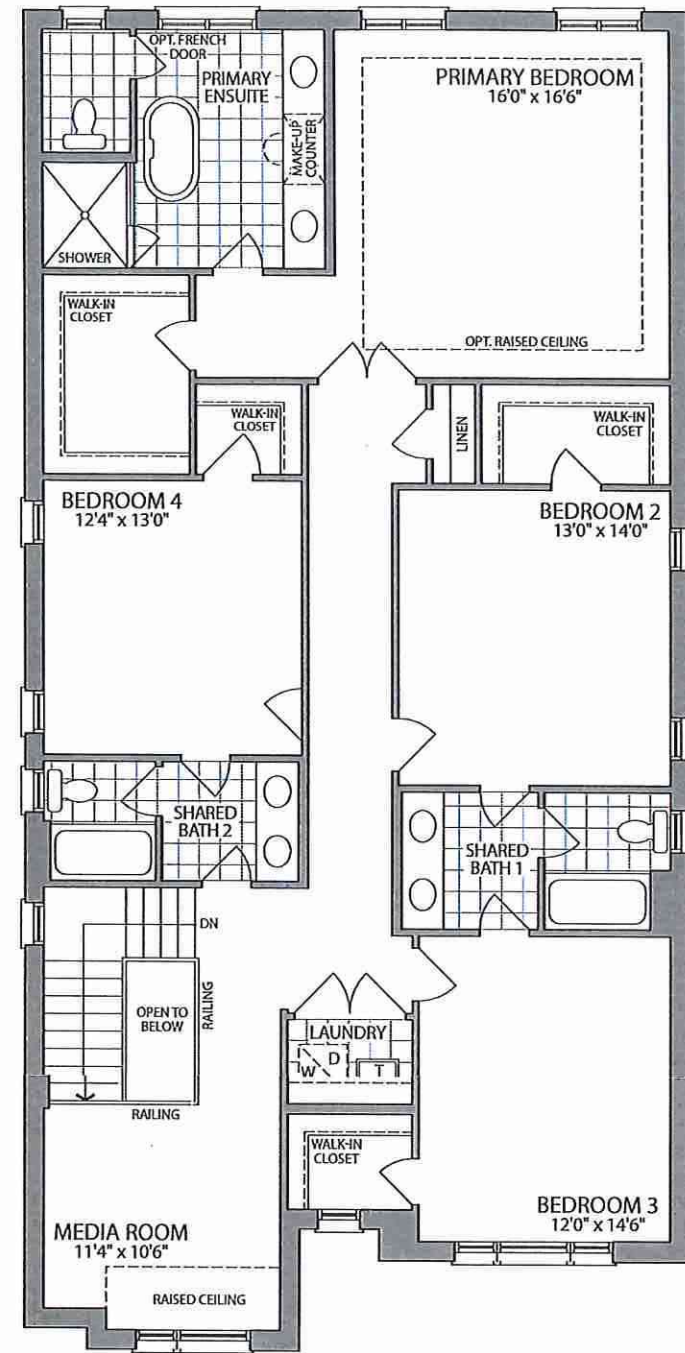

OPT. SECOND FLOOR
W/LAUNDRY & MEDIA ROOM
ELEV. C

Specifications and floor plans are subject to change without notice. All renderings are artist's concept. Plans are approximate dimensions. Actual usable floor space may vary from the stated floor area. E.&O.E.