



Structural

CONSTRUCTION SUMMARY

Forestside Estates Inc. PH. 8

PURCHASERS: ARULANANTHAM VAITHILINGAM and UMAPATHY ARULANANTHAM

TEL:


LOT NUMBER	PHASE	HOUSE TYPE	CLOSING DATE
43	8	BLUE ELM (38-04C4) - ELEV C - 4 BEDRM	25-Jun-24

Offer	BONUS PACKAGE -PURCHASER TO RECEIVE \$20,000 (INCLUSIVE OF TAXES) WORTH OF UPGRADES AT DECOR CENTRE AT TIME OF COLOUR CHART
Worksheet	Note:


Date Added: 09-Aug-23 Invoice Number: 8501

1 - BASEMENT- Increase basement height to APPROXIMATELY 9'-0" as per the Vendors specifications and architectural drawings.
Note:
1 - PURCHASER AWARE AND ACCEPTS THAT ANY CHANGES MADE TO UPGRADES AFTER SIGNING THIS PURCHASERS EXTRA FORM ARE SUBJECT TO A MINIMUM ADMINISTRATION FEE OF \$1,000
Note:


This Document is Extremely Time Sensitive - Printed 9 Aug 23 at 15:30

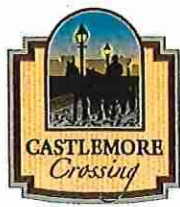


9'-0" BSM+

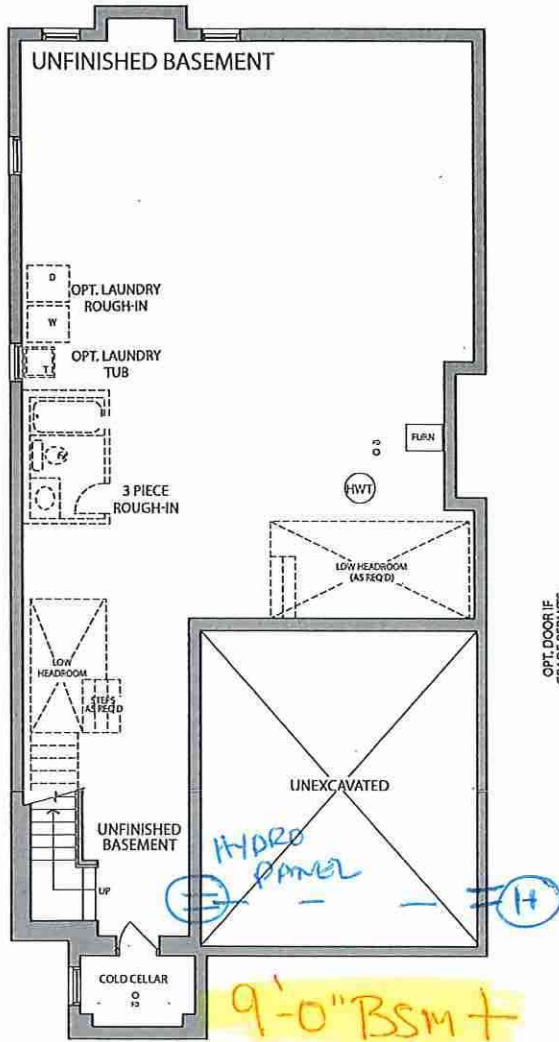

BASEMENT ELEV. C

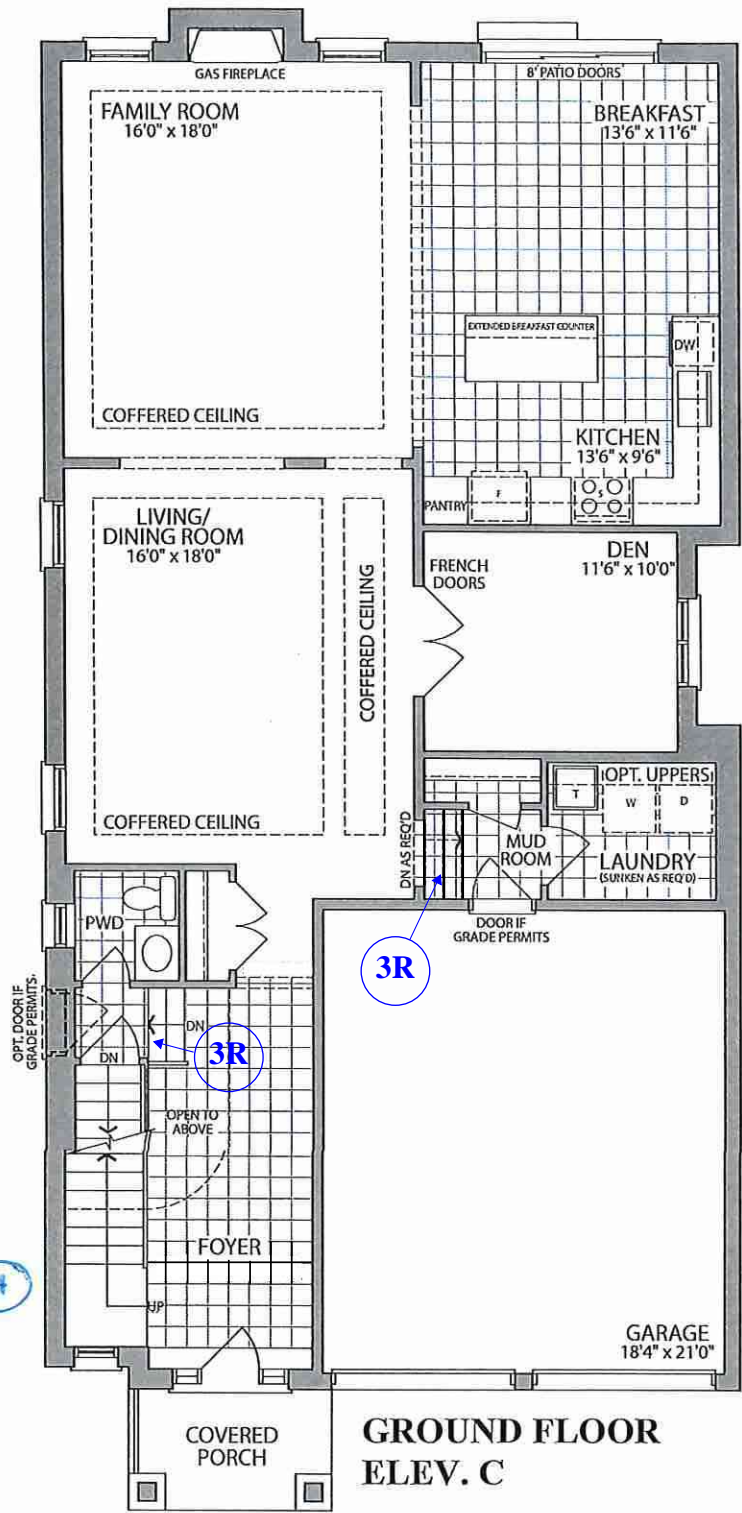

GROUND FLOOR  
ELEV. C

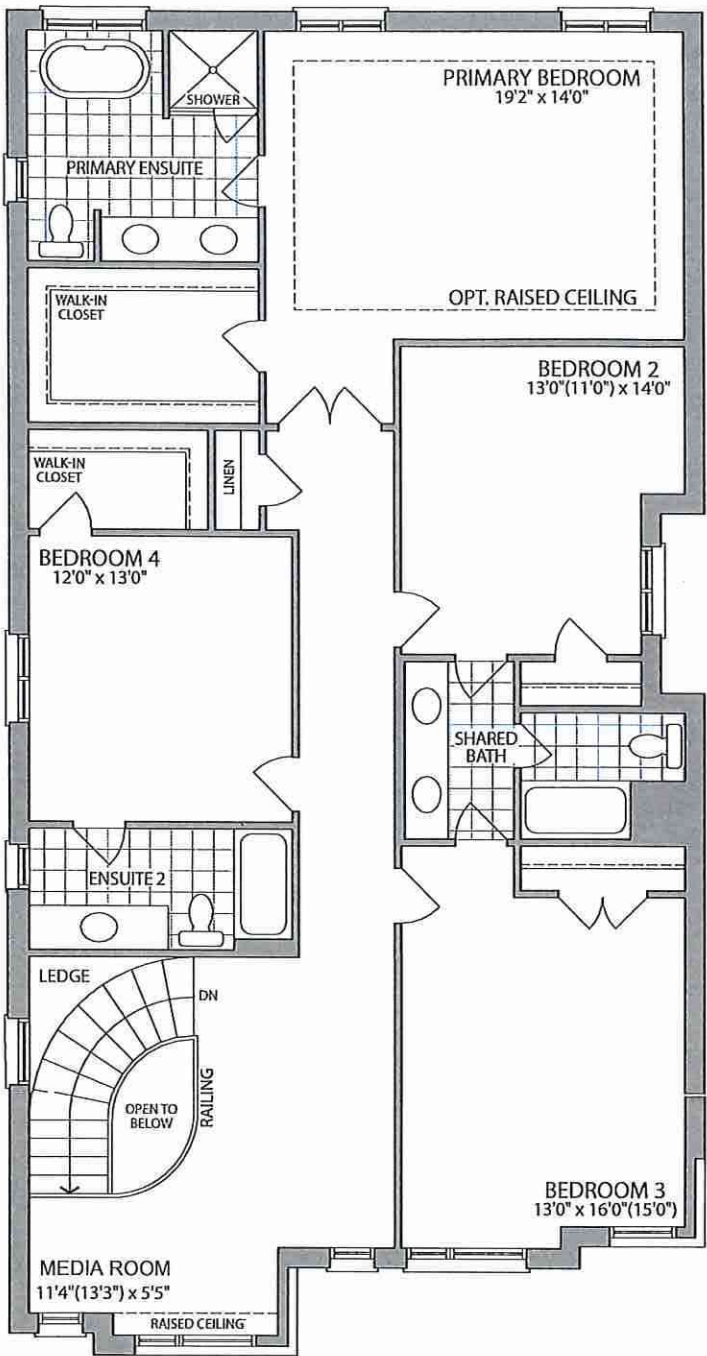

SECOND FLOOR  
ELEV. C

Materials, specifications and floor plans are subject to change without notice. All renderings are artist's concept. All floor plans are approximate dimensions. Actual usable floor space may vary from the stated floor area. E.&O.E.

LOT 43 . 38-04 . The Blue Elm . EL. C . 4 Bedroom . 3355 SQ. FT.